


MATCH LINE SEE SHEET U1.0

MATCH LINE SEE SHEET U1.4

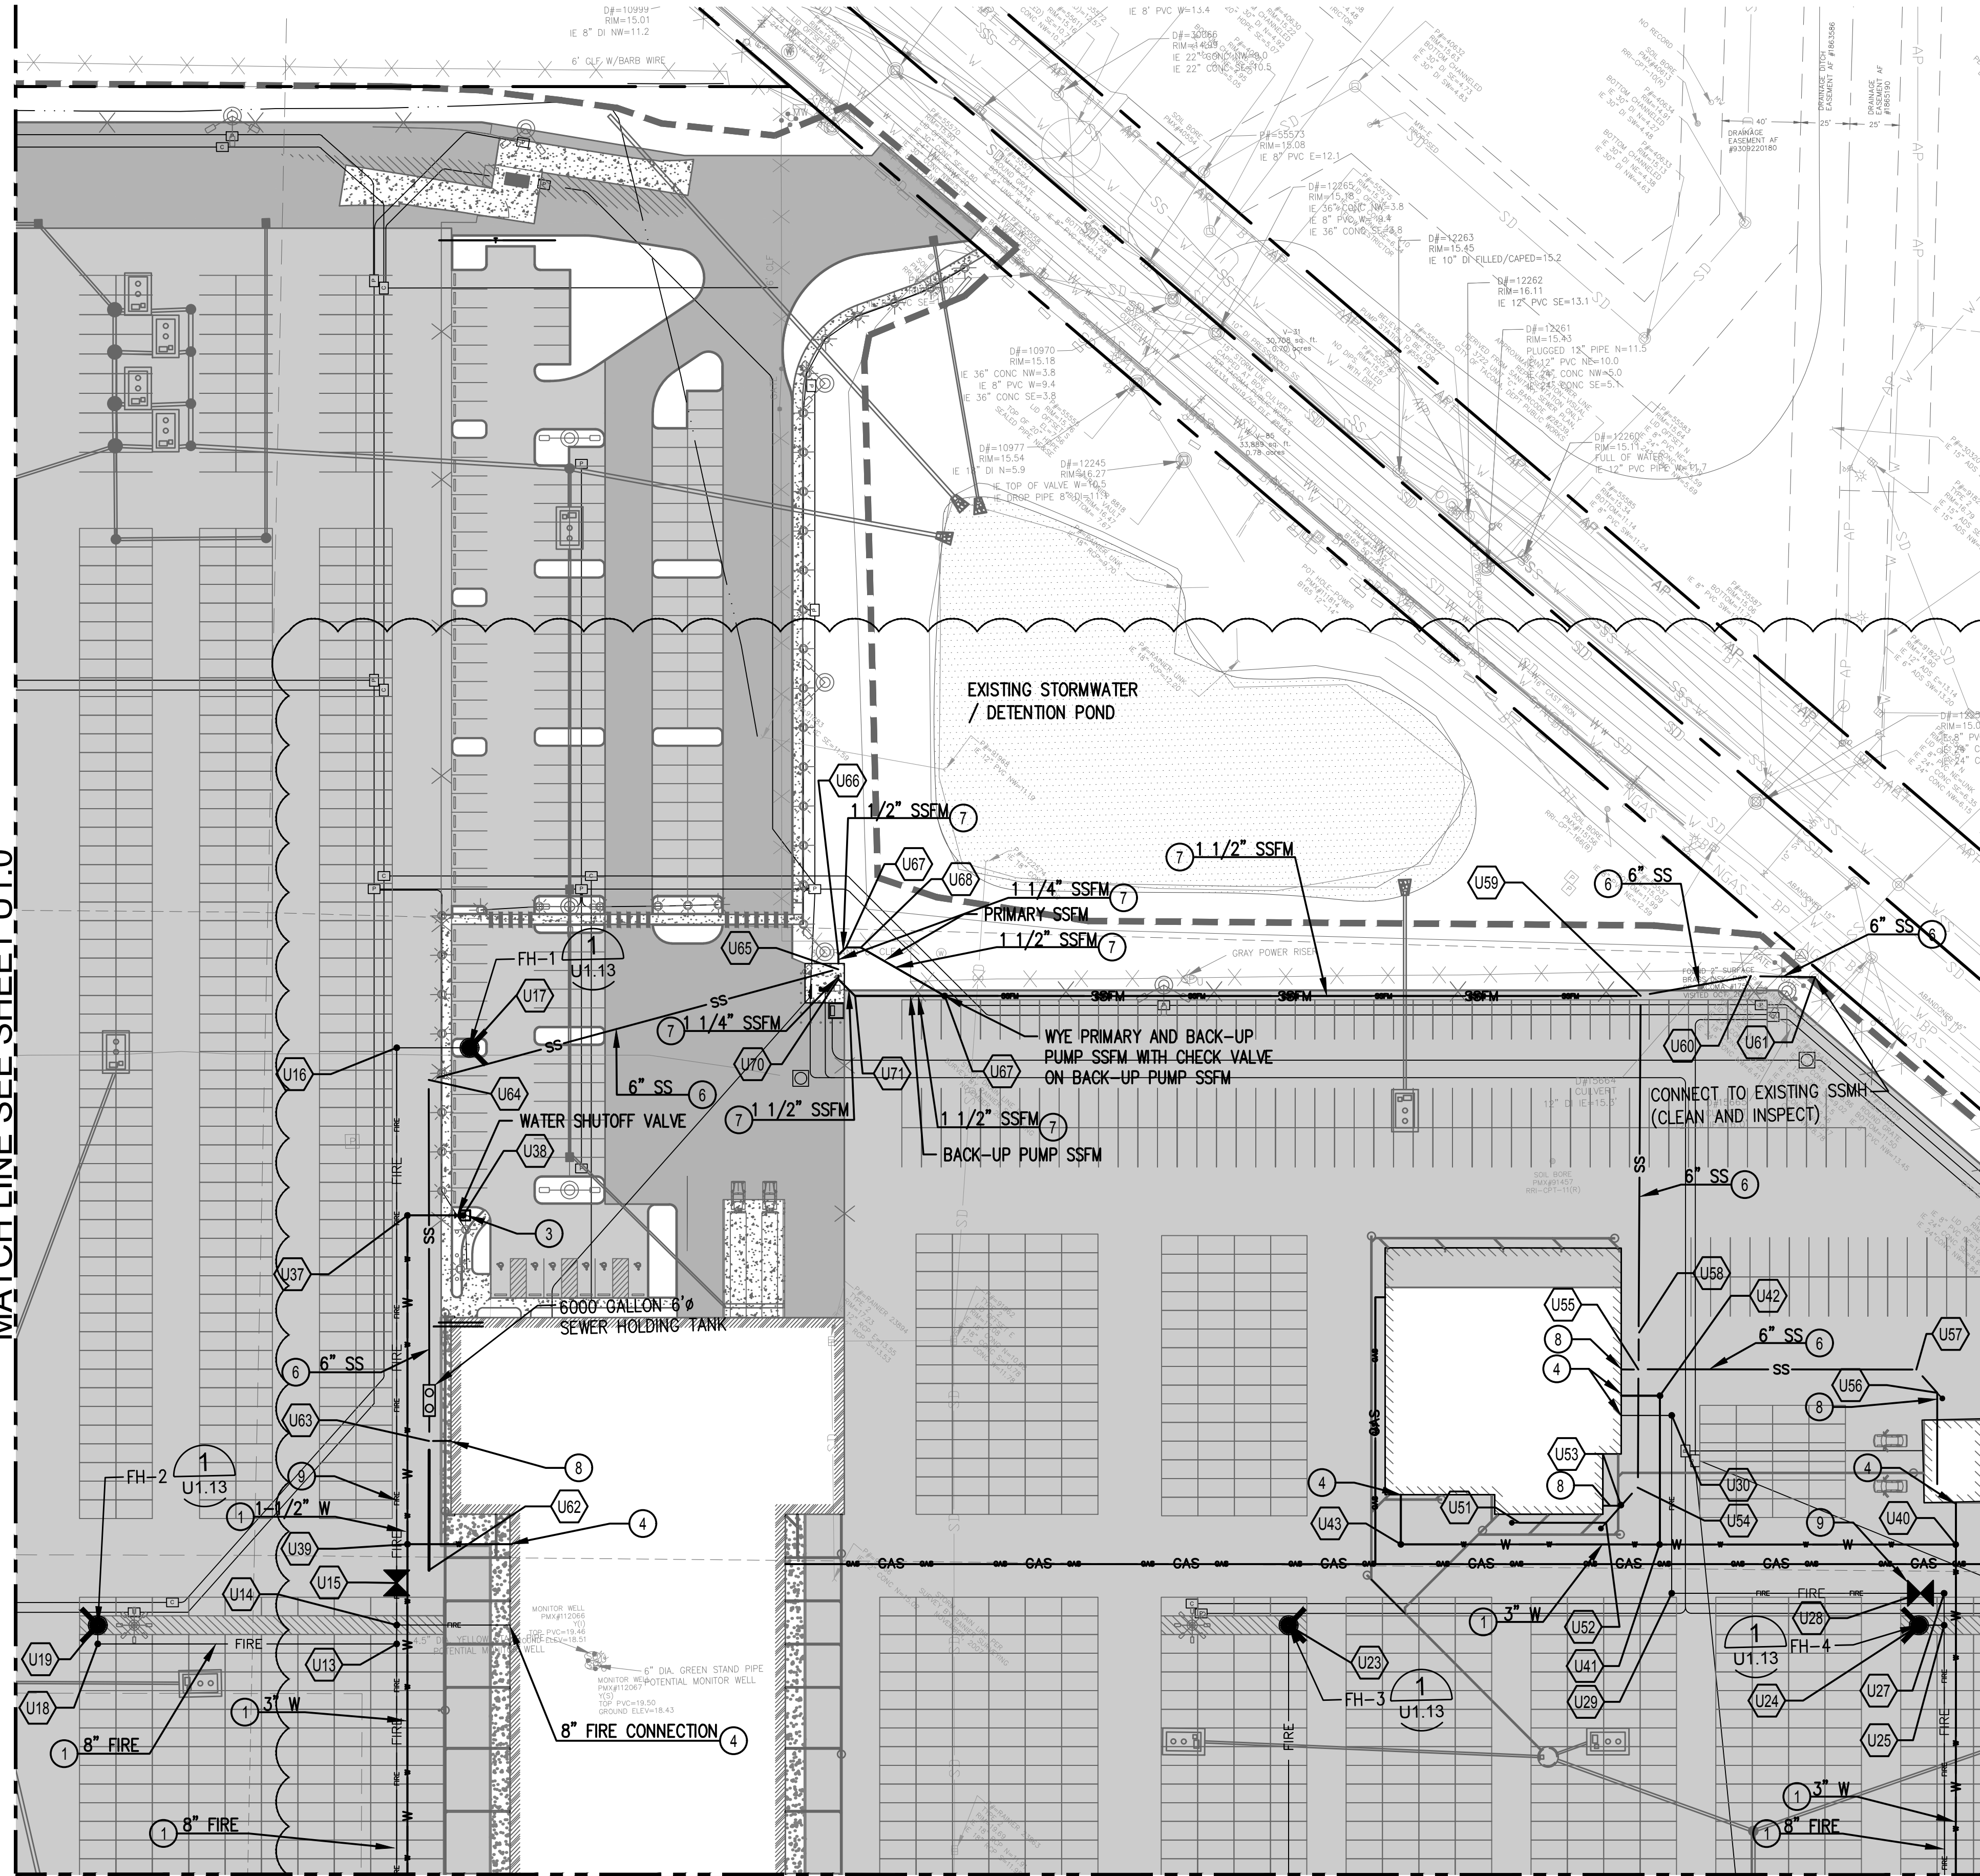


MATCH LINE SEE SHEET U1.3

UTILITY NOTES

1. CONSTRUCT CLASS 200 PVC WATER PIPE, SEE PLAN FOR SIZE, SEE 2 FOR TYPICAL TRENCH INSTALLATION. U1.13
2. CONNECT TO EXISTING METER
3. CONSTRUCT IRRIGATION METER, SEE LANDSCAPE PLANS
4. CONSTRUCT BUILDING WATER CONNECTION WITHIN 5' OF BUILDING AND COORDINATE BUILDING ENTRY WITH BUILDING CONTRACTOR
5. CONSTRUCT PIPE CASING, MINIMUM LENGTH 15' FROM 3 CENTERLINE OF TRACK ON BOTH SIDES. SEE U1.17
6. CONSTRUCT PVC GRAVITY SANITARY SEWER, SEE PLAN FOR SIZE
7. CONSTRUCT PVC SANITARY SEWER FORCE MAIN (SSFM)
8. LOCATE 6" SEWER STUB TO WITHIN 5' OF BUILDING AND COORDINATE BUILDING ENTRY WITH BUILDING CONTRACTOR
9. CONSTRUCT GATE VALVE, SIZE TO MATCH WATER PIPE, SEE 5 U1.13
10. CONSTRUCT HDPE WATER SERVICE PIPE. SEE 2 FOR TYPICAL TRENCH INSTALLATION. U1.13
11. TRENCH AND BACKFILL FOR GAS INSTALLATION PER SPECIFICATIONS

NOTES


1. SIDE SEWER CONNECTION PERMITS ARE REQUIRED AT CONNECTIONS TO EXISTING SANITARY SEWERS. FOR QUESTIONS, CONTACT CITY OF TACOMA SITE DEVELOPMENT AT (253) 591-5760. TO APPLY FOR A PERMIT, GO TO TACOMAPERMITS.ORG
2. REFER TO SHEETS D1.0 THRU D1.5 FOR APPROXIMATE AREAS OF KNOWN REMNANT CONTAMINATION, REMEDIATED CONTAMINATION, AND BURIED CONCRETE FOUNDATIONS.
3. FIRE HYDRANT GATE VALVES ARE NOT SHOWN FOR CLARITY. SEE 1 FOR VALVE LOCATION. U1.13
4. CONCRETE THRUST BLOCKS ARE NOT SHOWN FOR CLARITY. THRUST BLOCKS TO BE CONSTRUCTED PER 1 U1.15
5. SEE SHEETS U1.9-U1.12 FOR FIRE WATER LINE PROFILES.
6. SEE SHEETS U1.7-U1.8 FOR SANITARY SEWER PROFILE.
7. SEE SHEET U1.6 FOR DOMESTIC WATER INVERT ELEVATIONS.
8. SEE ELECTRICAL PLANS FOR POWER AND COMMUNICATION UTILITY SYSTEMS.
9. REFER TO SHEET U1.6 FOR SCHEDULE OF UTILITY LOCATIONS AND COMPONENTS.
10. METERS WILL BE PROVIDED AND INSTALLED BY TACOMA WATER, CONTRACTOR SHALL COORDINATE METER INSTALLATION AND CONNECT TO COMPLETED INSTALLATION.
11. ALL MANHOLES SHALL BE FITTED WITH PRECAST COMPRESSION GASKET CONNECTIONS OR FLEXIBLE BOOT CONNECTIONS.
12. CONSTRUCT SANITARY SEWER MANHOLES (SSMH) PER 1 U1.17

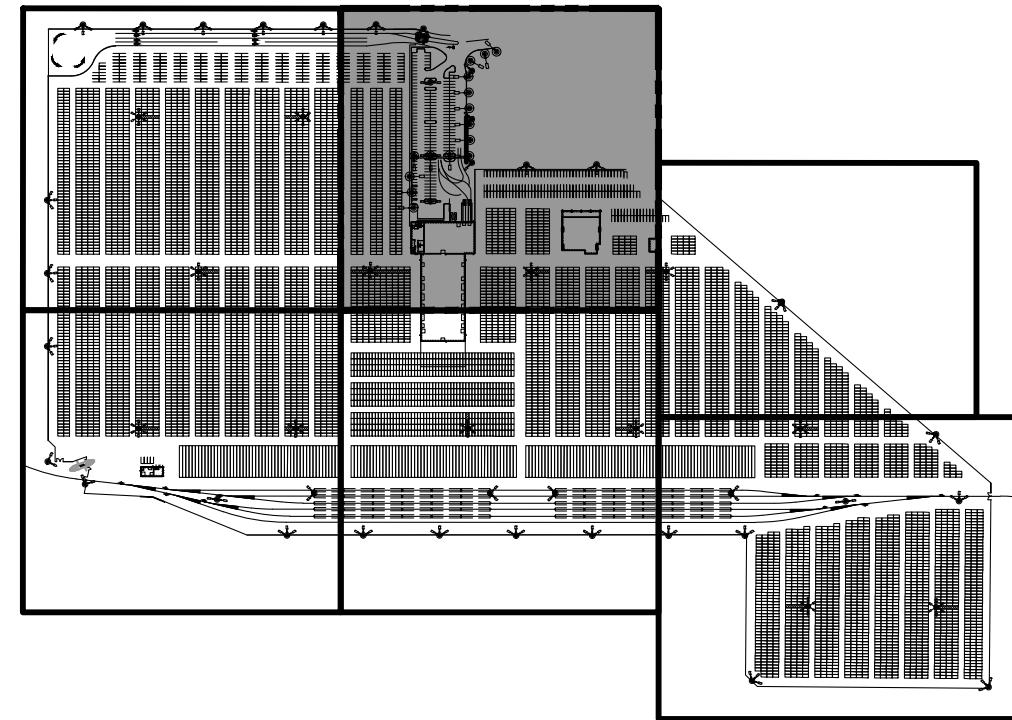

KEY PLAN
NTS

U1.1 95 OF 163	PARCEL 77 AUTO IMPORT TERMINAL				APPROVED:		CMB	5/7/2018	 2407 North 31st Street, Suite 100 Tacoma, Washington 98407 (253) 396-0150 Fax (253) 396-0162	 K. P. P. F. F. REGISTERED PROFESSIONAL ENGINEER NO. 32791 STATE OF WASHINGTON	 P.O. BOX 1837 TACOMA, WA 98401
	UTILITY PLAN AREA 2						CHECKED BY	DATE			
CONTR/CONS:	070770	TOWNSHIP:	21N	RANGE:	3E	SECTION:	36	SWK	5/9/2018		
M. ID:	201020.01	DAT-HRZ:	W83-SF	VERT:	PORT OF TACOMA BM#			PROJ. ENGR	DATE		
PHASE:	BID SET	PARCEL:	MULTIPLE			DRAWING SCALE:			AS SHOWN		
THIS DRAWING IS THE PROPERTY OF THE PORT OF TACOMA AND SHALL NOT BE USED ON OTHER WORK, DISCLOSED, COPIED, IN WHOLE OR IN PART, WITHOUT WRITTEN PERMISSION											

MATCH LINE SEE SHEET U1.0

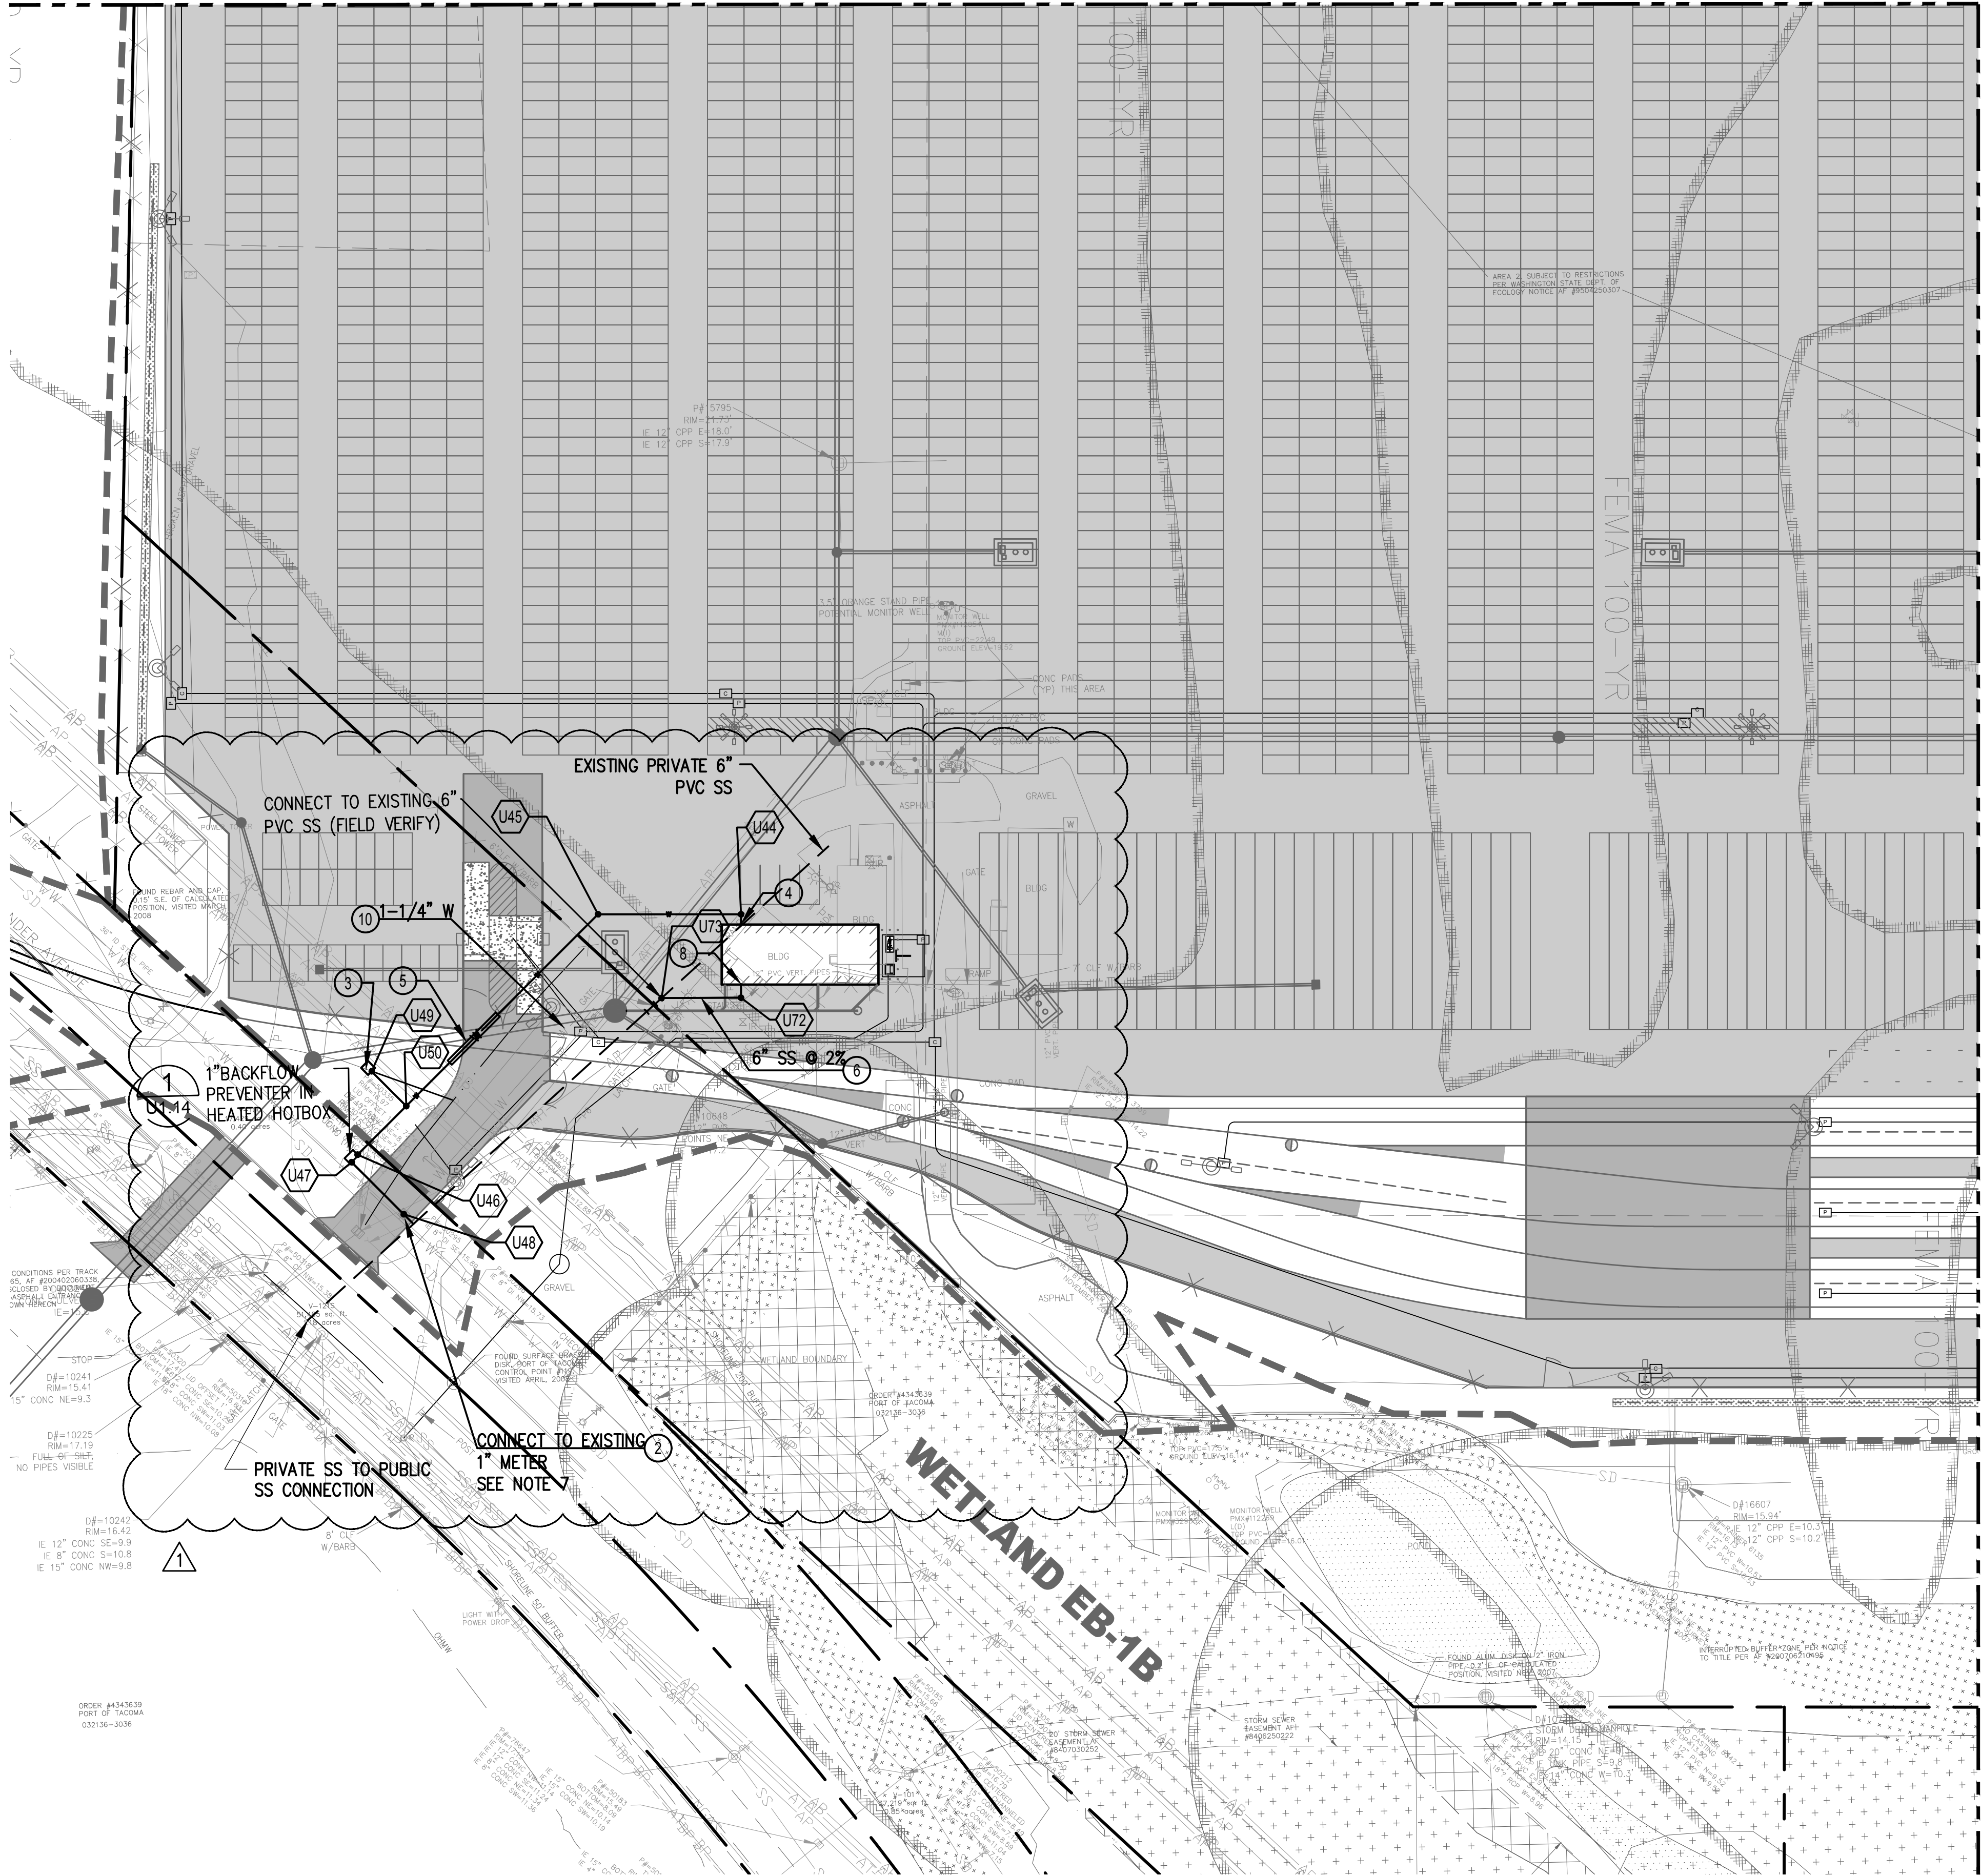


MATCH LINE SEE SHEET U1.3

UTILITY NOTES

1. CONSTRUCT CLASS 200 PVC WATER PIPE, SEE PLAN FOR SIZE, SEE 2 FOR TYPICAL TRENCH INSTALLATION
2. CONNECT TO EXISTING METER
3. CONSTRUCT IRRIGATION METER, SEE LANDSCAPE PLANS
4. CONSTRUCT BUILDING WATER CONNECTION WITHIN 5' OF BUILDING AND COORDINATE BUILDING ENTRY WITH BUILDING CONTRACTOR
5. CONSTRUCT PIPE CASING, MINIMUM LENGTH 15' FROM 3 CENTERLINE OF TRACK ON BOTH SIDES. SEE U1.17
6. CONSTRUCT PVC GRAVITY SANITARY SEWER, SEE PLAN FOR SIZE
7. CONSTRUCT PVC SANITARY SEWER FORCE MAIN (SSFM)
8. LOCATE 6" SEWER STUB TO WITHIN 5' OF BUILDING AND COORDINATE BUILDING ENTRY WITH BUILDING CONTRACTOR
9. CONSTRUCT GATE VALVE, SIZE TO MATCH WATER PIPE, SEE 5 U1.13
10. CONSTRUCT HDPE WATER SERVICE PIPE. SEE 2 FOR TYPICAL TRENCH INSTALLATION. U1.13
11. TRENCH AND BACKFILL FOR GAS INSTALLATION PER SPECIFICATIONS


NOTES

1. SIDE SEWER CONNECTION PERMITS ARE REQUIRED AT CONNECTIONS TO EXISTING SANITARY SEWERS. FOR QUESTIONS, CONTACT CITY OF TACOMA SITE DEVELOPMENT AT (253) 591-5760. TO APPLY FOR A PERMIT, GO TO TACOMAPERMITS.ORG
2. REFER TO SHEETS D1.0 THRU D1.5 FOR APPROXIMATE AREAS OF KNOWN REMNANT CONTAMINATION, REMEDIATED CONTAMINATION, AND BURIED CONCRETE FOUNDATIONS.
3. FIRE HYDRANT GATE VALVES ARE NOT SHOWN FOR CLARITY. SEE 1 FOR VALVE LOCATION. U1.13
4. CONCRETE THRUST BLOCKS ARE NOT SHOWN FOR CLARITY. THRUST BLOCKS TO BE CONSTRUCTED PER 1 U1.15
5. SEE SHEETS U1.9-U1.12 FOR FIRE WATER LINE PROFILES.
6. SEE SHEETS U1.7-U1.8 FOR SANITARY SEWER PROFILE.
7. SEE SHEET U1.6 FOR DOMESTIC WATER INVERT ELEVATIONS.
8. SEE ELECTRICAL PLANS FOR POWER AND COMMUNICATION UTILITY SYSTEMS.
9. REFER TO SHEET U1.6 FOR SCHEDULE OF UTILITY LOCATIONS AND COMPONENTS.
10. METERS WILL BE PROVIDED AND INSTALLED BY TACOMA WATER, CONTRACTOR SHALL COORDINATE METER INSTALLATION AND CONNECT TO COMPLETED INSTALLATION.
11. ALL MANHOLES SHALL BE FITTED WITH PRECAST COMPRESSION GASKET CONNECTIONS OR FLEXIBLE BOOT CONNECTIONS.
12. CONSTRUCT SANITARY SEWER MANHOLES (SSMH) PER 1 U1.17

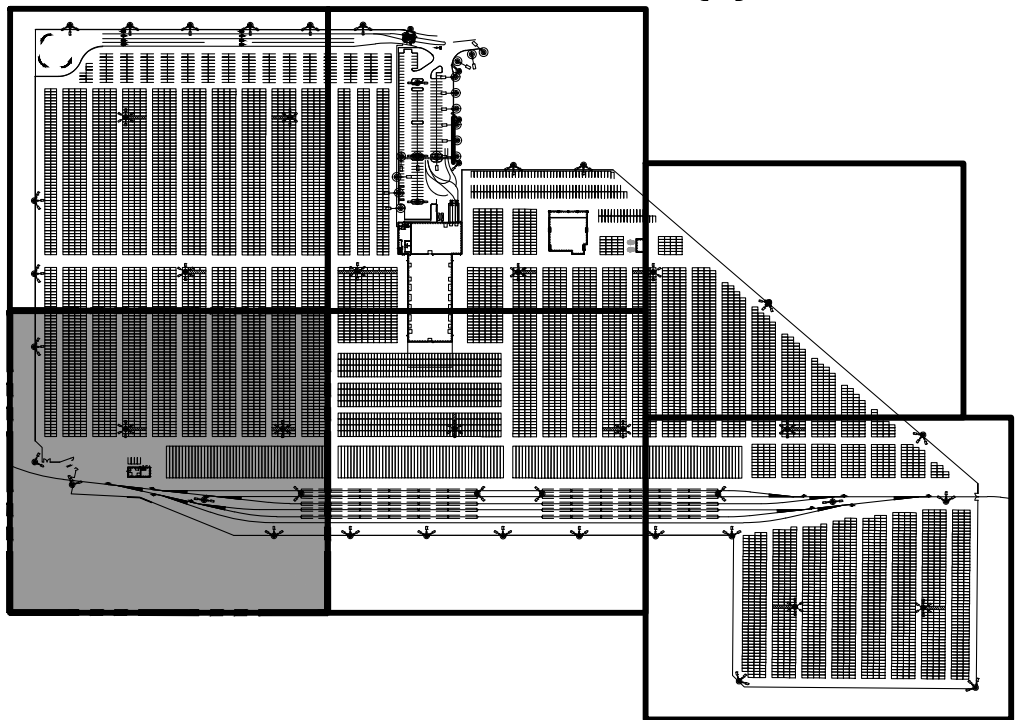

KEY PLAN
NTS

U1.2										PARCEL 77 AUTO IMPORT TERMINAL									
96 OF 163										UTILITY PLAN AREA 3									
CON/CONS:		070720		TOWNSHIP: 21N		RANGE: 3E		SECTION: 36											
M. ID:		201020.01		DAT-HRZ:		W83-SF		VERT:		PORT OF TACOMA BM#									
PHASE:		BID SET		PARCEL:		MULTIPLE		DRAWING SCALE:		AS SHOWN									
										APPROVED:									
		CMB		5/7/2018															
		CHECKED BY:		DATE															
		SWK		5/9/2018															
		PROJ. ENGR		DATE															
		PRINTED BY:		Hemons Jun 06, 2018															
		PORT ADDRESS:		ONE SITCOM PLAZA															
				TACOMA WA, 98401-1837															
										TACOMA WA, 98401-1837									
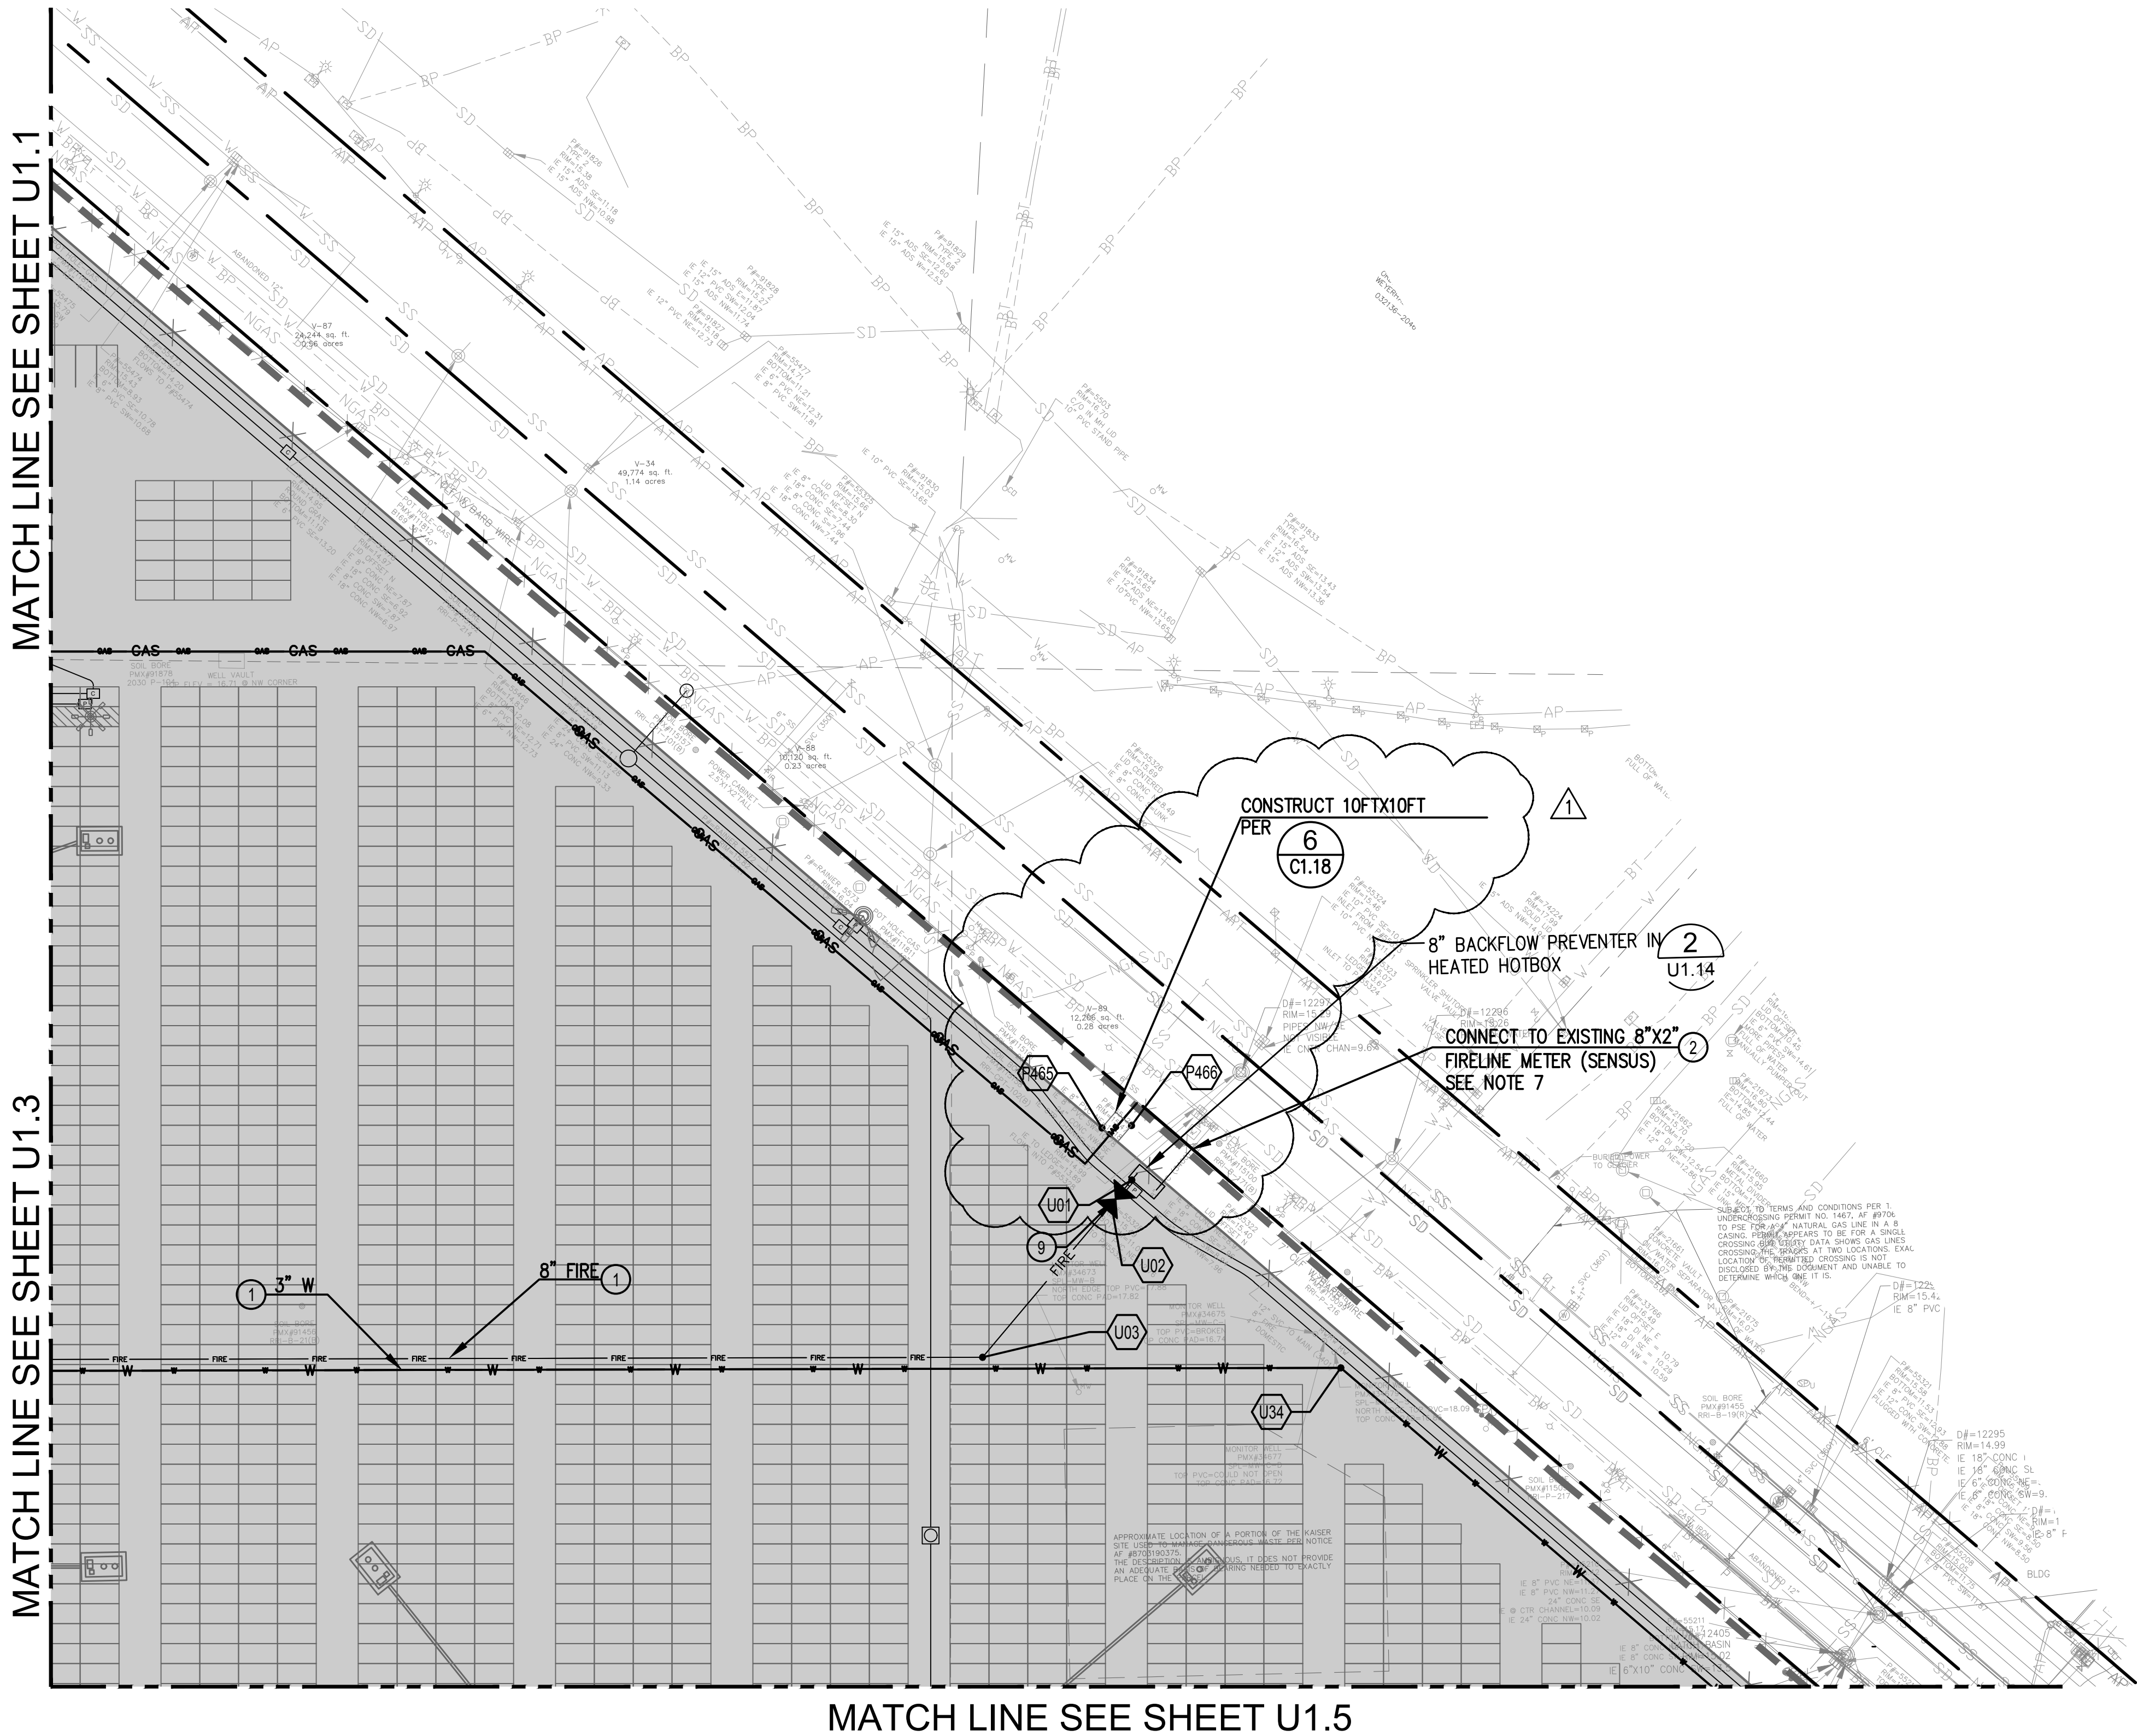


UTILITY NOTES

1. CONSTRUCT CLASS 200 PVC WATER PIPE, SEE PLAN FOR SIZE, SEE 2 FOR TYPICAL TRENCH INSTALLATION
2. CONNECT TO EXISTING METER
3. CONSTRUCT IRRIGATION METER, SEE LANDSCAPE PLANS
4. CONSTRUCT BUILDING WATER CONNECTION WITHIN 5' OF BUILDING AND COORDINATE BUILDING ENTRY WITH BUILDING CONTRACTOR
5. CONSTRUCT PIPE CASING, MINIMUM LENGTH 15' FROM 3 CENTERLINE OF TRACK ON BOTH SIDES. SEE U1.17
6. CONSTRUCT PVC GRAVITY SANITARY SEWER, SEE PLAN FOR SIZE
7. CONSTRUCT PVC SANITARY SEWER FORCE MAIN (SSFM)
8. LOCATE 6" SEWER STUB TO WITHIN 5' OF BUILDING AND COORDINATE BUILDING ENTRY WITH BUILDING CONTRACTOR
9. CONSTRUCT GATE VALVE, SIZE TO MATCH WATER PIPE, SEE 5 U1.13
10. CONSTRUCT HDPE WATER SERVICE PIPE. SEE 2 FOR TYPICAL TRENCH INSTALLATION. U1.13
11. TRENCH AND BACKFILL FOR GAS INSTALLATION PER SPECIFICATIONS

NOTES

1. SIDE SEWER CONNECTION PERMITS ARE REQUIRED AT CONNECTIONS TO EXISTING SANITARY SEWERS. FOR QUESTIONS, CONTACT CITY OF TACOMA SITE DEVELOPMENT AT (253) 591-5760. TO APPLY FOR A PERMIT, GO TO TACOMAPERMITS.ORG
2. REFER TO SHEETS D1.0 THRU D1.5 FOR APPROXIMATE AREAS OF KNOWN REMNANT CONTAMINATION, REMEDIATED CONTAMINATION, AND BURIED CONCRETE FOUNDATIONS.
3. FIRE HYDRANT GATE VALVES ARE NOT SHOWN FOR CLARITY. SEE 1 FOR VALVE LOCATION. U1.13
4. CONCRETE THRUST BLOCKS ARE NOT SHOWN FOR CLARITY. THRUST BLOCKS TO BE CONSTRUCTED PER 1 U1.15
5. SEE SHEETS U1.9-U1.12 FOR FIRE WATER LINE PROFILES.
6. SEE SHEETS U1.7-U1.8 FOR SANITARY SEWER PROFILE.
7. SEE SHEET U1.6 FOR DOMESTIC WATER INVERT ELEVATIONS.
8. SEE ELECTRICAL PLANS FOR POWER AND COMMUNICATION UTILITY SYSTEMS.
9. REFER TO SHEET U1.6 FOR SCHEDULE OF UTILITY LOCATIONS AND COMPONENTS.
10. METERS WILL BE PROVIDED AND INSTALLED BY TACOMA WATER, CONTRACTOR SHALL COORDINATE METER INSTALLATION AND CONNECT TO COMPLETED INSTALLATION.
11. ALL MANHOLES SHALL BE FITTED WITH PRECAST COMPRESSION GASKET CONNECTIONS OR FLEXIBLE BOOT CONNECTIONS.
12. CONSTRUCT SANITARY SEWER MANHOLES (SSMH) PER 1 U1.17

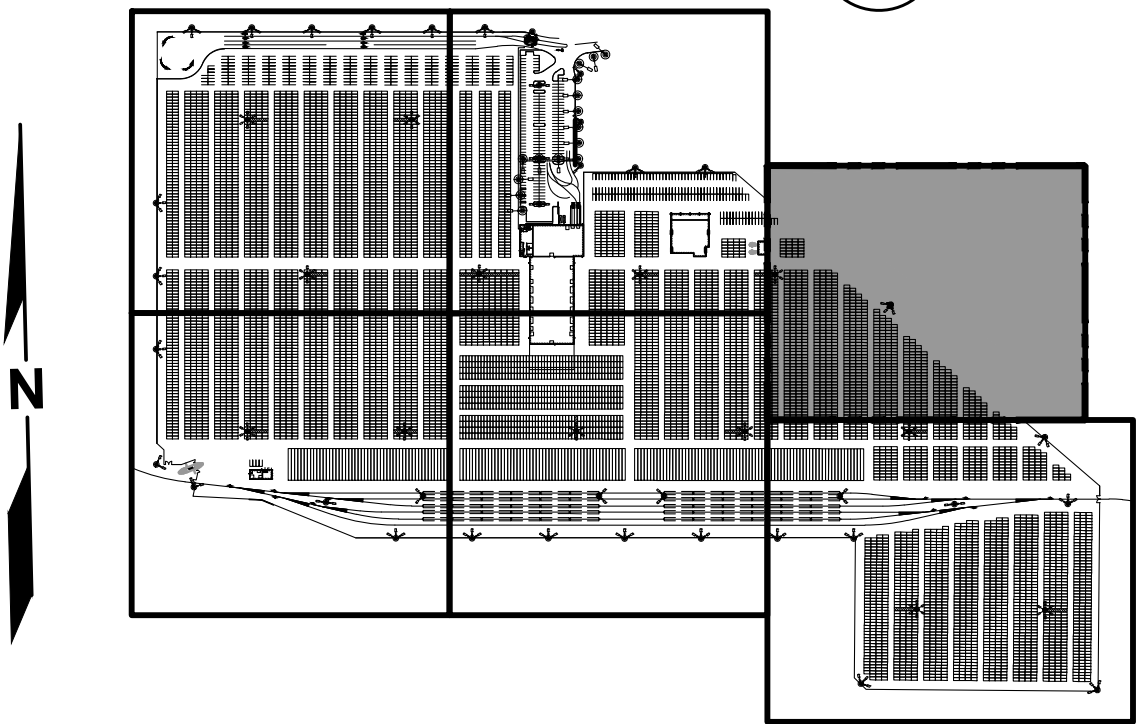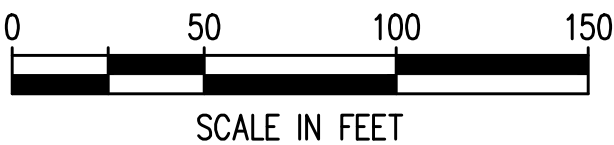

U1.4 98 OF 163	PARCEL 77 AUTO IMPORT TERMINAL				APPROVED:				CMB	5/7/2018						
	UTILITY PLAN AREA 5				CHECKED BY: DATE		SWK		5/9/2018	2407 North 31st Street, Suite 100 Tacoma, Washington 98407 (253) 396-0150 Fax (253) 396-0162				P.O. BOX 1837 TACOMA, WA 98401 (253) 396-3441		
	TOWNSHIP: 21N	RANGE: 3E	SECTION: 36	DATE: 07/07/20	DIRECTOR ENG. DATE		PRINTED BY: Hemons Jun 06, 2018		PORT ADDRESS: ONE SITCUM PLAZA		REVISION: ADDENDUM #4		BY: CMB		DATE: 6/5	
	DAT-HRZ: W83-SF	VERT: PORT OF TACOMA BM#	DRAWING SCALE: AS SHOWN		TACOMA WA 98401-1837											

FIRE WATER LOCATION TABLE				
POINT	DESCRIPTION	NORTHING	EASTING	SHEET
U1	BACKFLOW OUTLET	708273.93	1177068.96	U1.4
U2	GATE VALVE	708264.93	1177061.02	U1.4
U3	45 DEGREE ELBOW	708191.13	1176995.86	U1.4
U4	TEE	708201.13	1176533.04	U1.3
U5	GATE VALVE	708201.39	1176521.00	U1.3
U6	TEE	708208.34	1176199.32	U1.3
U7	TEE	708214.35	1175921.50	U1.3
U8	GATE VALVE	708214.60	1175909.51	U1.3
U9	TEE	708215.36	1175874.50	U1.3
U10	FH-5	708258.31	1175875.43	U1.3
U11	90 DEGREE ELBOW	708218.13	1175745.92	U1.3
U12	GATE VALVE	708230.18	1175746.21	U1.3
U13	TEE	708516.82	1175753.08	U1.1
U14	TEE	708526.39	1175753.31	U1.1
U15	GATE VALVE	708547.81	1175753.83	U1.1
U16	90 DEGREE ELBOW	708819.87	1175760.35	U1.1
U17	FH-1	708818.99	1175797.25	U1.1
U18	90 DEGREE ELBOW	708520.46	1175601.13	U1.1
U19	FH-2	708529.95	1175601.37	U1.1
U20	FH-6	708013.05	1175946.07	U1.3
U21	90 DEGREE ELBOW	708013.74	1175917.08	U1.3
U22	GATE VALVE	708221.08	1176199.63	U1.3
U23	FH-3	708515.44	1176206.68	U1.1
U24	FH-4	708507.76	1176527.09	U1.1
U25	TEE	708507.45	1176539.92	U1.1
U26	GATE VALVE	708213.08	1176533.31	U1.3
U27	90 DEGREE ELBOW	708523.70	1176540.28	U1.1
U28	GATE VALVE	708523.99	1176528.28	U1.1
U29	90 DEGREE ELBOW	708527.02	1176401.83	U1.1
U30	90 DEGREE ELBOW	708617.45	1176403.99	U1.1

WATER LOCATION TABLE						
POINT	DESCRIPTION	NORTHING	EASTING	INVERT ELEVATION	FINISH GRADE	SHEET
U31	CONNECT TO METER	707821.30	1177620.94	TO BE FIELD VERIFIED	EX GRADE 15.97 ±	U1.5
U32	45 DEGREE ELBOW	707804.48	1177606.07	16.09	18.84	U1.5
U33	BACKFLOW INLET	707803.26	1177586.26	15.93	18.68	U1.5
U34	45 DEGREE ELBOW	708182.02	1177166.37	16.60	19.35	U1.4
U35	TEE	708195.59	1176538.30	16.63	19.38	U1.3
U36	90 DEGREE ELBOW	708212.60	1175751.24	16.68	19.43	U1.3
U37	90 DEGREE ELBOW	708734.51	1175763.77	17.37	20.12	U1.1
U38	IRRIGATION METER	708733.85	1175790.68	17.39	20.14	U1.1
U39	TEE W/REDUCER	708567.34	1175759.76	17.59	20.34	U1.1
U40	TEE	708548.19	1176546.88	17.32	20.07	U1.1
U41	TEE	708551.98	1176396.42	17.18	19.93	U1.1
U42	90 DEGREE ELBOW	708627.59	1176398.23	17.54	20.29	U1.1
U43	90 DEGREE ELBOW	708555.19	1176264.72	17.28	20.03	U1.1
U44	90 DEGREE ELBOW	707898.11	1174955.29	15.42	18.17	U1.2
U45	45 DEGREE ELBOW	707958.78	1174844.58	0.00	18.44	U1.2
U46	CONNCT TO BACKFLOW PREVENTER	707839.61	1174719.56	16.46	17.60	U1.2
U47	CONNECT TO BACKFLOW PREVENTER	707836.27	1174716.05	16.46	17.60	U1.2
U48	CONNECT TO EX WATER METER	707803.72	1174747.07	16.46	17.60	U1.2
U49	IRRIGATION METER	707881.72	1174727.66	15.45	18.20	U1.2
U50	TEE	707863.70	1174744.83	12.90	18.20	U1.2

SANITARY SEWER LOCATION TABLE				
POINT	DESCRIPTION	NORTHING	EASTING	SHEET
U51	CLEANOUT	708564.71	1176325.29	U1.1
U52	45 DEGREE ELBOW WITH CLEANOUT	708563.65	1176369.26	U1.1
U53	WYE	708572.15	1176377.05	U1.1
U54	SSMH-1	708581.73	1176385.86	U1.1
U55	SSMH-2	708641.18	1176387.66	U1.1
U56	45 DEGREE ELBOW WITH CLEANOUT	708625.74	1176539.18	U1.1
U57	SSMH-5	708637.79	1176528.89	U1.1
U58	OIL WATER SEPARATOR	708659.79	1176388.22	U1.1
U59	SSMH-3	708831.04	1176393.35	U1.1
U60	SSMH-4	708839.86	1176449.65	U1.1
U61	EX SSMH	708838.47	1176482.26	U1.1
U62	OIL WATER SEPARATOR	708553.84	1175770.44	U1.1
U63	SSMH-6	708619.61	1175772.02	U1.1
U64	SSMH-7	708803.12	1175776.22	U1.1
U65	SS LIFT STATION	708854.28	1175985.82	U1.1
U66	45 DEGREE ELBOW W/ REDUCER	708861.59	1175986.00	U1.1
U67	45 DEGREE ELBOW	708865.36	1175989.95	U1.1
U68	30 DEGREE ELBOW	708865.18	1175997.50	U1.1
U69	30 DEGREE WYE	708839.52	1176039.58	U1.1
U70	45 DEGREE ELBOW W/ REDUCER	708849.29	1175985.70	U1.1
U71	45 DEGREE ELBOW	708849.62	1175993.96	U1.1
U72	SSMH-8	707914.65	1174916.15	U1.2
U73	CONNECT TO EX SEWER	707915.43	1174875.82	U1.2

U1.6

100 OF 163

CONT/CONS: 070770
M. ID: 201020.01
PHASE: BID SET



PARCEL 77 AUTO IMPORT TERMINAL

UTILITY LOCATION SCHEDULE

TOWNSHIP: 21N RANGE: 3E SECTION: 36
DAT-HRZ: W83-SF VERT: PORT OF TACOMA BM#
PARCEL: MULTIPLE DRAWING SCALE: AS SHOWN

APPROVED:

CMB 5/7/2018
CHECKED BY DATE
SWK 5/9/2018
DIRECTOR ENG. DATE
PRINTED BY: Hemons Jun 06, 2018
PORT ADDRESS: ONE SITCUM PLAZA
TACOMA WA, 98401-1837

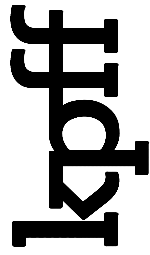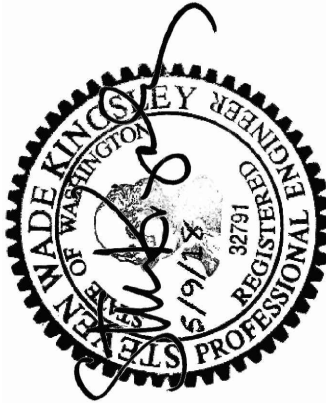

2407 North 31st Street, Suite 100
Tacoma, Washington 98407
(253) 396-0150 Fax (253) 396-0162




MARK:  REVISION:  ADDENDUM #4

BY: CMB


APPR: 

DATE: 6/5

THIS DRAWING IS THE PROPERTY OF THE PORT OF TACOMA AND SHALL NOT BE USED ON OTHER WORK, DISCLOSED, COPIED, IN WHOLE OR IN PART, WITHOUT WRITTEN PERMISSION

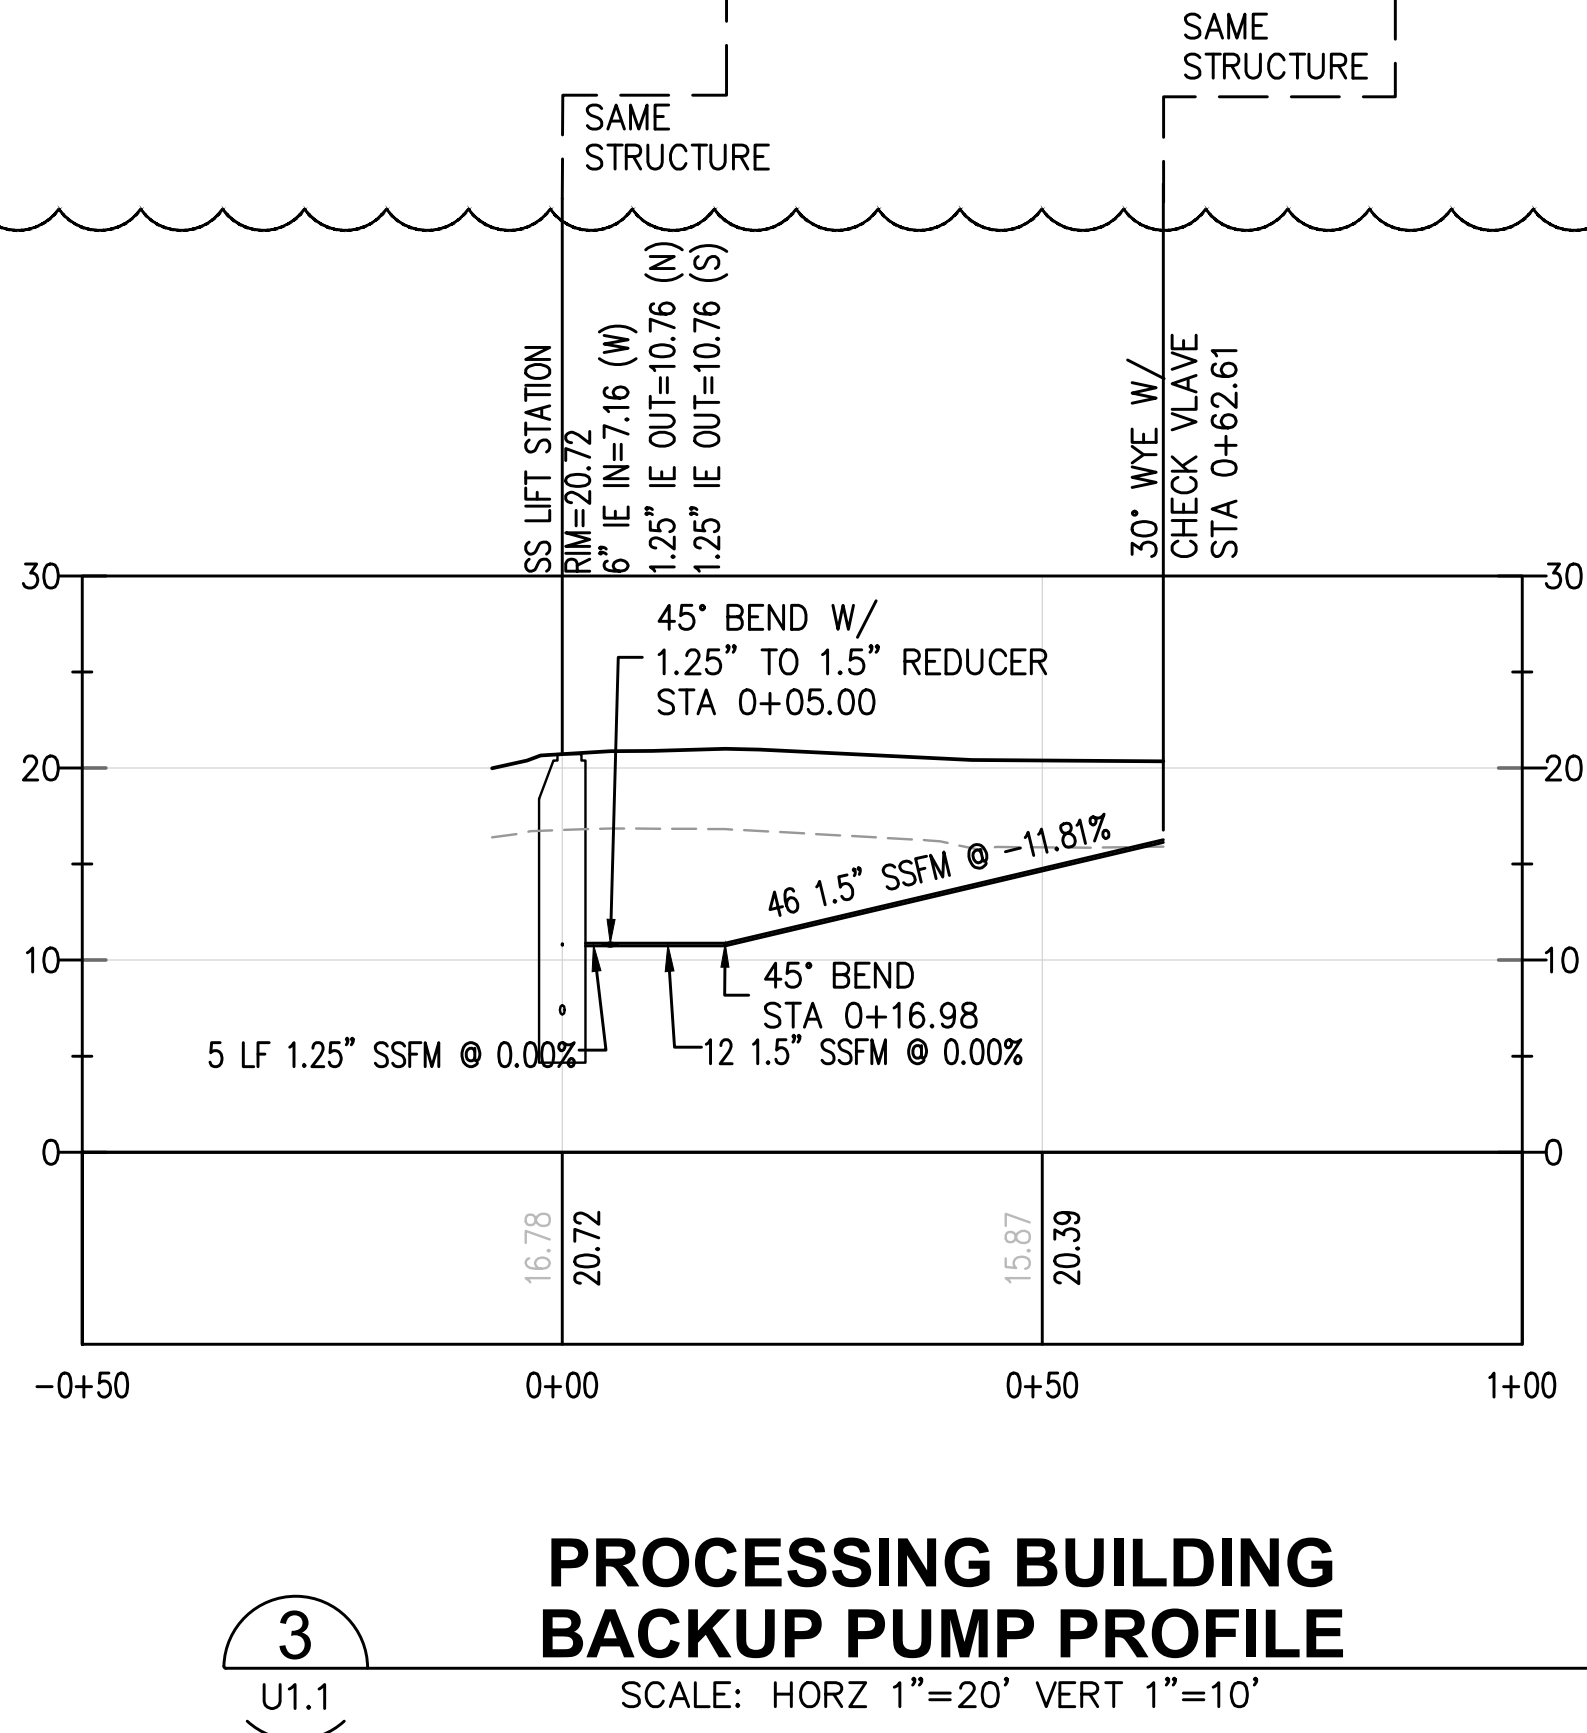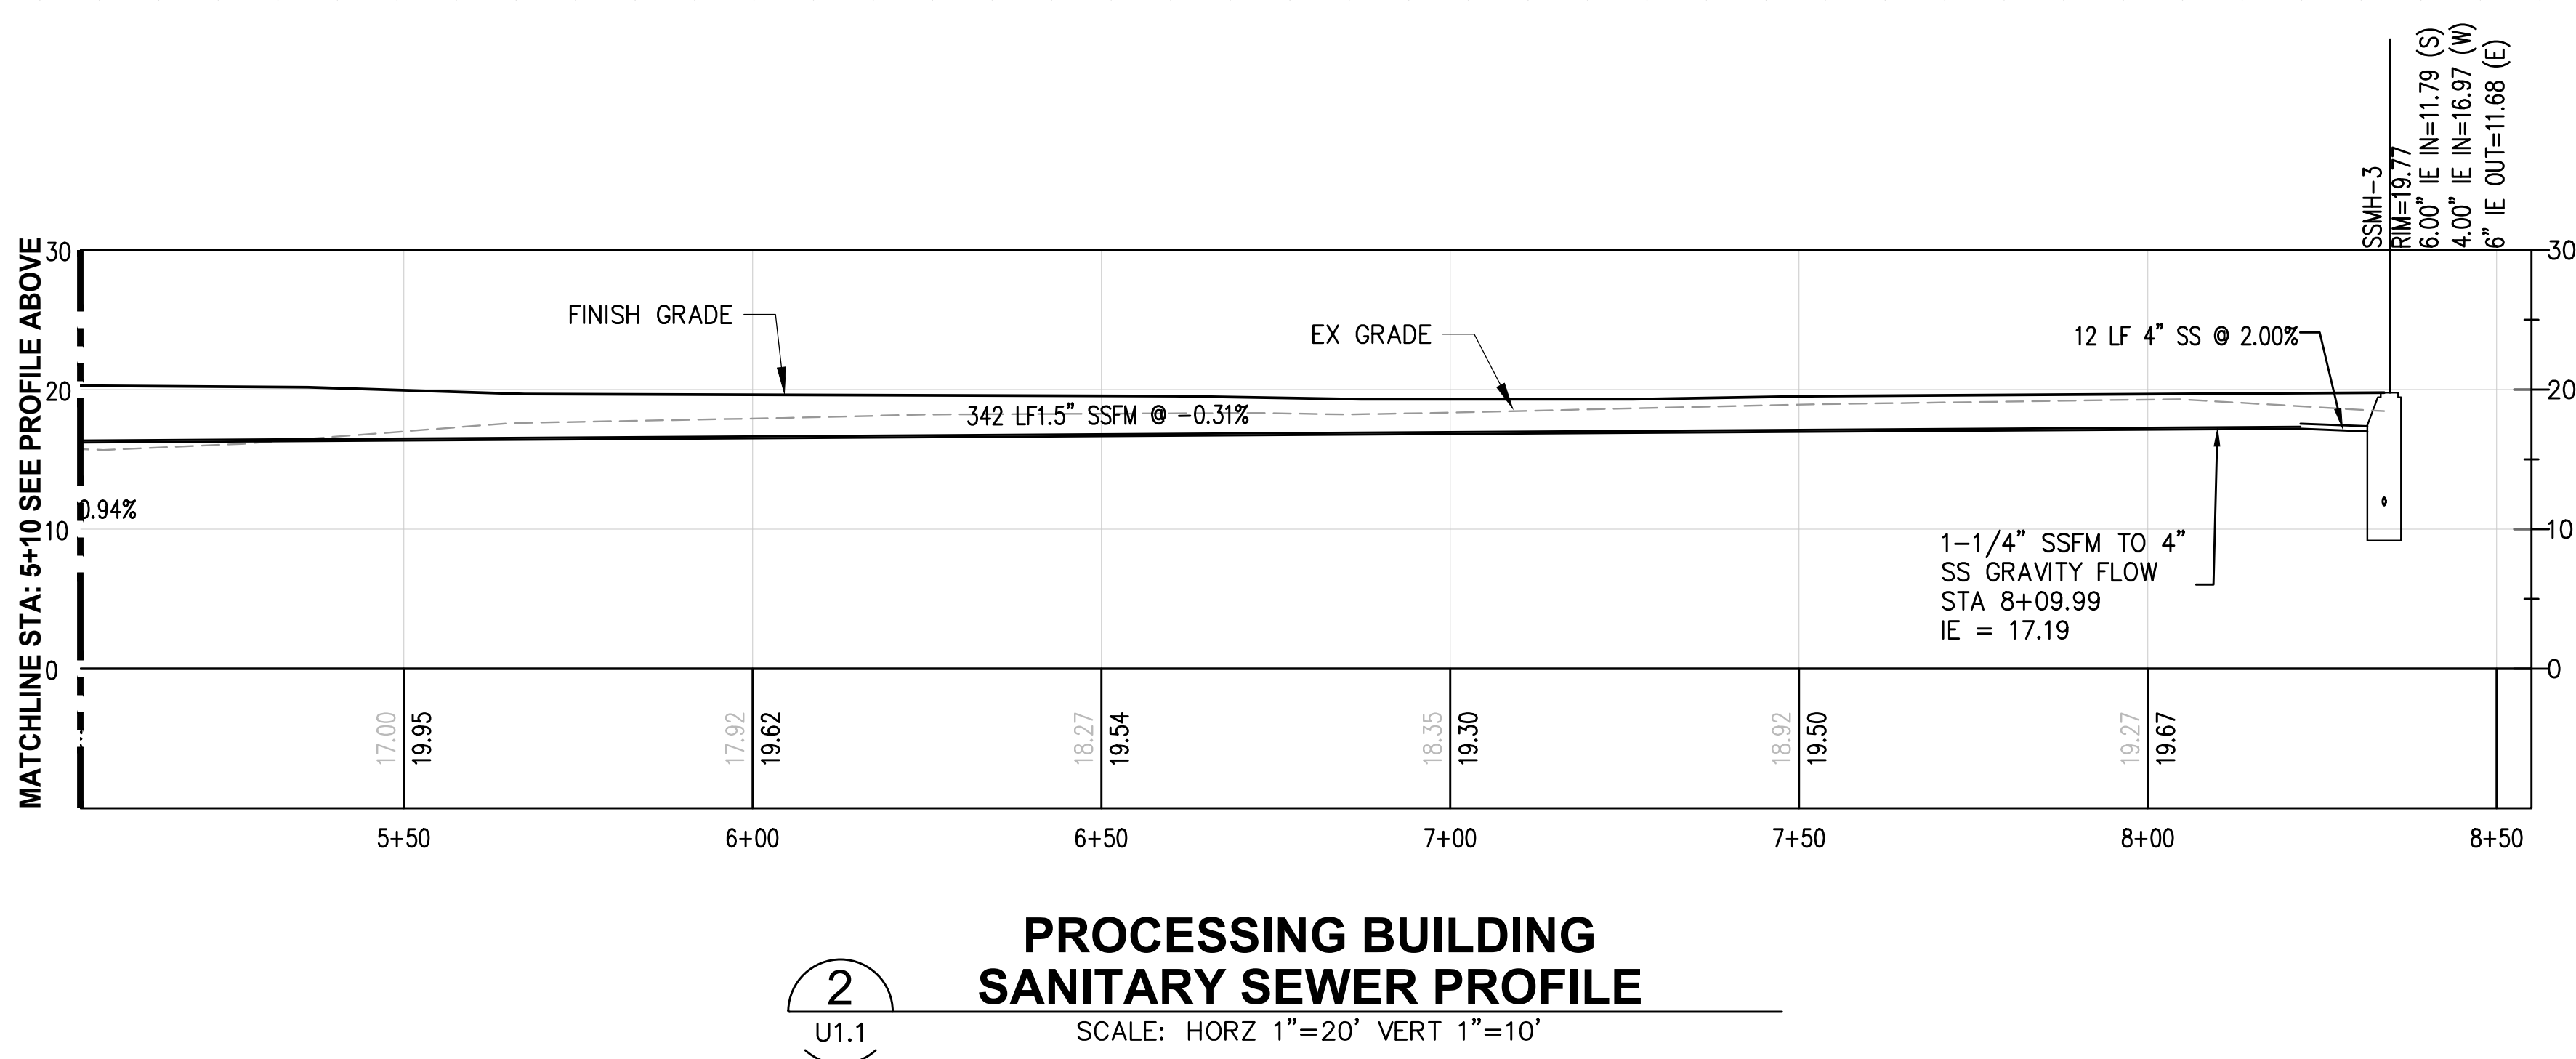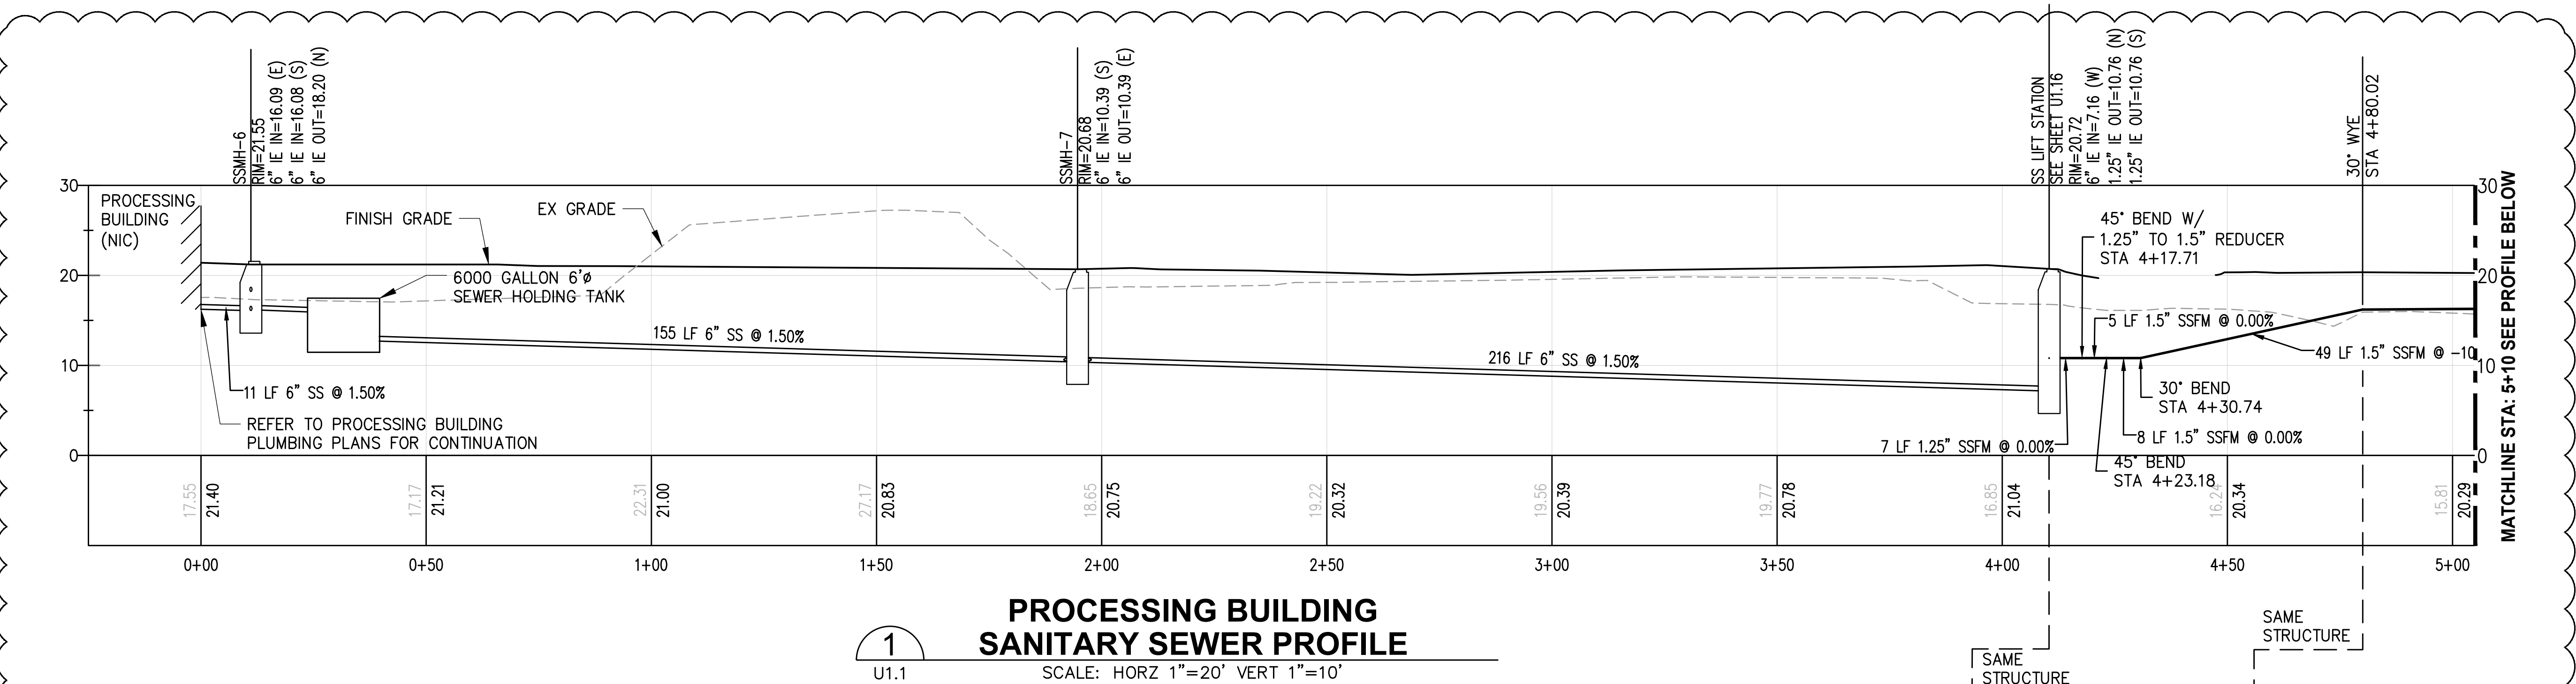

U1.8 102 OF 163										PARCEL 77 AUTO IMPORT TERMINAL										APPROVED:										CMB 5/7/2018																														Part of Tacoma P.O. BOX 1837 TACOMA WA 98401 (253)396-0162																																																																																																																																																																																																																																																																																																																																																																																																																																																																																																																																																																																																																																																																																																																																																																																																																																																																																																																																																																																																																																																																																																																																																																																																																																																																																																																																																																																																																																																																																																																																																																																																																																																																																																																																																																																																																																																																																																																																																																																																																																																																																																																																																																																																																																																																																																																																																																																																																																																																																																																																																																																																																																																																																																																																																																																																																																																																																																																																																																																																																																																																																																																																																																																																																																																																																																																																																																																																																																																																																																																																																																																																																																																																																																																																																																																																																																																																																																																																																																																																																																																																																																																																																																																																																																																																																																																																																																																																																																																																																																																																																																																																																																																																																																																																																																																																																																																																																																																																																																																																									
CONTRACT/CONS: 070770										TOWNSHIP: 21N										RANGE: 3E										SECTION: 36										CHECKED BY										DATE																																																																																																																																																																																																																																																																																																																																																																																																																																																																																																																																																																																																																																																																																																																																																																																																																																																																																																																																																																																																																																																																																																																																																																																																																																																																																																																																																																																																																																																																																																																																																																																																																																																																																																																																																																																																																																																																																																																																																																																																																																																																																																																																																																																																																																																																																																																																																																																																																																																																																																																																																																																																																																																																																																																																																																																																																																																																																																																																																																																																																																																																																																																																																																																																																																																																																																																																																																																																																																																																																																																																																																																																																																																																																																																																																																																																																																																																																																																																																																																																																																																																																																																																																																																																																																																																																																																																																																																																																																																																																																																																																																																																																																																																																																																																																																																																																																																																																																																																																																																																																			
M. ID: 201020.01										DAT-HRZ: W83-SF										VERT: PORT OF TACOMA BM#										PRINTED BY: Items Jun 06, 2018										SWK 5/9/2018																																																																																																																																																																																																																																																																																																																																																																																																																																																																																																																																																																																																																																																																																																																																																																																																																																																																																																																																																																																																																																																																																																																																																																																																																																																																																																																																																																																																																																																																																																																																																																																																																																																																																																																																																																																																																																																																																																																																																																																																																																																																																																																																																																																																																																																																																																																																																																																																																																																																																																																																																																																																																																																																																																																																																																																																																																																																																																																																																																																																																																																																																																																																																																																																																																																																																																																																																																																																																																																																																																																																																																																																																																																																																																																																																																																																																																																																																																																																																																																																																																																																																																																																																																																																																																																																																																																																																																																																																																																																																																																																																																																																																																																																																																																																																																																																																																																																																																																																																																																																																													
PHASE: BID SET										PARCEL: MULTIPLE										DRAWING SCALE: AS SHOWN										PORT ADDRESS: ONE SITCUM PLAZA										DIRECTOR ENG. DATE 5/9/2018																																																																																																																																																																																																																																																																																																																																																																																																																																																																																																																																																																																																																																																																																																																																																																																																																																																																																																																																																																																																																																																																																																																																																																																																																																																																																																																																																																																																																																																																																																																																																																																																																																																																																																																																																																																																																																																																																																																																																																																																																																																																																																																																																																																																																																																																																																																																																																																																																																																																																																																																																																																																																																																																																																																																																																																																																																																																																																																																																																																																																																																																																																																																																																																																																																																																																																																																																																																																																																																																																																																																																																																																																																																																																																																																																																																																																																																																																																																																																																																																																																																																																																																																																																																																																																																																																																																																																																																																																																																																																																																																																																																																																																																																																																																																																																																																																																																																																																																																																																																																																													

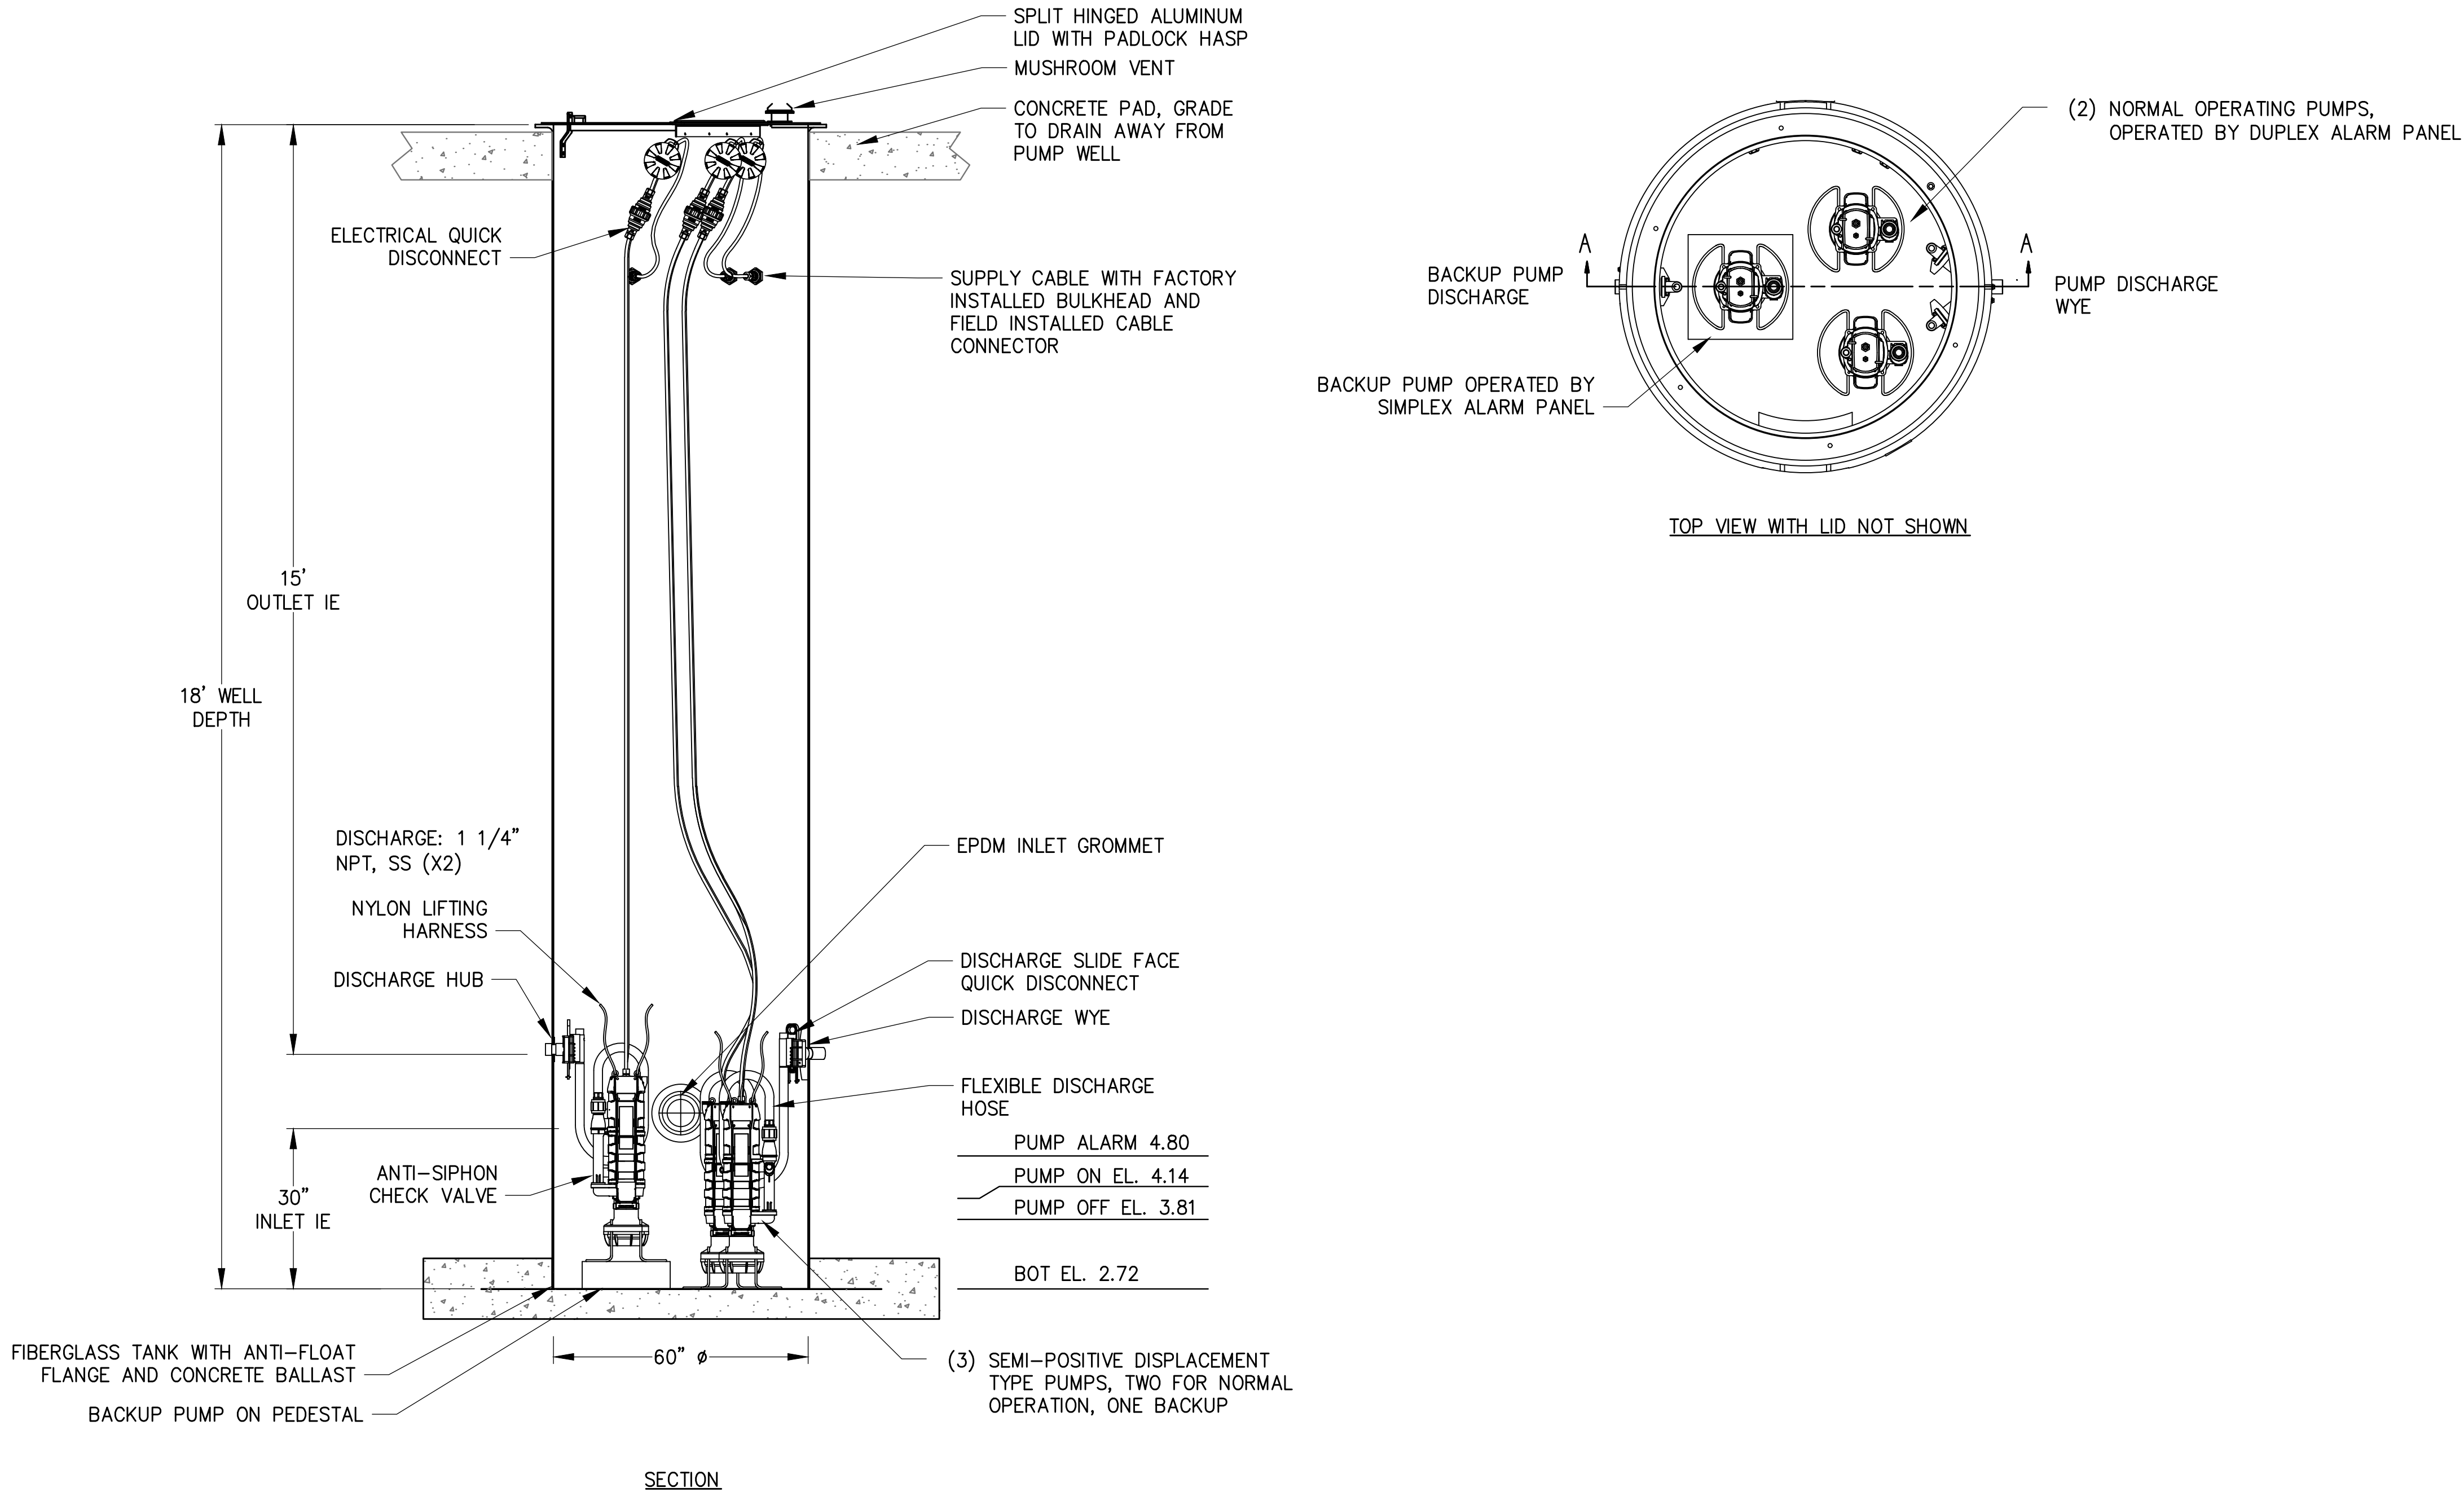

NOTE:
SANITARY SEWER LIFT STATION CONFIGURATION SHOWN IS BASED ON E-ONE W-SERIES, AND IS PROVIDED FOR TO DEPICT GENERAL CONFIGURATION ONLY. ACTUAL CONFIGURATION MAY VARY FOR OTHER LIFT STATION MODELS. REFER TO SPECIFICATIONS FOR REQUIREMENTS.

1

U1.1

SANITARY SEWER LIFT STATION

NTS

U1.16

110 OF 163

CONT/CONS: 070770
M. ID: 201020.01
PHASE: BID SET

PARCEL 77 AUTO IMPORT TERMINAL

UTILITY DETAILS
TOWNSHIP: 21N RANGE: 3E SECTION: 36
DAT-HRZ: W83-SF VERT: PORT OF TACOMA BM#
PARCEL: MULTIPLE DRAWING SCALE: AS SHOWN

APPROVED:

CMB 5/7/2018
CHECKED BY DATE
SWK 5/9/2018
PROJ. ENGR DATE
DIRECTOR ENG. DATE: Hemons Jun 06, 2018
PRINTED BY: TACOMA WA, 98401-1837
PORT ADDRESS: ONE SITCUM PLAZA
TACOMA WA, 98401-1837

MADE IN WASHINGTON
K. P. F. F.
REGISTERED PROFESSIONAL ENGINEER
NO. 32791
EXPIRATION DATE 6/30/2025

kpff

2407 North 31st Street, Suite 100
Tacoma, Washington 98407
(253) 396-0150 Fax (253) 396-0162
P.O. BOX 1837 TACOMA WA 98401 (253)396-3441

Port of Tacoma

MARK:


REVISION:

BY: CMB


ADDENDUM #4

APPR:

DATE: 6/5

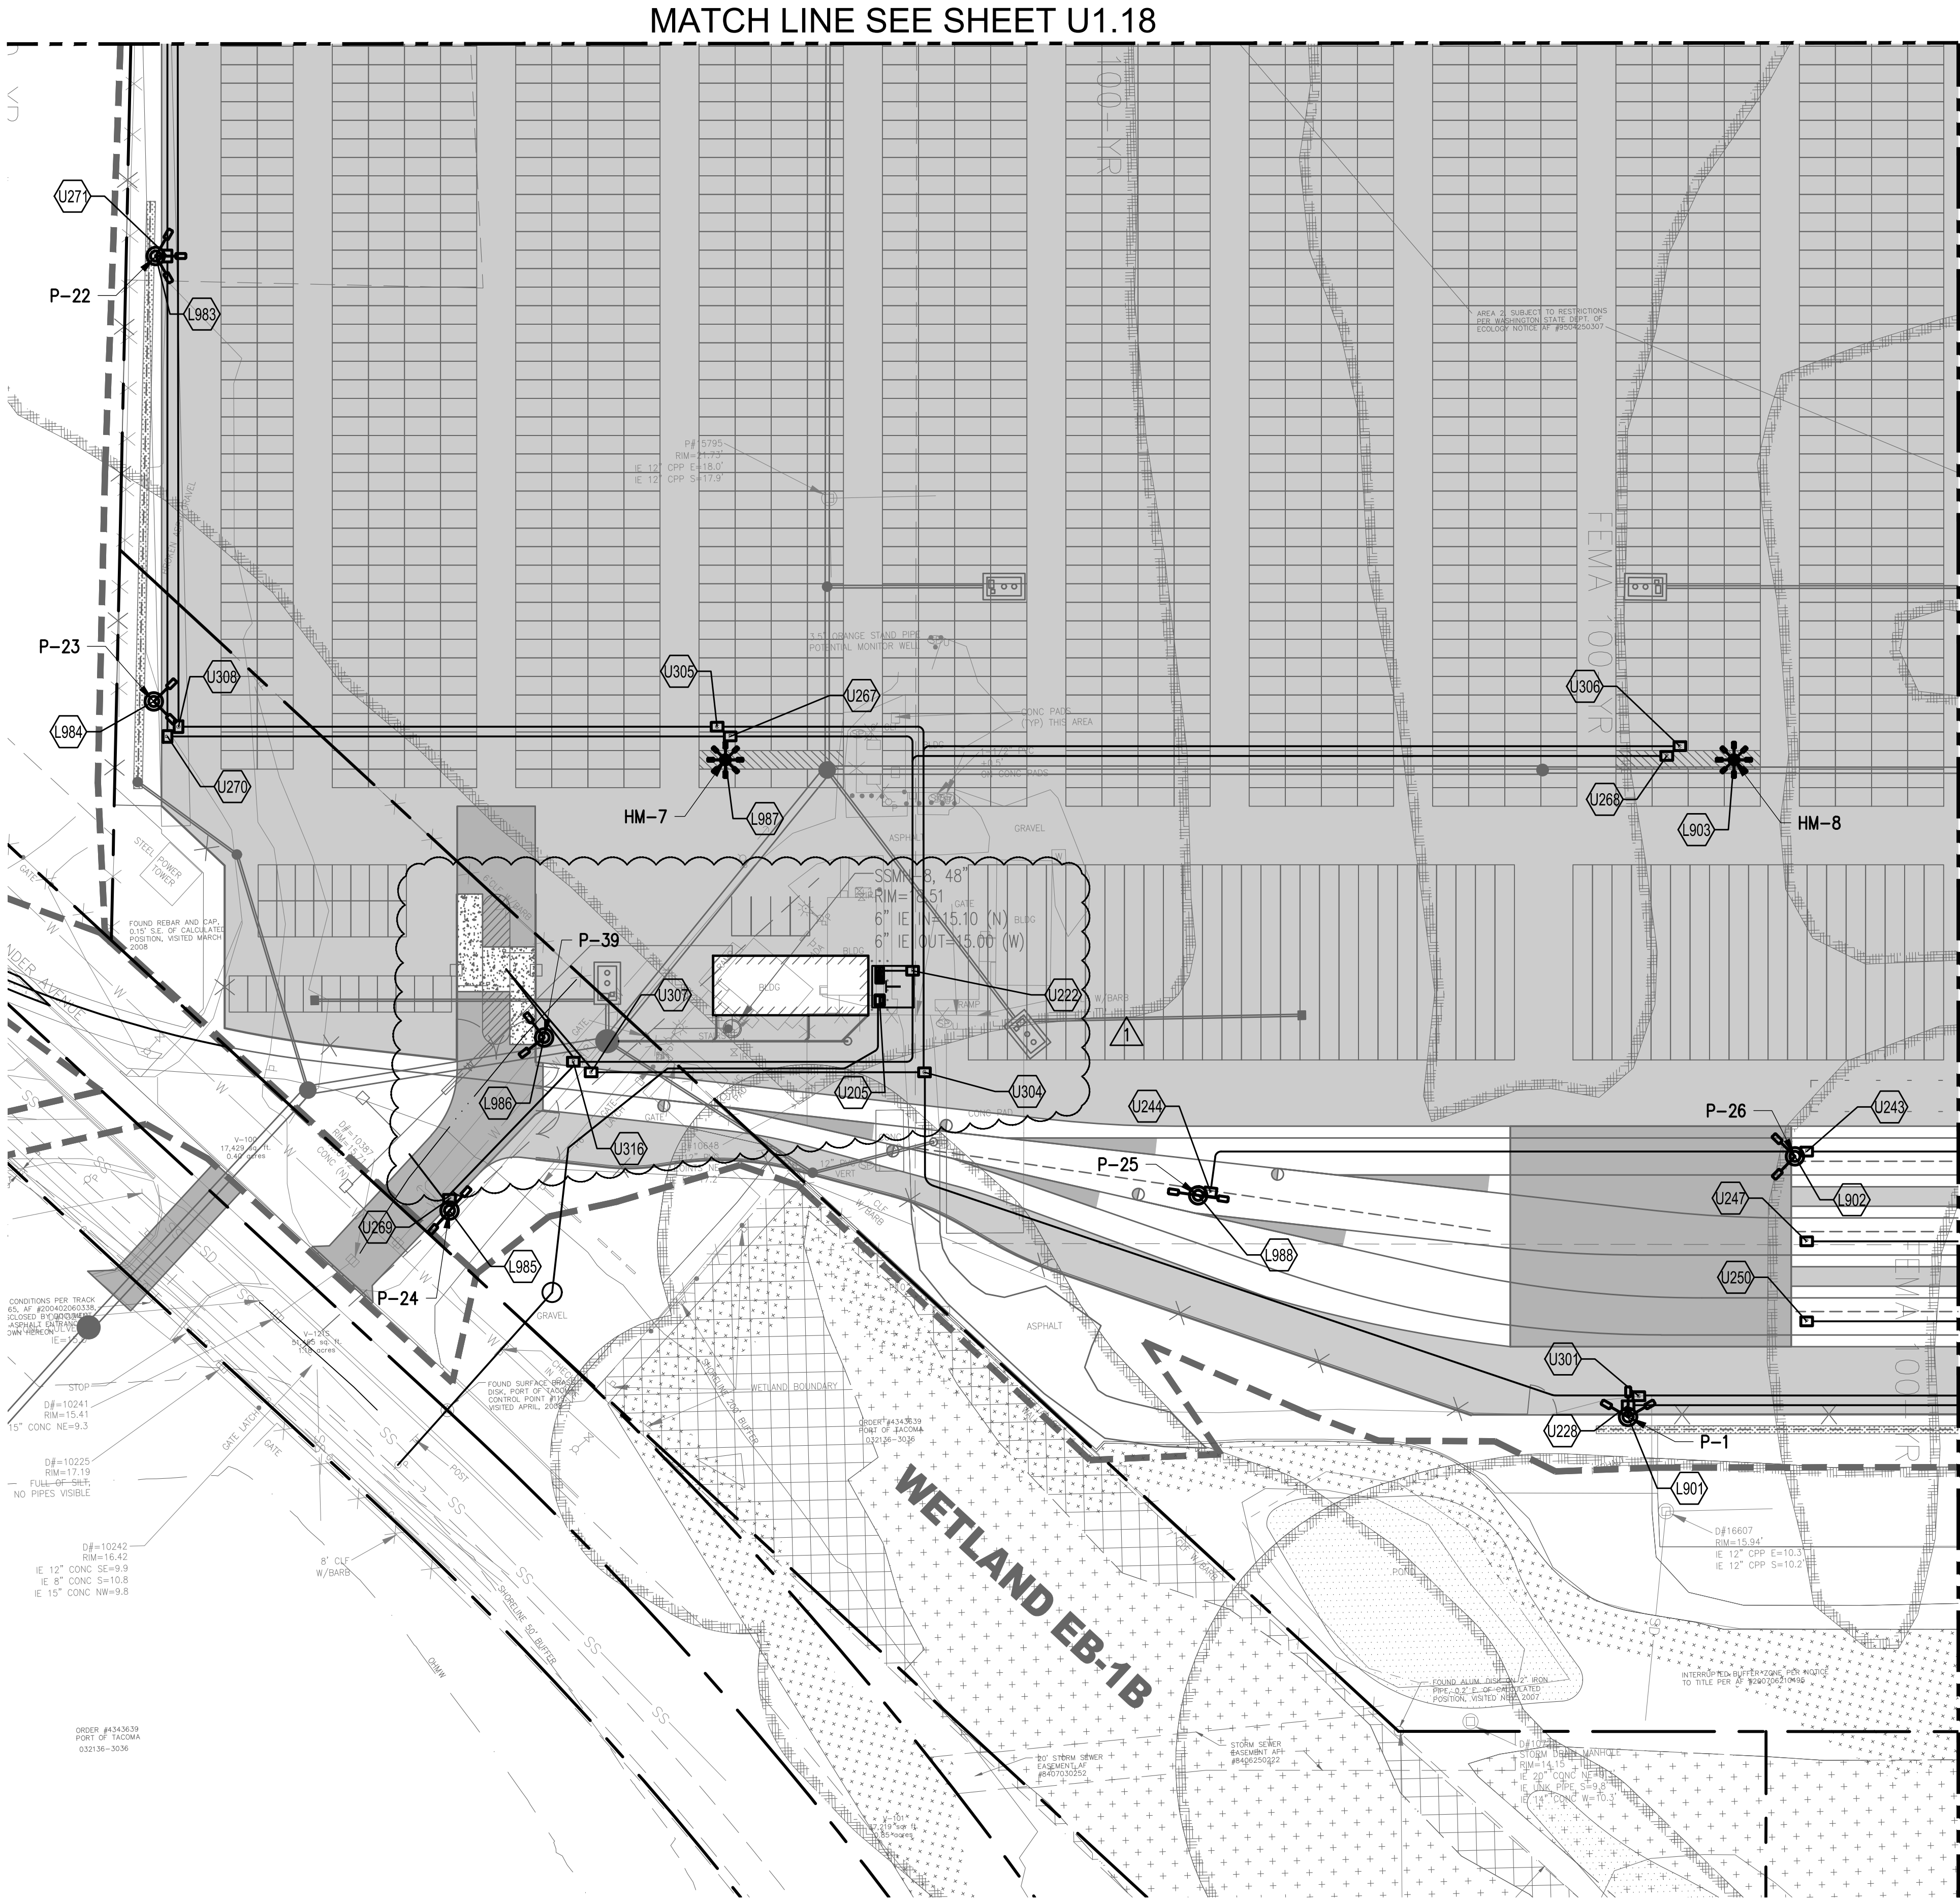

MATCH LINE SEE SHEET U1.21

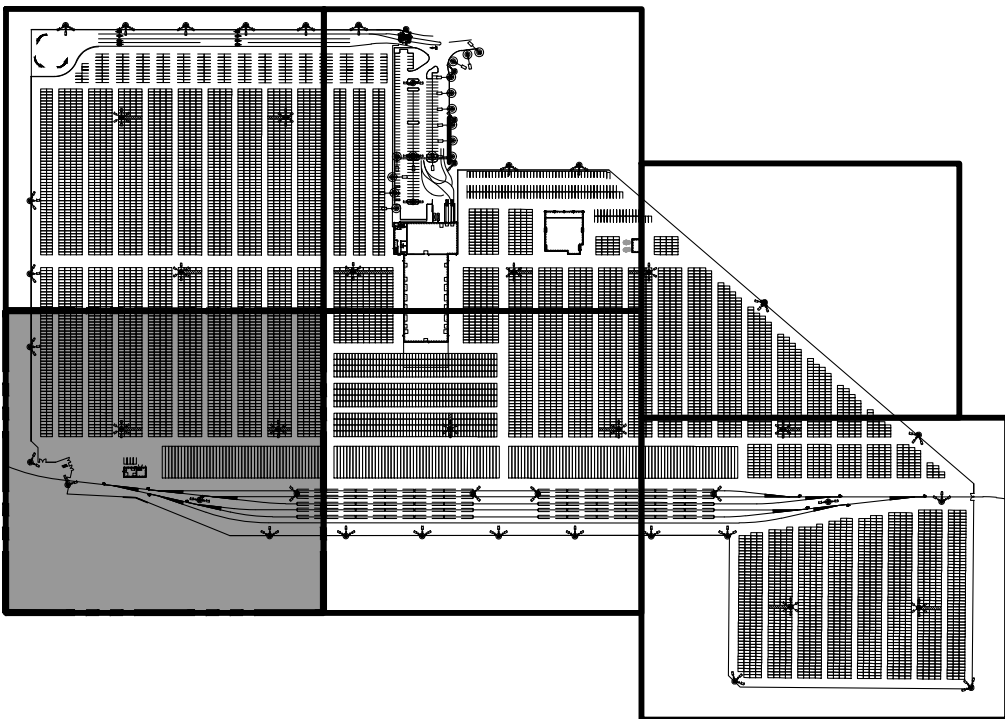

NOTES

1. REFER TO ELECTRICAL PLANS FOR POWER AND COMMUNICATION UTILITY SYSTEM.
2. SHEETS U1.18-U1.23 PROVIDED FOR POWER VAULTS, COMMUNICATION VAULTS, AND LIGHTPOLES LOCATIONS. SEE SHEET U1.24 FOR ELECTRICAL AND COMMUNICATION SCHEDULE.
3. ALL LOCATIONS REPRESENT CENTER OF STRUCTURE OR POLE.
4. SEE ELECTRICAL PLANS FOR POWER AND COMMUNICATION UTILITY SYSTEMS.

U1.20 114 OF 163			PARCEL 77 AUTO IMPORT TERMINAL				APPROVED:				CMB		5/7/2018				2407 North 31st Street, Suite 100 Tacoma, Washington 98407 (253) 396-0150 Fax (253) 396-0162	P.O. BOX 1837 TACOMA, WA 98401 (253)396-3841		
UTILITY LOCATION PLAN AREA 3							CHECKED BY DATE		SWK		5/9/2018									
							DIRECTOR ENG. DATE		PROJ. ENGR		DATE									
							PRINTED BY: chennett		Jun 06, 2018											
							PORT ADDRESS: ONE SITCUM PLAZA													
CONT/CONS: 070770			TOWNSHIP: 21N		RANGE: 3E		SECTION: 36								MARK:		REVISION:	BY:	CMB	DATE:
M. ID: 201020.01			DAT-HRZ: W83-SF		VERT: PORT OF TACOMA BM#										/A		ADDENDUM #4			6/5
PHASE: BID SET			PARCEL: MULTIPLE		DRAWING SCALE: AS SHOWN						TACOMA WA, 98401-1837									

ELECTRICAL AND COMMUNICATION HORIZONTAL CONTROL POINTS			
POINT	NAME	NORTHING	EASTING
U274	DH-101	709206.22	1175763.08
U275	DH-102	709001.83	1175758.20
U276	DH-103	708907.33	1175755.95
U277	DH-104	708904.81	1175861.33
U278	DH-105	709279.83	1175682.68
U279	DH-106	709292.04	1175173.58
U280	DH-107	709304.24	1174664.48
U281	DH-108	709009.22	1175450.05
U282	DH-109	709021.57	1174934.86
U283	DH-110	708818.70	1176460.35
U284	DH-111	708594.10	1176415.40
U285	DH-112	708527.61	1176157.89
U286	DH-113	708517.51	1176579.84
U287	DH-114	708397.74	1176933.20
U288	DH-115	707969.07	1177408.42
U289	DH-116	707819.09	1177574.68
U290	DH-117	708540.64	1175639.61
U291	DH-118	708553.03	1175110.21
U292	DH-119	708563.87	1174647.26
U293	DH-120	708024.78	1176479.21
U294	DH-121	708037.54	1175946.65
U295	DH-122	707993.21	1176992.39
U296	DH-123	707680.29	1176822.43
U297	DH-124	707703.99	1177060.35
U298	DH-125	707454.23	1176999.57
U299	DH-126	707441.16	1177412.91
U300	DH-127	707692.01	1176339.37
U301	DH-128	707715.03	1175376.25
U302	DH-129	707238.79	1176857.66
U303	DH-130	707187.48	1177558.11
U304	DH-131	707889.74	1175014.11
U305	DH-132	708069.34	1174912.12
U306	DH-133	708047.52	1175405.24
U307	DH-134	707893.82	1174843.30
U308	DH-135	708075.96	1174636.12
U309	DH-136	708941.71	1174656.10
U310	DH-137	708309.31	1176436.61
U311	DH-138	708630.24	1176675.45
U312	DH-139	707206.01	1177194.14

ELECTRICAL AND COMMUNICATION HORIZONTAL CONTROL POINTS			
POINT	NAME	NORTHING	EASTING
U313	DH-140	707703.65	1175859.31
U223	H-101	707681.74	1176570.29
U224	H-102	707687.49	1176330.36
U225	H-103	707693.24	1176090.43
U226	H-104	707699.00	1175850.50
U227	H-105	707704.75	1175610.57
U228	H-106	707710.50	1175370.64
U229	H-107	707988.33	1176987.38
U230	H-108	708019.97	1176470.99
U231	H-109	708032.43	1175951.43
U232	H-110	707449.10	1177003.51
U233	H-111	707436.34	1177407.31
U234	H-112	707240.74	1176848.48
U235	H-113	707181.44	1177562.98
U236	H-114	707776.85	1177129.90
U237	H-115	707769.18	1177486.77
U238	H-116	708398.24	1176940.11
U239	H-117	708824.82	1176454.49
U240	H-118	708832.10	1176150.79
U241	H-119	707820.09	1176223.60
U242	H-120	707825.30	1176006.37
U243	H-121	707838.27	1175465.25
U244	H-122	707824.83	1175159.27
U245	H-123	707774.10	1176222.49
U246	H-124	707779.31	1176005.26
U247	H-125	707792.28	1175464.15
U248	H-126	707733.11	1176221.51
U249	H-127	707738.32	1176004.28
U250	H-128	707751.29	1175463.17
U251	H-201	708522.51	1176162.36
U252	H-202	708512.60	1176575.84
U253	H-203	708756.27	1175852.76
U254	H-204	708536.08	1175620.03
U255	H-205	708547.60	1175115.89
U256	H-206	709014.08	1175456.17
U257	H-207	709026.47	1174939.32
U258	H-208	709256.88	1175845.76
U259	H-209	709289.20	1175521.55
U260	H-210	709293.73	1175332.73

ELECTRICAL AND COMMUNICATION HORIZONTAL CONTROL POINTS			
POINT	NAME	NORTHING	EASTING
U261	H-211	709298.25	1175143.90
U262	H-212	709302.78	1174955.08
U263	H-213	709309.55	1174672.58
U264	H-214	709037.26	1175978.20
U265	H-215	709151.36	1175979.13
U266	H-216	709114.40	1175861.35
U314	H-217	709278.47	1175835.61
U267	H-301	708064.19	1174918.71
U268	H-302	708042.68	1175398.41
U269	H-303	707830.71	1174769.21
U270	H-304	708071.10	1174630.33
U271	H-305	708317.22	1174636.23
U272	H-306	708547.16	1174641.74
U273	H-307	708777.09	1174647.26
U316	H-308	707899.43	1174834.30
U201	M-001	708480.49	1176833.99
U202	M-002	708796.35	1176477.09
U203	M-003	708833.31	1175984.32
U204	M-004	707698.71	1177084.18
U205	M-005	707927.18	1174992.07
U315	M-006	708106.80	1176969.07
U206	M-101	707699.01	1177071.35
U207	M-102	707675.87	1176815.22
U208	M-103	707720.15	1176762.20
U209	M-104	707761.14	1176763.19
U210	M-105	707807.13	1176764.29
U211	M-106	707814.24	1177587.52
U212	M-107	707969.57	1177415.33
U213	M-108	708268.87	1177070.08
U214	M-201	708799.36	1175965.34
U215	M-202	708599.20	1176410.53
U216	M-203	708895.39	1175974.80
U217	M-204	708898.31	1175856.17
U218	M-205	708900.76	1175750.79
U219	M-206	709006.95	1175753.33
U220	M-207	709210.03	1175758.20
U221	M-208	709285.22	1175687.75
U222	M-301	707941.90	1175009.29

LIGHTING HORIZONTAL CONTROL POINTS			
POINT	NAME	NORTHING	EASTING
L901	P-1	707704.50	1175370.49
L902	P-26	707835.91	1175459.19
L903	HM-8	708039.86	1175432.81
L904	P-2	707698.75	1175610.43
L905	P-3	707693.00	1175850.36
L906	HM-9	708027.55	1175946.17
L907	P-27	707822.65	1176012.30
L908	P-4	707687.25	1176090.29
L909	P-28	707817.35	1176217.53
L910	P-5	707681.49	1176330.22
L911	HM-10	708014.85	1176475.76
L912	P-6	707675.74	1176570.15
L913	P-29	707804.48	1176770.23
L914	P-7	707669.99	1176810.08
L915	P-8	707230.27	1176840.47
L916	HM-12	707443.10	1177003.37
L917	HM-13	707430.34	1177407.17
L918	P-9	707175.37	1177565.84
L919	P-30	707770.85	1177129.76
L920	P-31	707763.18	1177486.63
L921	P-10	707974.02	1177419.35
L922	HM-11	708002.46	1176992.61
L923	P-11	708402.70	1176944.12
L924	HM-6	708506.53	1176578.33
L925	P-12	708831.75	1176467.73
L926	HM-5	708516.62	1176157.70
L927	P-13	708842.35	1176151.03
L928	HM-4	708529.51	1175619.87
L929		708706.57	1175789.87
L930		708726.52	1175793.22

LIGHTING HORIZONTAL CONTROL POINTS			
POINT	NAME	NORTHING	EASTING
L931	P-38	708745.41	1175846.50
L932		708746.44	1175781.52
L933		708766.44	1175782.00
L934		708786.43	1175782.49
L935		708806.43	1175782.97
L936		708826.42	1175783.45
L937		708846.42	1175783.93
L938		708866.41	1175784.41
L939		708886.41	1175784.90
L940		708888.87	1175804.74
L941		708889.90	1175834.53
L942	P-37	708889.49	1175849.96
L943		708889.09	1175865.38
L944		708888.68	1175894.83
L945		708888.64	1175910.06
L946		708888.67	1175925.56
L947	P-32	708863.39	1175979.22
L948		708877.65	1175968.54
L949		708897.70	1175969.02
L950		708917.70	1175969.50
L951		708937.69	1175969.98
L952		708957.68	1175970.46
L953		708977.68	1175970.94
L954		708997.67	1175971.42
L955	P-33	709000.35	1175982.51
L956		709017.67	1175971.90
L957		709037.66	1175972.37
L958		709057.66	1175972.85
L959		709077.65	1175973.33
L960		709097.64	1175973.81

LIGHTING HORIZONTAL CONTROL POINTS			
POINT	NAME	NORTHING	EASTING
L961	P-36	709127.68	1175855.67
L962		709117.64	1175974.29
L963		709137.63	1175974.77
L964	P-34	709152.31	1175986.15
L965		709157.52	1175976.91
L966		709174.84	1175986.91
L967		709186.06	1176003.46
L968		709192.43	1176022.42
L969		709199.58	1176041.10
L970		709209.32	1176058.57
L971	P-35	709285.41	1175837.16
L972	P-14	709295.46	1175688.13
L973	P-15	709299.44	1175521.93
L974	HM-2	709020.07	1175456.31
L975	P-16	709303.97	1175333.11
L976	P-17	709308.50	1175144.28
L977	P-18	709313.02	1174955.46
L978	HM-1	709032.47	1174939.46
L979	P-19	709320.25	1174654.28
L980	P-20	708777.23	1174641.26
L981	P-21	708547.30	1174635.75
L982	HM-3	708541.60	1175115.75
L983	P-22	708317.37	1174630.23
L984	P-23	708089.14	1174623.76
L985	P-24	707824.71	1174769.07
L986	P-39	707912.20	1174819.68
L987	HM-7	708052.25	1174915.96
L988	P-25	707823.31	1175152.95

U1.24

118 OF 163

CONT/CONS: 070770

M. ID: 201020.01

PHASE: BID SET

PARCEL 77 AUTO IMPORT TERMINAL

ELECTRICAL AND COMMUNICATION UTILITY

LOCATION SCHEDULE

TOWNSHIP: 21N

DAT-HRZ: W83-SF

PARCEL: MULTIPLE

APPROVED:

CMB

CHECKED BY: DATE

SWK

5/9/2018

DIRECTOR

ENG. DATE

HEMONS JUN 06, 2018

PRINTED BY:

PORT ADDRESS: ONE SITCUM PLAZA

TACOMA, WA, 98401-1837

2407 North 31st Street, Suite 100
Tacoma, Washington 98407
(253) 396-0150 Fax (253) 396-0162

kpff

MADE KNOXLEY

REGISTERED PROFESSIONAL

32781

5/9/18

Port of Tacoma

P.O. BOX 1837 TACOMA, WA 98401 (253)396-0441

MARK: REVISION: ADDENDUM #4

BY: CMB

DATE: 6/5

APPR:

THIS DRAWING IS THE PROPERTY OF THE PORT OF TACOMA AND SHALL NOT BE USED ON OTHER WORK, DISCLOSED, COPIED, IN WHOLE OR IN PART, WITHOUT WRITTEN PERMISSION