

PORT OF TACOMA

PORT COMMISSIONERS:

CONSTANCE T. BACON

R. TED BOTTIGER

JACK A. FABULICH

RICHARD P. MARZANO

CLARE PETRICH

PIERCE COUNTY TERMINAL BUILDING CONSTRUCTION

CONTRACT # 998154


PORT STAFF:

ANDREA RINIKER

Executive Director

MICHAEL R. ADAMS

Chief Engineer

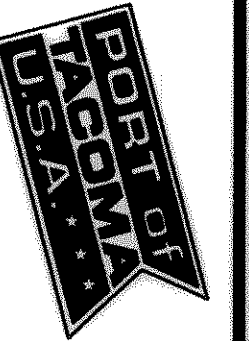

PORT OF TACOMA P.O. BOX 1837
TACOMA, WA 98401 253-383-5841
6021 12th Street East
Suite 201
Tacoma, WA 98424
Tel: 253.922.9037
Fax: 253.922.6499




RECORD DRAWING


APPROVED	LC	8/22/03
CHECKED BY	LC	8/22/03
CHIEF ENGINEER - DATE	PROJECT ENGR. - DATE	

DRAWING DATE: 12/29/04	TOWNSHIP: RANGE: SECTION:
PORT ADDRESS:	DATUM: HORIZ. VERT.
PORT PARCEL:	DRAWING SCALE: N.T.S.

PORT OF TACOMA PIERCE COUNTY TERMINAL TITLE SHEET AND OVERALL SITE PLAN	EP-6554-17 SHEET 1 OF 280 A1.G00
---	--

6321-17

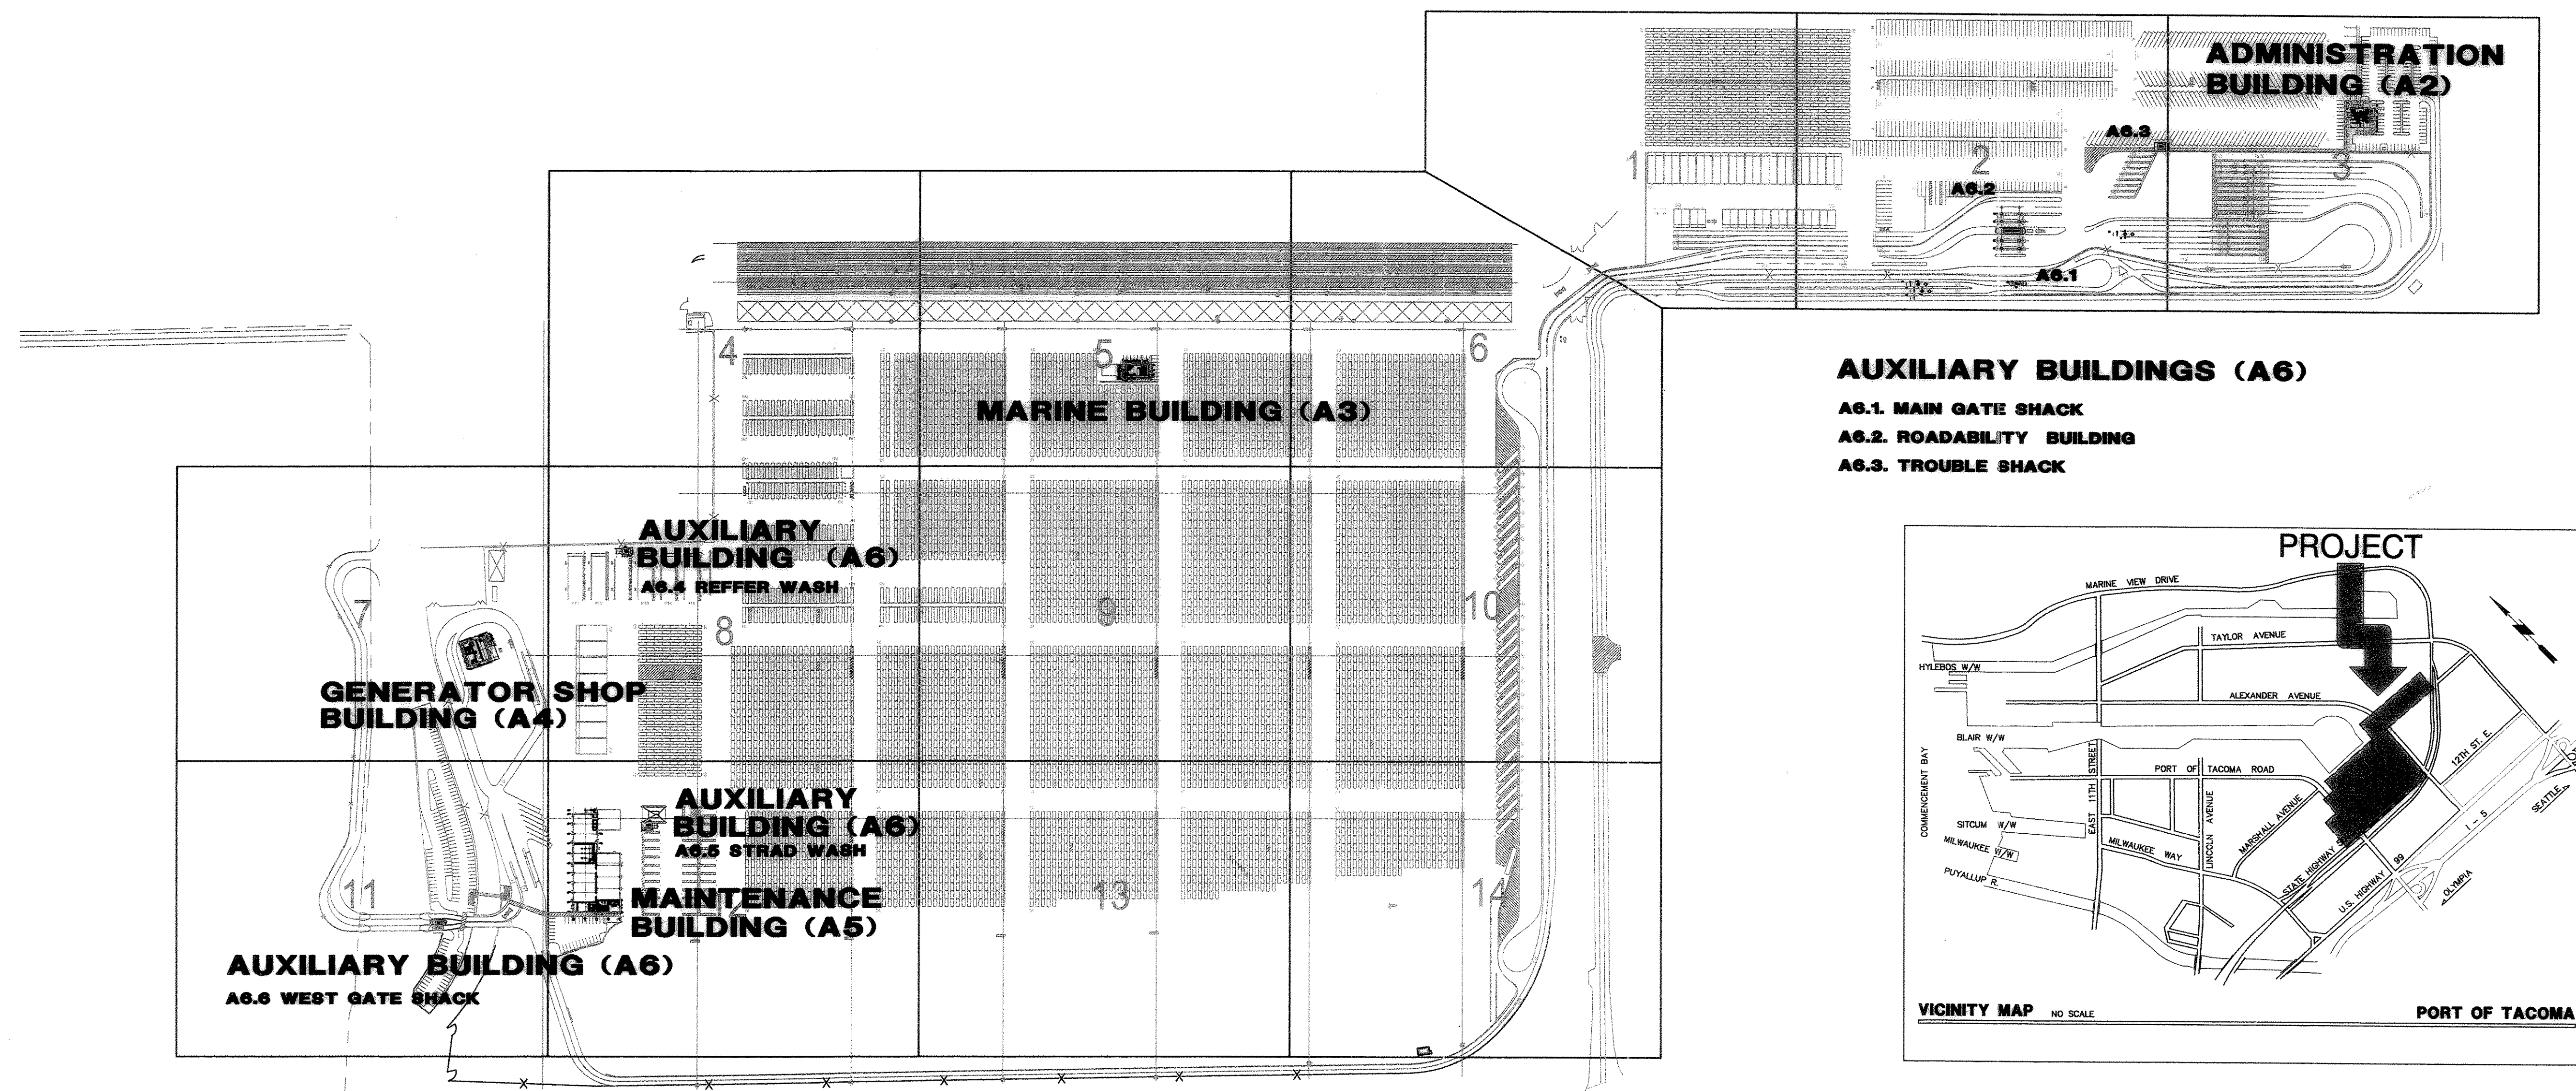

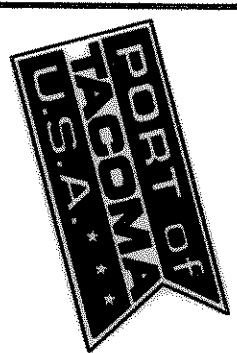

PORT OF TACOMA P.O. BOX 1837
TACOMA, WA 98401 253-383-5841
6021 12th street east
suite 201
tacoma, wa. 98424
tel: 253 . 922 . 9037
fax: 253 . 922 . 6499



RECORD DRAWING

APPROVED

LC 8/22/03

CHECKED BY - DATE

LC 8/22/03

PROJECT ENGR. - DATE

PORT OF TACOMA

PIERCE COUNTY TERMINAL

PROJECT DRAWING INDEX

EP 6664-47

A1.G01

SHEET 2 OF 230

6321-17

A6 AUXILIARY BUILDINGS

(A6, S6, M6 AND E6 DRAWING SERIES)

BUILDING DESIGNATIONS

A6.1	MAIN GUARD SHACK
A6.2	MAIN GUARD CANOPY (SEE CIVIL DRAWINGS)
A6.3	ROADABILITY CANOPY AND BUILDING
A6.4	TROUBLE SHACK
A6.5	REEFER STEAM WASH
A6.6	STRAD STEAM WASH
A6.6	WEST GUARD SHACK

A6.G01 COVER SHEET

ARCHITECTURAL DRAWINGS

A6.100	SITE AND FLOOR PLANS
A6.101	SITE AND FLOOR PLANS
A6.120	REFLECTED CEILING PLANS
A6.200	FINISH SCHEDULES
A6.300	ELEVATIONS
A6.400	BUILDING SECTIONS

STRUCTURAL DRAWINGS

S6.001	GENERAL NOTES
S6.002	GENERAL NOTES
S6.101	FOUNDATION AND FRAMING PLANS
S6.102	FOUNDATION AND FRAMING PLANS
S6.301	FOUNDATION DETAILS AND SCHEDULES
S6.302	STRUCTURAL DETAILS AND SCHEDULES

MECHANICAL DRAWINGS

M6.100	MECHANICAL SCHEDULES
M6.210	PLUMBING FONDATION PLANS
M6.220	PLUMBING FLOOR PLANS
M6.221	ENLARGED WASH BLDG PLUMBING PLANS
M6.310	MECHANICAL HVAC PLANS
M6.400	MECHANICAL DIAGRAMS
M6.401	MECHANICAL DIAGRAMS

ELECTRICAL DRAWINGS

E6.100	BUILDING LIGHTING PLAN
E6.200	BUILDING POWER PLAN
E6.300	BUILDING SYSTEMS PLAN
E6.400	PANEL SCHEDULES

A7 STANDARDS AND DETAILS

(A7 DRAWING SERIES)

ARCHITECTURAL DRAWINGS

A7.600	SITE DETAILS
A7.601	EXTERIOR WALL DETAILS
A7.602	EXTERIOR WALL DETAILS
A7.603	WINDOW AND STOREFRONT DETAILS
A7.604	WINDOW AND STOREFRONT DETAILS
A7.605	OVERHEAD AND HOLLOW METAL DOORS
A7.606	CANOPY, GUARDRAILING AND DECK DETAILS
A7.607	MISCELLANEOUS EXTERIOR DETAILS
A7.608	ENLARGED PLANS - STAIRS
A7.609	ENLARGED PLANS - STAIRS
A7.610	ENLARGED PLANS - STAIRS
A7.611	INTERIOR ELEVATIONS
A7.612	CASEWORK ELEVATIONS
A7.613	CASEWORK ELEVATIONS & INTERIOR DETAILS

A4 GENERATOR SHOP BUILDING

(A4, S4, M4 AND E4 DRAWING SERIES)

A4.G01 COVER SHEET

ARCHITECTURAL DRAWINGS

A4.G02	SITE PLAN
A4.100	FLOOR PLAN
A4.110	ROOF PLAN
A4.120	REFLECTED CEILING PLANS
A4.200	FINISH SCHEDULES
A4.300	ELEVATIONS
A4.400	BUILDING SECTIONS
A4.500	WALL SECTIONS
A4.501	WALL SECTIONS

STRUCTURAL DRAWINGS

S4.001	GENERAL NOTES
S4.002	GENERAL NOTES
S4.101	FOUNDATION AND FRAMING PLANS
S4.201	BRACED FRAME ELEVATIONS
S4.301	FOUNDATION DETAILS AND SCHEDULES
S4.302	FOUNDATION DETAILS AND SCHEDULES
S4.311	FRAMING DETAILS AND SCHEDULES
S4.312	FRAMING DETAILS AND SCHEDULES
S4.321	ROOF FRAMING DETAILS

MECHANICAL DRAWINGS

M4.100	MECHANICAL SCHEDULES
M4.210	FOUNDATION & PLUMBING FLOOR PLAN
M4.210	REFLECTED AND FURRED CEILING PLANS
M4.400	MECHANICAL DETAILS

ELECTRICAL DRAWINGS

E4.100	BUILDING LIGHTING PLAN
E4.200	BUILDING POWER PLAN
E4.300	BUILDING SYSTEMS PLAN
E4.400	BUILDING PANEL SCHEDULES

A5 MAINTENANCE BUILDING

(A5, S5, M5 AND E5 DRAWING SERIES)

A5.G01 COVER SHEET

ARCHITECTURAL DRAWINGS

A5.G02	SITE PLAN
A5.100	OVERALL FLOOR PLANS
A5.101	1ST FLOOR SOUTH HALF PLAN
A5.102	1ST FLOOR NORTH HALF PLAN
A5.103	MEZZANINE AND TOWER FLOOR PLANS
A5.110	ROOF PLAN
A5.120	1ST FLOOR NORTH HALF REFLECTED
A5.121	REFLECTED CEILING PLAN
A5.121	1ST FLOOR SOUTH HALF REFLECTED
A5.122	REFLECTED CEILING PLAN
A5.122	MEZZANINE AND TOWER REFLECTED
A5.200	CEILING PLANS
A5.300	FINISH SCHEDULES
A5.301	ELEVATIONS
A5.302	ELEVATIONS
A5.303	ELEVATIONS
A5.400	BUILDING SECTIONS
A5.401	BUILDING SECTIONS
A5.402	BUILDING SECTIONS
A5.403	BUILDING SECTIONS
A5.404	BUILDING SECTIONS
A5.500	WALL SECTIONS
A5.501	WALL SECTIONS
A5.502	WALL SECTIONS

MECHANICAL DRAWINGS

M5.100	MECHANICAL SCHEDULES
M5.101	MECHANICAL SCHEDULES
M5.210	PARTIAL FOUNDATION PLAN
M5.211	PARTIAL FOUNDATION PLAN
M5.220	PARTIAL PLUMBING FLOOR PLANS
M5.221	PARTIAL PLUMBING FLOOR PLANS
M5.222	PARTIAL PLUMBING FLOOR PLANS
M5.310	PARTIAL REFLECTED CEILING PLAN
M5.311	PARTIAL REFLECTED CEILING PLAN
M5.320	PARTIAL REFLECTED CEILING PLAN
M5.321	PARTIAL FURRED CEILING PLANS
M5.322	PARTIAL FURRED CEILING PLANS
M5.400	MECHANICAL DETAILS
M5.401	MECHANICAL DETAILS
M5.402	MECHANICAL DETAILS
M5.403	MECHANICAL DIAGRAMS & DETAILS
M5.404	MECHANICAL CONTROLS

ELECTRICAL DRAWINGS

E5.100	BUILDING LIGHTING PLAN
E5.101	BUILDING LIGHTING PLAN
E5.102	BUILDING LIGHTING PLAN
E5.200	BUILDING POWER PLAN
E5.201	BUILDING POWER PLAN
E5.202	BUILDING POWER PLAN
E5.300	BUILDING SYSTEMS PLAN
E5.301	BUILDING SYSTEMS PLAN
E5.302	BUILDING SYSTEMS PLAN
E5.400	BUILDING ELECTRICAL RISER
E5.500	PANEL SCHEDULES
E5.501	PANEL SCHEDULES

STRUCTURAL DRAWINGS

S5.001	GENERAL NOTES
S5.002	GENERAL NOTES
S5.003	LIVE LAND DIAGRAM
S5.101	OVERALL FOUNDATION PLAN
S5.102	PARTIAL FOUNDATION PLAN
S5.103	PARTIAL FOUNDATION PLAN
S5.201	FLOOR FRAMING PLANS
S5.202	CRANE RUNWAY FRAMING PLAN
S5.203	EXTERIOR PLATFORM FRAMING PLAN
S5.204	OVERALL ROOF FRAMING PLAN
S5.205	PARTIAL ROOF FRAMING PLAN
S5.206	PARTIAL ROOF FRAMING PLAN
S5.207	STAIR AND ELEVATOR SHAFT PLANS
S5.301	BUILDING SECTIONS
S5.302	BRACED FRAME ELEVATIONS
S5.401	FOUNDATION DETAILS & SCHEDULES
S5.402	BASE DETAILS
S5.403	ELEVATOR AND STAIR DETAILS
S5.404	BASE PLATE TYPES
S5.411	TYPICAL STEEL CONNECTION DETAILS
S5.412	MOMENT CONNECTION DETAILS
S5.413	BRACE CONNECTION DETAILS
S5.414	BRACE CONNECTION DETAILS
S5.415	TOWER FRAMING DETAILS
S5.416	CRANE DETAILS
S5.417	HOIST RUNWAY CONNECTION DETAILS
S5.418	MISCELLANEOUS CONNECTION DETAIL
S5.419	MISCELLANEOUS CONNECTION DETAIL
S5.421	ROOF DECK
S5.422	COMPOSITE STEEL DECK DETAILS
S5.431	CRANE DETAILS

A1 REFERENCE DRAWINGS

(A1 AND AS DRAWING SERIES)

ARCHITECTURAL

A1.G00	TITLE SHEET AND OVERALL SITE PLAN
A1.G01	PROJECT DRAWING INDEX
A1.AS1	ARCHITECTURAL DRAFTING LEGENDS AND SYMBOLS
A1.AS2	STANDARD MOUNTING HEIGHTS

MECHANICAL DRAWINGS

M1.100	LEGEND AND SCHEDULES
M1.200	DETAILS
M1.201	DETAILS

PRIMARY CONTRACTS DRAWINGS

GG1	SITE AVAILABILITY
GG2	RELATED WORK
GG3	WHARF, PHASE 2 DREDGE AND SLIP 5 FILL
GG4	DEMOLITION OF BUILDINGS 8801, 8902, 8903, 8904, AND 8908
GG5	CONTAINER YARD & INTERMODAL YARD
GG6	BUILDING CONSTRUCTION
GG7	RELATED WORK

ELECTRICAL DRAWINGS

E1.100	LEGEND AND LIGHTING FIXTURE SCHEDULE
E1.101	MECHANICAL EQUIPMENT CONN. SCHEDULES
E1.102	LIGHTING CONTROL DIAGRAMS
E1.103	LIGHTING CONTROL DIAGRAMS
E1.104	DIAGRAMS
E1.105	ELECTRICAL DETAILS AND DIAGRAMS
E1.200	ELECTRICAL SITE PLAN

A2 ADMINISTRATION BUILDING

(A2, S2, M2 AND E2 DRAWING SERIES)

A2.G01 COVER SHEET

ARCHITECTURAL DRAWINGS

A2.G02	SITE PLAN
A2.100	FLOOR PLANS
A2.110	ROOF PLANS
A2.120	REFLECTED CEILING PLANS
A2.200	FINISH SCHEDULES
A2.300	ELEVATIONS
A2.400	BUILDING SECTION
A2.401	BUILDING SECTION
A2.500	WALL SECTIONS
A2.501	WALL & STAIR SECTION

MECHANICAL DRAWINGS

M2.100	SCHEDULES
M2.210	FOUNDATION & PLUMBING FLOOR PLANS
M2.211	PLUMBING FLOOR PLANS
M2.310	REFLECTED CEILING PLANS
M2.320	FURRED CEILING PLANS
M2.400	MECHANICAL DETAILS
M2.401	MECHANICAL CONTROLS

ELECTRICAL DRAWINGS

E2.100	BUILDING LIGHTING PLAN
E2.200	BUILDING POWER PLAN
E2.201	BUILDING POWER PLAN
E2.300	BUILDING SYSTEMS PLAN
E2.400	BUILDING ELECTRICAL RISER
E2.500	PANEL SCHEDULES

STRUCTURAL DRAWINGS

S2.001	GENERAL NOTES
S2.002	GENERAL NOTES
S2.101	FOUNDATION AND FRAMING PLANS
S2.102	STAIR PLANS AND SECTIONS
S2.201	BRACED FRAME ELEVATIONS
S2.301	FOUNDATION DETAILS AND SCHEDULES
S2.302	FOUNDATION DETAILS AND SCHEDULES
S2.311	FRAMING DETAILS
S2.312	FRAMING DETAILS
S2.321	COMPOSITE STEEL DECK DETAILS

A3 MARINE BUILDING

(A3, S3, M3 AND E3 DRAWING SERIES)

A3.G01 COVER SHEET

ARCHITECTURAL DRAWINGS

A3.G02	SITE PLAN
A3.100	FLOOR PLANS
A3.110	ROOF PLAN
A3.120	REFLECTED CEILING PLANS
A3.200	FINISH SCHEDULES
A3.300	ELEVATIONS
A3.400	BUILDING SECTIONS
A3.500	WALL SECTIONS

STRUCTURAL DRAWINGS

S3.001	GENERAL NOTES
S3.002	GENERAL NOTES
S3.101	FOUNDATION AND FRAMING PLANS
S3.102	STAIR PLANS
S3.201	BRACED FRAME ELEVATIONS
S3.301	FOUNDATION DETAILS & SCHEDULES
S3.302	FOUNDATION DETAILS & SCHEDULES
S3.311	FRAMING DETAILS & SCHEDULES
S3.312	FRAMING DETAILS & SCHEDULES
S3.321	COMPOSITE STEEL DECK DETAILS

MECHANICAL DRAWINGS

M3.100	MECHANICAL SCHEDULES
M3.210	FOUNDATION & PLUMBING FLOOR PLANS
M3.310	REFLECTED AND FURRED CEILING PLANS
M3.400	MECHANICAL CONTROLS

ELECTRICAL DRAWINGS


E3.100	BUILDING LIGHTING PLAN
E3.200	BUILDING POWER PLAN
E3.300	BUILDING SYSTEMS PLAN
E3.400	PANEL SCHEDULES

PORT OF TACOMA

PIERCE COUNTY TERMINAL

MARINE BUILDING SET

KEY PLAN

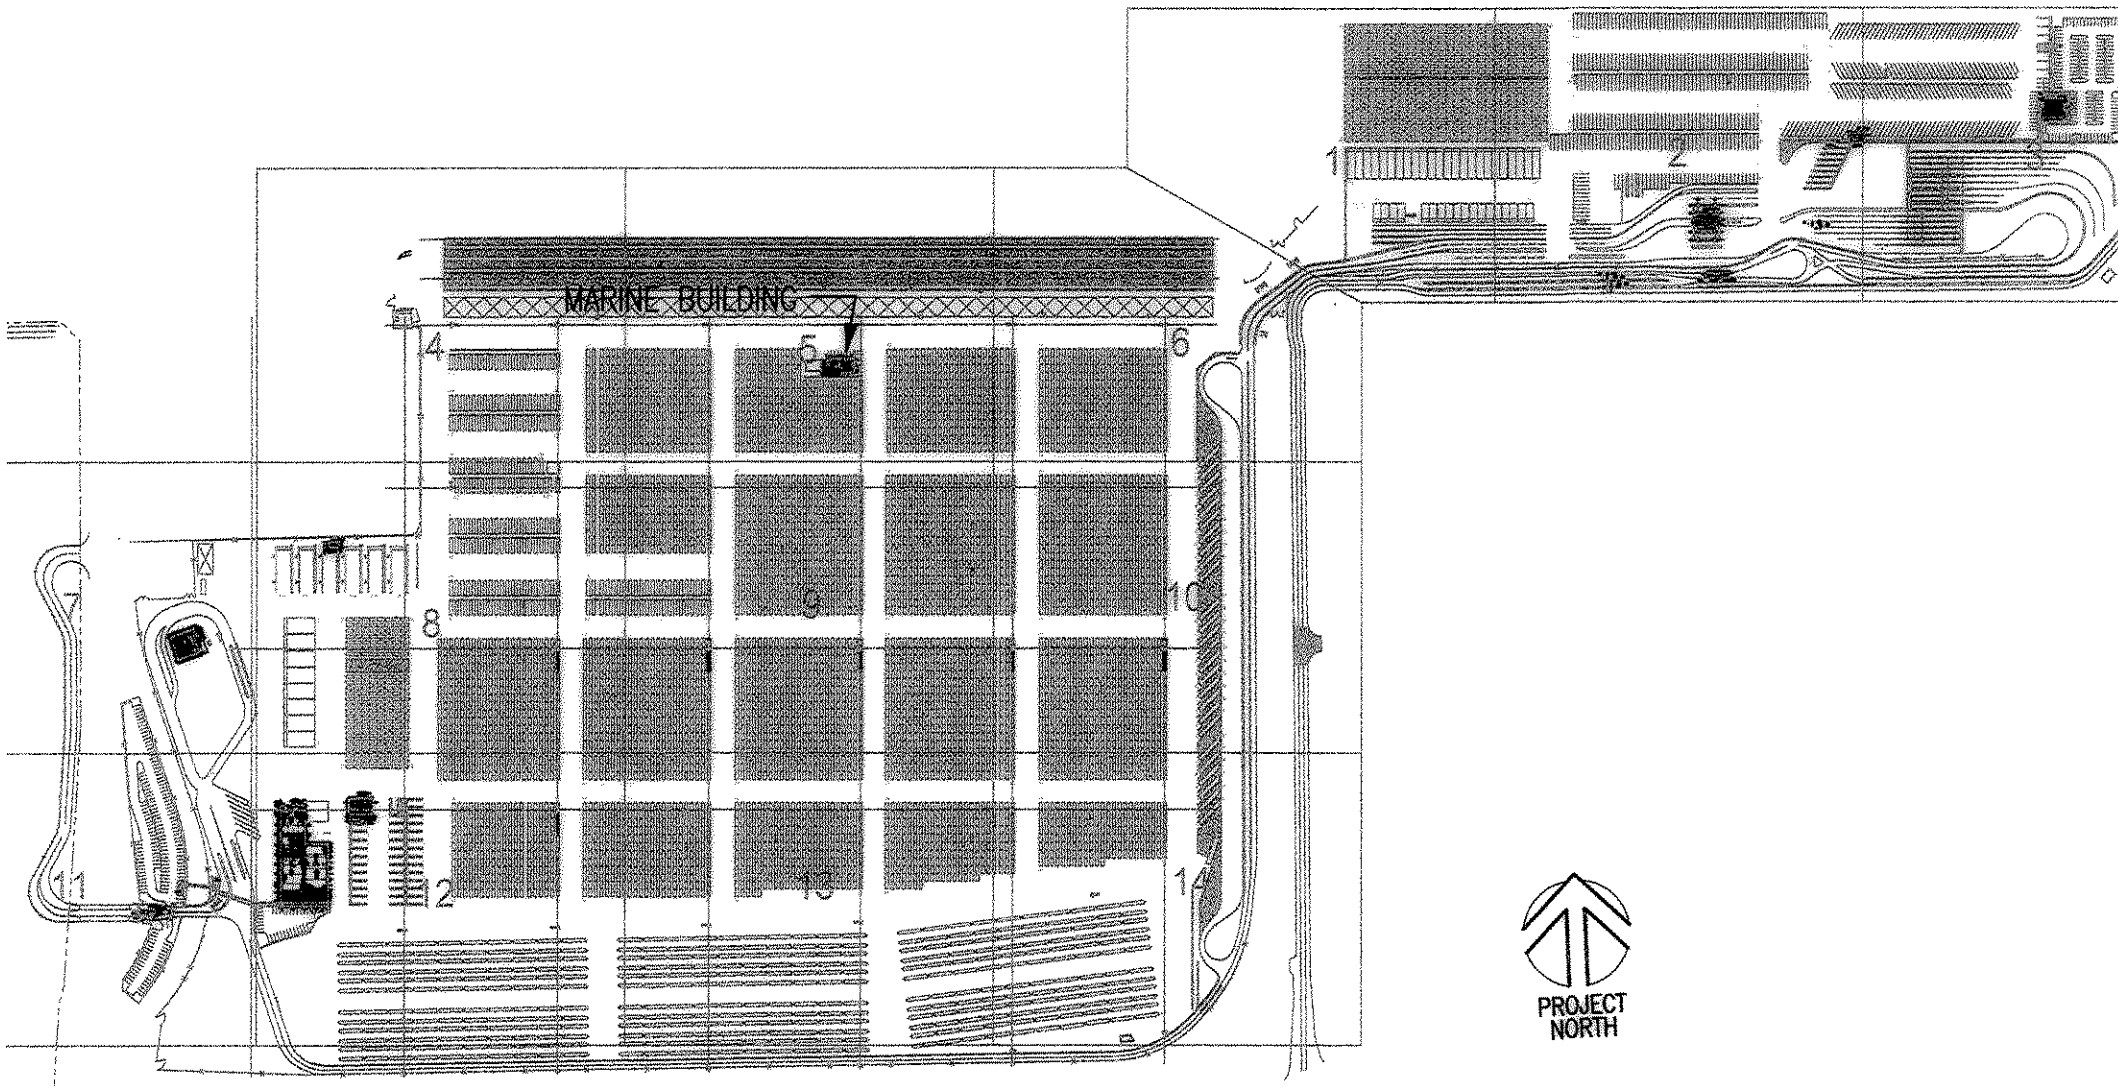

BUILDING INFORMATION


BUILDING AREA	
FIRST FLOOR	1,750 SQ. FT.
SECOND FLOOR	1,750 SQ. FT.
TOTAL	3,500 SQ. FT.
FIRE SPRINKLERS	NO
CODE INFORMATION	
OCCUPANCY GROUPS	B - OFFICE A-3 - BREAK
CONSTRUCTION TYPE	V-N
MAXIMUM ALLOWABLE BUILDING HEIGHT	40 FT.
MAXIMUM ALLOWABLE BUILDING STORIES	2 STORIES
ALLOWABLE FLOOR AREA	
ALL FLOORS	8,000 SQ. FT.
OCCUPANT LOAD	
FIRST FLOOR	78 OCCUPANTS
SECOND FLOOR	10 OCCUPANTS
TOTAL	88 OCCUPANTS

SHEET INDEX


A3.G01	COVER SHEET	Project Team
ARCHITECTURAL DRAWINGS		OWNER
A3.G02	SITE PLAN	PORT OF TACOMA
A3.100	FLOOR PLANS	P.O. BOX 1837
A3.110	ROOF PLAN	6021 12TH STREET EAST
A3.120	REFLECTED CEILING PLANS	TACOMA, WA 98401
A3.200	FINISH SCHEDULES	CONTACT: DAVID MEYERS
A3.300	ELEVATIONS	PHONE: 253-428-8612
A3.400	BUILDING SECTIONS	FAX: 253-383-6233
A3.500	WALL SECTIONS	EMAIL: dmyers@portoftacoma.com
STRUCTURAL DRAWINGS		ARCHITECT
S3.001	GENERAL NOTES	HELIX ARCHITECTURE, P.S.
S3.002	GENERAL NOTES	6021 12TH STREET EAST SUITE 201
S3.101	FOUNDATION AND FRAMING PLANS	TACOMA, WA 98424
S3.102	STAIR PLANS	CONTACT: LOWELL CATE
S3.201	BRACED FRAME ELEVATIONS	PHONE: (253) 922-9037
S3.301	FOUNDATION DETAILS & SCHEDULES	FAX: (253) 922-6499
S3.302	FOUNDATION DETAILS & SCHEDULES	EMAIL: lowellc@helixarch.com
S3.311	FRAMING DETAILS & SCHEDULES	GEOTECHNICAL ENGINEER
S3.312	FRAMING DETAILS & SCHEDULES	GEO ENGINEERS
S3.321	COMPOSITE STEEL DECK DETAILS	1101 SOUTH FAWCETT AVENUE
S3.331	ROOF FRAMING DETAILS	TACOMA, WA 98402
MECHANICAL DRAWINGS		CONTACT: DAVE PHELPS
M3.100	SCHEDULES	PHONE: 253-383-4940
M3.210	PLUMBING PLANS	FAX: 253-383-4923
M3.310	RCP AND FURRED CEILING PLANS	EMAIL: dphep@geoenr.com
ELECTRICAL DRAWINGS		STRUCTURAL ENGINEER
E3.100	BUILDING LIGHTING PLAN	BERGER/ABAM ENGINEERS, INC.
E3.200	BUILDING POWER PLAN	33301 NINTH AVENUE SOUTH
E3.300	BUILDING SYSTEMS PLAN	SUITE 300
E3.400	PANEL SCHEDULES	FEDERAL WAY, WA 98003
		CONTACT: RUBA ZUMUT
		PHONE: 206-431-2300
		FAX: 206-431-2250
		EMAIL: zumut@abam.com
		MECHANICAL ENGINEER
		BCE ENGINEERS
		6021 12TH STREET EAST, SUITE 200
		TACOMA, WA 98424
		CONTACT: DUANE LEASE
		PHONE: 253-922-0446
		FAX: 253-922-0896
		EMAIL: duanel@bceeng.com
		ELECTRICAL ENGINEER
		BCE ENGINEERS
		6021 12TH STREET EAST, SUITE 200
		TACOMA, WA 98424
		CONTACT: MIKE COZART
		PHONE: 253-922-0446
		FAX: 253-922-0896
		EMAIL: mcozart@bceeng.com



AMERICAN INSTITUTE OF ARCHITECTS

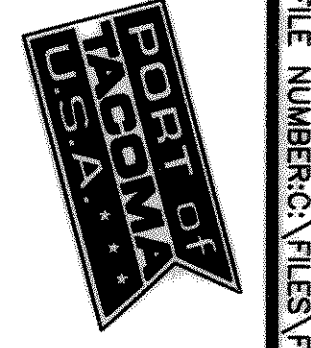

PORT OF TACOMA
TACOMA, WA 98401
253-383-5841

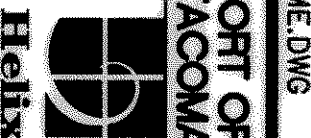

Helix
6021 12th street east
suite 201
Tacoma, wa 98424
tel: 253-922-9037
fax: 253-922-6499

APPROVED	LC	8/22/03
CHIEF ENGINEER - DATE	CHECKED BY - DATE	
PROJECT ENGR - DATE	8/22/03	


TOWNSHIP: RANGE: SECTION:	PORT OF TACOMA
DATUM: HORIZ: VERT:	PIERCE COUNTY TERMINAL
DRAWING SCALE: NTS	MARINE BUILDING

EP-5551-17

A3.G01

SHEET 56 OF 230

6321-17

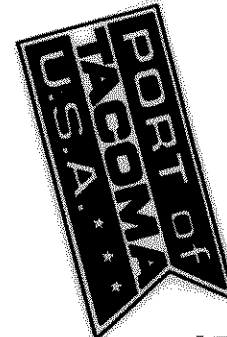

PORT OF TACOMA P.O. BOX 1887
TACOMA, WA 98401 253-383-6841
6021 12th Street East
Suite 201
Tacoma, WA 98424
Tel: 253.922.9037
Fax: 253.922.6499

RECORD DRAWING

APPROVED
LC
9/22/03
CHECKED BY - DATE
LC
9/22/03
PROJECT ENGR - DATE

PORT OF TACOMA
PIERCE COUNTY TERMINAL
MARINE BUILDING

EP-55561-47


A3.G02
SHEET 67 OF 230

CONTRACT NUMBER: 998154
E. NUMBER: E1974
PHASE: RECORD DRAWING



6321-17

SITE PLAN LEGEND

DESCRIPTION	SYMBOL AND TEXT
PROPERTY LINE length (ft) angle (survey)	100.00' N 90°00'00" W
ADJACENT PROPERTY LINE adjacent parcel lines	100.00' N 90°00'00" W
PROPERTY SETBACK LINE description and dimension	10'-0" FRONT YARD SETBACK
EASEMENT description and dimension	5'-0" UTILITY EASEMENT
FINISH GRADE ELEVATION existing (E)	EL. 0.00
LANDSCAPING	
BUILDING OUTLINE description, f.f. elevation, building dimensions, orientation	40.0' 20.0' BUILDING F.F. = 0.00'
FUTURE BUILDING/ PHASE OUTLINE description and phase	FUTURE ADDITION PHASE II
CONTAINER	
JERSEY BARRIER	
FENCE height/description	X - X - X - X 6' CHAINLINK FENCE
PARKING STALL AND LANDSCAPE PLANTER	row count, compact stall indicator (C), wheel stops where indicated, concrete curb R=2' 18'-0"
HANDICAPPED PARKING STALLS	row count, handicap stall indicator (HC), concrete curb, curb cut, HC signs, 2% max. slope all directions 26'-0"
LIGHT POLE	
FIRE HYDRANT	FH
MONUMENT ENTRY SIGN	description, shape, material ENTRY SIGN (STONE)
CENTERLINE OF ROAD	STREET NAME
EDGE OF ROAD	EDGE OF PAVEMENT

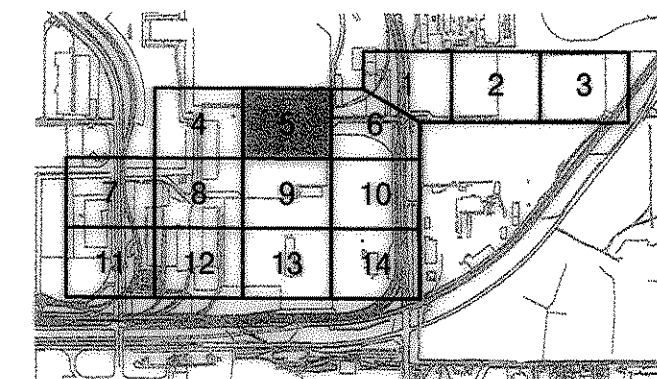

KEY MAP
N.T.S.

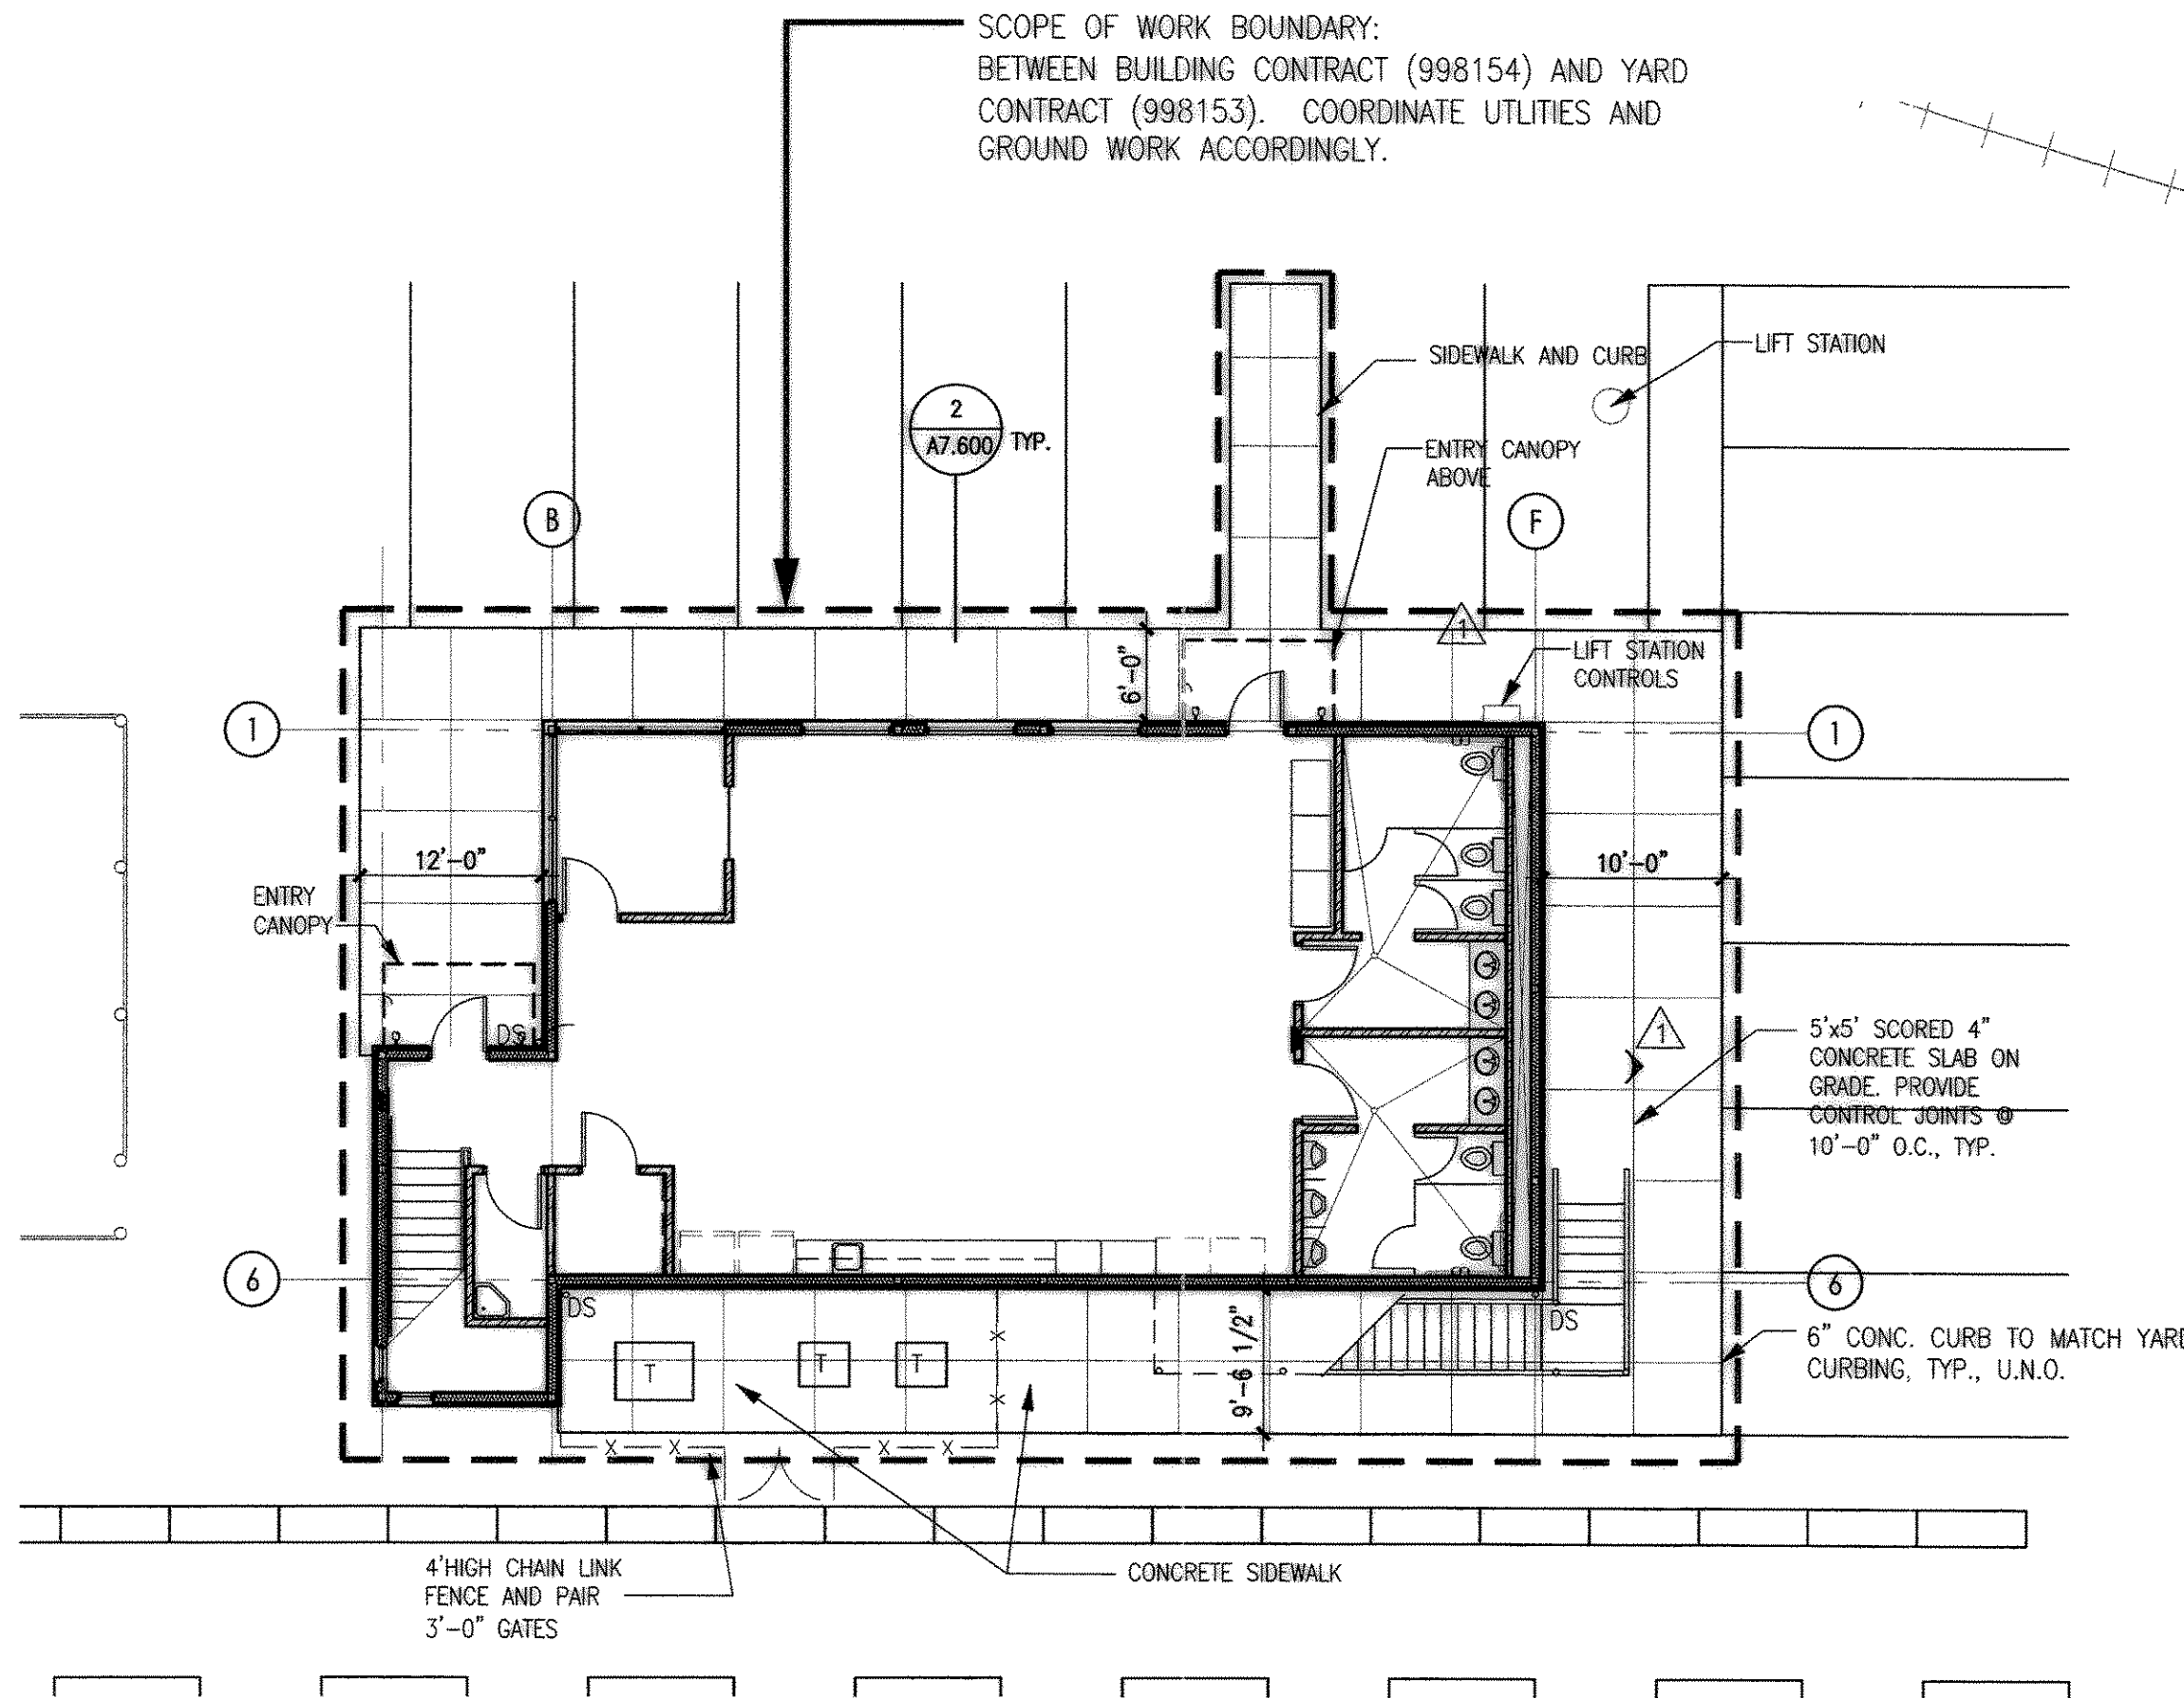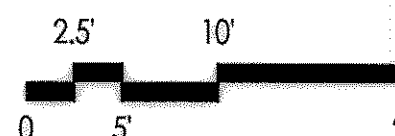

1	MARINE BUILDING SITE PLAN	F.F. = 21.75'
SCALE: 1"=10'-0"		PEC E2164A_FP-01.DWG

FOR FINISHED FLOOR ELEVATION AND BUILDING
CORNER LOCATIONS REFER TO CONTRACT
(998153) PROVIDE 1:20 SIDEWALK CROSS SLOPE

PORT OF TACOMA
USA

6021 12th street east
Tacoma, WA 98424
tel: 253.922.9037
fax: 253.922.6499

PORT OF TACOMA
P.O. BOX 1837
TACOMA, WA 98401
253-383-6841

6021 12th street east
Tacoma, WA 98424
tel: 253.922.9037
fax: 253.922.6499

RECORD DRAWINGS

DATE: 6/21/03

BY: JMM

APPROVED: DATE: 6/21/03

APPROVED

CHIEF ENGINEER - DATE

PROJECT ENGR. - DATE

MECHANICAL LEGENDS AND SCHEDULES

PORT OF TACOMA
PIERCE COUNTY TERMINAL
STANDARD MECHANICAL SHEETS

EP-5554-17
M1.100

SHEET 12 OF 230

TOWNSHIP: RANGE: SECTION: 36 36 36

DATE: 6/21/03

SCALE: NONE


CONTRACT NUMBER: 980134

FILE NUMBER: C:\M1.100-2003003.DWG

PLUMBING FIXTURE SCHEDULE											
UNIT NO	FIXTURE	MOUNTING	MANUFACTURER AND MODEL NUMBERS				W	V	HW	CW	REMARKS
P-1	WATER CLOSET	WALL	TOILET: SEAT: FLUSH VALVE:	KOHLER, KINGSTON #K-4330 CHURCH #9500C SLOAN ROYAL #8111	4"	2"	-	1"			
P-1A	WATER CLOSET	WALL	TOILET: SEAT: FLUSH VALVE:	KOHLER, KINGSTON #K-4330 CHURCH #9500C SLOAN ROYAL #8111	4"	2"	-	1"			ADA COMPLIANT, SEAT MUST BE 17" HIGH MINIMUM 19" HIGH MAXIMUM.
P-1C	WATER CLOSET	FLOOR	TOILET: SEAT: FLUSH VALVE:	KOHLER, HIGHCLIFF #K-4368 CHURCH #9500C SLOAN ROYAL #8111	4"	2"	-	1"			PROVIDE BOLT CAPS.
P-1D	WATER CLOSET	FLOOR	TOILET: SEAT: FLUSH VALVE:	KOHLER, HIGHCLIFF #K-4368 CHURCH #9500C SLOAN ROYAL #8111	4"	2"	-	1"			ADA COMPLIANT, SEAT MUST BE 17" HIGH MINIMUM, PROVIDE BOLT CAPS.
P-2	URINAL	WALL	URINAL: FLUSH VALVE:	KOHLER, BARDON #K-4960-T SLOAN ROYAL #8186-1	2"	1½"	-	¾"			
P-2A	URINAL	WALL	URINAL: FLUSH VALVE:	KOHLER, BARDON #K-4960-T SLOAN ROYAL #8186-1	2"	1½"	-	¾"			ADA COMPLIANT URINAL RIM TO BE 17" ABOVE FINISHED FLOOR
P-3	LAVATORY	WALL	SINK: FITTINGS: SUPPLIES: TRAP:	KOHLER, KINGSTON #K-2005 SYMMONS SCOT #S-60-G EBC #LAH16 EBC #TS140	2"	1½"	½"	½"			
P-3A	LAVATORY	WALL	SINK: FITTINGS: SUPPLIES: TRAP:	KOHLER, KINGSTON #K-2005 SYMMONS SCOT #S-60-G-H EBC #LAH16 EBC #TS140	2"	1½"	½"	½"			ADA COMPLIANT, PROVIDE WITH EBC INSTITUTIONAL ADA INSULATOR KIT.
P-3B	LAVATORY	COUNTER	SINK: FITTINGS: SUPPLY: TRAP:	KOHLER, PENNINGTON #K-2904 SYMMONS SCOT #S-60-G-H EBC #LAH16 EBC #TS140	2"	1½"	½"	½"			
P-3C	LAVATORY	COUNTER	SINK: FITTINGS: SUPPLY: TRAP:	KOHLER, PENNINGTON #K-2904 SYMMONS SCOT #S-60-G-H EBC #LAH16 EBC #TS140	2"	1½"	½"	½"			ADA COMPLIANT, PROVIDE WITH EBC INSTITUTIONAL ADA INSULATOR KIT.
P-4	WORK SINK	COUNTER	SINK: FITTINGS: SUPPLIES: WASTE: TRAP:	JUST #SL-1921-A-GR CHICAGO FAUCETS #786-GN8A-E3-317 EBC #LAH16 JUST #J-35-FS EBC #TS150	2"	1½"	½"	½"			
P-5	SERVICE SINK	FLOOR	FIXTURE: FITTINGS: WASTE: TRAP:	FLORESTONE #MSR-2424 CHICAGO FAUCETS #897VB FLORESTONE #MR-375 CAST IRON	3"	2"	¾"	¾"			PROVIDE WITH WEDGE-LOK SEAL #MR-374
P-6	SHOWER	STALL	STALL: CONTROLS:	FIBER-FAB #63 BF SYMMONS #96-1-150 SHOWER UNIT	2"	1½"	½"	½"			MOUNT SHOWER CONTROL AT 42" ABOVE SHOWER FLOOR, 2GPM SHOWERHEAD. PROVIDE TRAP PRIMER CONNECTION
P-6A	SHOWER	STALL	STALL: CONTROLS:	FIBER-FAB #63 HI SYMMONS #96-1-150 SHOWER UNIT	2"	1½"	½"	½"			PROVIDE STALL WITH LOW PROFILE BOTTOM FOR INSTALLATION FLUSH W/ FLOOR. PROVIDE 2" SHOWER DRAIN & HEAVY DUTY CURTAIN & HOOKS. PROVIDE TRAP PRIMER CONNECTION.
P-6B	SHOWER	STALL	STALL: CONTROLS:	FIBER-FAB #48 HI SYMMONS #96-1-150 SHOWER UNIT	2"	1½"	½"	½"			PROVIDE STALL WITH LOW PROFILE BOTTOM FOR INSTALLATION FLUSH W/ FLOOR. PROVIDE 2" SHOWER DRAIN & HEAVY DUTY CURTAIN & HOOKS. PROVIDE TRAP PRIMER CONNECTION.
P-7	WASH FOUNTAIN (CEM)	FLOOR		BRADLEY SENTRY #SN2003-A-AST-F-STD-TMA-NSD-BS	1½"	1½"	1"	1"			VERIFY RIM HEIGHT, FURNISH COMPLETE WITH SUPPLY STOPS, STRAINER AND P-TRAP
P-8	EMERGENCY EYEWASH	WALL		CHICAGO FAUCETS #9007	2"	1½"	-	½"			HEAVY GAUGE CORROSION RESISTANT STAINLESS STEEL BOWL
P-9	WALL HYDRANT HOT AND COLD	WALL		J.R. SMITH #5760 "TWIN TEMP"	-	-	¾"	¾"			BRONZE BOX HYDRANT CHROME PLATED FACE & 'T' HANDLE KEY
P-10	TRENCH DRAIN	FLOOR	DRAIN: GRATE:	JR SMITH 9819 JR SMITH 9870-461	4"	-	-	-			
P-10A	TRENCH DRAIN	FLOOR	DRAIN: GRATE:	JR SMITH 9819 JR SMITH 9870-461	4"	-	-	-			PROVIDE WITH INTEGRAL CATCH BASIN & GALVANIZED SEDIMENT BUCKET.
P-11	WALL HYDRANT	WALL		J.R. SMITH #5609QT	-	-	-	¾"			BRONZE BOX HYDRANT CHROME PLATED FACE & 'T' HANDLE KEY
P-12	DRINKING FOUNTAIN ADA	WALL		HAWS #1118 STAINLESS STEEL, FURNISH WITH TRAP, SERVICE SUPPLY STOP AND SUPPORT SYSTEM	2"	1½"	-	½"			BARRIER FREE, SELF-CLOSING FRONT PUSH BAR, STREAM REGULATOR
P-13	AUXILIARY BUILDING LAVATORY	WALL	SINK: SUPPLIES: TRAP:	KOHLER, KINGSTON #2005 EBC #LAH16 EBC #TS140	2"	1½"	-	-			INSTALLATION AND ALL COMPONENTS SHALL BE ADA COMPLIANT. PROVIDE WITH EBC ADA INSULATOR KIT.


GRILLES-REGISTERS-DIFFUSERS SCHEDULE										
UNIT NO	DESCRIPTION	MFR.	MODEL	CFM	AIR PATTERN	MOUNTING	FACE SIZE	NECK SIZE	COLOR	REMARKS
CD-1	CEILING DIFFUSER	TITUS	TDC-1	PER PLANS	2 WAY	T-BAR	23 3/4" x 23 3/4"	PER PLANS	WHITE	FRAME 3
CD-2	CEILING DIFFUSER	TITUS	TDC-2	PER PLANS	2 WAY	T-BAR	23 3/4" x 23 3/4"	PER PLANS	WHITE	FRAME 3
CD-3	CEILING DIFFUSER	TITUS	TDC-3	PER PLANS	3 WAY	T-BAR	23 3/4" x 23 3/4"	PER PLANS	WHITE	FRAME 3
CD-4	CEILING DIFFUSER	TITUS	TDC-4	PER PLANS	4 WAY	T-BAR	23 3/4" x 23 3/4"	PER PLANS	WHITE	FRAME 3
CDH-	CEILING DIFFUSER	TITUS	②	PER PLANS	②	SURFACE	NECK SIZE + 5/8" TOTAL	PER PLANS	WHITE	③ FRAME 6
X-LSSX-X	LINEAR SLOT SUPPLY DIFFUSER	TITUS	FL	PER PLANS	2 WAY	SURFACE	5 3/4" HIGH	PER PLANS	AS SELECT. BY ARCH.	①
RD	ROUND DUCT DIFFUSER	TITUS	TMRA	PER PLANS	360°	SURFACE	NECK SIZE + 2" TOTAL	PER PLANS	WHITE	
SDS	SIDEWALL SUPPLY DIFFUSER	TITUS	300RL	PER PLANS	DBL. DEFLECTION	SURFACE	NECK SIZE + 1 1/4" TOTAL	PER PLANS	WHITE	③④ WITHOUT MOUNTING HOLES.
RG	RETURN/RELIEF GRILLE	TITUS	50F-A	PER PLANS	-	T-BAR	NECK SIZE + 1" TOTAL	PER PLANS	WHITE	WITHOUT MOUNTING HOLES
RGH	RETURN/RELIEF GRILLE	TITUS	50F-A	PER PLANS	-	SURFACE	NECK SIZE + 1 1/4" TOTAL	PER PLANS	WHITE	③
RGS	SIDEWALL RETURN/RELIEF GRILLE	TITUS	350 RL	PER PLANS	-	SURFACE	NECK SIZE + 1 1/4" TOTAL	PER PLANS	WHITE	③④ WITHOUT MOUNTING HOLES
EG	EXHAUST GRILLE	TITUS	50F-A	PER PLANS	-	T-BAR	NECK SIZE + 1" TOTAL	PER PLANS	WHITE	
EGS	SIDEWALL RETURN/RELIEF GRILLE	TITUS	350 RL	PER PLANS	-	SURFACE	NECK SIZE + 1 1/4" TOTAL	PER PLANS	WHITE	③④ WITHOUT MOUNTING HOLES
EGH	EXHAUST GRILLE	TITUS	50F-A	PER PLANS	-	SURFACE	NECK SIZE + 1 3/4" TOTAL	PER PLANS	WHITE	③
TGS	SIDEWALL/TRANSFER GRILLE	TITUS	350 RL	PER PLANS	-	SURFACE	NECK SIZE + 1 3/4" TOTAL	PER PLANS	WHITE	③④ WITHOUT MOUNTING HOLES


- NOTES FOR GRILLES, REGISTERS, DIFFUSERS SCHEDULE:
- ① PROVIDE WITH INSULATED PLENUM BOXES. SLOT DIFFUSER CALLOUT
- ② MODEL No. & AIR PATTERN SHALL BE SAME AS CD-1 THRU CD-4, EXCEPT PROVIDE FOR MOUNTING INDICATED.
- ③ FURNISH WITH "OPPOSED BLADE DAMPER"(OBD).
- ④ FURNISH WITH HORIZONTAL FRONT BLADES.

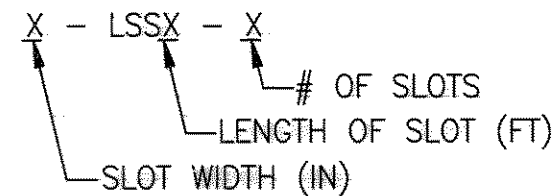

PLUMBING LEGEND	
SYMBOL	DESCRIPTION
----	COLD WATER (CW)
-----	HOT WATER (HW)
-----	HOT WATER CIRCULATION (HWC)
-----	WASTE OR SANITARY SEWER
---OW---	OIL WASTE
-----	VENT (V)
---OW---	ONLY WASTE
---A---	COMPRESSED AIR PIPING
---F---	FIRE MAIN / FIRE SPRINKLER PIPING
---CG---	CHASSIS GREASE PIPING
---EO---	ENGINE OIL PIPING
---HO---	HYDRAULIC OIL PIPING
---AF---	ANTIFREEZE PIPING
---GO---	GEAR OIL PIPING
---WO---	WASTE OIL PIPING
---EA---	EXTRACTION SYS. COMPRESSED AIR PIPING
---RL---	RAIN LEADER
---ST---	STORM
---COND---	CONDENSATE PIPING
J L	VENT THRU ROOF (VTR)
GHI	WALL CLEAN OUT (WCO)
O---	FLUSH/SURFACE CLEANOUT (FCO/SCO)
II---	CLEAN OUT (CO)
RD ⊙	ROOF DRAIN WITH RAIN LEADER
⊙	FLOOR DRAIN (FD)
⊙	FLOOR & FUNNEL DRAIN (F&FD)
▲	TRAP PRIMER WITH ACCESS PANEL
---	FREEZEPROOF WALL HYDRANT (FWH)
---	FREEZEPROOF BOX HYDRANT (FBH)
---	GAS COCK
---	GAS SOLENOID VALVE

MECHANICAL LEGEND			
SYMBOL	DESCRIPTION	SYMBOL	DESCRIPTION
---	LIQUID (REFRIGERANT)	⊗	SUPPLY DUCT DOWN
---	SUCTION (REFRIGERANT)	⊗	RETURN, RELIEF, TRANSFER, OSA DUCT UP
⊗	GATE VALVE (GV)	⊗	RETURN, RELIEF, TRANSFER, OSA DUCT DOWN
⊗	GLOBE VALVE	⊗	EXHAUST DUCT UP
⊗	BUTTERFLY VALVE	⊗	EXHAUST DUCT DOWN
⊗	PRESSURE REDUCING VALVE (PRV)	⊗	RECTANGULAR DUCT SQUARE ELBOW UP
⊗	CHECK VALVE (CV)	⊗	RECTANGULAR DUCT, RADIUS ELBOW UP
⊗	FLOW CONTROL VALVE	⊗	RECTANGULAR DUCT, SQUARE ELBOW DOWN
⊗	TEMP./PRESS. RELIEF VALVE (T&PRV)	⊗	RECTANGULAR DUCT, RADIUS ELBOW DOWN
⊗	BALL VALVE	⊗	ROUND DUCT ELBOW DOWN
⊗	BALANCING COCK (BC)	⊗	ROUND DUCT ELBOW UP
G+	PIPE DOWN	⊗	CEILING AIR TERMINAL - SQUARE
O+	PIPE UP	⊗	CEILING AIR TERMINAL - ROUND
⊗	BRANCH-TOP CONNECTION	12 X 12 CD 300 CFM	AIR TERMINAL SIZE, TYPE & CFM
⊗	BRANCH-BOTTOM CONNECTION		FLEXIBLE DUCT
⊗	BRANCH-SIDE CONNECTION	⊗	VOLUME DAMPER (VD)
⊗	CAP END OF PIPE	⊗	MOTORIZED DAMPER
⊗	FLOW DIRECTION	⊗	CEILING RADIANT FIRE DAMPER
⊗ OR ⊗	VALVE IN RISER / DROP	⊗	FIRE DAMPER
⊗	PIPE ANCHOR	⊗	COMBINATION FIRE/SMOKE DAMPER
⊗	PIPE GUIDE	⊗	FLEXIBLE CONNECTION (DUCT)
⊗	FLEXIBLE CONNECTION (PIPE)	⊗	TURNING VANES (TV)
⊗	REDUCER	⊗	BACKDRAFT DAMPER (BD)
⊗	STRAINER	⊗	THERMOSTAT (T'STAT)
⊗	UNION	⊗ G	THERMOSTAT WITH GUARD (T'STAT)
⊗	THRUST BLOCK (TB)	⊗	SPACE PRESSURE SENSOR
⊗	DRAIN VALVE	⊗	CARBON DIOXIDE SENSOR
⊗	VACUUM BREAKER	AFF	ABOVE FINISHED FLOOR
⊗	PRESSURE GAUGE	BFF	BELOW FINISHED FLOOR
⊗	THERMOMETER	MC	MECHANICAL CONTRACTOR
⊗	AQUASTAT	EC	ELECTRICAL CONTRACTOR
⊗	SUPPLY DUCT UP	GC	GENERAL CONTRACTOR

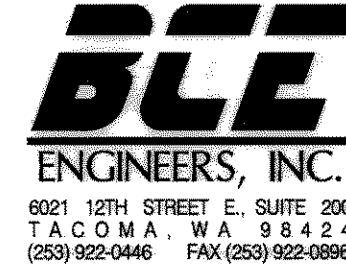

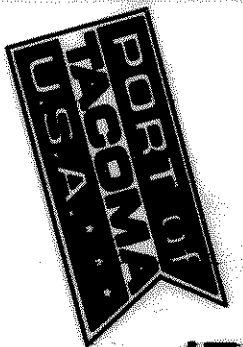

PORT OF TACOMA
TACOMA, WA 98401
P.O. BOX 1837
253-383-6841



4021 12th Street East
Suite 201
Tacoma, WA 98424
Tel: 253.922.9037
Fax: 253.922.6499

REVISION	DATE
RECORD DRAWINGS	

APPROVED

CHECKED BY - DATE

PROJECT ENGR - DATE

PORT OF TACOMA
PIERCE COUNTY TERMINAL
STANDARD MECHANICAL SHEETS
MECHANICAL DETAILS


EP-666417
M1.200

SHEET 13 OF 230

CONTRACT NUMBER: 998154

PHASE: RECORD DRAWINGS

6321-17

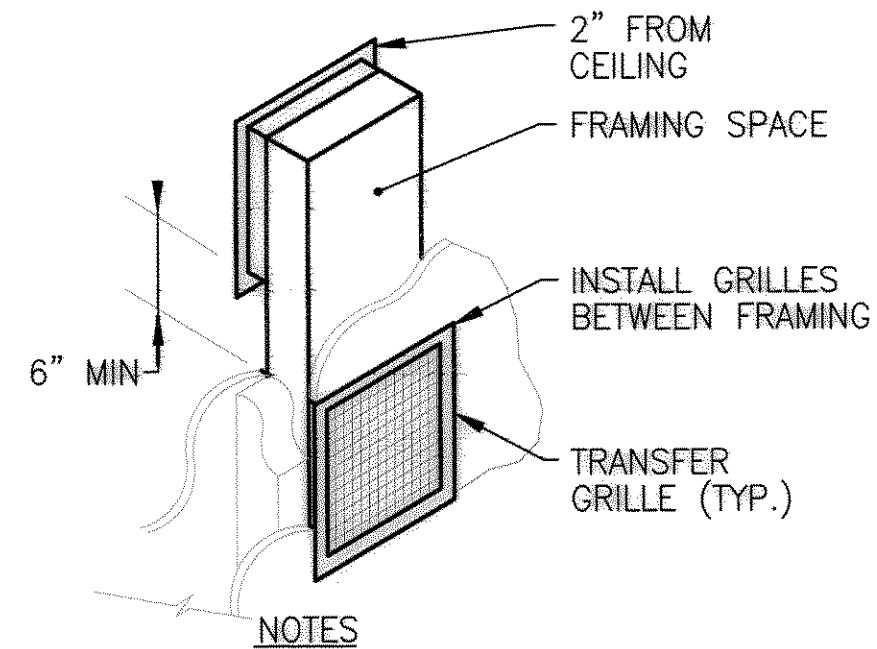


- NOTES
1. OFFSET GRILLES FOR PRIVACY.
 2. PAINT WALL FLAT BLACK BEHIND GRILLE.

TRANSFER GRILLE INSTALLATION DETAIL


NOT TO SCALE

NOTE:
MAINTAIN ACCESS CLEARANCE ON BOTH SIDES FOR SERVICE OF BLOWER
* INSTALL DUCT HANGER STRAPS ADJACENT TO FLEX CONNECTION

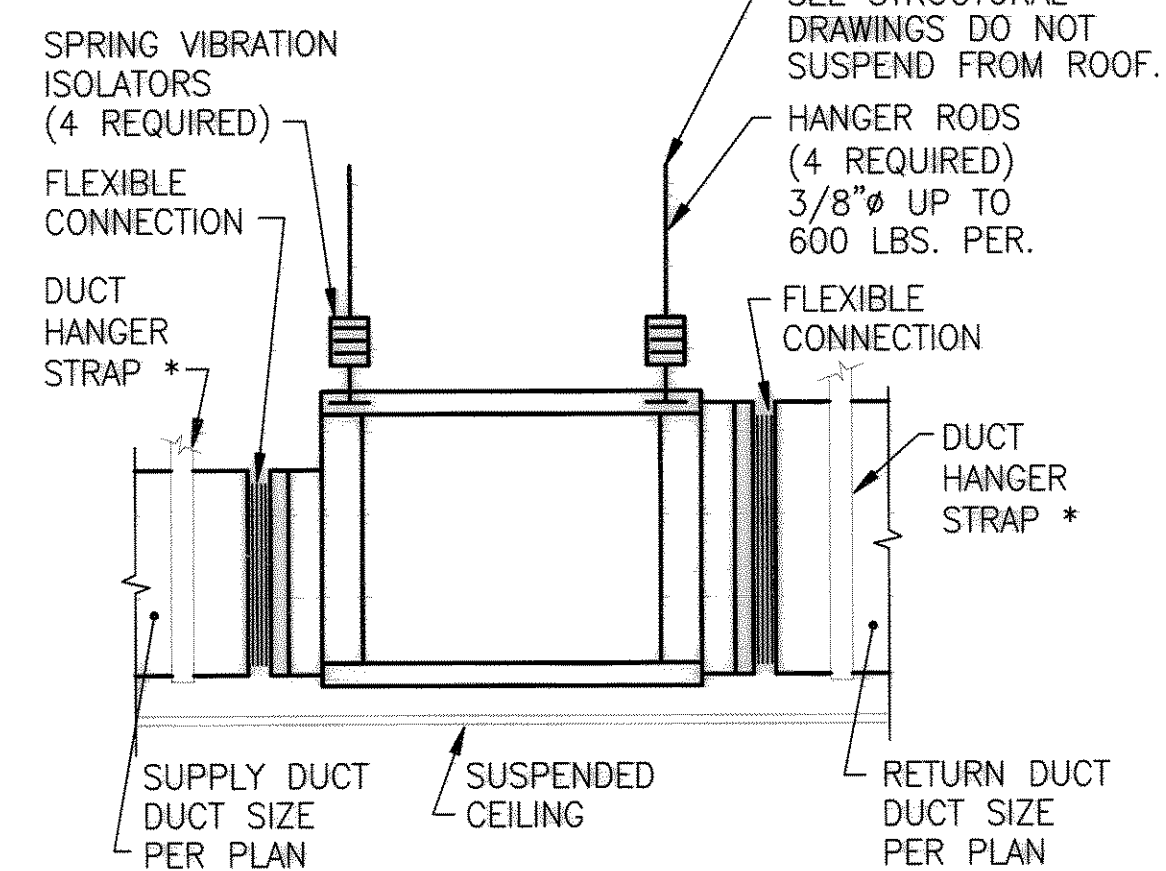

TYPICAL EXHAUST FAN INSTALLATION DETAIL

NO SCALE

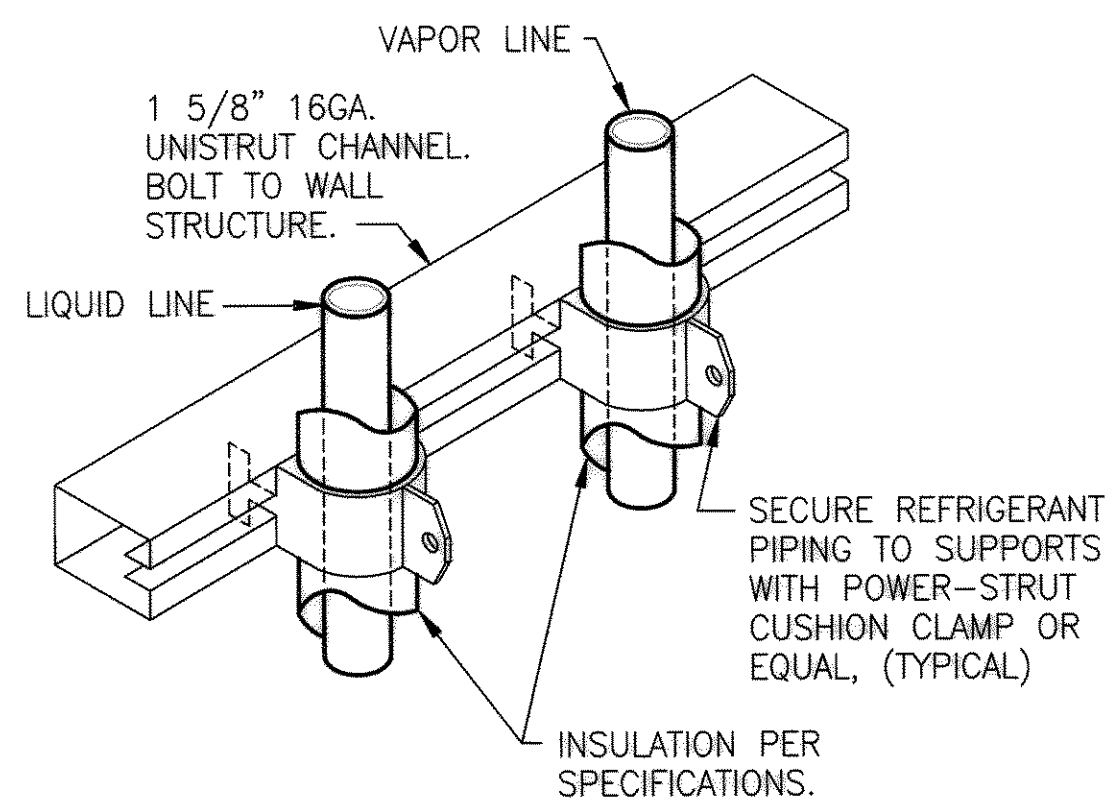


REFRIGERANT PIPE SUPPORT DETAIL

DIAGRAMMATIC




6021 12TH STREET E., SUITE 200
TACOMA, WA 98424
(253) 922-0446 FAX (253) 922-0886

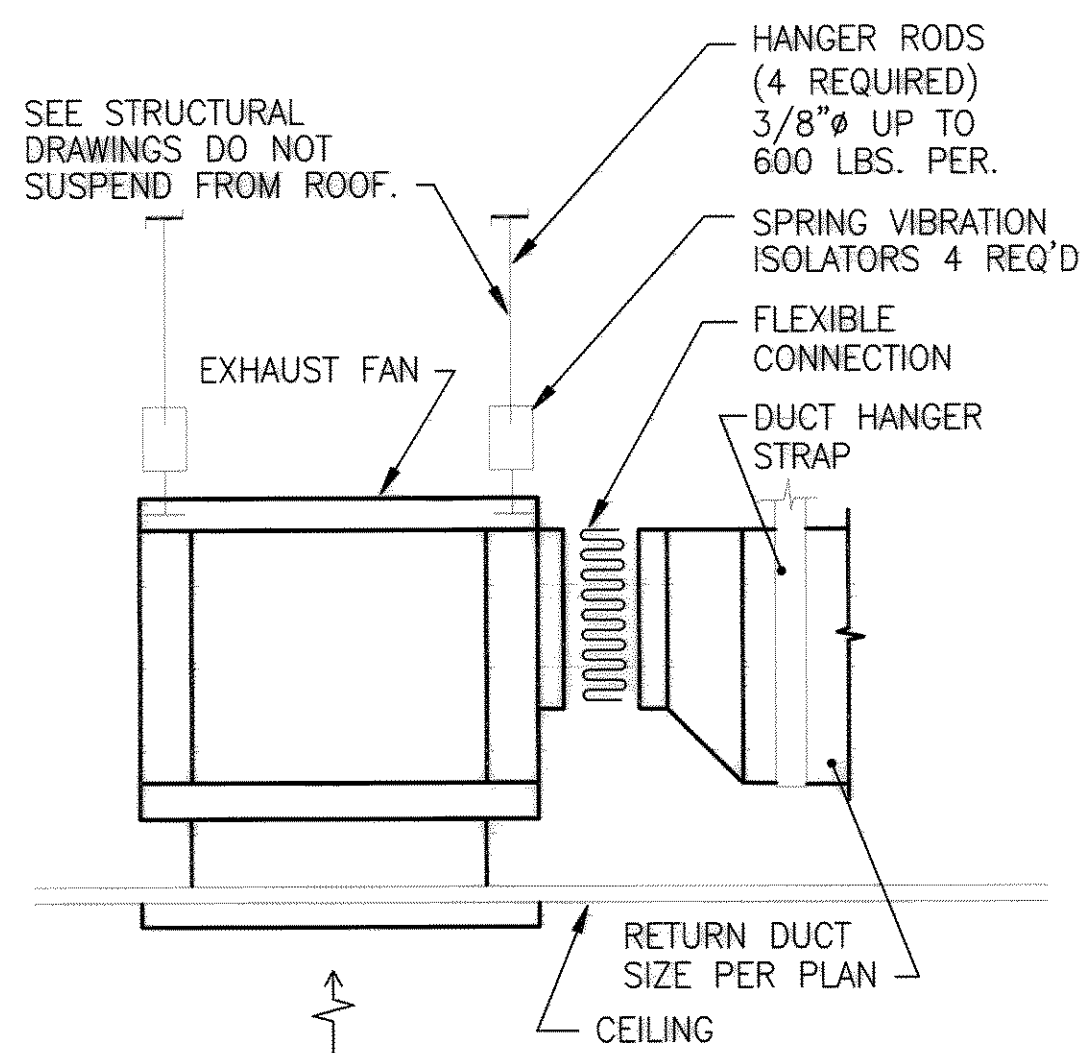


CEILING MOUNTED EXHAUST FAN INSTALLATION DETAIL

NOT TO SCALE

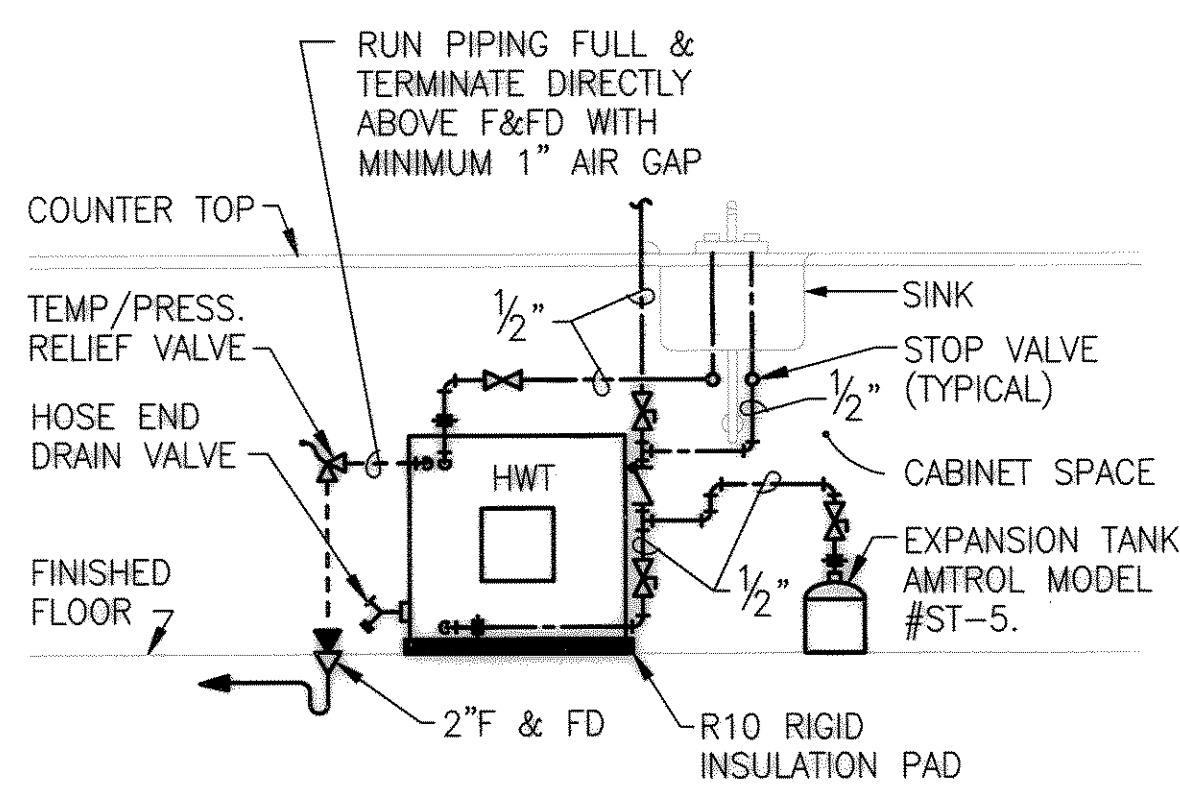


UNDER CABINET HOT WATER TANK PIPING DIAGRAM

DIAGRAMMATIC

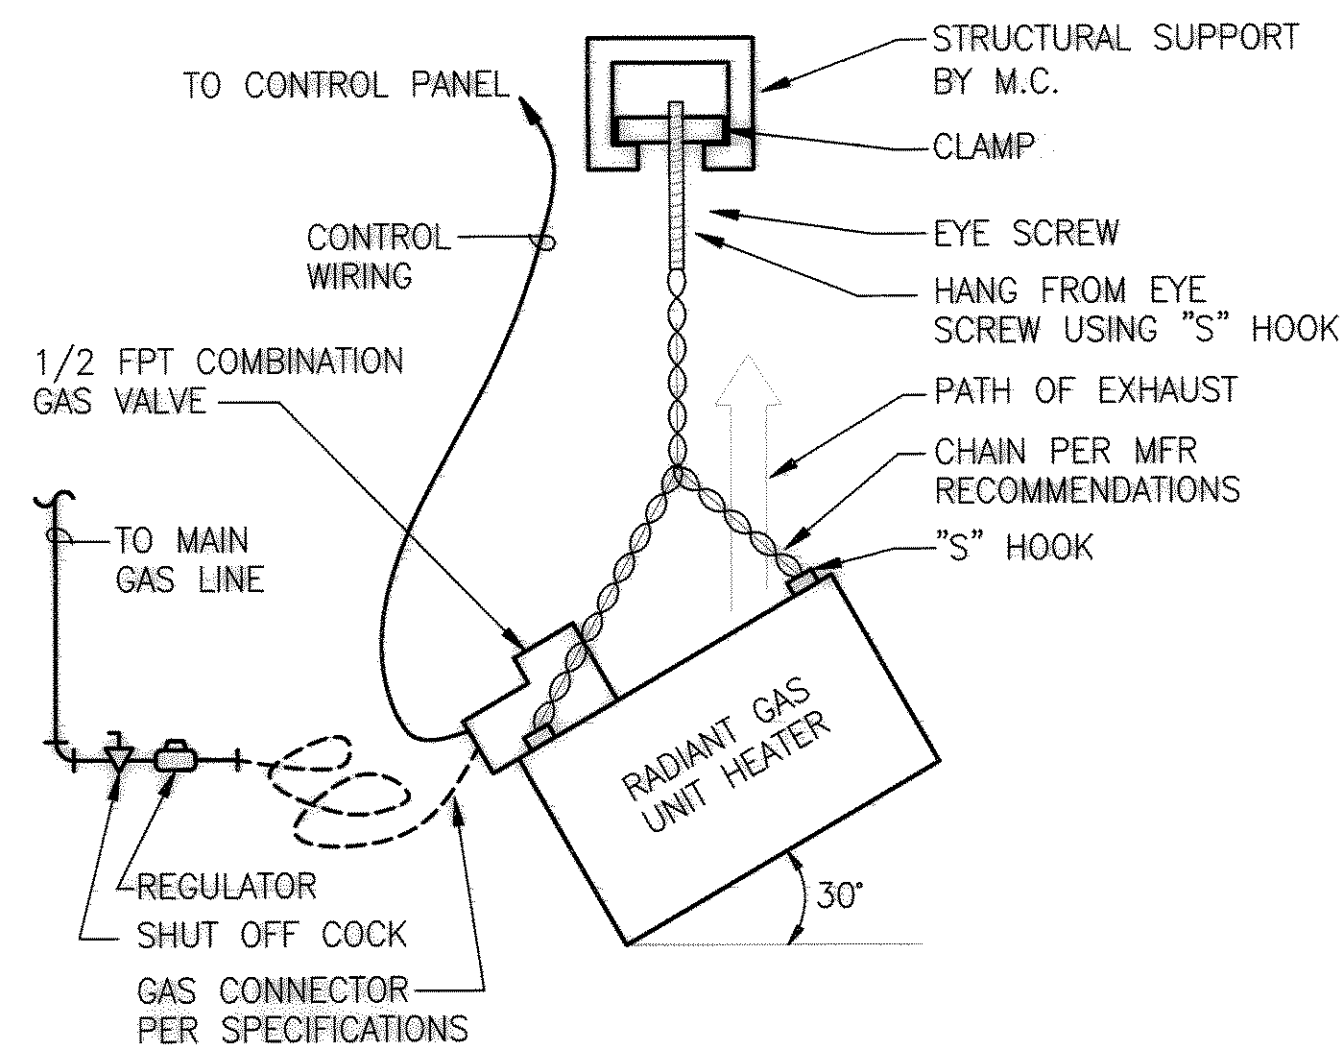


TYPICAL RADIANT HEATER INSTALLATION DETAIL

DIAGRAMMATIC

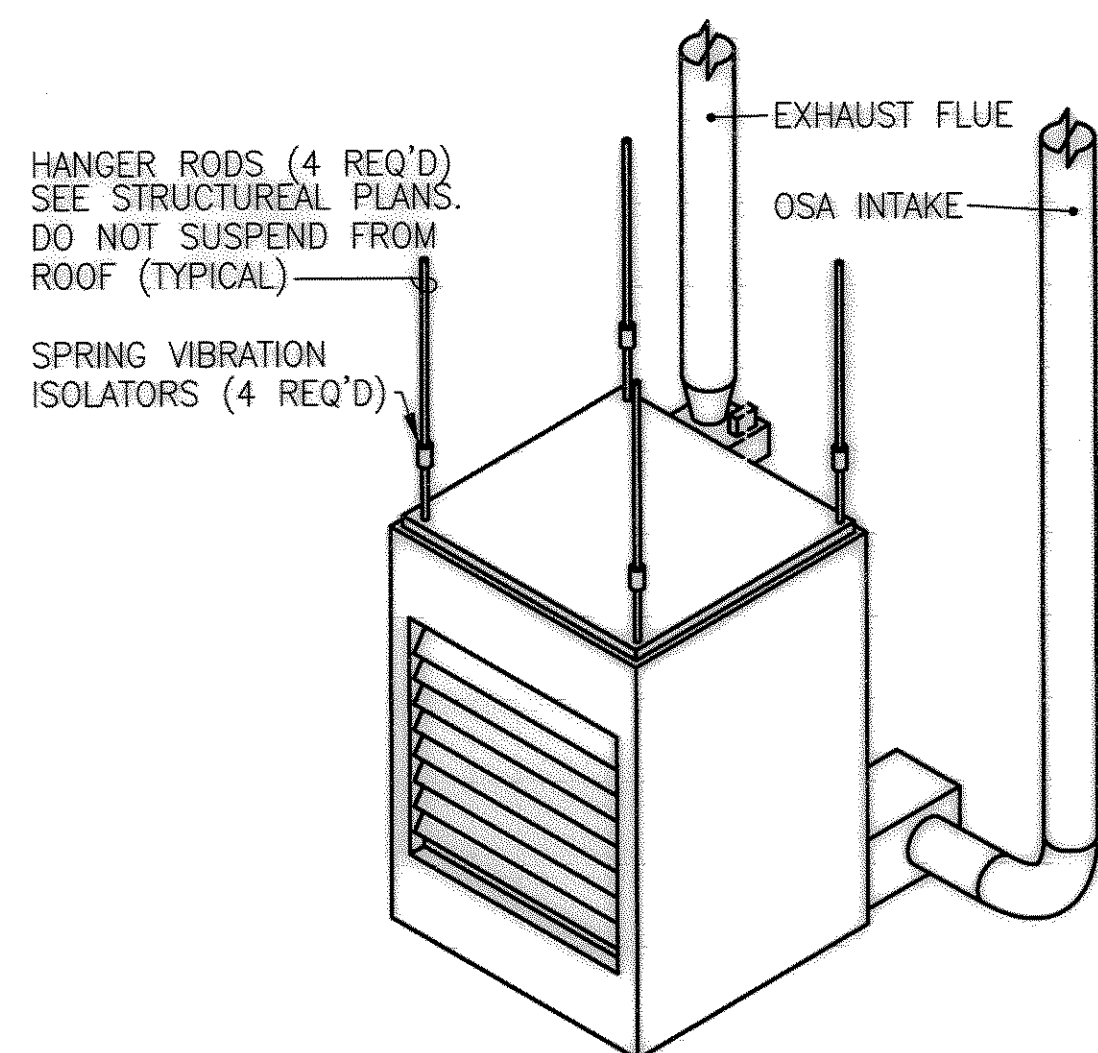


TYPICAL GAS UNIT HEATER INSTALLATION DETAIL

NO SCALE

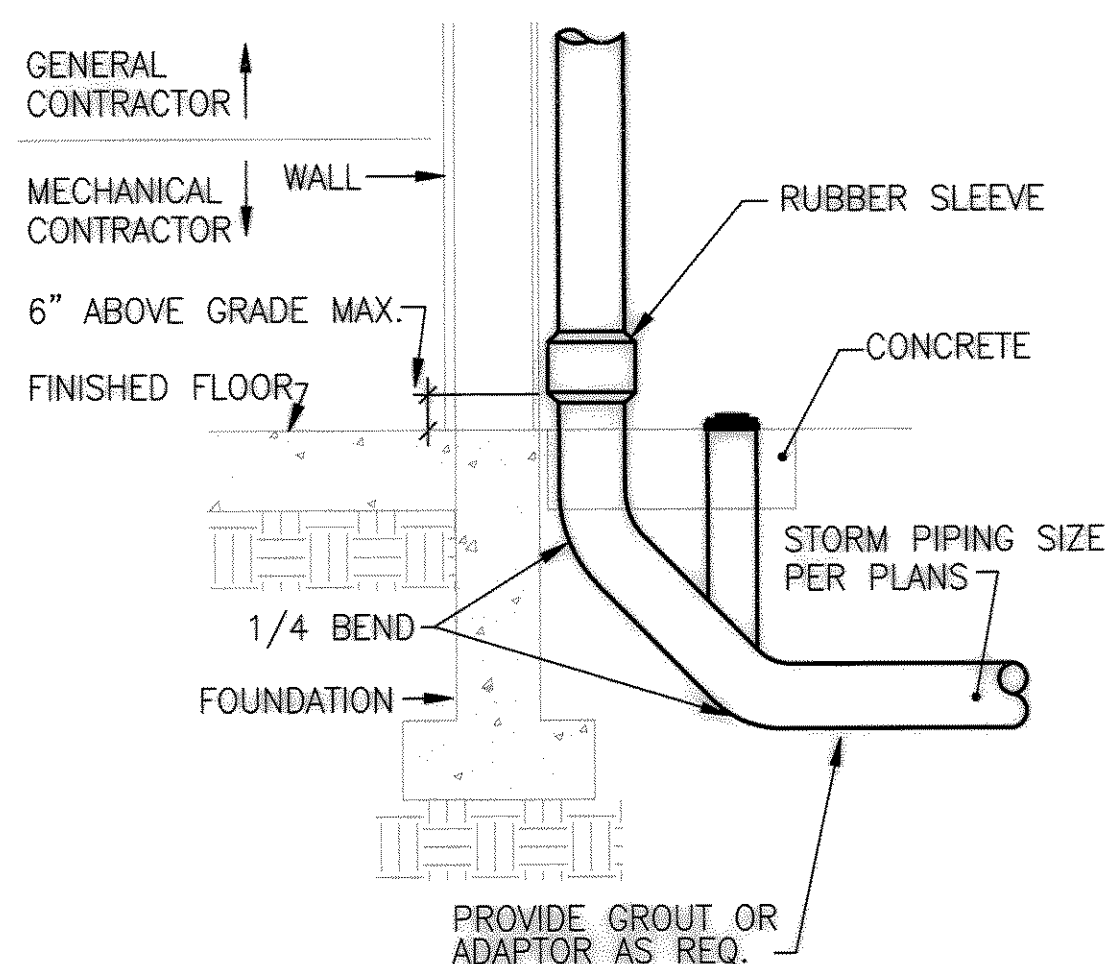


TYPICAL DOWNSPOUT CONNECTION DETAIL

NO SCALE

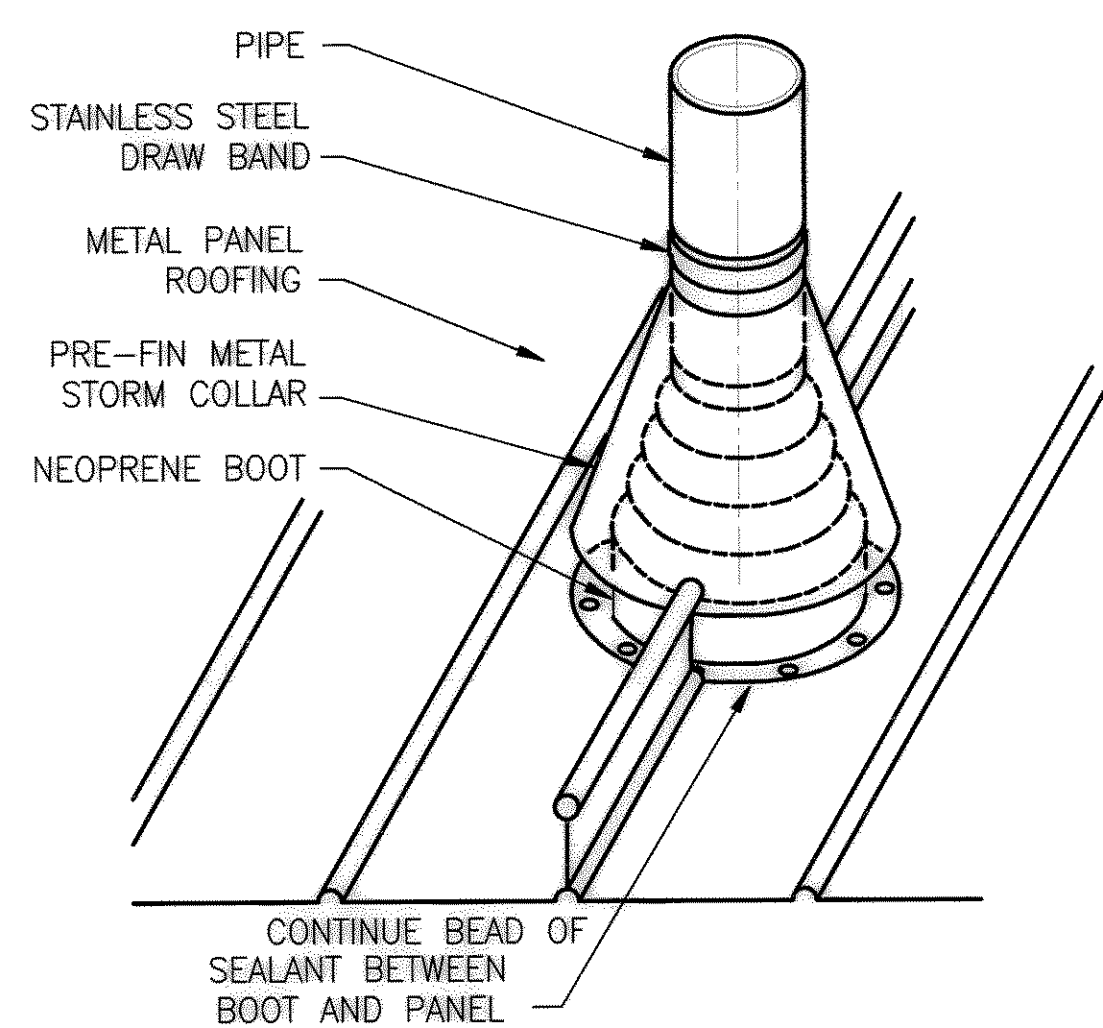


PIPE PENETRATION @ MTL. ROOFING

NOT TO SCALE

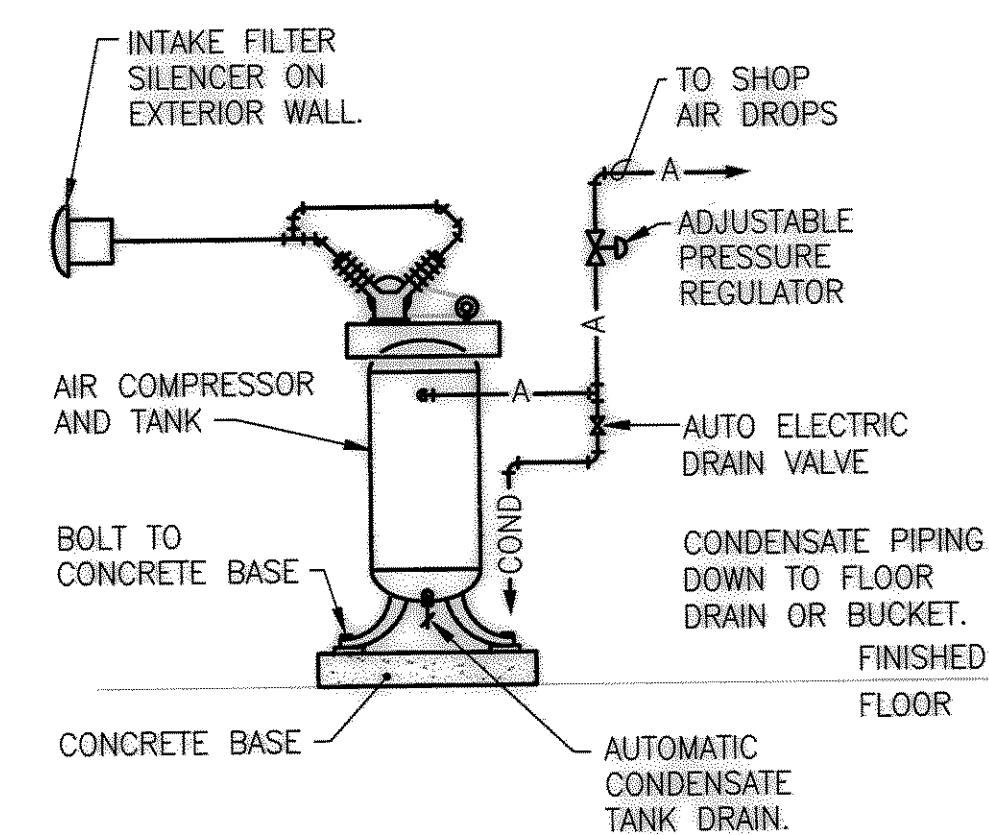


AIR COMPRESSOR PIPING DIAGRAM

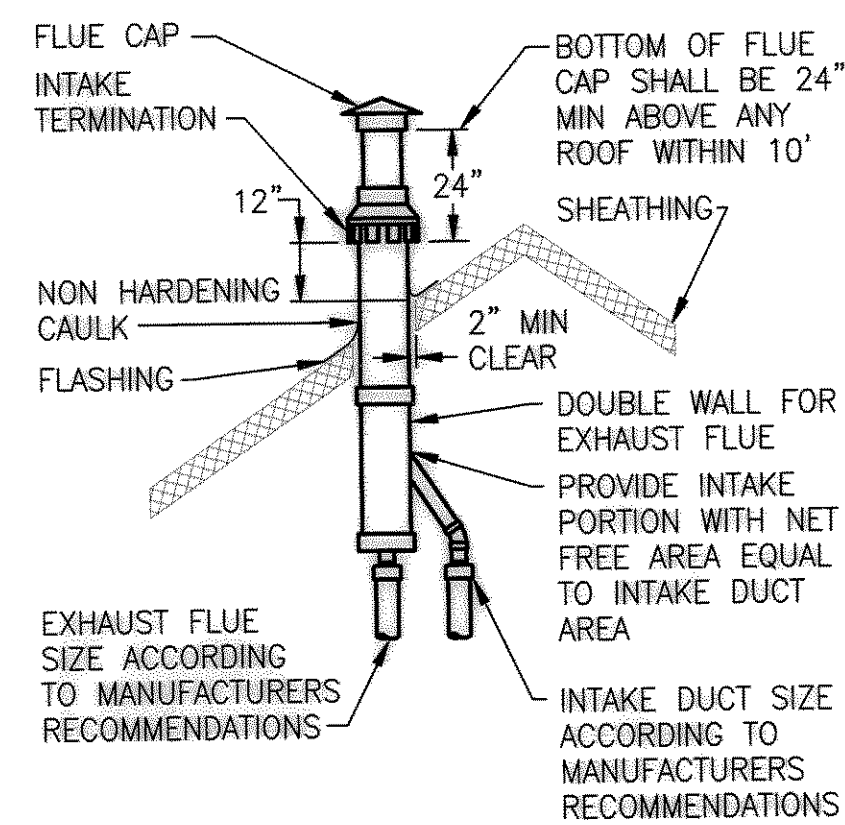

NOTE:


1. VERIFY PITCH OF ROOF AND PROVIDE BLOCKING AND FLASHING AS REQUIRED.
2. COORDINATE EQUIPMENT AND FLUE LOCATION WITH G.C.

CONCENTRIC FLUE ROOF
PENETRATION DETAIL
NO SCALE

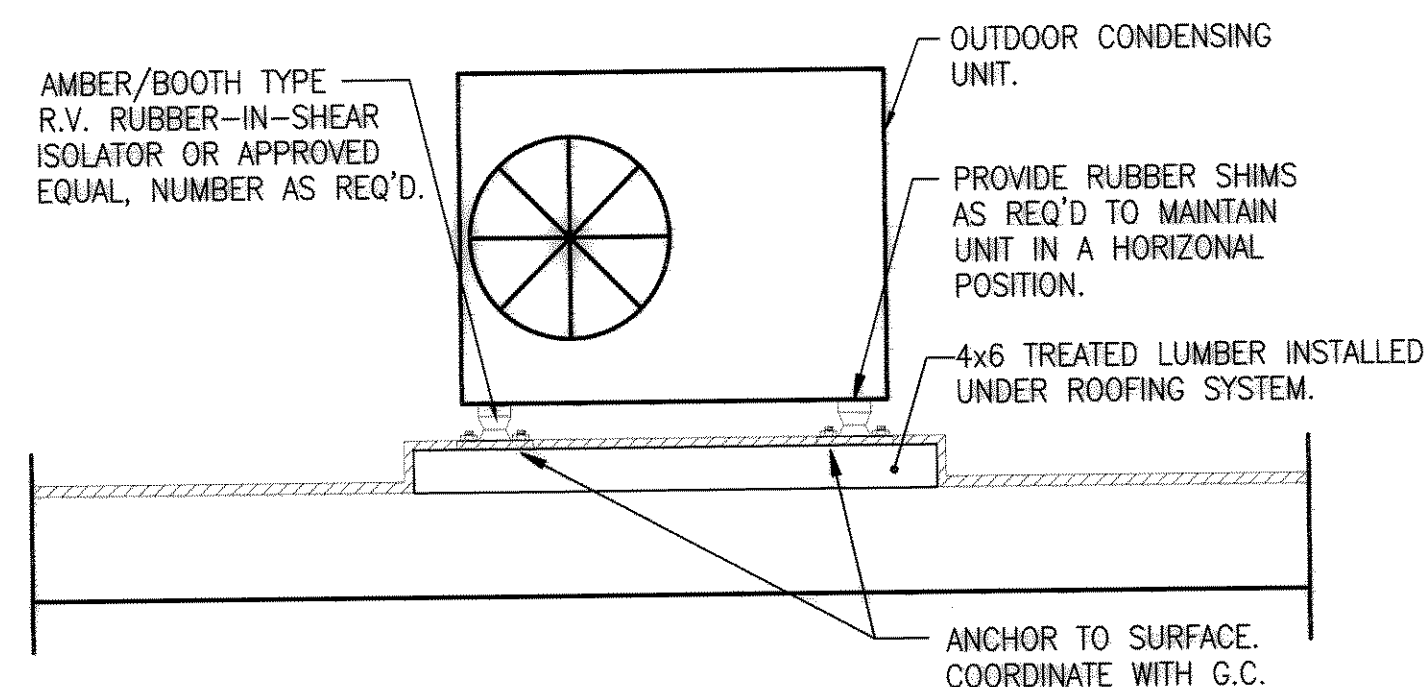


NOTE:
ALL PENETRATIONS INTO ROOF SHALL BE
SEALED WATER TIGHT.

CONDENSING UNIT MOUNTING DETAIL
NOT TO SCALE

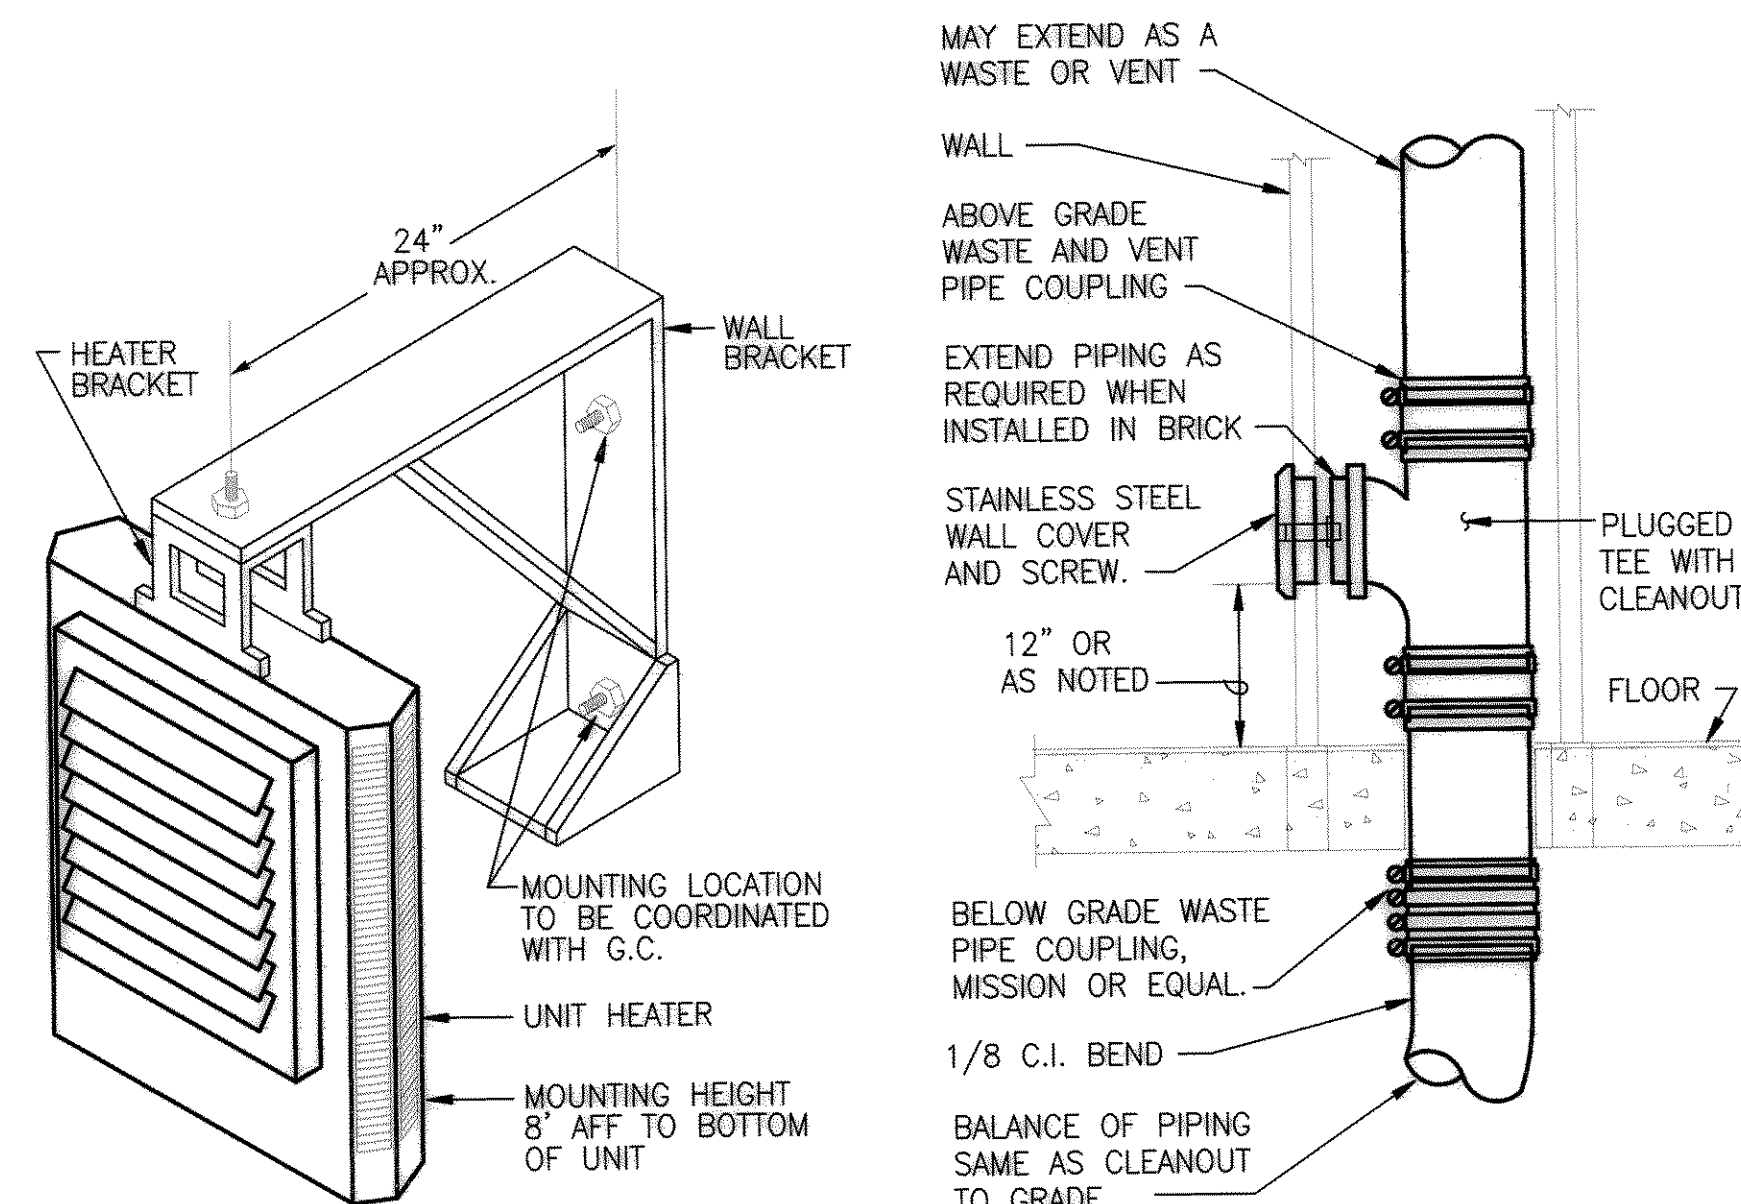


ELECTRIC UNIT HEATER INSTALLATION DETAIL NOT TO SCALE

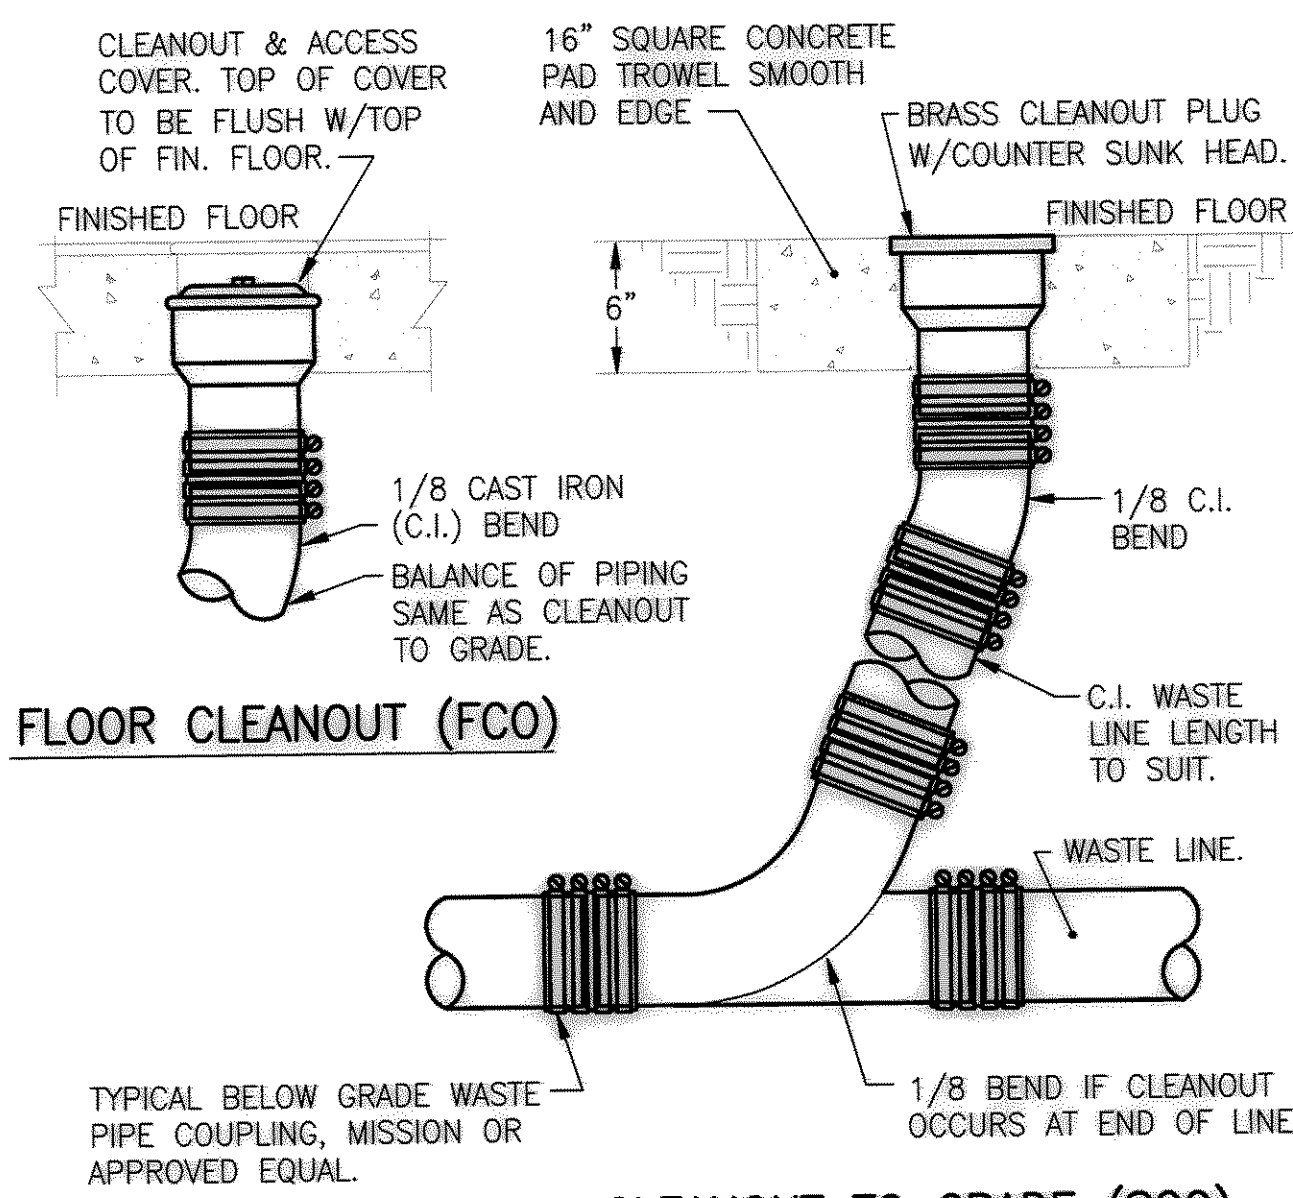


CLEANOUT DETAILS

DIAGRAMMATIC

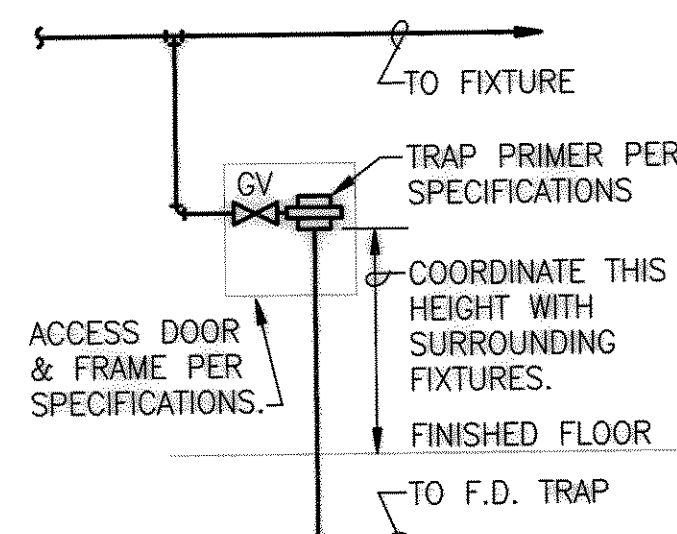


TRAP PRIMER
PIPING DIAGRAM
DIAGRAMMATIC

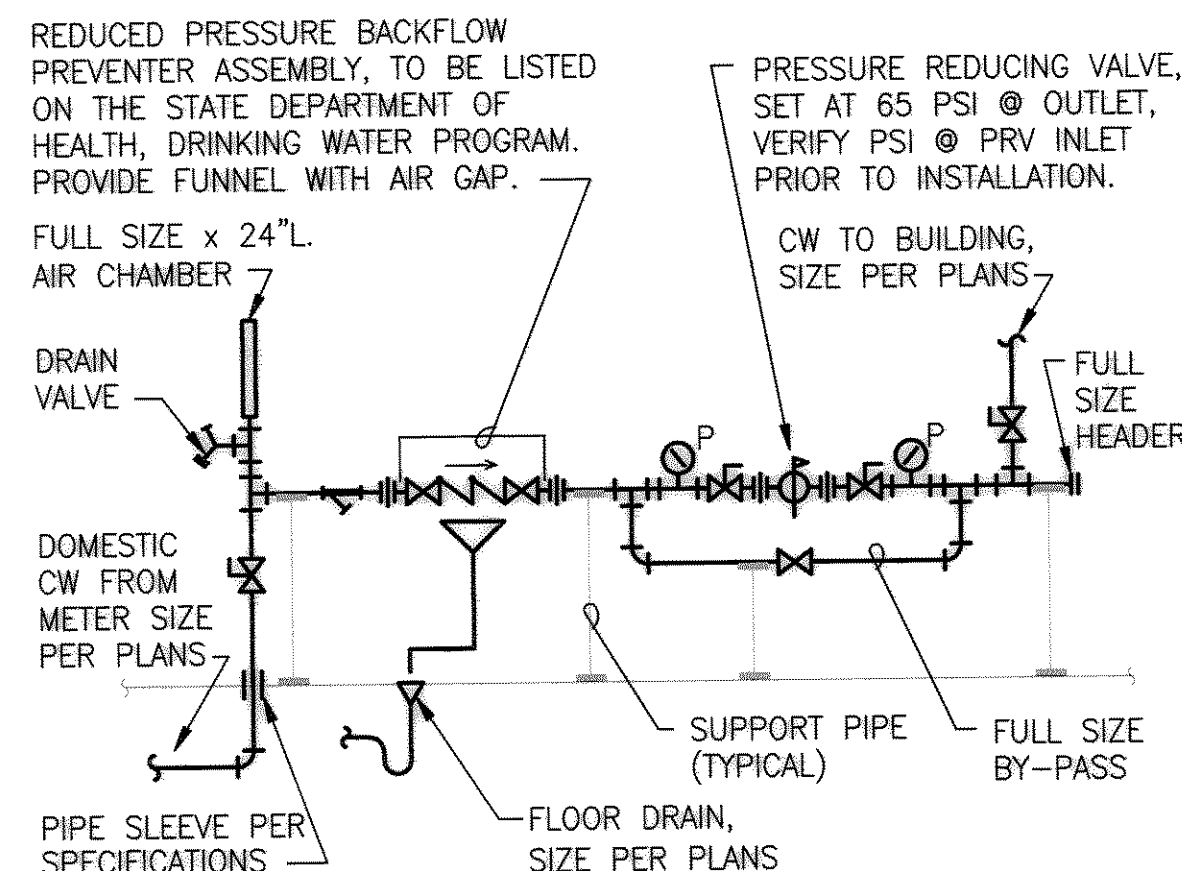

DOMESTIC WATER HEADER DETAIL

NO SCALE

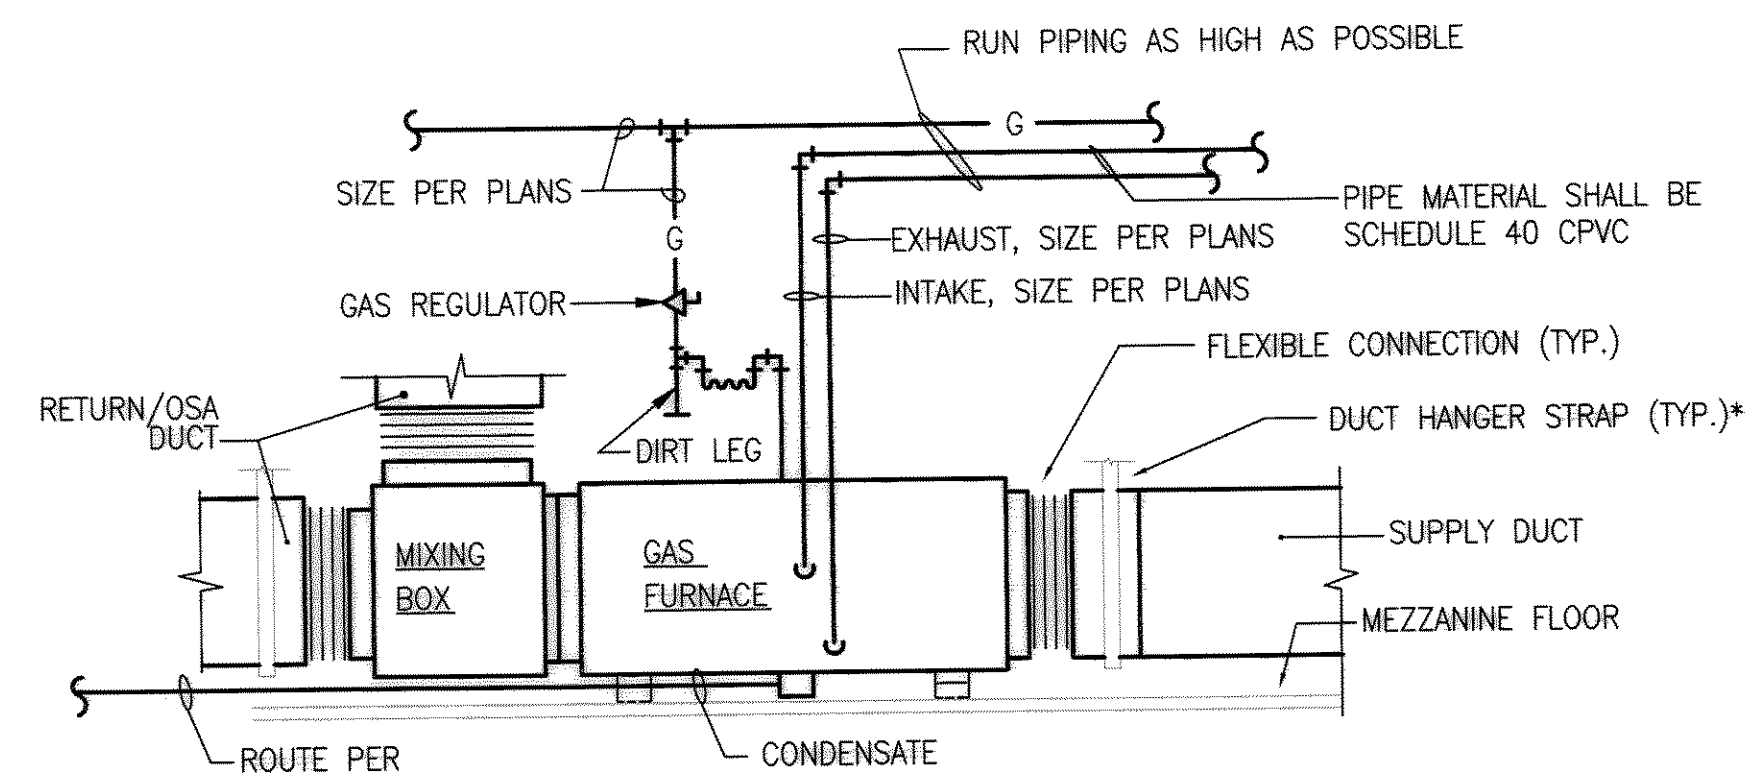


NOTE:
PROVIDE EARTHQUAKE PROOF SUPPORT

* INSTALL DUCT HANGER STRAP
ADJACENT TO FLEX. CONNECTION.

GAS FURNACE INSTALLATION DETAIL

BLE
ENGINEERS, INC.
6021 12TH STREET E, SUITE 200
TACOMA, WA 98424
(253) 922-0446 FAX (253) 922-0896

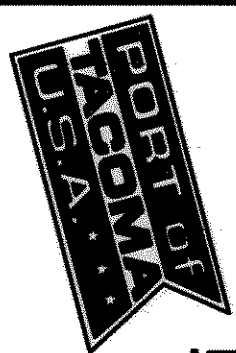

PORT OF TACOMA
TACOMA, WA 98401 253-883-8841
6021 12th Street East
Tacoma, WA 98424
Tel: 253.922.9037
Fax: 253.922.6499



DATE: 06/20/2025

BY: [Signature]

PROJECT: 15 OF 230

DATE: 06/20/2025

APPROVED

CHECKED BY - DATE

PROJECT ENGR.- DATE

PORT OF TACOMA
PIERCE COUNTY TERMINAL
LEGEND AND LIGHTING
FIXTURE SCHEDULE


EP-6664-17

E1.100

SHEET 15 OF 230

CONTRACT NUMBER: 988154
E NUMBER: E1974
DATE: 06/20/2025
PHASE: RECORD DRAWINGS

6321-17

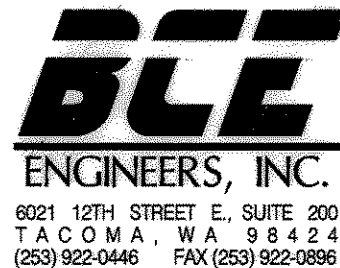

6021 12TH STREET E., SUITE 200
TACOMA, WA 98424
(253) 922-0446 FAX (253) 922-0808

GENERAL NOTES FOR LIGHTING FIXTURE SCHEDULE				
1. PROVIDE BALLASTS TO ACCOMMODATE DUAL LEVEL SWITCHING FOR ALL 3 AND 4 LAMP FIXTURES.				
2. SEE DRAWINGS FOR LOCATIONS AND QUANTITIES OF FIXTURES WITH EMERGENCY BATTERY PACKS.				
LIGHTING FIXTURE SCHEDULE				
SYMBOL	DESCRIPTION	LAMPS	VOLTS	MOUNTING & REMARKS
			WATTS	
AH1	KIM LTV10/NF/100MH120	(1) 100W MH	120 129	MOUNT IN GRADE AS SHOWN FOR ILLUMINATING FLAG.
AH2	KIM LTV10/SP/175MH120	(1) 175W MH	120 210	MOUNT IN GRADE AS SHOWN FOR ILLUMINATING FLAG.
AH3	GARDCO DF12-NSP-250MH-120-CH	(1) 250W MH	120V 300	MOUNT TO TOP OF CANOPY. MOUNT HOOD TO BOTTOM OF FIXTURE. ARCH. TO CHOOSE COLOR
AH4	GARDCO DF12-NSP-250MH-277-CH	(1) 250W MH	277V 300	MOUNT TO TOP OF CANOPY. MOUNT HOOD TO BOTTOM OF FIXTURE. ARCH. TO CHOOSE COLOR
AF1	PACE AGPM -6000-L-PLT32-277-O-TAL-WM/SHK	(1) 32W PLT	277V 37	CUSTOM MOUNT SHEPARDS HOOK ON 12' POLE. SEE ARCH MOUNTING DETAIL.
PF1	COLUMBIA KL4-232-EB8120	(2) 32W T8	120V 59	4' INDUSTRIAL STRIPLIGHT. PENDANT MOUNT AT 9'-0"
PF2	COLUMBIA KL4-232-EB8277	(2) 32W T8	277V 59	4' INDUSTRIAL STRIPLIGHT. PENDANT MOUNT AT 9'-0" AFF
PF3	ALERA ALS-2T8-20/80-CM-LD-EB8277-MW	(2) 32W T8	277V 59	PENDANT MOUNT AT 9'-0" AFF
PF4	ALERA ALS-3T8-20/80-CM-LD-EB8277-MW-HB/OB	(3) 32W T8	277V 86	PENDANT MOUNT AT 9'-0" AFF
PF5	COLUMBIA KL4-232-EB8120	(2) 32W T8	120V 59	CHAIN HUNG 4' INDUSTRIAL STRIPLIGHT. HANG FROM PLATFORM AT 8'-0" AFF
PH1	HUBBELL CH 32 W 4 M HG16	(1) 320W PS MH	277V 342	PENDANT MOUNT FIXTURE SO BOTTOM OF FIXTURE IS AT HEIGHTS INDICATED ON PLANS
PH2	HUBBELL CH 10 H 4 M HG22	(1) 1000W MH	277V 1080	PENDANT MOUNT FIXTURE SO BOTTOM OF FIXTURE IS AT HEIGHTS INDICATED ON PLANS
RF1	PRESCOLITE CFT832HEB-STF802H	(1) 32W PLT	120V 37	8" CAN RECESSED IN CEILING
RF2	COLUMBIA 4PS 24-232 G-FSA12-EB8120	(2) 32W T8	120V 59	2'x4' LAY IN TROFFER
RF3	COLUMBIA P424-332 G-LD36-S-3EB8120	(3) 32W T8	120V 86	2'x4' LAY IN PARABOLIC
RF4	PRESCOLITE CFT632HEB-STF602H	(1) 32W PLT	120V 37	6" CAN RECESSED IN CEILING
RF5	COLUMBIA P424-232 G-LD26-S-EB8120	(2) 32W T8	120V 59	2'x4' LAY IN PARABOLIC
RF6	COLUMBIA 4PS 24-332 G-FSA12-3EB8120	(3) 32W T8	120V 86	2'x4' LAY IN TROFFER
RF7	INFINITY PH60-132T-277-EB	(1) 32W PLT	277V 37	6" RECESSED CAN SHOWER FIXTURE. WET LOCATION
RF8	PRESCOLITE CFTD832HEB-STFD802H	(2) 32W PLT	120V 70	8" CAN RECESSED IN CEILING
RF9	PRESCOLITE CFT832HEB-STF802H	(1) 32W PLT	277V 37	8" CAN RECESSED IN CEILING
RF10	COLUMBIA 4PS 24-232 G-FSA12-EB8277	(2) 32W T8	277V 59	2'x4' LAY IN TROFFER
RF11	COLUMBIA P424-332 G-LD36-S-EB8277	(3) 32W T8	277V 86	2'x4' LAY IN PARABOLIC
RF12	PRESCOLITE CFT632HEB-STF602H	(1) 32W PLT	277V 37	6" CAN RECESSED IN CEILING
RF13	COLUMBIA P424-232 G-LD26-S-EB8277	(2) 32W T8	277V 59	2'x4' LAY IN PARABOLIC
RF14	COLUMBIA 4PS 24-332 G-FSA12-3EB8277	(3) 32W T8	277V 86	2'x4' LAY IN TROFFER
RF15	PRESCOLITE CFTD832HEB-STFD802H	(2) 32W PLT	277V 70	8" CAN RECESSED IN CEILING
SF1	COLUMBIA LU4-232-EB8277	(2) 32W T8	277V 59	SURFACE MOUNT IN LOCKER ROOMS
SF2	COLUMBIA KL4-232-EB8120	(2) 32W T8	120V 59	4' INDUSTRIAL STRIPLIGHT. SURFACE MOUNT.
SF3	LUMINAIRE ALV 84-232-10%-277-BK	(2) 32W T8	277V 59	SURFACE MOUNT IN STAIRWELL
SF4	COLUMBIA CS4-132-EB8120	(1) 32W T8	120V 32	SURFACE MOUNT UNDER STAIRWAY LANDING.
SF5	EXTERIEUR VERT LINEOS X 120V	(1) 28W T5	120V 32	SURFACE MOUNT UNDER EXTERIOR CANOPY. SEE ARCH. MOUNTING DETAIL.
SF6	COLUMBIA KL4-232-EB8277	(2) 32W T8	277V 59	4' INDUSTRIAL STRIPLIGHT. PROVIDE CUSTOM UNISTRUT MOUNTING BRACKET. MOUNT AT 9'-6" AFF.
SF7	LUMINAIRE ALV 84-132-10%-277-OP-BK-WET	(1) 32W T8	277V 32	SURFACE MOUNT IN EXTERIOR SOFFIT
SF8	COLUMBIA KL4-232-EB8277	(2) 32W T8	277V 59	4' INDUSTRIAL STRIPLIGHT.

ELECTRICAL LEGEND


SYMBOL	DESCRIPTION	SYMBOL	DESCRIPTION
LIGHTING		MISCELLANEOUS	
	RECESSED FLUORESCENT LIGHT FIXTURE	①	CONSTRUCTION NOTES
	SURFACE OR PENDANT MOUNT FLUORESCENT LIGHT FIXTURE (CIRCLE INDICATES RECESSED OR CONCEALED JUNCTION BOX)	W	W INDICATES WEATHERPROOF FOR ALL DEVICES, PROVIDE LOCKING COVER ON RECEPTACLES.
	WALL MOUNT H.I.D. LIGHT FIXTURE	SWITCHES	
	WALL MOUNT COMPACT FLUORESCENT LIGHT FIXTURE	\$	SINGLE POLE SWITCH
	SURFACE OR RECESSED H.I.D. OR COMPACT FLUORESCENT LIGHT FIXTURE	\$OS	COMBINATION SWITCH / OCCUPANCY SENSOR
	SURFACE OR PENDANT MOUNT STRIP LIGHT (CIRCLE INDICATES RECESSED OR CONCEALED JUNCTION BOX)	\$3	THREE WAY SWITCH
	FIXTURE WITH EMERGENCY BATTERY PACK	a \$ \$ b	MULTI-GANGED SWITCH (LOWER CASE LETTERS INDICATES SWITCHING)
	EXIT LIGHT FIXTURE (PROVIDE DIRECTION ARROWS AS INDICATED)	Ⓜ	PHOTOCELL CONTROL
	WALL MOUNTED EXIT LIGHT FIXTURE (PROVIDE DIRECTION ARROWS AS INDICATED)	Ⓢ	TIME CLOCK CONTROL
	EMERGENCY BATTERY PACK WITH TWIN HEAD FLOOD	Ⓢ	OCCUPANCY SENSOR (LIGHTING CONTROL)
RECEPTACLES		EQUIPMENT AND WIRING	
	DUPLEX RECEPTACLE (E INDICATES EXISTING TO BE REPLACED)		CONDUIT STUB OUT (PROVIDE CONCRETE MARKER ON EXTERIOR)
	DUPLEX RECEPTACLE (G INDICATES GROUND FAULT CIRCUIT INTERRUPTER AT +45")		HOMERUN TO PANEL & CIRCUIT NUMBERS AS INDICATED ON PLANS
	DUPLEX RECEPTACLE (C INDICATES ABOVE COUNTER)		RACEWAY CONCEALED IN WALL OR CEILING
	COMPUTER RECEPTACLE WITH ISOLATED GROUND, DUPLEX OR FOURPLEX AS INDICATED		RACEWAY CONCEALED UNDERGROUND OR UNDER FLOOR SLAB, P = PRIMARY , S = SECONDARY
	FOURPLEX RECEPTACLE		MARKS INDICATE NUMBER OF #12 AWG UNLESS NOTED OTHERWISE
	FLOOR MOUNTED COMBINATION FOURPLEX ISOLATED GROUND RECEPTACLE, DATA & TELEPHONE JUNCTION BOX		GROUNDING CONDUCTOR
	SPECIAL PURPOSE OUTLET - 3Ø, VOLTAGE AND AMPERES AS INDICATED		FLEXIBLE CONDUIT
FIRE ALARM SYSTEM			GROUNDING SYSTEM PER CODE
②	SMOKE DETECTOR WITH BASE (C INDICATES WITH ELEVATOR RECALL CONTACT) (D INDICATES DUCT DETECTOR)	①	JUNCTION BOX - SIZE PER CODE (F INDICATES FIRE ALARM SYSTEM)
①	HEAT DETECTOR - RATE OF RISE AND FIXED TEMPERATURE TYPE(F INDICATES FIXED ONLY) (RC INDICATES RATE COMPENSATION TYPE)(R INDICATES RATE OF RISE ONLY)		MOTOR CONNECTION (D INDICATES FIRE/SMOKE DAMPER)
	PULL STATION - MOUNT AT +48" AFF	\$M	MANUAL STARTER
	COMBINATION HORN/STROBE - MOUNT AT +80" AFF OR 6" BELOW CEILING, WHICHEVER IS LOWER (L INDICATES LOW TAP)		DISCONNECT SWITCH
	STROBE ONLY - MOUNT AT +80" AFF OR 6" BELOW CEILING, WHICHEVER IS LOWER		FUSED DISCONNECT SWITCH
	FIRE ALARM CONTROL PANEL		COMBINATION DISCONNECT / MAGNETIC MOTOR STARTER
	FIRE ALARM NETWORK CONTROL ANNUNCIATOR PANEL		277/480 VOLT PANELBOARD
	REMOTE INDICATOR LAMP, MOUNT AT +96" AFF		MAIN DISTRIBUTION BOARD
	ALARM BELL		TRANSFORMER
	PRESSURE SWITCH		PUSH-BUTTON CONTROLLER
	OS&Y TAMPER SWITCH		ENCLOSED CIRCUIT BREAKER, AMPERES AS INDICATED
COMMUNICATION SYSTEM			HANDHOLE
	COMMUNICATION / DATA JUNCTION BOX (4/S BOX WITH SINGLE GANG MUDRING AND COVER PLATE) 3/4"C. TO ACCESSIBLE CEILING SPACE (F INDICATES FOR FIRE ALARM)		UNINTERRUPTABLE POWER SUPPLY
	TELEPHONE JUNCTION BOX (4/S BOX AT +48" WITH SINGLE GANG MUDRING AND COVER PLATE) 3/4"C. TO ACCESSIBLE CEILING SPACE OR AS NOTED ON PLAN.		MECHANICAL EQUIPMENT CONNECTION SYMBOL. REFER TO THE MECHANICAL EQUIPMENT CONNECTION SCHEDULES FOR CONNECTION REQUIREMENTS.
	TELEPHONE BACKBOARD. SEE DETAIL ON SHEET E1.105		

SF9	LUMINAIRE ALV 84-232-10%-120-BK	(2) 32W T8	120V 59	SURFACE MOUNT IN STAIRWELL
WF1	COLUMBIA W4-132-EB8120	(1) 32W T8	120V 32	WALL MOUNT ABOVE MIRROR
WF2	COLUMBIA CS4-132-EB8120-CSWG4	(1) 32W T8	120V 32	WALL MOUNT IN ELEVATOR PIT. PROVIDE LAMP GUARD AND WIRE GUARD.
WF3	LUMINIS NT645DL F126 120	(1) 26W PLT	120V 28	WALL MOUNT SO TOP OF FIXTURE IS EVEN WITH TOP OF DOOR FRAME, UNLESS NOTED OTHERWISE. ARCHITECT TO CHOOSE COLOR.
WF4	COLUMBIA W4-132-EB8277	(1) 32W T8	277V 32	WALL MOUNT ABOVE MIRROR
WF5	LUMINIS NT645DL F126 277	(1) 26W PLT	277V 28	WALL MOUNT SO TOP OF FIXTURE IS EVEN WITH TOP OF DOOR FRAME, UNLESS NOTED OTHERWISE. ARCHITECT TO CHOOSE COLOR.
WF6	PACE AGPM -6000-L-PLT32-120-O-TAL-WM/SHK	(1) 32W PLT	120V 37	WALL MOUNT SO BOTTOM OF FIXTURE IS AT HEIGHTS INDICATED ON PLANS. PROVIDE SHEPARDS HOOK
WH1	KIM WD18UG/250MH277/BL-P	(1) 250W MH	277V 300	WALL MOUNT
EM1	PRESCOLITE ET4-277V-NB-ESHLF	(2) 12W PAR 36	277V 60W	EMERGENCY LIGHTS. PROVIDE WITH MOUNTING SHELF MOUNT @ 12' ABOVE FINISHED FLOOR
EX1	PATHWAY XG	INCLUDED	DUAL <5	UNIVERSAL MOUNT, DUAL VOLTAGE EXIT LIGHT FIXTURE.

MECHANICAL EQUIPMENT CONNECTION SCHEDULE (MAKE-UP AIR HANDLING UNIT)										
EQUIP.	VOLT/PH	LOAD			CIRCUIT		CONDUIT/WIRE SIZE	STARTER FURNISHED BY	DISCONNECT FURNISHED BY	REMARKS
		KVA	MCA	HP	PANEL	BKR				
MUA-5A	460/3	17.5		15	5H2	19,21,23	3/4" (4) #10AWG	MFR	E.C.	
MUA-5B	460/3	17.5		15	5H2	13,15,17	3/4" (4) #10AWG	MFR	E.C.	
MUA-6C	460/3	6.3		5	5H6	13,15,17	1/2" (4) #12AWG	MFR	E.C.	

MECHANICAL EQUIPMENT CONNECTION SCHEDULE (HOT WATER WASH SYSTEM)										
EQUIP.	VOLT/PH	LOAD			CIRCUIT		CONDUIT/WIRE SIZE	STARTER FURNISHED BY	DISCONNECT FURNISHED BY	REMARKS
		KVA	MCA	HP	PANEL	BKR				
HW-6A	480/3	17.5	42.7	15	6H1	1,3,5	1" C. (4) #6AWG	MFR	E. C.	
HW-6B	480/3	17.5	42.7	15	6H2	1,3,5	1" C. (4) #6AWG	MFR	E. C.	
HW-6C	480/3	17.5	42.7	15	6H2	2,4,6	1" C. (4) #6AWG	MFR	E. C.	

MECHANICAL EQUIPMENT CONNECTION SCHEDULE (WATER RECYCLE SYSTEM)										
EQUIP.	VOLT/PH	LOAD			CIRCUIT		CONDUIT/WIRE SIZE	STARTER FURNISHED BY	DISCONNECT FURNISHED BY	REMARKS
		VA	MCA	HP	PANEL	BKR				
WRS-6A	208/1	4992	30		6P2	7.9	1/2" C. (3) #10AWG			
WRS-6B	208/1	4992	30		6P1	7.9	1/2" C. (3) #10AWG			
WRS-6C	208/1	4992	30		6P1	11.13	1/2" C. (3) #10AWG			

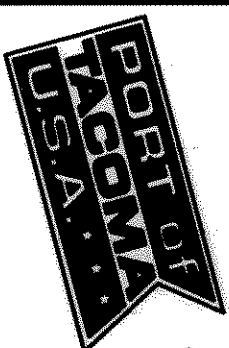

PORT OF TACOMA P.O. BOX 1837
TACOMA, WA 98401 253-383-6841
6021 12th street, suite 200
tacoma, wa 98424
tel: 253 . 922 . 9037
fax: 253 . 922 . 6499



Holtz
6021 12th street, suite 200
tacoma, wa 98424
tel: 253 . 922 . 9037
fax: 253 . 922 . 6499

MARK	REVISION
RECORD DRAWINGS	

APPROVED

CHIEF ENGINEER - DATE

CHECKED BY - DATE

PROJECT ENGR. - DATE


PORT OF TACOMA
PIERCE COUNTY TERMINAL
LIGHTING CONTROL DIAGRAMS

EP-6664-17
E1.102
SHEET 17 OF 230

DRAWING DATE: TOWNSHIP: RANGE: SECTION:
PORT ADDRESS: DATUM: HORIZ: VERT:
PORT PARCEL: DRAWING SCALE: NONE

CONTRACT NUMBER: 998154
E. NUMBER: E1974
PHASE: RECORD DRAWINGS





6321-17

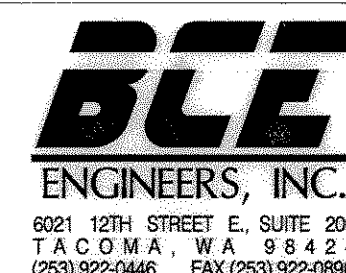


6021 12TH STREET E., SUITE 200
TACOMA, WA 98424
(253) 922-0446 FAX (253) 922-0885


GENERAL NOTE

1. DEPENDING ON TIMECLOCK SETTINGS AND POSITION OF BYPASS SWITCH, LIGHTING MAY BE CONTROLLED DIRECTLY BY PHOTOCELL, TIMECLOCK, OR "ON" BY PHOTOCELL, "OFF" BY TIMECLOCK.

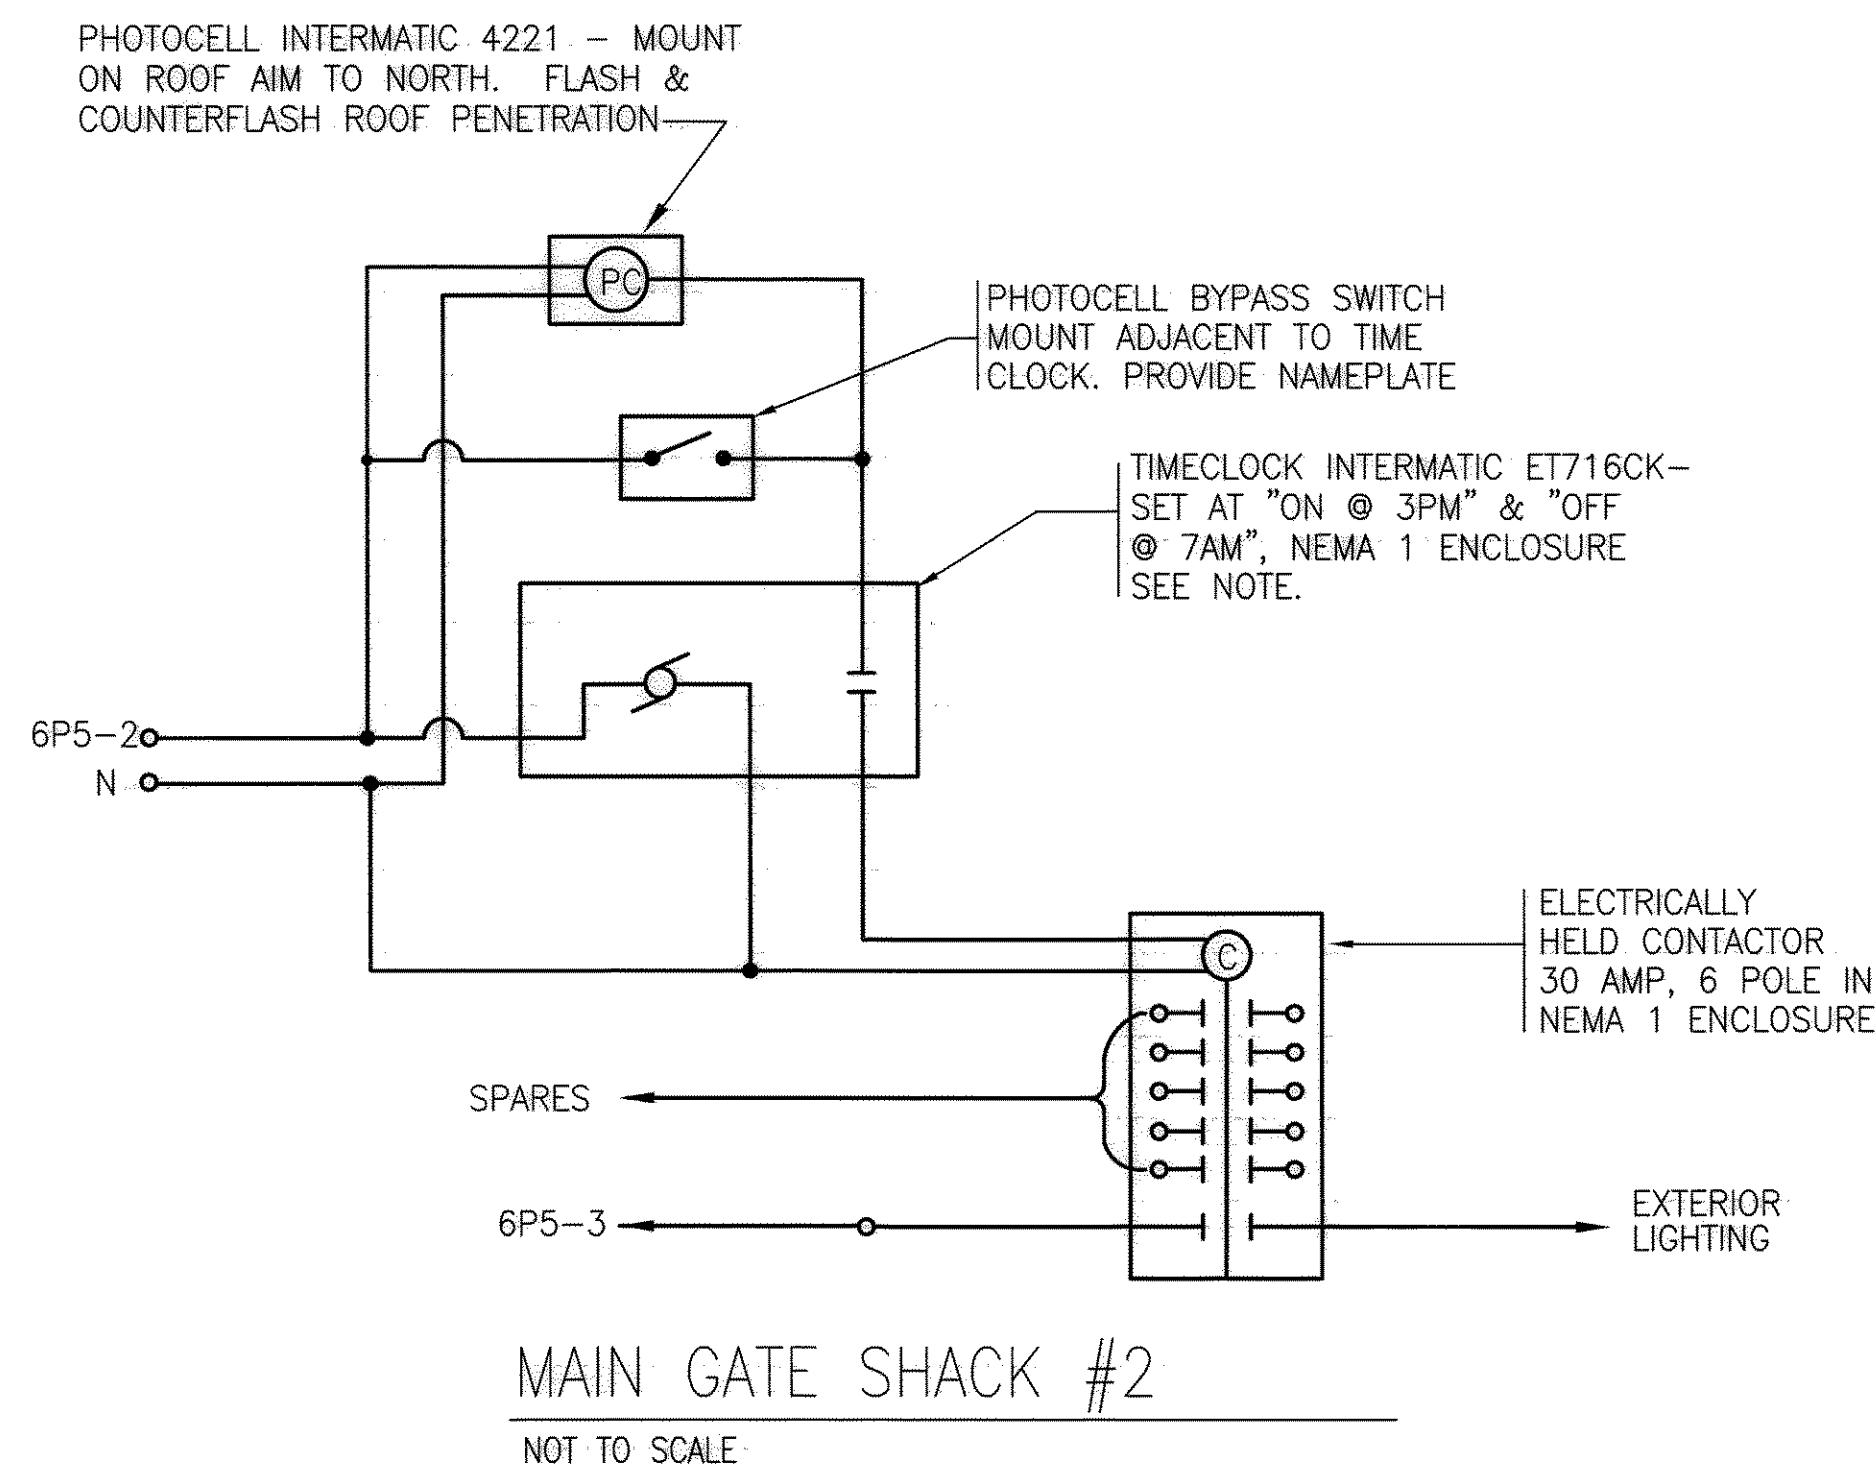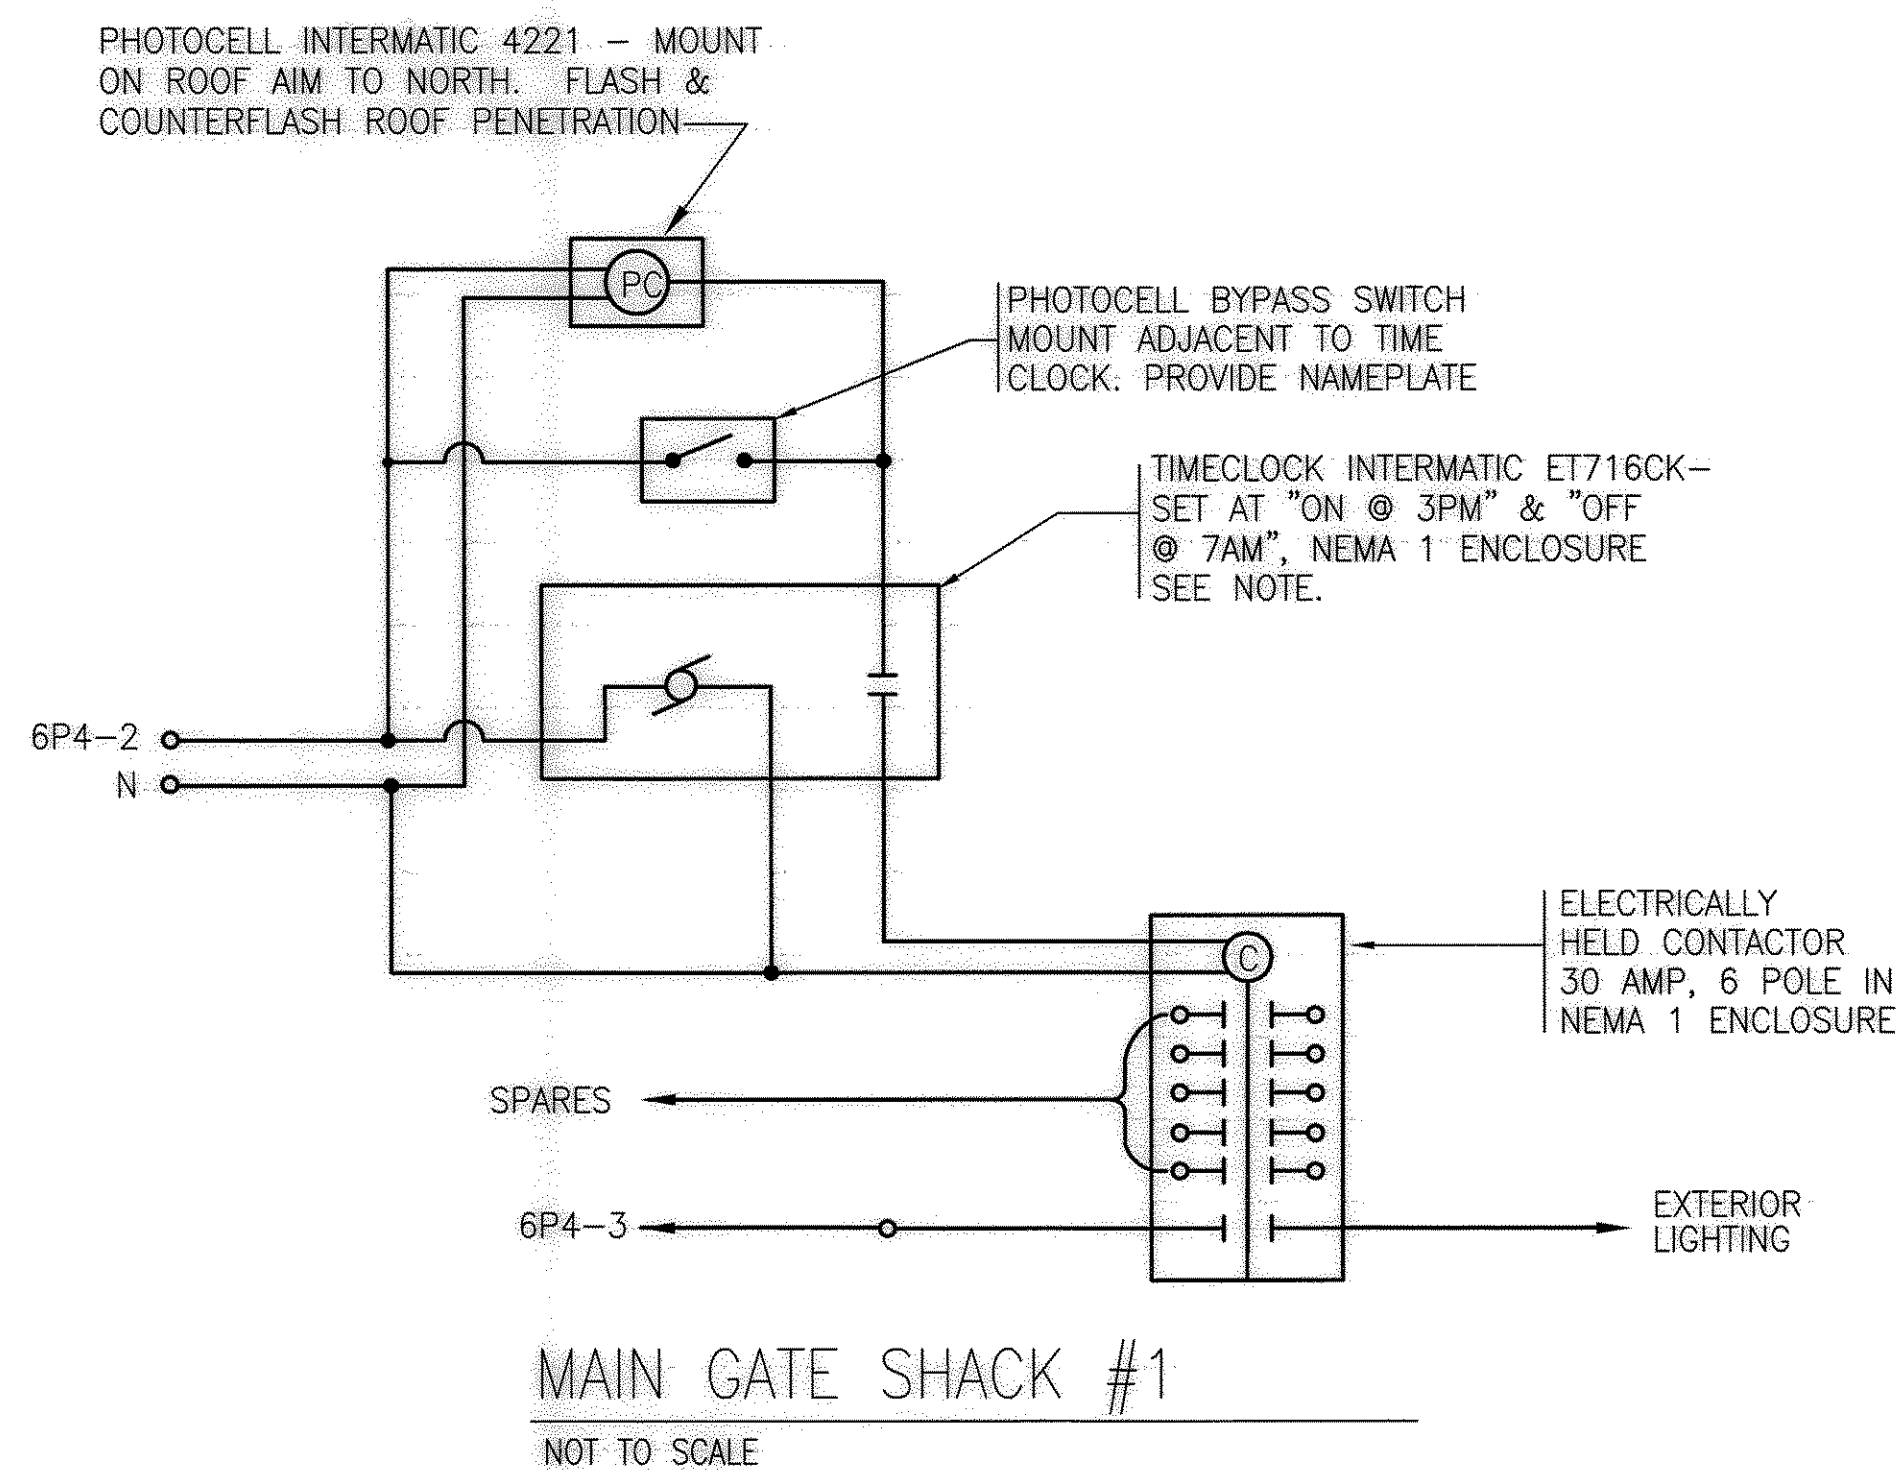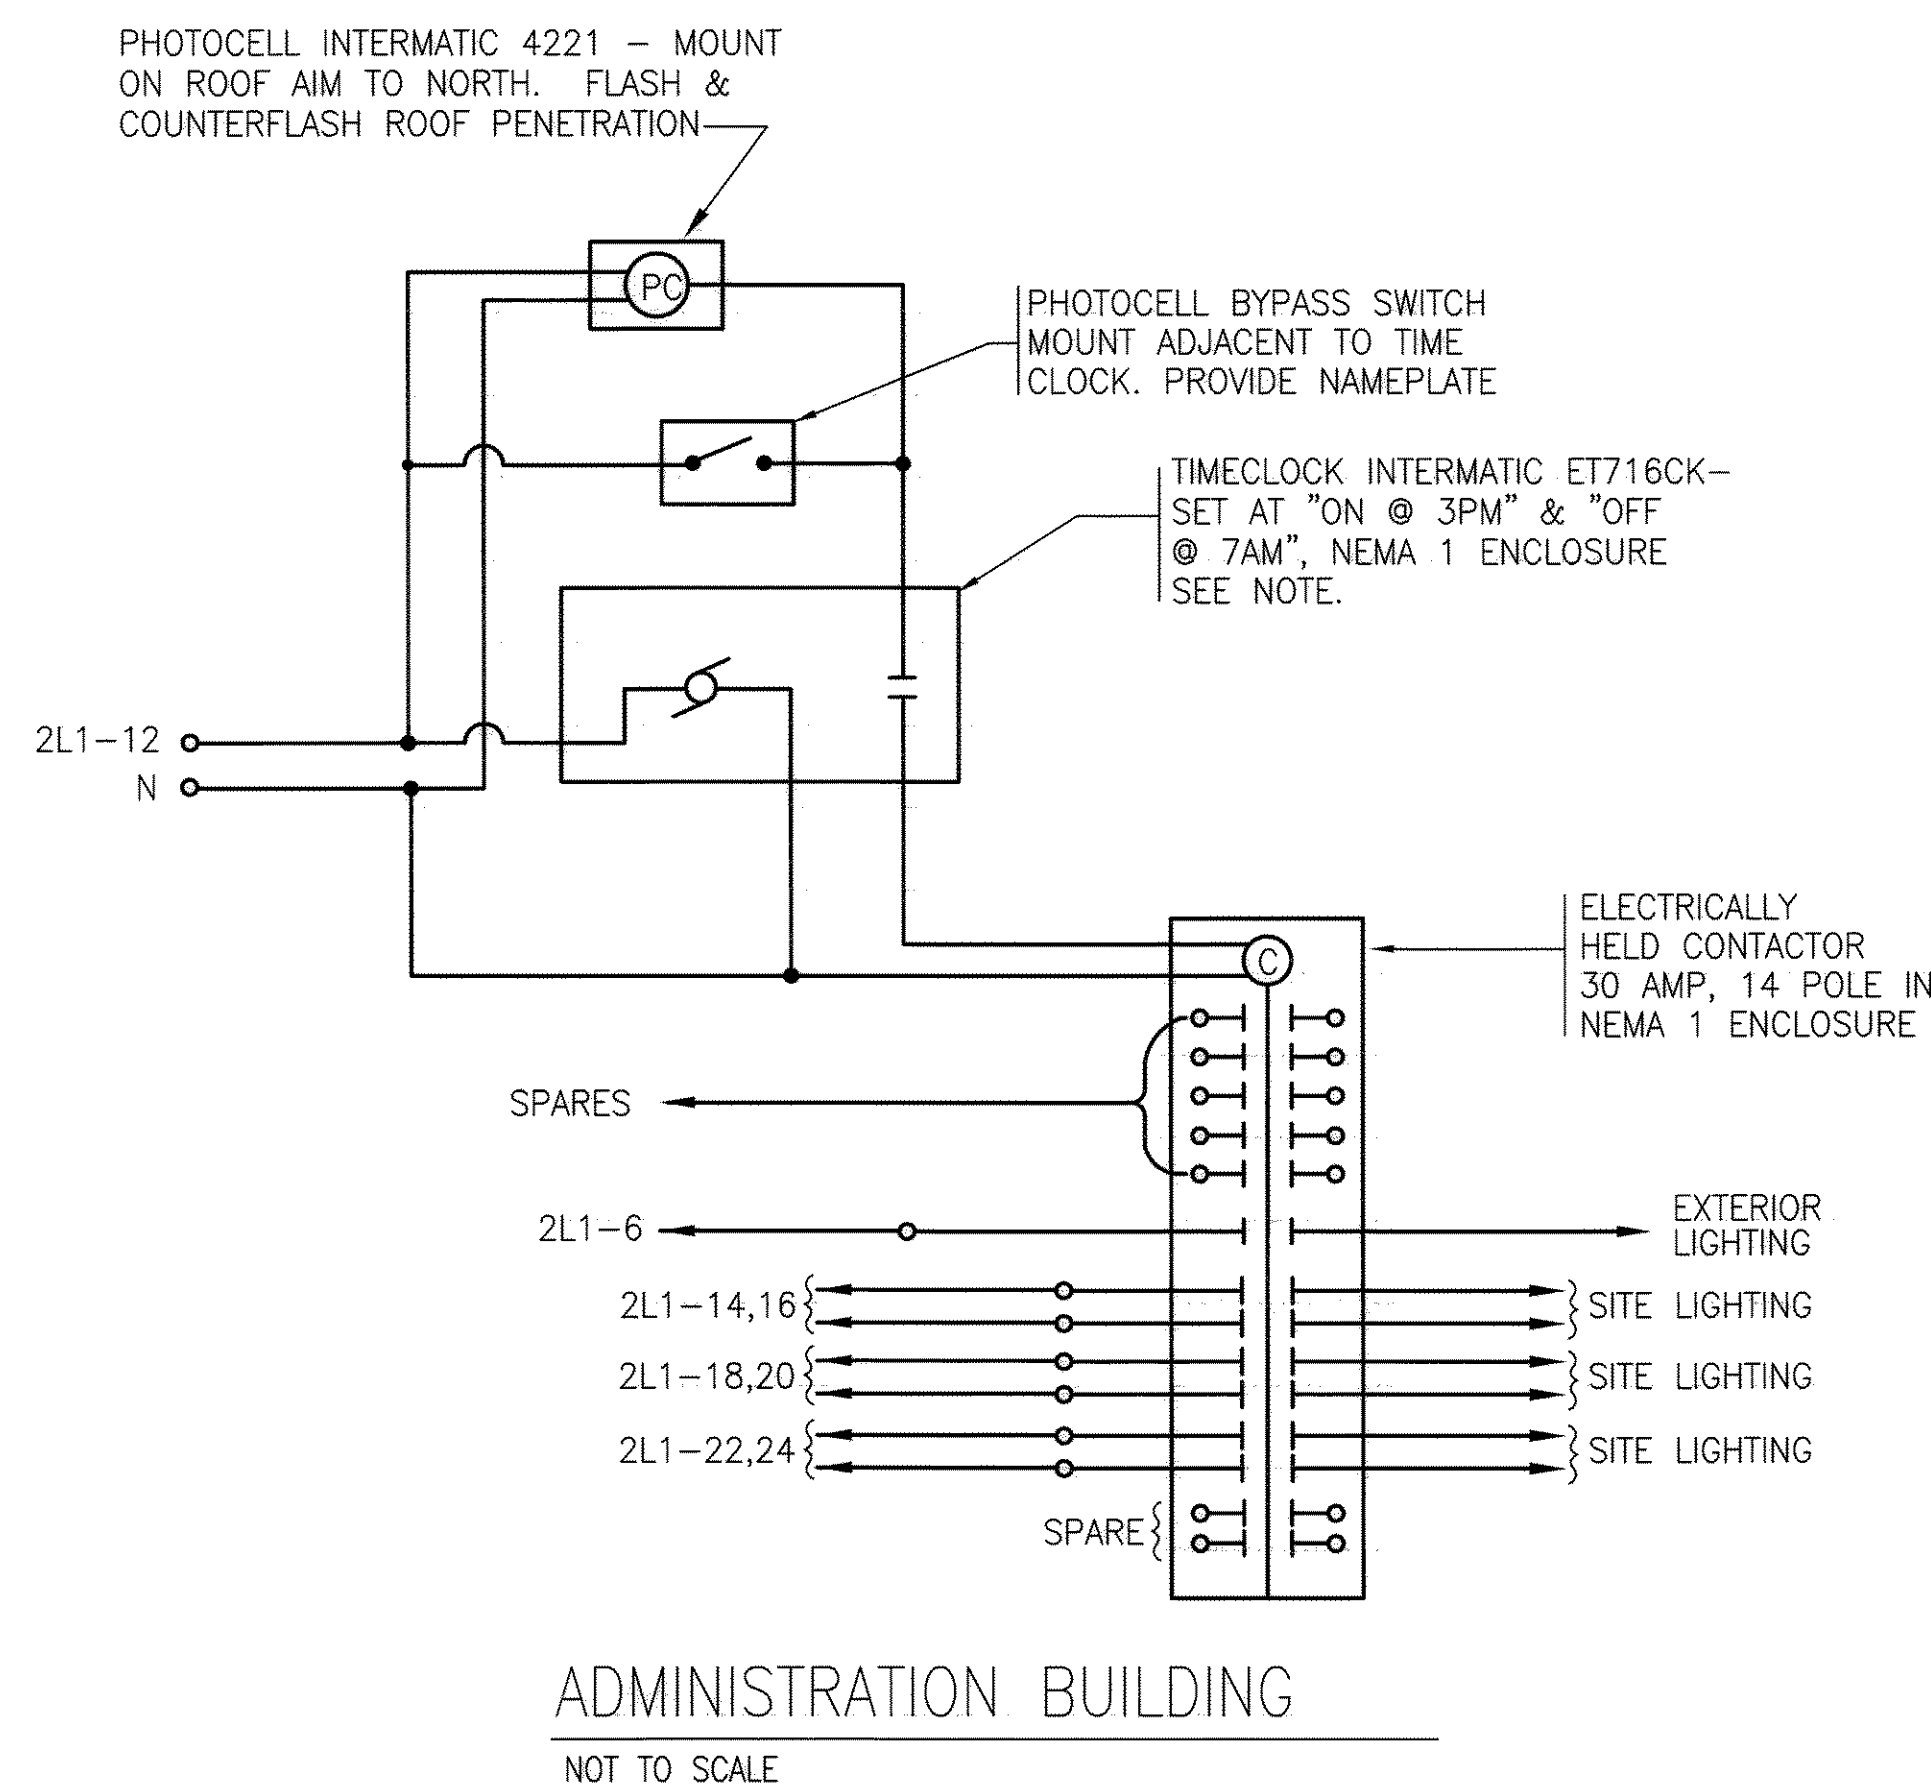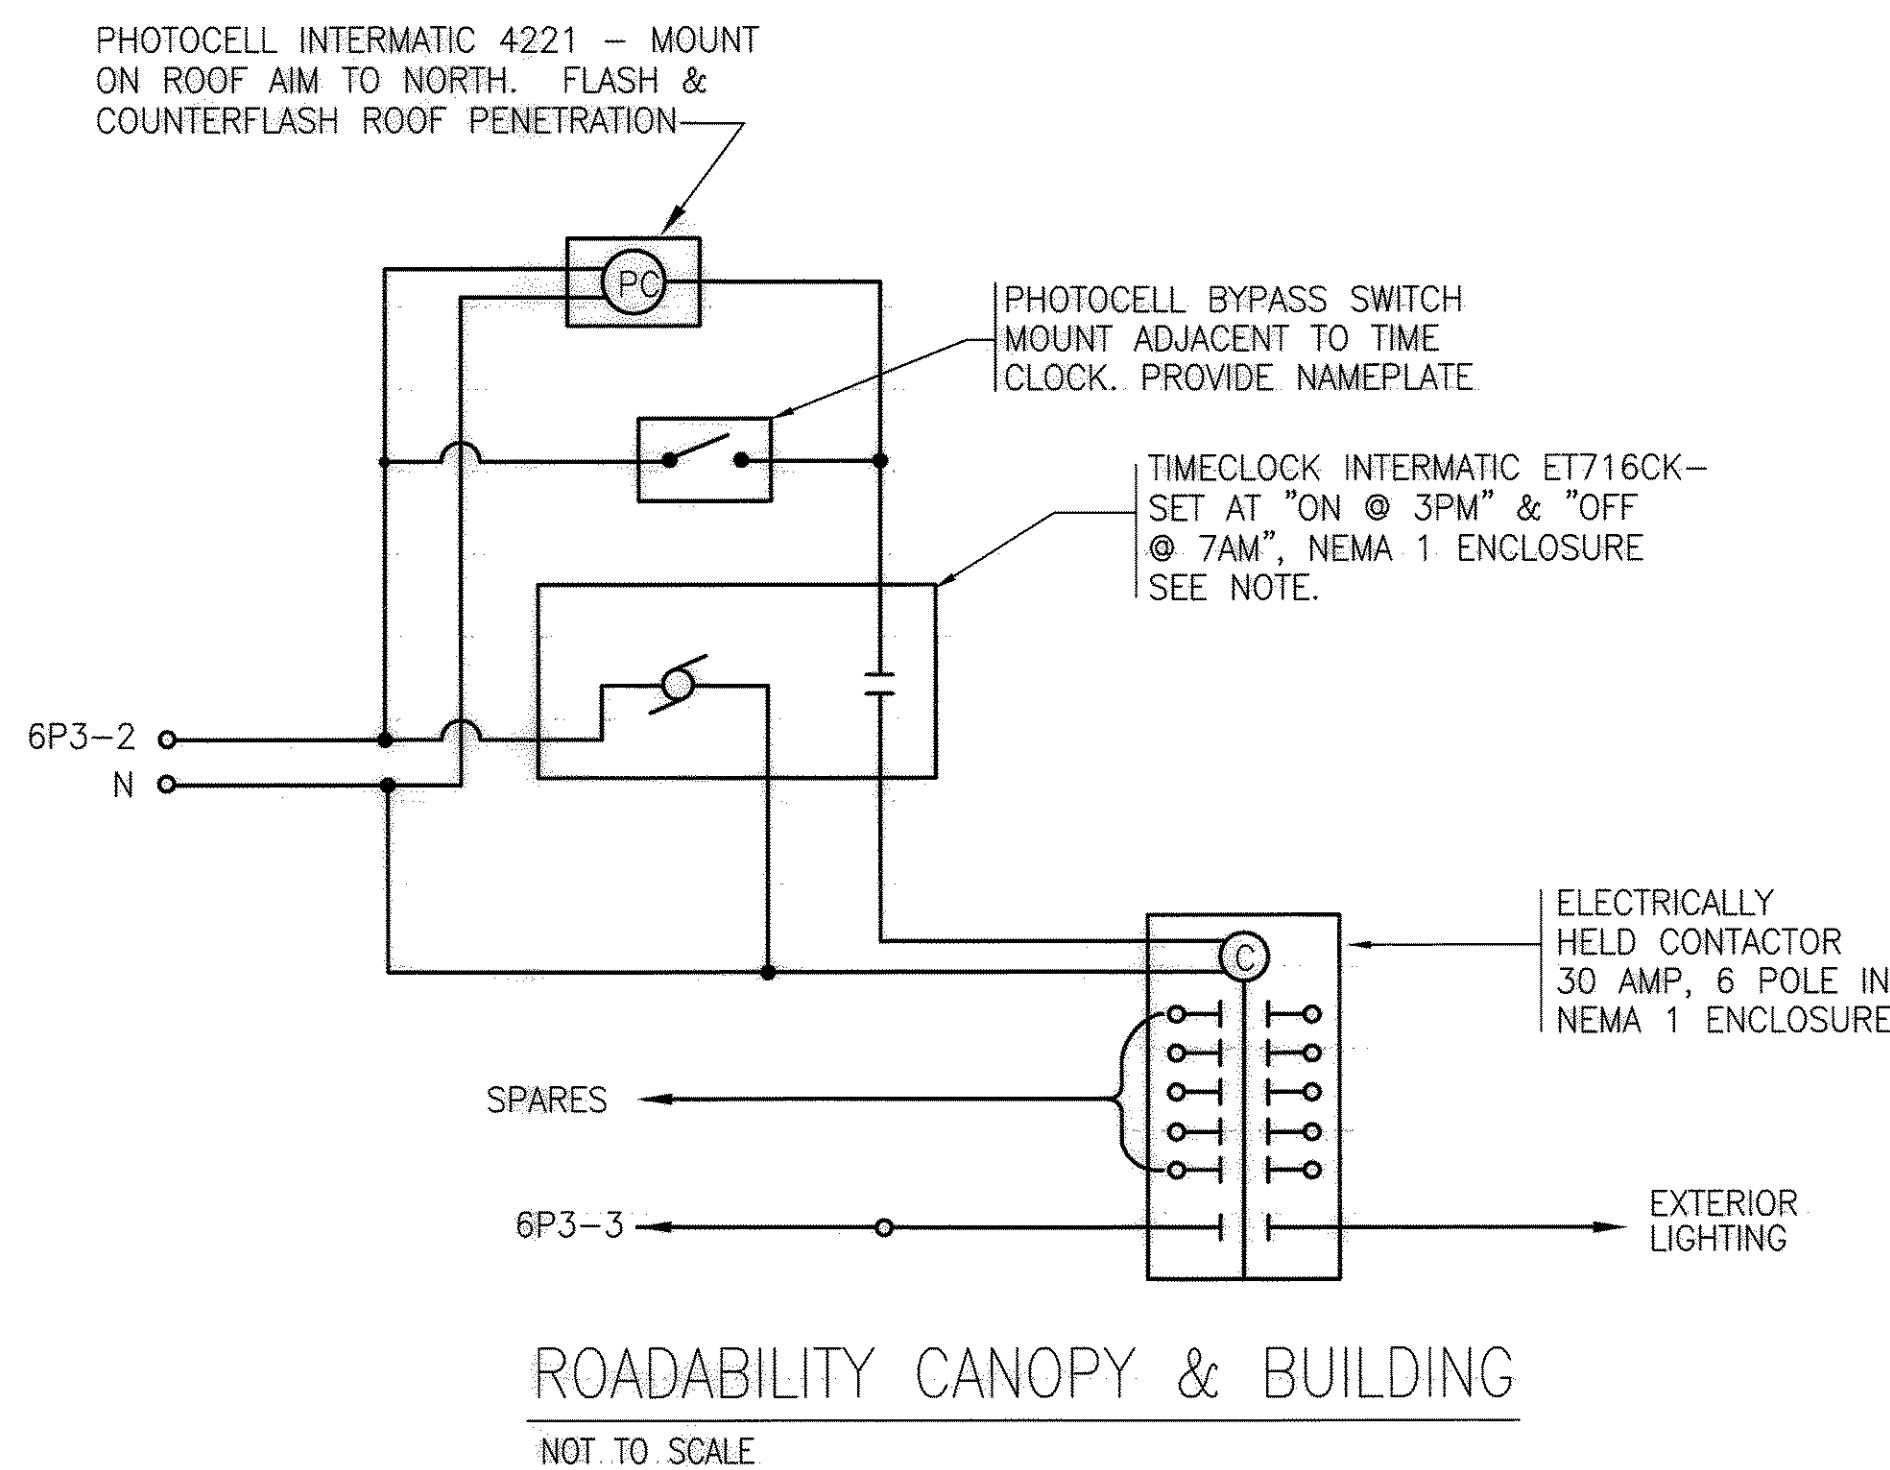

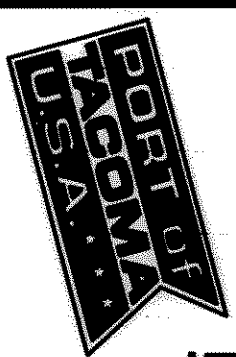

PORT OF TACOMA P.O. BOX 1837
TACOMA, WA 98401 253-383-5841

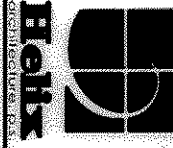

6021 12th Street east
Suite 200
Tacoma, WA 98401
Tel: 253.922.9034
Fax: 253.922.4499

DATE	REVISION	BY	DATE
RECORD	DATE		

APPROVED

CHIEF ENGINEER - DATE

CHECKED BY - DATE

PROJECT ENGR - DATE

PORT OF TACOMA
PIERCE COUNTY TERMINAL
LIGHTING CONTROL DIAGRAMS

EP-5664-17

E1.103


SHEET 18 OF 230

CONTRACT NUMBER: 988134

DATE: 10/97

PHASE: RECORD DRAWINGS


6321-17

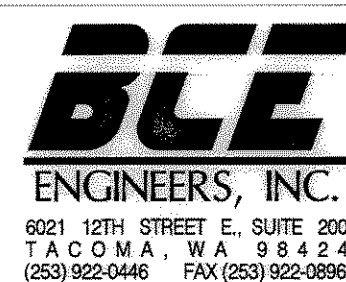

6021 12TH STREET E., SUITE 200
TACOMA, WA 98404
(253) 922-0446 FAX (253) 922-3995


GENERAL NOTE

1. DEPENDING ON TIMECLOCK SETTINGS AND POSITION OF BYPASS SWITCH, LIGHTING MAY BE CONTROLLED DIRECTLY BY PHOTOCELL, TIMECLOCK, OR "ON" BY PHOTOCELL, "OFF" BY TIMECLOCK.

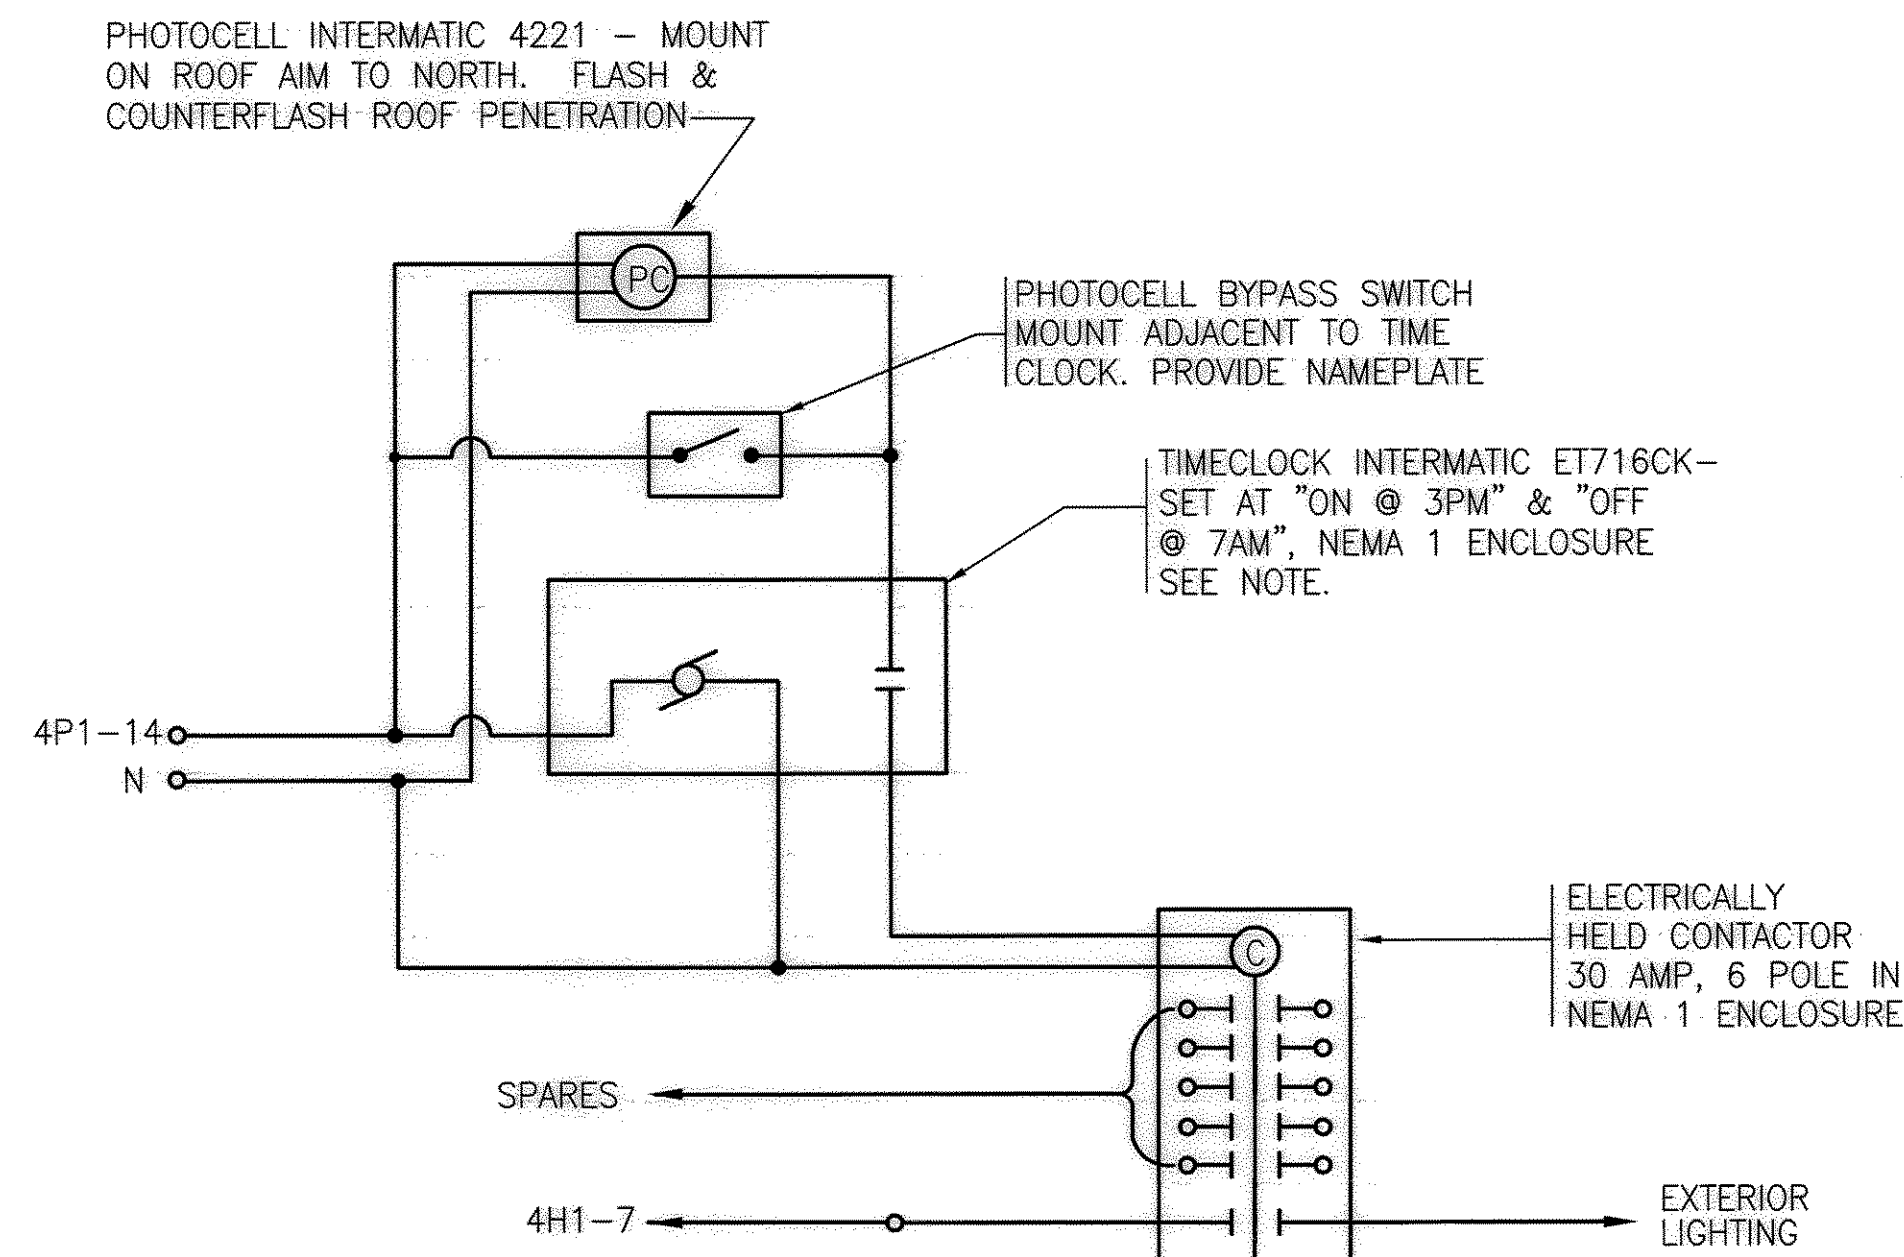


GENERATOR SHOP

NOT TO SCALE

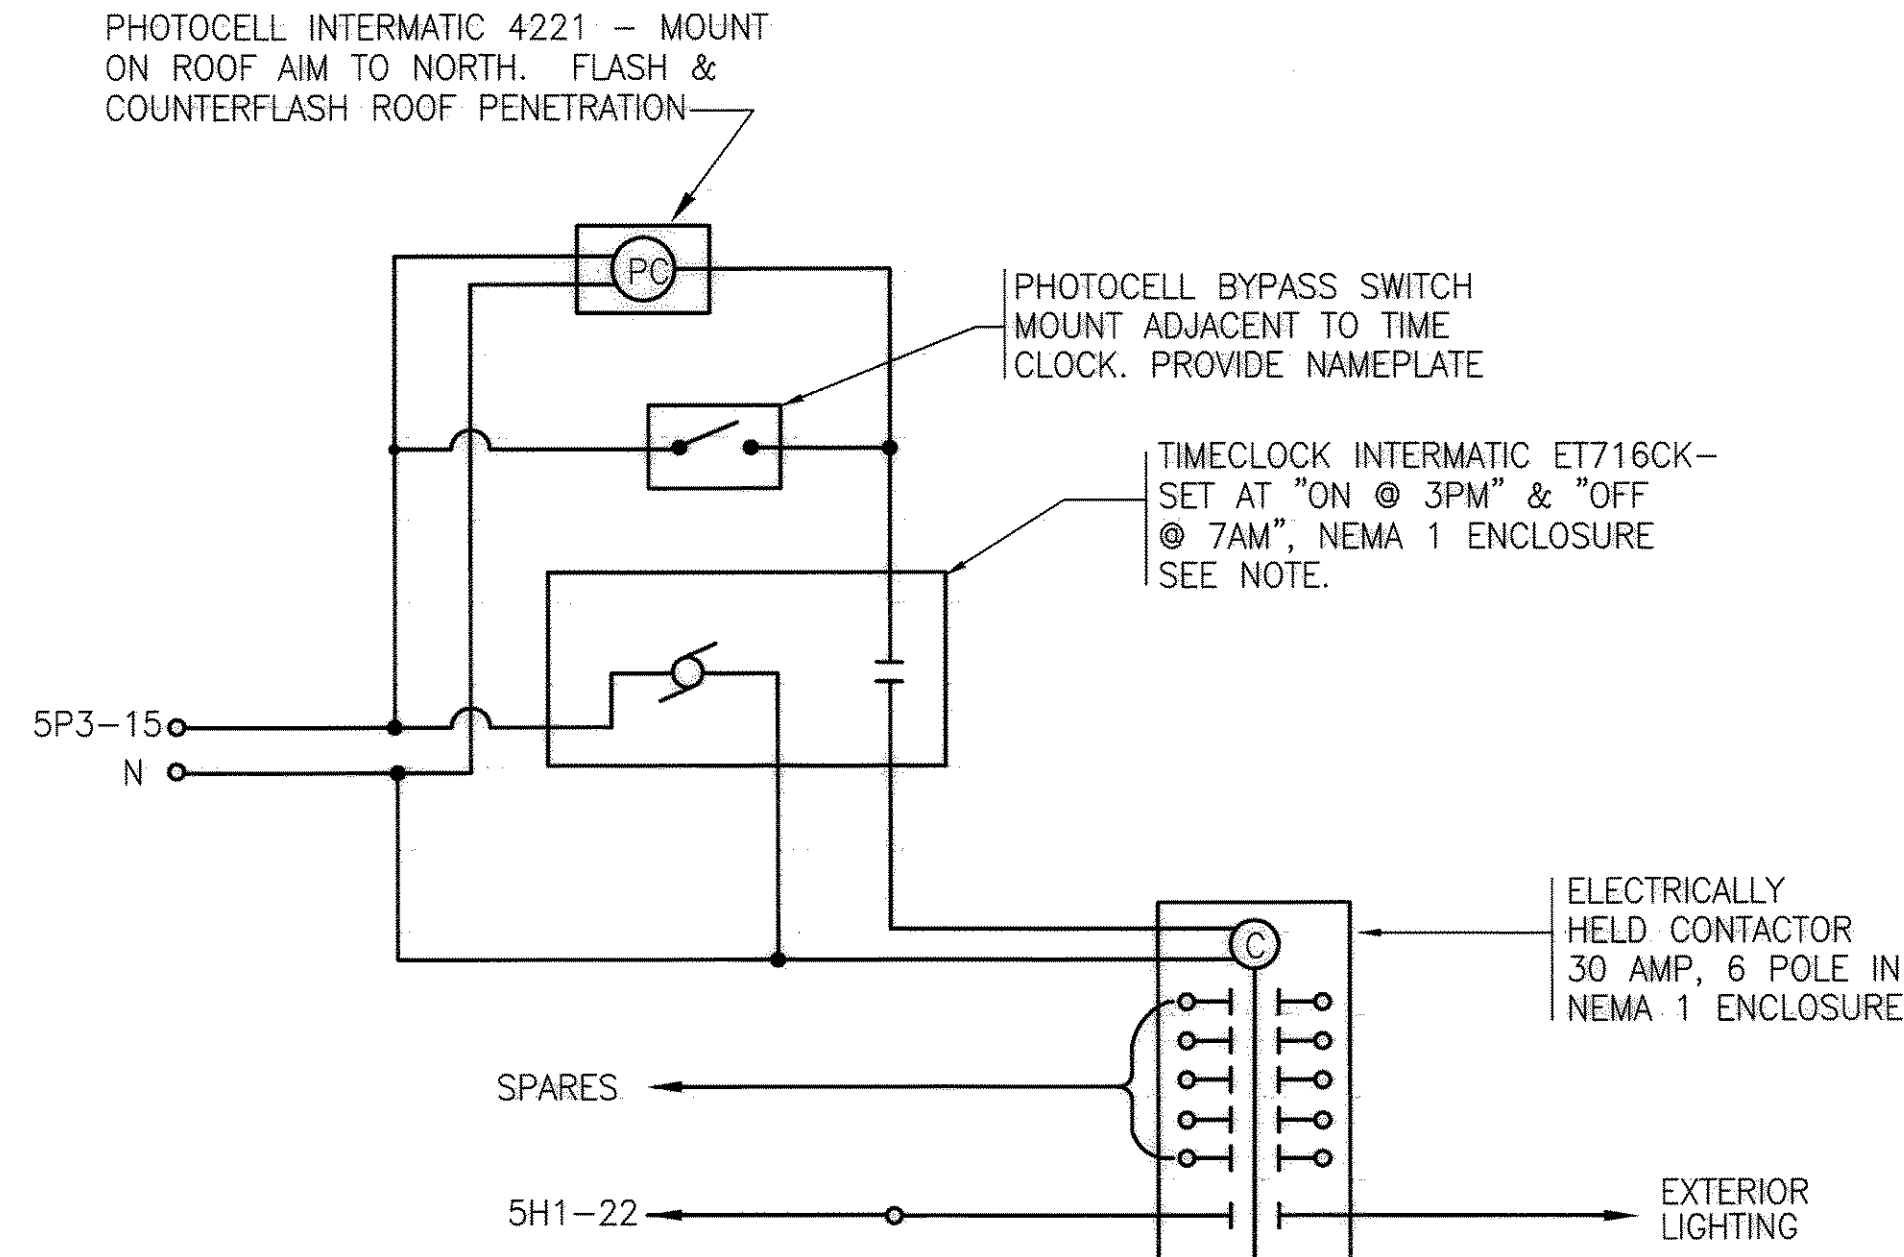


MAINTENANCE BUILDING

NOT TO SCALE

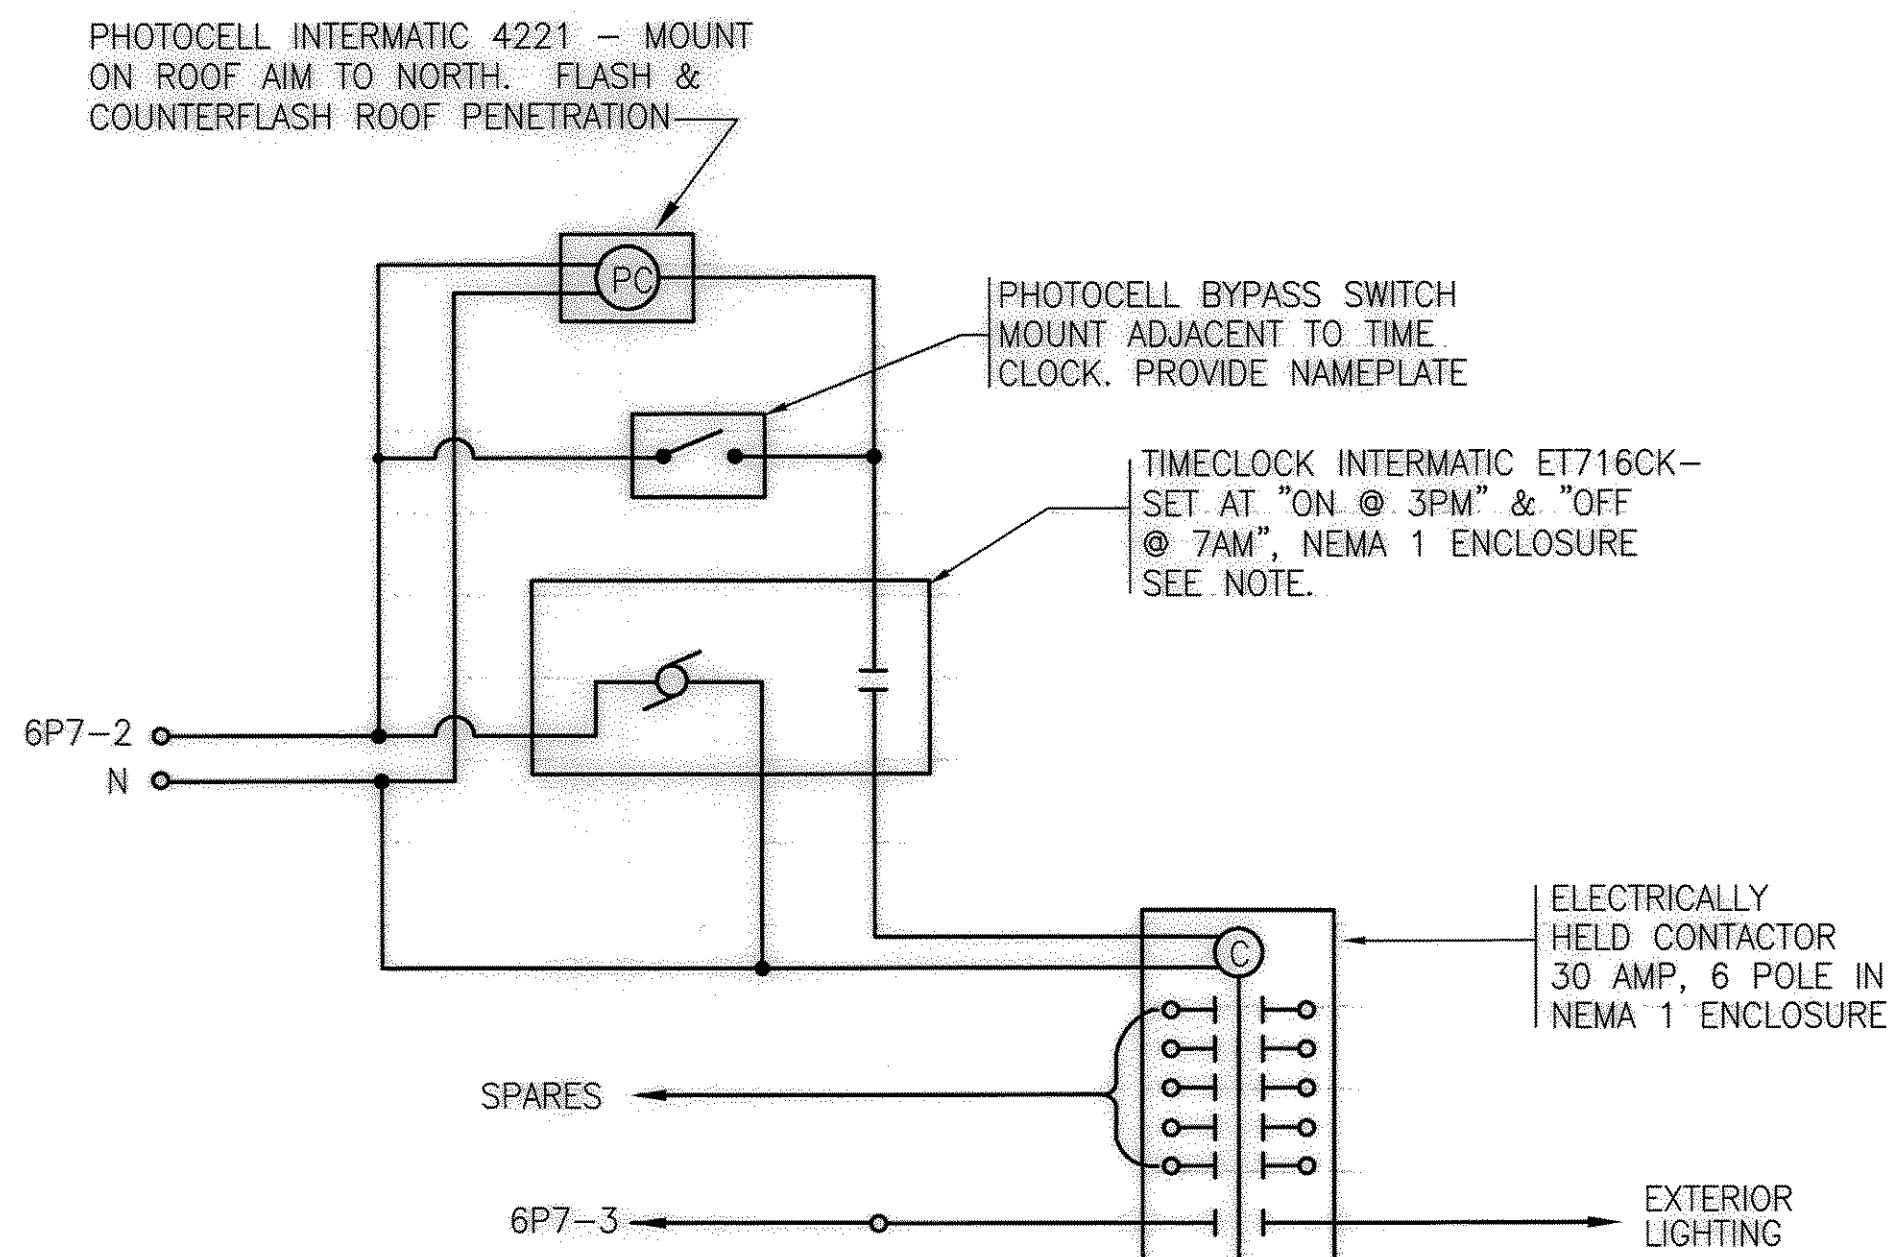


TROUBLE SHACK

NOT TO SCALE

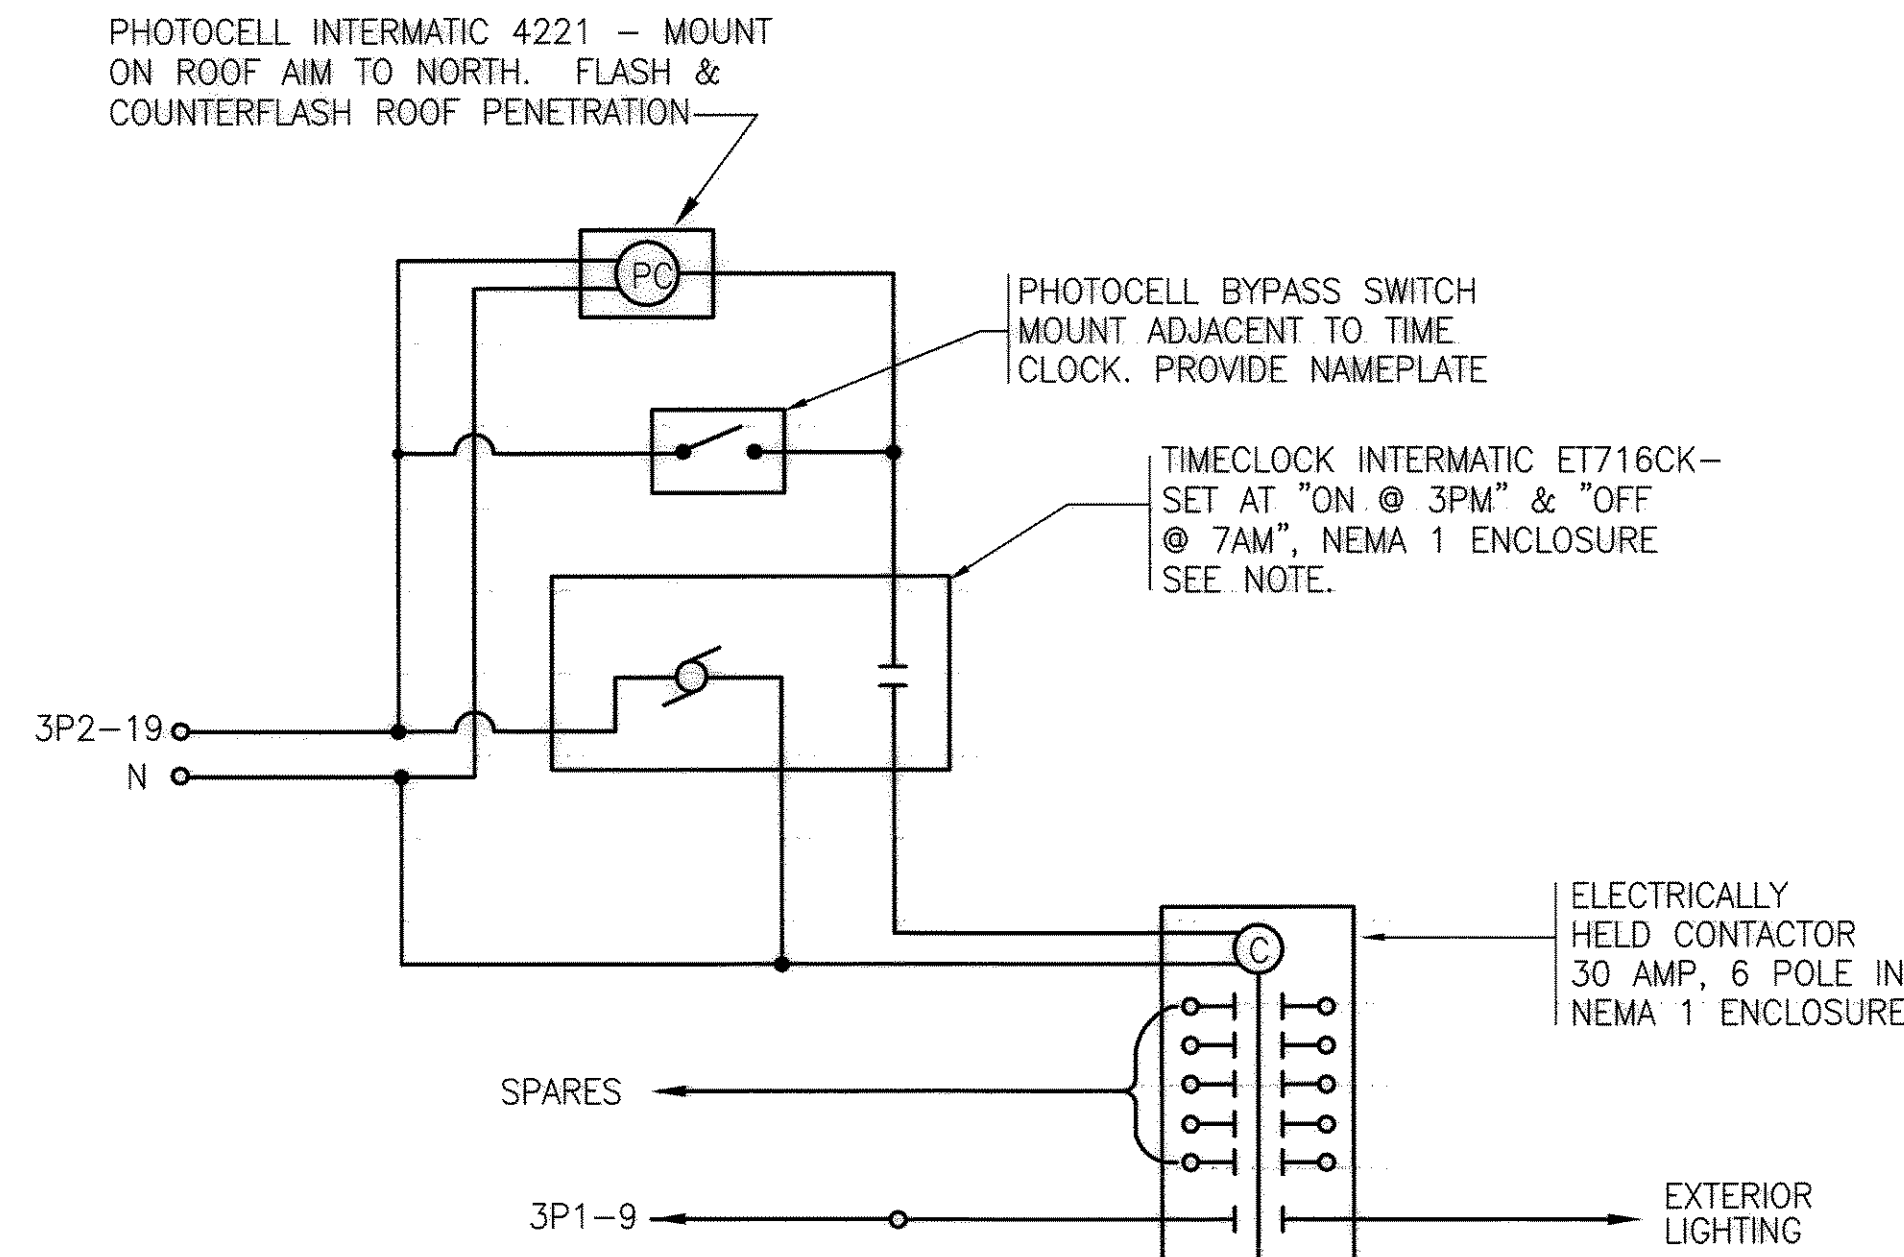

MARINE BUILDING

NOT TO SCALE

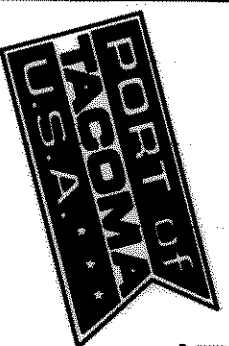

PORT OF TACOMA P.O. BOX 1837
TACOMA, WA 98401 253-383-6841

6021 12th Street East
Suite 201
Tacoma, WA 98424
Tel: 253-922-9037
Fax: 253-922-6499

REVISION	DATE	BY	APPROVED
1			
2			
3			
APPROVED

CHIEF ENGINEER - DATE

CHECKED BY - DATE


PROJECT ENGR. - DATE

PORT OF TACOMA
PIERCE COUNTY TERMINAL
DIAGRAMS

EP-6664-47
E1.104
SHEET 19 OF 230
CONTRACT NUMBER: 988154
DATE: 1/19/74
PHASE: RECORD DRAWINGS


6321-17

BCE
ENGINEERS, INC.
6021 12TH STREET E. SUITE 200
TACOMA, WA 98424
(253) 922-0446 FAX (253) 922-0696

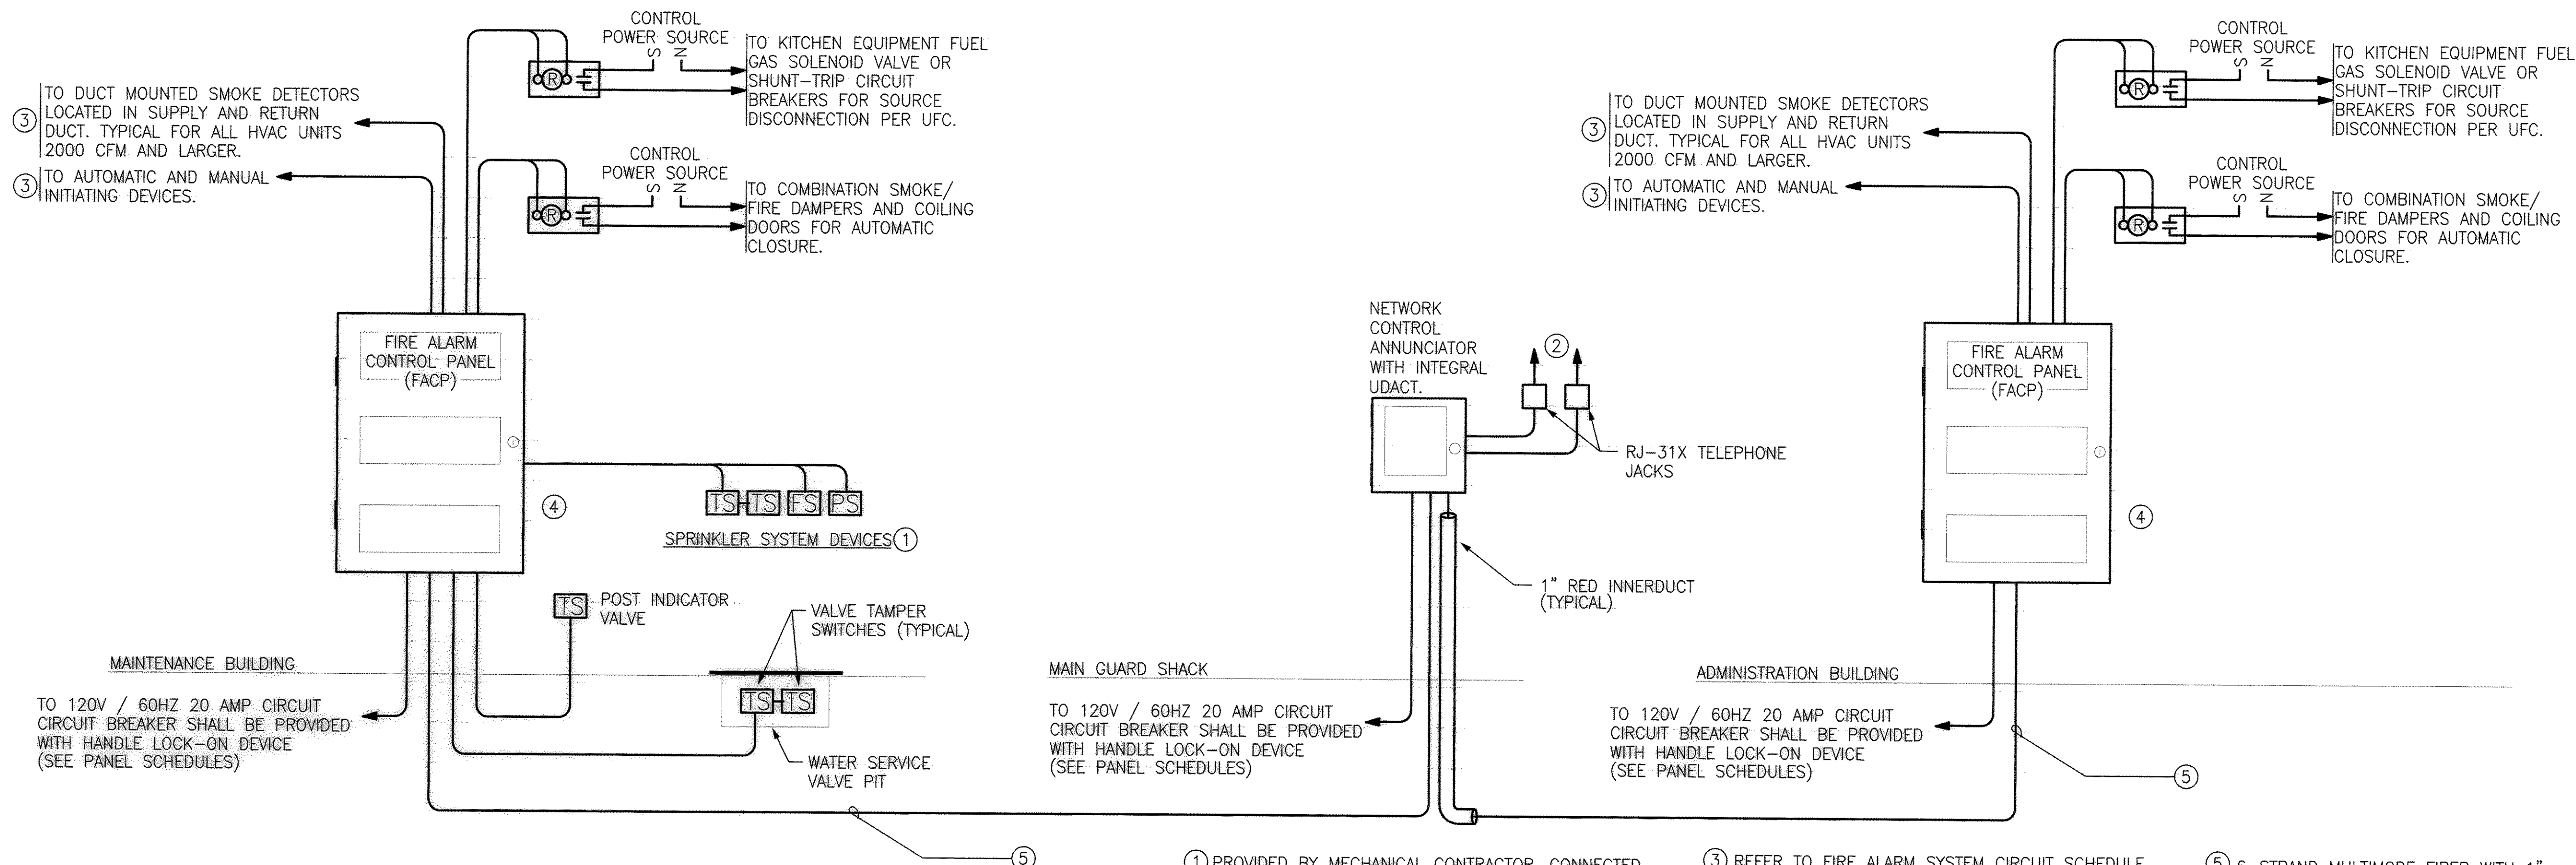


- ① PROVIDED BY MECHANICAL CONTRACTOR, CONNECTED TO FACP BY ELECTRICAL CONTRACTOR. COORDINATE WITH DIVISION 15 CONTRACTOR TO CONFIRM LOCATION AND QUANTITY.
- ② (2) 4 PAIR/22 GAUGE TELEPHONE CABLES TO RJ-21X PUNCHBLOCK LOCATED AT TELEPHONE TERMINATION BOARD. TELEPHONE LINE SERVICE PROVIDED BY OWNER.
- ③ REFER TO FIRE ALARM SYSTEM CIRCUIT SCHEDULE FOR MINIMUM CIRCUITING REQUIREMENTS.
- ④ PANEL SHALL BE FLUSH MOUNTED WHERE INSTALLED IN FINISHED AREAS SUCH AS OFFICE, WORKROOMS, CORRIDORS, ETC... PROVIDE SURFACE TYPE MOUNTING WHERE PANEL IS LOCATED IN UTILITY TYPE SPACES SUCH AS CUSTODIAL, MECHANICAL OR ELECTRICAL ROOMS.
- ⑤ 6-STRAND MULTIMODE FIBER WITH 1" INNERDUCT. COMMSCOPE #Z-006-DS-6F-FSDBK. SEE SPECIFICATION SECTION 16720. PROVIDE SERVICE LOOP IN EACH MANHOLE.

FIRE ALARM SYSTEM - BLOCK DIAGRAM
DIAGRAMMATIC

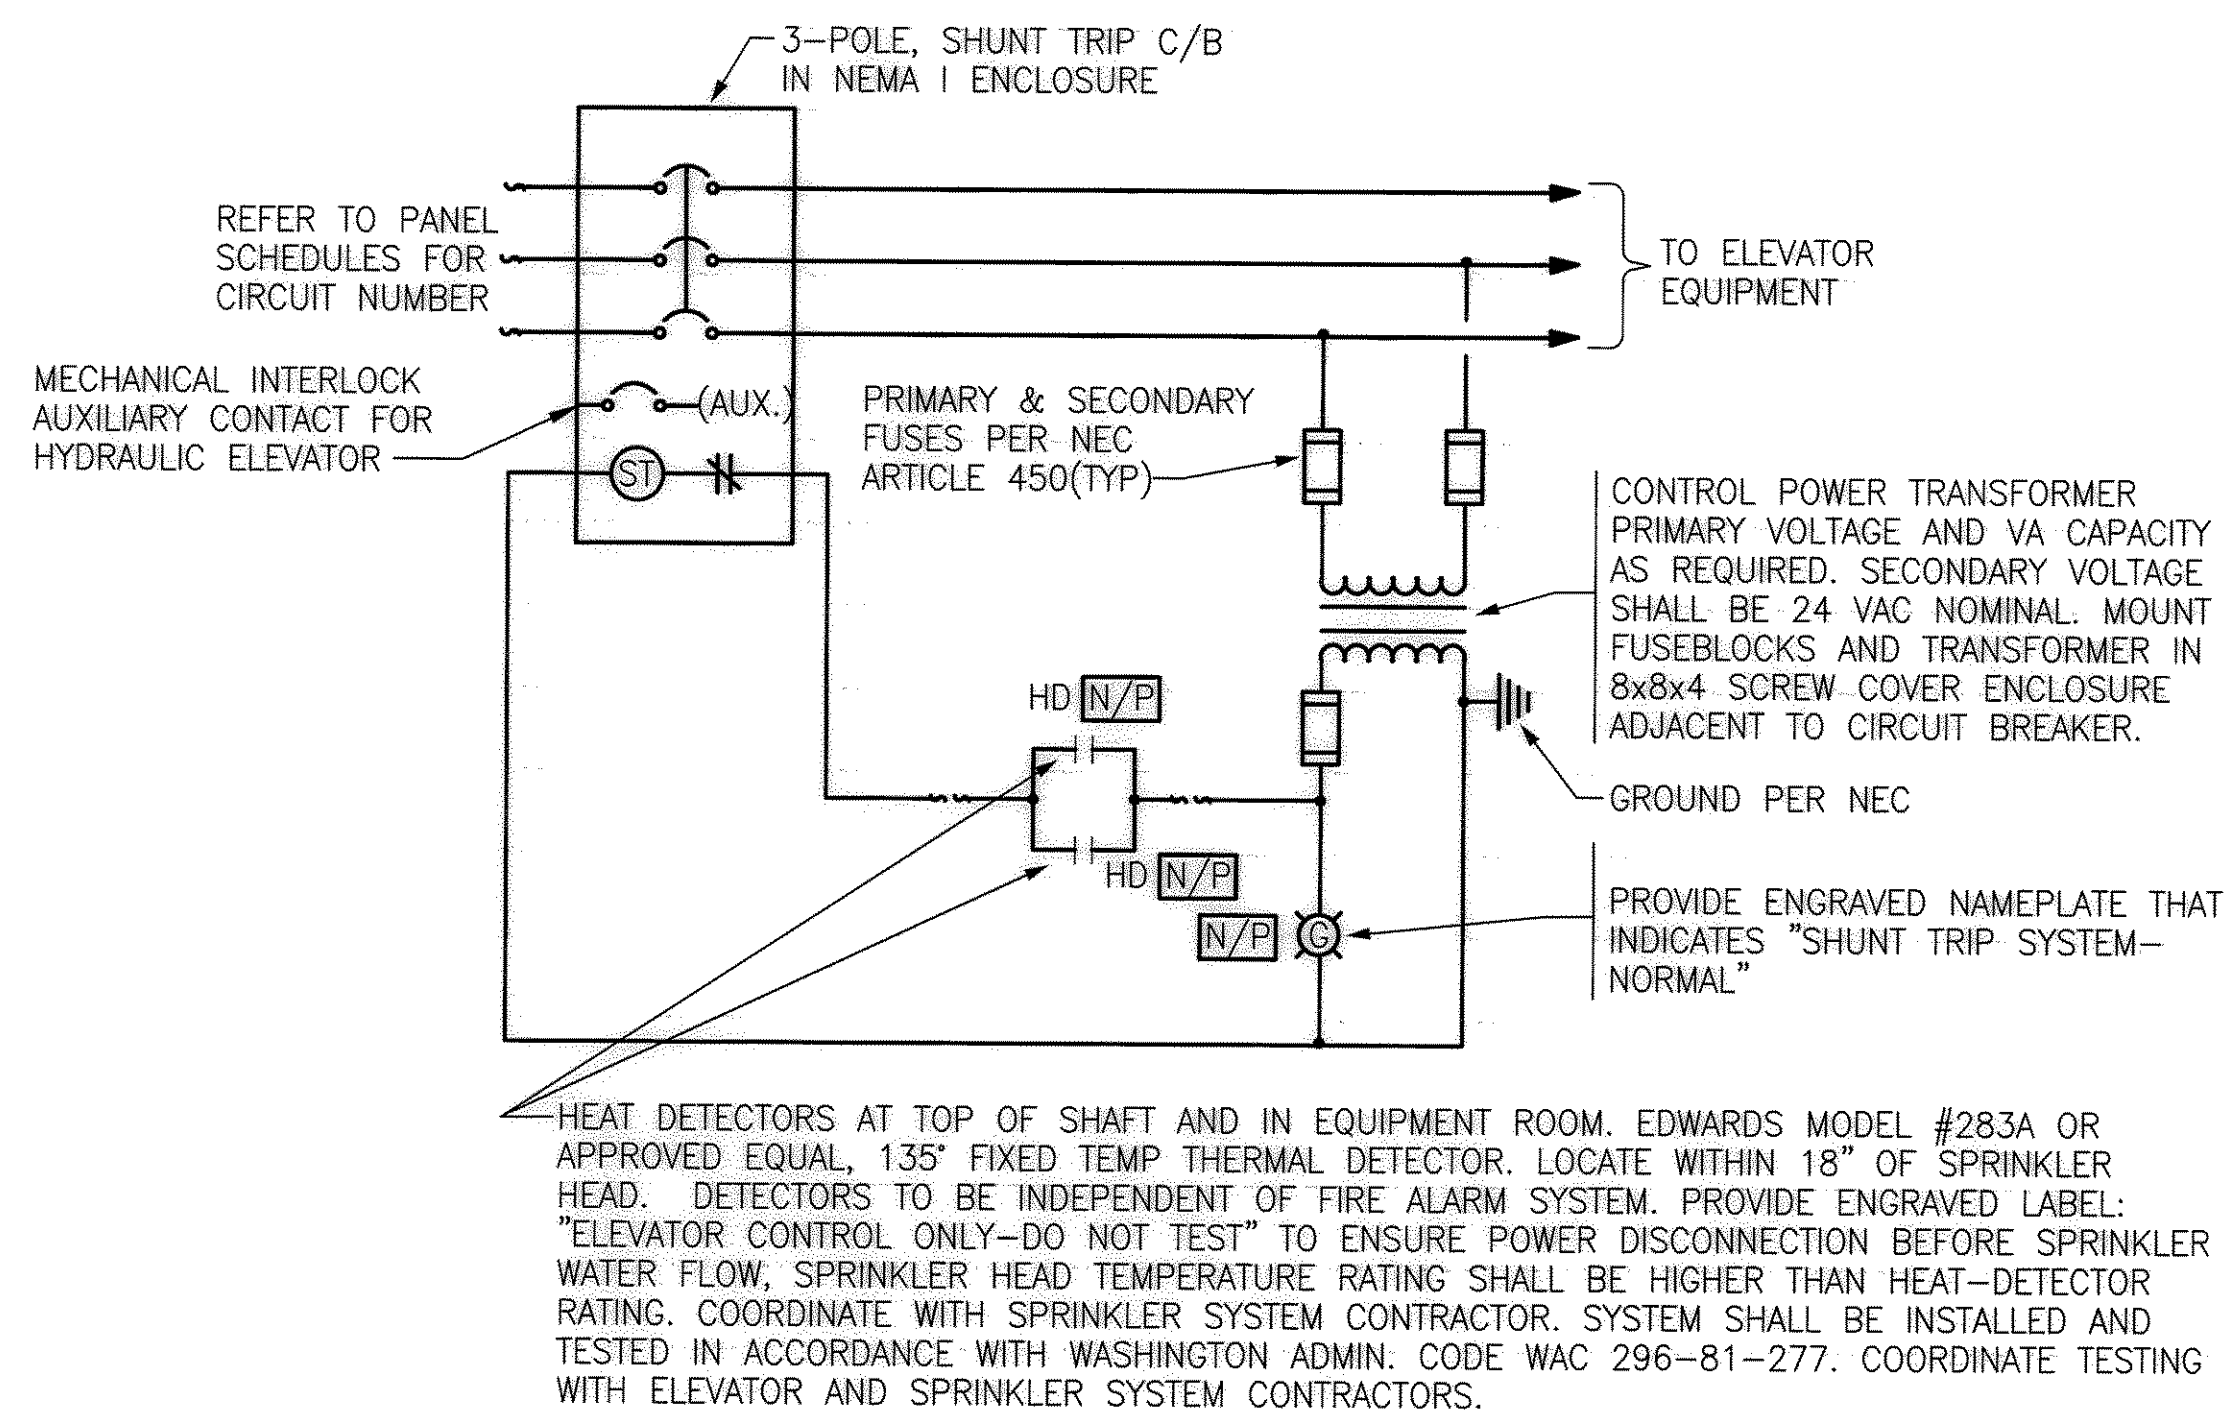

MAINTENANCE AND ADMINISTRATION BUILDING
ELEVATOR SHUNT TRIP SYSTEM - CONNECTION DETAIL


NOT TO SCALE

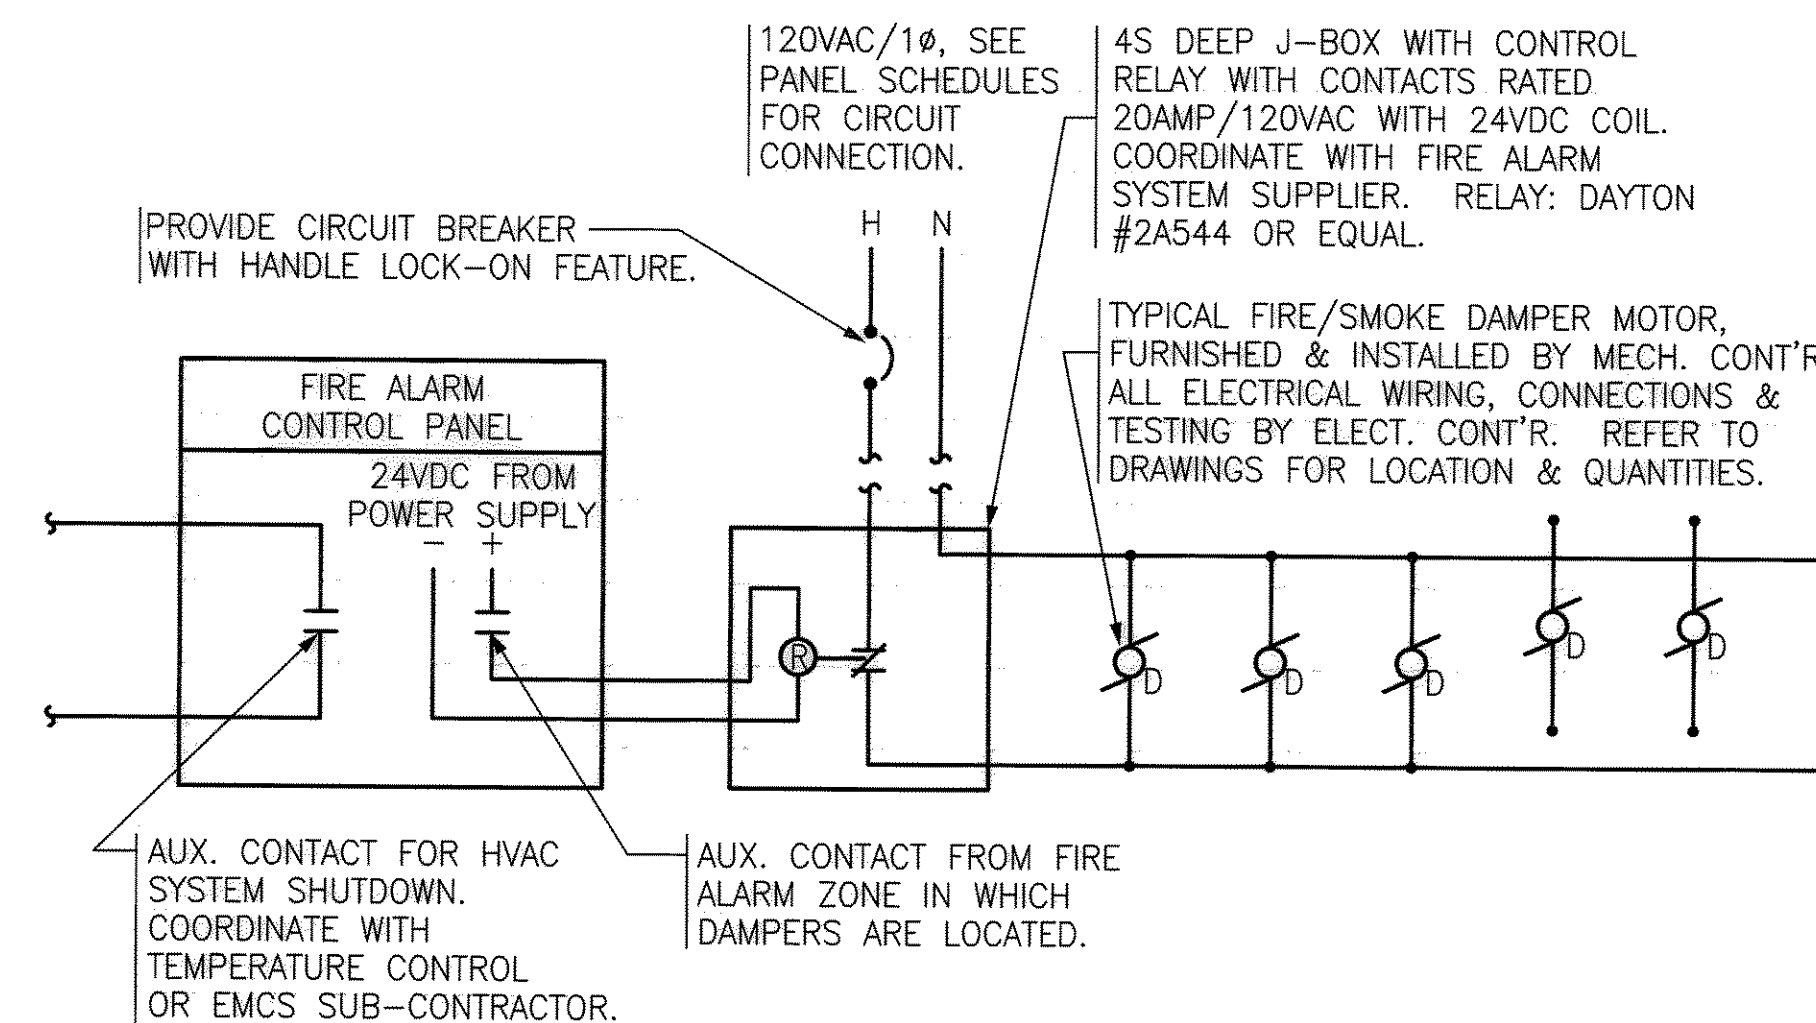

SEQUENCE OF OPERATION: UPON POWER OUTAGE OR ZONE FIRE ALARM SIGNAL, FIRE/SMOKE DAMPERS SHALL CLOSE, AND HVAC SYSTEM SHALL BE SHUTDOWN. UPON RESET OF FIRE ALARM CONTROL PANEL, DAMPERS SHALL AUTOMATICALLY OPEN, AND HVAC SYSTEM SHALL START.

FIRE/SMOKE DAMPER CONTROL DIAGRAM

NOT TO SCALE

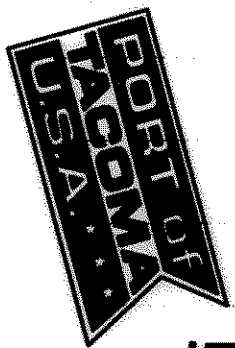

PORT OF TACOMA
TACOMA, WA 98401
P.O. BOX 1837
253-383-6841

6021 12th Street East
Suite 201
Tacoma, WA 98424
Tel: 253.922.9037
Fax: 253.922.6499

MARK	REVISION	DATE
RECORD DRAWINGS	BY: [blank]	DATE: [blank]

APPROVED

CHIEF ENGINEER - DATE

CHECKED BY - DATE
PROJECT ENGR - DATE

PORT OF TACOMA
PIERCE COUNTY TERMINAL
DETAILS AND DIAGRAMS

TOWNSHIP: RANGE: SECTION:
DATING: HORIZ: VERT:
DRAWING SCALE: NONE

EP-6664-17
E1.105
SHEET 20 OF 230
CONTRACT NUMBER: 998154
DATE: 11/17/03
PHASE: RECORD DRAWINGS


6321-17



6021 12TH STREET E. SUITE 200
TACOMA, WA 98424
(253) 922-0446 FAX (253) 922-0896


DOOR DETAIL NOTES

- 1 RECESSED 4-SQUARE J-BOX W/1-GANG MUD RING & BLANK, S/S PLATE, FOR TERMINATION OF SWITCH PIGTAIL LEADS.
- 2 SECURE CONDUIT TO DOOR FRAME TO PREVENT MOVEMENT.
- 3 NOT USED
- 4 3/4" EMT TO ACCESSIBLE CEILING SPACE. PROVIDE PULLSTRING.
- 5 POWER SUPPLY BY CARD ACCESS SUPPLIER.
- 6 CARD READER ROUGH-IN. MOUNT AT +48"A.F.F. MOUNT ON WALL ADJACENT TO DOOR STRIKE WHERE POSSIBLE.

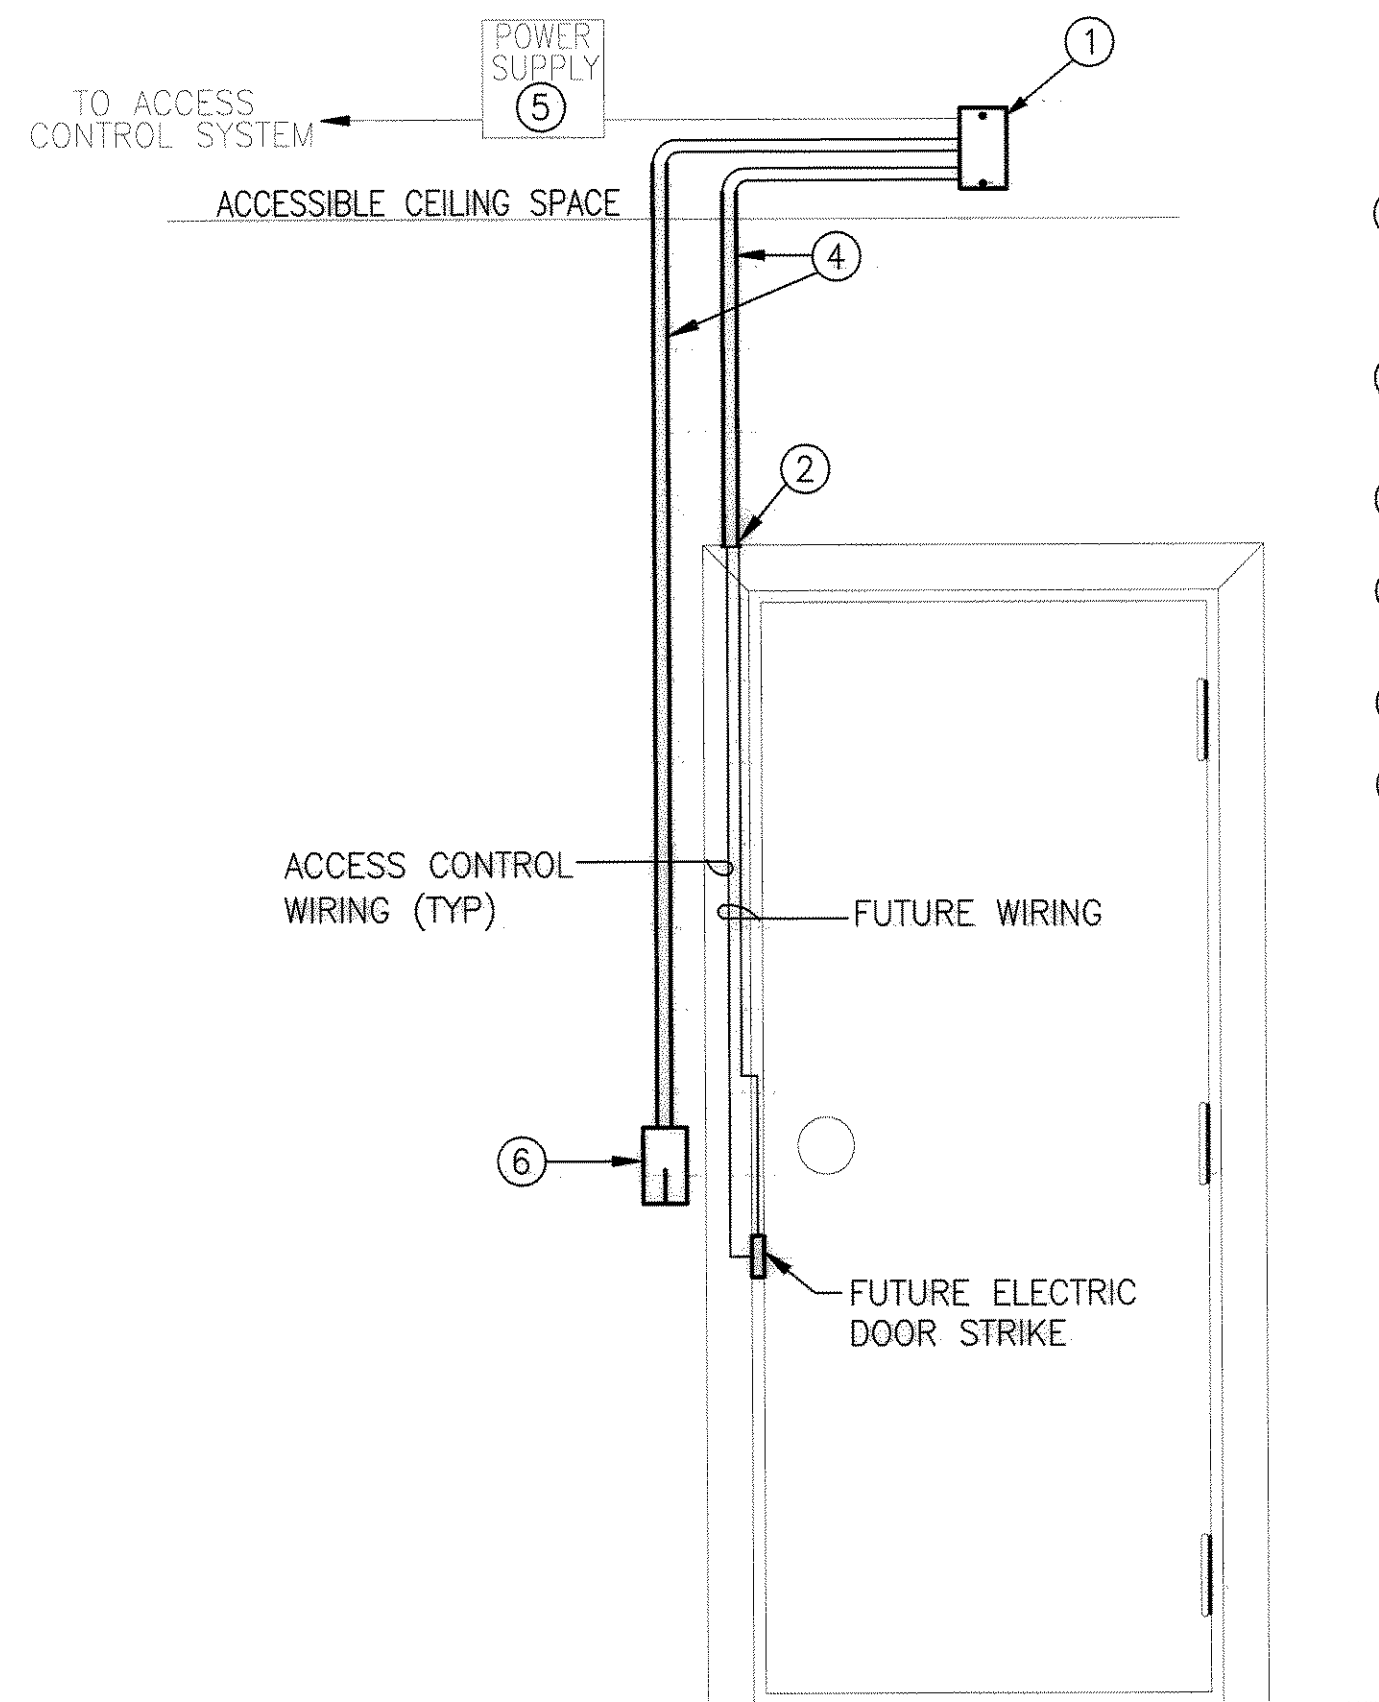


CARD ACCESS ROUGH-IN DETAIL

NOT TO SCALE

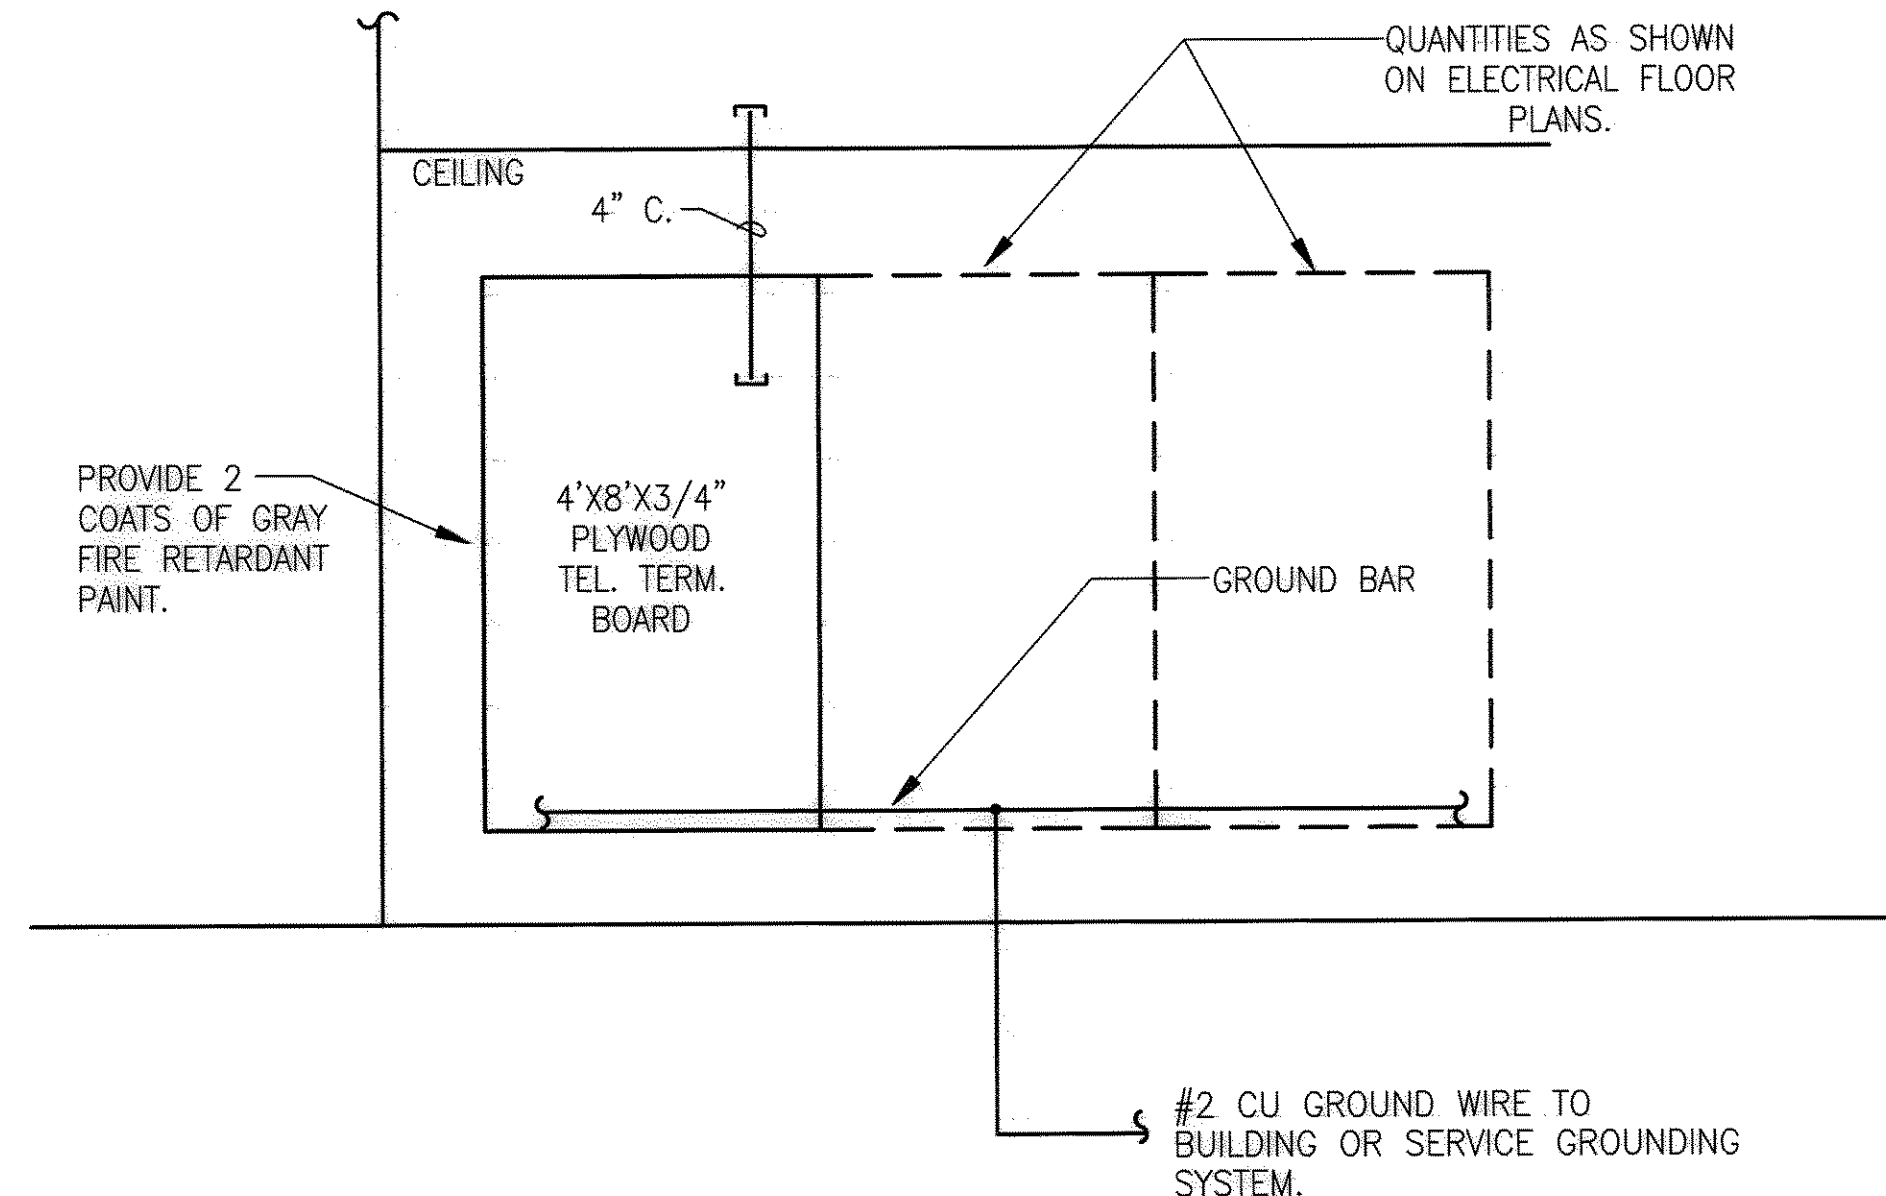


TELEPHONE BACKBOARD DETAIL

NO SCALE

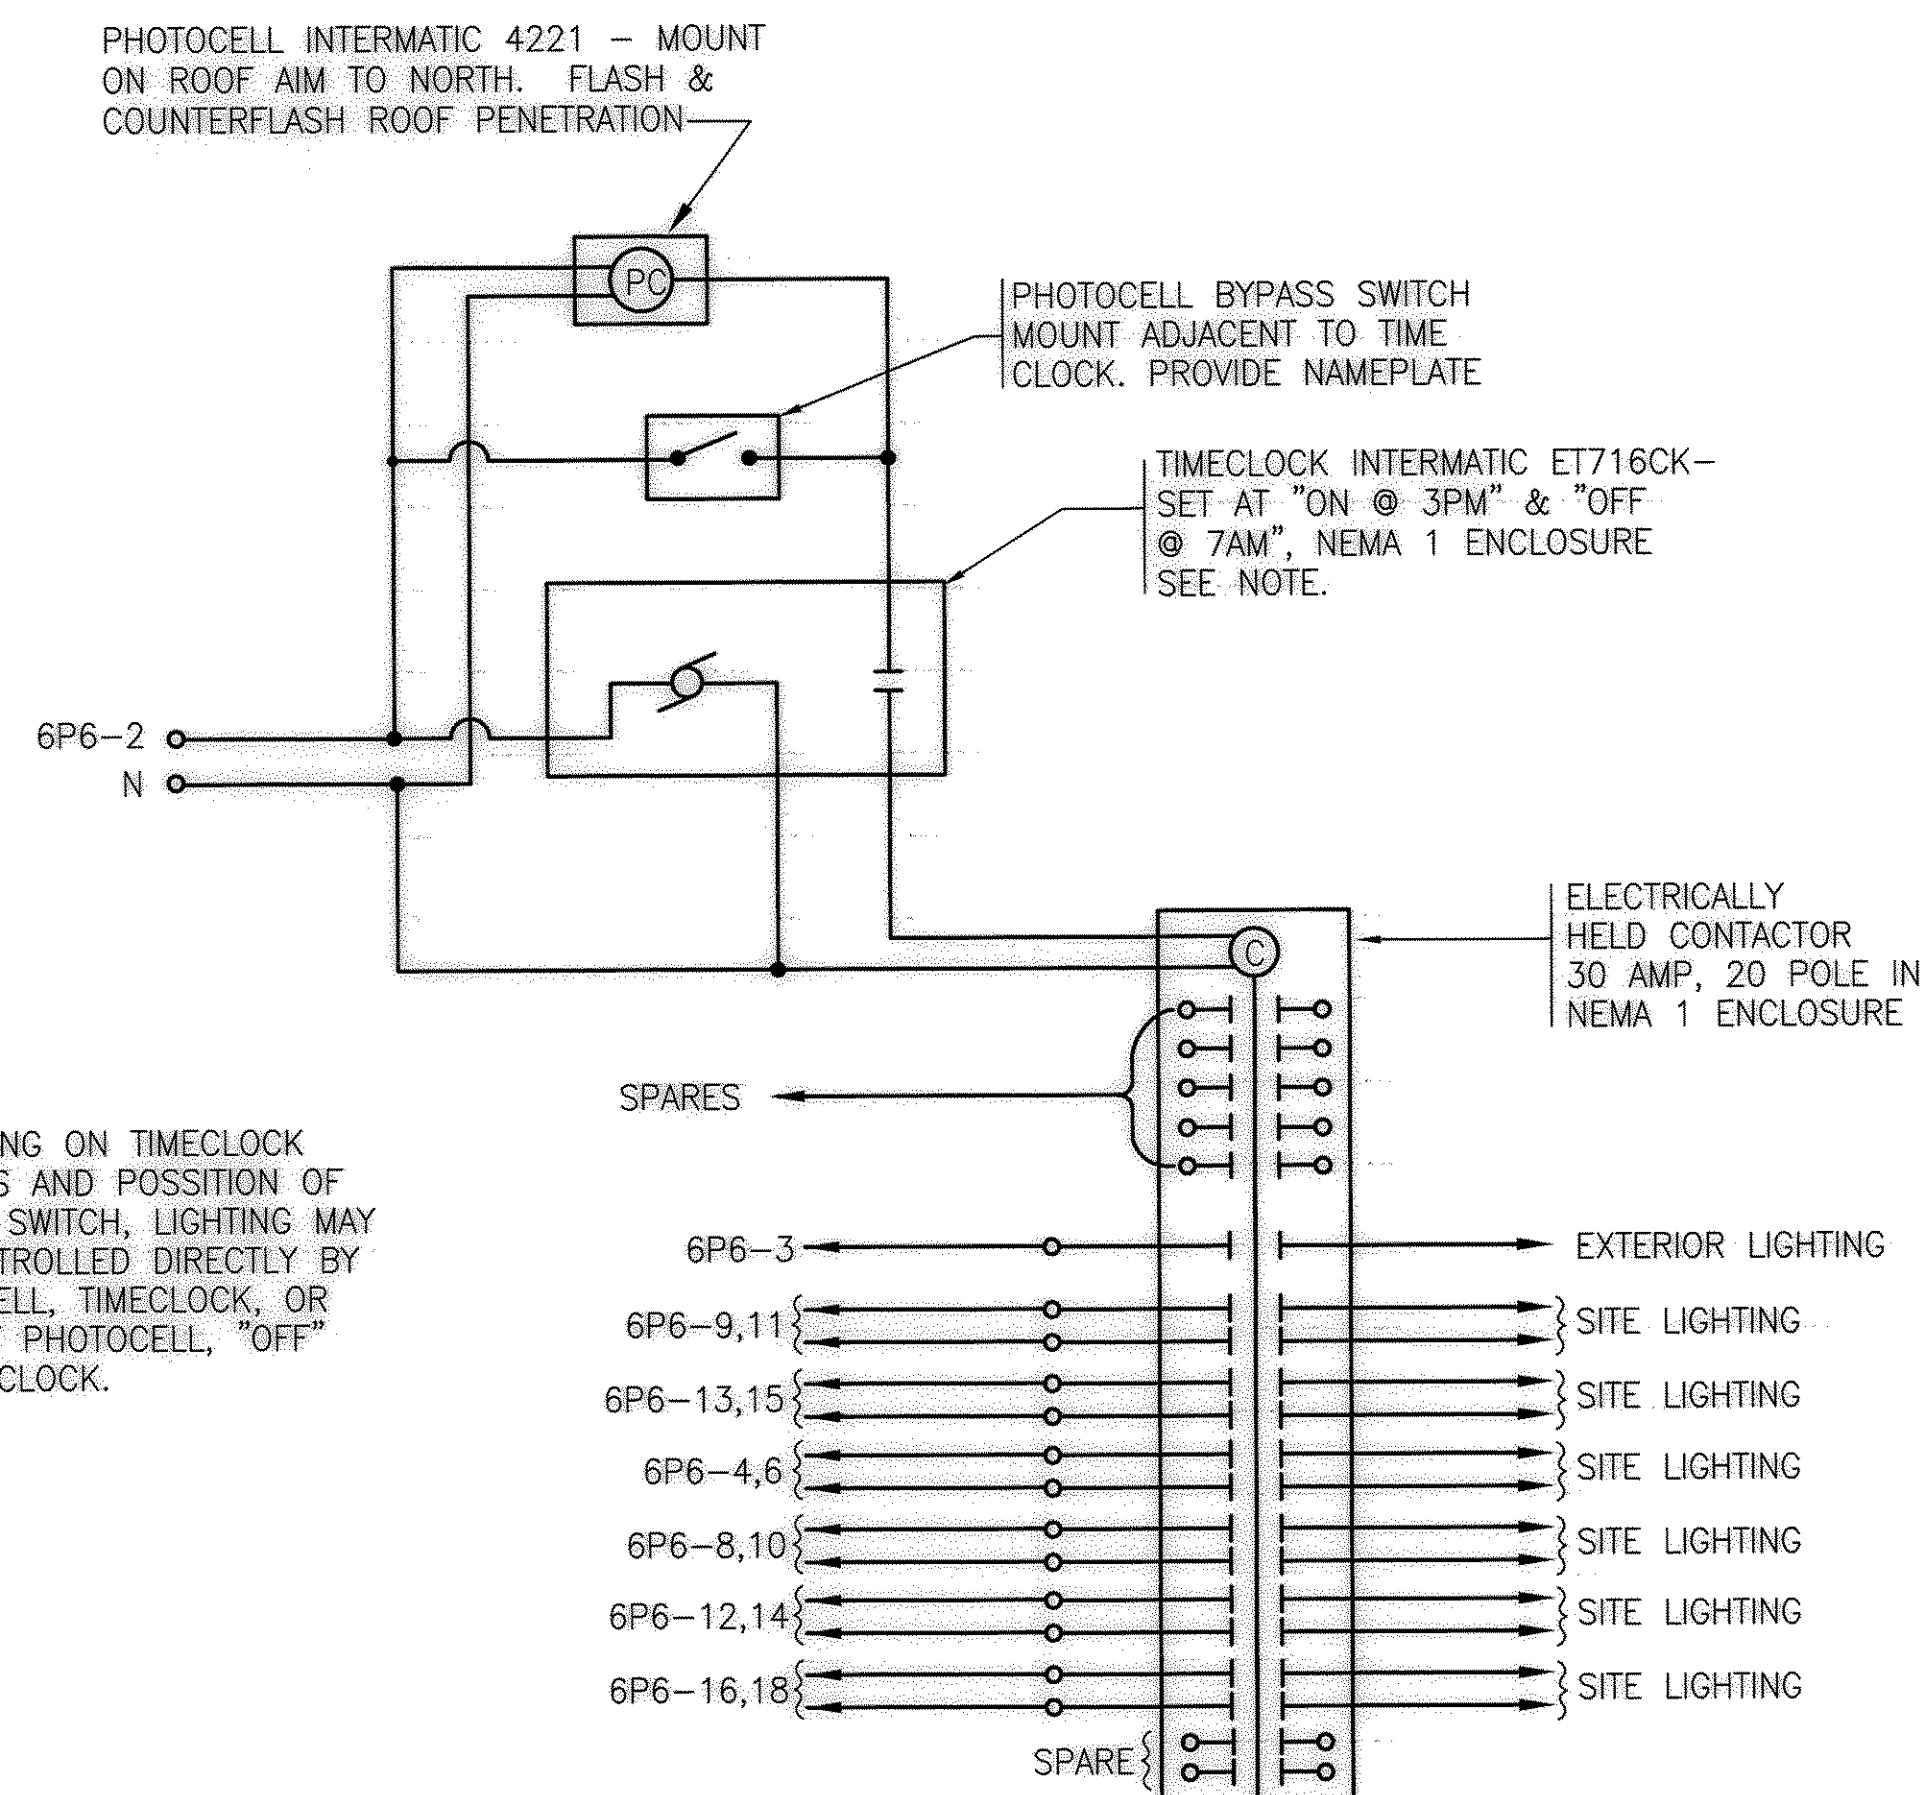

WEST GATE

NOT TO SCALE

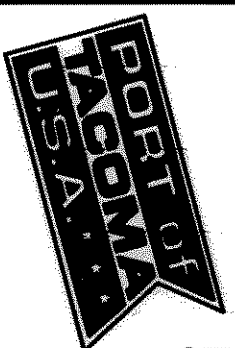

PORT OF TACOMA P.O. BOX 1837
TACOMA, WA 98401 253-383-6841



4021 12th street east
suite 200
tacoma, wa 98424
tel: 253 . 922 . 9037
fax: 253 . 922 . 6499

MARK	REVISION	BY	APPROVED	DATE
RECORD DRAWINGS				

APPROVED

CHIEF ENGINEER - DATE

CHECKED BY - DATE

PROJECT ENGR - DATE

PORT OF TACOMA
PIERCE COUNTY TERMINAL
ELECTRICAL SITE PLAN


EP-5551-17

E1.200


SHEET 21 OF 230

CONTRACT NUMBER: 998154
E. NUMBER: E1974
PHASE: RECORD DRAWINGS

6321-17

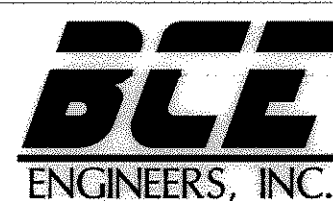

6021 12TH STREET E., SUITE 200
TACOMA, WA 98424
(253) 922-0446 FAX (253) 922-0886

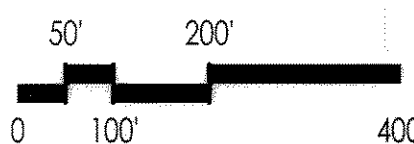


GENERAL NOTES

1. FIRE ALARM CONDUIT INSTALLED BY CONTRACT # 998153 ELECTRICAL CONTRACTOR. SEE CONTRACT #998153 SITE DRAWINGS FOR DETAILED CONDUIT PATHS, MANHOLE LOCATIONS AND TO VERIFY DISTANCES. CONDUIT PATH SHOWN FOR ILLUSTRATION PURPOSES ONLY ON THIS SHEET.
2. SPLICING OF FIBER NOT PERMITTED WITHOUT PRIOR APPROVAL BY ENGINEER.

CONSTRUCTION NOTES

- ① 6-STRAND FIBER OPTIC CABLE WITH 1" RED INNERDUCT FOR FIRE ALARM NETWORK. ROUTE NEW FIBER AND INNERDUCT IN 2" DEDICATED FIRE ALARM CONDUIT AND MANHOLES PROVIDED UNDER CONTRACT # 998153. PROVIDE SERVICE LOOP IN EACH MANHOLE.

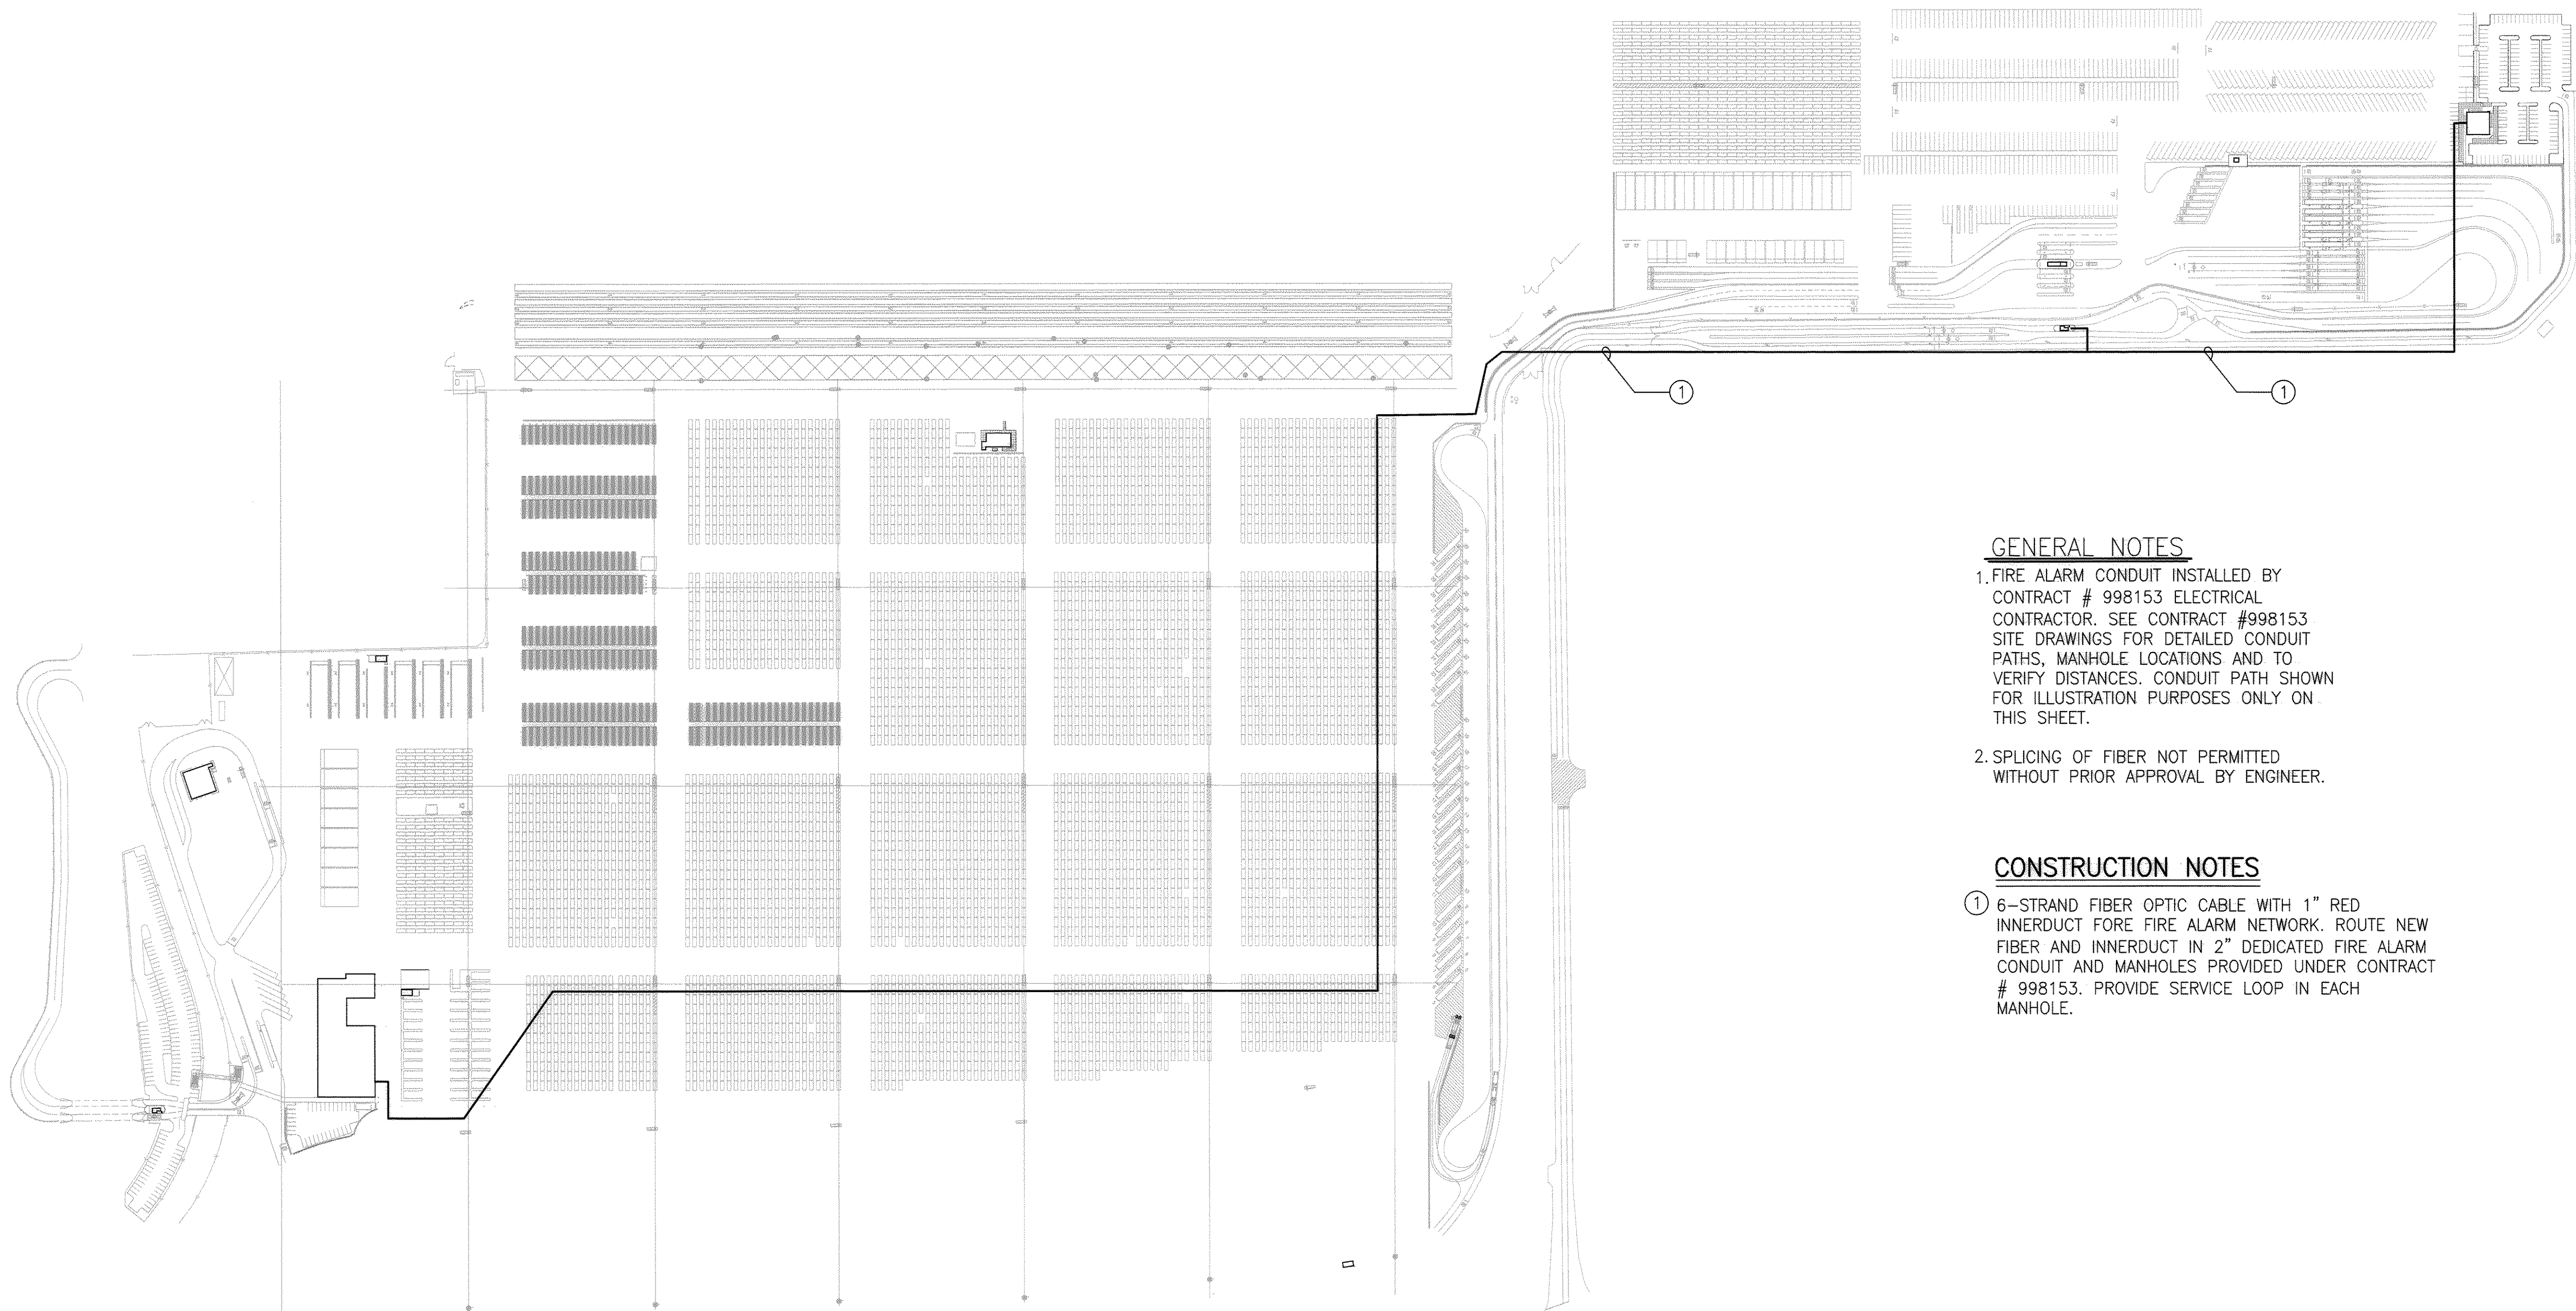


1	ELECTRICAL SITE PLAN	BMM	xsp-23003.dwg
SCALE: 1"=200'-0"			

PORT OF TACOMA

PIERCE COUNTY TERMINAL

MARINE BUILDING SET

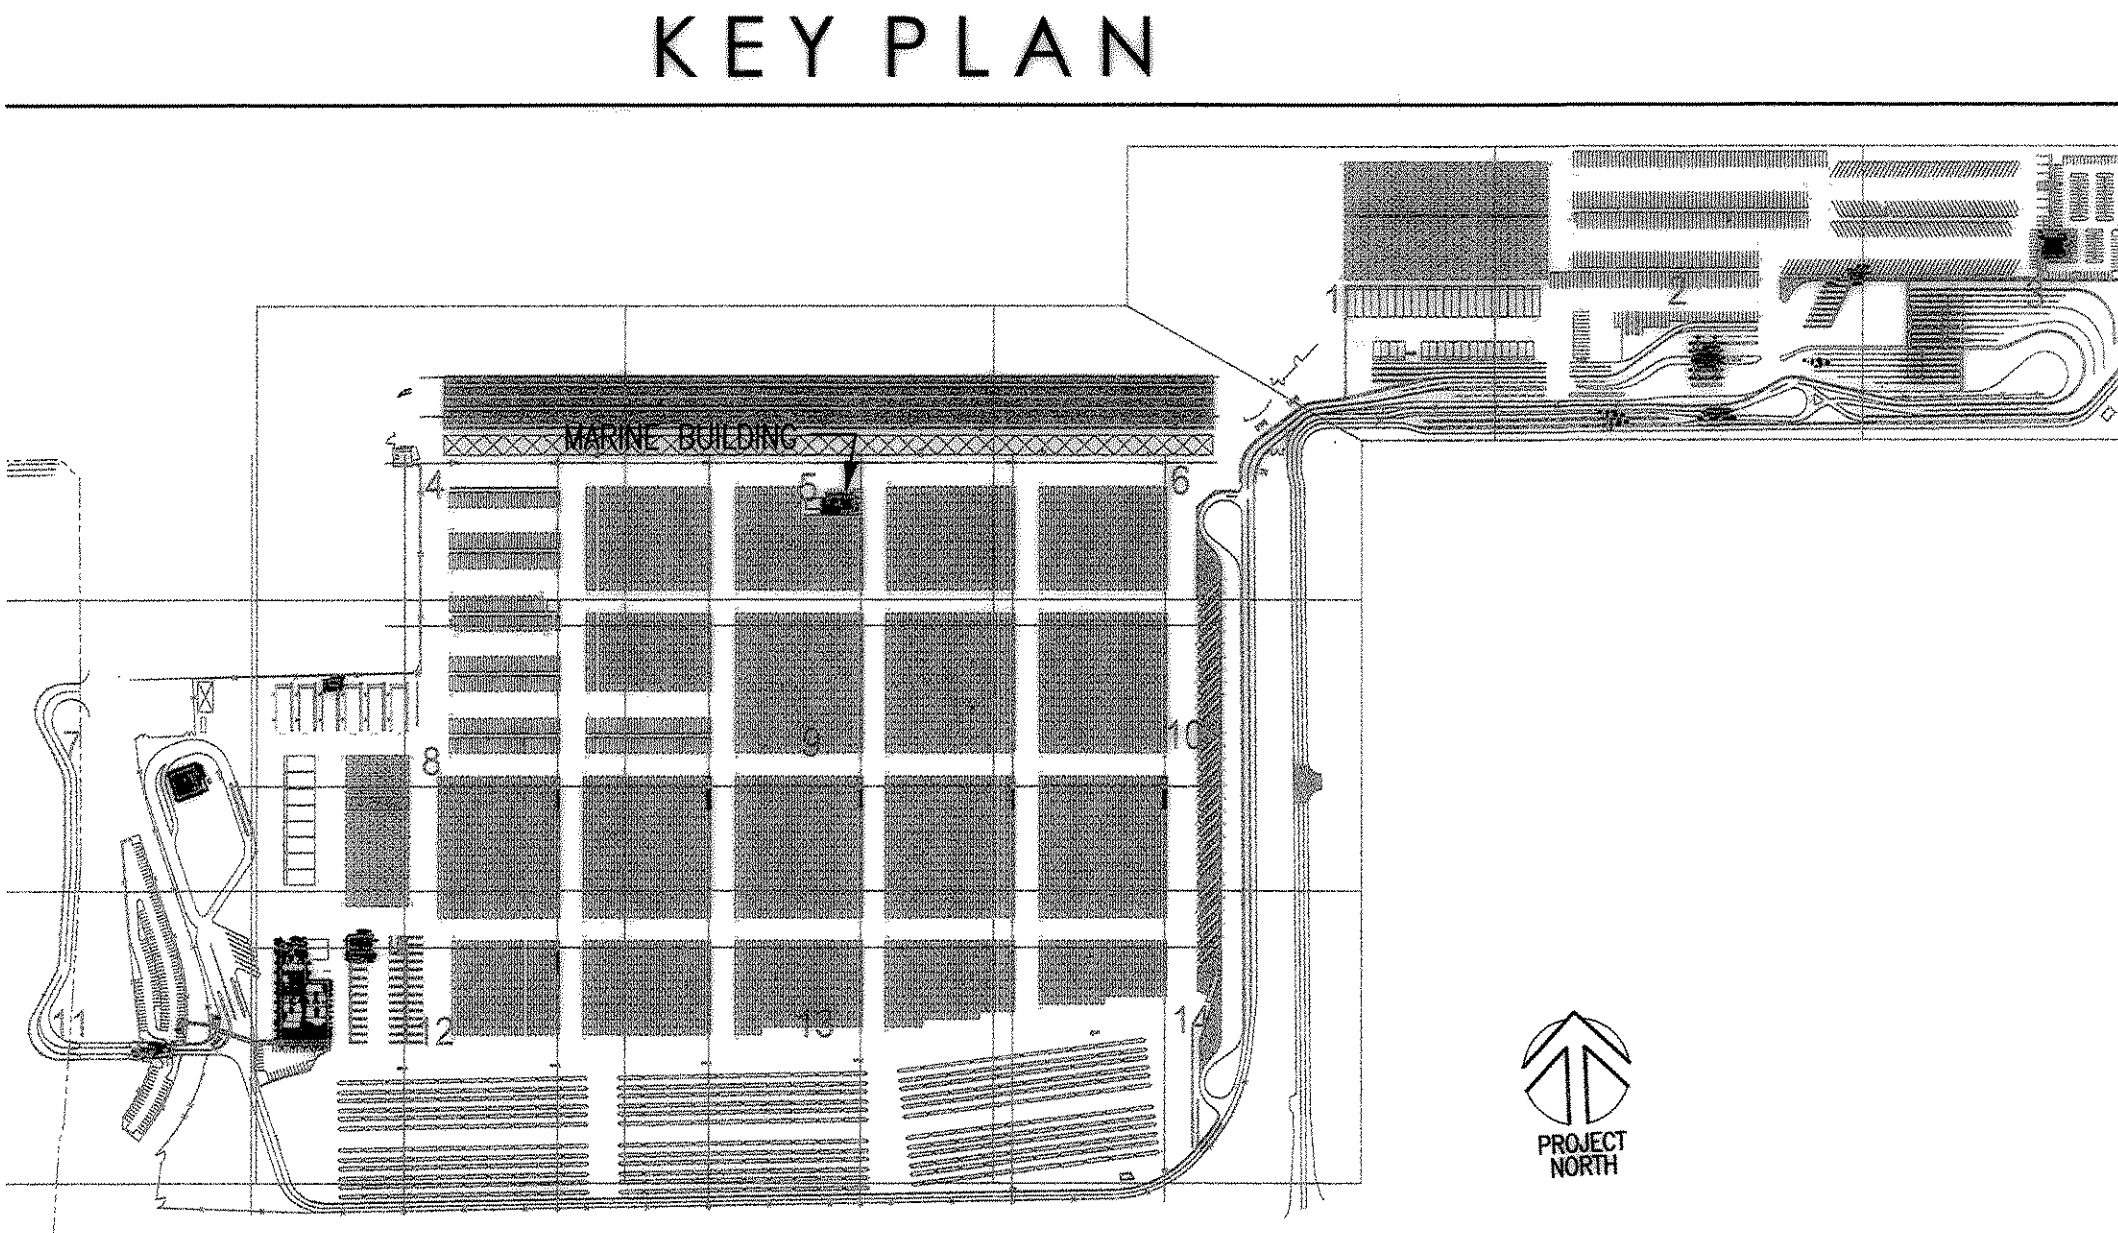

BUILDING INFORMATION

BUILDING AREA	
FIRST FLOOR	1,750 SQ. FT.
SECOND FLOOR	1,750 SQ. FT.
TOTAL	3,500 SQ. FT.
FIRE SPRINKLERS	NO
CODE INFORMATION	
OCCUPANCY GROUPS	B - OFFICE A-3 - BREAK
CONSTRUCTION TYPE	V-N
MAXIMUM ALLOWABLE BUILDING HEIGHT	40 FT.
MAXIMUM ALLOWABLE BUILDING STORIES	2 STORIES
ALLOWABLE FLOOR AREA	
ALL FLOORS	8,000 SQ. FT.
OCCUPANT LOAD	
FIRST FLOOR	78 OCCUPANTS
SECOND FLOOR	10 OCCUPANTS
TOTAL	88 OCCUPANTS

SHEET INDEX

A3.G01	COVER SHEET	Project Team
ARCHITECTURAL DRAWINGS		OWNER
A3.G02	SITE PLAN	PORT OF TACOMA
A3.100	FLOOR PLANS	P.O. BOX 1837
A3.110	ROOF PLAN	6021 12th STREET EAST
A3.120	REFLECTED CEILING PLANS	TACOMA, WA 98401
A3.200	FINISH SCHEDULES	CONTACT: DAVID MEYERS
A3.300	ELEVATIONS	PHONE: 253-428-8612
A3.400	BUILDING SECTIONS	FAX: 253-383-6233
A3.500	WALL SECTIONS	EMAIL: dmyers@portoftacoma.com
STRUCTURAL DRAWINGS		ARCHITECT
S3.001	GENERAL NOTES	HELIX ARCHITECTURE, P.S.
S3.002	GENERAL NOTES	6021 12th STREET EAST SUITE 201
S3.101	FOUNDATION AND FRAMING PLANS	TACOMA, WA 98424
S3.102	STAIR PLANS	CONTACT: LOWELL CATE
S3.201	BRACED FRAME ELEVATIONS	PHONE: (253) 922-9037
S3.301	FOUNDATION DETAILS & SCHEDULES	FAX: (253) 922-6499
S3.302	FOUNDATION DETAILS & SCHEDULES	EMAIL: lowellc@helixarch.com
S3.311	FRAMING DETAILS & SCHEDULES	GEOTECHNICAL ENGINEER
S3.312	FRAMING DETAILS & SCHEDULES	GEO ENGINEERS
S3.321	COMPOSITE STEEL DECK DETAILS	1101 SOUTH FAWCETT AVENUE
S3.331	ROOF FRAMING DETAILS	TACOMA, WA 98402
MECHANICAL DRAWINGS		CONTACT: DAVE PHELPS
M3.100	SCHEDULES	PHONE: 253-383-4940
M3.210	PLUMBING PLANS	FAX: 253-383-4923
M3.310	RCP AND FURRED CEILING PLANS	EMAIL: dphep@geoenr.com
ELECTRICAL DRAWINGS		STRUCTURAL ENGINEER
E3.100	BUILDING LIGHTING PLAN	BERGER/ABAM ENGINEERS, INC.
E3.200	BUILDING POWER PLAN	33301 NINTH AVENUE SOUTH
E3.300	BUILDING SYSTEMS PLAN	SUITE 300
E3.400	PANEL SCHEDULES	FEDERAL WAY, WA 98003
		CONTACT: RUBA ZUMUT
		PHONE: 206-431-2300
		FAX: 206-431-2250
		EMAIL: zumut@abam.com
		MECHANICAL ENGINEER
		BCE ENGINEERS
		6021 12TH STREET EAST, SUITE 200
		TACOMA, WA 98424
		CONTACT: DUANE LEASE
		PHONE: 253-922-0446
		FAX: 253-922-0896
		EMAIL: duane@bceeng.com
		ELECTRICAL ENGINEER
		BCE ENGINEERS
		6021 12TH STREET EAST, SUITE 200
		TACOMA, WA 98424
		CONTACT: MIKE COZART
		PHONE: 253-922-0446
		FAX: 253-922-0896
		EMAIL: mcozart@bceeng.com



PORT OF TACOMA
TACOMA, WA 98401
253-383-5841

Helix
6021 12th street east
suite 201
Tacoma, wa 98424
tel: 253-922-9037
fax: 253-922-6499

APPROVED

LC 8/22/03

CHECKED BY - DATE

LC 8/22/03

PROJECT ENGR - DATE


PORT OF TACOMA
PIERCE COUNTY TERMINAL
MARINE BUILDING

EP-5551-17

A3.G01

SHEET 56 OF 230

6321-17

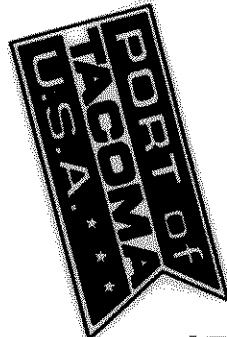

PORT OF TACOMA P.O. BOX 1837
TACOMA, WA 98401 253-383-6841
6021 12th Street East
Suite 201
Tacoma, WA 98424
Tel: 253.922.9037
Fax: 253.922.6499

RECORD DRAWING

APPROVED
CHIEF ENGINEER - DATE
DATE: 12/20/04

LC 9/22/03
CHECKED BY - DATE
9/22/03
PROJECT ENGR - DATE


PORT OF TACOMA
PIERCE COUNTY TERMINAL
MARINE BUILDING

EP-5554-47
A3.G02
SHEET 67 OF 230



6321-17

SITE PLAN LEGEND

DESCRIPTION	SYMBOL AND TEXT
PROPERTY LINE length (ft) angle (survey)	100.00' N 90°00'00" W
ADJACENT PROPERTY LINE adjacent parcel lines	100.00' N 90°00'00" W
PROPERTY SETBACK LINE description and dimension	10'-0" FRONT YARD SETBACK
EASEMENT description and dimension	5'-0" UTILITY EASEMENT
FINISH GRADE ELEVATION existing (E)	EL. 0.00
LANDSCAPING	
BUILDING OUTLINE description, f.f. elevation, building dimensions, orientation	40.0' 20.0' BUILDING F.F. = 0.00'
FUTURE BUILDING/ PHASE OUTLINE description and phase	FUTURE ADDITION PHASE II
CONTAINER	
JERSEY BARRIER	
FENCE height/description	X-X-X-X 6' CHAINLINK FENCE
PARKING STALL AND LANDSCAPE PLANTER	row count, compact stall indicator (C), wheel stops where indicated, concrete curb R=2' 18'-0"
HANDICAPPED PARKING STALLS	row count, handicap stall indicator (HC), concrete curb, curb cut, HC signs, 2% max. slope all directions 26'-0"
LIGHT POLE	
FIRE HYDRANT	FH
MONUMENT ENTRY SIGN description, shape, material	ENTRY SIGN (STONE)
CENTERLINE OF ROAD description	STREET NAME
EDGE OF ROAD description	EDGE OF PAVEMENT

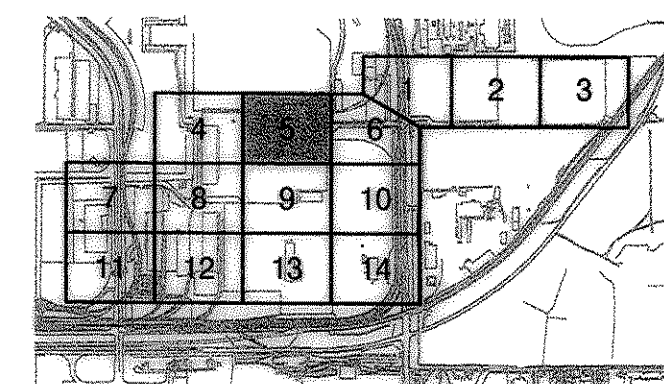

KEY MAP
N.T.S.

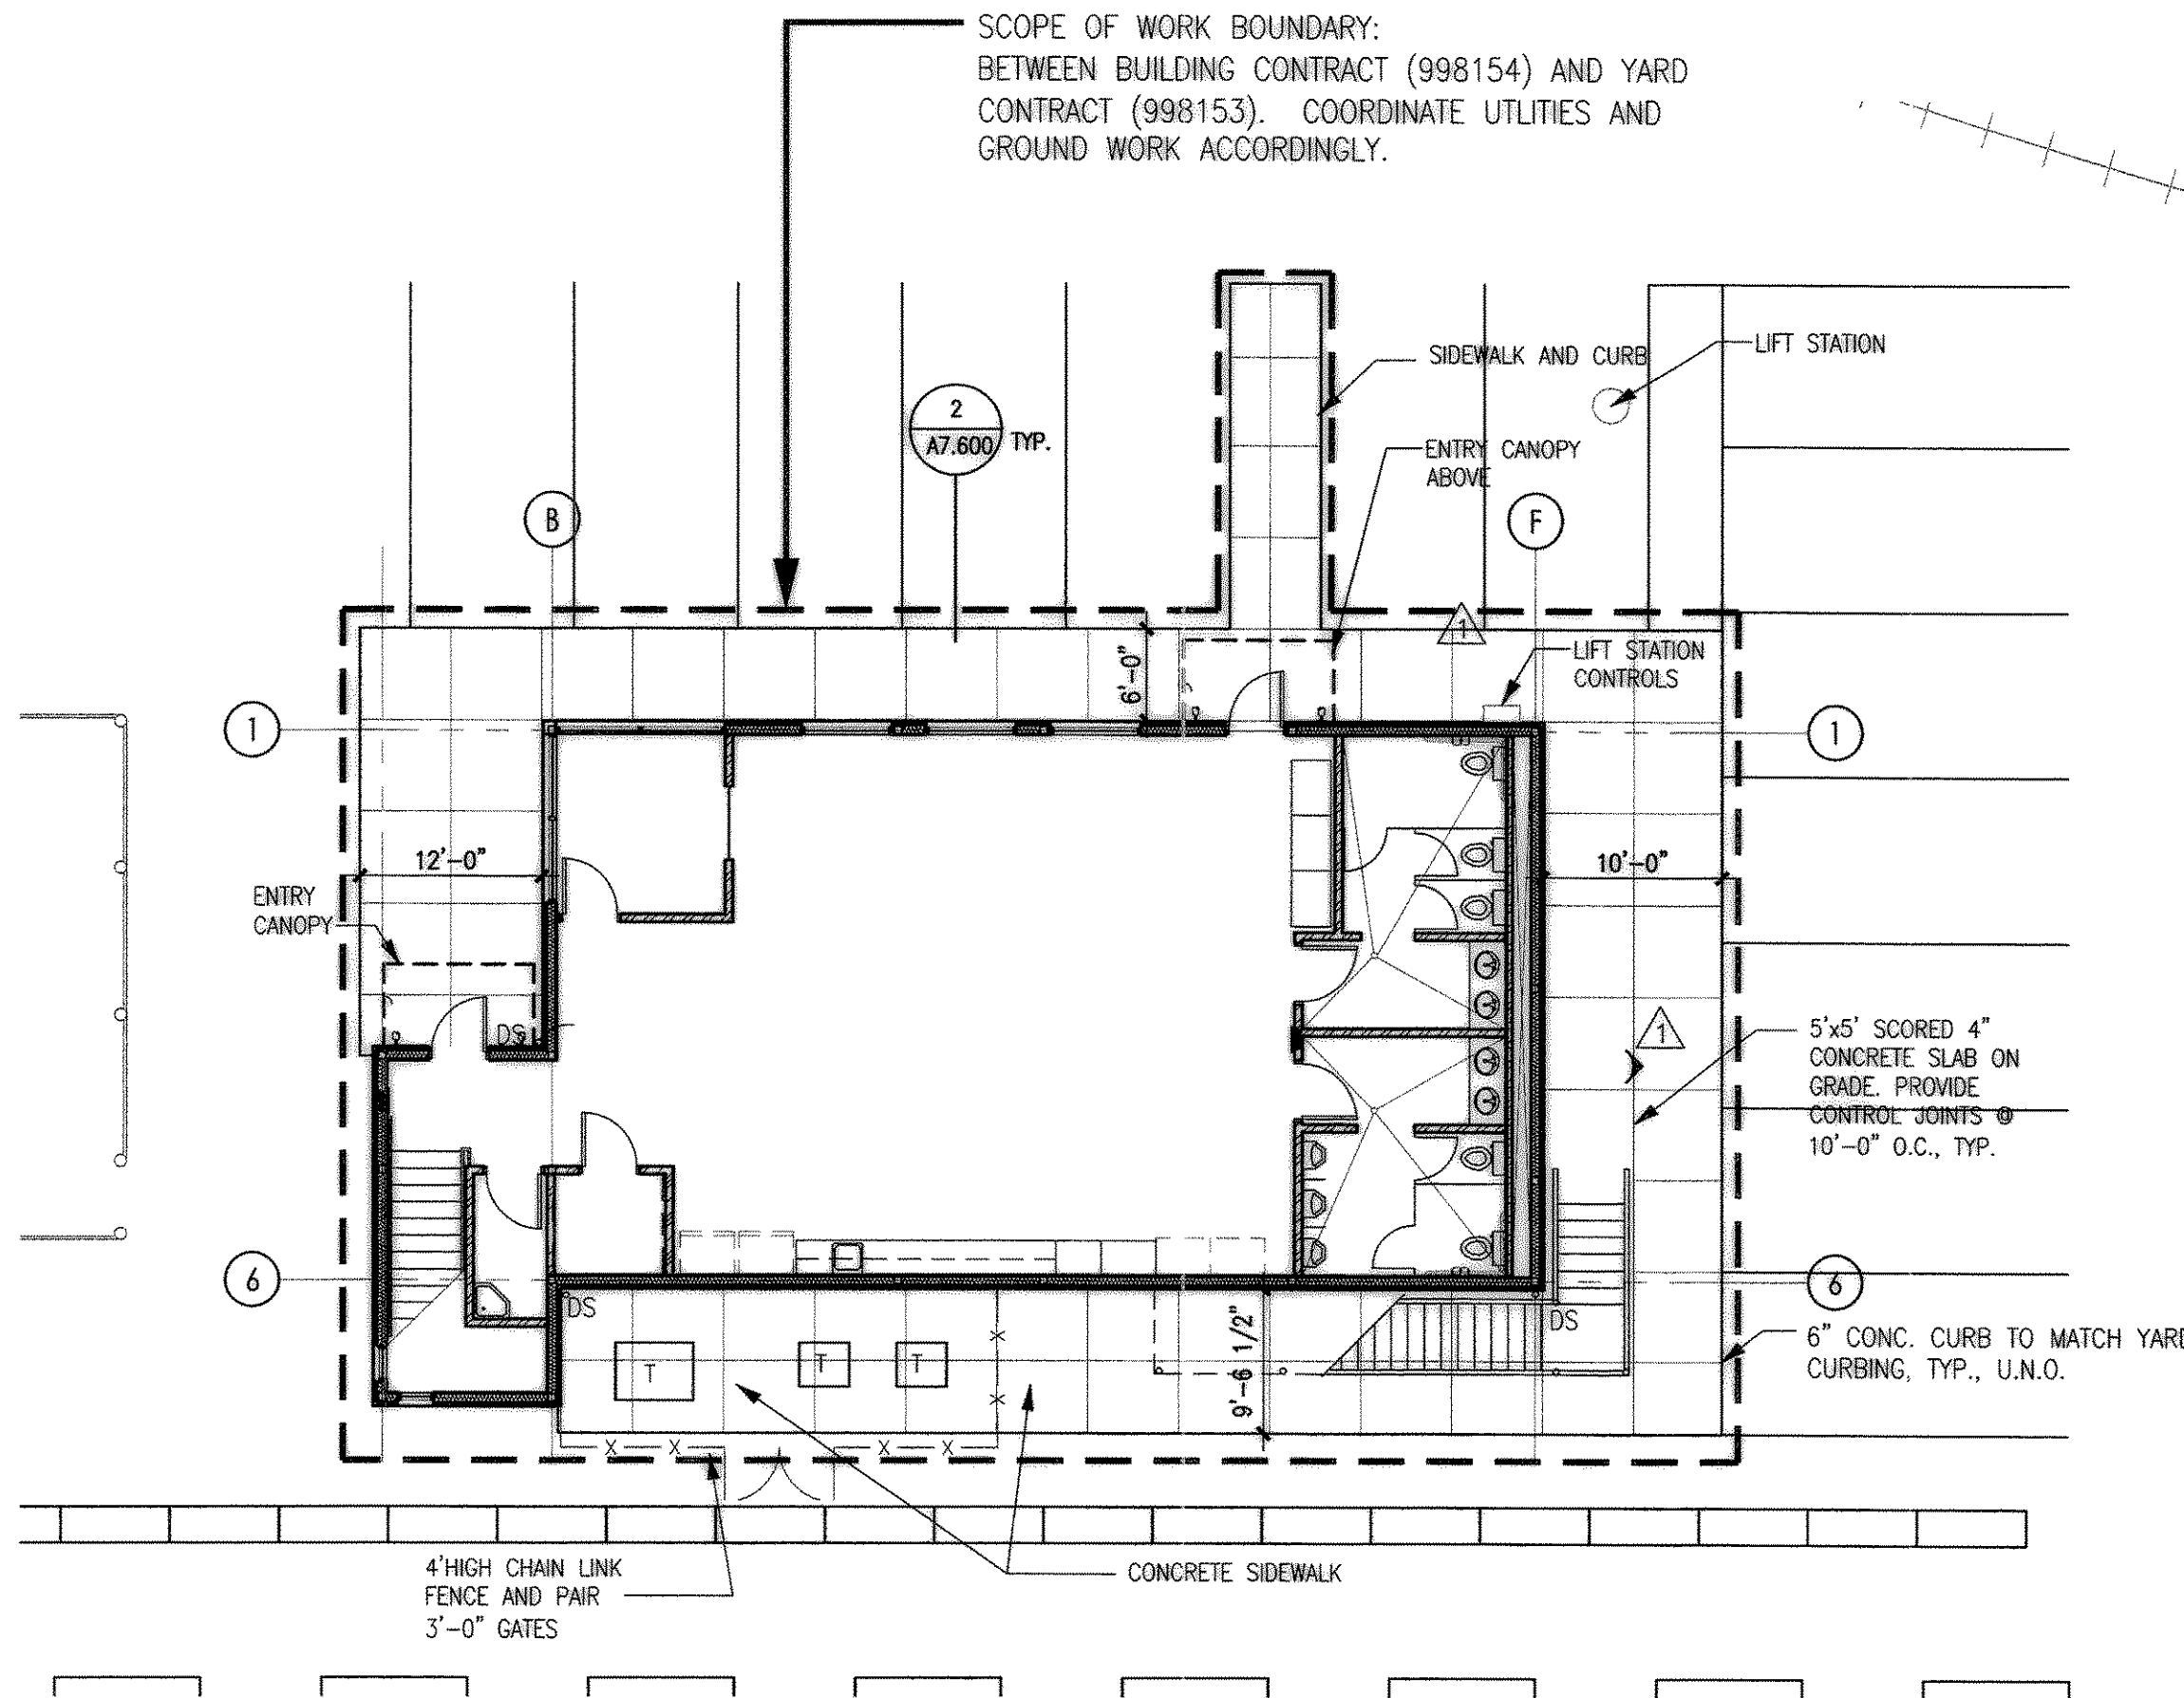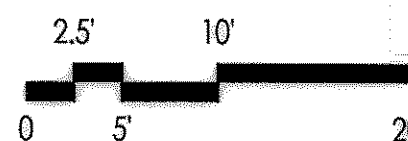

1	MARINE BUILDING SITE PLAN	F.F. = 21.75'
SCALE: 1"=10'-0"		PEC E2164A_FP-01.DWG

FOR FINISHED FLOOR ELEVATION AND BUILDING
CORNER LOCATIONS REFER TO CONTRACT
(998153) PROVIDE 1:20 SIDEWALK CROSS SLOPE

**PORT OF TACOMA P.O. BOX 1837
TACOMA, WA 98401 253-383-5841**

RECORD
DRAWING

APPROVED

CHIEF ENGINEER - DATE


LC 8/22/03
CHECKED BY - DATE
LC 8/22/03
PROJECT ENGR. - DATE

**PORT OF TACOMA
PIERCE COUNTY TERMINAL
MARINE BUILDING**


EP-5551-17

A3.100
SHEET 58 OF 230

6321-17

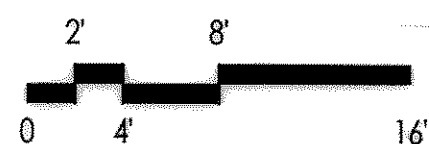


WALL TYPES	
DESCRIPTION	SYMBOL AND TEXT
WALL TYPE 1	
3 5/8" METAL STUDS @ 16" O.C.	
WALL TYPE 2	
6" METAL STUDS @ 16" O.C.	
WALL TYPE 3	
4" METAL C-H STUDS @ 24" O.C. WITH 1" SHAFT LINER AND 5/8" GWB (SHAFTWALL)	
WALL TYPE 4	
6" METAL C-H STUDS @ 24" O.C. WITH 1" SHAFT LINER AND 5/8" GWB (SHAFTWALL)	
WALL TYPE 5	
6" METAL STUDS @ 16" O.C. W/ 7/8 FURRING CHANNELS AND METAL SIDING	
WALL TYPE 6	
16" METAL GIRTS W/ 3-5/8" METAL STUDS @ 16" O.C. AND METAL SIDING	
WALL TYPE 7	
8" METAL GIRTS AND METAL SIDING	
WALL TYPE 8	
12" CMU WALL	
1 HOUR RATED WALL	
	

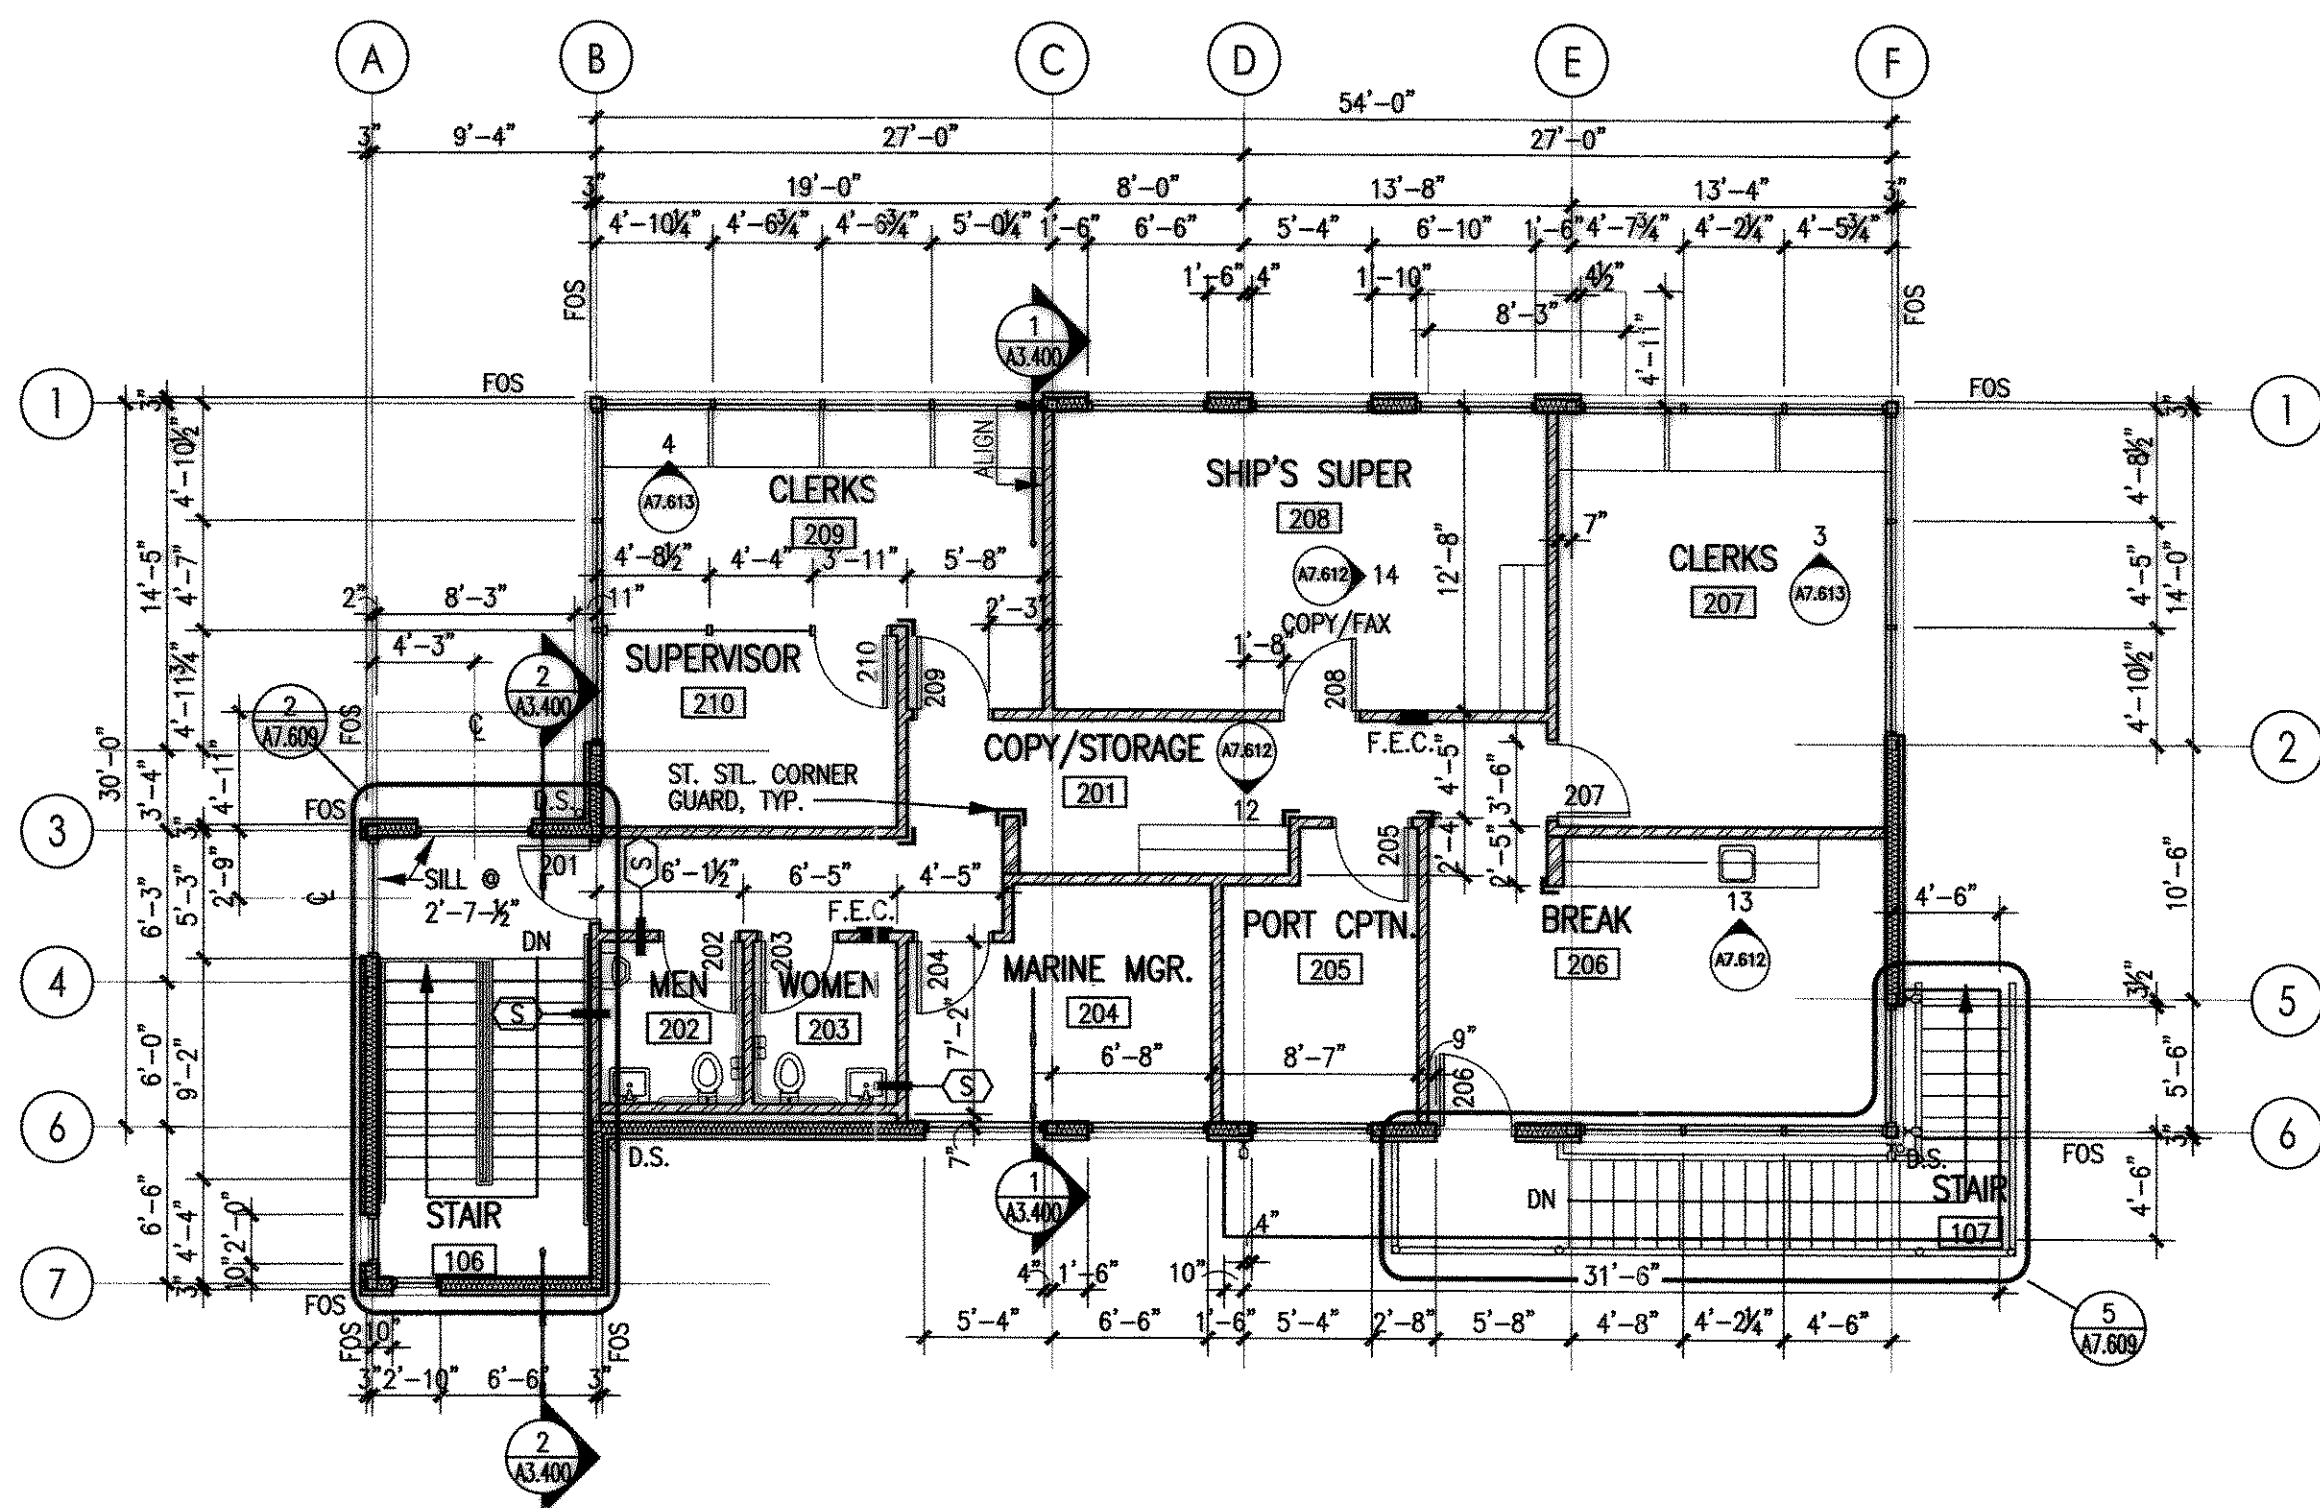

SECOND FLOOR PLAN


SCALE: 1/8"=1'-0"

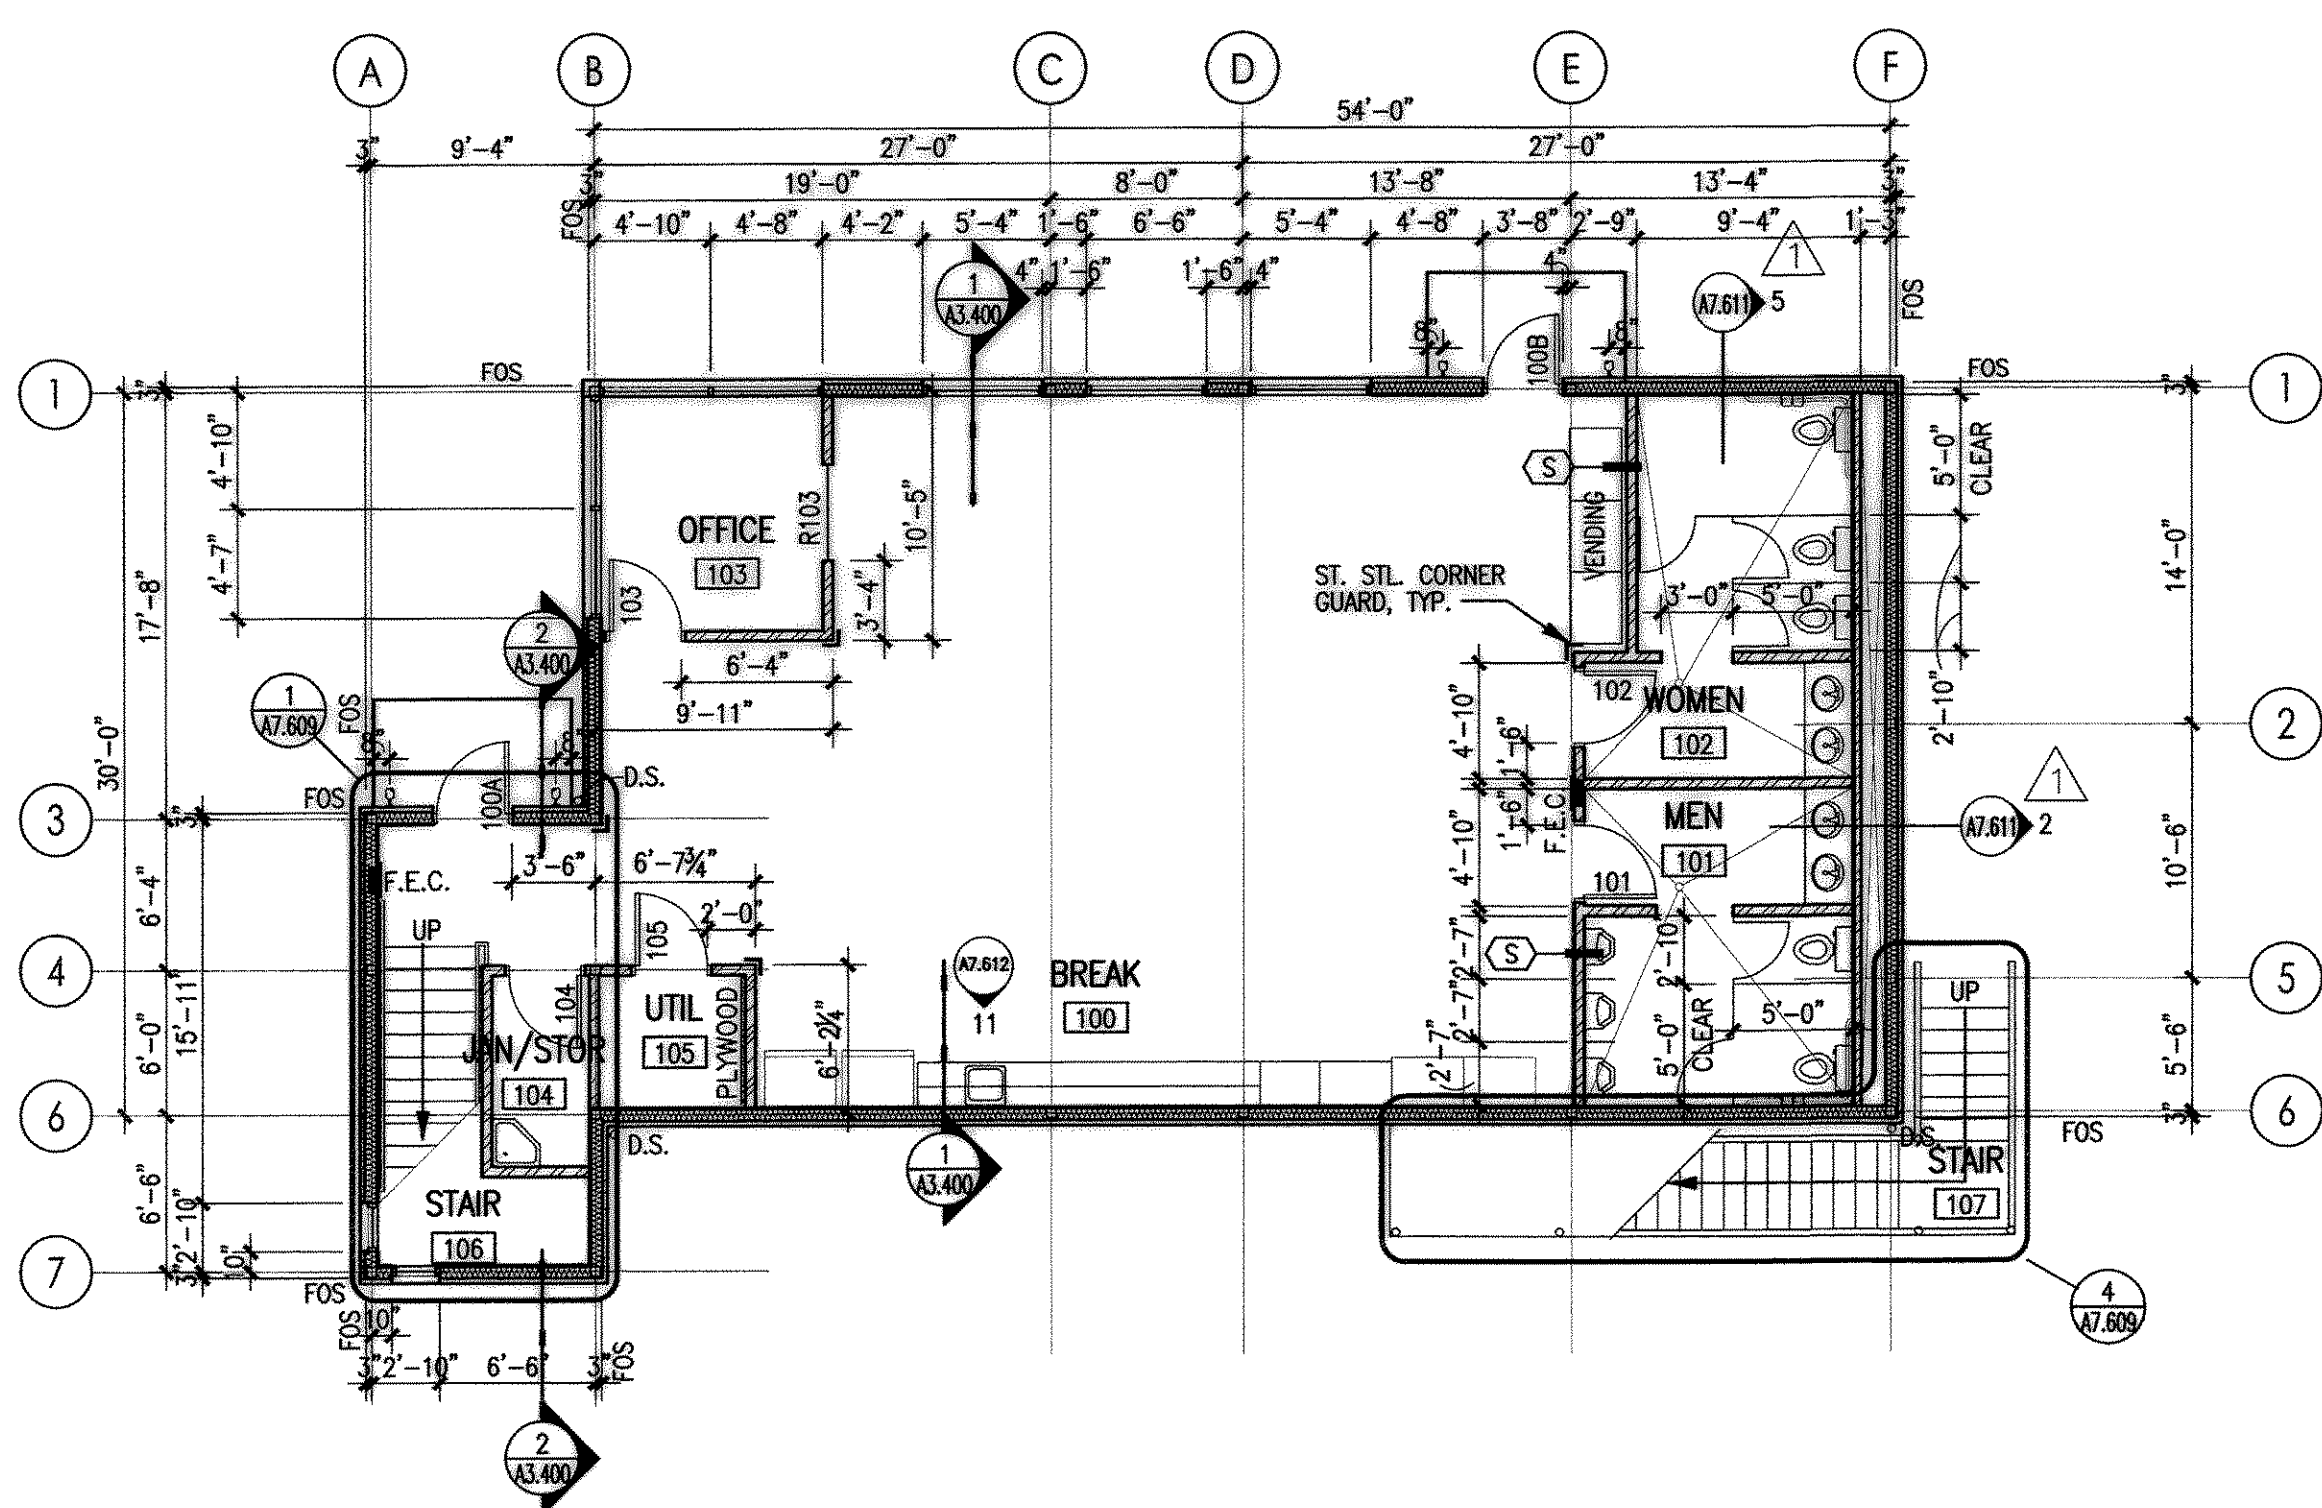

FIRST FLOOR PLAN

SCALE: 1/8"=1'-0"

PEC	E2164A_FP-01.DWG
-----	------------------

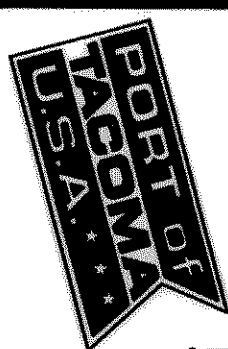

PORT OF TACOMA P.O. BOX 1837
TACOMA, WA 98401 253-383-5841



6021 12th street east
suite 201
tacoma wa 98404
tel: 253-922-6499
fax: 253-922-6499

RECORD DRAINING

APPROVED

CHIEF ENGINEER - DATE

LC 8/22/03
CHECKED BY - DATE

LC 8/22/03
PROJECT ENGR - DATE

PORT OF TACOMA
PIERCE COUNTY TERMINAL
MARINE BUILDING

EP-5554-17



A3.110
SHEET 59 OF 230

CONTRACT NUMBER: 998134
PHASE: RECORD DRAINING


6321-17

ROOF PLAN LEGEND

DESCRIPTION	SYMBOL AND TEXT
METAL DECKING refer to structural for layout, type and sizes	
METAL ROOFING 18" wide standing seam metal roof panels	
BUILDING OUTLINE BELOW	
ROOF OUTLINE	
ROOF FEATURES	
ROOFING IDENTIFICATION material type	
FEATURE IDENTIFICATION feature elevation	
SLOPE IDENTIFICATION direction indicator, rise / run	
ELEVATION IDENTIFICATION feature elevation t.o. curb t.o. parapet t.o. roof t.o. steel b.o. gutter	
ROOF ACCESS HATCH 30" w x 36" d, cricket at up slope side	
ROOF TOP MECHANICAL UNIT unit number, unit weight, unit dimensions, hvac unit on 12" ht. built-up curb with flashing	
ROOF GUTTER continuous watertight metal gutter, slope to d.s.	
DOWNSPOUT refer to RP for size and locations	

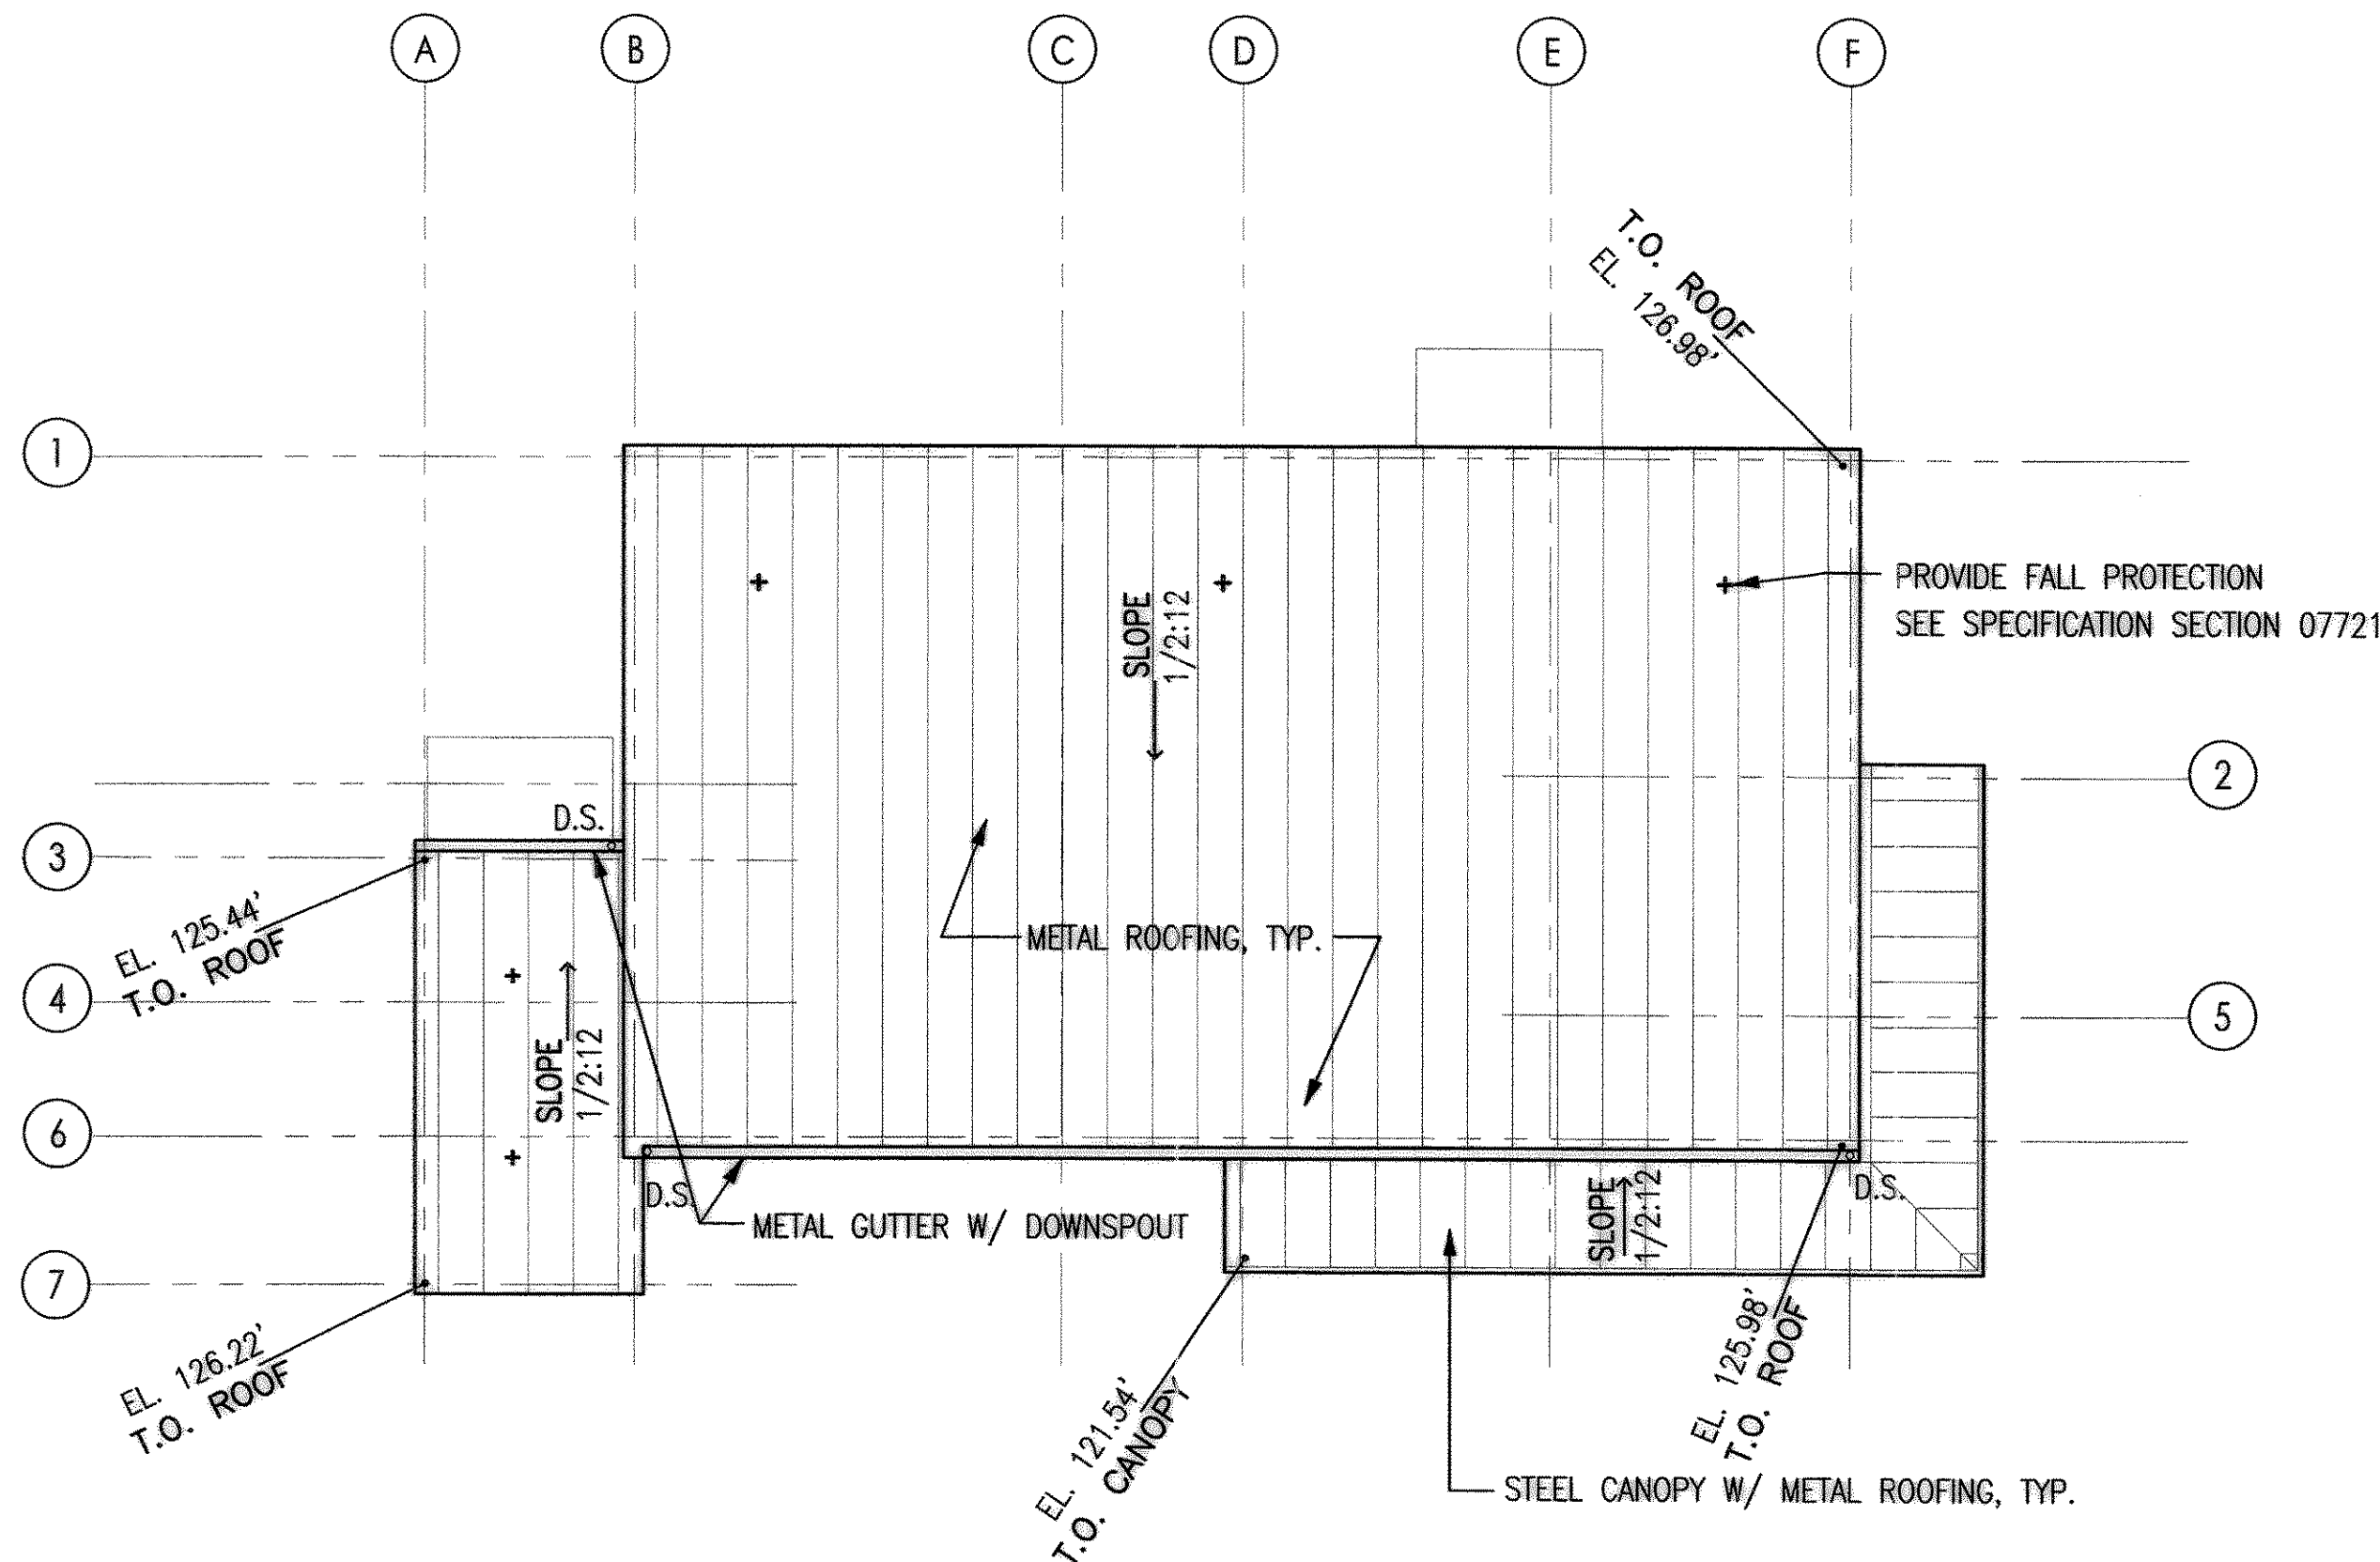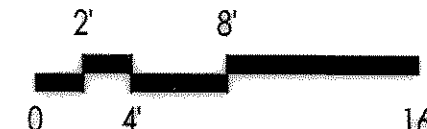

1 ROOF PLAN
SCALE: 1/8"=1'-0"
PEC E2164A_2-RP-01.DWG

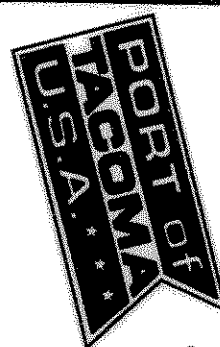

PORT OF TACOMA, P.O. BOX 1837
TACOMA, WA 98401 253-383-6841



6021 12th street east
Tacoma, WA 98424
Tel: 253-922-9037
Fax: 253-922-6499

RECORD DRAWING

APPROVED

CHIEF ENGINEER - DATE

LC 8/22/03
CHECKED BY - DATE
LC 8/22/03
PROJECT ENGR - DATE


PORT OF TACOMA
PIERCE COUNTY TERMINAL
MARINE BUILDING

EP-5551-17

A3.120
SHEET 60 OF 230


CONTRACT NUMBER: 988154
E NUMBER: E1974
PHASE: RECORD DRAWING

6321-17

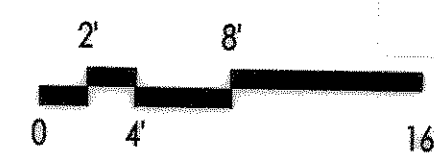

REFLECTED CEILING PLAN LEGEND

DESCRIPTION	SYMBOL AND TEXT
CEILING IDENTIFICATION room number material ceiling height	
SOFFIT material item height	
TYPE 1 SUSPENDED ACOUSTICAL CEILING SYSTEM 2'x4' tiles, refer to RCP for grid starting point, otherwise center layout in space - typical	
GWB CEILING SYSTEM gwb ceiling system	
SLOPED CEILING IDENTIFICATION direction indicator, rise / run, refer to RCP for ceiling heights and starting point	
RECESSED FLUORESCENT LIGHT FIXTURE 2'x4' fixture, 2'x2' fixture coordinate with electrical	
SURFACE MOUNTED FLUORESCENT LIGHT FIXTURE 1'x4' fixture, 1'x2' fixture coordinate with electrical	
SUSPENDED FLUORESCENT LIGHT FIXTURE 1'x4' fixture, 1'x2' fixture coordinate with electrical, refer to RCP for height of fixture	
RECESSED DOWN LIGHT FIXTURE center fixture in ceiling tile or at spacing dimensioned on RCP, refer to electrical for fixture type	
SPRINKLER HEAD center head in ceiling tile or at spacing dimensioned on RCP, refer to fire protection	
SUSPENDED TRACK AND ADJUSTABLE LIGHT FIXTURES coordinate location with interior furnishings, refer to RCP for mounting height	
WALL MOUNTED EXIT SIGN center over exit door, mount at 8'-0" o.f.f.	
RECESSED SUPPLY AIR DIFFUSER 2'x2' fixture, coordinate with mechanical	
RECESSED RETURN AIR DIFFUSER 2'x2' fixture, coordinate with mechanical	

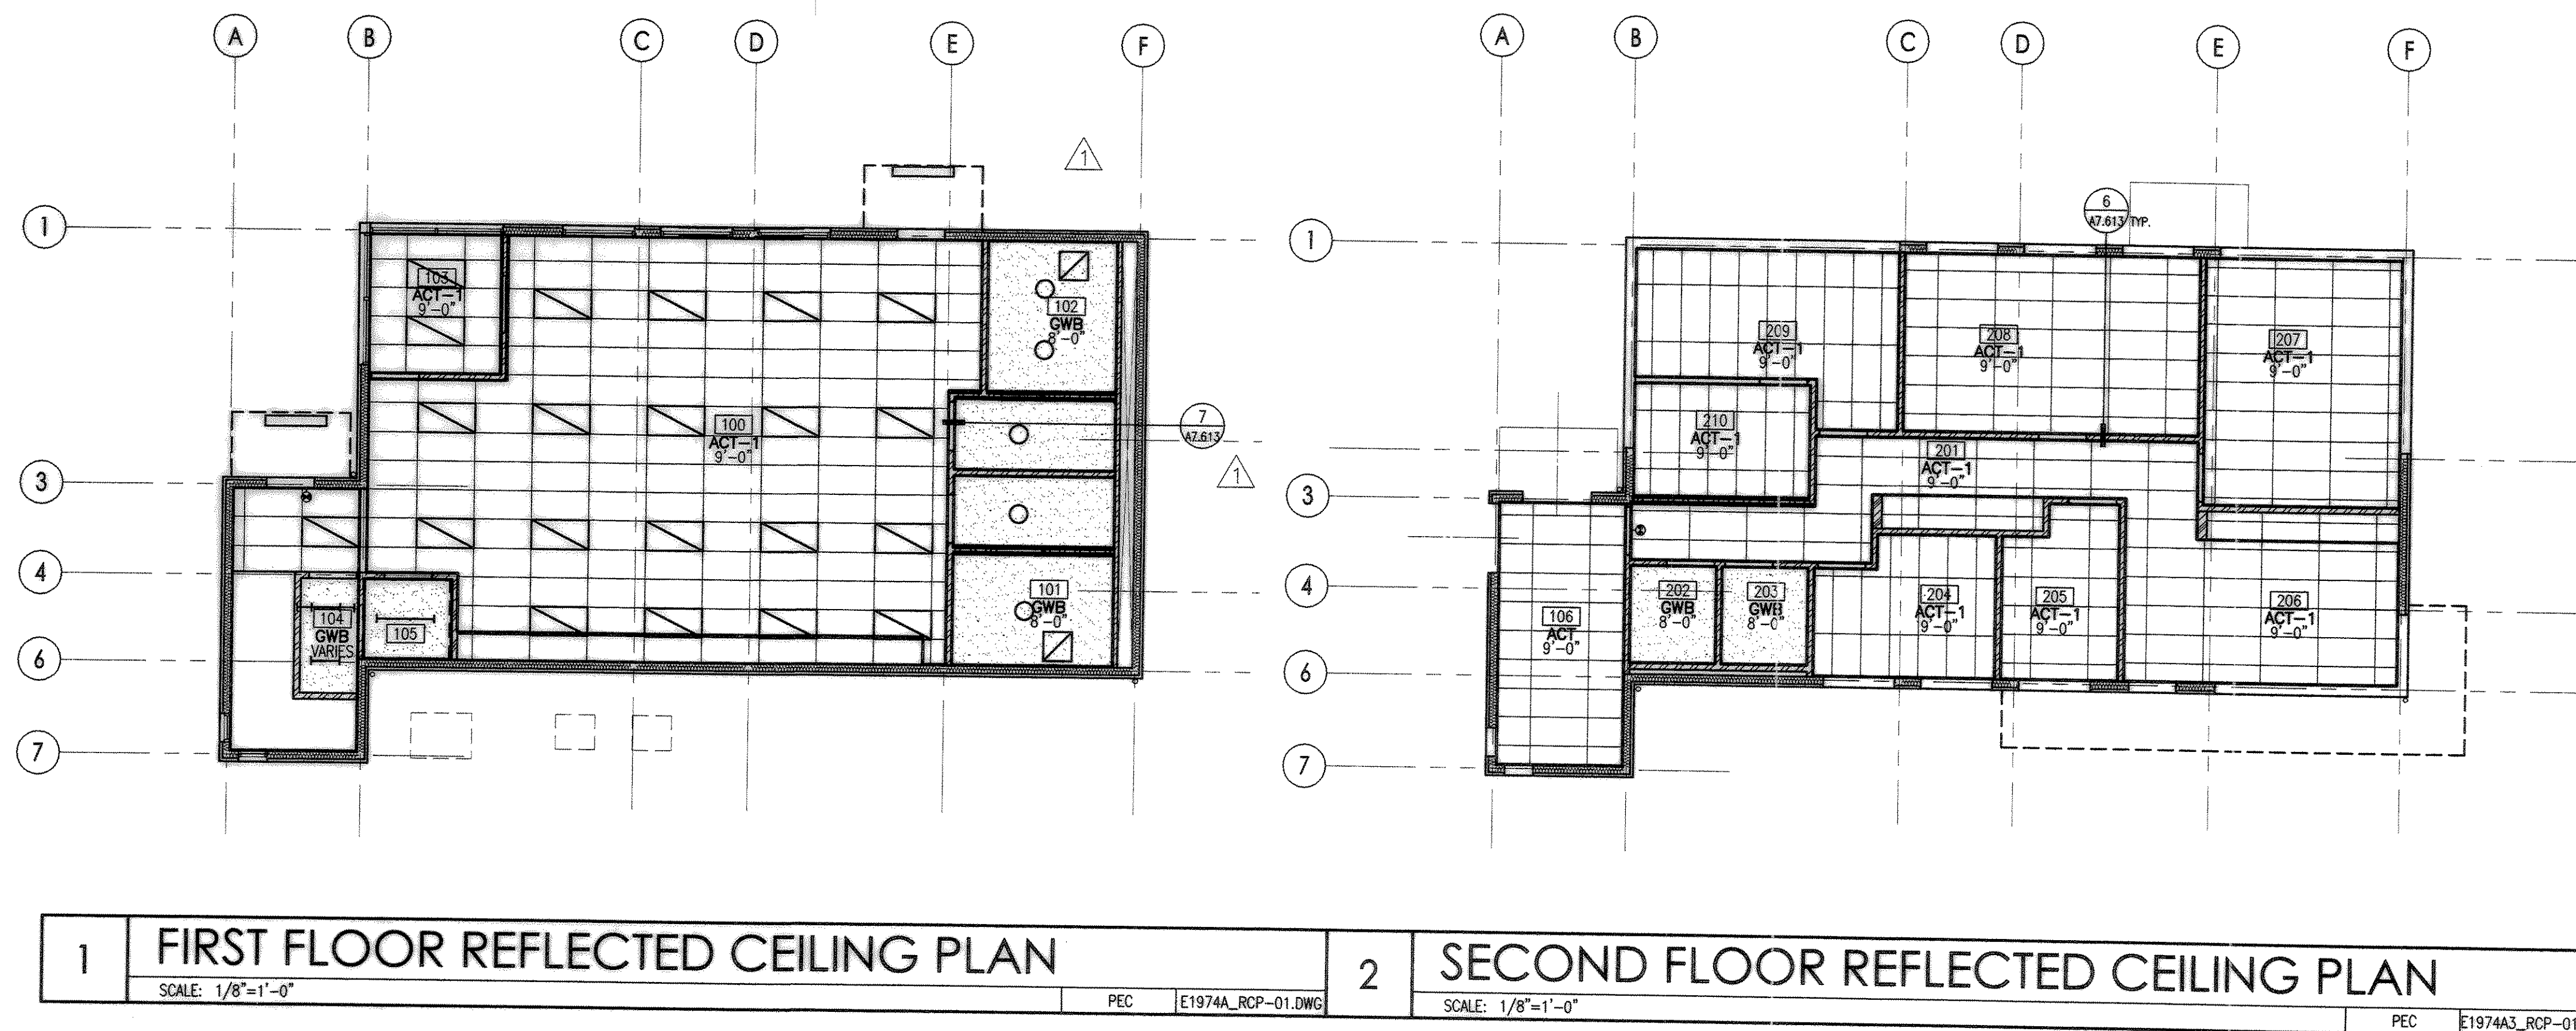

1 FIRST FLOOR REFLECTED CEILING PLAN

SCALE: 1/8"=1'-0"

PEC E1974A_RCP-01.DWG

2 SECOND FLOOR REFLECTED CEILING PLAN

SCALE: 1/8"=1'-0"

PEC E1974A3_RCP-01.DWG

**PORT OF TACOMA P.O. BOX 1837
TACOMA, WA 98401 253-383-6841**

Helix

6021 12th street east
suite 201
tacoma, wa. 98424
tel: 253 . 922. 9037
fax: 253 . 922. 6499

[illegible]

APPROVED

CHIEF ENGINEER -- DATE

LC 8/22/03
CHECKED BY - DATE
LC 8/22/03
PROJECT ENGR. - DATE

**PORT OF TACOMA
PIERCE COUNTY TERMINAL
MARINE BUILDING**

EP-5551-17

A3.200
SHEET 61 OF 230

E NUMBER: E1974
PHASE: RECORD DRAWING

NO.	DOOR					RATING	HARDWARE GROUP	FRAME				NOTES
	SIZE	TYPE	MATERIAL	FINISH	GLAZING			MATERIAL	FINISH	TYPE	GLAZING	
100A	3'-0"x7'-0"	4	HM	PT	F	+	4	HM	PT	1	-	ELECTRIC STRIKE
100B	3'-0"x7'-0"	4	HM	PT	F	+	4	HM	PT	1	-	-
101	3'-0"x7'-0"	1	WD	ST	-	-	16	HM	PT	1	-	-
102	3'-0"x7'-0"	1	WD	ST	-	-	16	HM	PT	1	-	-
103	3'-0"x7'-0"	1	WD	ST	-	-	2	HM	PT	1	-	-
104	3'-0"x7'-0"	1	HM	PT	-	-	2	HM	PT	1	-	-
105	3'-0"x7'-0"	1	HM	PT	-	-	2	HM	PT	1	-	-
201	3'-0"x7'-0"	4	HM	PT	F	+	12	HM	PT	1	-	-
202	3'-0"x7'-0"	1	WD	ST	-	-	6	HM	PT	1	-	-
203	3'-0"x7'-0"	1	WD	ST	-	-	6	HM	PT	1	-	-
204	3'-0"x7'-0"	1	WD	ST	-	-	2	HM	PT	1	-	-
205	3'-0"x7'-0"	1	WD	ST	-	-	2	HM	PT	1	-	-
206	3'-0"x7'-0"	4	HM	PT	F	+	21	HM	PT	1	-	-
207	3'-0"x7'-0"	1	WD	ST	-	-	3	HM	PT	1	-	-
208	3'-0"x7'-0"	1	WD	ST	-	-	2	HM	PT	1	-	-
209	3'-0"x7'-0"	1	WD	ST	-	-	3	HM	PT	1	-	-
210	3'-0"x7'-0"	1	WD	ST	+	+	2	HM	PT	2	+	-
R103	4'-0"x4'-0"	-	-	-	-	-	-	HM	PT	1	-	-

GENERAL NOTES

- ① +


1. REFER TO PROJECT SPECIFICATION, SECTION 08710, "HARDWARE" FOR HARDWARE GROUPS.
2. REFER TO PROJECT SPECIFICATION, SECTION 08800, "GLAZING" FOR GLAZING TYPES.
3. REFER TO PROJECT SPECIFICATION, SECTION 01910, "COLOR AND MATERIALS" FOR FINISHES.
4. DOOR, FRAME, AND RELITE TYPES NOT SCHEDULED, ARE NOT USED.

[illegible]


GENERAL NOTES

- ① INSTALL FRP AT 54" HT A.F.F. ²
- ② SEE DETAIL 10/A7.613 FOR VCT FLOOR PATTERN


1. REFER TO PROJECT SPECIFICATION, SECTION 01910, "COLOR AND MATERIALS" FOR FINISHES.

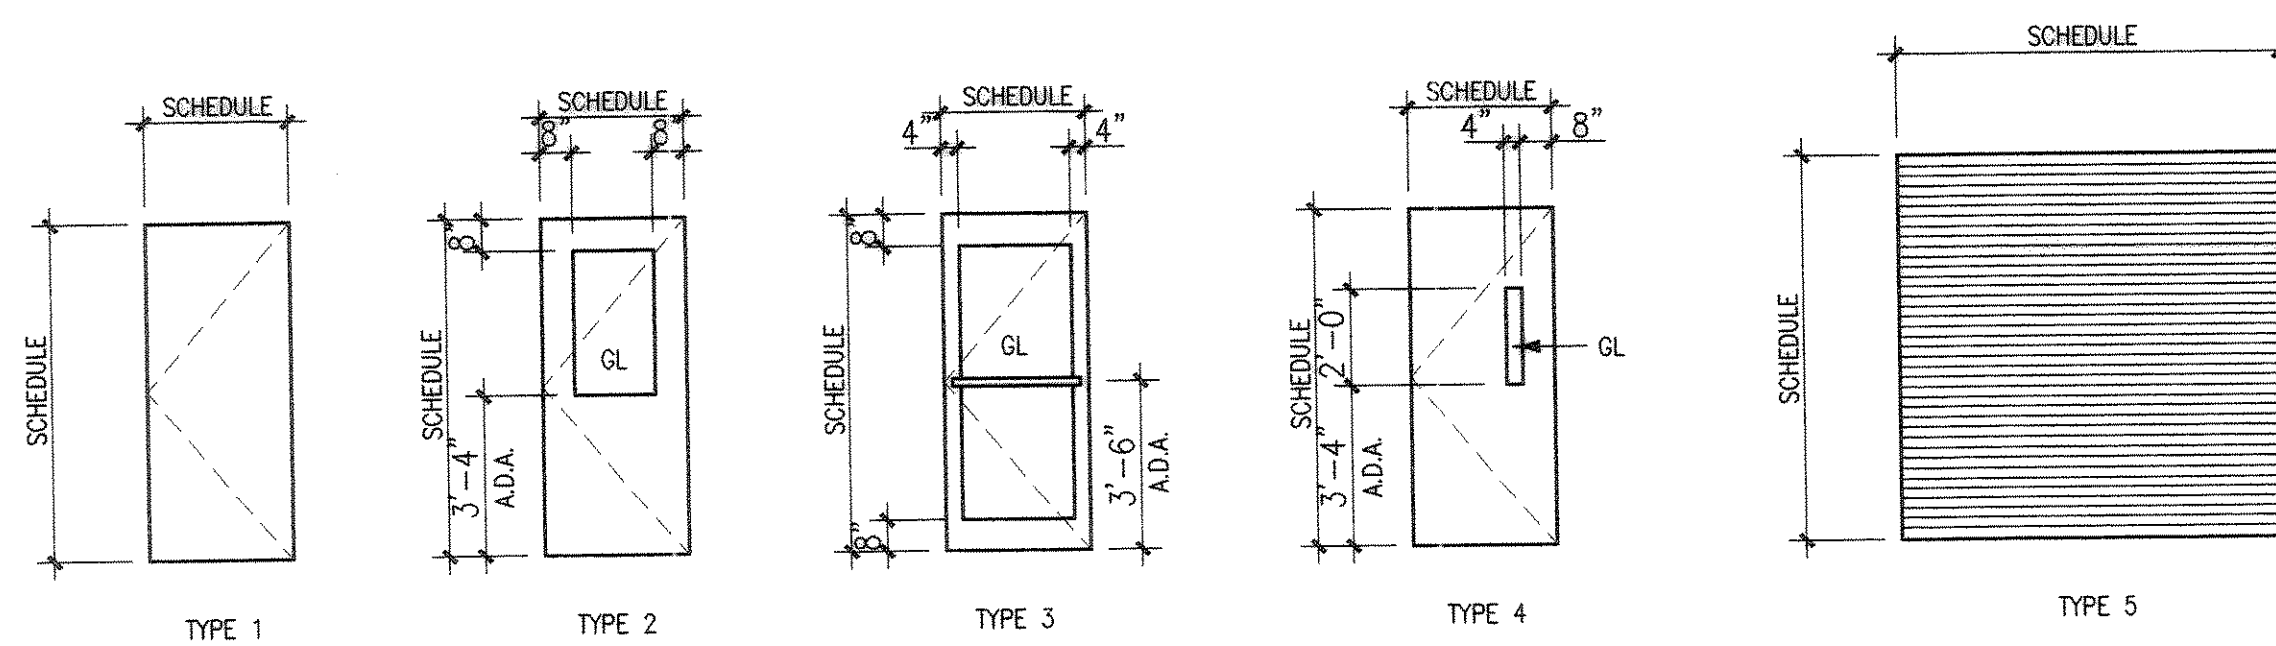

SCALE: $1/4" = 1' - 0"$

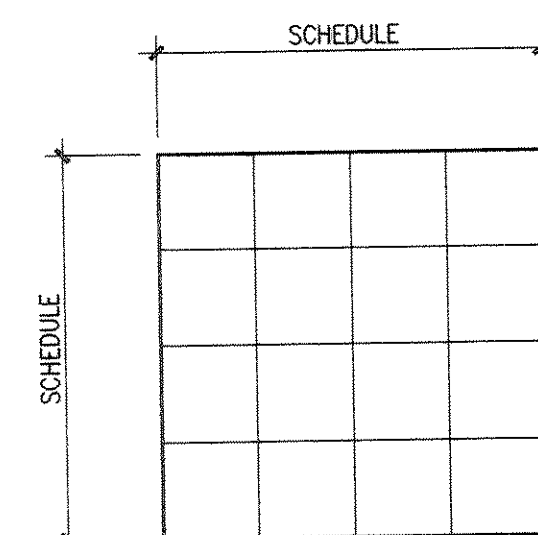


TYPE 6 (FABRIC)

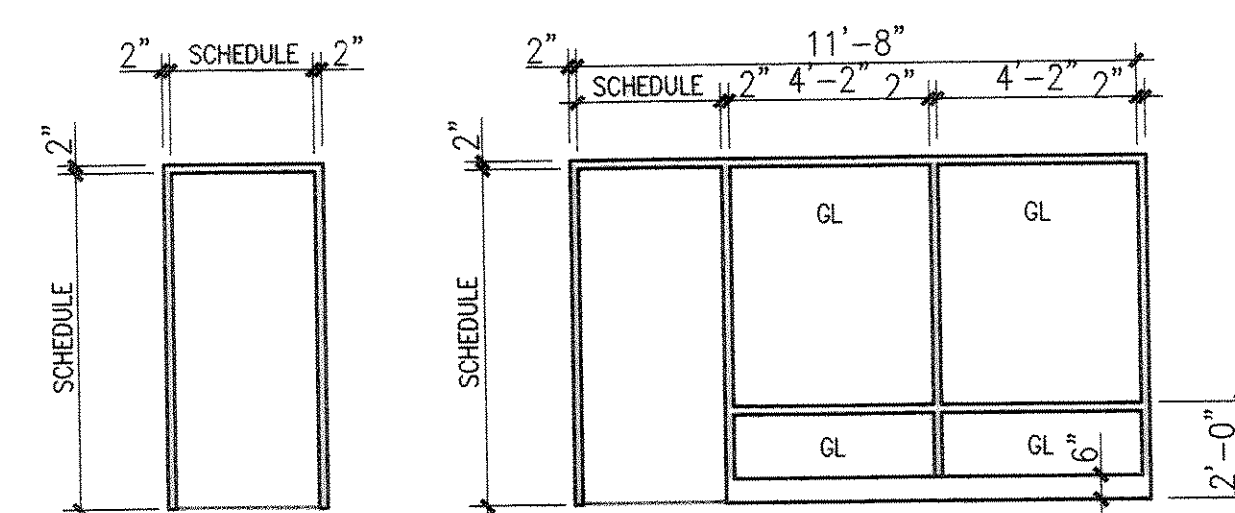

TYPE 1


TYPE 2

SCALE: $1/4" = 1'-0"$

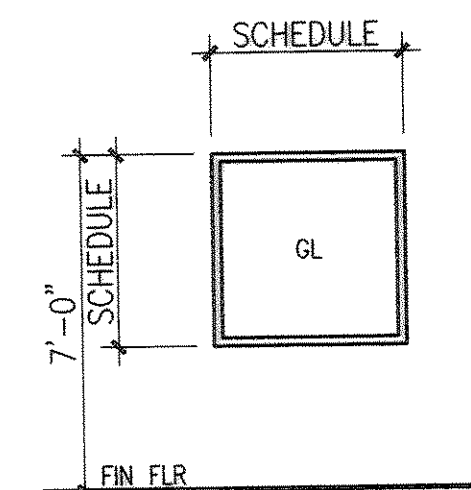


TYPE 1

SCALE: $1/4" = 1'-0"$

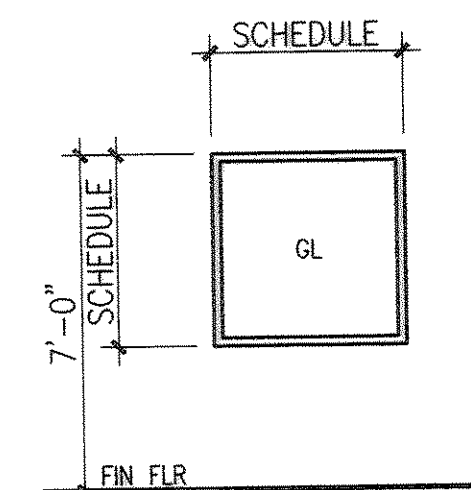

SCALE: $1/4" = 1'-0"$

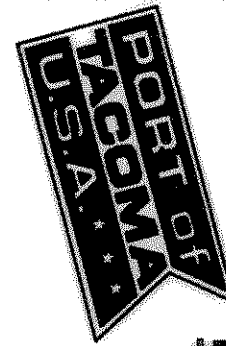

PORT OF TACOMA, P.O. BOX 1837
TACOMA, WA 98401 253-383-5841

6021 12th street east
suite 201
Tacoma WA 98404
tel: 253.922.6434
fax: 253.922.6499

RECORD DRAWING

APPROVED

CHIEF ENGINEER - DATE

LC 8/22/03
CHECKED BY - DATE

PROJECT ENGR - DATE



PORT OF TACOMA
PIERCE COUNTY TERMINAL
MARINE BUILDING

TOWNSHIP RANGE SECTION


DRAWING SCALE: 1/8" = 1'-0"

EP-5554-17
A3.300
SHEET 62 OF 230


6321-17

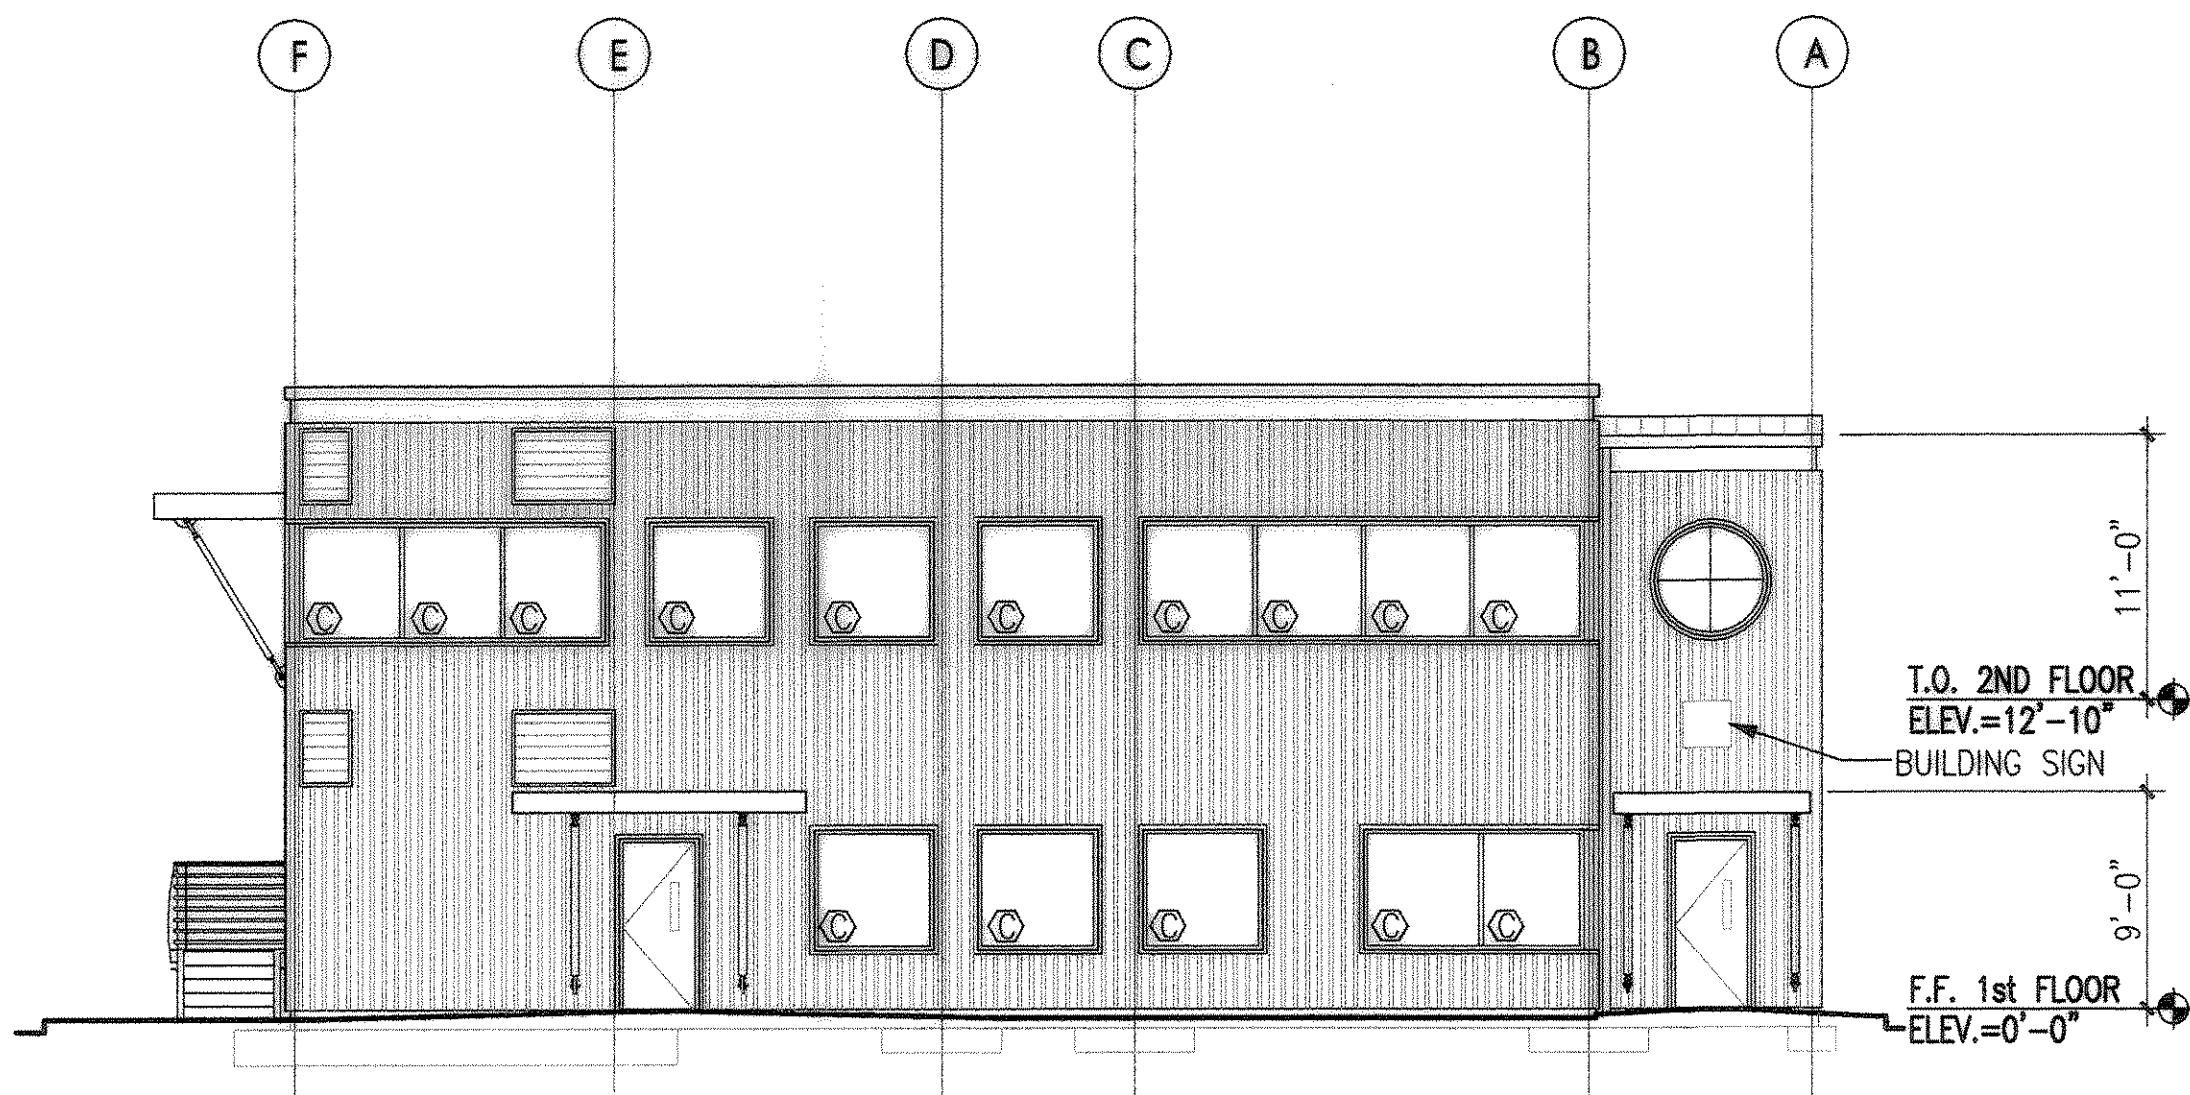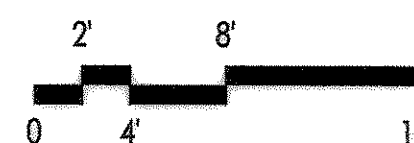


1 NORTH ELEVATION
SCALE: 1/8"=1'-0" PEC E2164A_2-EL-01.DWG

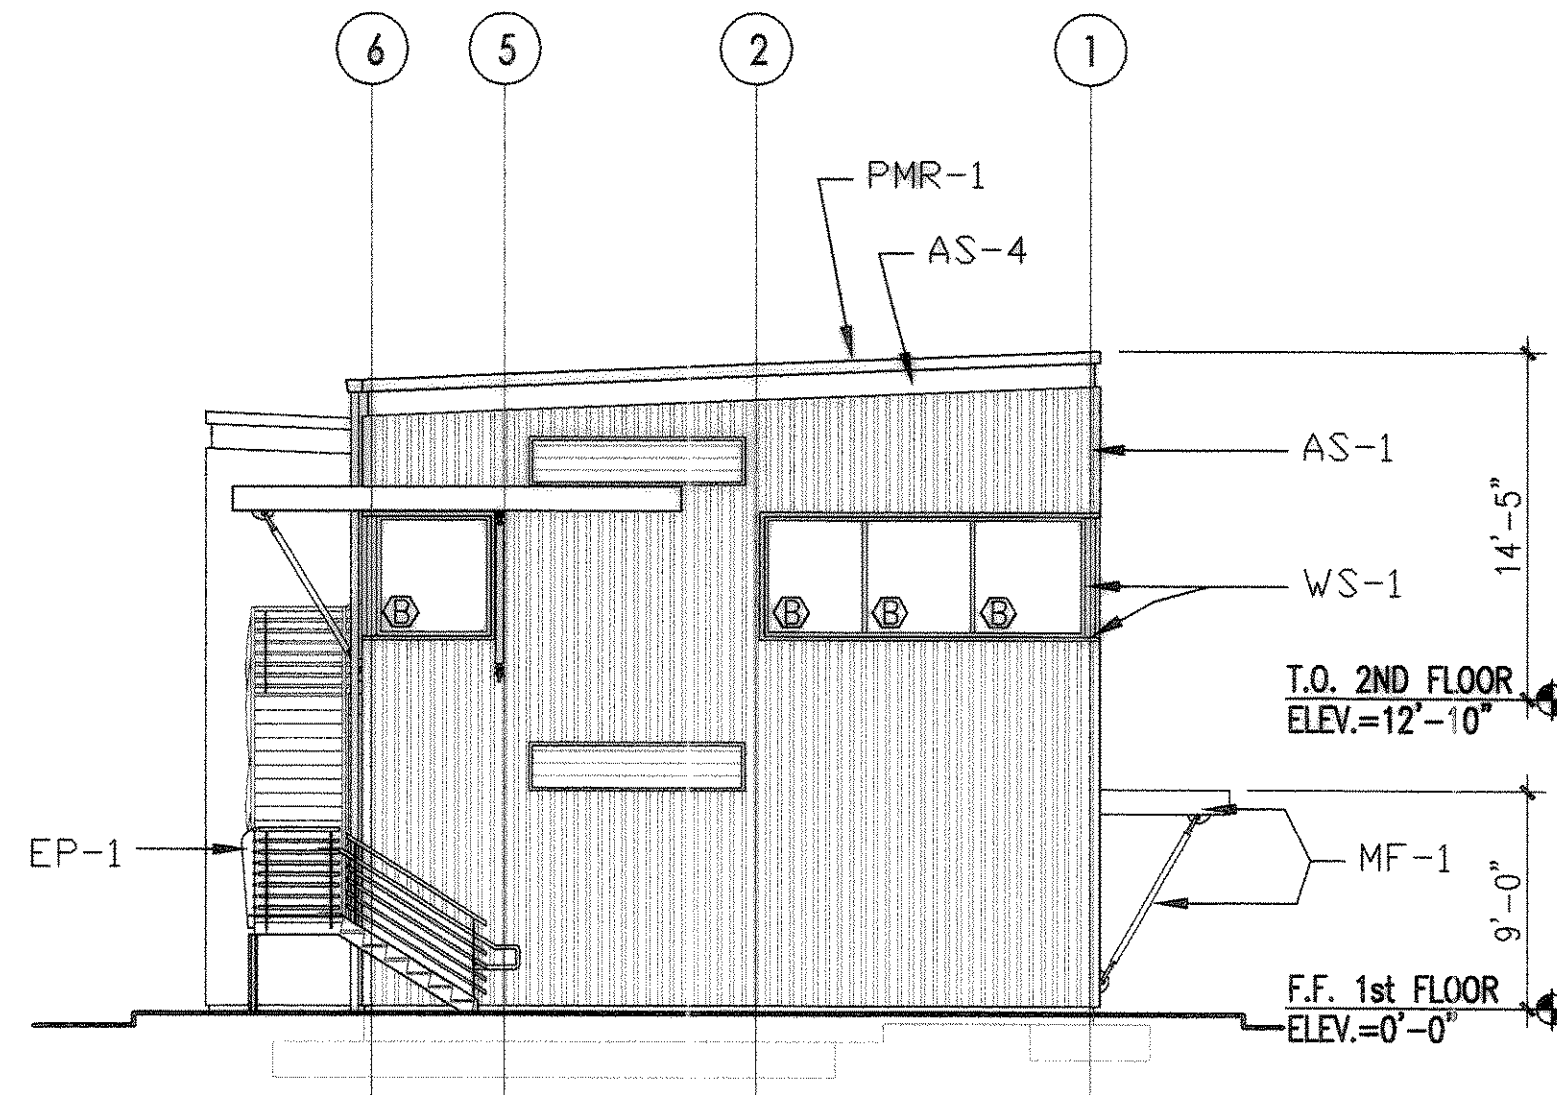


2 EAST ELEVATION
SCALE: 1/8"=1'-0" PEC E2164A_2-EL-01.DWG

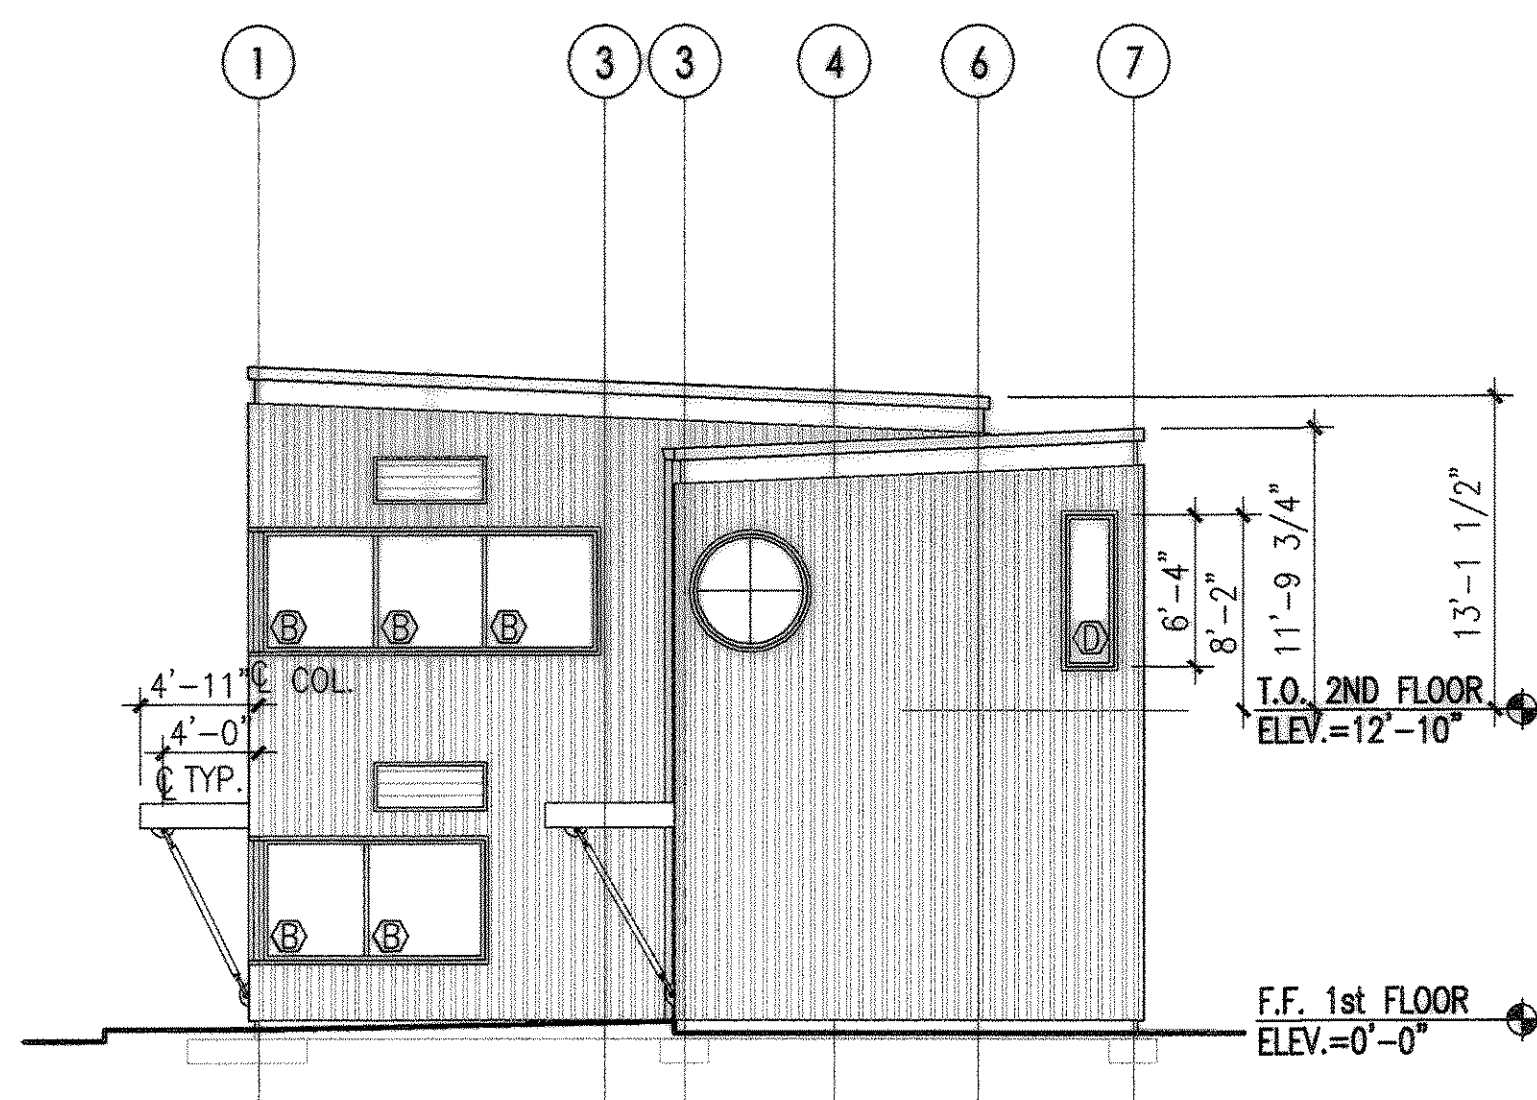

3 WEST ELEVATION
SCALE: 1/8"=1'-0" PEC E2164A_2-EL-01.DWG

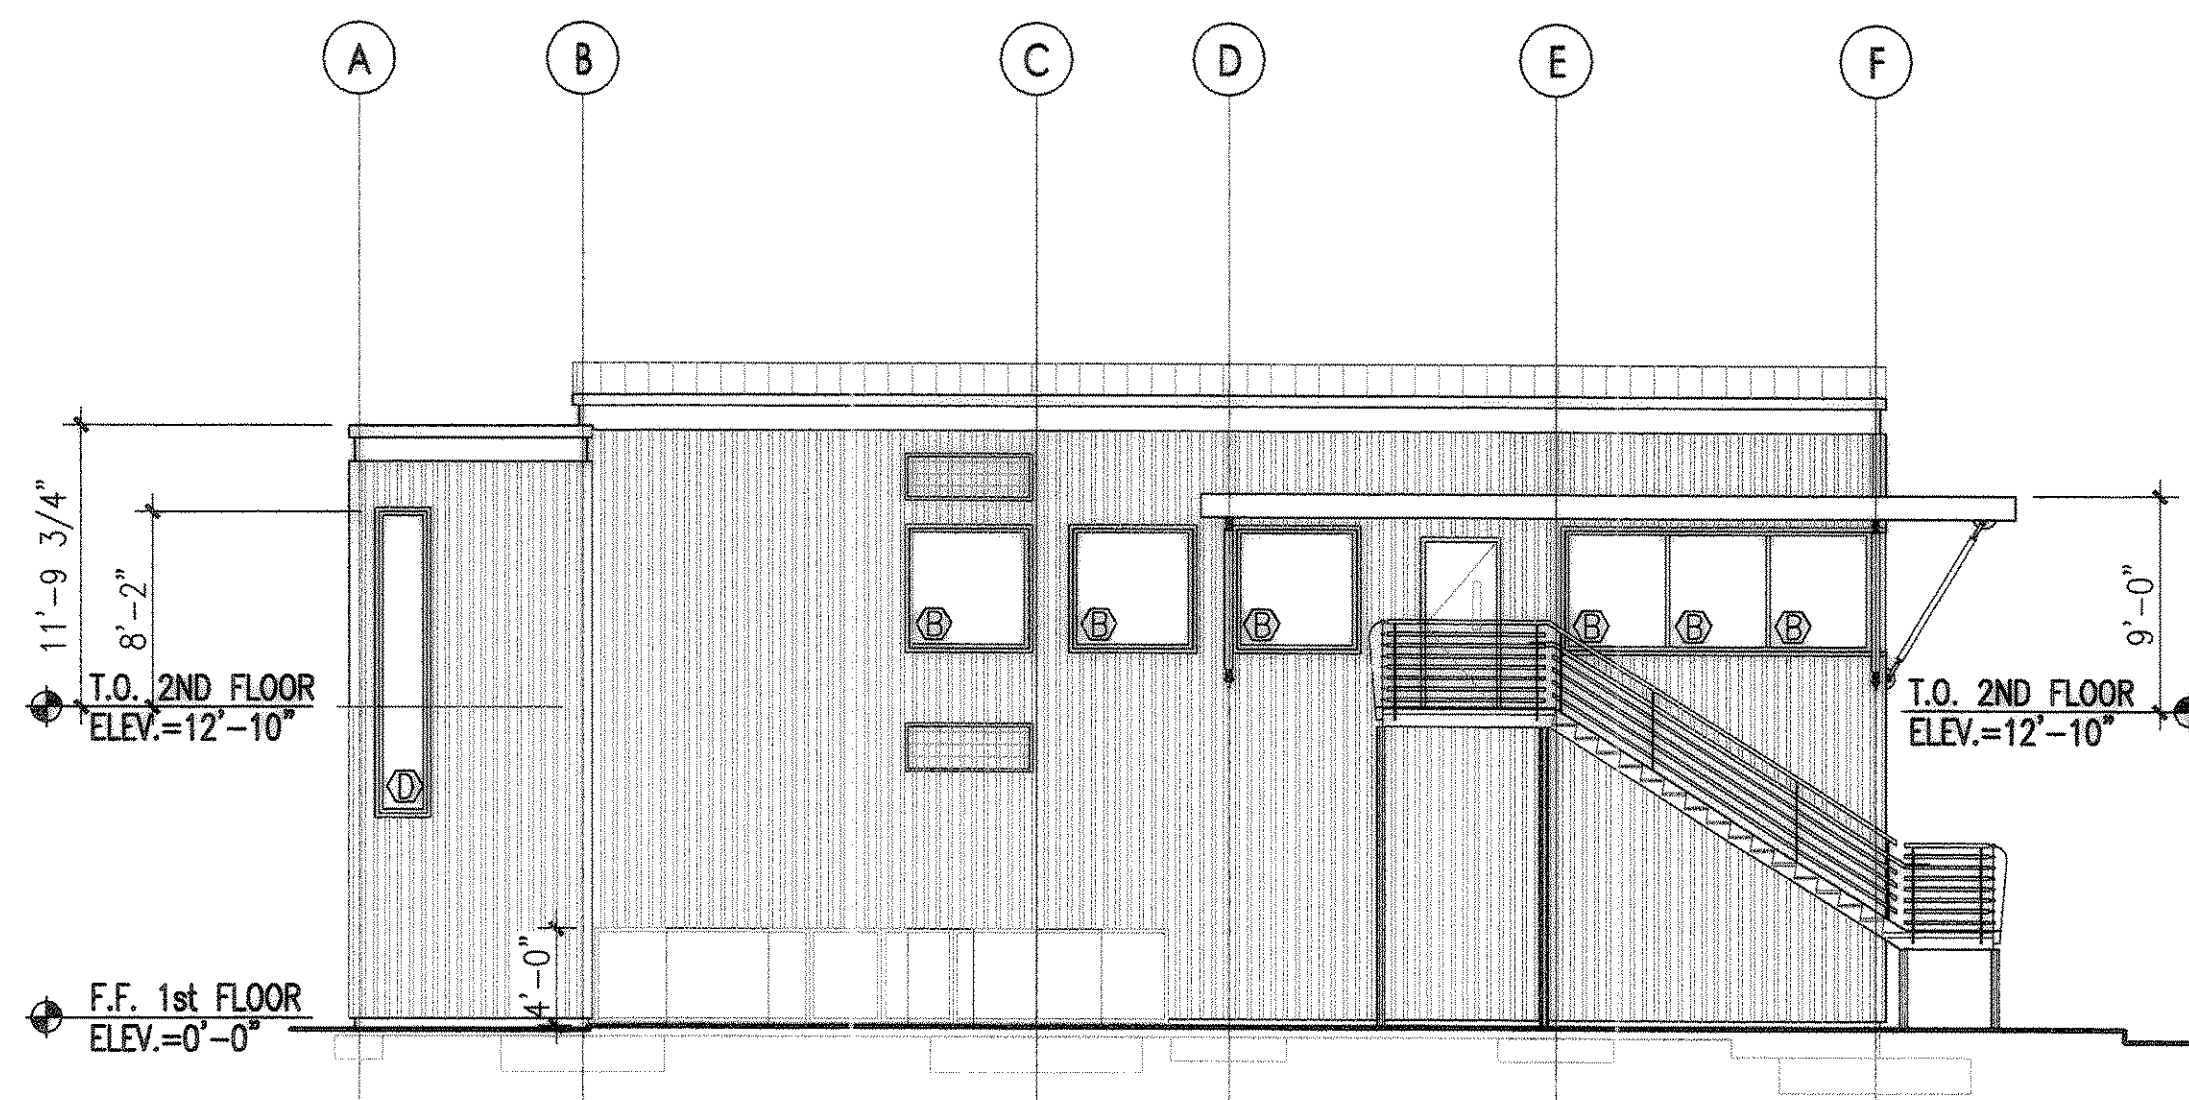

4 SOUTH ELEVATION
SCALE: 1/8"=1'-0" PEC E2164A_2-EL-01.DWG

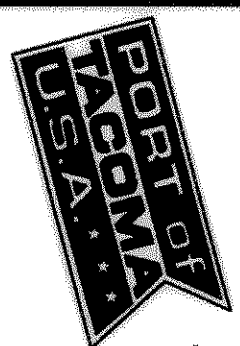

PORT OF TACOMA P.O. BOX 1837
TACOMA, WA 98401 253-383-6841



6021 12th street east
suite 201
tacoma, wa 98424
tel: 253.922.7402
fax: 253.922.0497

RECORD DRAWING

APPROVED

CHIEF ENGINEER - DATE

LC 8/22/03
CHECKED BY - DATE

LC 8/22/03
PROJECT ENGR. - DATE

PORT OF TACOMA
PIERCE COUNTY TERMINAL
MARINE BUILDING



EP-5554-17

A3.400
SHEET 63 OF 230

CONTRACT NUMBER: 998154

DATE: 8/22/03


6321-17

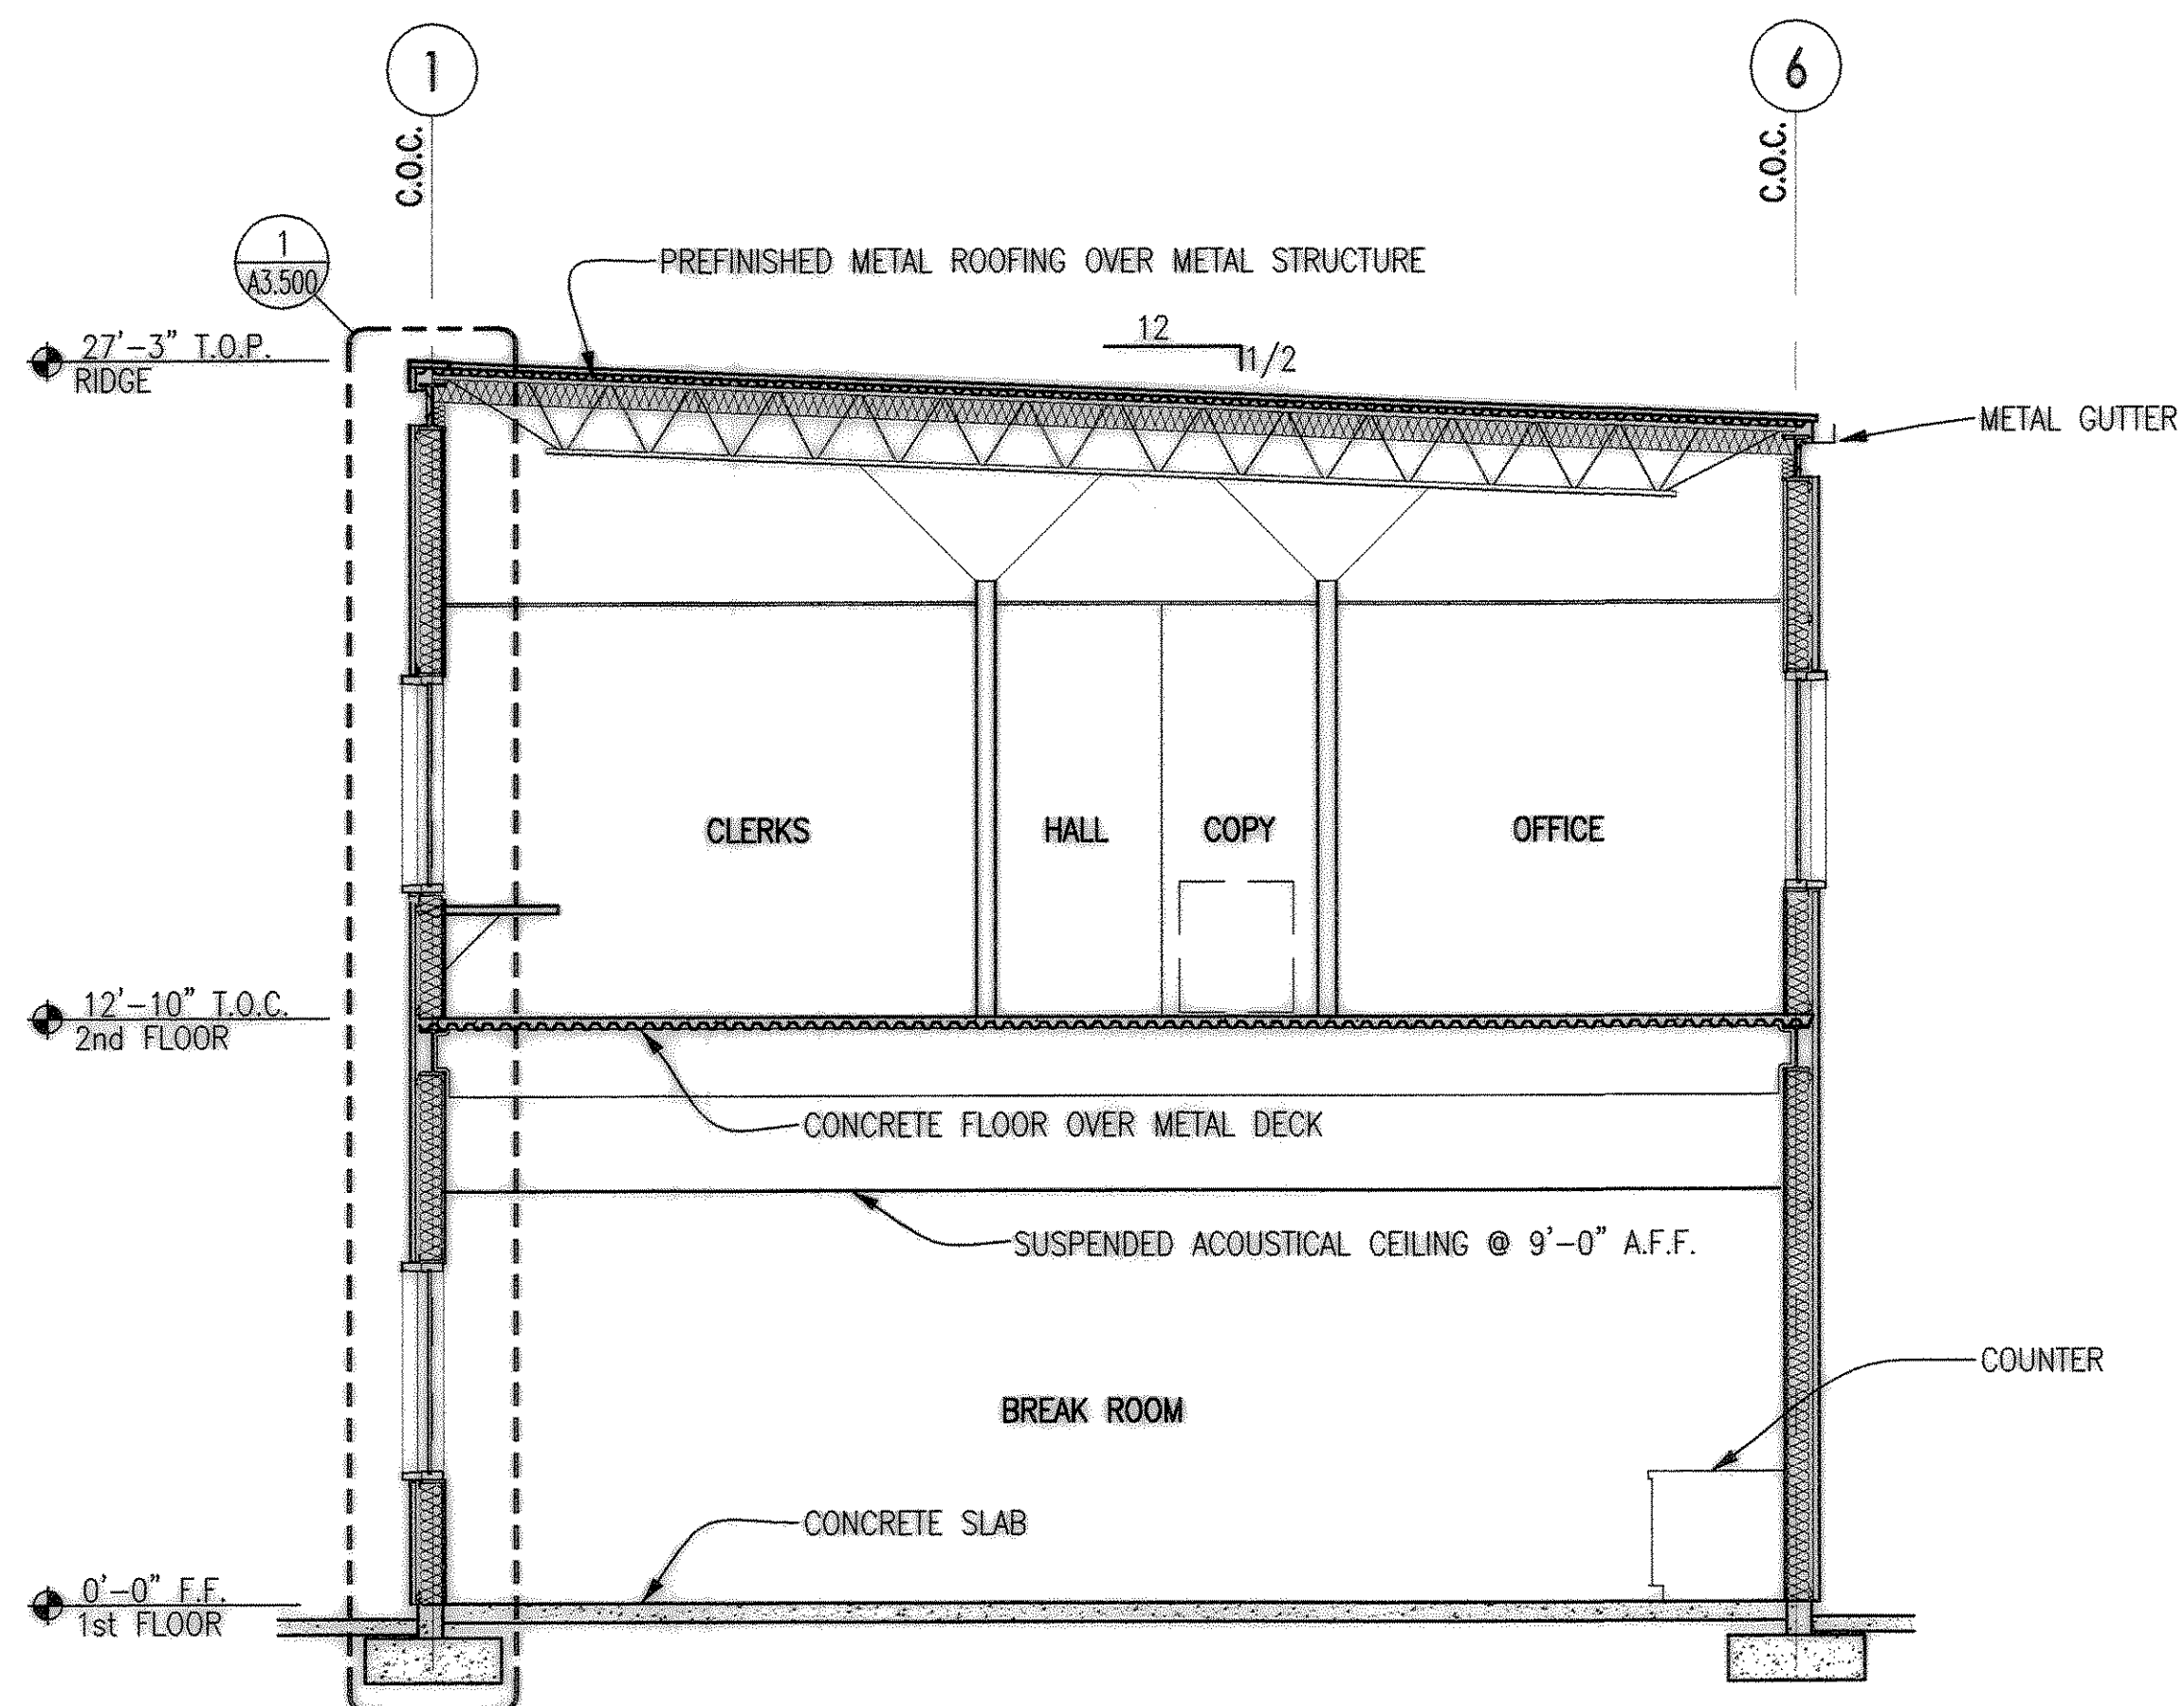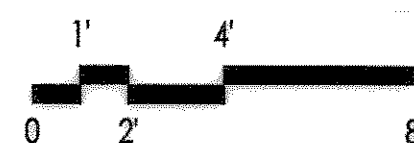

1 BUILDING SECTION

SCALE: 1/4"=1'-0"


PEC E2164A_2-BS-01.DWG

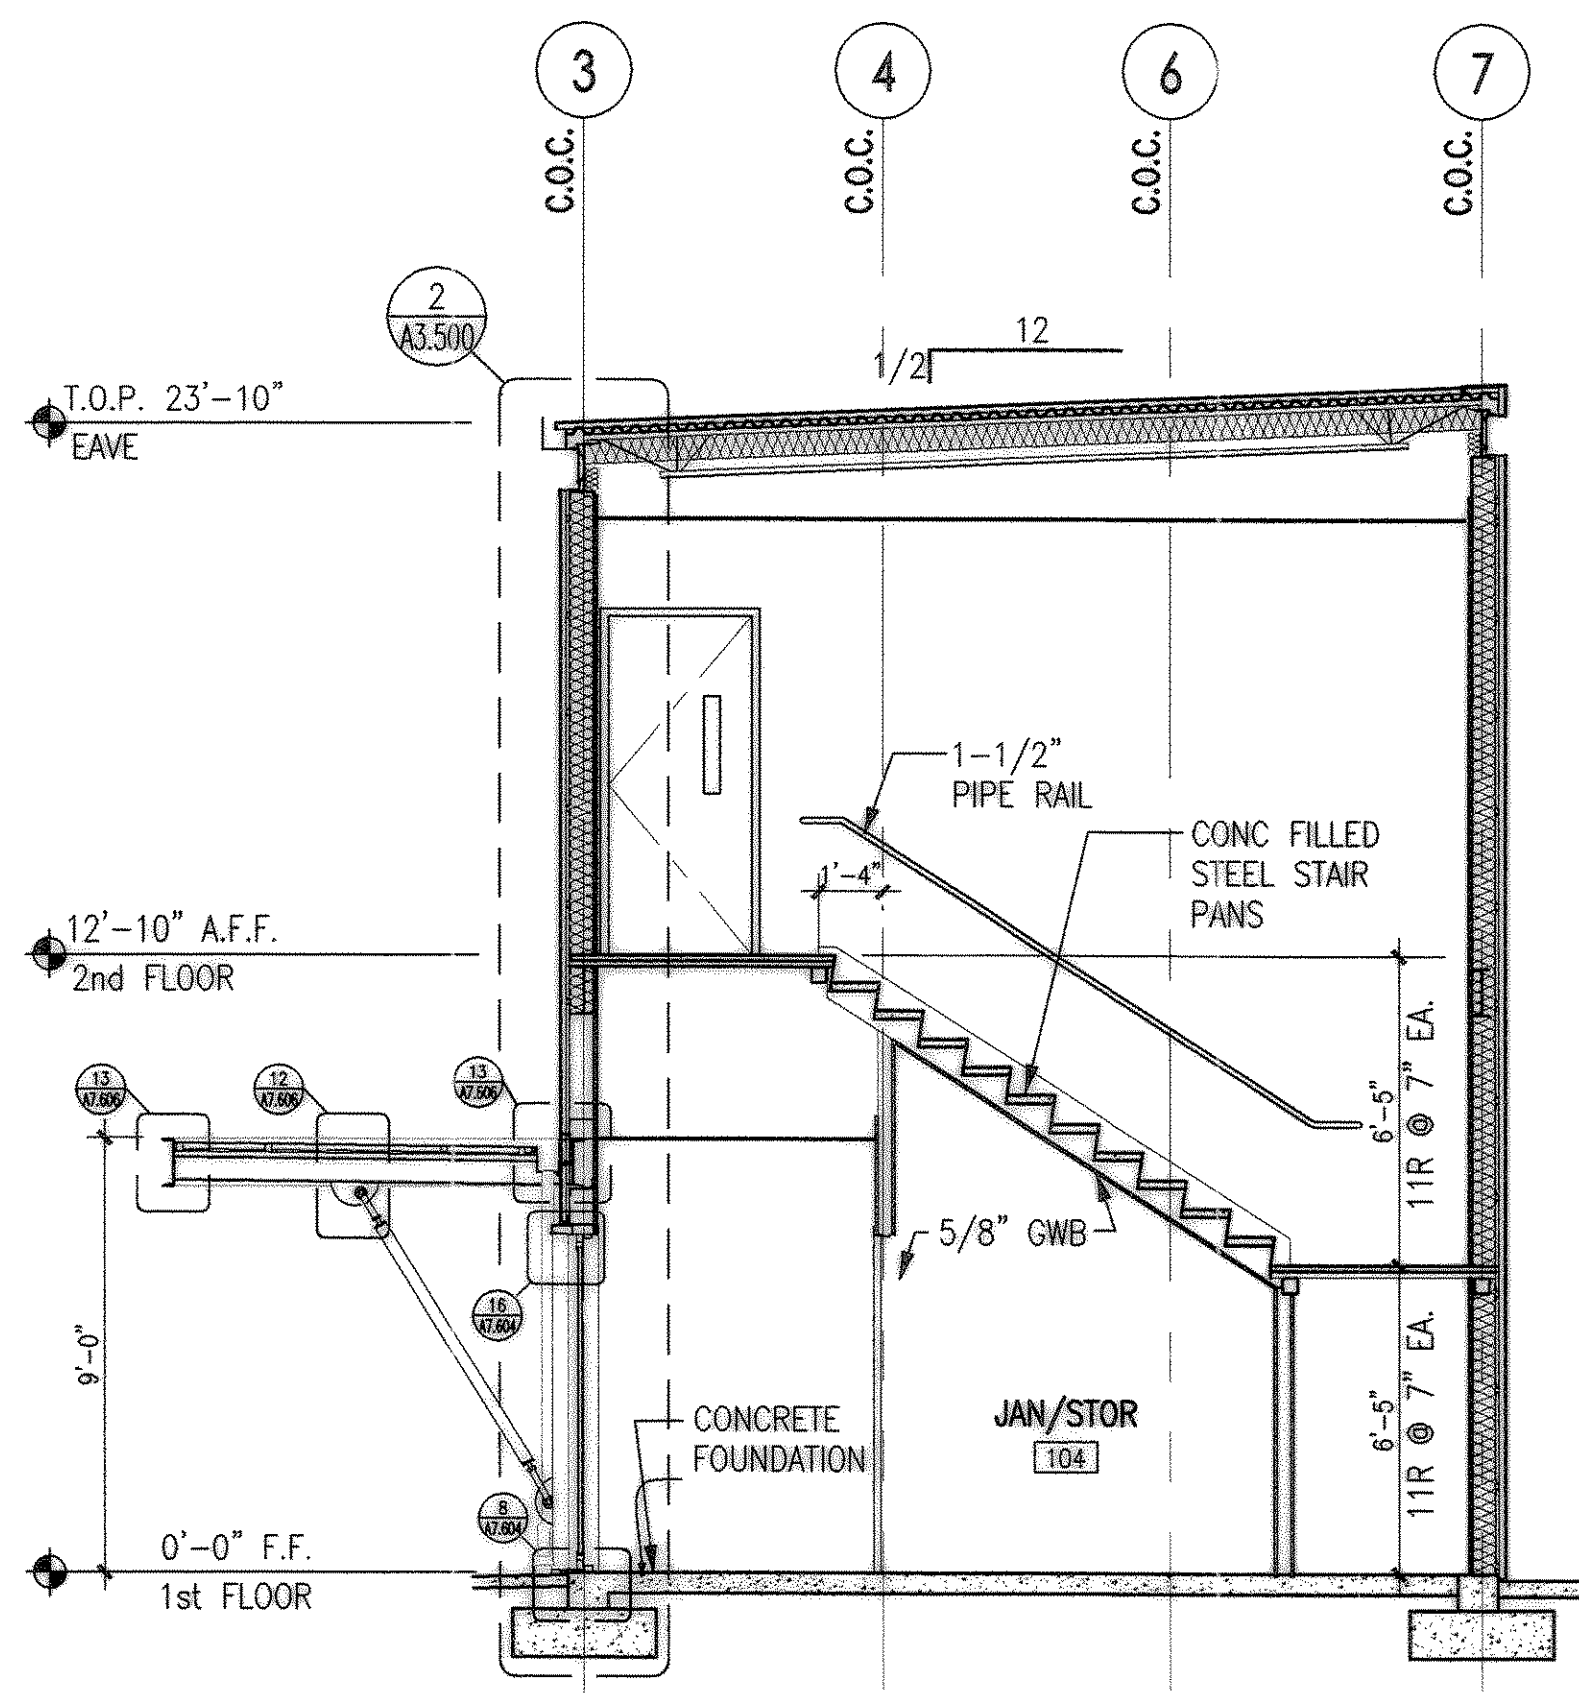

2 STAIR SECTION

SCALE: 1/4"=1'-0"

PEC E2164A_2-BS-01.DWG

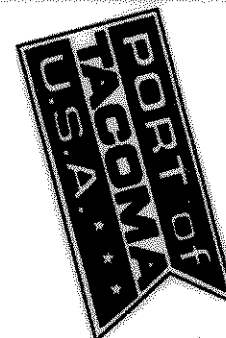

PORT OF TACOMA P.O. BOX 1837
TACOMA, WA 98401 253-383-6841

Helix
6021 12th street east
Suite 201
Tacoma, WA 98404
tel: 253.922.6494
fax: 253.922.6499

RECORD DRAWING

APPROVED

CHIEF ENGINEER - DATE

CHECKED BY - DATE



PROJECT ENGR - DATE

PORT OF TACOMA
PIERCE COUNTY TERMINAL
MARINE BUILDING


DRAWING DATE: 12/20/04
DRAWN BY: JES
PORT PARCEL: 1
TOWNSHIP: RANGE: SECTION:
DRAWING SCALE: 1/2" = 1'-0"

EP-6561-17
A3.500
SHEET 64 OF 230
CONTRACT NUMBER: 996114
PHASE: RECORD DRAWING


6321-17

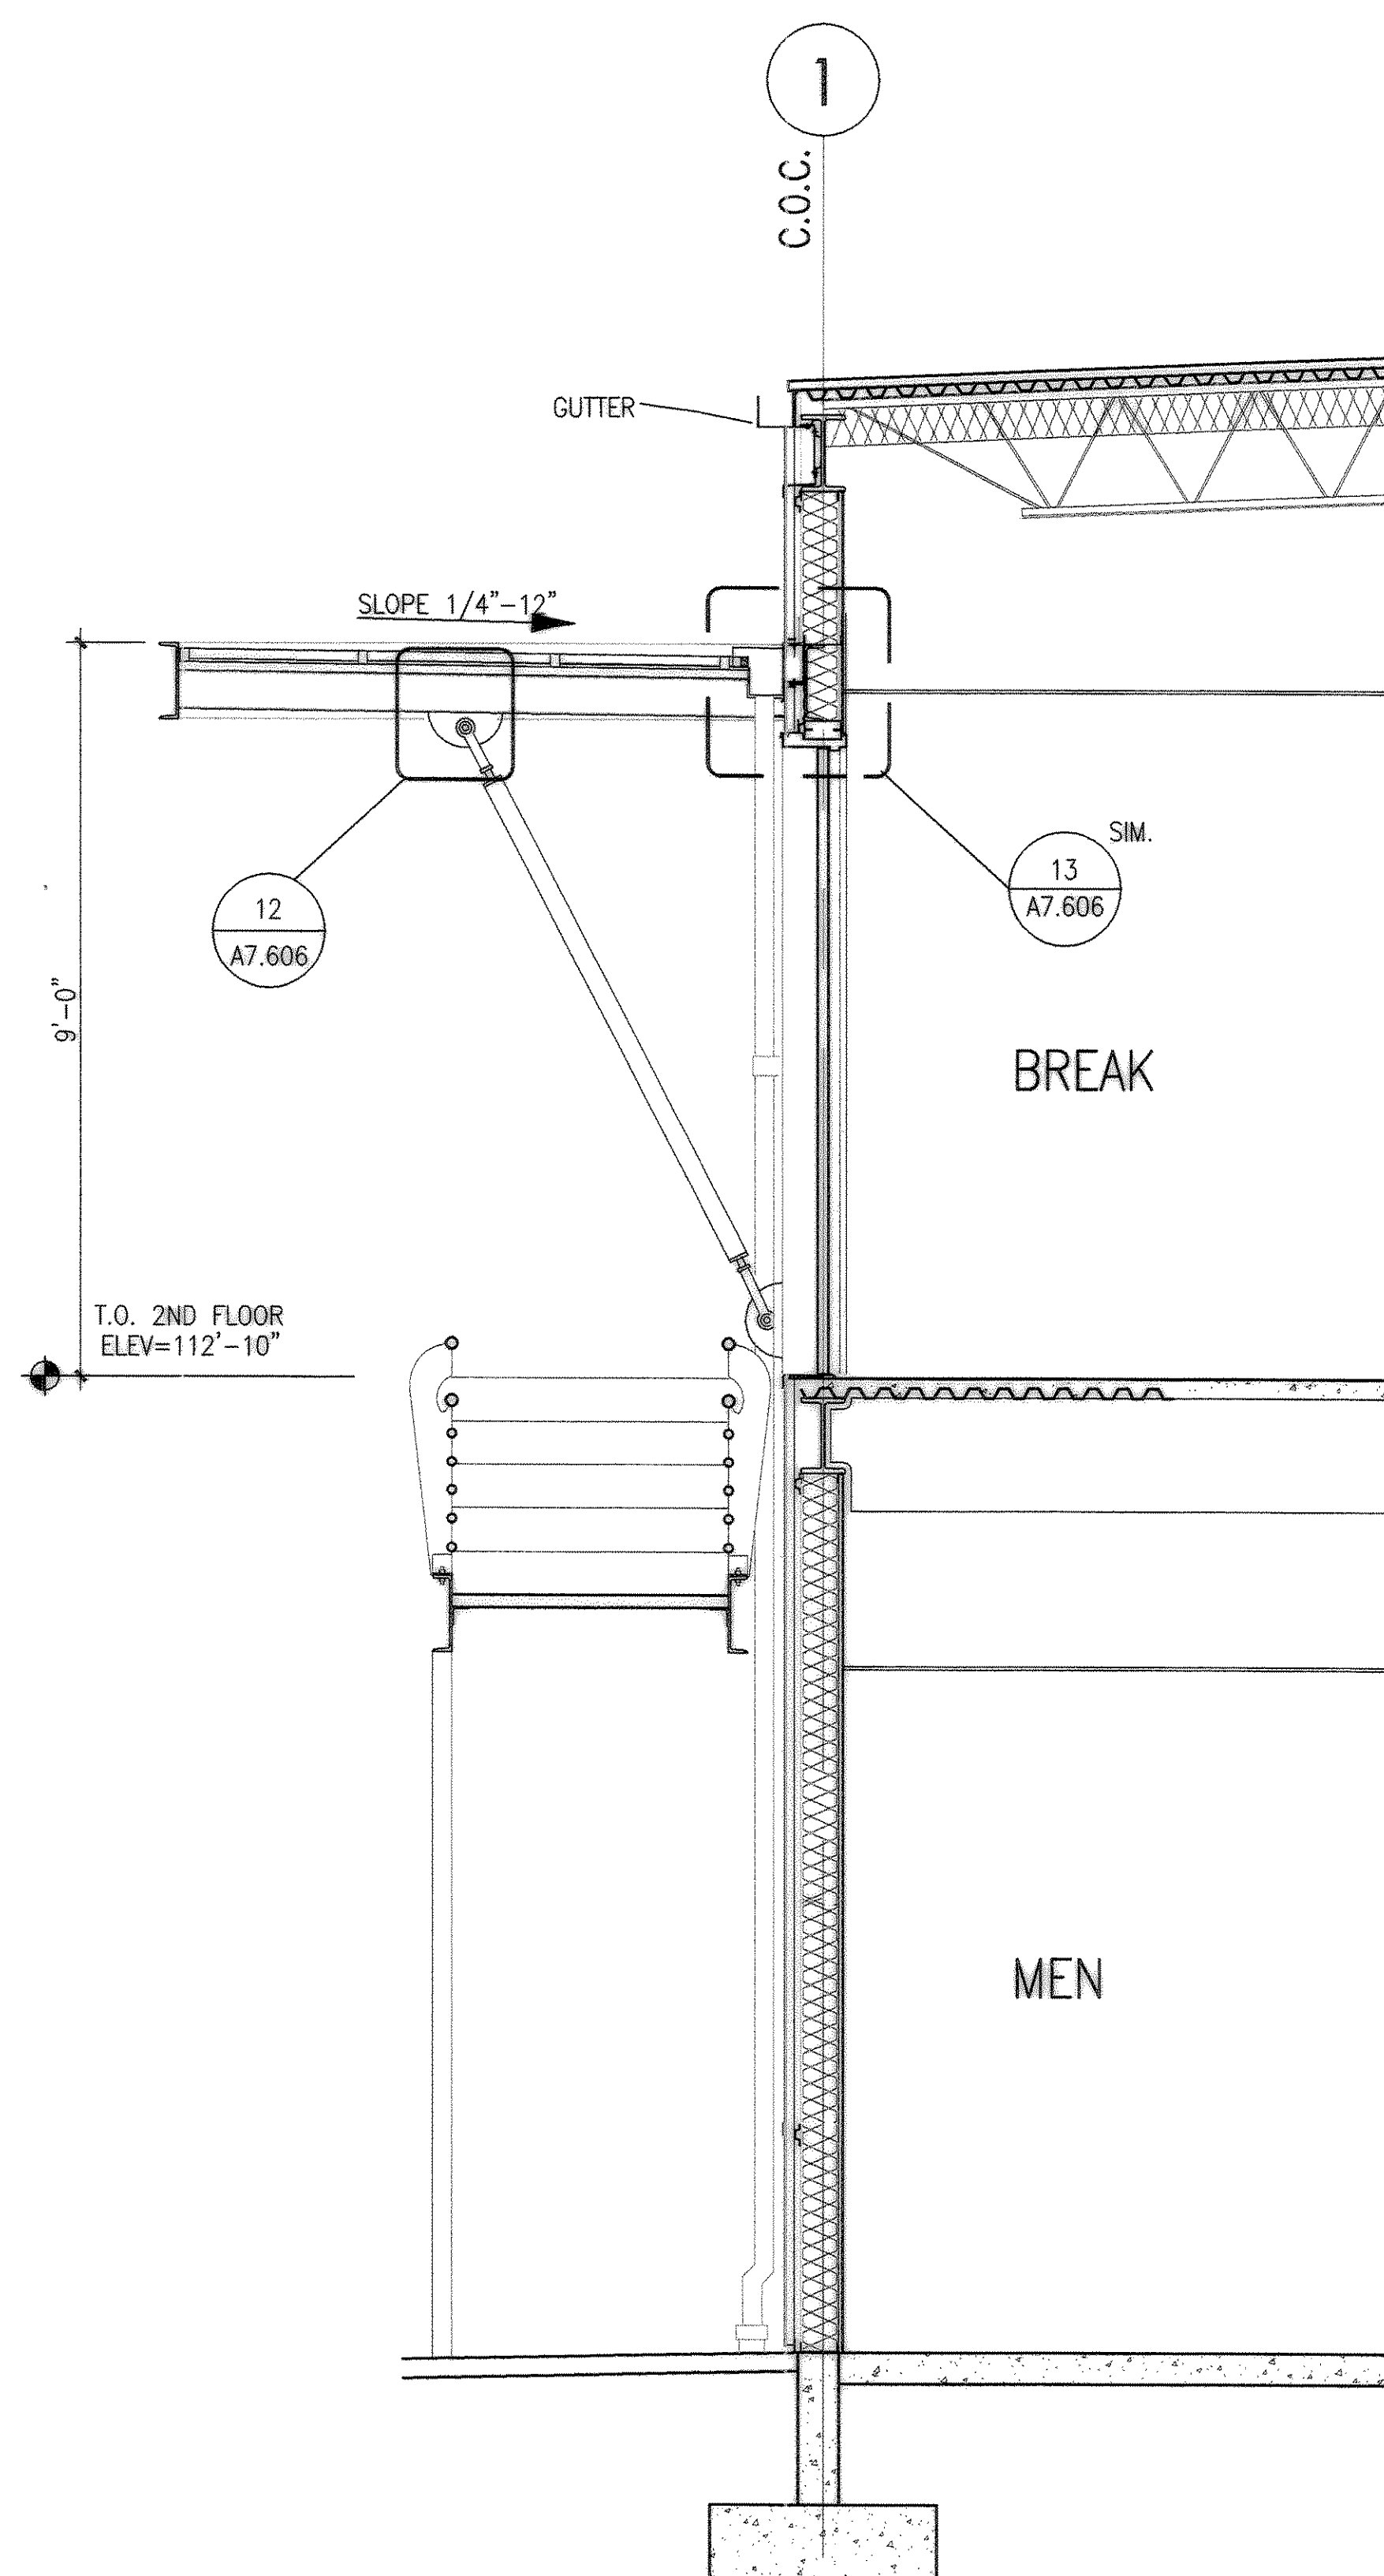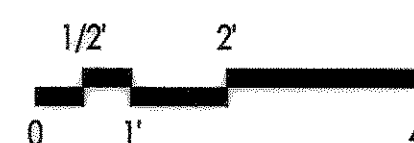

3 WALL SECTION
SCALE: 1/8"=1'-0" PEC E2164A_2-EL-01.DWG

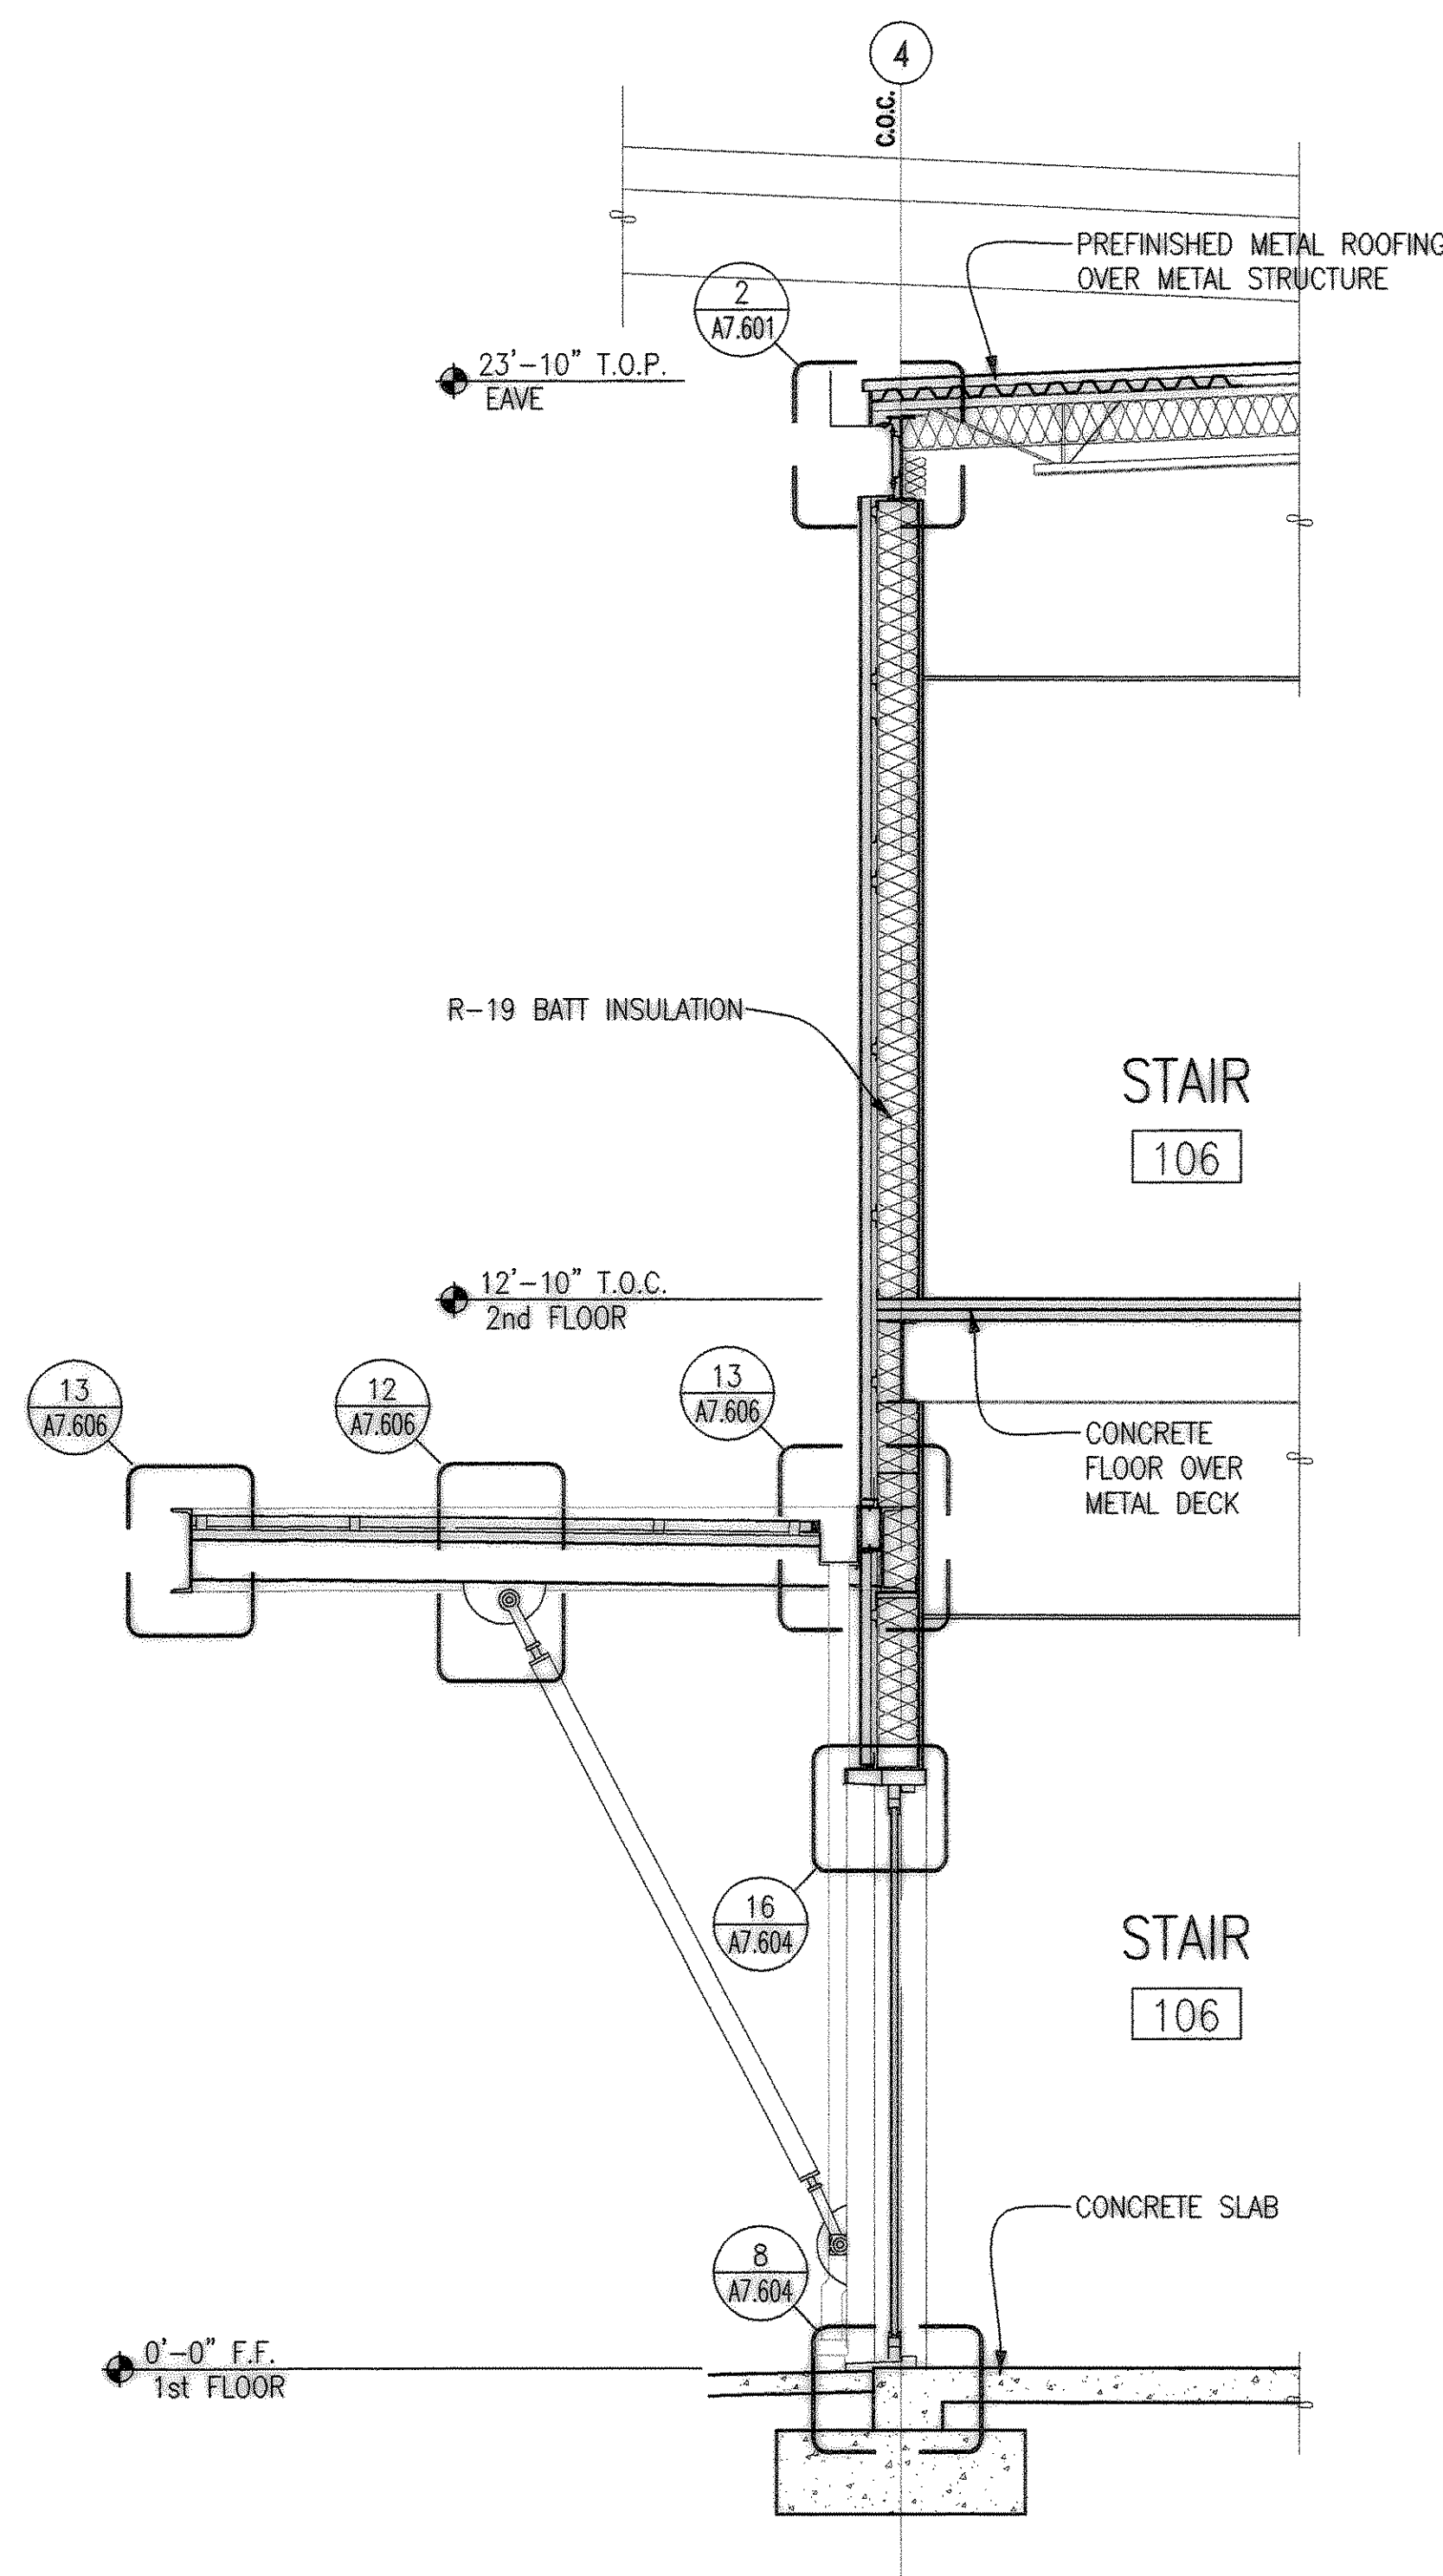

2 WALL SECTION
SCALE: 1/8"=1'-0" PEC E2164A_2-EL-01.DWG

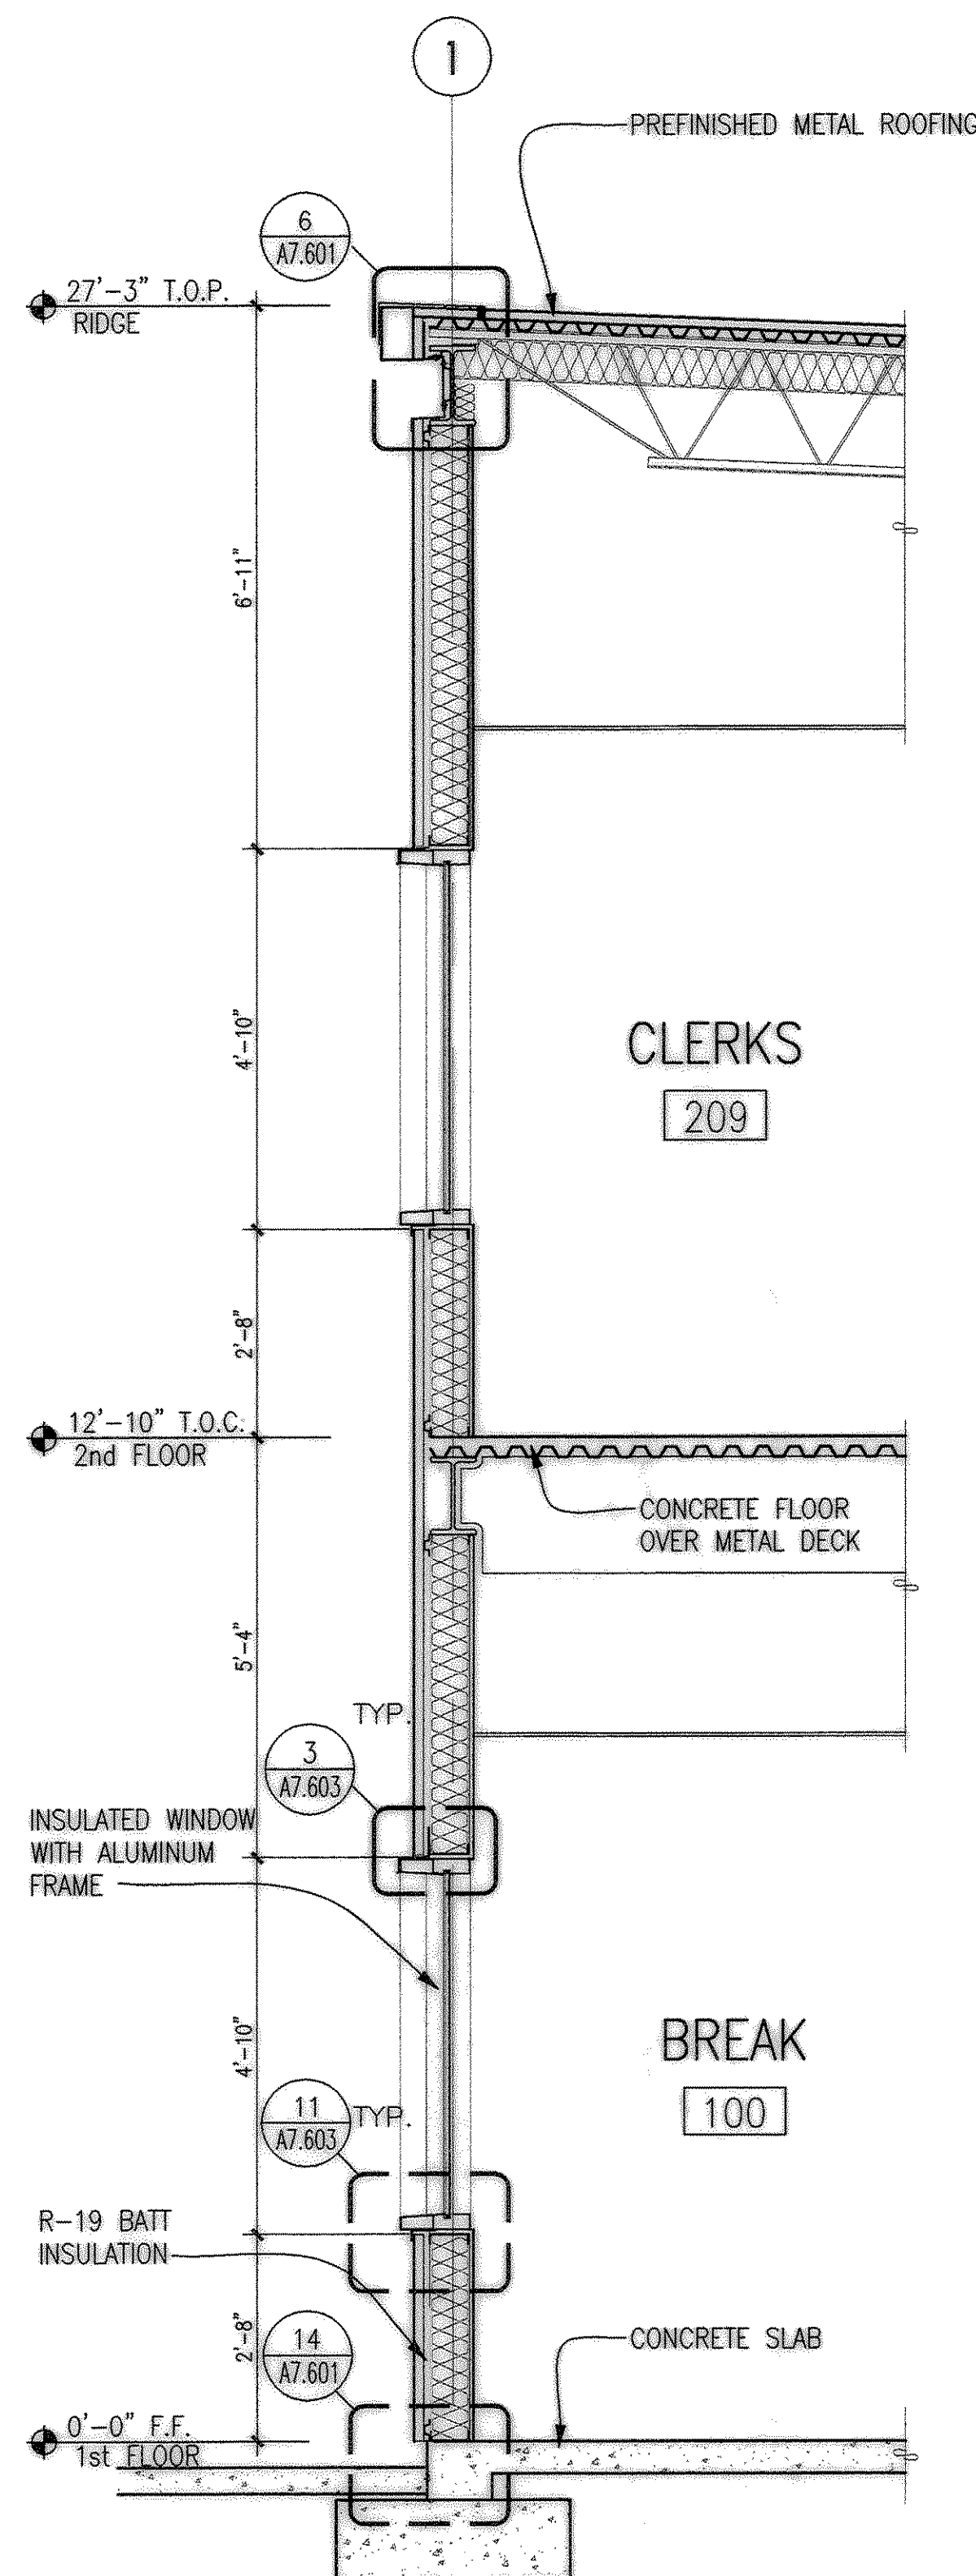

1 WALL SECTION
SCALE: 1/8"=1'-0" PEC E2164A_2-EL-01.DWG

CODES AND STANDARDS

1. UNIFORM BUILDING CODE (UBC) 1997 AS ADOPTED AND AMENDED BY THE TACOMA BUILDING DEPARTMENT AND STATE OF WASHINGTON.
2. AMERICAN CONCRETE INSTITUTE (ACI), BUILDING CODE REQUIREMENTS FOR STRUCTURAL CONCRETE 2002 EDITION.
3. ACI, BUILDING CODE REQUIREMENTS FOR MASONRY STRUCTURES 2002 EDITION.
4. AMERICAN INSTITUTE OF STEEL CONSTRUCTION (AISC), ALLOWABLE STRESS DESIGN, NINTH EDITION.
5. AMERICAN INSTITUTE OF STEEL CONSTRUCTION (AISC), LOAD AND RESISTANCE FACTOR DESIGN SPECIFICATION FOR STRUCTURAL STEEL BUILDINGS AND MANUAL OF STEEL CONSTRUCTION, THIRD EDITION.
6. AISC SEISMIC PROVISIONS FOR STRUCTURAL STEEL BUILDING, 2002 EDITION.
7. AMERICAN WELDING SOCIETY (AWS) CODES, STANDARDS, AND SPECIFICATIONS, 2001 EDITION.
8. STEEL DECK INSTITUTE, DESIGN MANUAL AND DIAPHRAGM DESIGN MANUAL, 2001 EDITION.
9. STEEL JOISTS INSTITUTE (SJI), STANDARD SPECIFICATIONS AND LOAD TABLES, FOR STEEL JOISTS AND GIRDERS, 2002 EDITION.
10. STRUCTURAL ENGINEERS ASSOCIATION OF WASHINGTON SNOW LOAD MANUAL.

GENERAL

1. ALL DIMENSIONS AND DETAILS SHALL BE VERIFIED BY THE CONTRACTOR PRIOR TO FABRICATION AND/OR CONSTRUCTION. THIS INCLUDES, BUT IS NOT LIMITED TO, VERIFYING SIZE AND LOCATION OF ALL MECHANICAL AND ELECTRICAL OPENINGS WITH THE RESPECTIVE SUBCONTRACTOR, AS WELL AS COORDINATING ALL INSERTS AND ATTACHMENTS FOR THE USE OF OTHER TRADES.
2. ALL SHOP DRAWINGS FOR THE REINFORCING STEEL, STRUCTURAL STEEL, METAL DECK, AND MISCELLANEOUS STEEL SHALL BE SUBMITTED TO AND REVIEWED BY THE ENGINEER PRIOR TO FABRICATION.
3. THE BUILDING FRAME (FOUNDATIONS, WALLS, FLOORS, AND ROOF SYSTEM) HAS BEEN DESIGNED TO WITHSTAND THE DESIGN LOADS WITHOUT EXCEEDING ALLOWABLE STRESSES. CONTRACTOR SHALL TEMPORARILY BRACE INCOMPLETE PARTS OF THE STRUCTURE UNTIL SUCH TIME AS BUILDING FRAME AS A WHOLE IS COMPLETE.

STRUCTURAL CONCEPT

1. VERTICAL LOADS (GRAVITY) ARE CARRIED BY A COMPOSITE METAL DECK ACTING COMPOSITELY WITH THE STEEL BEAMS AND GIRDERS SUPPORTED BY STEEL COLUMNS. THE COLUMNS DELIVER THEIR REACTIONS TO CONCRETE FOUNDATIONS. THE VERTICAL LOAD-CARRYING FRAME IS COMPLETE.
2. LATERAL LOADS (SEISMIC) ARE CARRIED BY THE FLOOR ACTING AS DIAPHRAGMS SUPPORTED BY BRACED FRAMES. THE BRACED FRAMES DELIVER THEIR LOADS (SHEAR AND OVERTURNING MOMENTS) TO THE FOUNDATIONS.

DESIGN LOADS

- | | |
|---|------------------------|
| 1. ROOF SNOW LOAD | 25 PSF |
| 2. LIVE LOADS (UBC '97) | |
| ROOF LIVE LOAD | 20 PSF |
| OFFICE | 50 PSF |
| PARTITIONS | 20 PSF |
| WALKWAYS AND STAIRS | 100 PSF |
| 3. LIVE LOAD REDUCTION: | PER UBC SECTION 1607.5 |
| 4. DEAD LOADS: ACTUAL WEIGHT OF MATERIALS OF CONSTRUCTION | |
| 5. SEISMIC LOAD PER UBC 97 | |
| V (BASE SHEAR) = (2.5 Cal/R) W | 0.14 W |
| Z (ZONE 3) | 0.30 |
| I | 1.00 |
| R BUILDING FRAME SYSTEM WITH SPECIAL CONCENTRICALLY BRACED FRAMES | 6.4 |
| C _a | 0.36 |
| SOIL PROFILE TYPE | Se |
| 6. WIND LOAD PER UBC 97 USING METHOD I | |
| P = C _e x C _q x q _s x I _w | 80 mph |
| BASIC WIND SPEED IS | B |
| EXPOSURE | PER TABLE 16-G UBC '97 |
| C _e | PER TABLE 16-H UBC '97 |
| C _q | PER TABLE 16-F UBC '97 |
| q _s | |
| I _w | 1.0 |

STRUCTURAL CONCRETE

1. ALL CONCRETE WORK SHALL CONFORM TO AMERICAN CONCRETE INSTITUTE STANDARD 301 (ACI 301), "SPECIFICATIONS FOR STRUCTURAL CONCRETE FOR BUILDINGS." THE CONTRACTOR SHALL KEEP A COPY ON SITE FOR REFERENCE.
2. ALL STRUCTURAL CONCRETE SHALL HAVE AGGREGATES CONFORMING TO ASTM C 33 AND SHALL HAVE AN APPROVED WATER-REDUCING, NON-AIR-ENTRAINING, ADMXTURE ADDED AS RECOMMENDED BY THE MANUFACTURER.
3. DESIGN MIXES FOR THE FOLLOWING CLASSES OF CONCRETE, INCORPORATING CEMENT OF ONE BRAND THROUGHOUT, TOGETHER WITH THE REQUIRED ADMXTURE, SHALL BE PROPORTIONED TO METHOD 1 OR METHOD 2, PER ACI 301, FOR A SLUMP IN INCHES LESS THAN THE MAXIMUM FOR EACH CLASS THAT IS TABULATED. THE MIXES SHALL BE TESTED AND APPROVED PRIOR TO USE.

CONC CLASS	LOCATION	MIN COMPR. STRENGTH AT 28 DAYS	MIN CEMENT CONTENT 94lb SACKS PER CU YD	MAX W/C RATIO ...	MAX SLUMP INCH	MIN AIR CONTENT (% VOL) ...
1	ALL OTHER	4,000 PSI	6 1/2	.45	4	SEE NOTE BELOW
2	EXTERIOR SOG AND PVMT	4,000 PSI	6 1/2	.4	3	5 1/2 (±1 1/2)

AIR ENTRAINMENT PER POT SPECIFICATIONS. THE MAXIMUM ALLOWABLE WATER/CEMENT (W/C) RATIO FOR CONCRETE CLASSES INDICATED ABOVE SHALL ACCOUNT FOR WATER FROM ALL SOURCES, INCLUDING ADMXTURES AND THE MOISTURE CONTENT OF THE FINE AGGREGATE. MIX DESIGNS MAY BE PROPORTIONED ESPECIALLY FOR PUMPING SO AS NOT TO EXCEED THE MAXIMUM SLUMP TABULATED FOR EACH CLASS WHEN MEASURED AT THE FORMS. APPROVED MIX DESIGNS SHALL NOT BE MODIFIED TO SUIT PUMPING BY THE ADDITION OF WATER.

4. REINFORCING STEEL SHALL CONFORM TO ASTM A 615, GRADE 60.
5. WELDED FABRIC SHALL CONFORM TO ASTM A 185.
6. CONSTRUCTION JOINTS SHALL BE PROVIDED AS DETAILED ON THE DRAWINGS. THE LOCATIONS AND TYPES OF CONSTRUCTION JOINTS NOT SHOWN ON THE DRAWINGS SHALL BE APPROVED BY THE ENGINEER IN ADVANCE. JOINTS NOT SHOWN ON THE DRAWINGS SHALL BE TREATED IN A MANNER SO AS TO COMPENSATE FOR THE LOSS OF STRENGTH AS FOLLOWS:
 - A. FORMED JOINTS SHALL HAVE 3/4-IN. DEEP INTERMITTENT KEYS, COVERING AT LEAST ONE-THIRD OF THE TOTAL JOINT SURFACE AREA.
 - B. POUR TERMINATION JOINTS SHALL BE LEFT CLEAN AND ROUGH, WITH AN AVERAGE ROUGHNESS OF 1/4-IN. MINIMUM.
 - C. DETAILED REINFORCEMENT SHALL BE CONTINUOUS THROUGH CONSTRUCTION JOINTS, UNLESS OTHERWISE SHOWN ON THE STRUCTURAL DRAWINGS.
 - D. EXTRA REINFORCEMENT SHALL BE ADDED THROUGH CONSTRUCTION JOINTS IN THE AMOUNT OF 0.21% OF THE TOTAL JOINT SURFACE AREA, AND SHALL BE ANCHORED FOR TENSION TO EACH SIDE OF THE JOINT.
 - E. BOND NEW CONCRETE TO HARDENED CONCRETE WITH APPROVED BONDING AGENT. APPLY IN ADVANCE OF CONCRETE POUR TO CAREFULLY CLEANED CONCRETE SURFACES.
 - F. SEAL ALL JOINTS EXPOSED TO GROUNDWATER, EARTH OR EXPOSED TO WEATHER INCLUDING SLAB-TO-SLAB AND SLAB TO-WALL. FORM A CONTINUOUS 3/4-IN. DEEP V-GROOVE OR SQUARE RECESS ALONG THE EXPOSED FACE OF JOINT U.N.O. SANDBLAST, PRIME, AND SEAL WITH AN APPROVED POLYURETHANE SEALANT THAT IS COMPATIBLE WITH THE SPECIFIED DAMPPROOFING.
 - G. IN CASES WHERE JOINTS CAN BE SHOWN NOT TO IMPAIR THE STRENGTH OF THE STRUCTURE, THE STRUCTURAL ENGINEER MAY RELAX THESE REQUIREMENTS.
7. NO REINFORCING MAY BE WELDED EXCEPT BY APPROVAL OF THE ENGINEER PRIOR TO CONSTRUCTION. IF, FOR ANY REASON, AN ARC IS CREATED BETWEEN REINFORCING AND WELDING ELECTRODE, THE REINFORCING MUST BE REPLACED.
8. LAP SPLICES OF REINFORCEMENT: UNLESS NOTED OTHERWISE, SPLICES SHALL BE AS FOLLOWS:

BARS	#8 OR SMALLER	- 40xDIA
	#9 OR LARGER	- 50xDIA
9. REFER TO ARCHITECTURAL, ELECTRICAL, MECHANICAL, AND STRUCTURAL DRAWINGS FOR ALL INSERTS, GROOVES, ETC., TO BE CAST IN CONCRETE AND FOR LOCATION OR PIPES, DUCTS, CONDUITS, ETC.
10. FOR CHAMFERS, REGLETS, REVEALS AND RECESSES, SEE ARCHITECTURAL DRAWINGS.
11. ALL CONCRETE FLOORS, INCLUDING SLAB-ON-GRADE WITHIN THE BUILDING, SHALL RECEIVE CONCRETE SEALER.
12. CONCRETE SHALL NOT BE CAST WHEN THE AMBIENT OUTSIDE TEMPERATURE IS 40° F OR LESS. CONCRETE SHALL BE PROTECTED FROM FREEZING FOR 24 HOURS AFTER CASTING. COLD WEATHER PLACING OF CONCRETE SHALL BE PERMITTED IF A PROCEDURE, COMPLYING WITH ACI 306.1-87, IS SUBMITTED TO AND APPROVED BY THE BUILDINGS DIVISION.

NON SHRINK GROUT

GROUT SHALL BE NONSHRINKABLE GROUT CONFORMING TO ASTM C 1107 AND CRD-621, CORPS OF ENGINEERS "SPECIFICATIONS FOR NON SHRINK GROUT." GROUT SHALL HAVE A SPECIFIED COMPRESSIVE STRENGTH AT TWENTY-EIGHT (28) DAYS OF 5000 PSI. PREGROUTING OF BASE PLATES WILL NOT BE PERMITTED.

FOUNDATIONS

1. FOUNDATION DESIGN IS BASED ON:
 - A. GEOTECHNICAL REPORTS PREPARED BY GEO ENGINEERS DATED JANUARY, 2003 AND FEBRUARY, 2003 AND AS AMENDED IN LETTER DATED MARCH 10TH, 2003.
 - B. ALL FOUNDATION WORK SHALL BE IN ACCORDANCE WITH THE RECOMMENDATIONS OF THESE REPORTS.
2. ALL SOIL FILL OR BACKFILL MATERIAL SUPPORTING SLABS, FOUNDATIONS, OR STRUCTURE SHALL BE STRUCTURAL FILL AND MUST BE APPROVED FOR USE BY THE ENGINEER. STRUCTURAL FILL FOR FLOOR SLABS AND BACKFILL OF RETAINING WALLS IS TO BE COMPACTED TO A DENSE UNYIELDING SURFACE OF 95% OF ITS MODIFIED PROCTOR MAXIMUM DRY DENSITY. ALL STRUCTURAL FILL IS TO BE PLACED IN 12-IN. MAXIMUM LOOSE, LEVEL, UNIFORM LIFTS IN PREPARATION FOR COMPACTION. DO NOT BACKFILL AGAINST WALLS UNTIL THE SUPPORTING FLOORS ARE CAST AND CURED.
3. BACKFILL FOR WALLS SHALL CONSIST OF FREE DRAINING GRANULAR MATERIAL, ESSENTIALLY FREE FROM VARIOUS TYPES OF WOOD WASTE OR OTHER EXTRANEOUS OR OBJECTIONABLE MATERIALS. IT SHALL CONSIST OF LESS THAN 7% PASSING THE #200 SIEVE OF ALL SAMPLES PASSING THE 3/4" MINUS SIEVE. MINIMUM WIDTH OF FREE DRAINING MATERIAL SHALL BE WIDTH OF EXCAVATION OR 3'-0" WHICHEVER IS LESS.

STRUCTURAL STEEL

1. ALL STEEL CONSTRUCTION SHALL COMPLY WITH THE CODE OF STANDARD PRACTICE FOR STEEL BUILDINGS AND BRIDGES 2000 EDITION AND CONFORM TO THE FOLLOWING:

W-SHAPES:	ASTM A992, Fy = 50 KSI
PLATES & FLAT BARS:	ASTM A572, GRADE 50 Fy = 50 KSI
OTHER STRUCTURAL STL SHAPES:	ASTM A36, Fy = 36 KSI
PIPE:	ASTM A53 GRADE B, Fy = 35 KSI
TUBE:	ASTM A500 GRADE B, Fy = 46 KSI
COMPOSITE STEEL DECK:	ASTM 653, GRADE 33
ANCHOR RODS:	ASTM F1554, Fy = 55 KSI
HEADED STUD ANCHORS:	ASTM A108, Fy = 50 KSI (GRADES 1010 TO 1020)
2. WHERE BOLTED CONNECTIONS ARE INDICATED. THEY SHALL BE MADE WITH 3/4-IN. DIAMETER, ASTM A 325, TYPE N BOLTS WITH HARDENED WASHERS CONFORMING TO THE "SPECIFICATIONS FOR STRUCTURAL JOINTS USING ASTM A 325 OR A 490 BOLTS."
3. WELDS AND ELECTRODES SHALL BE IN ACCORDANCE WITH THE LATEST RECOMMENDATIONS OF AWS AND AISC, SUITABLE TO THE PARTICULAR MATERIALS AND SITUATIONS. USE 70KSI FILLER METAL.
4. WELDERS SHALL BE CERTIFIED BY THE WASHINGTON ASSOCIATION OF BUILDING OFFICIALS (WABO). SUBMIT EVIDENCE OF CERTIFICATION.
5. CAMBER BEAMS AS NOTED ON THE FRAMING PLANS. WHERE NO CAMBER IS NOTED, FABRICATE BEAMS SO THAT THE CAMBER AS ROLLED (WITHIN ALLOWABLE TOLERANCES) IS POSITIVE.
6. PROVIDE MINIMUM 3/16" FILLET WELD OR 3/16" GROOVE WELD ALL AROUND THE MEMBERS BEING CONNECTED WHERE A WELD IS NOT SPECIFICALLY CALLED OUT.
7. ITEMS TO BE HOT-DIPPED GALVANIZED:
 - A. UNLESS NOTED OTHERWISE, ALL CONCRETE ACCESSORIES OF FERROUS MATERIAL INCLUDING: INSERTS, EMBEDMENTS, BRACKETS.
 - B. PIPE GUARDS, BOLLARDS AND HARDWARE FOR SAME.
 - C. WHERE NOTED AS "GA" OR "GALV." OR "GAL."
8. LOCATIONS OF ALL EMBEDDED ITEMS SHALL BE COORDINATED WITH VENDOR'S SHOP DRAWINGS.

LIGHT GAGE STEEL FRAMING

1. THE COLD-FORMED STRUCTURAL FRAMING SHALL BE MANUFACTURED FROM STRUCTURAL QUALITY STEEL HAVING MINIMUM YIELD STRENGTH OF 33 KSI, FOR ALL GAUGES, OR OPTIONAL 50 KSI FOR 16 GA AND HEAVIER AND HAVE MINIMUM PROTECTION COATING EQUAL TO G-60 GALVANIZED FINISH. THE STEEL SHALL CONFORM TO ONE OF THE FOLLOWING ASTM STANDARDS: ASTM A 653, ASTM A 875, ASTM A 792 OR ASTM A 463.
2. ALL STRUCTURAL MEMBERS SHALL BE DESIGNED IN ACCORDANCE WITH THE AISI "SPECIFICATION FOR THE DESIGN OF COLD-FORMED STEEL STRUCTURAL MEMBERS" 1996 EDITION.
3. CONTRACTOR SHALL SUBMIT DRAWINGS AND CALCULATIONS STAMPED AND SIGNED BY A PROFESSIONAL ENGINEER IN THE STATE OF WASHINGTON. CALCULATIONS FOR LIGHT GAGE FRAMING TO VERIFY SIZES, GAGES, AND SPACING OF MEMBERS AND CONNECTIONS. DRAWINGS SHALL SHOW SIZE, THICKNESS, LAYOUT, CONNECTIONS, MATERIAL DESIGNATION, METHOD OF INSTALLATION AND ACCESSORIES.
4. ALL COMPONENTS AND CONNECTIONS SHALL BE DESIGNED ACCORDING TO THE CODES LISTED AND ADDITIONAL LOADS SHOWN ON THE DRAWINGS. MEMBER SIZES SHOWN ON THE DRAWINGS ARE FOR REFERENCE AS A MINIMUM AND SHALL BE VERIFIED.
5. FASTENING OF COMPONENTS SHALL BE WITH SELF-DRILLING SCREWS OR WELDING. SCREWS OR WELDS SHALL BE OF SUFFICIENT SIZE TO ENSURE THE STRENGTH OF THE CONNECTION. ALL WELDING SHALL CONFORM TO AWS SPECIFICATIONS AND ALL WELDERS SHALL BE CERTIFIED FOR LIGHT GAUGE STEEL AWS SPECIFICATIONS.
6. PROVIDE ALL ACCESSORIES INCLUDING BUT NOT NECESSARILY LIMITED TO TRACKS, CLIPS, WEB STIFFENERS, ANCHORS, FASTENING DEVICES, AND OTHER ACCESSORIES REQUIRED FOR A COMPLETE AND PROPER INSTALLATION.


METAL ROOF OR FLOOR DECKING

1. ALL METAL DECKING SHALL CONFORM TO THE PROVISION OF THE AMERICAN IRON AND STEEL INSTITUTE'S "SPECIFICATIONS FOR THE DESIGN OF COLD-FORMED STEEL STRUCTURAL MEMBERS."
2. METAL FLOOR DECKING SHALL BE 2"x20 GA COMPOSITE TYPE, WITH G60 GALVANIZING HAVING MINIMUM SECTION PROPERTIES PER FT OF WIDTH (BASED ON VERCO W2 FORMLOK)


S+ =	.361 IN ³
S- =	.370 IN ³
I =	.423 IN ⁴
3. FASTENING OF 3" FLOOR DECK TO BE:
 - A. (4)- $\frac{5}{8}$ " DIA PUDDLE WELDS PER FULL 3'-0" SHEET WIDTH AT TRANSVERSE SUPPORTS.
 - B. SIDE LAPS: BUTTON PUNCHING AT 3'-0" MAXIMUM OC.
 - C. FLOOR DECKING LAID PARALLEL TO SUPPORTING WALLS OR FRAMES SHALL BE CONNECTED WITH $\frac{5}{8}$ ". FUSION WELDS AT 12 IN. O.C.
4. 1 1/2"x20 GA METAL ROOF DECKING SHALL HAVE MINIMUM SECTION PROPERTIES PER FT OF WIDTH (BASED ON VERCO HSB-36)

S+ =	.235 IN ³
S- =	.248 IN ³
I =	.216 IN ⁴
5. FASTENING OF 1 1/2" TYPE HSB DECK TO BE:
 - A. (7) - $\frac{5}{8}$ " DIA PUDDLE WELDS PER FULL 3'-0" SHEET WIDTH AT TRANSVERSE SUPPORTS.
 - B. SIDE LAPS: BUTTON-PUNCHING AT 2'-0" MAXIMUM O.C.
 - C. ROOF DECKING LAID PARALLEL TO SUPPORTING WALLS OR FRAMES SHALL BE CONNECTED WITH $\frac{5}{8}$ ". FUSION WELDS OR HILTI X-EDNK22-THQ12 FASTENERS AT 12 IN. O.C.
6. 3"x20 GA. METAL ROOF DECKING SHALL HAVE MINIMUM SECTION PROPERTIES PER FT OF WIDTH (BASED ON VERCO N-24)

S+ =	.502 IN ³
S- =	.562 IN ³
I =	.837 IN ⁴
7. FASTENING OF 3" ROOF DECK TO BE:
 - A. (4)- $\frac{5}{8}$ " DIA PUDDLE WELDS OR (4)-HILTI X-EDNK22-THQ12 FASTENERS PER FULL 2'-0" SHEET WIDTH AT TRANSVERSE SUPPORTS.
 - B. SIDE LAPS: BUTTON PUNCHING AT 1'-0" MAXIMUM OC.
 - C. ROOF DECKING LAID PARALLEL TO SUPPORTING WALLS OR FRAMES SHALL BE CONNECTED WITH $\frac{5}{8}$ ". FUSION WELDS OR HILTI X-EDNK22-THQ12 FASTENERS AT 12 IN. O.C.

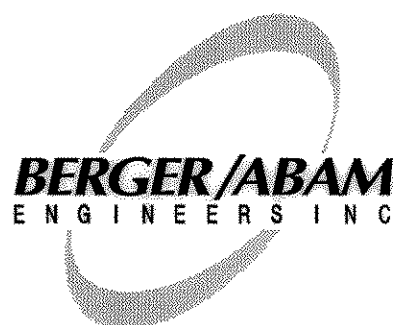

33301 9TH AVENUE SOUTH
FEDERAL WAY, WASHINGTON
98003-2600
VOICE: (206)431-2300
FAX: (206)431-2250

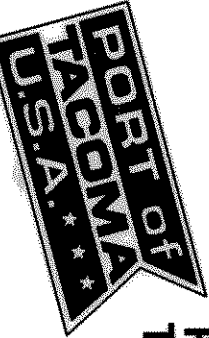

PORT OF TACOMA P.O. BOX 1837
TACOMA, WA 98401 253-383-5841



6021 12th street east
suite 201
Tacoma wa 98404
tel: 253.9034
fax: 253.922.6499

APPROVED	RENZ	08/22/03
CHECKED BY - DATE	LY	08/22/03
PROJECT ENR - DATE		
SENIOR DIRECTOR OF FACILITY DEVELOPMENT	DATE	
DRAWING DATE: 12/20/04		
PORT ADDRESS:		
PORT PARCEL:		
TOWNSHIP:	RANGE:	SECTION:
DATUM: HORIZ:		
DRAWING SCALE:		
VERT:		
PORT OF TACOMA PIERCE COUNTY TERMINAL MARINE BUILDING GENERAL NOTES		
EPRC443 6221-17 S3.001 SHEET 65 OF 239		
CONTRACT NUMBER: 996154 E NUMBER: E1974 PHASE: RECORD DRAWINGS		

OPEN WEB STEEL JOISTS

1. ALL STEEL JOIST DESIGN, MANUFACTURE AND ERECTION SHALL CONFORM TO STEEL JOIST INSTITUTE SPECIFICATION.
2. ALL ACCESSORIES, BRIDGING AND HEADERS, ETC. SHALL BE PROVIDED AS REQUIRED TO PROVIDE A COMPLETE SYSTEM FOR SUPPORT OF DECKING MATERIAL.
3. ALL JOISTS SHALL BE CONNECTED TO SUPPORTING MEMBERS WITH 3/16 FILLET WELDS 2 INCHES IN LENGTH EACH SIDE OF JOIST, UNLESS NOTED OTHERWISE.
4. ALL WELDERS SHALL BE CERTIFIED TO AWS STANDARDS.
5. DRILLED, SCREWED, OR WELDED CONNECTIONS SHALL NOT BE MADE ON JOISTS OR GIRDERS UNLESS EXPLICITLY SHOWN ON THE STRUCTURAL DRAWINGS.
6. OWSJ SHALL BE DESIGNED TO RESIST ADDITIONAL LOADS DUE TO THE FALL ARREST SYSTEM AT ROOF. COORDINATE LOCATION AND MAGNITUDE WITH FALL ARREST SYSTEM SUPPLIER PRIOR TO DESIGN AND FABRICATION.

SPECIAL INSPECTION

A SPECIAL INSPECTOR, REGISTERED BY THE WASHINGTON ASSOCIATION OF BUILDING OFFICIALS (WABO), RESPONSIBLE TO THE OWNER, AND APPROVED BY THE ENGINEER, SHALL PROVIDE INSPECTION OF THE CONSTRUCTION. IN ADDITION TO, OR IN ACCORDANCE WITH, THE REQUIREMENTS OF THE UBC CHAPTER 17, THE DUTIES OF A SPECIAL INSPECTOR SHALL INCLUDE, BUT NOT NECESSARILY BE LIMITED TO, THE FOLLOWING:

1. FORMS: TRUE TO LINE, TIGHT, AND FREE OF DEBRIS.
2. REINFORCING OF THE SIZE AND QUANTITY CALLED FOR ON THE DESIGN DRAWINGS, TIED, BRACED, OR SUPPORTED SECURELY IN POSITION WITH PROPER COVER AND CLEARANCE. RUNWAYS ARE NOT TO BE SUPPORTED OFF REINFORCING.
3. SLUMP AND CYLINDER TESTS AT THE RATE OF ONE FOR EACH 100 YARDS OF CONCRETE PLACED OR FRACTION THEREOF, WITH A MINIMUM OF ONE TEST FOR EACH DAY'S WORK. NOTE: THREE CYLINDERS ARE REQUIRED FOR EACH TEST.
4. AIR CONTENT: FREQUENT DETERMINATION OF THE ENTRAINED AIR CONTENT SHALL BE MADE AT THE FORMS, ONE TEST FOR EACH THIRD TRUCK MINIMUM.
5. COLLECT DELIVERY TICKETS TO INCLUDE (ALSO TO BE ON TEST REPORT):
- A. NAME OF BATCH PLANT
 - B. SERIAL NUMBER OF TICKET
 - C. DATE AND TRUCK NUMBER
 - D. NAME OF CONTRACTOR
 - E. SPECIFIC NAME OF JOB
 - F. SPECIFIC DESIGNATION OF CONCRETE (I.E., MIX NO. 1, 5 SACK)
 - G. AMOUNT OF CONCRETE
 - H. TIME LOADED ON
 - I. TIME OF MIXING 1-1/2 HOURS OR 300 REVOLUTIONS MAXIMUM
 - J. SLUMP
6. WELDING: VERIFY THAT THE WELDER IS CERTIFIED BY WABO, THAT THE PROPER ELECTRODES IN OVEN-DRY CONDITIONS ARE BEING USED, AND THAT PROPER METHODS AND PREPARATIONS ARE USED.
- A. ALL WELDS SHALL BE CHECKED VISUALLY.
 - B. ALL SHOP AND FIELD WELDING SHALL BE SUBJECT TO INSPECTION BY A WABO REGISTERED WELDING INSPECTOR ENGAGED BY THE OWNER. THE INSPECTOR SHALL UTILIZE X-RAY TEST, ULTRASONIC TESTING, MAGNETIC PARTICLE INSPECTION, AND ANY OTHER AID TO VISUAL INSPECTION THAT MAY BE DEEMED NECESSARY TO ASSURE THE ADEQUACY OF THE WELDING. TESTING AND INTERPRETATION WILL BE CARRIED OUT BY THE OWNER AT ANY STAGE AFTER WELDING.
 - C. OF ALL FILLET WELDS, 10% SHALL BE CHECKED BY MAGNETIC PARTICLE TESTING.
 - D. 100% OF ALL COMPLETE PENETRATION WELDS SHALL BE CHECKED BY RADIOGRAPHIC OR ULTRASONIC TESTING.
 - E. ALL WELDS FOUND DEFECTIVE AND REPAIRED SHALL BE REINSPECTED BY SAME METHOD ORIGINALLY USED - COST OF REPAIR AND REINSPECTION TO BE BORNE BY CONTRACTOR.
 - F. STANDARDS FOR ACCEPTANCE SHALL BE AS GIVEN IN AWS D1.1

7. STRUCTURAL STEEL CONNECTIONS: VERIFY THAT THE PROPER NUMBER AND TYPE OF BOLTS ARE INSTALLED WITH PROPER TORQUE.
8. THE WELD QUALITY OF SHEAR STUD CONNECTORS SHALL BE VERIFIED BY HAMMER TEST ACCORDING TO AMERICAN WELDING SOCIETY, INC., STRUCTURAL WELDING CODE, D1.1
9. SEE UBC CHAPTER 17 FOR REQUIRED SPECIAL INSPECTION REPORTING.

ABBREVIATIONS

ABT	ABOUT	MECH	MECHANICAL
ALT	ALTERNATE	MIN	MINIMUM
A.R.	ANCHOR ROD	MISC	MISCELLANEOUS
ARCH	ARCHITECTURAL	MTL	METAL
ASTM	AMERICAN SOCIETY OF TESTING AND MATERIALS	NIC	NOT IN CONTRACT
		NO.	NUMBER
AVG	AVERAGE	NTS	NOT TO SCALE
AWS	AMERICAN WELDING SOCIETY	OC	ON CENTER
BAL	BALANCE	OPNG	OPENING
BC	BOTTOM CHORD	OPH	OPPOSITE HAND
BLDG	BUILDING	OWSJ	OPEN WEB STEEL JOIST
BM	BEAM	PL	PLATE
BOT	BOTTOM	P/C	PRECAST
BP	BASE PLATE	PSF	POUNDS PER SQUARE FOOT
BRG	BEARING	PSI	POUNDS PER SQUARE INCH
C	CHANNEL	R	RADIUS
CGS	CENTER OF GRAVITY OF STEEL	REF	REFERENCE
CL	CENTERLINE	REINF	REINFORCE
CIP	CAST-IN-PLACE	REQD	REQUIRED
CJ	CONSTRUCTION JOINT	SCHED	SCHEDULE
CLR	CLEAR	SECT	SECTION
COL	COLUMN	SIM	SIMILAR
CONC	CONCRETE	SPA	SPACE(S)
CONN	CONNECTION	SPECS	SPECIFICATIONS
CONT	CONTINUOUS	SQ	SQUARE
CP	COMPLETE PENETRATION	STD	STANDARD
CTR	CENTER	STIFF	STIFFENER
DIA	DIAMETER	STIR	STIRRUP
DIAG	DIAGONAL	STL	STEEL
DIR	DIRECTION	SYMM	SYMMETRICAL
DWG	DRAWING	T & B	TOP & BOTTOM
EA	EACH	TBF	TRUSS BRACED FRAME
EF	EACH FACE	TC	TOP CHORD
EL	ELEVATION	THK	THICK
ELEV	ELEVATION	TOPG	TOPPING
EMBD	EMBEDMENT OR EMBEDDED	TOS	TOP OF STEEL
EXP	EXPANSION	TRANSV	TRANSVERSE
EXT	EXTERIOR	TS	STRUCTURAL TUBE
FIN	FINISH	T/S	TOP SIDE
FTG	FOOTING	TYP	TYPICAL
GAGE	GAGE	U.N.O.	UNLESS NOTED OTHERWISE
GAL	GALVANIZE	U/S	UNDER SIDE
HCA	HEAD CONCRETE ANCHOR	VERT	VERTICAL
HDW	HARDWARE	W/	WITH
HORIZ	HORIZONTAL	W/O	WITHOUT
INT	INTERIOR	WP	WORK POINT
JST	JOIST	&	AND
JT	JOINT	@	AT
K	KIP(S)	Ø	DIAMETER
L	ANGLE	#	NUMBER
LB	POUND(S)		
LLH	LONG LEG HORIZONTAL		
LLV	LONG LEG VERTICAL		
LONG	LONGITUDINAL		
MAX	MAXIMUM		

PORT OF TACOMA
U.S.A.

6021 12th street east
suite 201
tacoma wa 98401
tel: 253.922.9037
fax: 253.922.6499

RECORD DRAWINGS

Helix

PORT OF TACOMA
TACOMA, WA 98401
P.O. BOX 1887
253-383-5841

APPROVED

SENIOR DIRECTOR OF FACILITY DEVELOPMENT

DRAWING DATE: 12/20/04

PORT ADDRESS: PORT PARCEL:

DATE

PROJECT ENR - DATE

RNZ 08/22/03

CHECKED BY - DATE

LY 08/22/03

PORT OF TACOMA
PIERCE COUNTY TERMINAL
MARINE BUILDING
GENERAL NOTES

EP0004.47

6321-17

S3.002

SHEET 66 OF 230


CONTRACT NUMBER: 998154

PHASE: RECORD DRAWINGS

BERGER/ABAM

ENGINEERS INC.

33301 9TH AVENUE SOUTH
FEDERAL WAY, WASHINGTON
98003-2600
VOICE: (206)431-2300
FAX: (206)431-2250

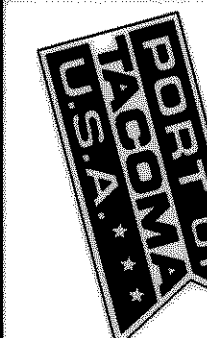

PORT OF TACOMA P.O. BOX 1837
TACOMA, WA 98401 253-383-5841

RECORD DRAWINGS

Heit

4021 12th street east
Tacoma, WA 98424
Tel: 253.922.9037
Fax: 253.922.6499

APPROVED

RNZ 08/22/03
CHECKED BY: DATE

LY 08/22/03
PROJECT ENGR: DATE

SENIOR DIRECTOR OF
FACILITY DEVELOPMENT
DRAWING DATE: 12/20/04
PORT ADDRESS:
PORT PARCEL:

PORT OF TACOMA

PIERCE COUNTY TERMINAL
MARINE BUILDING
FOUNDATION AND FRAMING PLANS

TOWNSHIP:
DATING: HORIZ:
DRAWING SCALE:


SECTION:
VERT:

EPCCAL 17

6321-17


S3.101
SHEET 67 OF 230

CONTRACT NUMBER: 990154
E NUMBER: E1974
PHASE: RECORD DRAWINGS

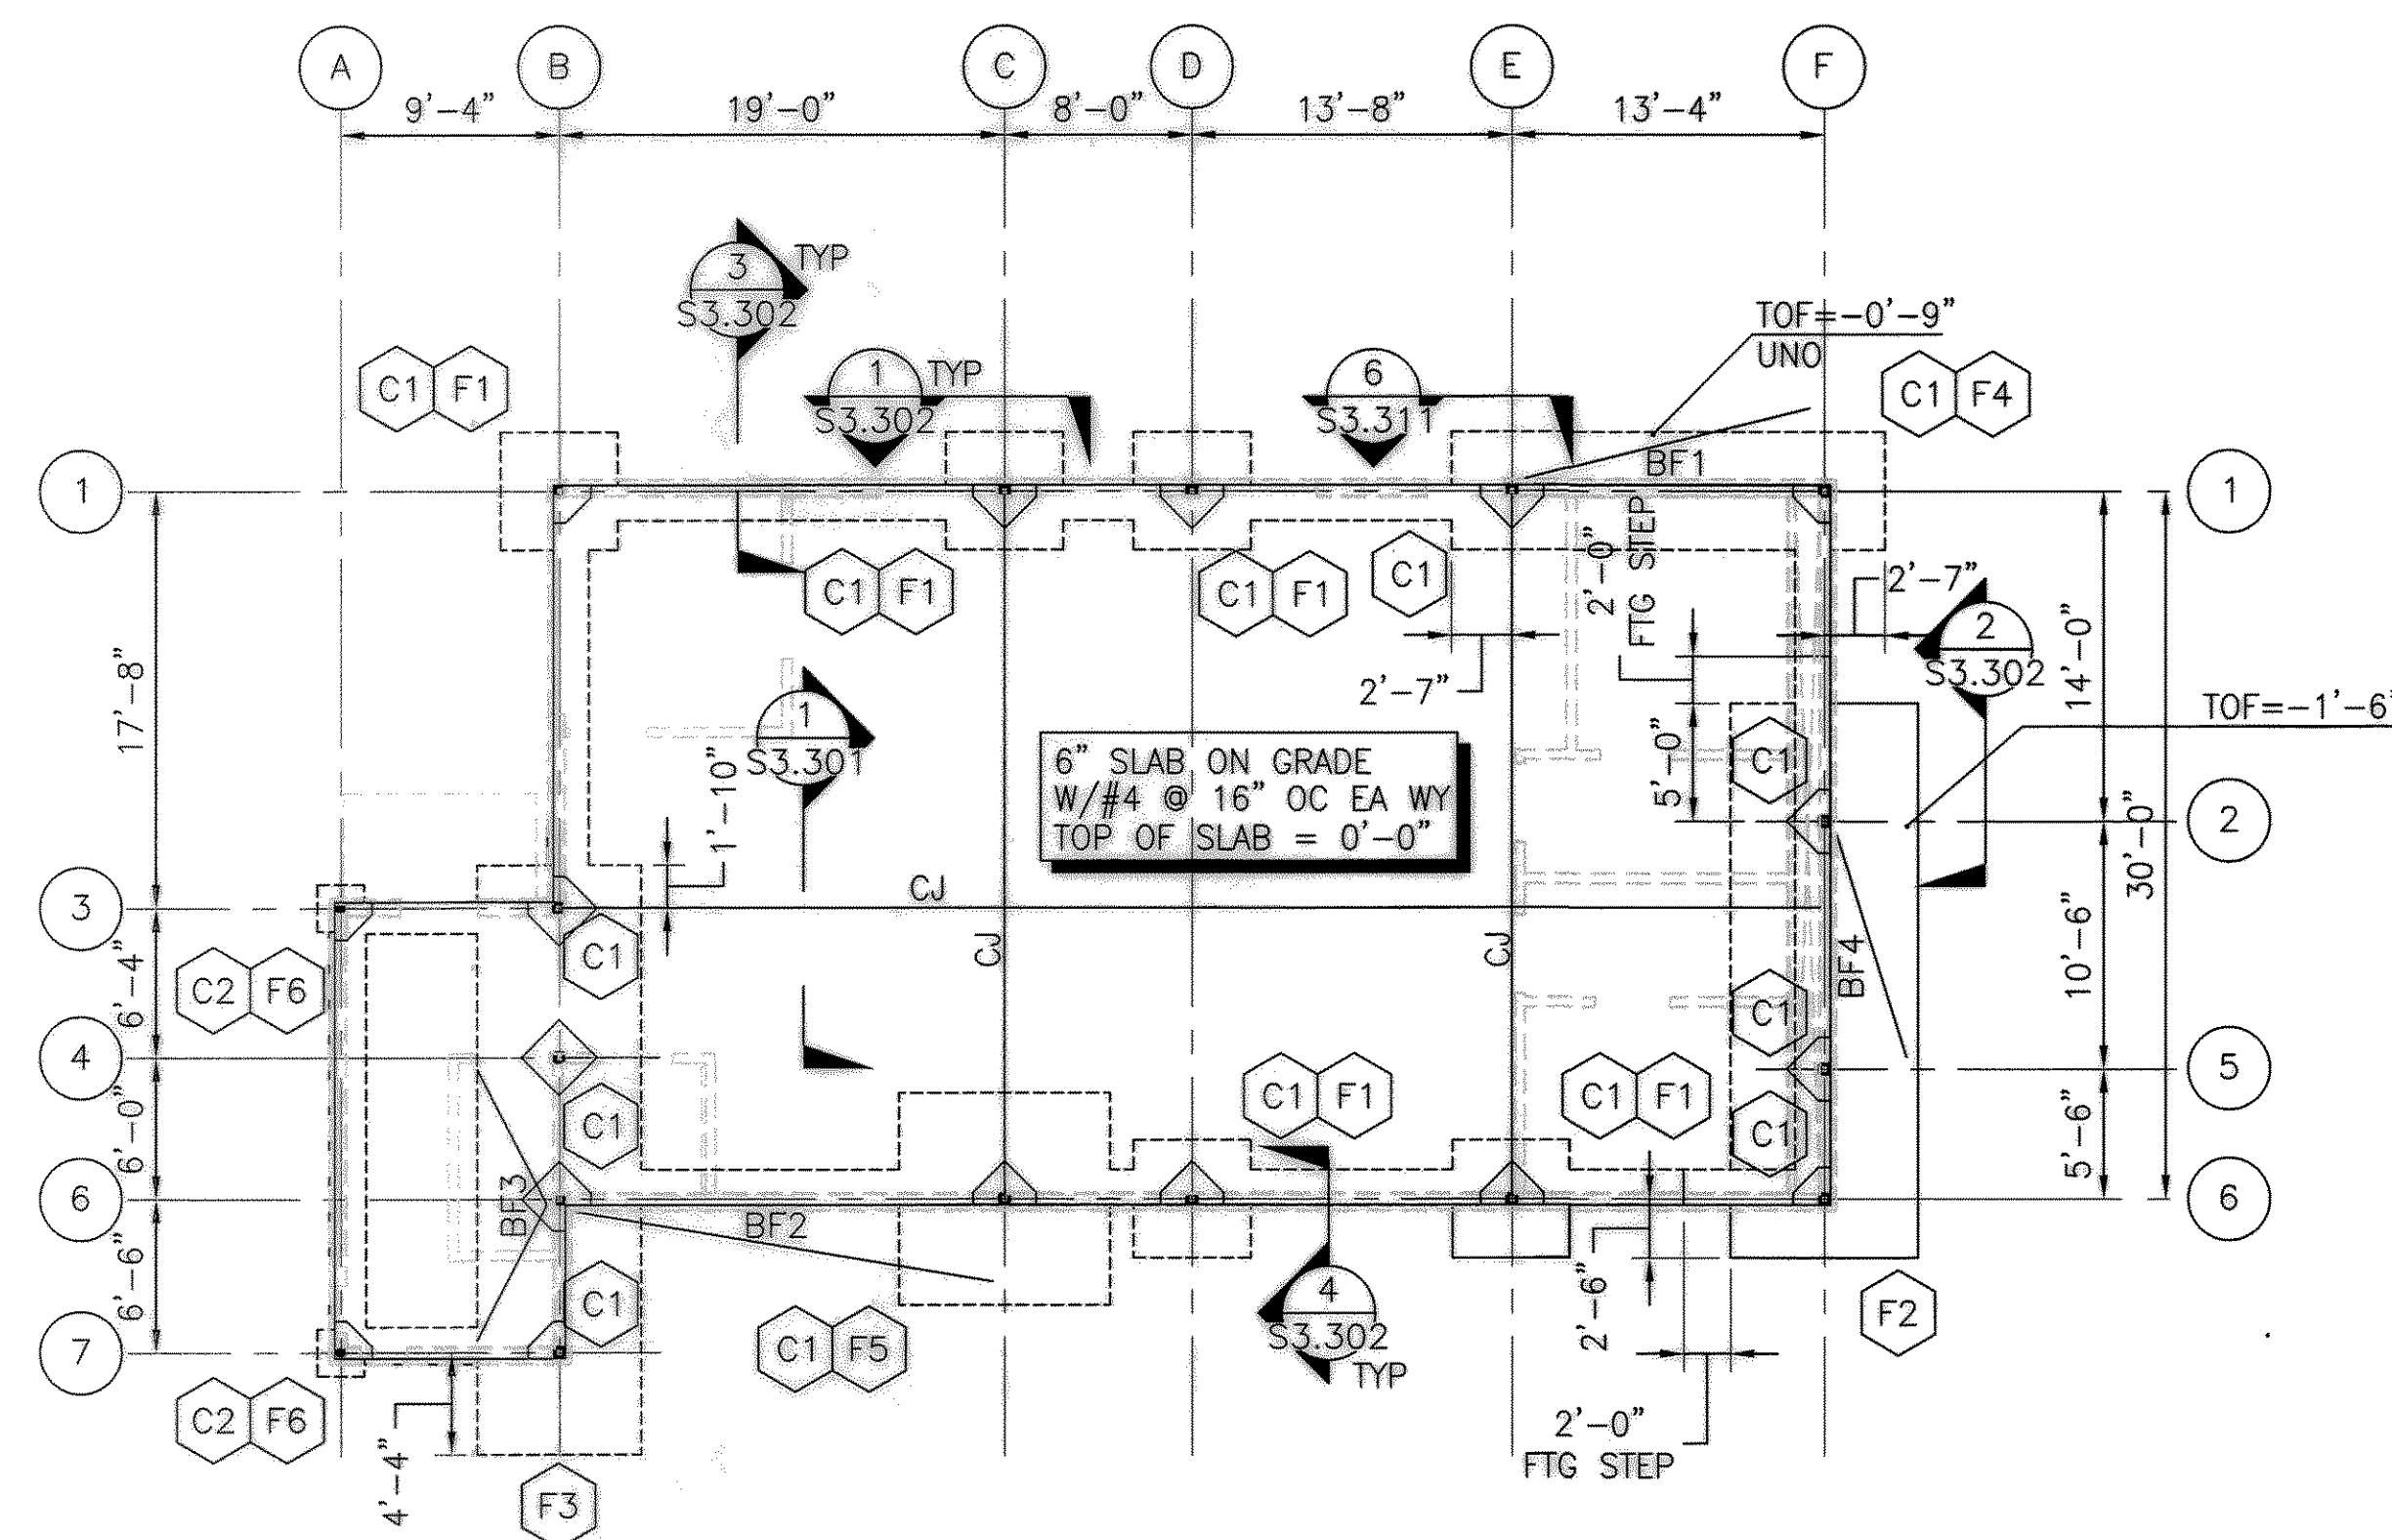


FOUNDATION PLAN

SCALE: 1/8" = 1'-0"

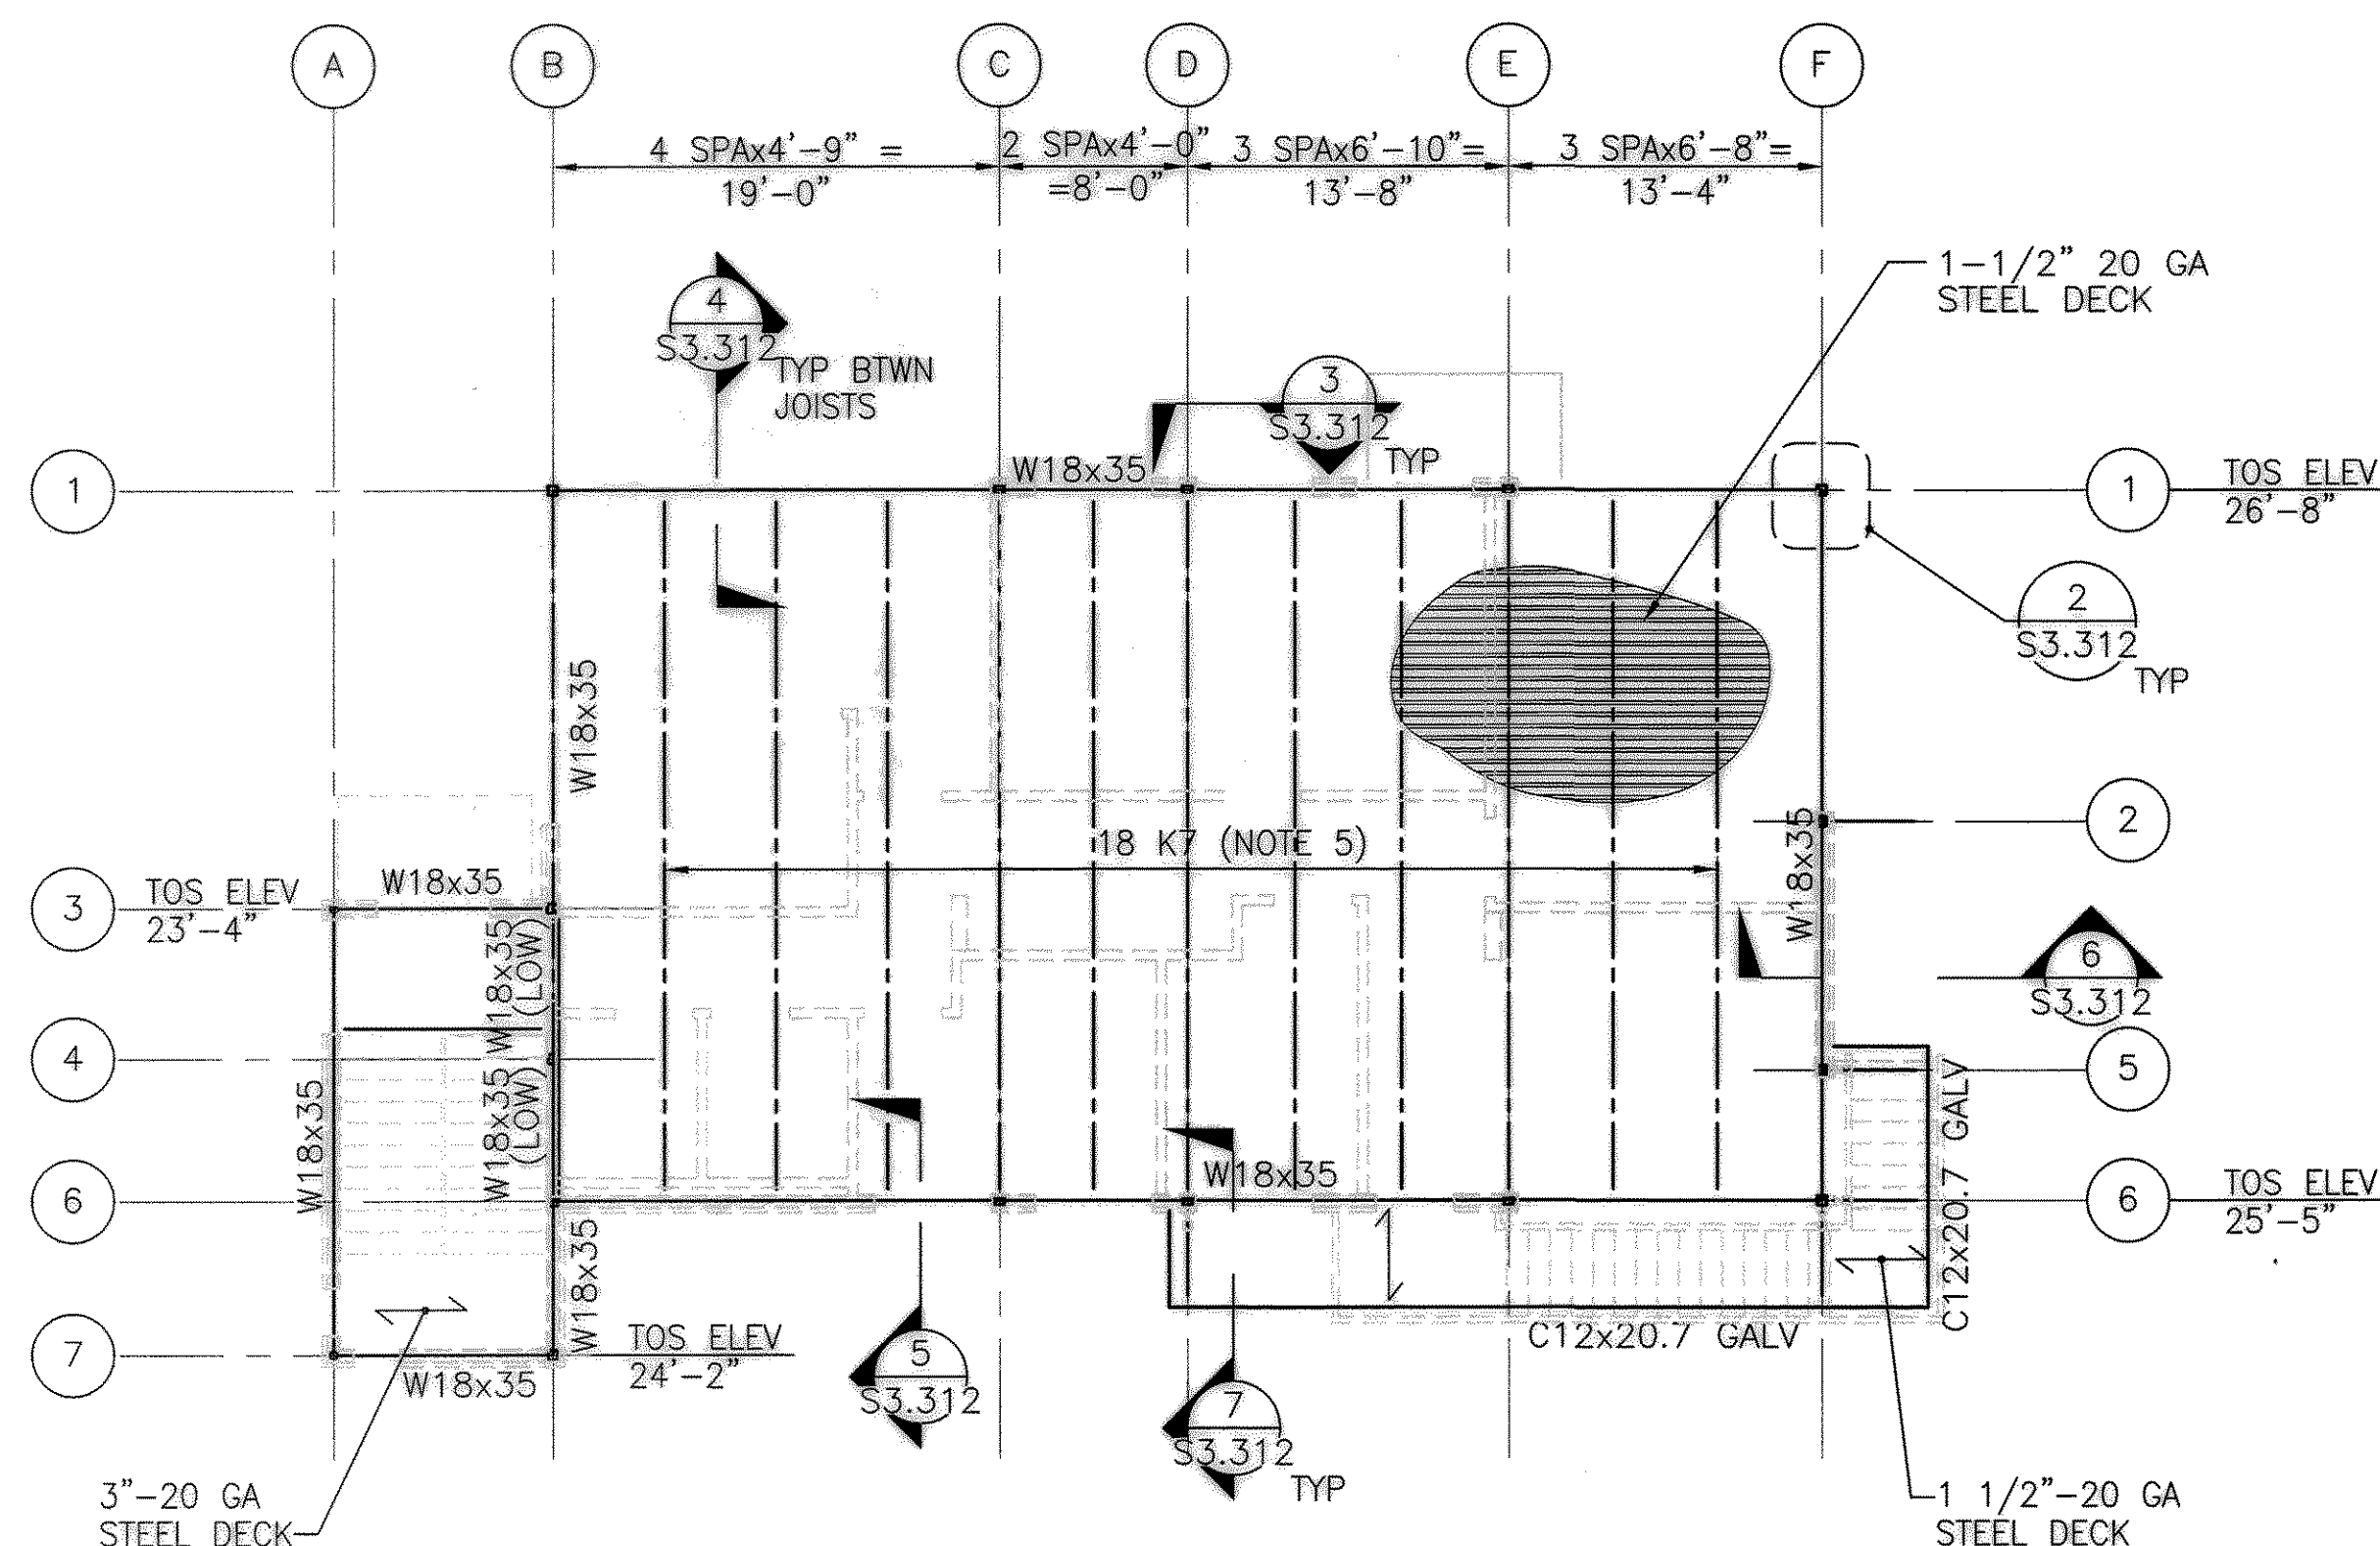

ROOF FRAMING PLAN

SCALE: 1/8" = 1'-0"

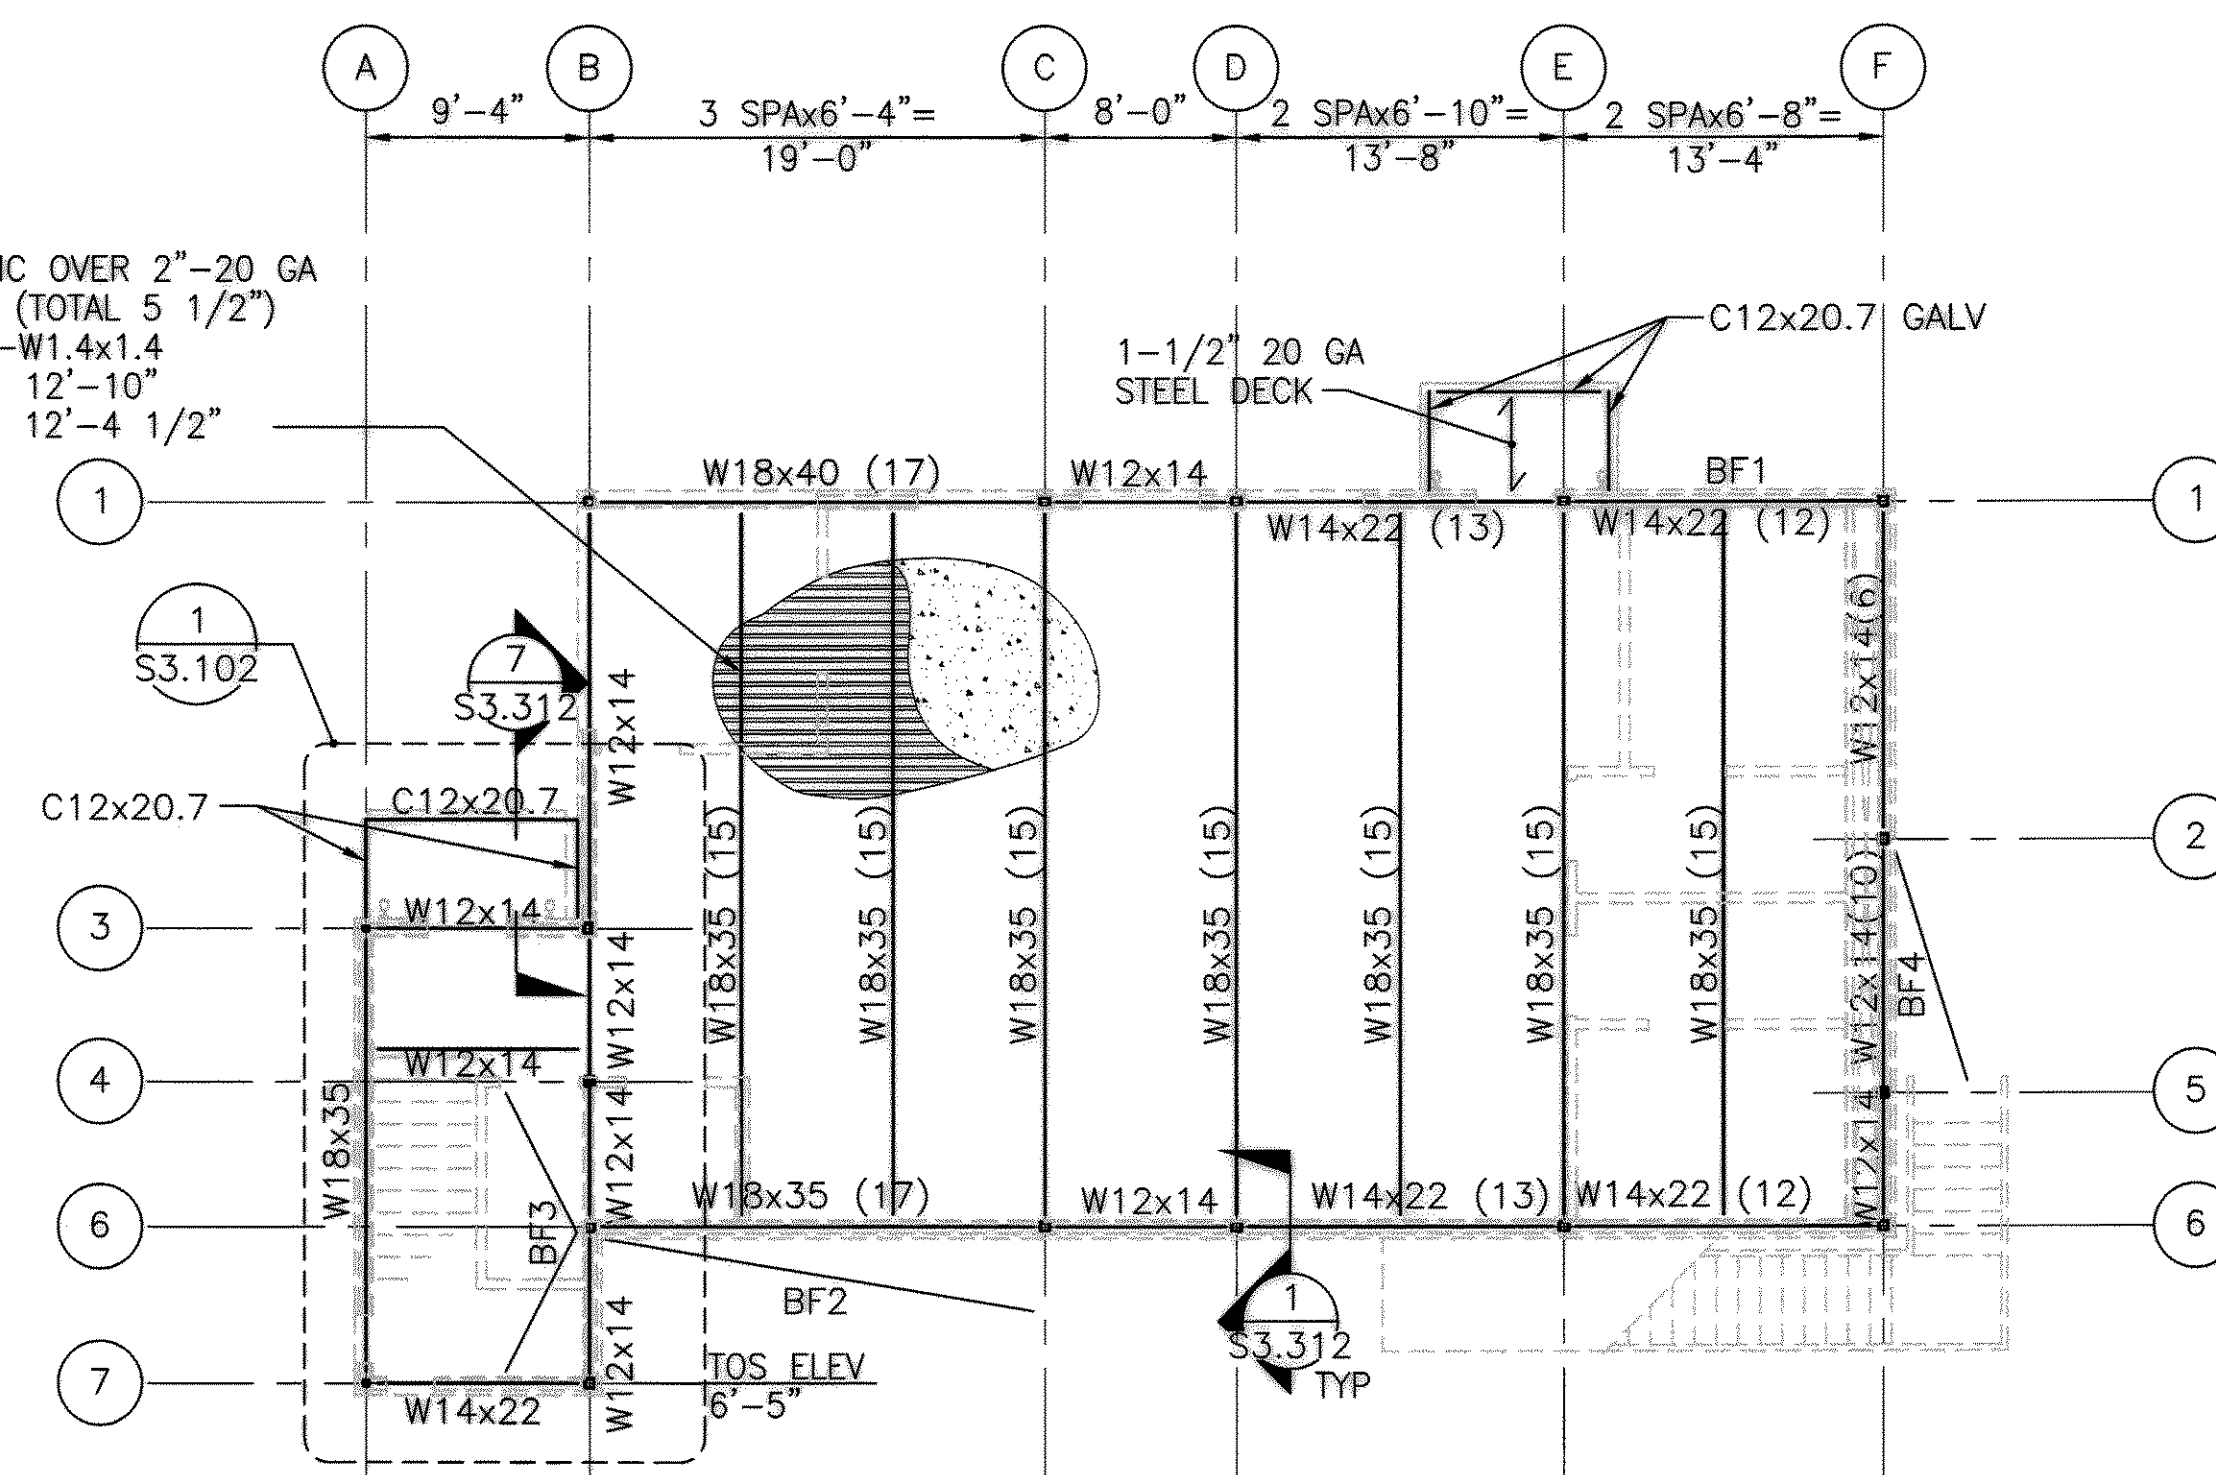

SECOND FLOOR FRAMING PLAN

SCALE: 1/8" = 1'-0"

PLAN NOTES:

- BF INDICATES BRACED FRAME. SEE S3.201 FOR ELEVATIONS.
- FOR FLOOR AND ROOF DECK ATTACHMENT SEE GENERAL NOTES SHEET S3.001.
- FOR TYPICAL COMPOSITE DECK DETAILS SEE S3.321
- FOR TYP ISOLATION JOINTS AT COLUMN, SEE (4) S3.301
- DESIGN JOISTS FOR A NET UPLIFT OF 70 PLF.


COLUMN MARK	C1	C2				
COLUMN	TS 5x5x3/8	TS 4x4x1/4				
BASE PLATE (WxLxT)	13"x13"x1"	12"x12"x1"				
BASE PLATE TYPE	TYPE I	TYPE I				
ANCHOR RODS (DIAXEMBED)	(4) 3/4"x0'-9"	(4) 3/4"x0'-9"				
ANCHOR ROD TYPE	TYPE I	TYPE I				
FOUNDATION MARK	F1	F2	F3	F4	F5	F6
FOOTING (WxLxT)	5'-0"x 5'-0"x1'-0"	8'-0"x 23'-6"x1'-6"	7'-0"x 25'-0"x1'-6"	5'-0"x 18'-6"x1'-6"	9'-0"x 9'-0"x1'-6"	2'-0"x 2'-0"x1'-0"
REINFORCEMENT	#5 @ 12" EW B	#5 @ 12" EW T & B	#5 @ 9" EW T & B	#5 @ 9" EW T & B	#5 @ 12" EW T & B	(3)#4 EW B
TOP OF FOOTING ELEV	PER PLAN	PER PLAN	PER PLAN	PER PLAN	PER PLAN	PER PLAN
NOTES	1	1				

COLUMN/FND SCHEDULE NOTES:

- FOR BASE PLATE AND ANCHOR ROD DETAILS, SEE (3) S3.301



33301 9TH AVENUE SOUTH
FEDERAL WAY, WASHINGTON
98003-2600
VOICE: (206)431-2300
FAX: (206)431-2250

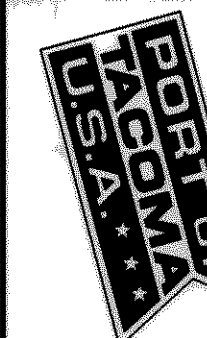

PORT OF TACOMA P.O. BOX 1837
TACOMA, WA 98401 253-383-5841

4021 12th street east
suite 201
tacoma, wa 98424
tel: 253-922-9037
fax: 253-922-6499

RECORD DRAWINGS

APPROVED

RNZ 08/22/03

CHECKED BY - DATE

LY 08/22/03

PROJECT ENGR - DATE

SENIOR DIRECTOR OF DATE

FACILITY DEVELOPMENT

DRAWING DATE: 12/20/04

PORT ADDRESS:


PORT PARCEL:

PORT OF TACOMA
PIERCE COUNTY TERMINAL
MARINE BUILDING
STAIR PLANS


EP 6321-17

S3.102
SHEET 68 OF 230



CONTRACT NUMBER: 98154
E NUMBER: E1374
PHASE: RECORD DRAWINGS

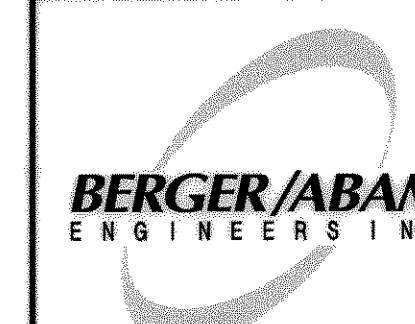


33301 9TH AVENUE SOUTH
FEDERAL WAY, WASHINGTON
98003-2600
VOICE: (206)431-2300
FAX: (206)431-2250

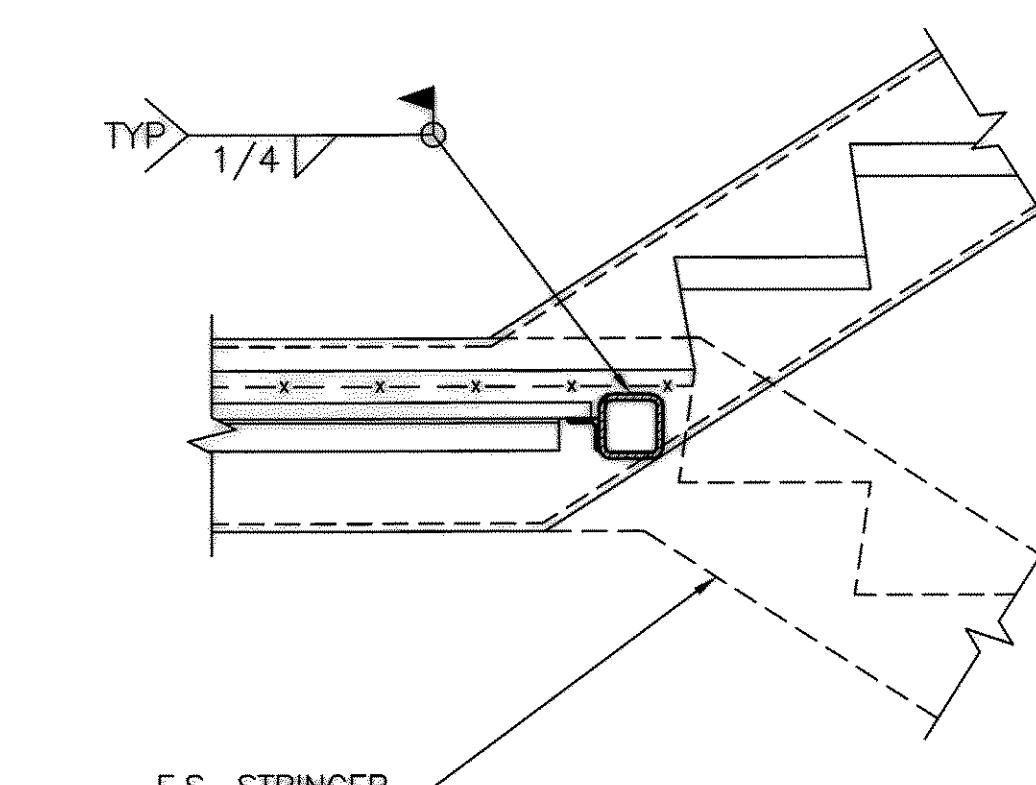


3 STAIR STRINGER DETAIL
S3.102 SCALE: 1" = 1'-0"

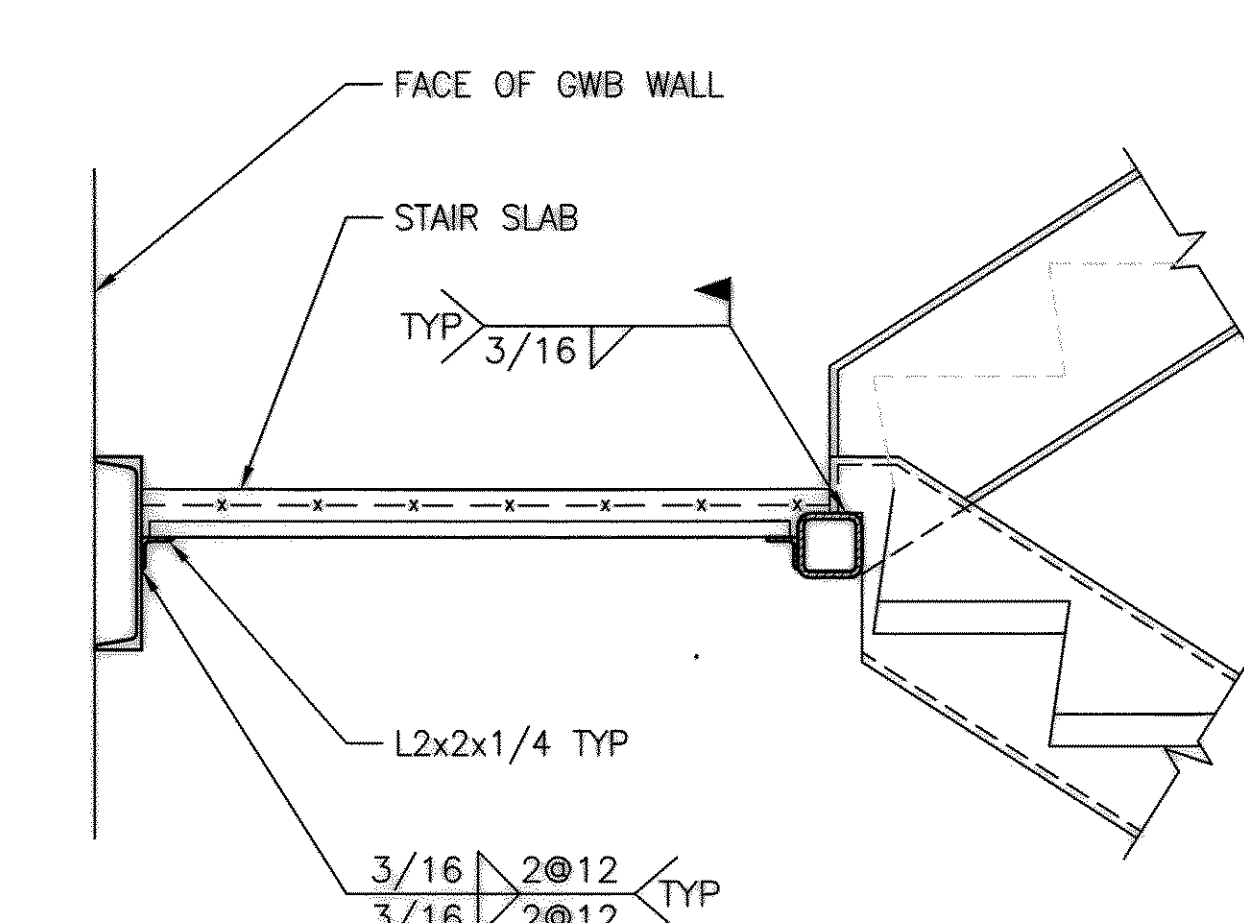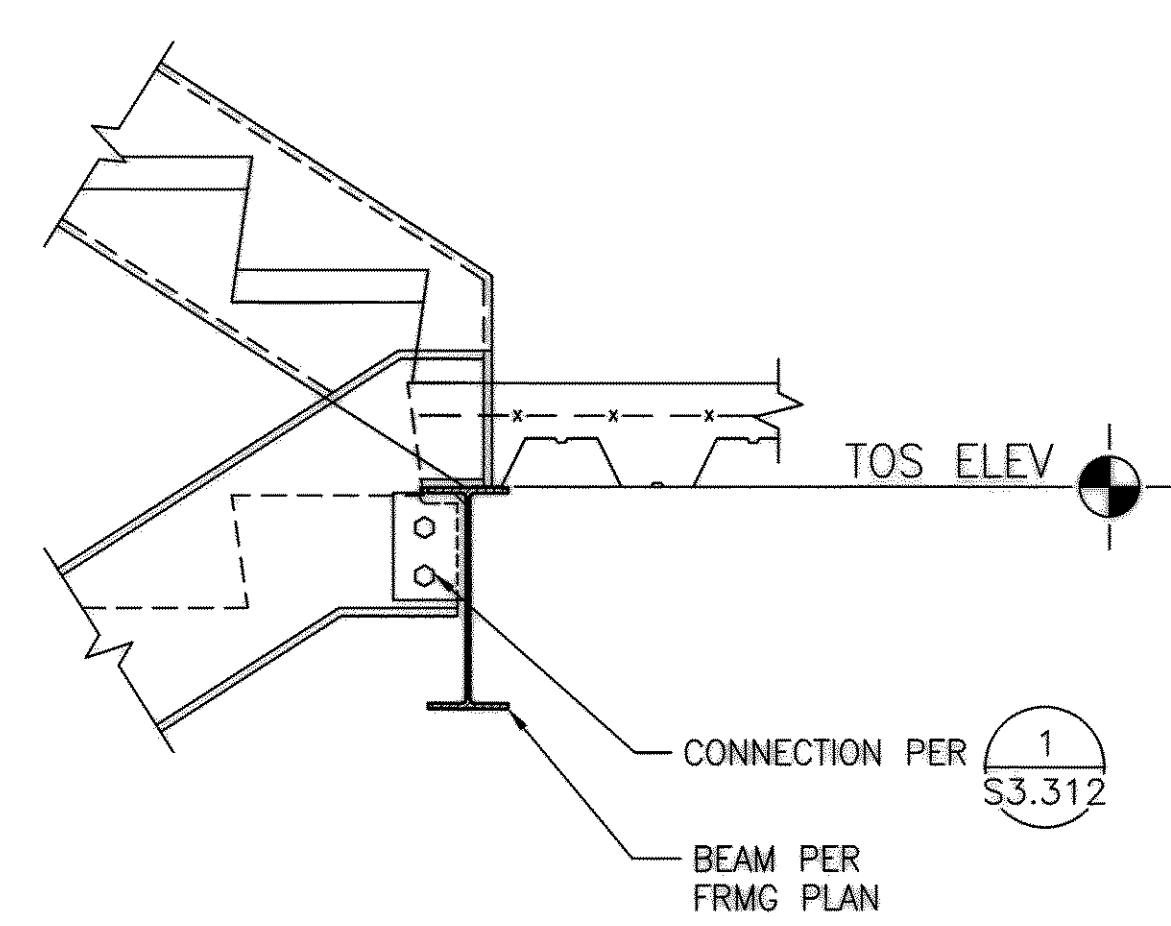


2 STAIR STRINGER DETAIL
S3.102 SCALE: 1" = 1'-0"

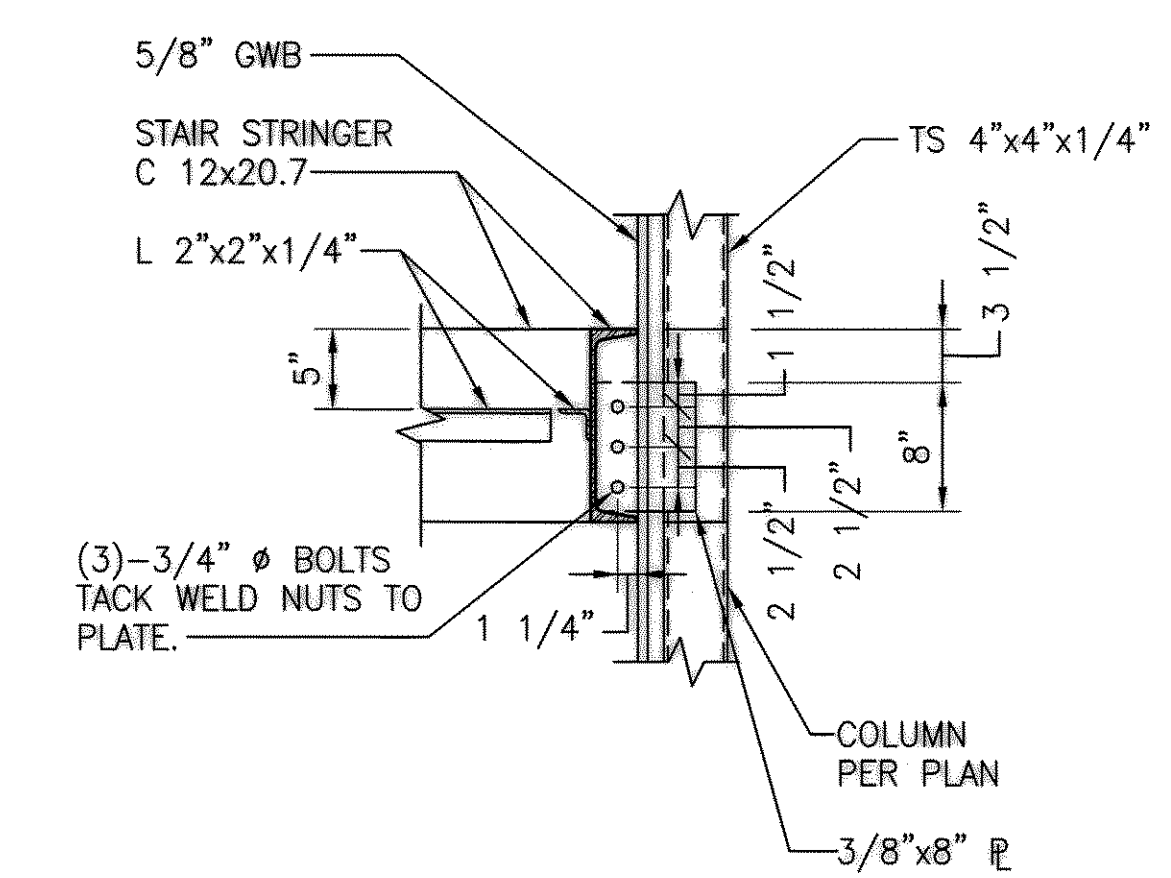


5 SECTION
S3.102 SCALE: 1" = 1'-0"

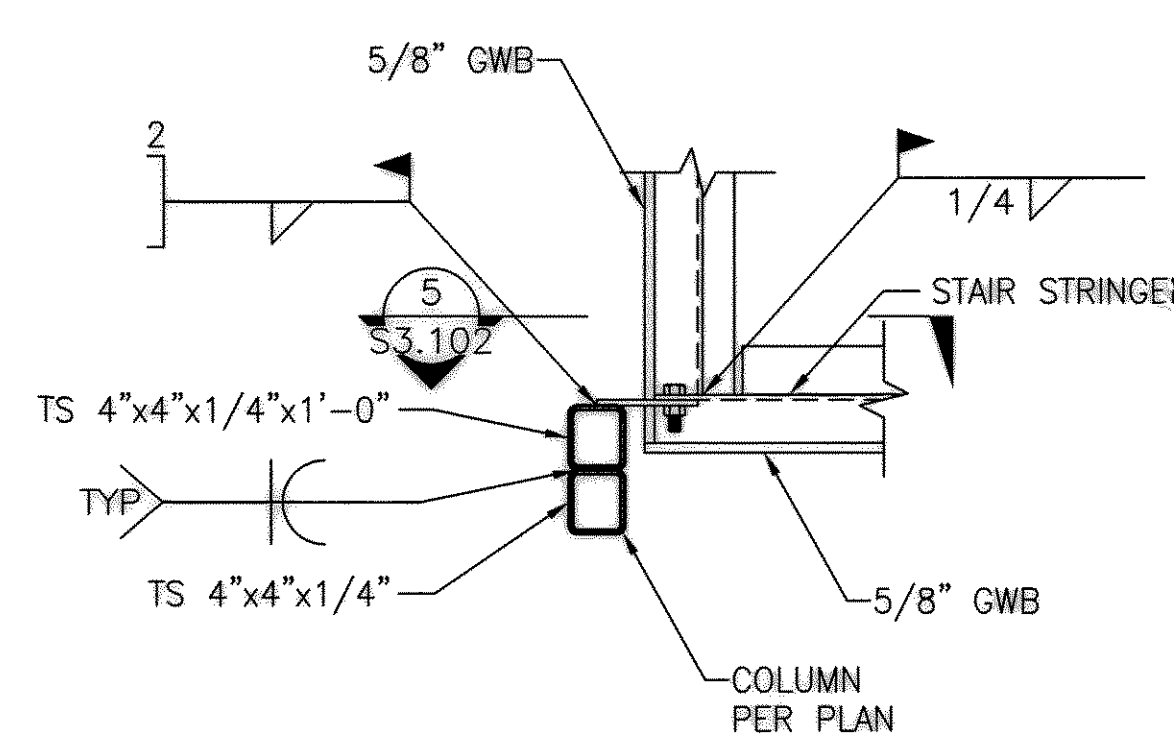

4 STAIR STRINGER DETAIL
S3.102 SCALE: 1" = 1'-0"

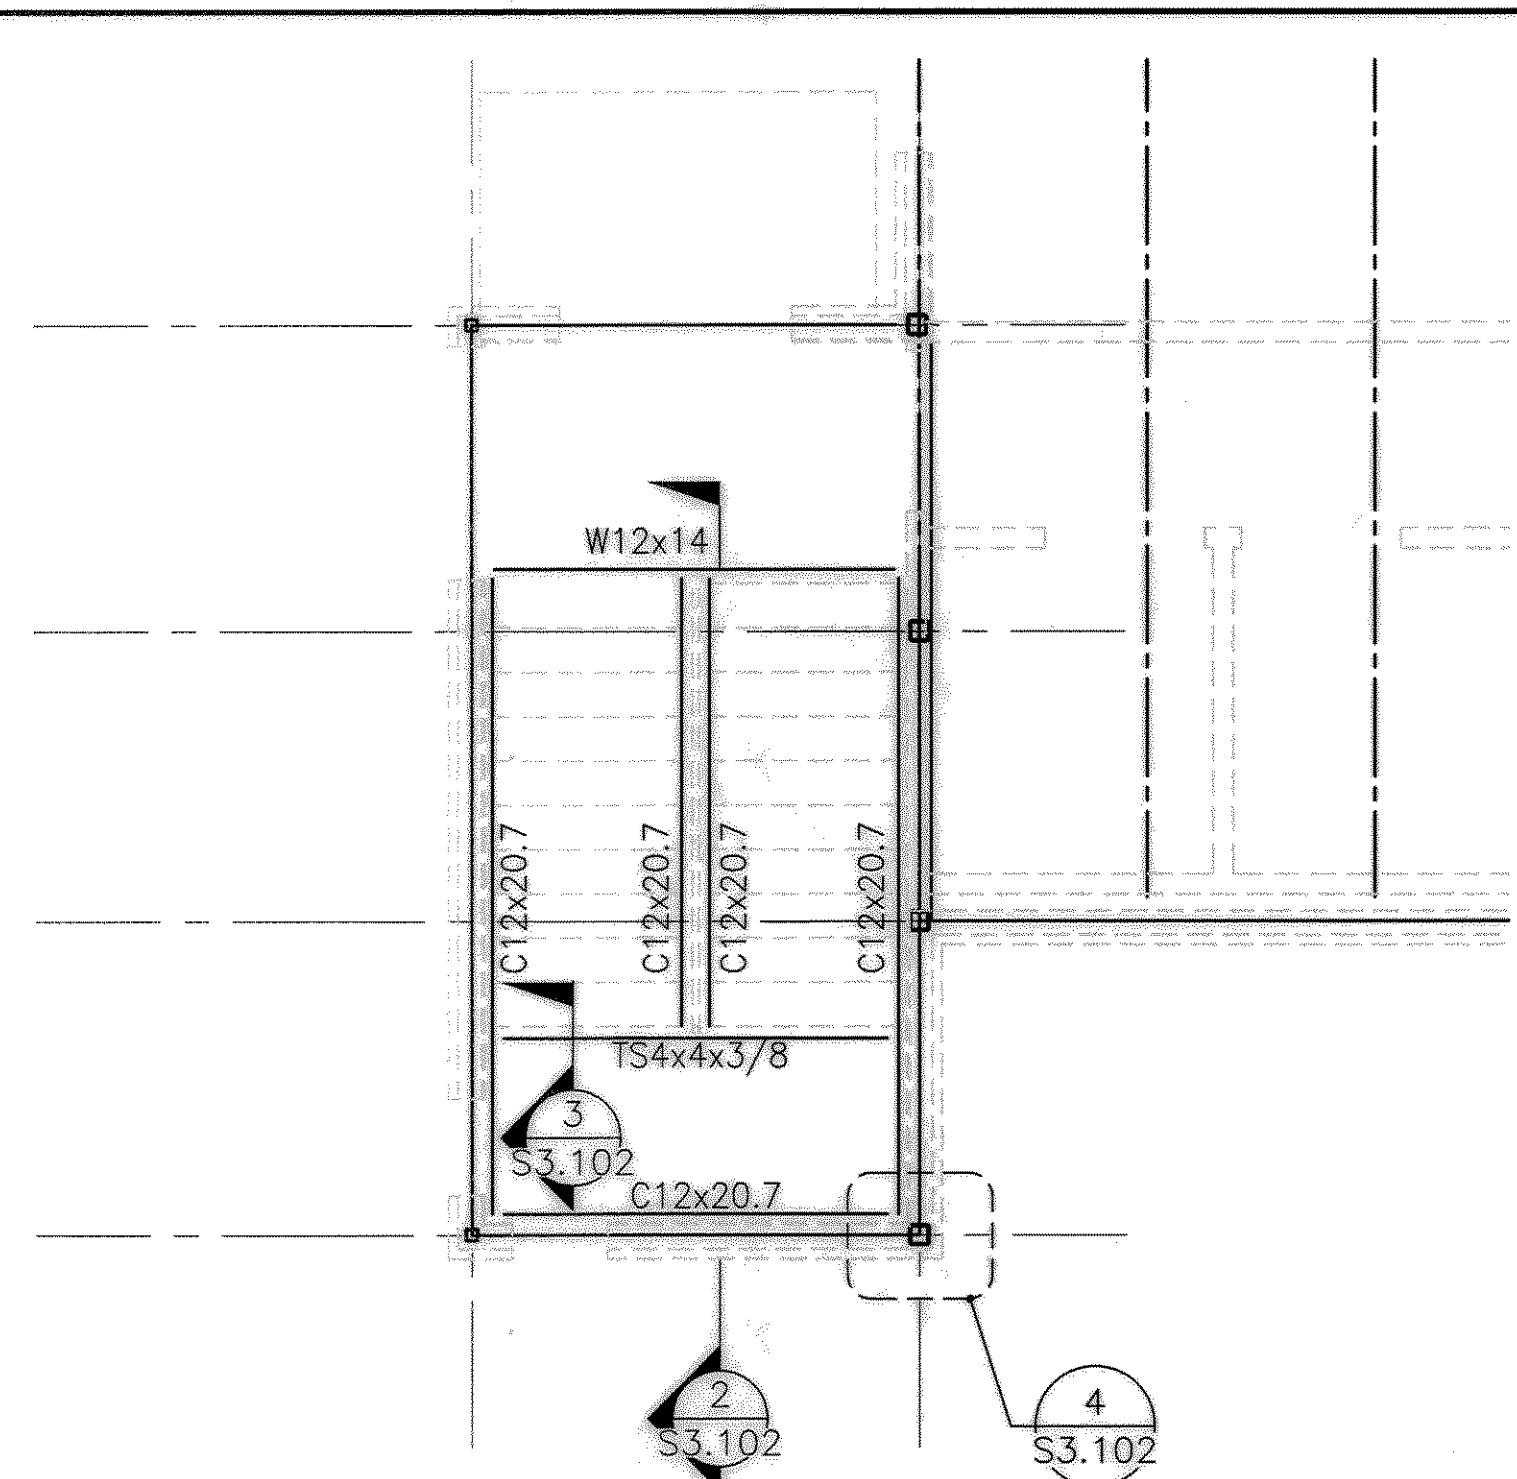

1 STAIR FRAMING PLAN
S3.102 SCALE: 1/4" = 1'-0"

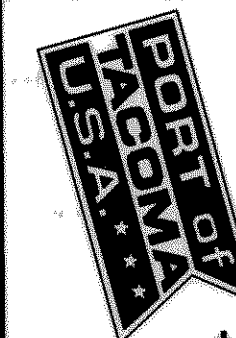

PORT OF TACOMA P.O. BOX 1837
TACOMA, WA 98401 253-383-5841



4021 12th street east
suite 201
Tacoma, WA 98424
tel: 253 . 922 . 9037
fax: 253 . 922 . 6499

RECORD DRAWINGS

APPROVED

RNZ 08/22/03
CHECKED BY - DATE

LY 08/22/03
PROJECT ENGR - DATE

SENIOR DIRECTOR OF DATE
FACILITY DEVELOPMENT
DRAWING DATE: 12/29/04
PORT ADDRESS:
PORT PARCEL:


PORT OF TACOMA
PIERCE COUNTY TERMINAL
MARINE BUILDING
BRACED FRAME ELEVATIONS

EP00443


6321-17

S3.201
SHEET 69 OF 230


CONTRACT NUMBER: 998154
E NUMBER: E1974
PHASE: RECORD DRAWINGS

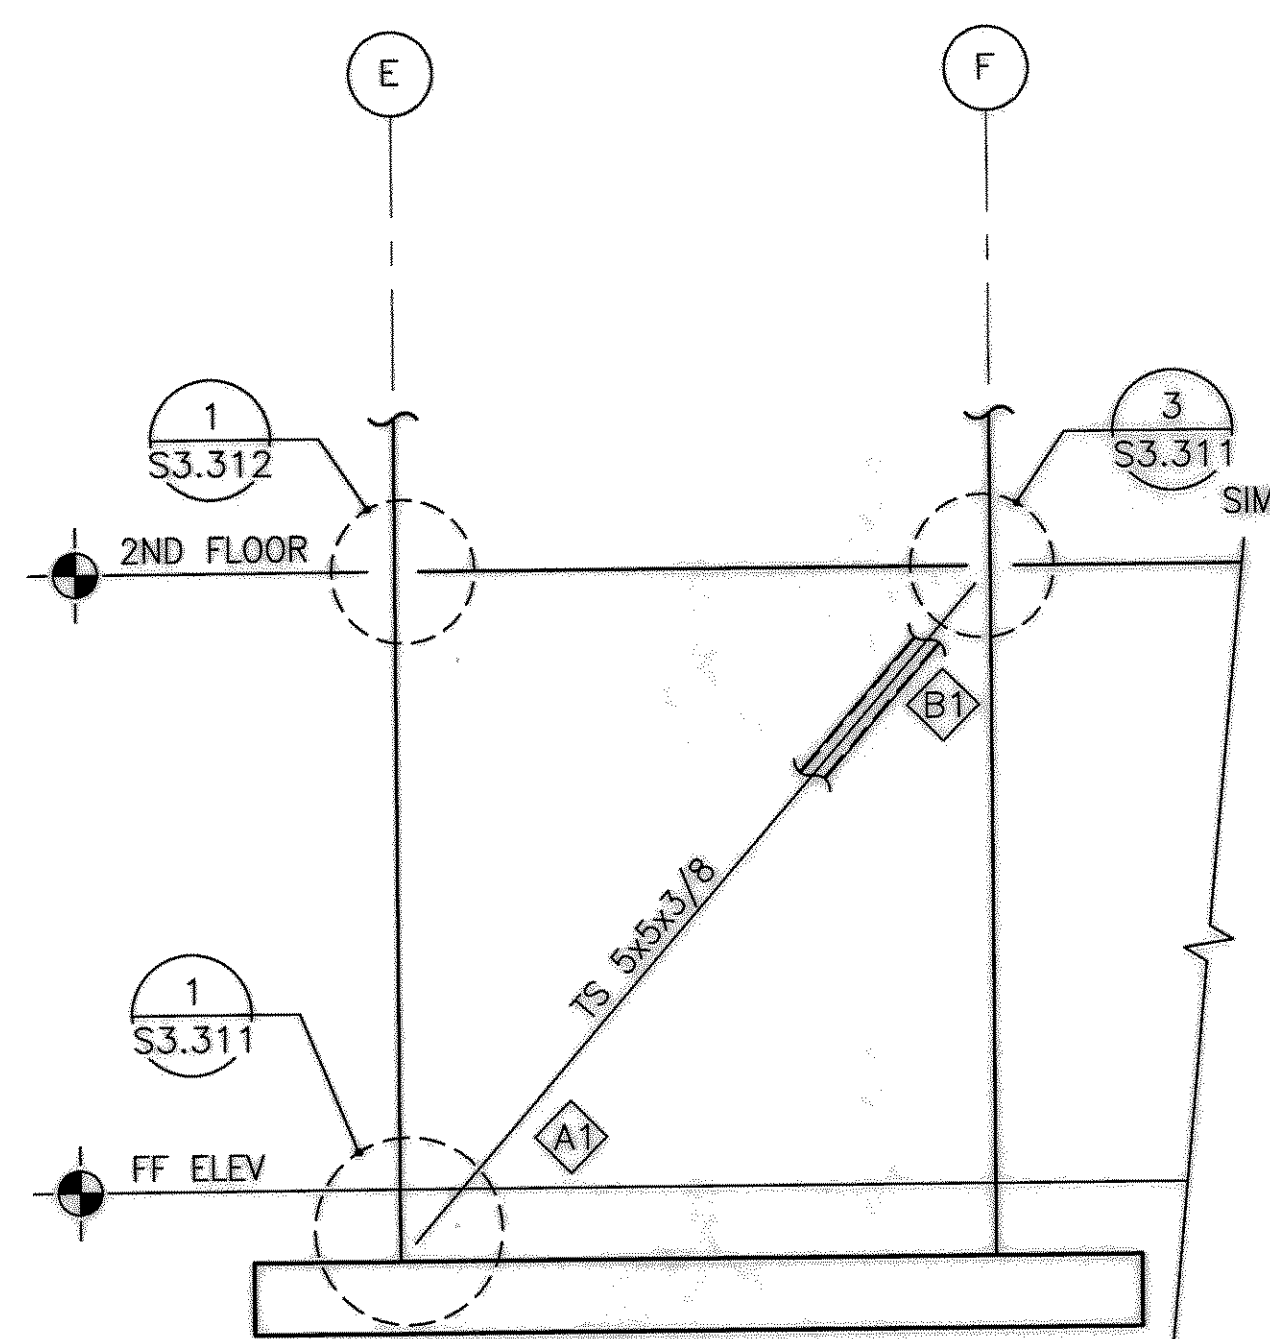


BRACED FRAME BF1
SCALE: 1/4" = 1'-0"

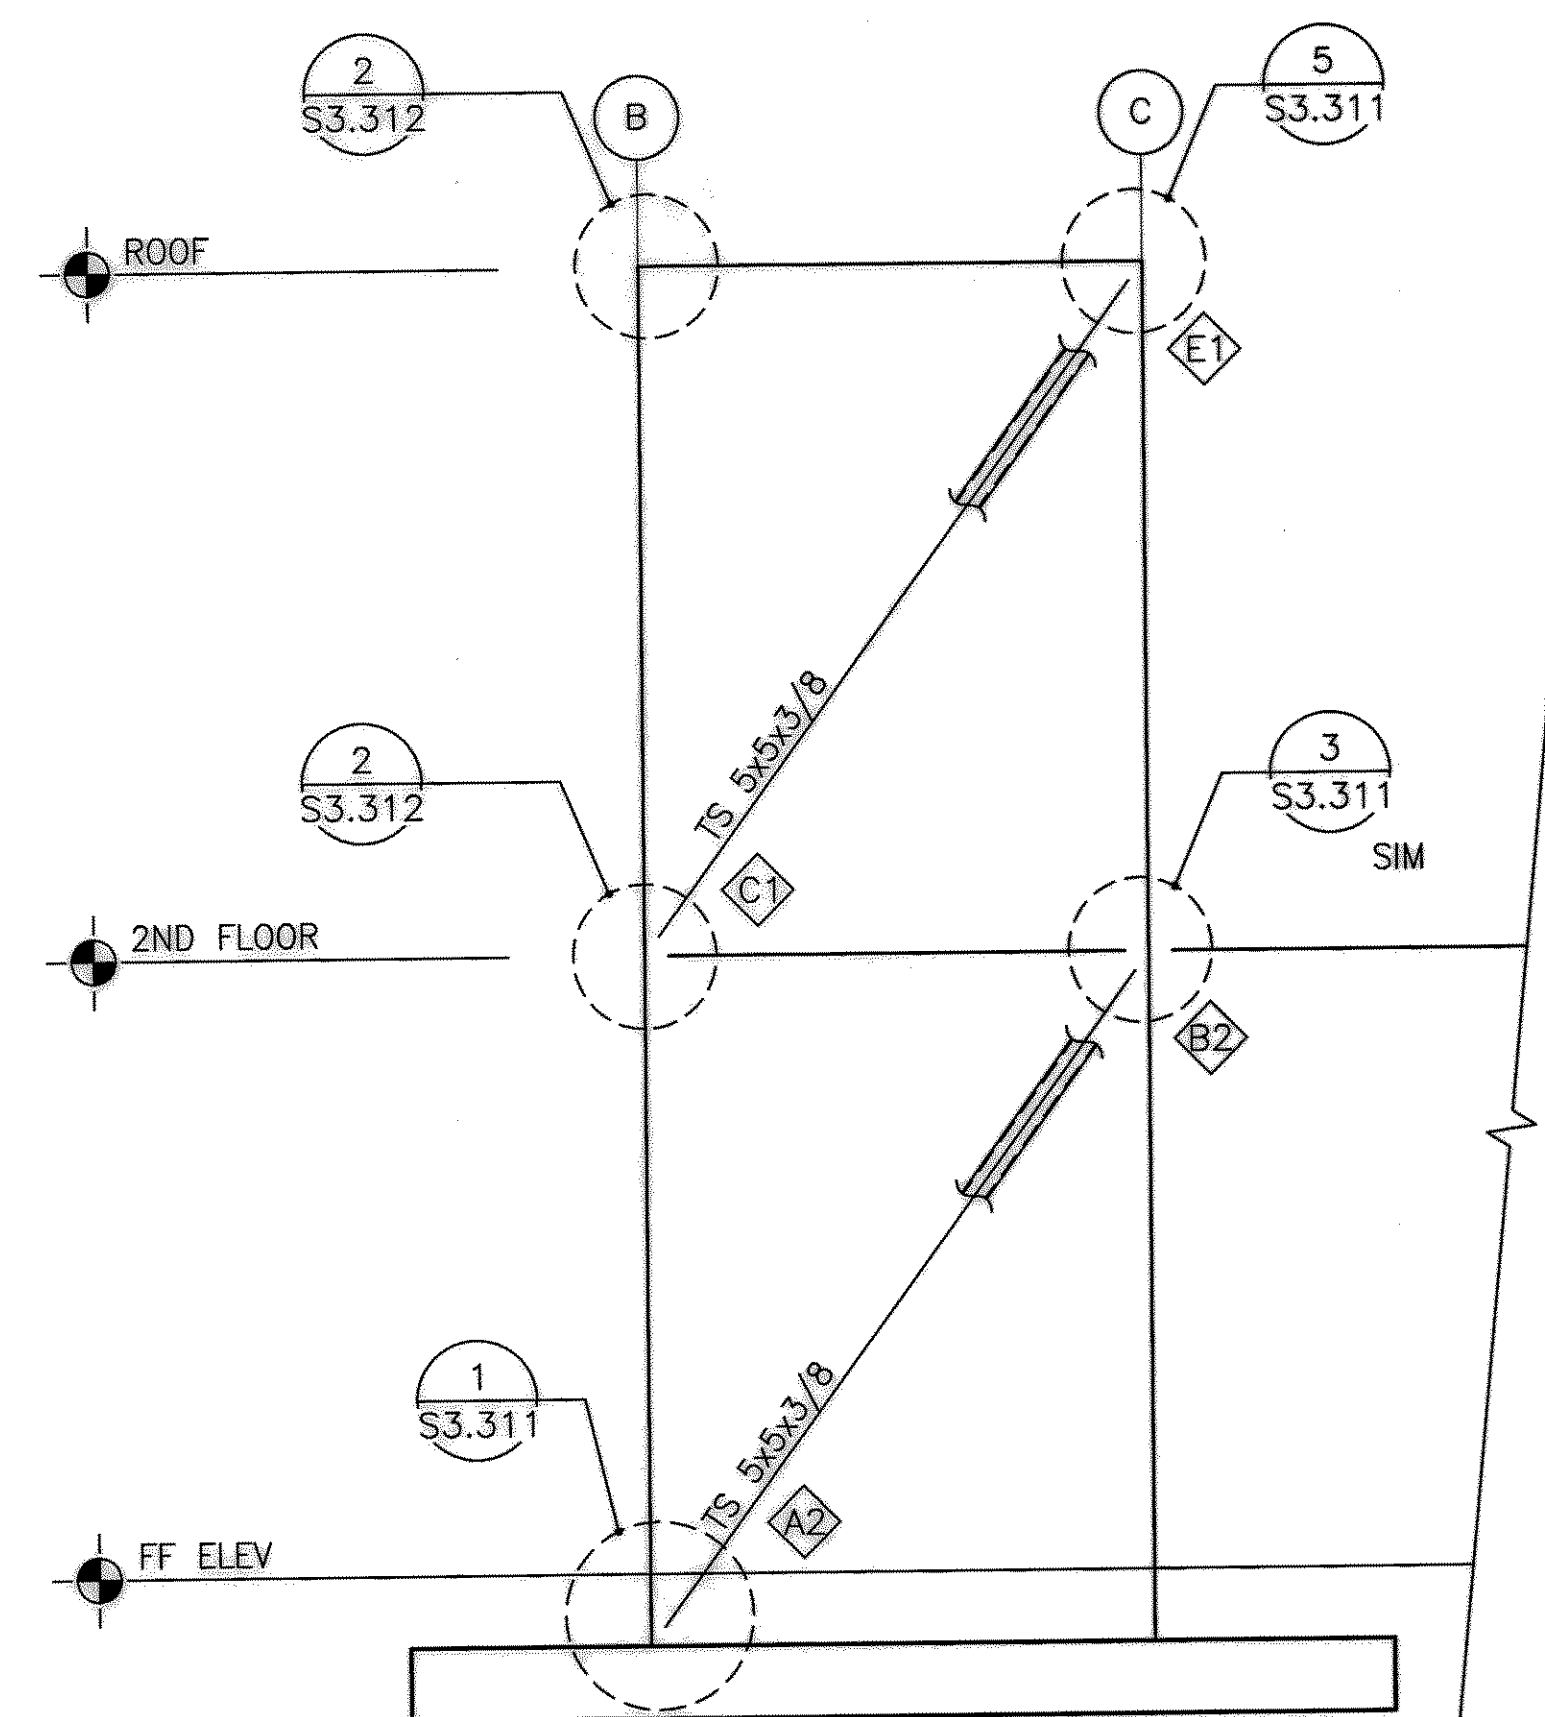

BRACED FRAME BF2
SCALE: 1/4" = 1'-0"

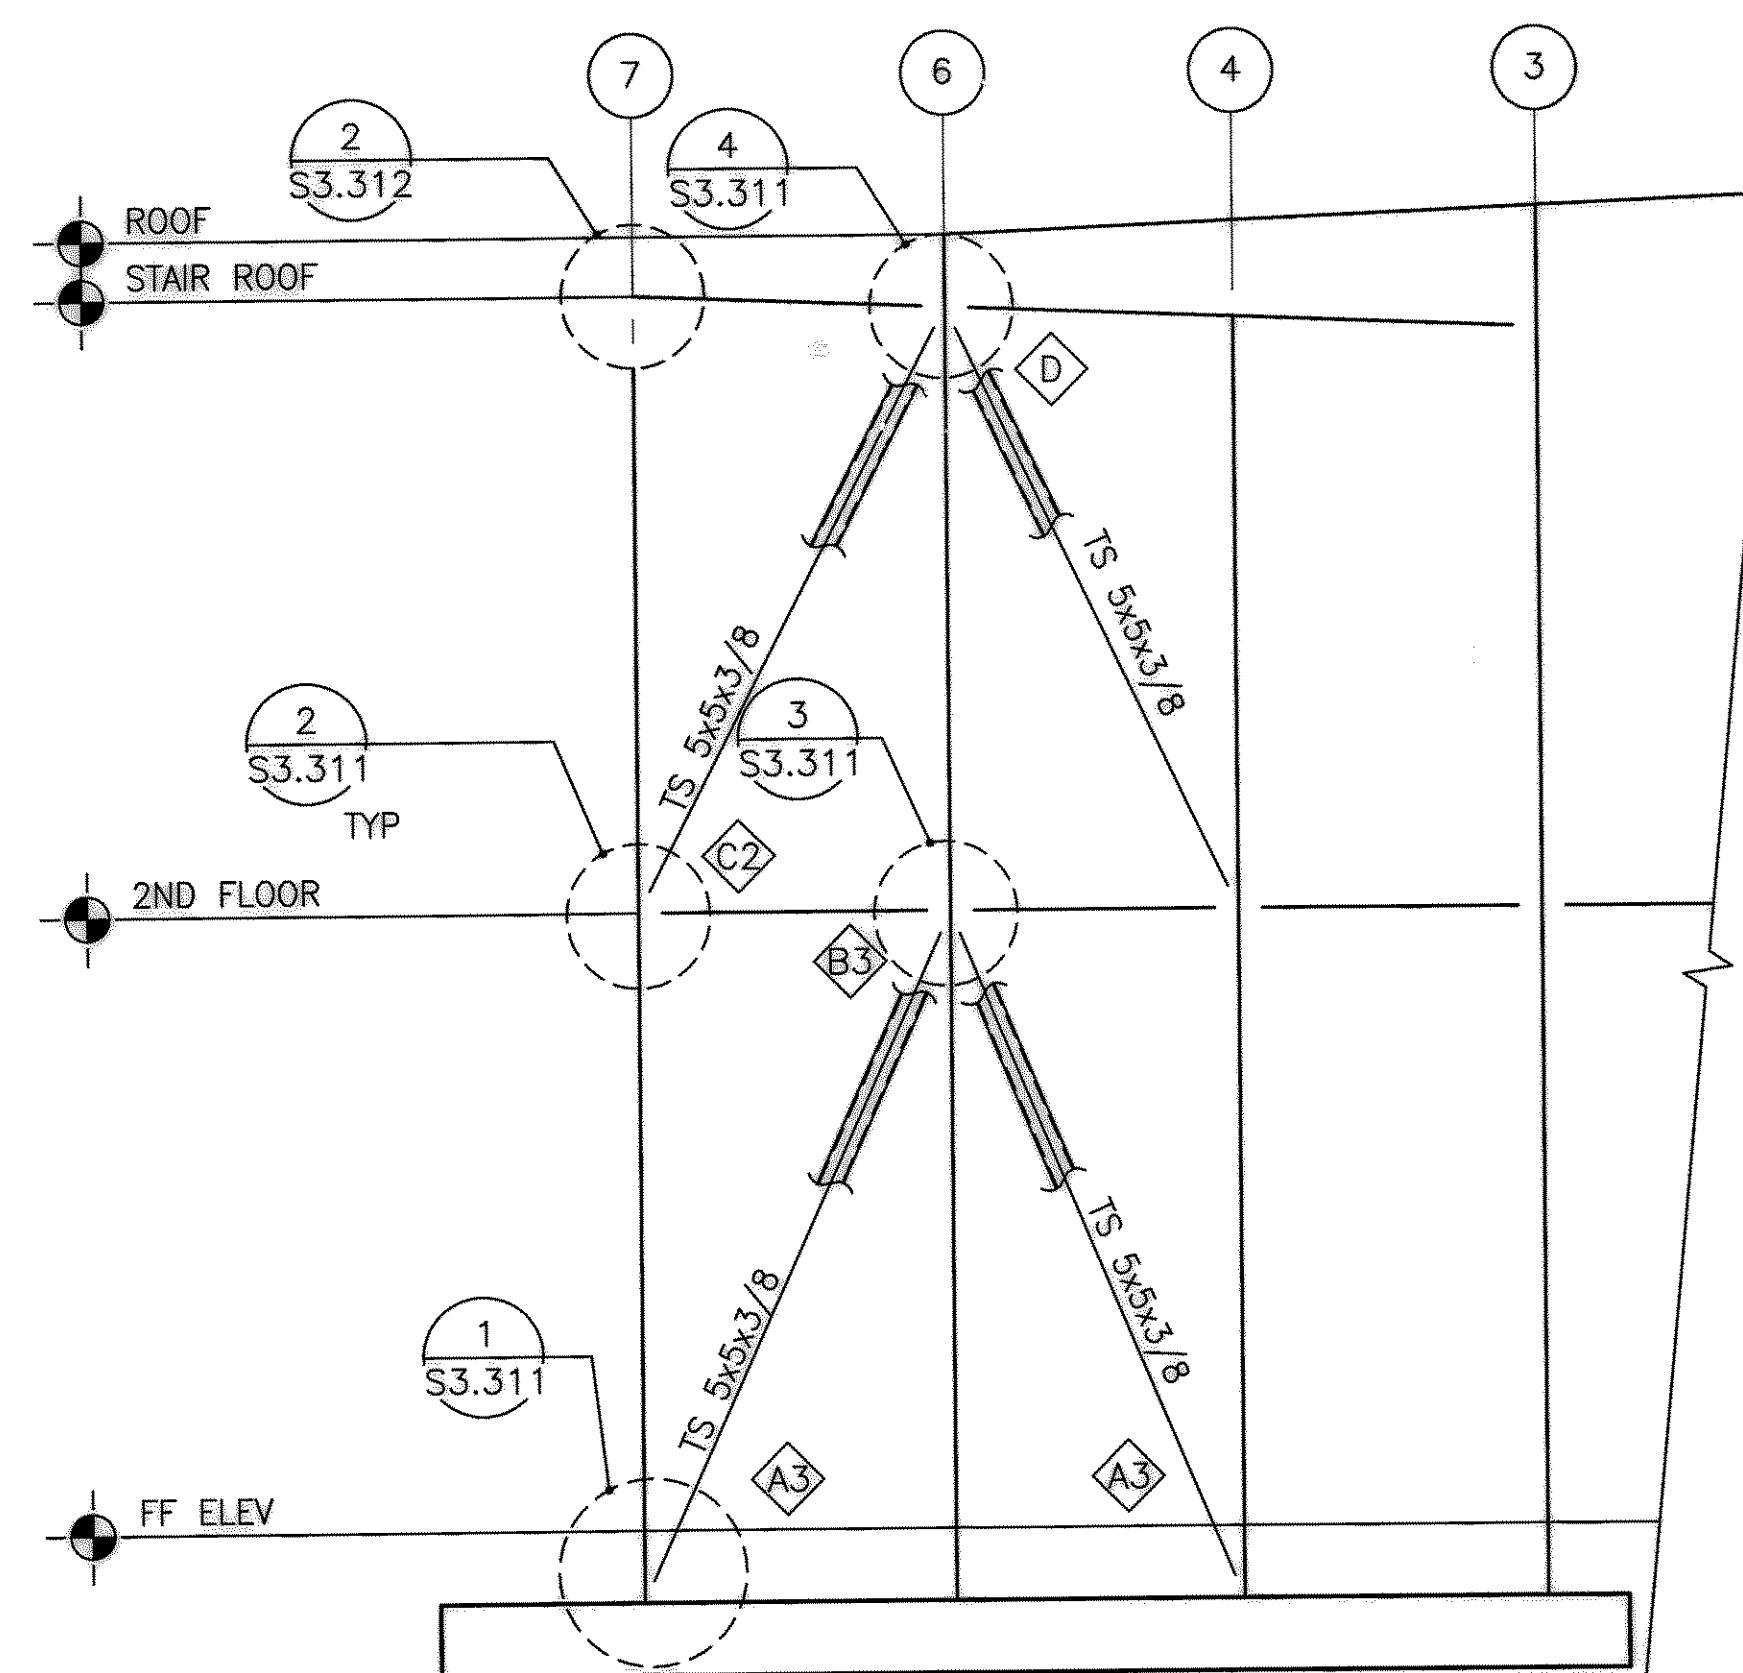


BRACED FRAME BF3
SCALE: 1/4" = 1'-0"

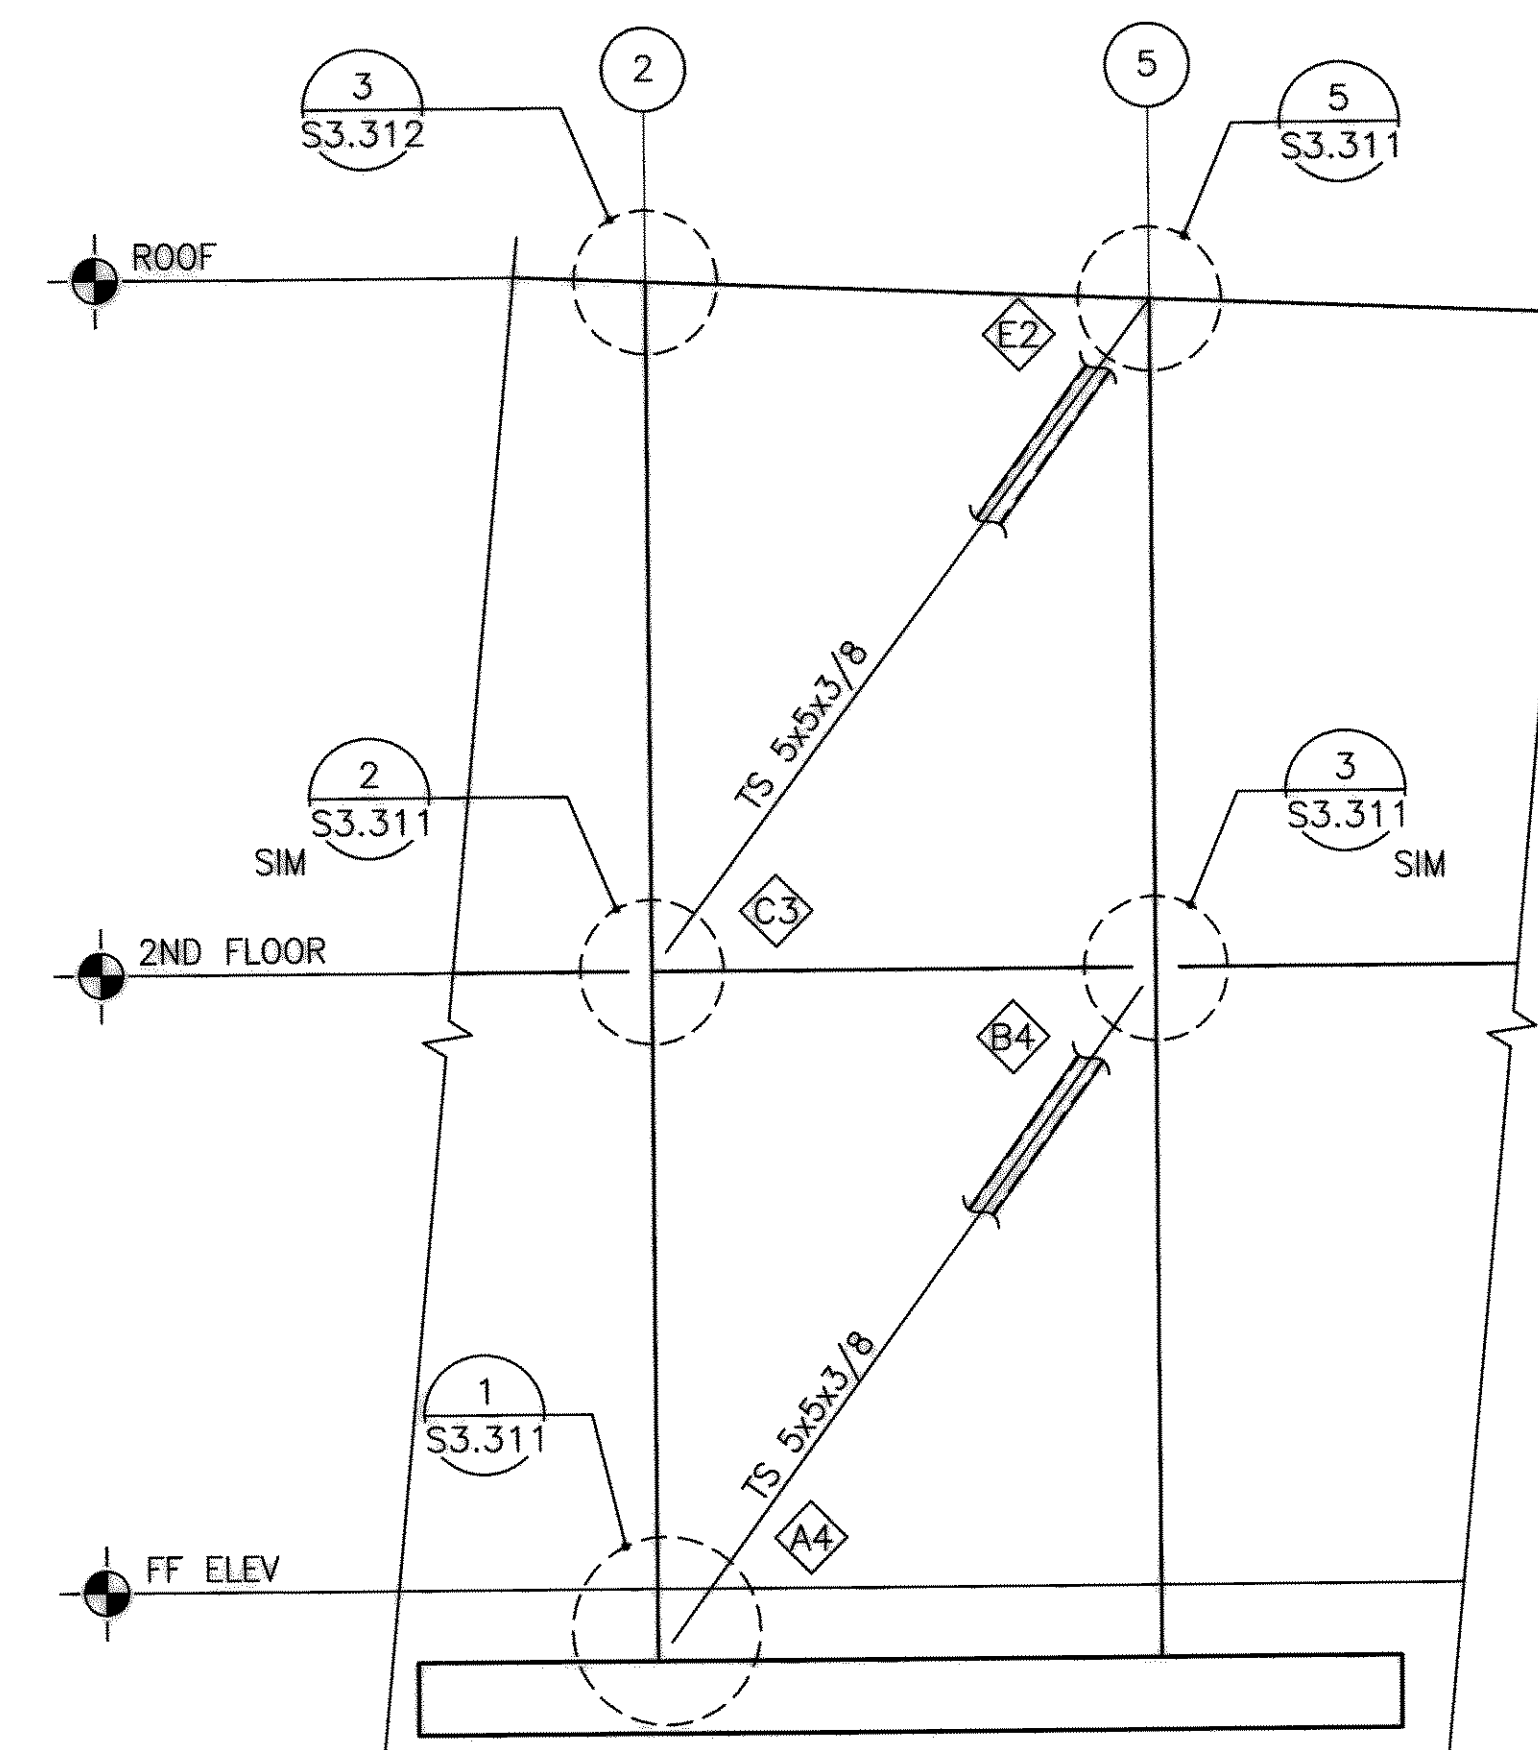

BRACED FRAME BF4
SCALE: 1/4" = 1'-0"



33301 9TH AVENUE SOUTH
FEDERAL WAY, WASHINGTON
98003-2600
VOICE: (206)431-2300
FAX: (206)431-2250

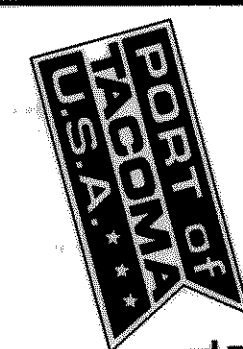

PORT OF TACOMA
TACOMA, WA 98401 P.O. BOX 1837
253-383-5841



6021 12th Street East
Tacoma, WA 98401
Tel: 253-922-9037
Fax: 253-922-6499

RECORD DRAWINGS

APPROVED

RNZ 08/22/03
CHECKED BY: - DATE

LY 08/22/03
PROJECT ENGR - DATE

SENIOR DIRECTOR OF
FACILITY DEVELOPMENT
DATE: 12/29/04
PORT ADDRESS:
PORT PARCEL:

PORT OF TACOMA

PIERCE COUNTY TERMINAL
MARINE BUILDING


FOUNDATION DETAILS AND SCHEDULES

EP004 17


6321-17

S3.301
SHEET 70 OF 230


CONTRACT NUMBER: 980154
E. NUMBER: E1974
PHASE: RECORD DRAWINGS

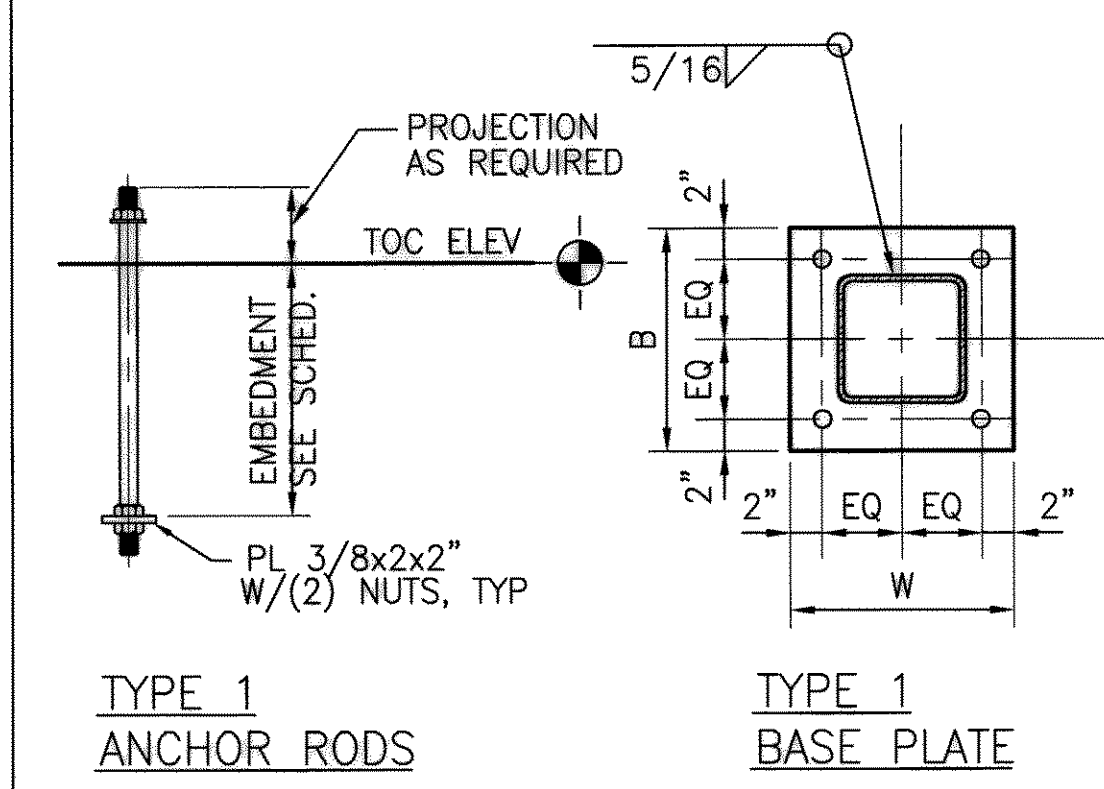


3 TYPE 1 ANCHOR RODS
SCALE: 1" = 1'-0"

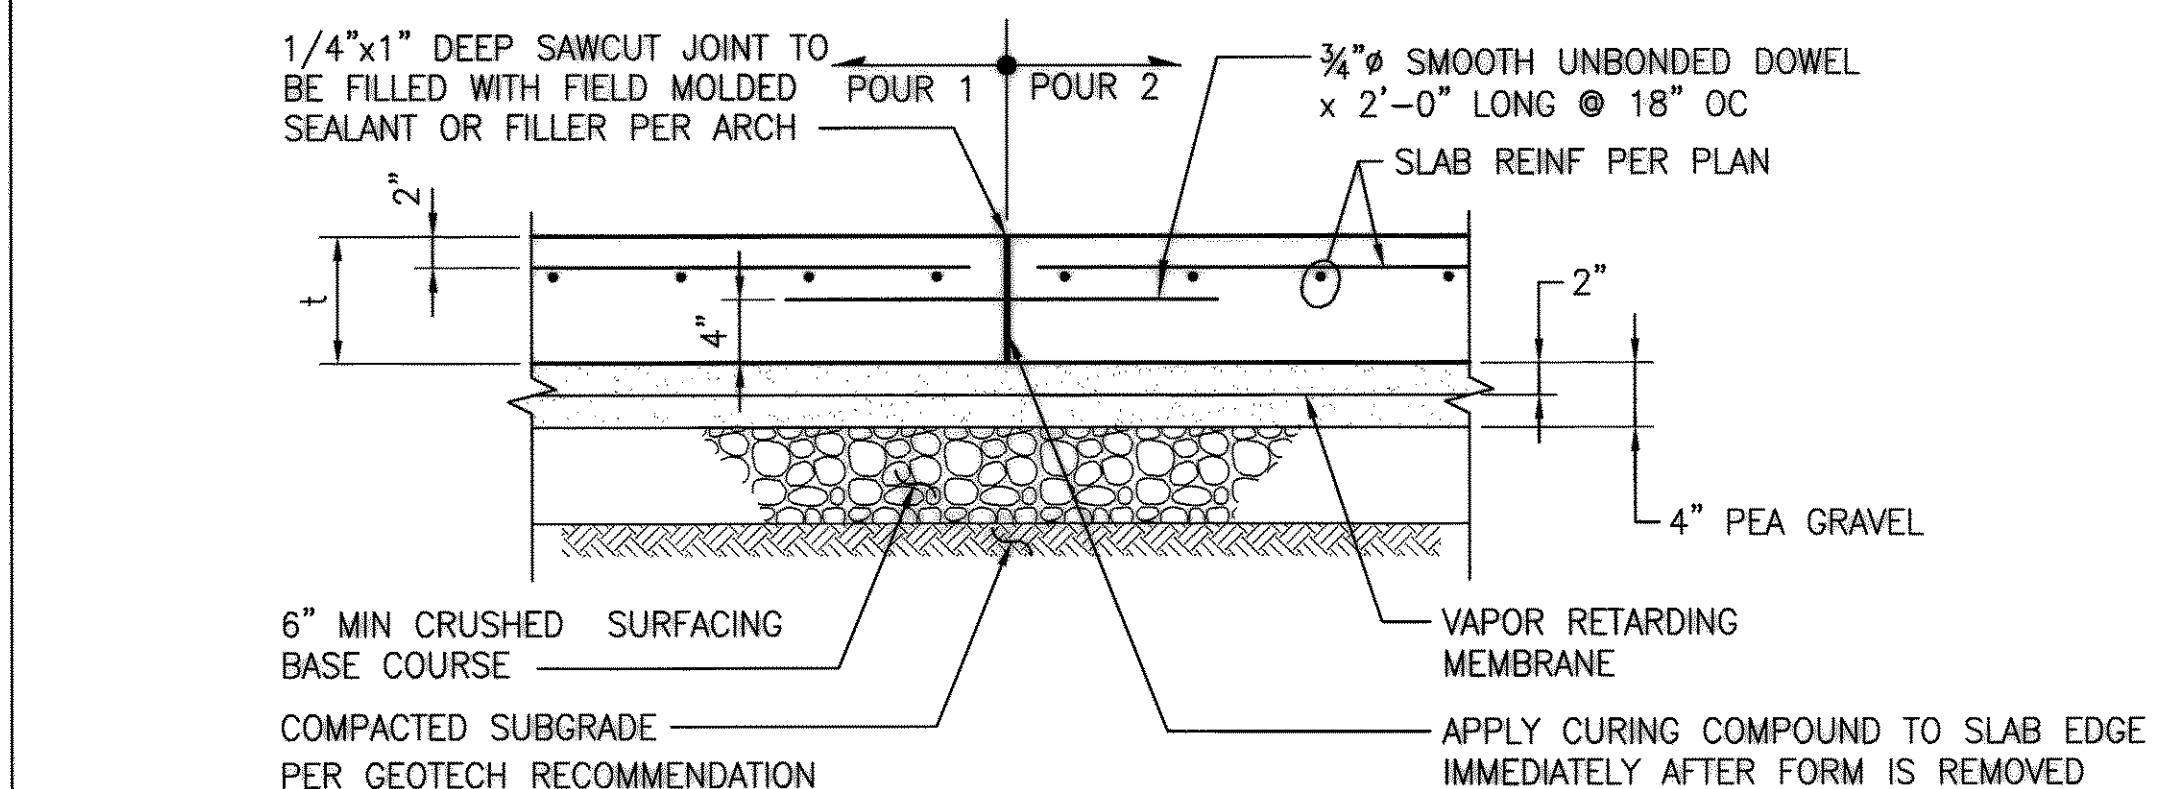


2 TYPE 2 CONSTRUCTION JOINT
SCALE: 1" = 1'-0"

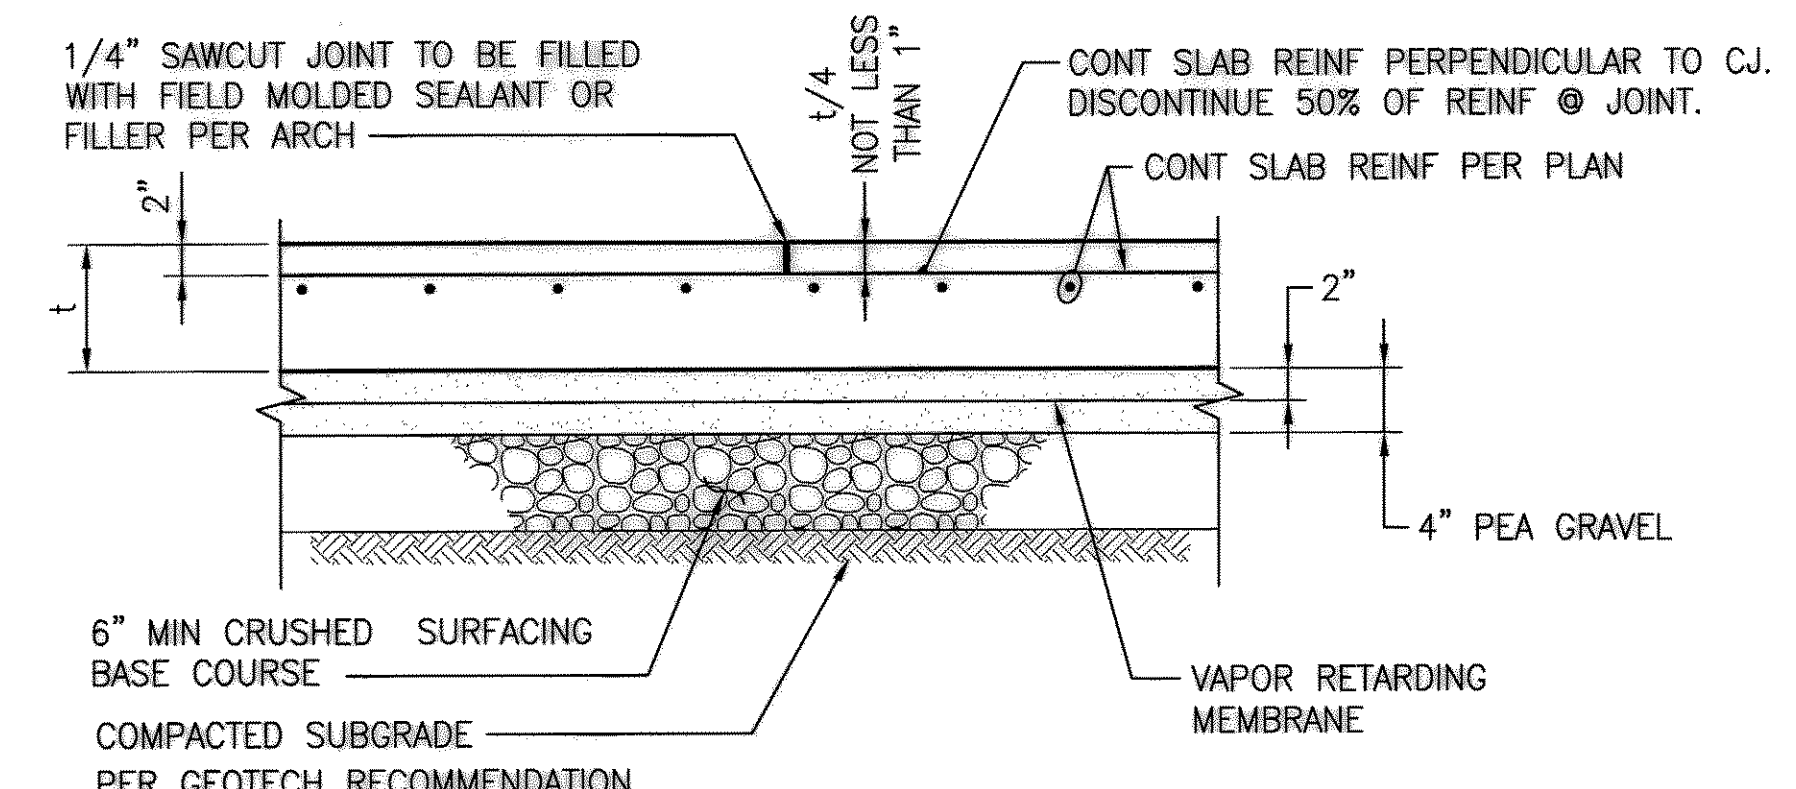

1 TYPE 1 TYPICAL CONTRACTION JOINT
SCALE: 1" = 1'-0"

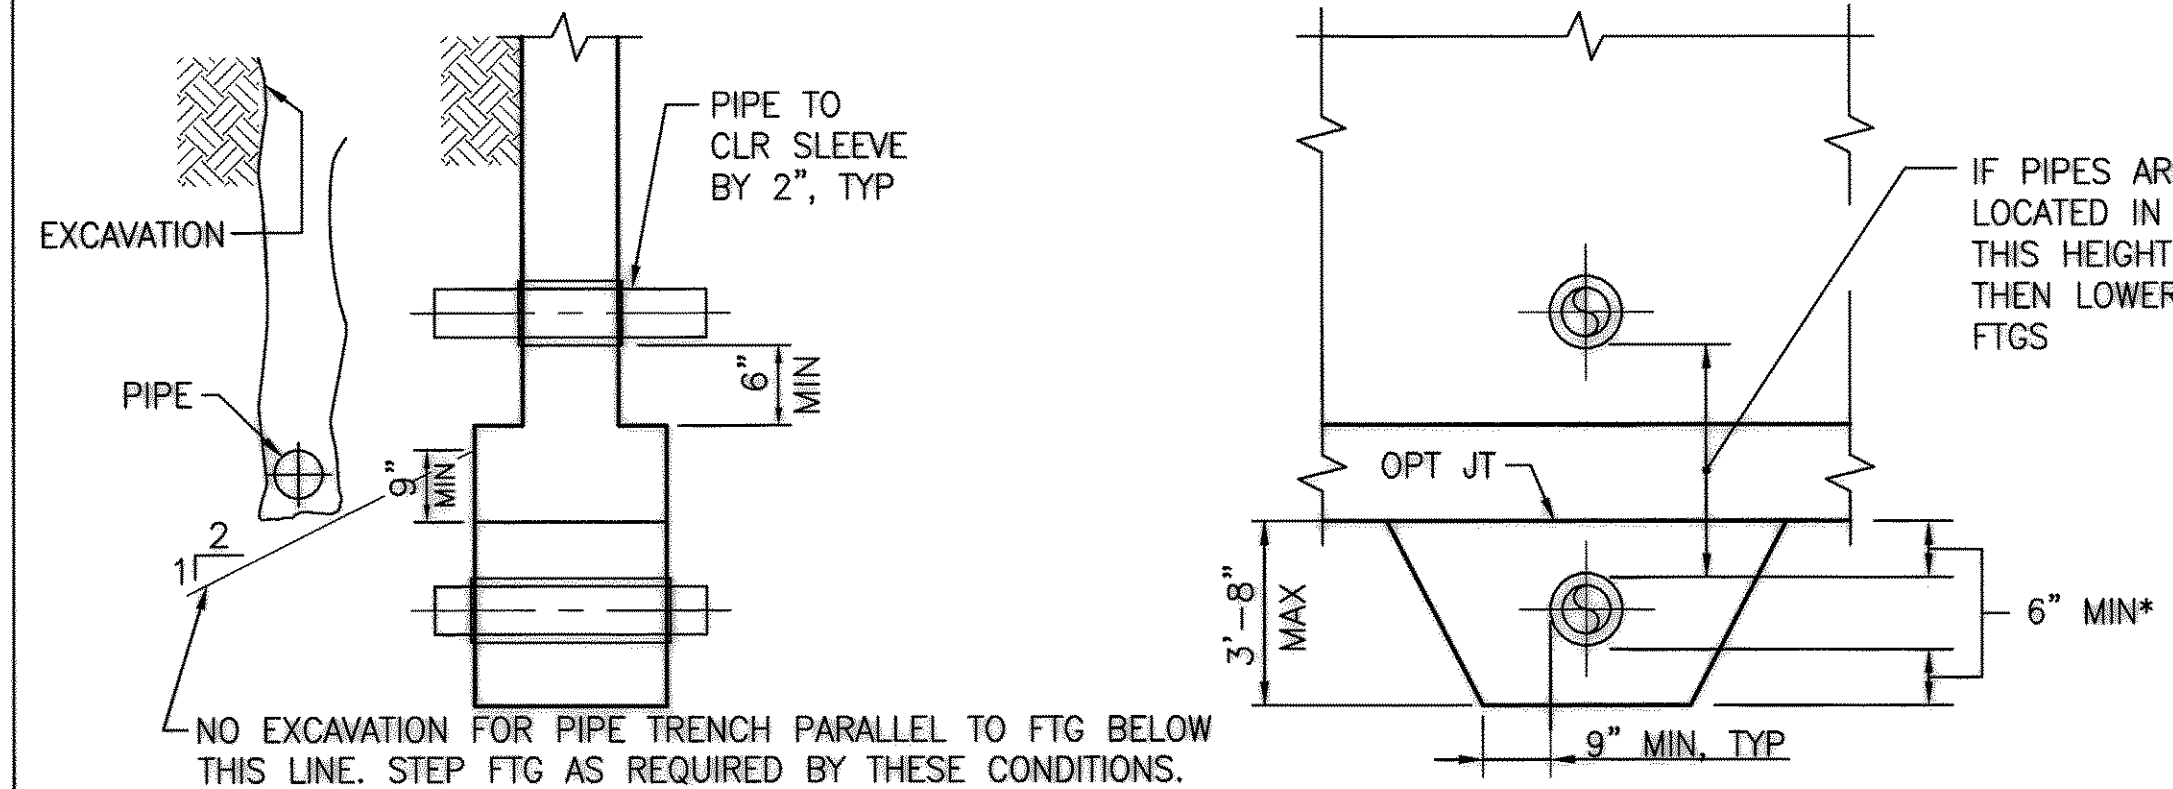


5 PIPE THROUGH CONC DETAIL
SCALE: 1" = 1'-0"

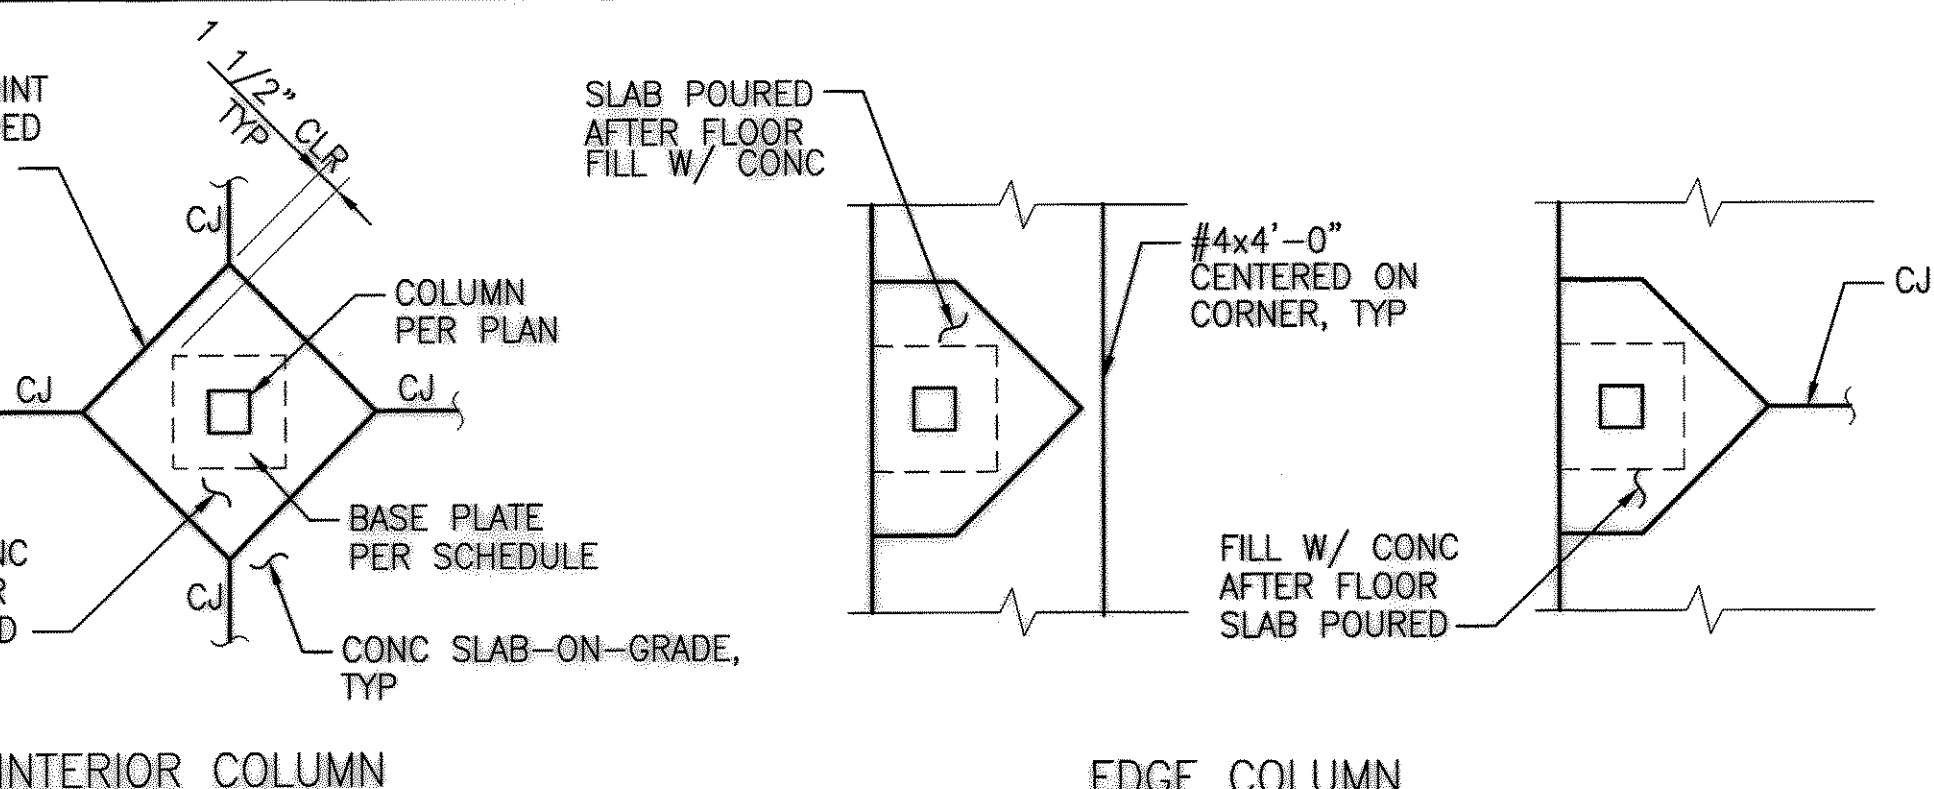

4 ISOLATION JOINT @ COLUMN DETAIL
SCALE: NTS

BERGER/ABAM
ENGINEERS INC.

33301 9TH AVENUE SOUTH
FEDERAL WAY, WASHINGTON
98003-2600
VOICE: (206)431-2300
FAX: (206)431-2250

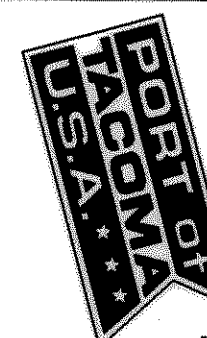

PORT OF TACOMA P.O. BOX 1837
TACOMA, WA 98401 253-383-5841



6021 12th street east
suite 201
Tacoma, wa 98424
tel: 253-922-9037
fax: 253-922-6499

RECORD DRAWINGS

APPROVED

RNZ 06/22/03
CHECKED BY - DATE

LY 06/22/03
PROJECT ENGR - DATE

SENIOR DIRECTOR OF
FACILITY DEVELOPMENT
DATE

DRAWING DATE: 12/20/04

PORT ADDRESS:

PORT PARCEL:

TOWNSHIP: RANGE: SECTION:

DATUM: HORIZ: VERT:


DRAWING SCALE:

PORT OF TACOMA
PIERCE COUNTY TERMINAL
MARINE BUILDING
FOUNDATION DETAILS AND SCHEDULES


EP 6321-17

S3.302
SHEET 71 OF 230


CONTRACT NUMBER: 998154
E NUMBER: E1974
PHASE: RECORD DRAWINGS

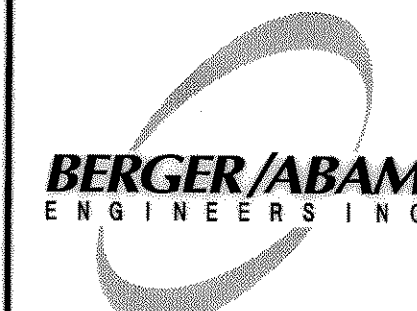


33301 9TH AVENUE SOUTH
FEDERAL WAY, WASHINGTON
98003-2600
VOICE: (206)431-2300
FAX: (206)431-2250

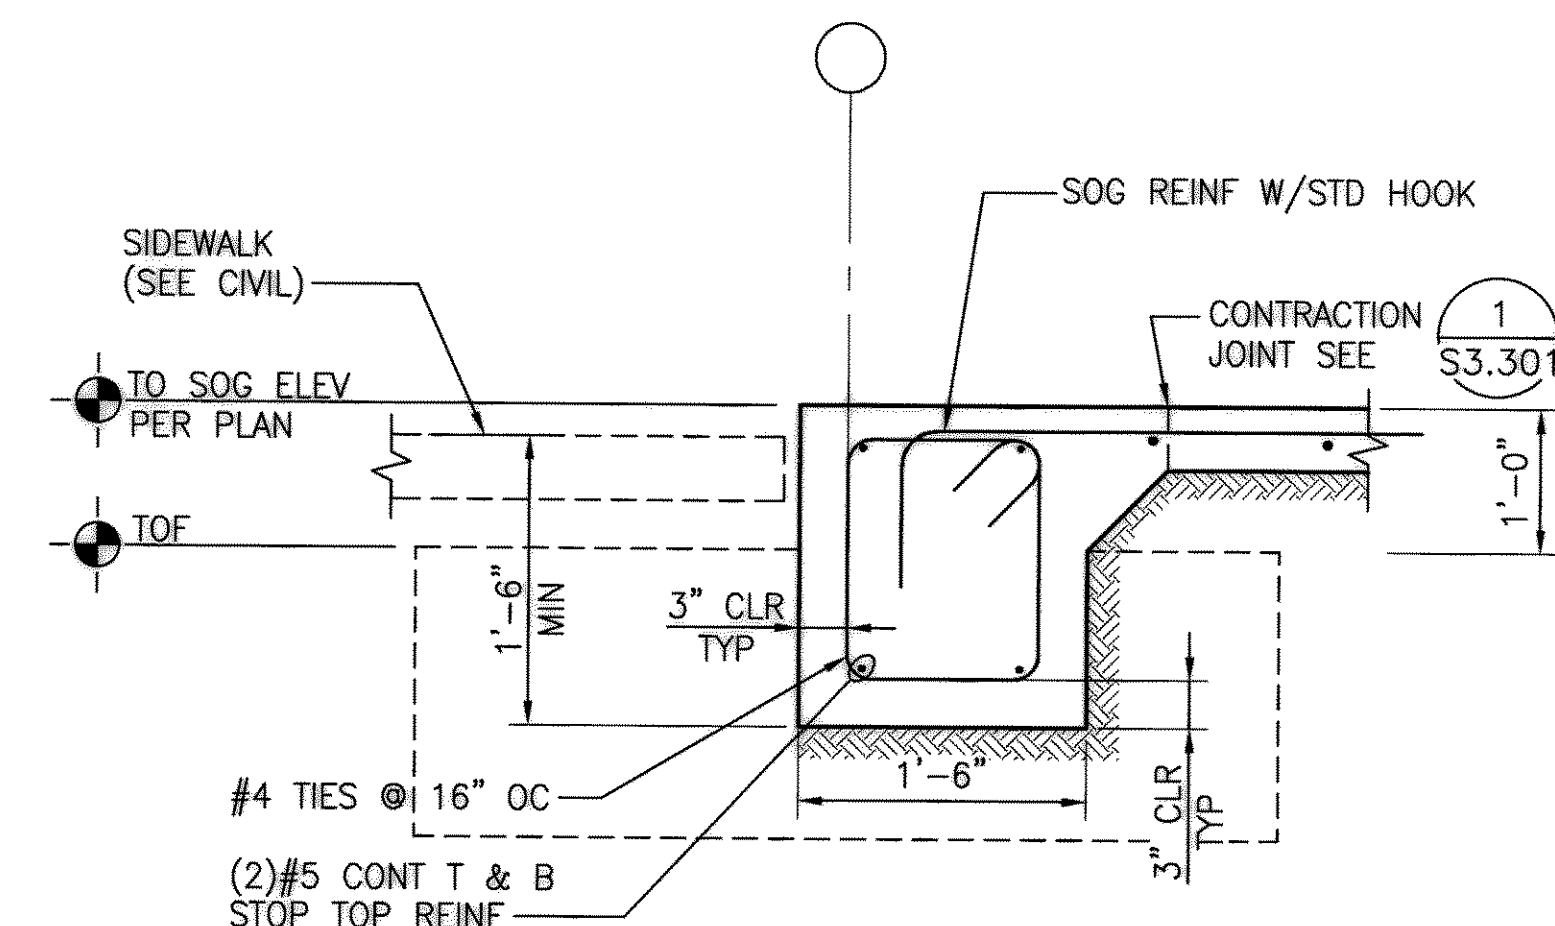


3 TYP EXT WALL FOUNDATION DETAIL
S3.302 SCALE: 1" = 1'-0"

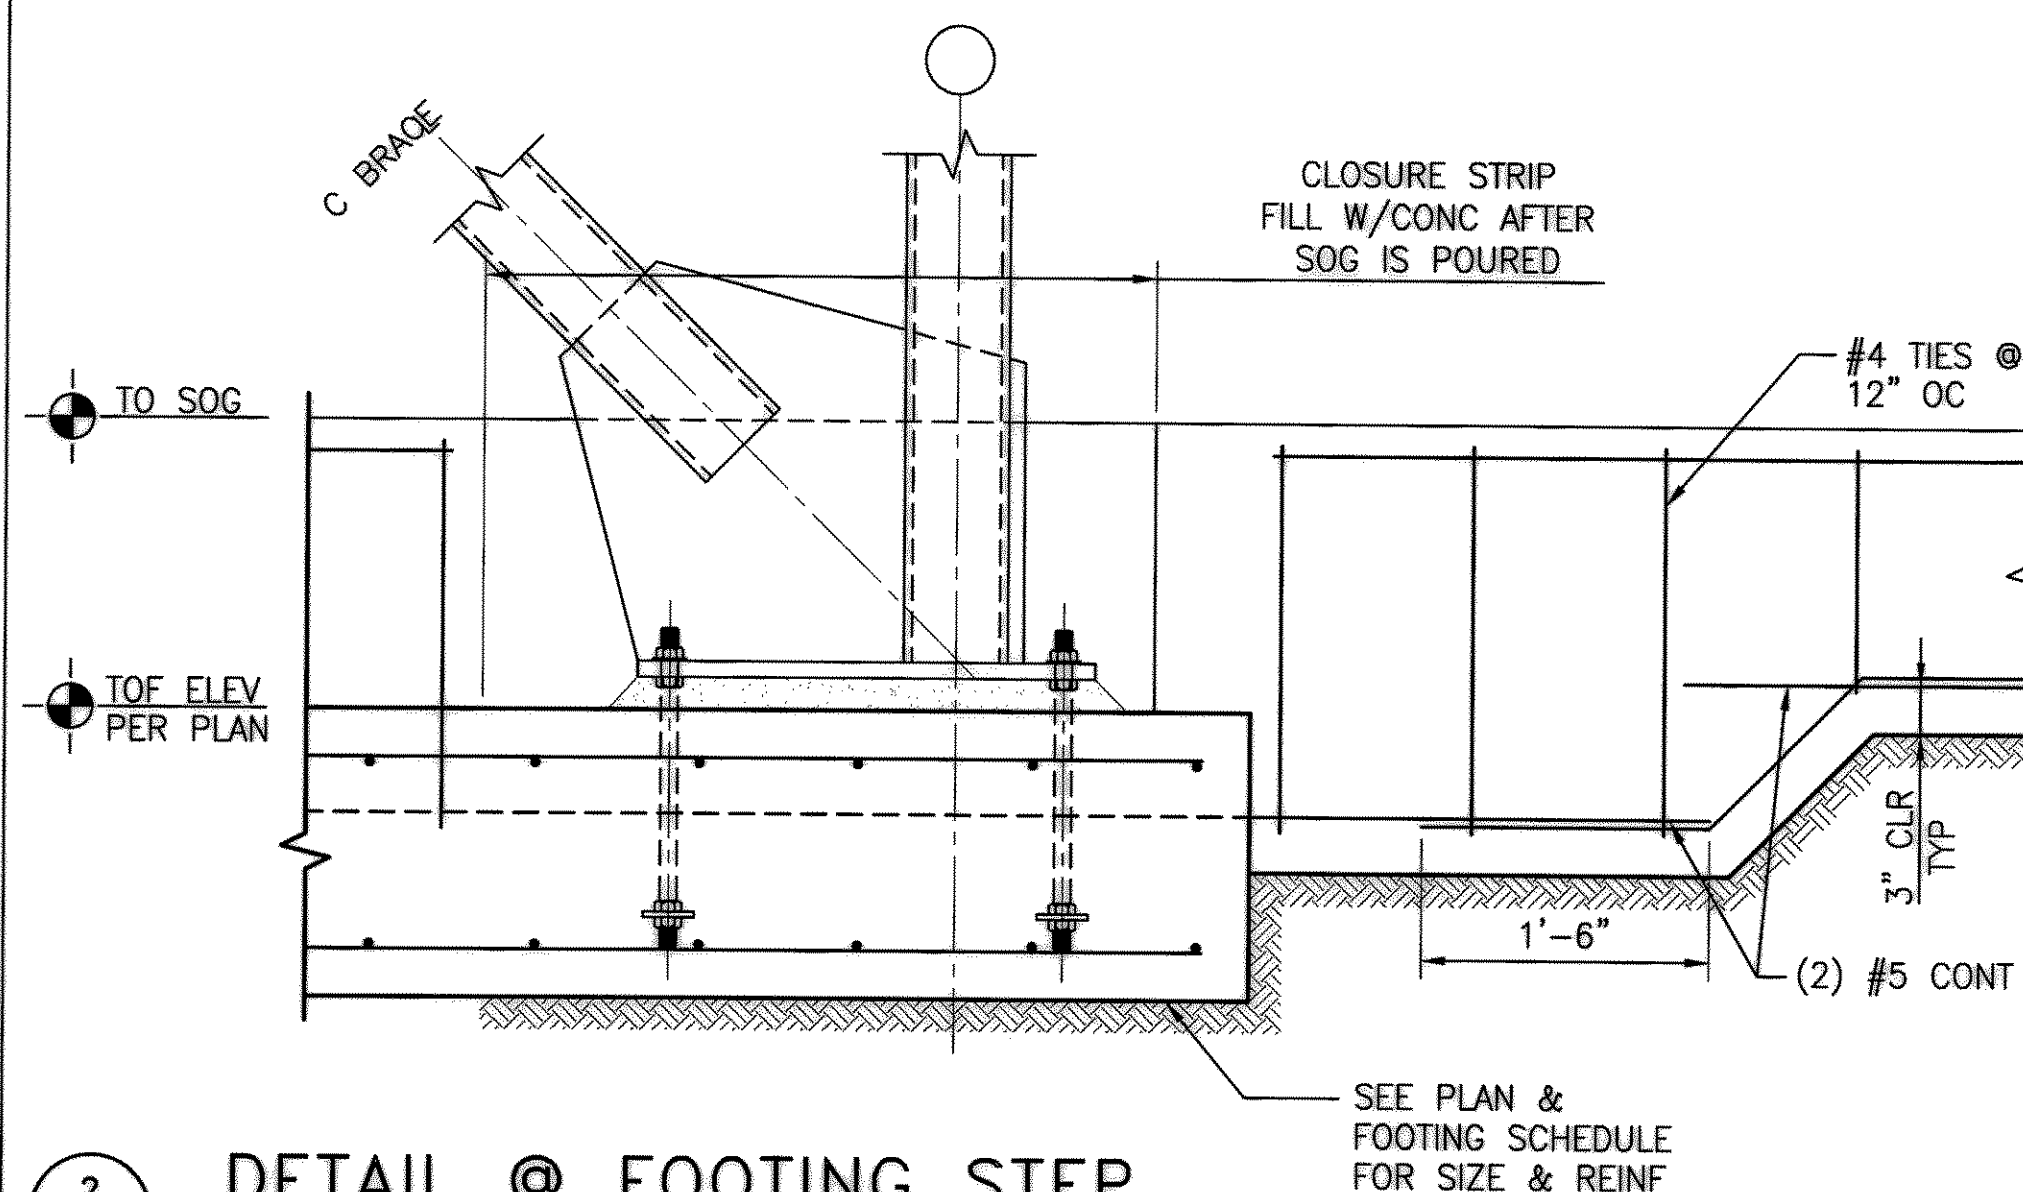


2 DETAIL @ FOOTING STEP
S3.302 SCALE: 1" = 1'-0"

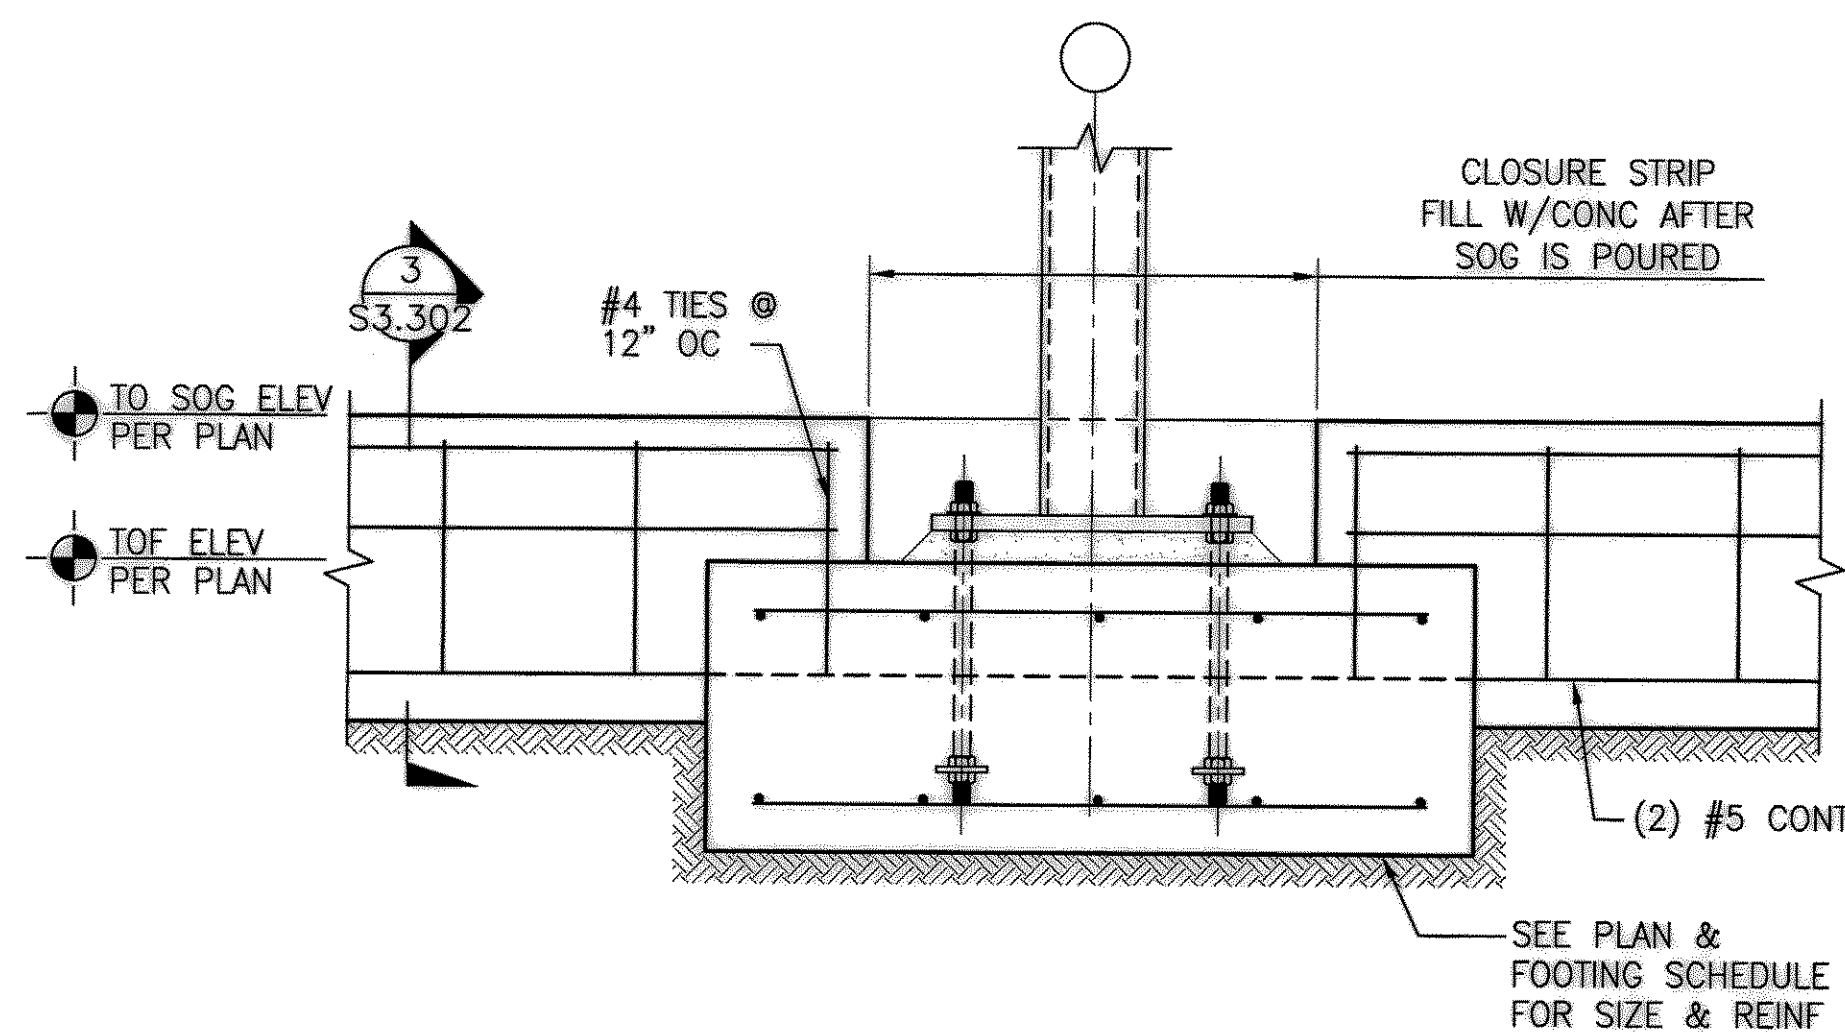

1 TYPICAL DETAIL
S3.302 SCALE: 1" = 1'-0"

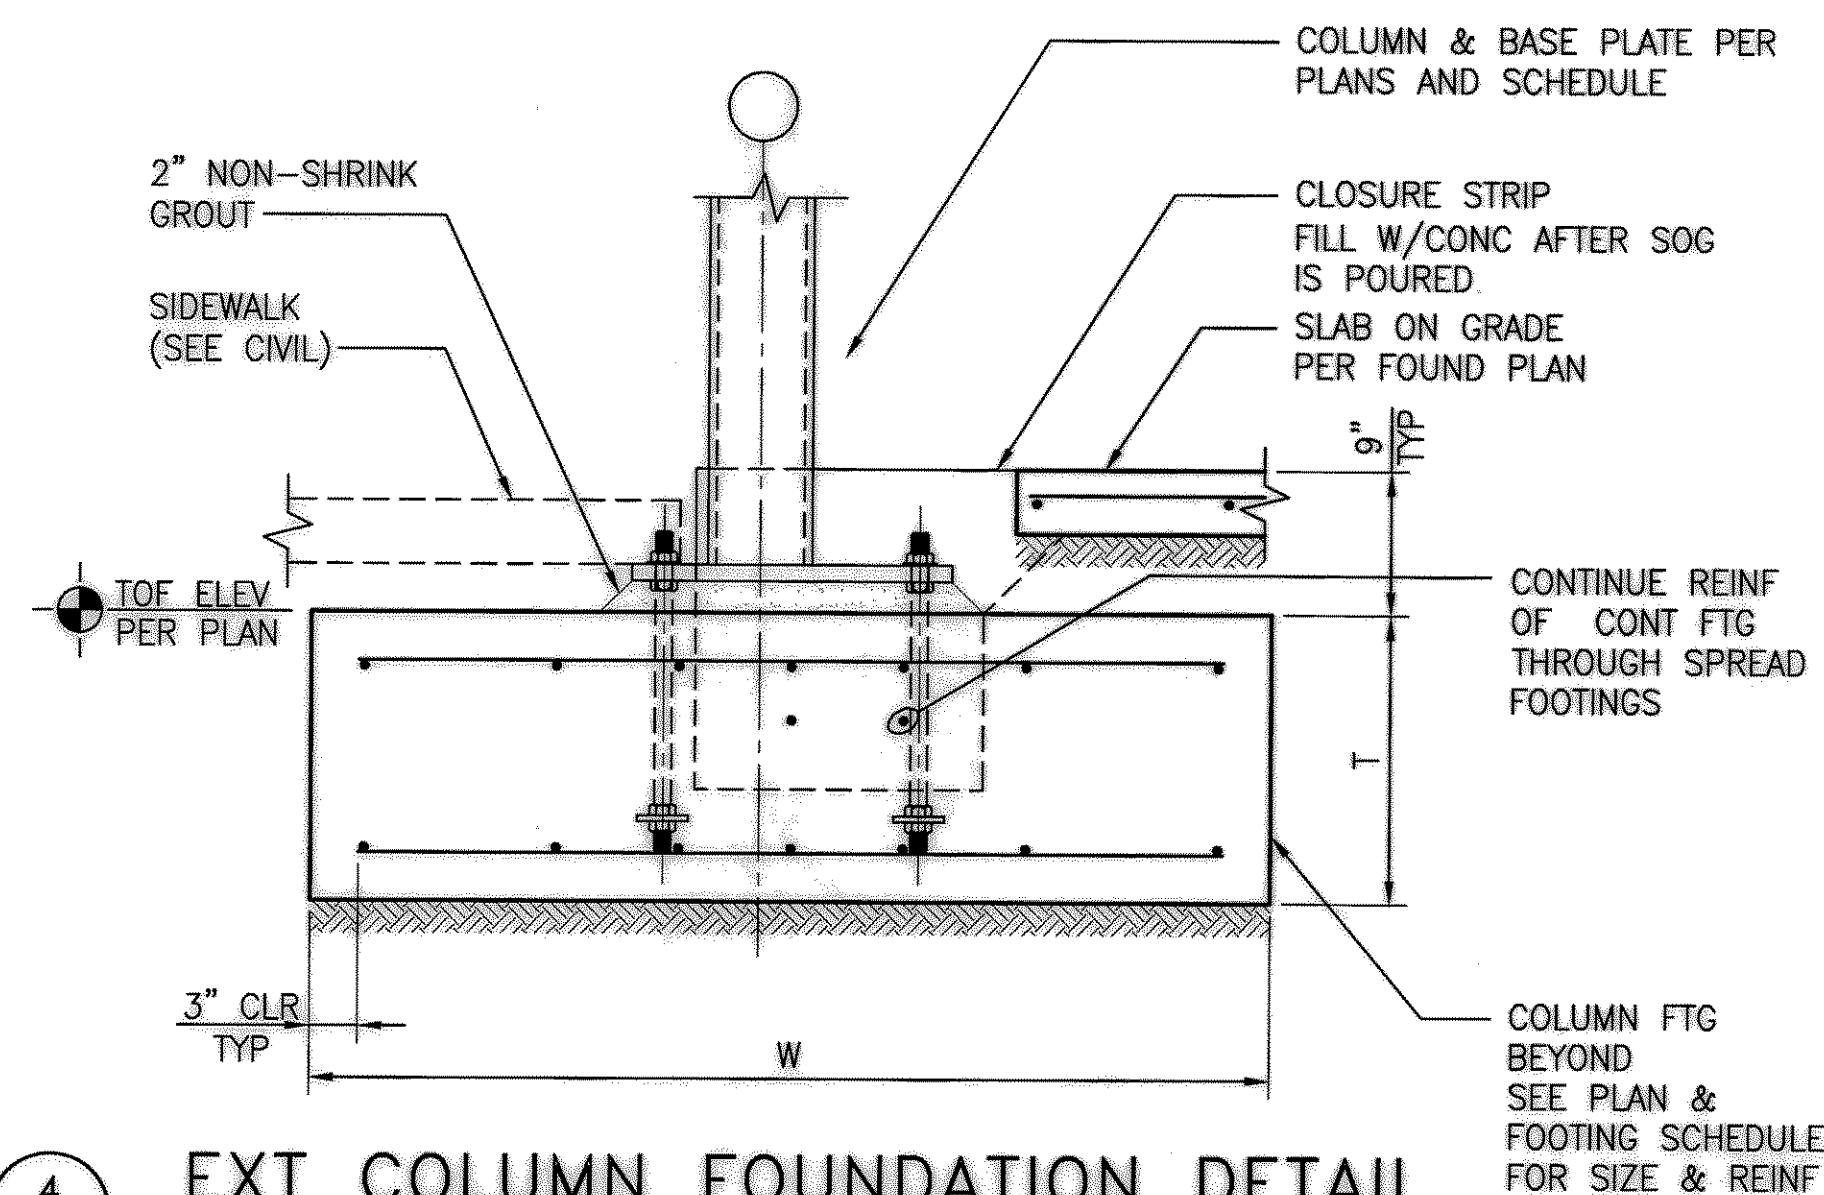


4 EXT COLUMN FOUNDATION DETAIL
S3.302 SCALE: 1" = 1'-0"

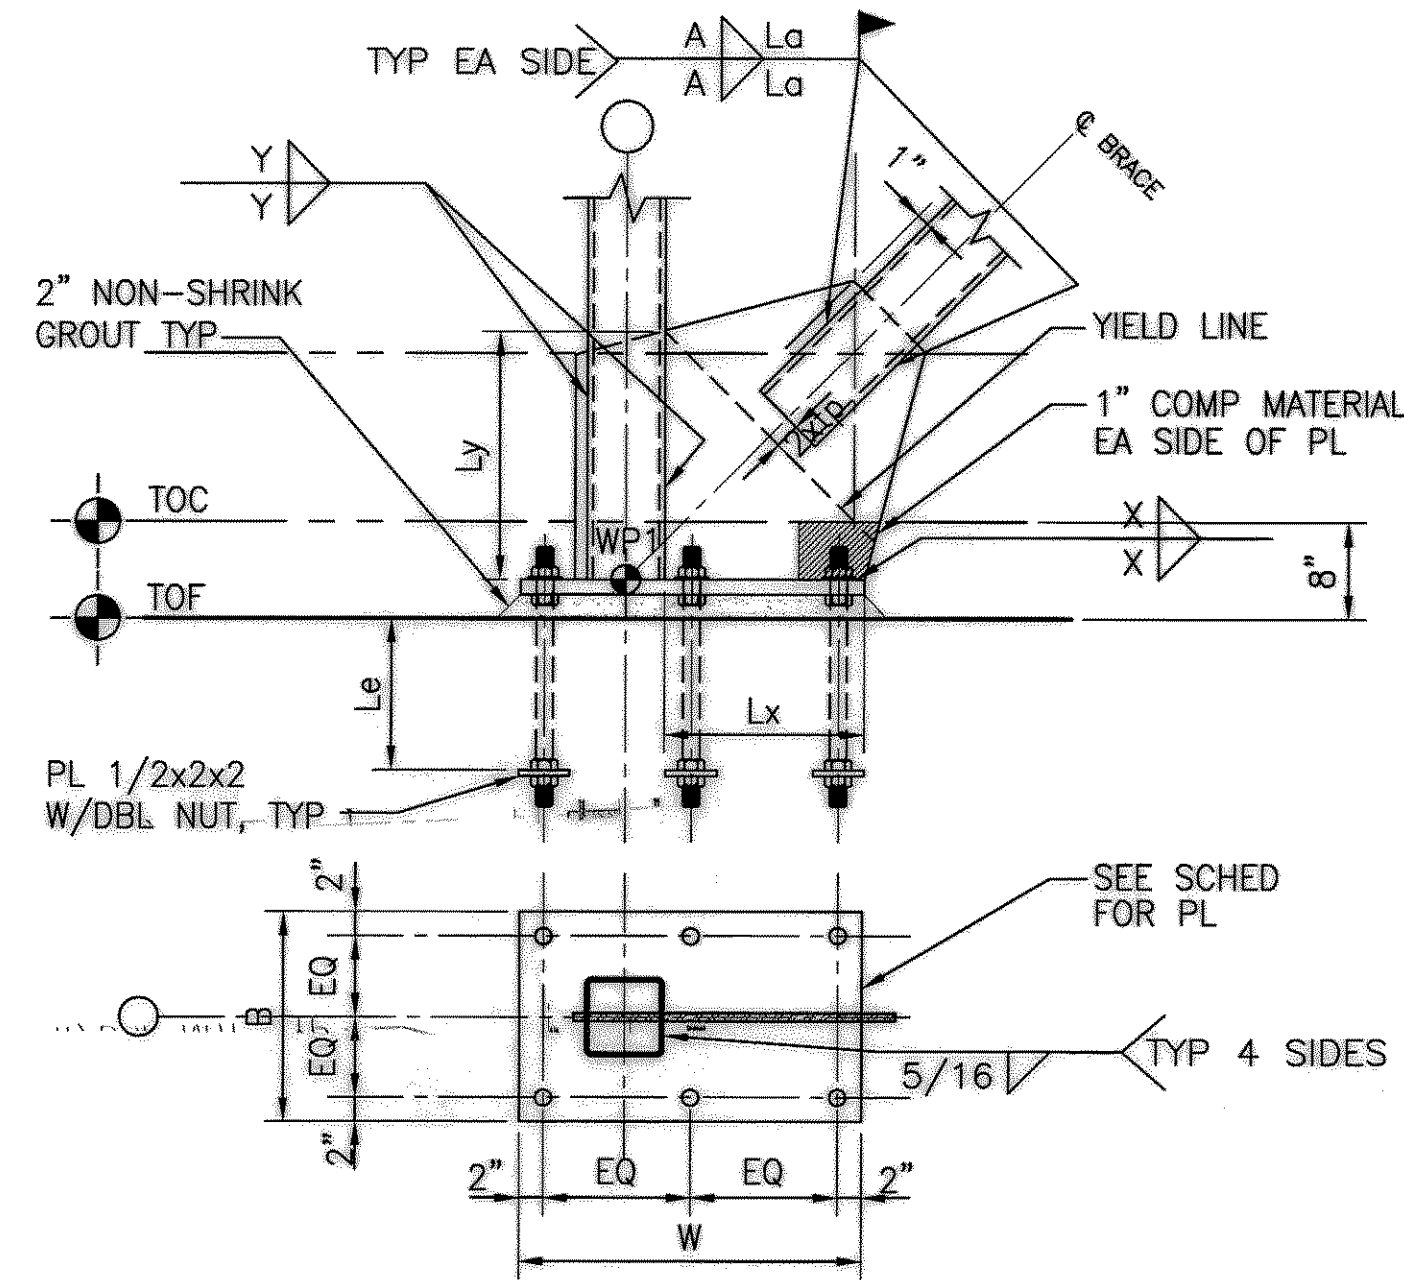


CONNECTION SCHEDULE									
CONN TYPE	GUSSET PL THK	WELD SIZE(X)	Lx	WELD SIZE(Y)	Ly	WELD SIZE(A)	Lx	BASE PL (BxWxt)	ANCHOR BOLTS (No-ØxEMB)
A1	5/8"	5/16"	1'-5"	5/16"	1'-10"	5/16"	12"	1"x1'-0"x2'-2"	(6) 1"x1'-2"
A2	5/8"	5/16"	2'-1"	5/16"	1'-8"	5/16"	12"	1"x1'-0"x2'-10"	(6) 1"x1'-2"
A3	5/8"	5/16"	0'-10"	5/16"	2'-4"	5/16"	12"	1"x1'-0"x1'-7"	(6) 1"x1'-2"
A4	5/8"	5/16"	1'-3"	5/16"	2'-0"	5/16"	12"	1"x1'-0"x2'-0"	(6) 1"x1'-2"

1 GUSSET PLATE DETAIL
SCALE: 3/4" = 1'-0"

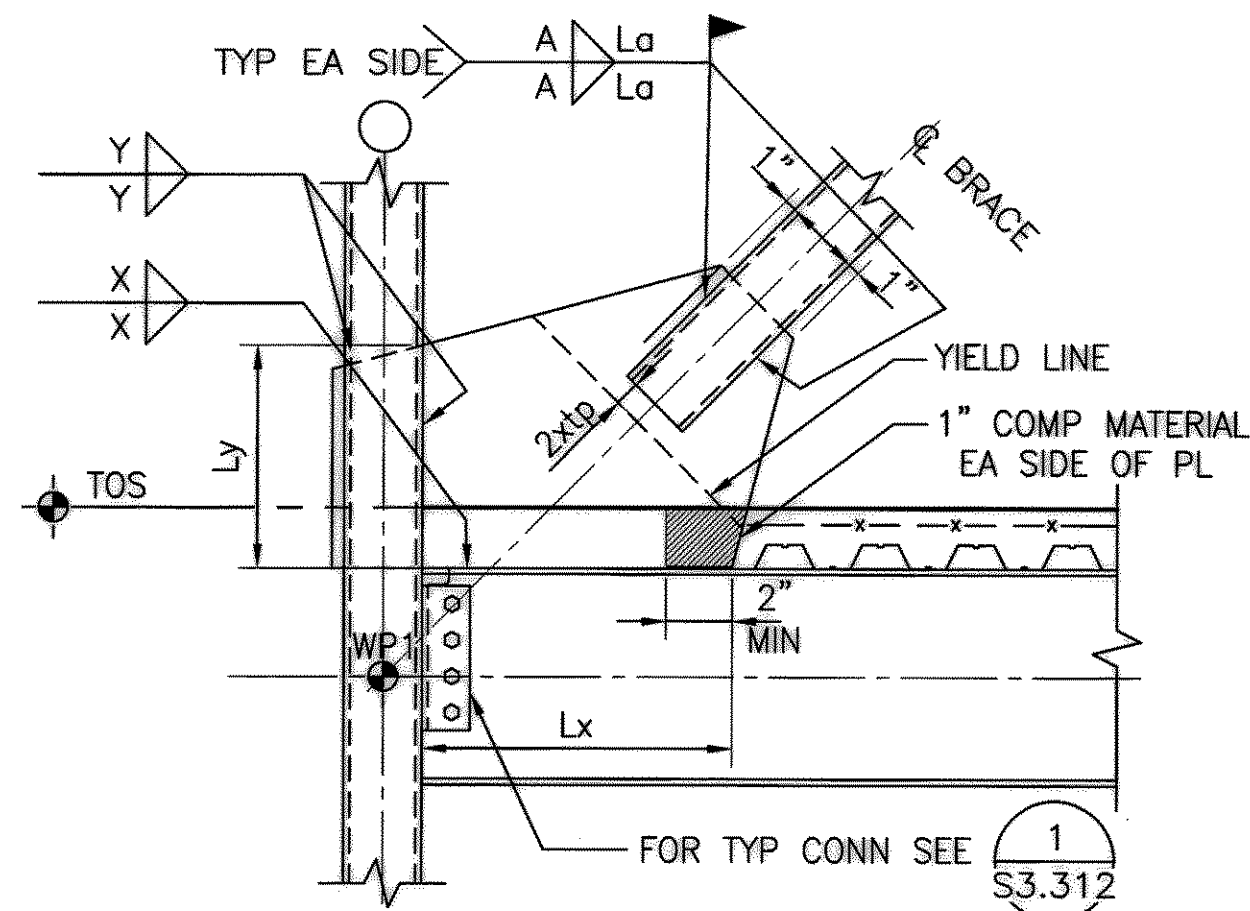


CONNECTION SCHEDULE									
CONN TYPE	GUSSET PL THK	WELD SIZE(X)	Lx	WELD SIZE(Y)	Ly	WELD SIZE(A)	Lx	BASE PL (BxWxt)	ANCHOR BOLTS (No-ØxEMB)
C1	5/8"	1/4"	3'-2"	1/4"	1'-0"	5/16"	12"		
C2	5/8"	5/16"	1'-4"	5/16"	2'-0"	5/16"	12"		
C3	5/8"	5/16"	1'-6"	5/16"	1'-4"	5/16"	12"		

2 GUSSET PLATE DETAIL
SCALE: 3/4" = 1'-0"

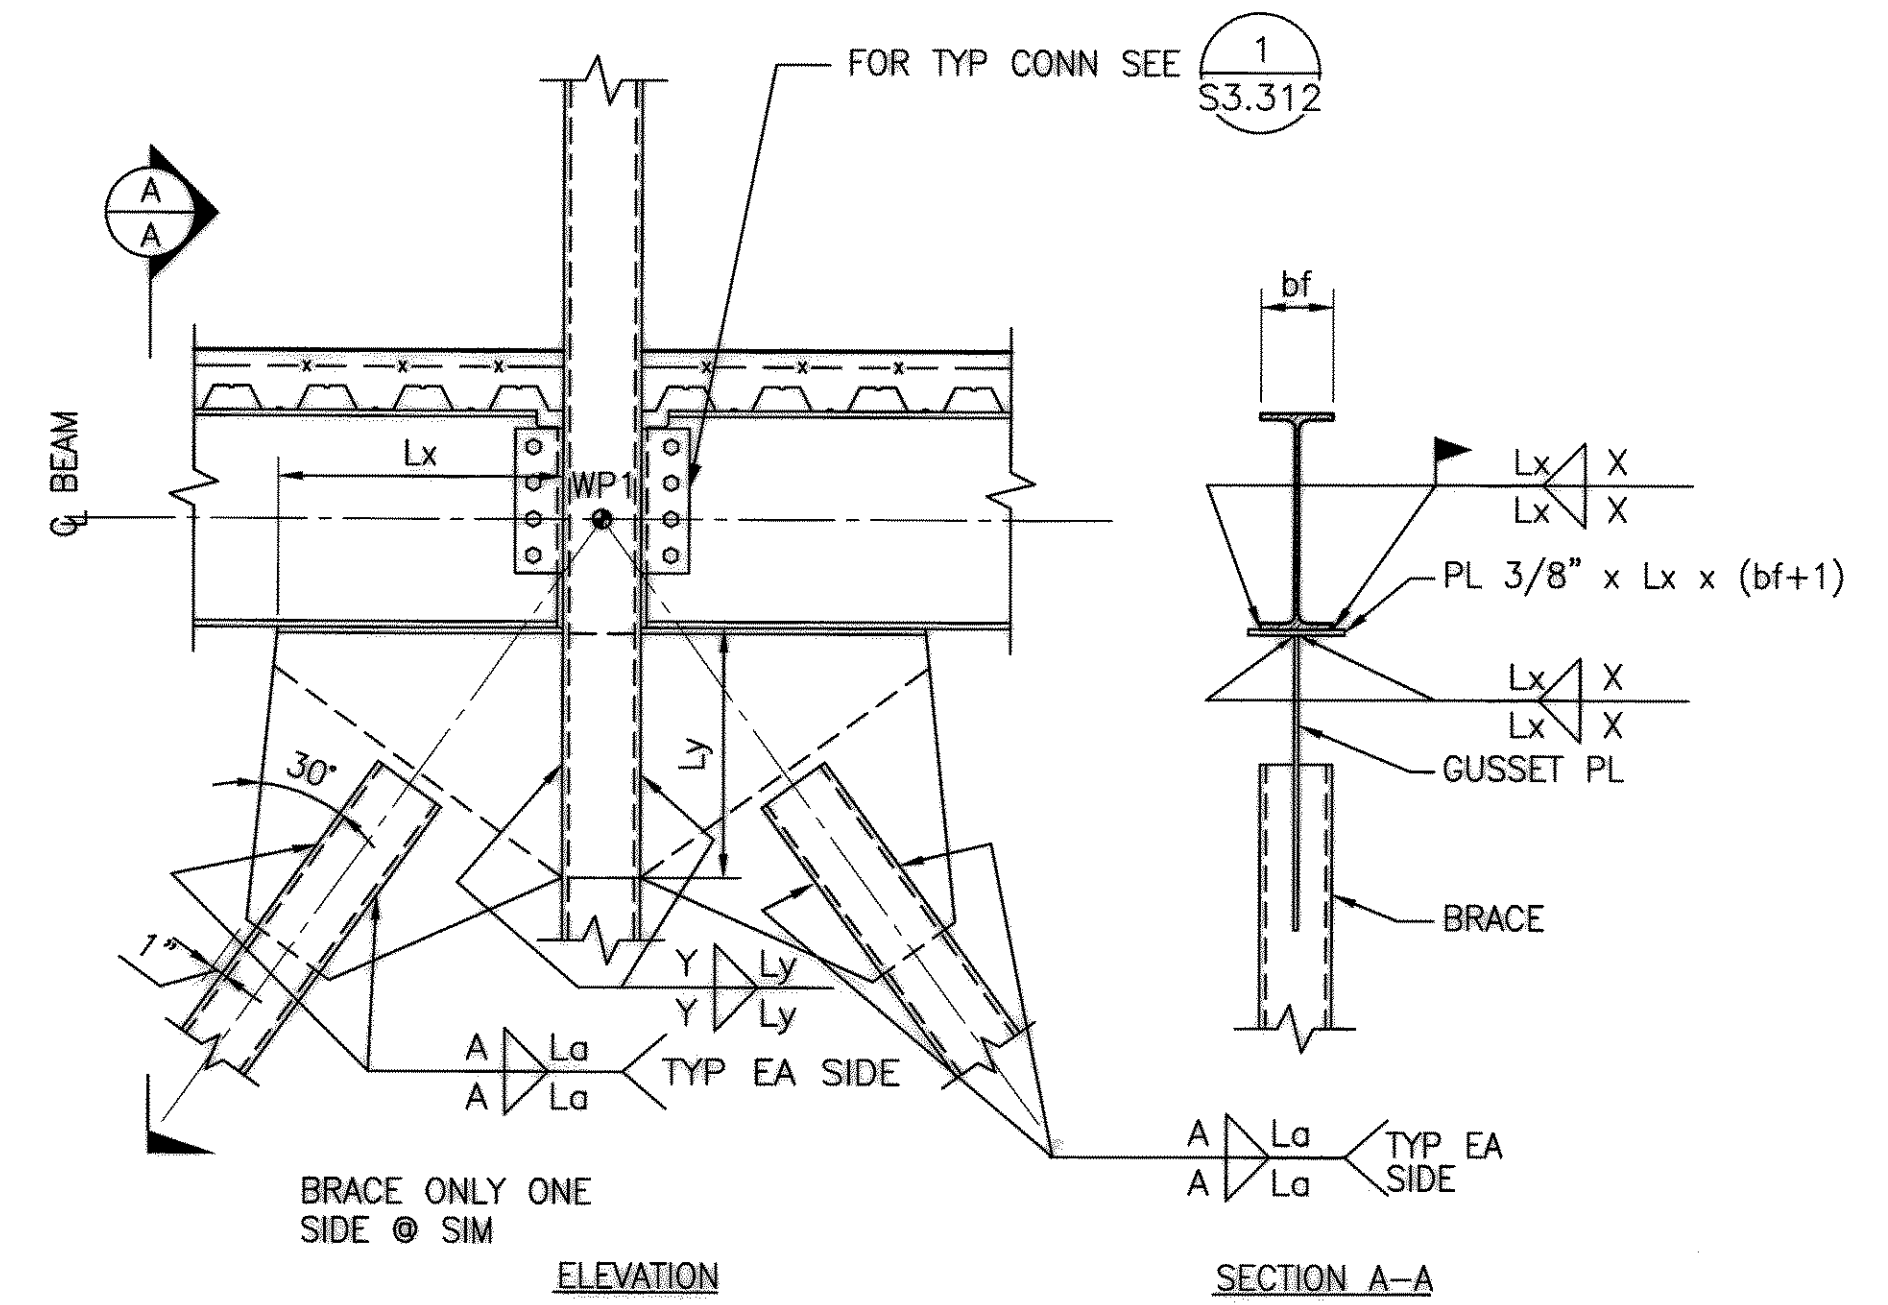


CONNECTION SCHEDULE									
CONN TYPE	GUSSET PL THK	WELD SIZE(X)	Lx	WELD SIZE(Y)	Ly	WELD SIZE(A)	Lx	BASE PL (BxWxt)	ANCHOR BOLTS (No-ØxEMB)
B1	5/8"	5/16"	2'-1"	5/16"	1'-3"	5/16"	12"		
B2	5/8"	1/4"	3'-2"	1/4"	1'-0"	5/16"	12"		
B3	5/8"	5/16"	1'-2"	5/16"	2'-0"	5/16"	12"		
B4	5/8"	5/16"	1'-6"	5/16"	1'-4"	5/16"	12"		

3 GUSSET PLATE DETAIL
SCALE: 3/4" = 1'-0"

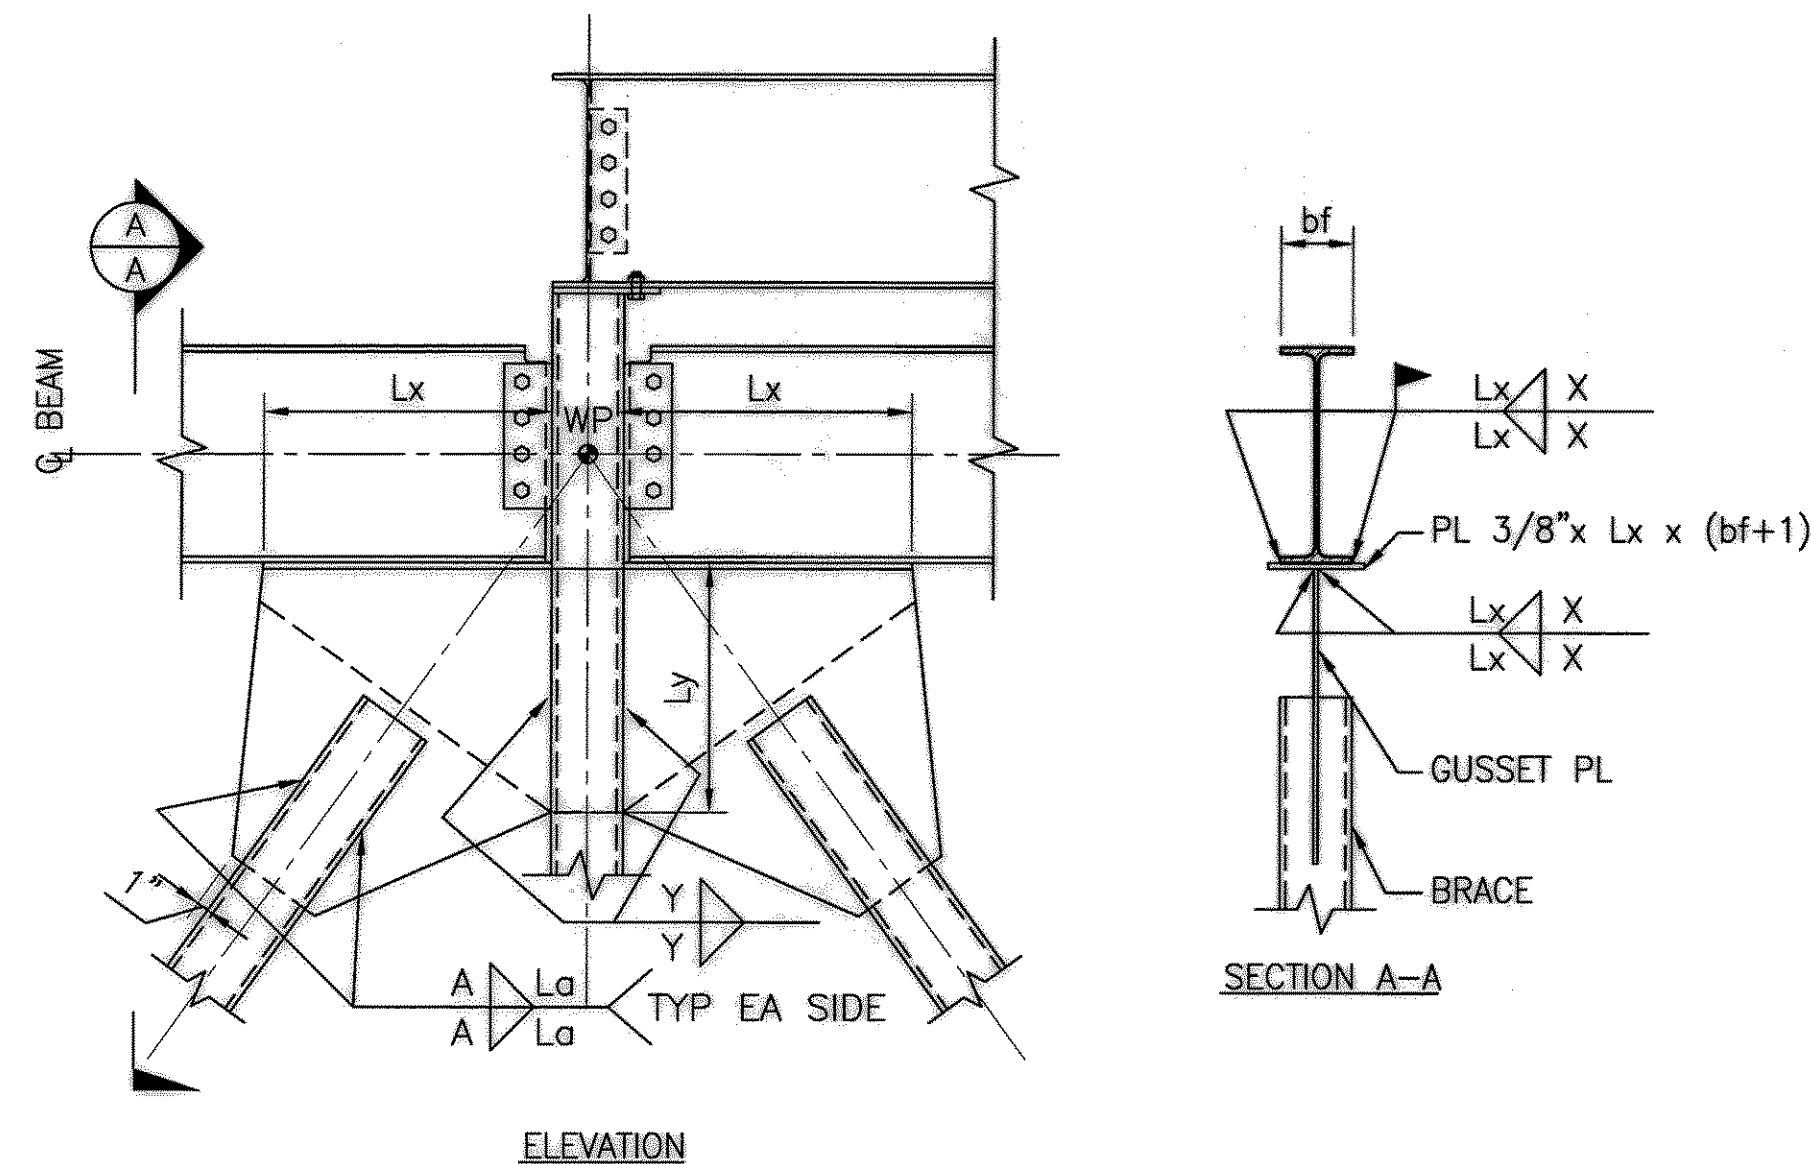


CONNECTION SCHEDULE							
CONN TYPE	GUSSET PL THK	WELD SIZE(X)	Lx	WELD SIZE(Y)	Ly	WELD SIZE(A)	Lx
D	5/8"	5/16"	1'-5"	5/16"	2'-0"	5/16"	12"

4 GUSSET PLATE DETAIL
SCALE: 3/4" = 1'-0"

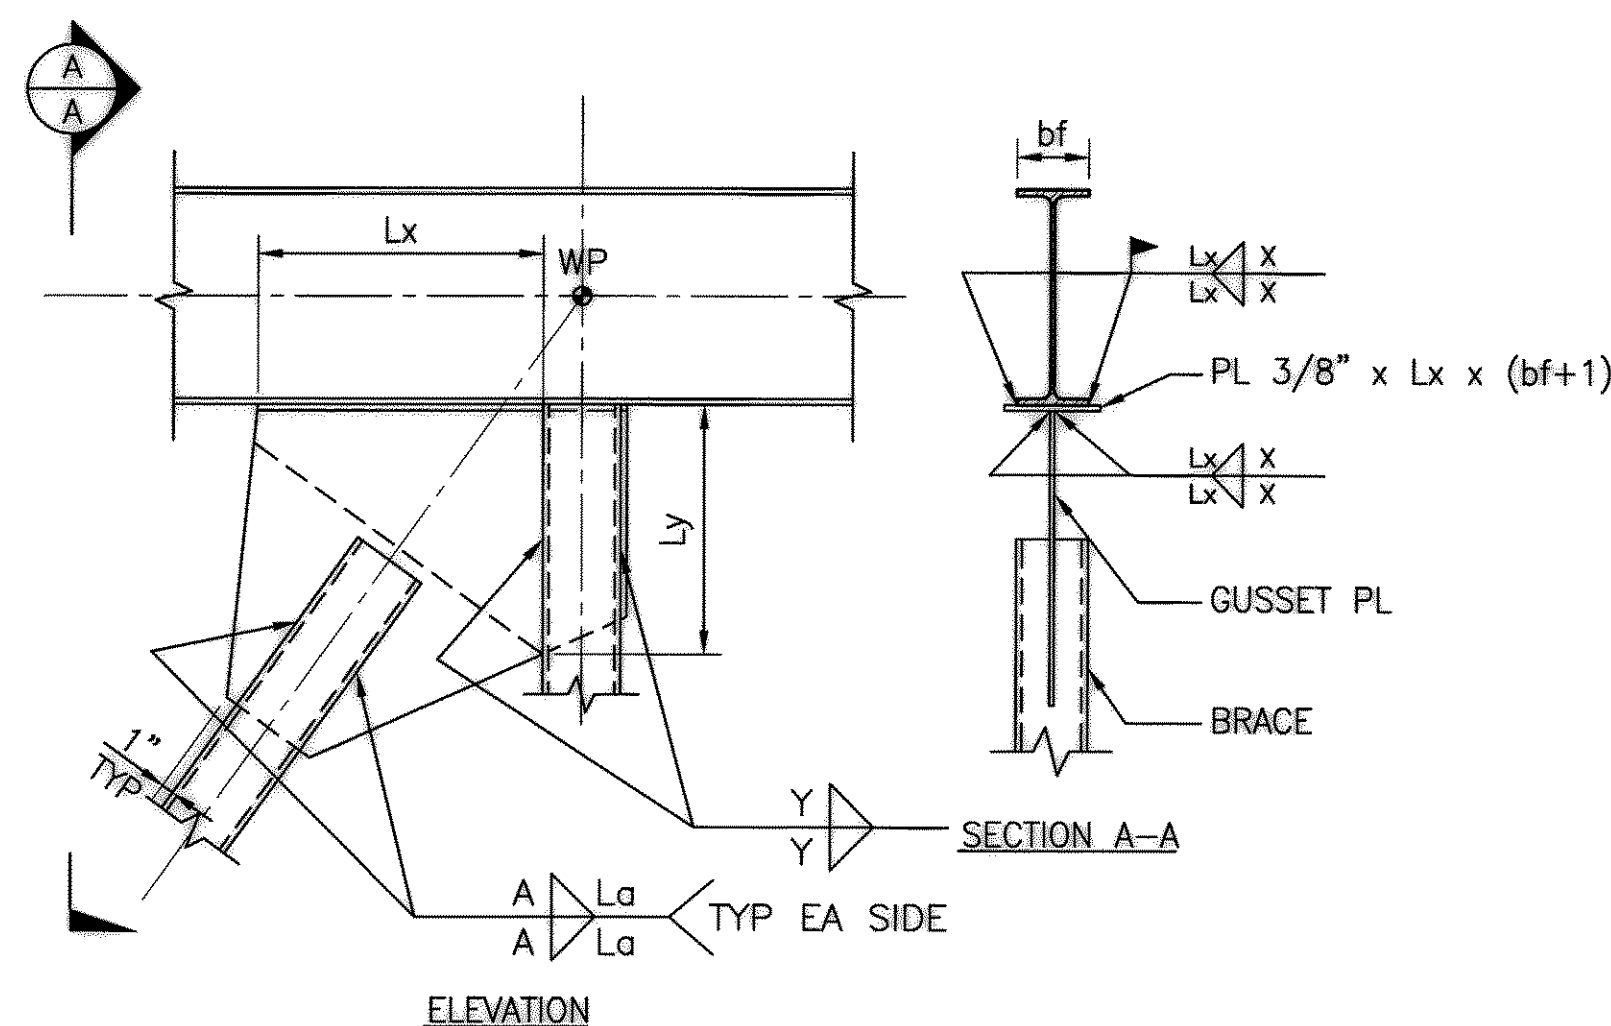

CONNECTION SCHEDULE							
CONN TYPE	GUSSET PL THK	WELD SIZE(X)	Lx	WELD SIZE(Y)	Ly	WELD SIZE(A)	Lx
E1	5/8"	1/4"	3'-2"	1/4"	1'-0"	5/16"	12"
E2	5/8"	5/16"	1'-10"	5/16"	1'-2"	5/16"	12"

5 GUSSET PLATE DETAIL
SCALE: 3/4" = 1'-0"

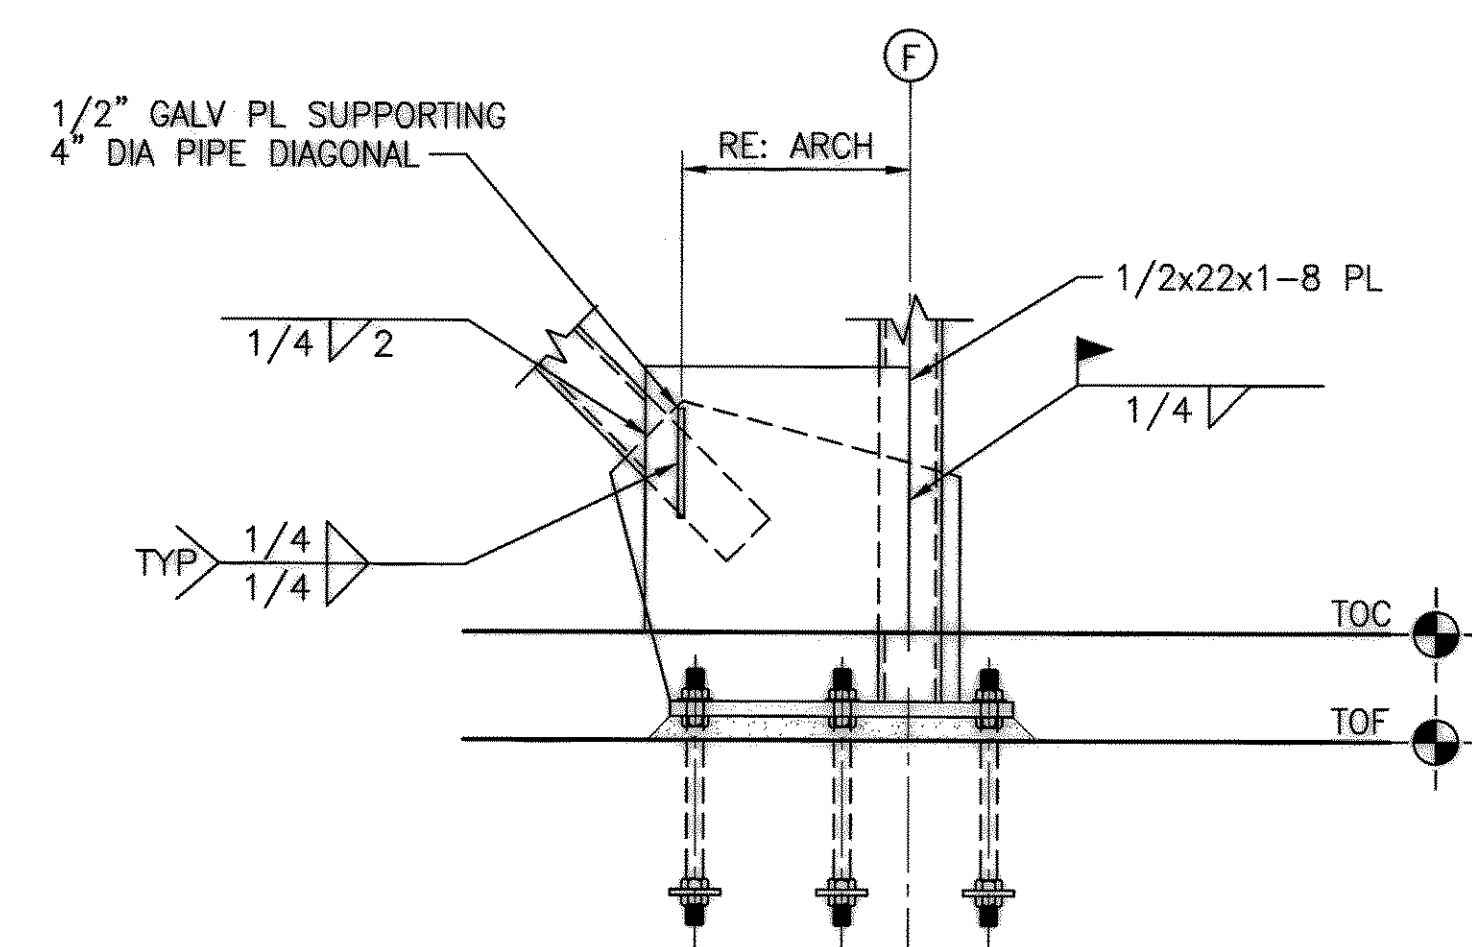

6 GUSSET PLATE DETAIL
SCALE: 3/4" = 1'-0"


BERGER/ABAM
ENGINEERS INC.
33301 9TH AVENUE SOUTH
FEDERAL WAY, WASHINGTON
98003-2600
VOICE: (206)431-2300
FAX: (206)431-2250

PORT OF TACOMA
TACOMA, WA 98401 253-883-5841
P.O. BOX 1837
6021 12th Street East
Suite 201
Tacoma, WA 98424
Tel: 253.922.9037
Fax: 253.922.6499

APPROVED: RNZ 08/22/03
CHECKED BY: LY 08/22/03
PROJECT ENGR: DATE
SENIOR DIRECTOR OF FACILITY DEVELOPMENT
DRAWING DATE: 12/20/04
PORT ADDRESS: PORT PARCEL:


PORT OF TACOMA
PIERCE COUNTY TERMINAL
MARINE BUILDING
FRAMING DETAILS AND SCHEDULES
TOWNSHIP: RANGE: SECTION:
DATE: HORIZ: VERT:
DRAWING SCALE:

EP00047
6221-17
S3.311
SHEET 72 OF 230
CONTRACT NUMBER: 99074
E NUMBER: E1374
PHASE: RECORD DRAWINGS

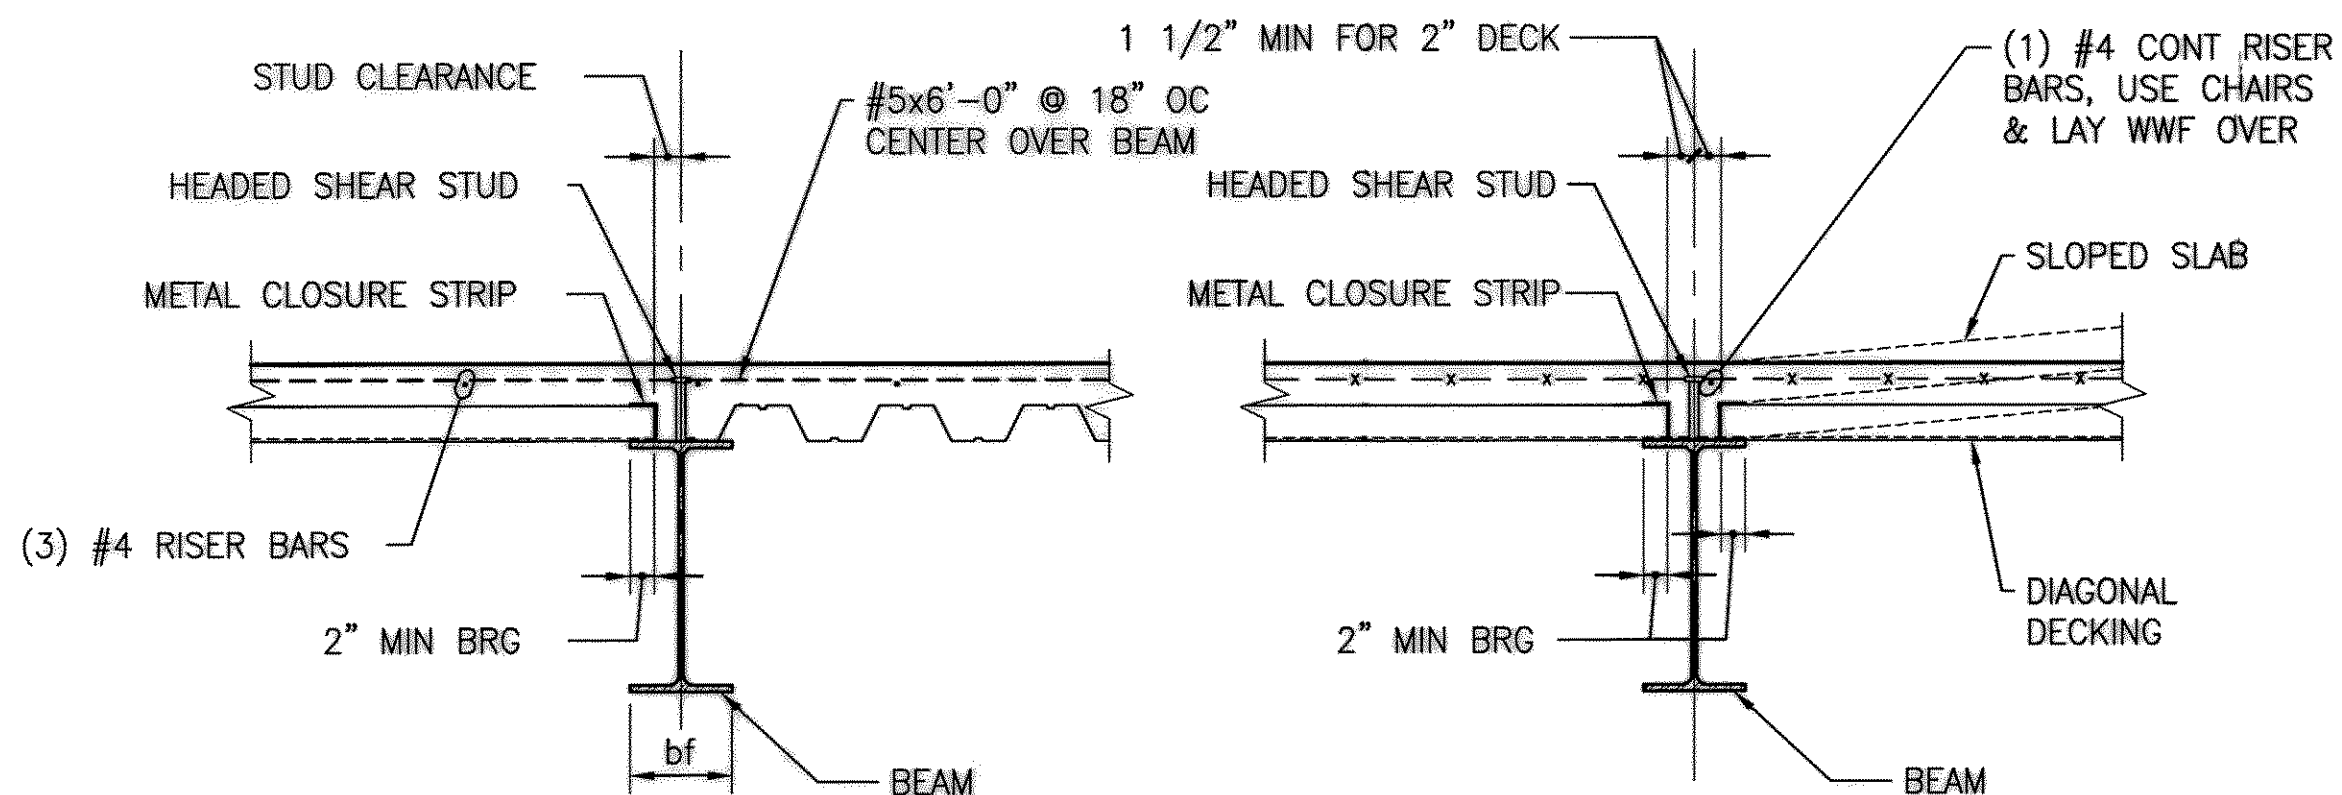

NOTE:
FOR CONTINUOUS METAL CLOSURE STRIPS-MINIMUM BEAM WIDTH bf = 7" FOR 2" DECK. FOR NARROWER BEAMS USE INDIVIDUAL CLOSURES AT EACH HIGH DECK FLUTE. 2" MINIMUM BEARING CONTROLS.


1
S3.321
DETAIL
SCALE: 3/4"=1'-0"

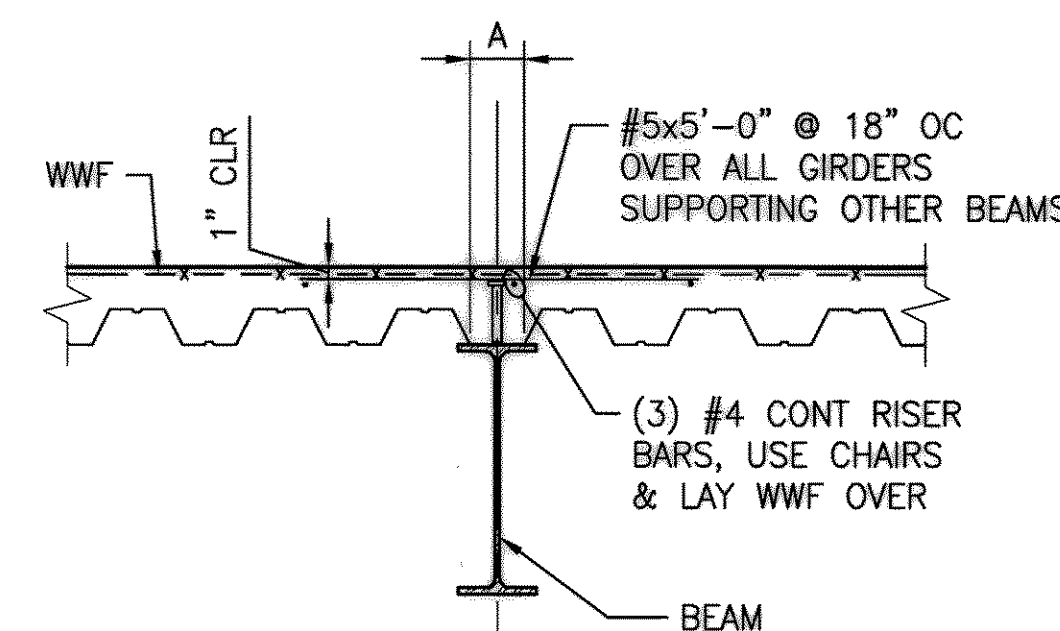

NOTE:
DECK RIB VALLEY TO BE CENTERED OVER BEAM WHERE POSSIBLE OR DECK MUST BE SPLIT FULL LENGTH OF BEAM TO PROVIDE CONC HAUNCH WITH MIN WIDTH A = 3" FOR 2" DECK


TYPICAL COMPOSITE BEAM OR GIRDER
PARALLEL TO COMPOSITE SLAB

2
S3.321
DETAIL
SCALE: 3/4"=1'-0"

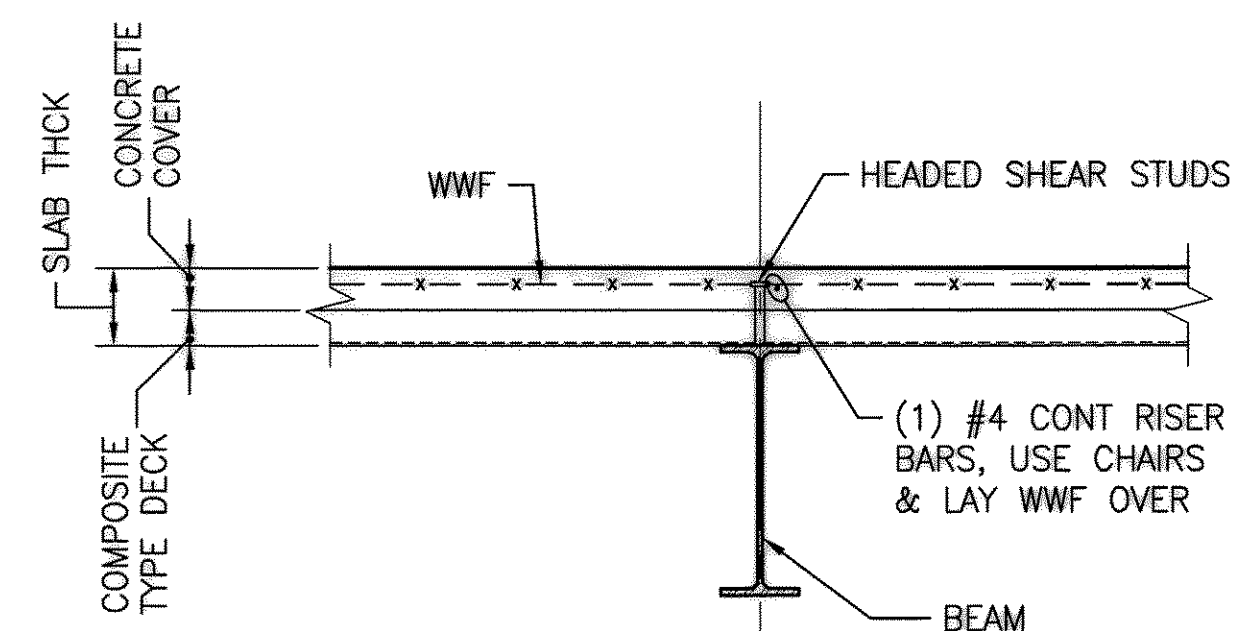


TYPICAL COMPOSITE BEAM PERPENDICULAR
TO COMPOSITE SLAB


3
S3.321
DETAIL
SCALE: 3/4"=1'-0"

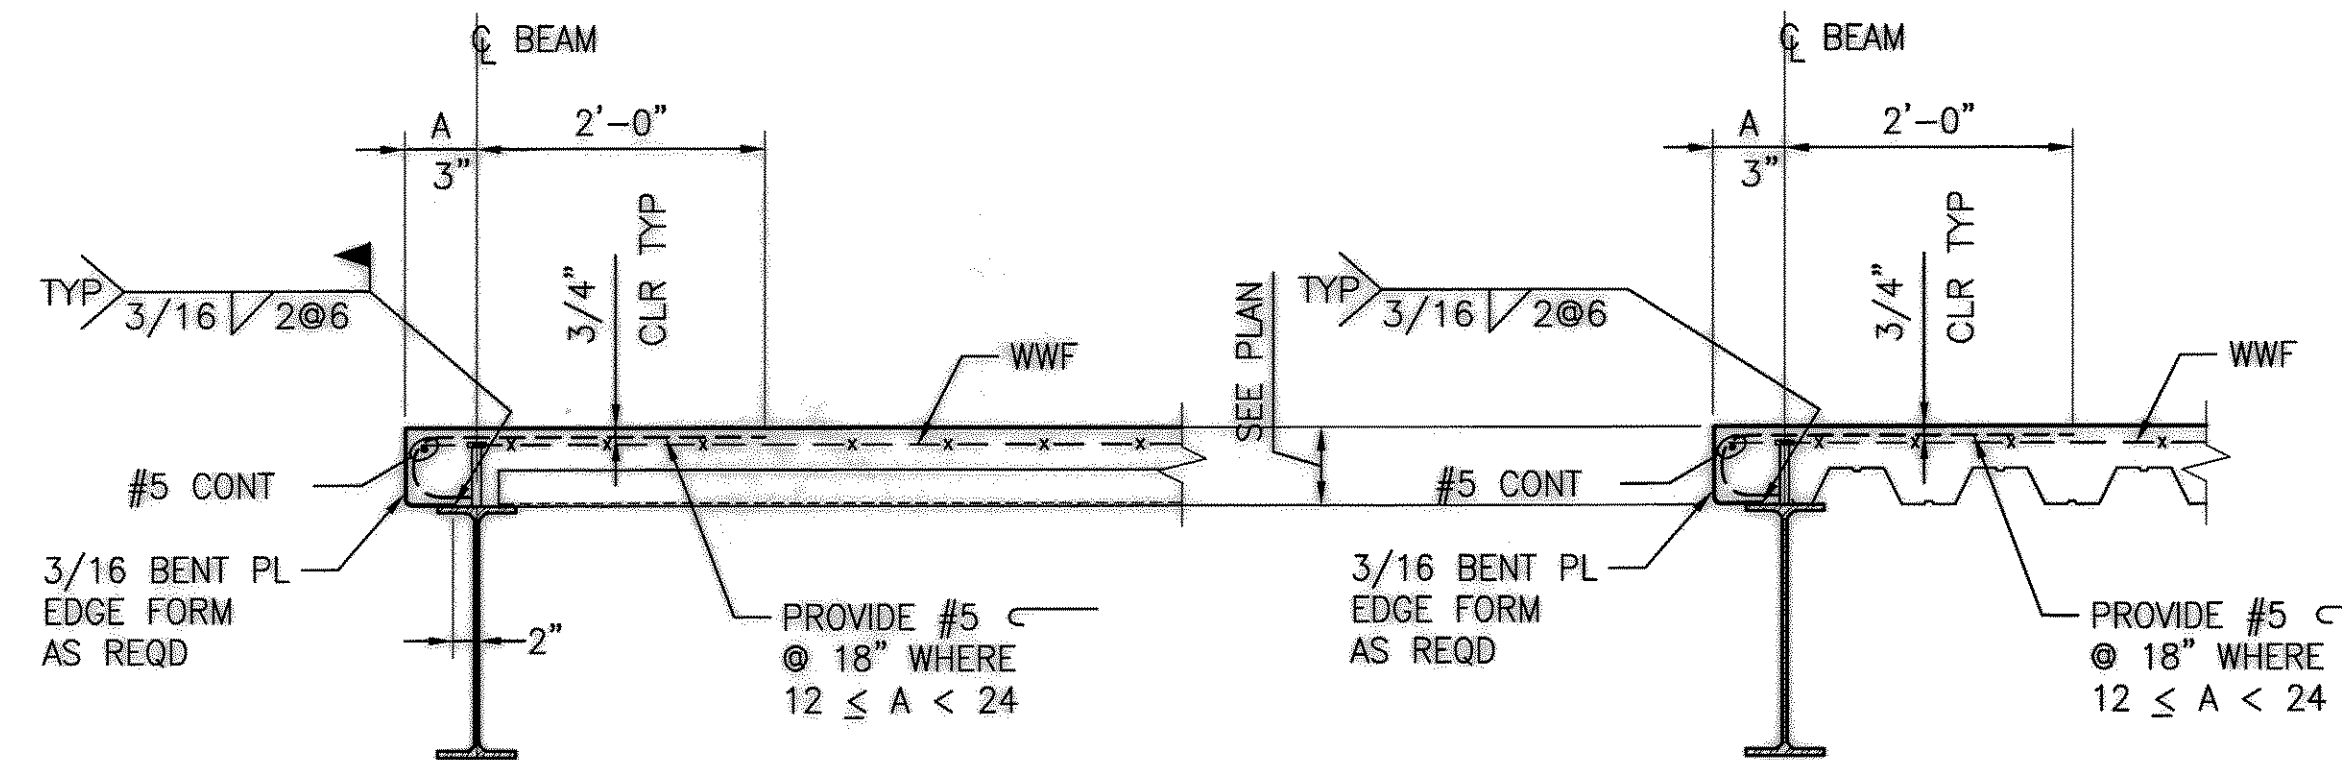

4
S3.321
TYP SLAB EDGE @ OPENING
SCALE: 3/4"=1'-0"

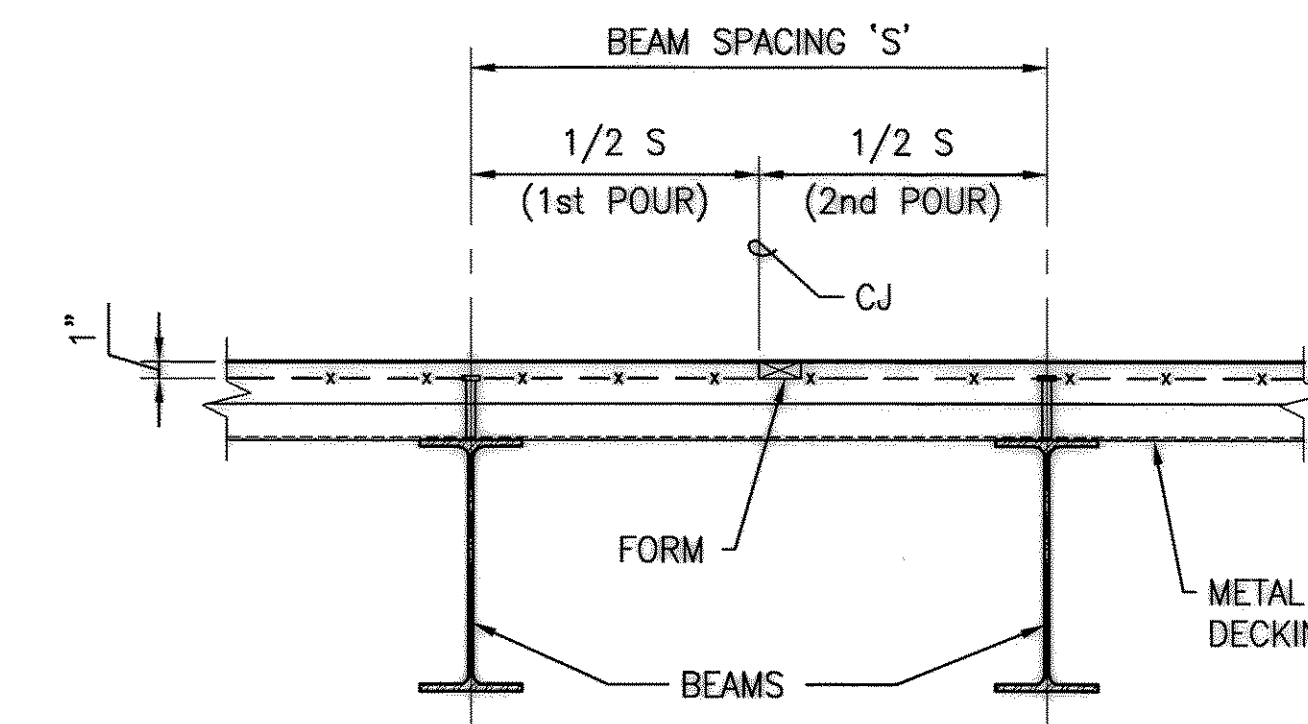


5
S3.321
JOINT PERPENDICULAR TO DECK
SCALE: 3/4"=1'-0"

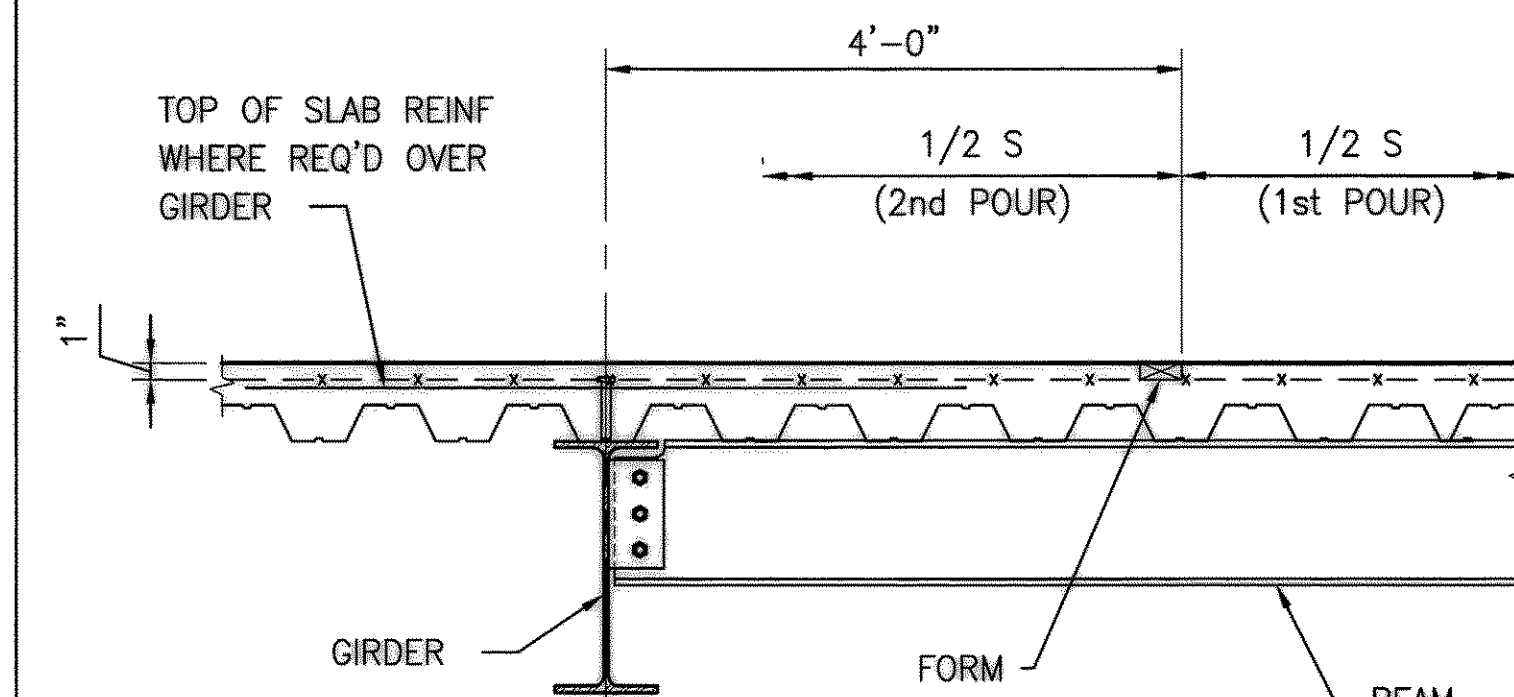


TYPICAL CONSTRUCTION JOINT FOR SLAB
ON METAL DECK W/COMPOSITE BEAMS

6
S3.321
DETAIL
SCALE: 3/4"=1'-0"

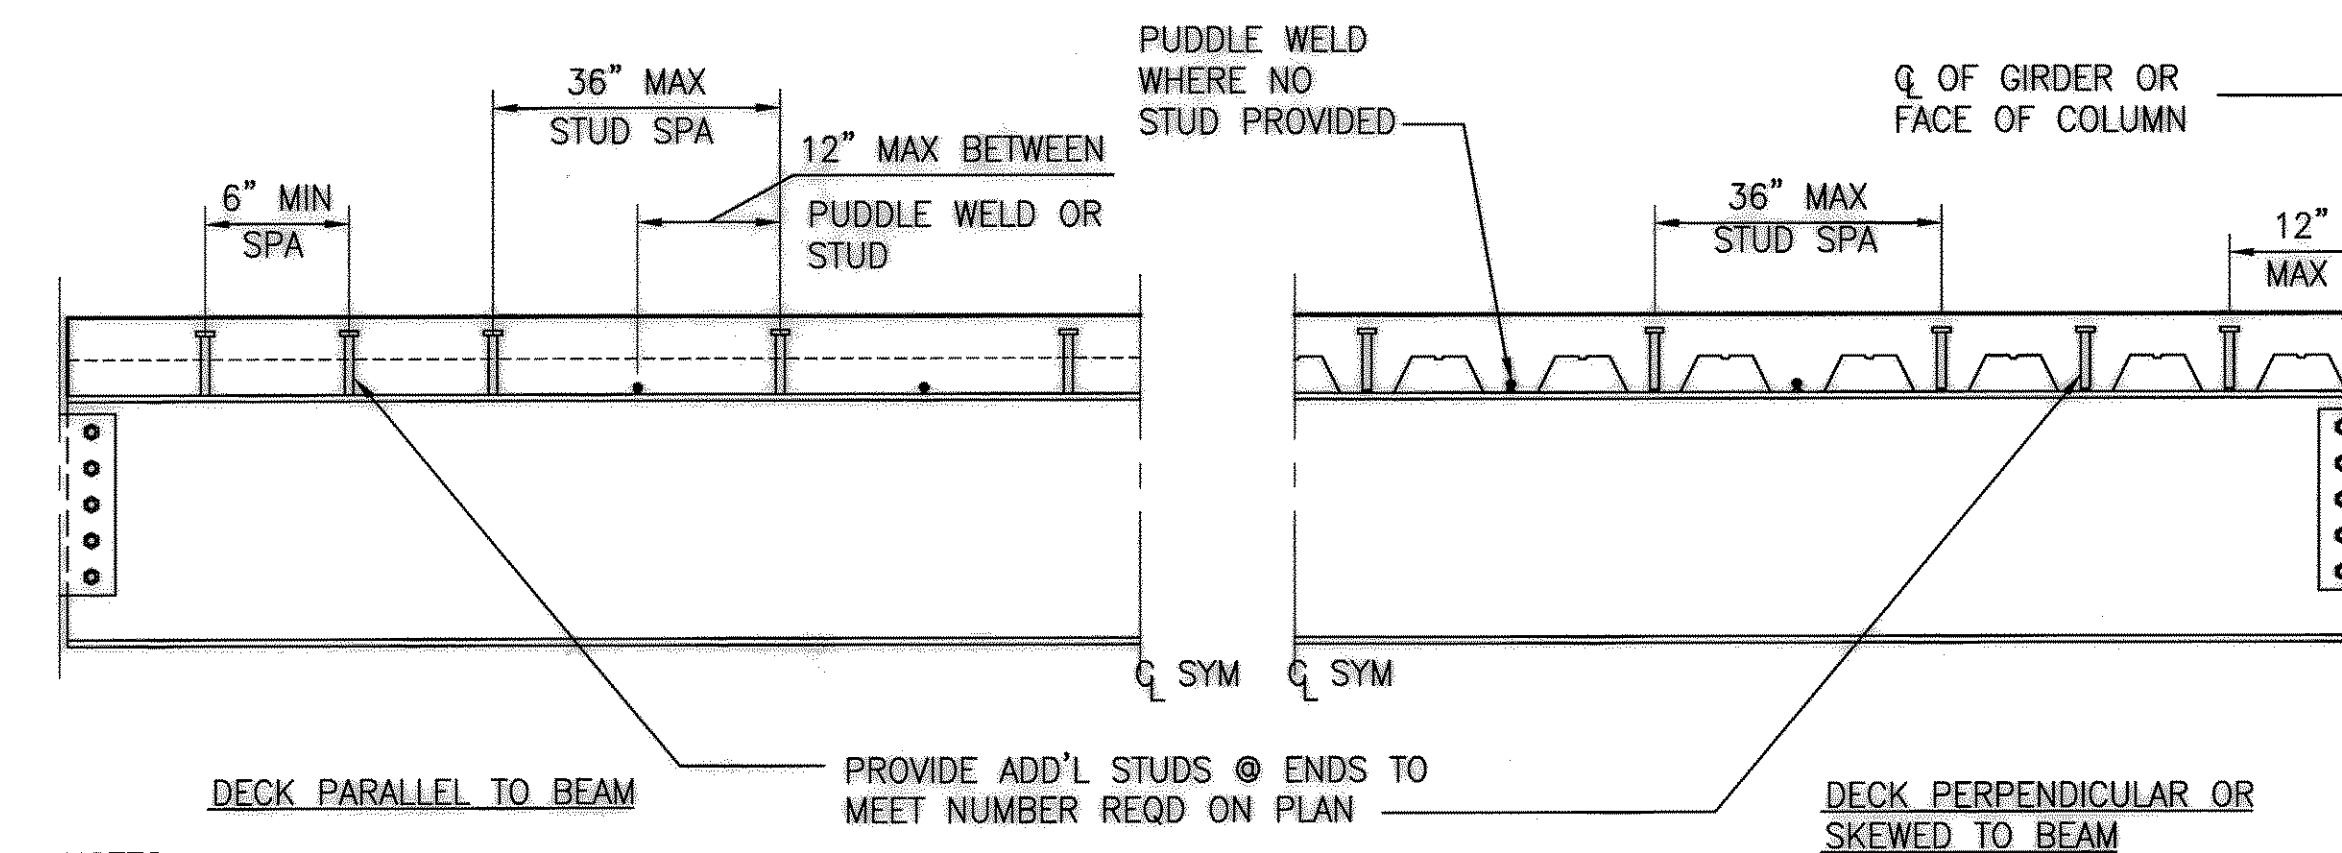


NOTES
1. HEADED SHEAR STUDS TO BE 3/4" x 4 1/2" LONG AFTER WELDING.
2. THE MINIMUM NUMBER OF STUDS REQUIRED IS SHOWN AS (X) ON FRAMING PLANS. NO STUDS ARE REQUIRED WHERE (0) APPEARS OR WHERE NO DESIGNATION IS GIVEN. ADDITIONAL STUDS MAY BE REQUIRED TO MEET THE ABOVE MAXIMUM SPACING REQUIREMENTS.
3. IF TWO STUDS ARE REQUIRED IN ONE FLUTE THE TRANSVERSE SPACING SHALL BE 3" MINIMUM.

7
S3.321
TYP COMPOSITE BEAM DETAIL
SCALE: 3/4"=1'-0"

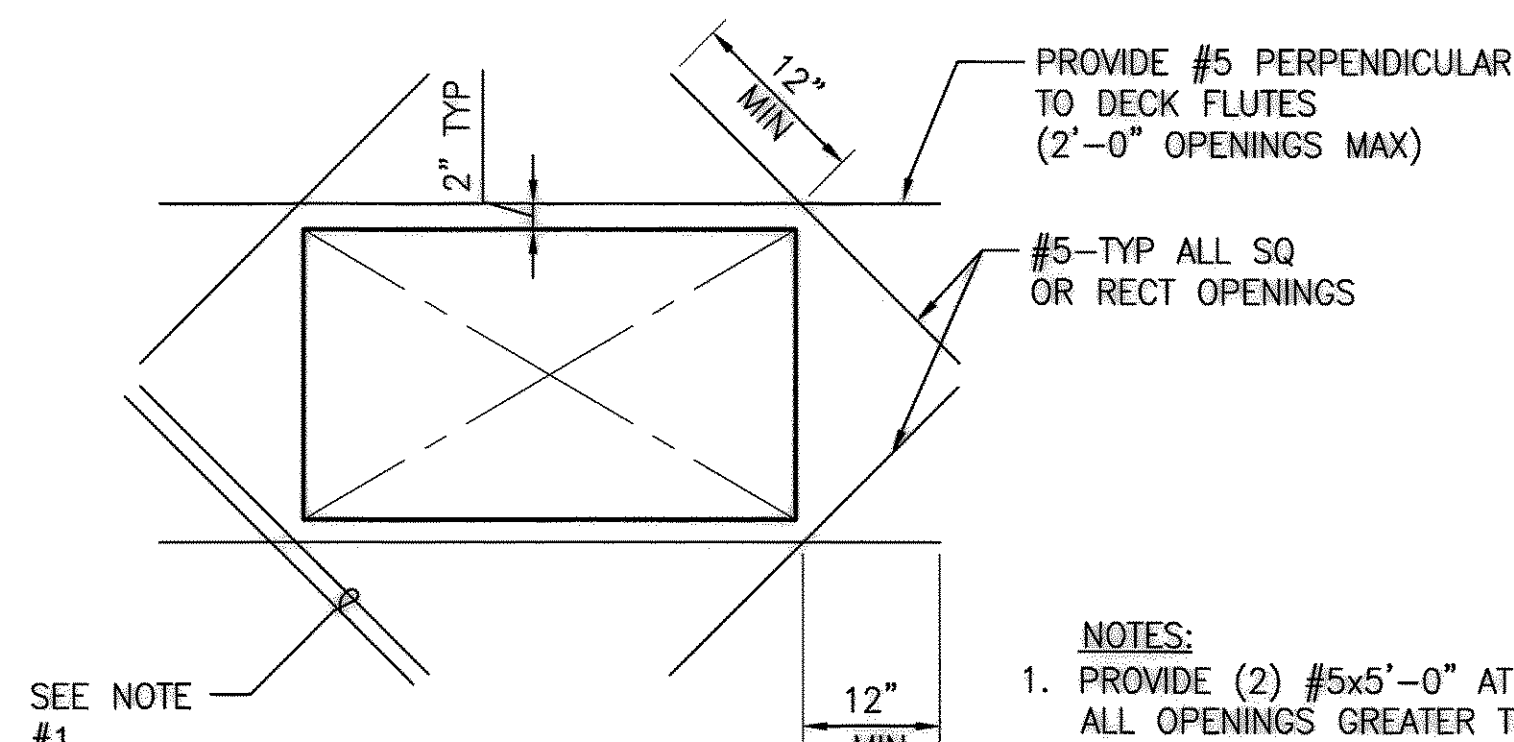

NOTES:
1. PROVIDE (2) #5x5'-0" AT ALL OPENINGS GREATER THAN 6'-0" SUCH AS ELEVATOR, STAIR, AND AIR SHAFT OPENINGS.
2. ALL OPENINGS NOT SHOWN ON THE DWGS MAY REQUIRE PERIMETER SUPPORT AND SHALL BE APPROVED BY THE ENGINEER.

8
S3.321
DETAIL
SCALE: 3/4"=1'-0"

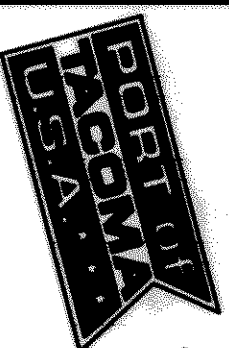

PORT OF TACOMA P.O. BOX 1897
TACOMA, WA 98401 263-983-6841
6021 12th street east
suite 201
tacoma, wa 98424
tel: 253-922-9037
fax: 253-922-6499

DATE:	REVISION:
BY:	APPROVED:
FOR:	RECORD DRAWINGS:

ELECTRIC WALL HEATER									
UNIT NO	MFR.	MODEL	LOCATION	INTERLOCK	ELECTRICAL			DISCONNECT FURN. BY	REMARKS
					WATT	VOLTS	Ø		
EW-3A	KING	W2415	UTILITY 105	T*STAT	1125	208	1	EC	①②

NOTES FOR ELECTRIC WALL HEATER SCHEDULE:

- ① PROVIDE WITH 2-POLE THERMOSTAT KIT.
② PROVIDE W/SURFACE MOUNT KIT.

ELECTRICAL WATER HEATER SCHEDULE												
UNIT NO	MFR.	MODEL	LOCATION	TANK SIZE (GAL)	WATTS	RECOVERY (GPH) @ 80° F RISE	WET WEIGHT (LB)	ELECTRICAL VOLTS	STARTER FURN. BY	DISCONNECT FURN. BY	REMARKS	
HWT-3A	ELSF-40	A.O. SMITH	1ST FL MENS	40	6000	31	540	208	3	N/A	EC	①②③

NOTES FOR WATER HEATER SCHEDULE

- ① SINGLE POINT POWER CONNECTION. PROVIDE ALL POWER TRANSFORMERS AS NECESSARY. ③ MC TO PROVIDE AND INSTALL AQUASTAT. EC TO PROVIDE ELECTRICAL CONNECTION.
② SET TEMPERATURE AT 110° F.

INDOOR UNIT SPLIT SYSTEM SCHEDULE																			
UNIT NO	MFR.	MODEL	LOCATION	AREA SERVED	BLOWER				AUX. ELEC. HEAT KW	WEIGHT (lbs)	ELECTRICAL				STARTER FURN. BY	DISCONNECT FURN. BY	DUCT SMOKE DETECTOR FURN. BY	REMARKS	
					CFM	ECONOMIZER	MIN. OSA	EXT. RPM SP. (SPD)			HP	② MCA	MOP	VOLTS					Ø
HP-3A	TRANE	TWE090A3	WOMENS	1ST FLR	2700	100%	1360	0.75	730	1.5	34.88	315	112	125	208	3	MFR	EC	MC ③ ①②
HP-3B	TRANE	TWE048A	COPY FAX	2ND FLR NORTH	1200	100%	250	0.80	(MED)	½	10.56	150	36	40	208	3	MFR	EC	N/A ①②
HP-3C	TRANE	TWE036A	CORRIDOR	2ND FLR SOUTH	900	100%	315	0.80	(MED)	½	10.56	125	34	40	208	3	MFR	EC	N/A ①②

NOTES FOR INDOOR UNIT SPLIT SYSTEM SCHEDULE.

- ① PROVIDE UNIT WITH A SINGLE POINT POWER CONNECTION. PROVIDE ALL POWER TRANSFORMERS AS NECESSARY.
② INCLUDES AUXILIARY ELECTRIC HEATER
③ DETECTOR, REMOTE STATION & CONTROL WIRING FOR FAN SHUTDOWN BY CONTROLS CONTRACTOR.

EXHAUST FAN SCHEDULE																	
UNIT NO	MFR.	MODEL	LOCATION	CONFIGURATION	AREA SERVED	PERFORMANCE			BACKDRAFT DAMPER	SPEED CONTROL	CONTROLLED BY OR INTERLOCKED WITH	HP (WATTS)	ELECTRICAL	STARTER FURN. BY	DISCONNECT FURN. BY	REMARKS	
						CFM	EX.	S.P.					RPM				VOLTS
EF-3A	PENN	Z102STDA	WOMENS	INLINE	MENS/WOMENS RESTROOM	595	0.31	1050	NO	YES	HP-3A	(273)	120	1	EC	EC	①②③
EF-3B	PENN	Z8HTDA	BREAK ROOM	INLINE	BREAK ROOM	340	0.30	1550	NO	YES	HP-3A	(132)	120	1	EC	EC	①②③
EF-3C	PENN	Z81STDA	2ND MENS	INLINE	MENS/WOMENS/BREAK ROOM	220	0.30	1050	NO	YES	HP-3B	(84)	120	1	EC	EC	①②③
EF-3D	PENN	Z8STDA	BREAK 206	INLINE	BREAK ROOM 206	130	0.27	1050	NO	YES	HP-3C	(75)	120	1	EC	EC	①②③

NOTES FOR EXHAUST FAN SCHEDULE

- ① ALL EXHAUST FANS TO BE WIRED FROM MOTOR TO BOX ON EXTERIOR OF FAN ENCLOSURE.
② SPEED CONTROL TO BE FACTORY WIRED TO THE OUTSIDE CABINET OF INLINE FANS.
③ EC TO PROVIDE A MANUAL STARTER (INCLUDING DISCONNECT). MC TO PROVIDE AND INSTALL A MOTOR RATED RELAY FOR CONTROLS INTERLOCK.

OUTDOOR UNIT SPLIT SYSTEM SCHEDULE																
UNIT NO	MFR.	MODEL	LOCATION	EER (SEER)	COOLING ①		HEATING ②		WEIGHT (LBS)	ELECTRICAL				STARTER FURN. BY	DISCONNECT FURN. BY	REMARKS
					TOTAL MBH	SENS. @80°F	MBH	COP (HSPF)		MCA	MOP	VOLTS	Ø			
CU-3A	TRANE	TWA090A3	SOUTH PERIMETER	10.3	88.8	62.8	53.7	3.0	343	37.1	60	208	3	MFR	EC	③
CU-3B	TRANE	TWA048C3	SOUTH PERIMETER	(10.05)	46.5	32.0	42.0	2.9	239	25	30	208	3	MFR	EC	③
CU-3C	TRANE	TWA036C3	SOUTH PERIMETER	(10.35)	35.2	23.8	32.6	2.9	198	25	30	208	3	MFR	EC	③


NOTES FOR OUTDOOR UNIT SPLIT SYSTEM SCHEDULE.

- ① COOLING CAPACITY MBH @ 95°F. O.D.D.B. & 67°F. W.B., 80°F. D.B. INDOOR
② HEATING CAPACITY MBH @ 17°F. E.A.T., 70°F. INDOOR
③ PROVIDE SINGLE POINT POWER CONNECTION. PROVIDE POWER TRANSFORMERS AS NECESSARY.


PUMPS SCHEDULE													
UNIT NO	MFR.	MODEL	LOCATION	MOTOR		HEAD (FT)	FLOW (GPM)	ELECTRICAL			STARTER FURN. BY	DISCONNECT FURN. BY	REMARKS
				HP	RPM			MCA	MOP	VOLTS Ø			
CP-3A	ARMSTRONG	ARMFLO E10B	MEN	1/6	-	2.1	-	1.62	-	115	1	②	② ①

NOTES FOR CIRCULATION PUMP SCHEDULE

- ① E.C. TO CONNECT AQUASTAT. AQUASTAT SET POINT IS 100°F
② EC TO PROVIDE A MANUAL STARTER (INCLUDING DISCONNECT). MC TO PROVIDE AND INSTALL A MOTOR RATED RELAY FOR CONTROLS INTERLOCK.

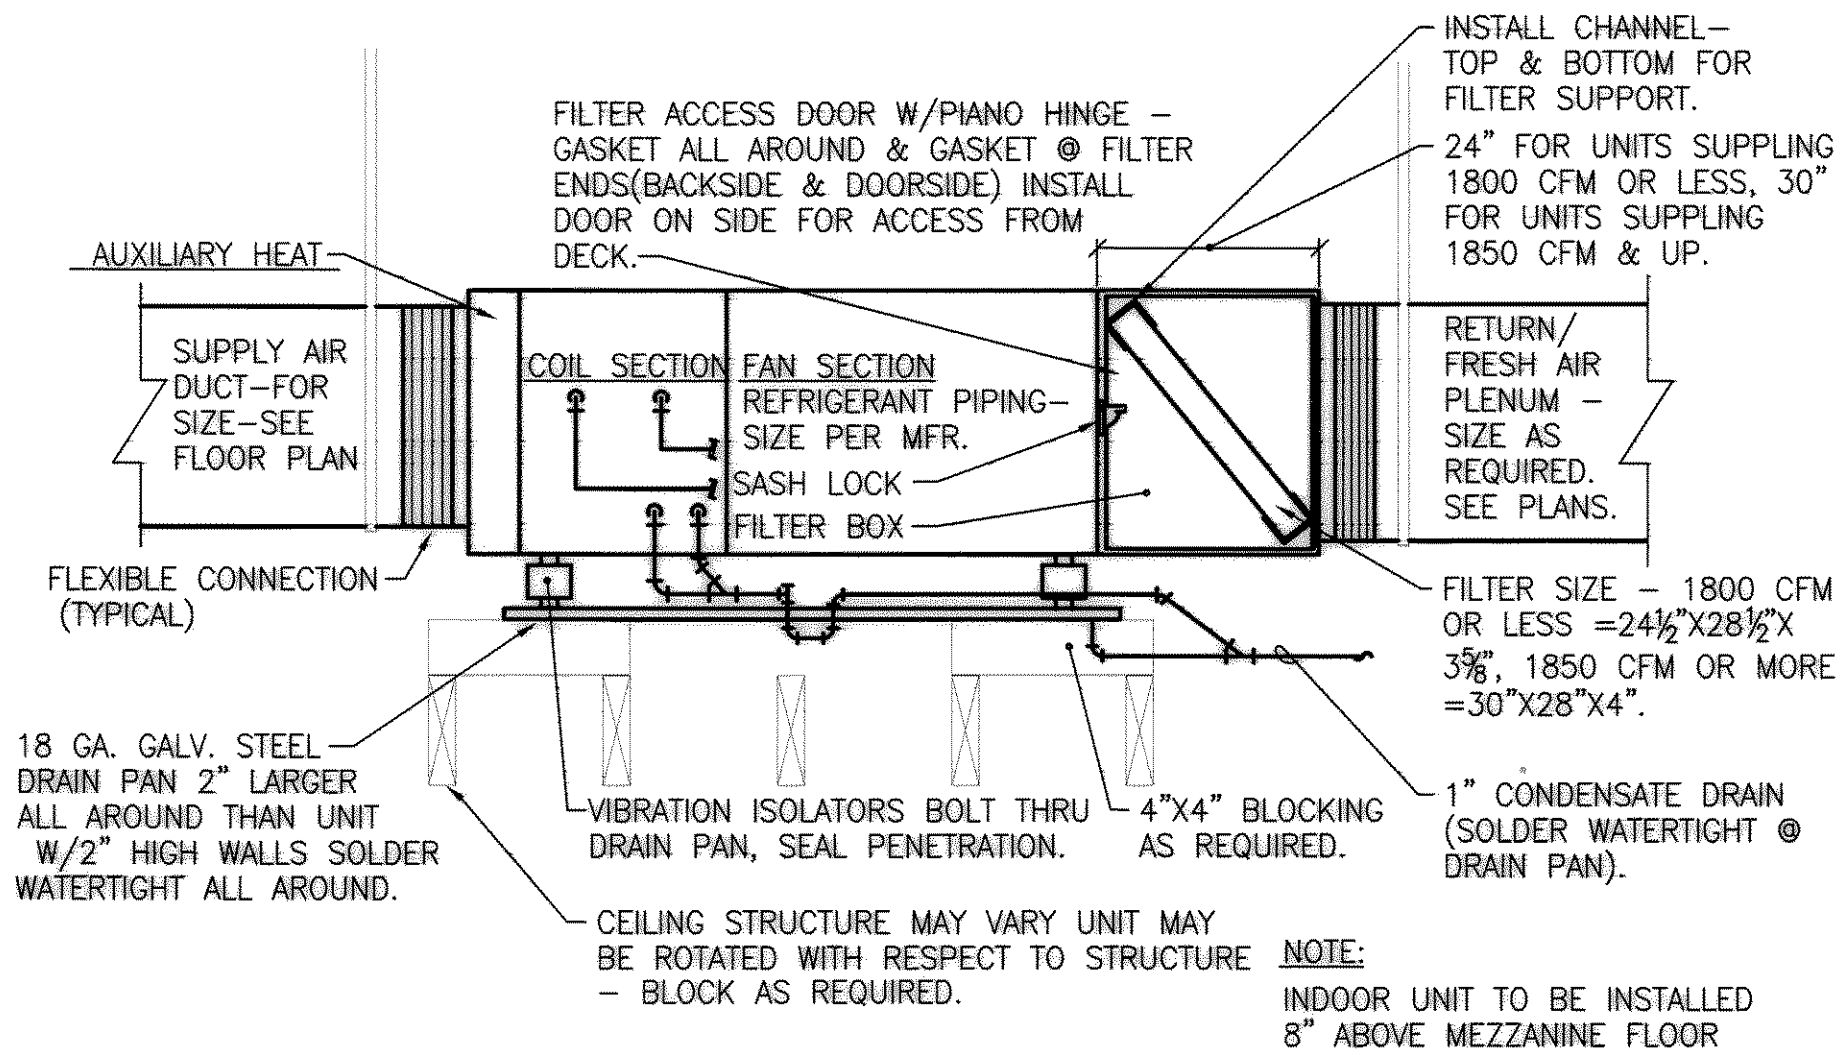

**INDOOR HEAT PUMP
INSTALLATION DETAIL**
NOT TO SCALE

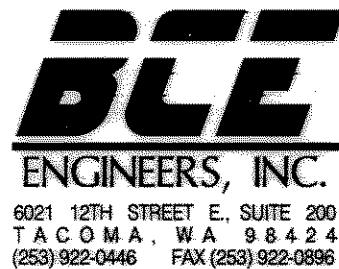


6321-17


APPROVED	CHECKED BY - DATE
CHIEF ENGINEER - DATE	PROJECT ENGR - DATE
DRAWING DATE:	DATE:
FOR ADDRESS:	FOR ADDRESS:
FOR PROJECT:	FOR PROJECT:

**PORT OF TACOMA
PIERCE COUNTY TERMINAL
MARINE BUILDING
MECHANICAL SCHEDULES**

**EP-5554-47
M3.100**
SHEET 75 OF 230
CONTRACT NUMBER 998154
E. NUMBER E1974
DATE: 08/20/05
PHASE: RECORD DRAWINGS

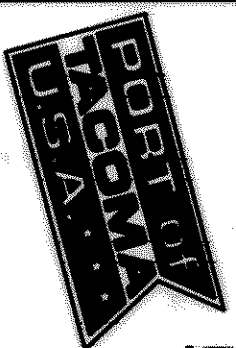

PORT OF TACOMA P.O. BOX 1837
TACOMA, WA 98401 253-363-5841

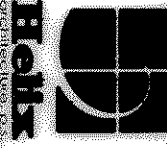

6021 12th street east
suite 201
tacoma, wa 98424
tel: 253 . 922 . 4092
fax: 253 . 922 . 4099

MARK	REVISION	BY	DATE
RECORD DRAWINGS			

APPROVED

CHIEF ENGINEER - DATE

CHECKED BY - DATE

PROJECT ENGR - DATE

PORT OF TACOMA
PIERCE COUNTY TERMINAL
MARINE BUILDING
MECHANICAL CONTROLS


EP-5661-17

M3.400

SHEET 78 OF 230

CONTRACT NUMBER: 99B154
E NUMBER: E197
PHASE: RECORD DRAWINGS


6321-17

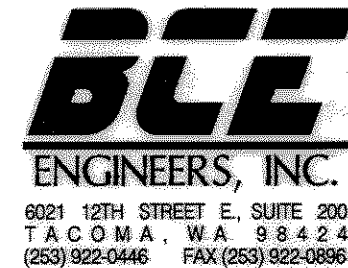

6021 12TH STREET E. SUITE 200
TACOMA, WA 98424
(253) 922-0446 FAX (253) 922-0096

HEAT PUMP UNITS

- A. AIR CONDITIONING UNIT SHALL BE CONTROLLED BY THE SPACE T'STAT. THE UNIT FAN AND COMPRESSOR SHALL CYCLE ON AND OFF TO MAINTAIN ROOM TEMPERATURE SETPOINT OF 78°F (ADJUSTABLE) FOR COOLING, AND 70°F (ADJUSTABLE) FOR HEATING.

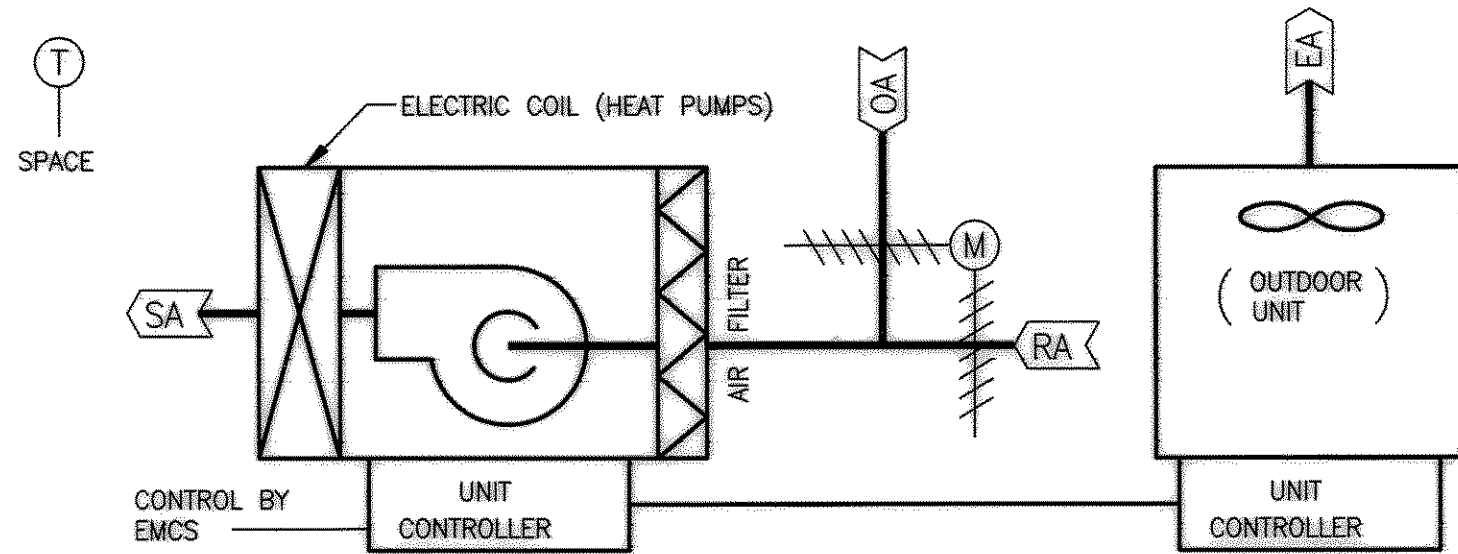


SPLIT SYSTEM COOLING UNITS


- A. SPLIT SYSTEM COOLING UNIT SHALL BE CONTROLLED BY THE SPACE THERMOSTAT PROVIDED WITH THE UNIT. THE UNIT FAN AND COMPRESSOR SHALL CYCLE ON AND OFF TO MAINTAIN ROOM TEMPERATURE SETPOINT OF 80°F (ADJUSTABLE). EMCS SYSTEM SHALL MONITOR SPACE TEMPERATURE.
- B. HEAT PUMP UNIT (ROOM C-324) SHALL BE CONTROLLED BY THE BUILDING EMCS SYSTEM THROUGH THE SPACE THERMOSTAT. THE UNIT FAN, COMPRESSOR, REVERSING VALVE AND ELECTRIC HEATER SHALL BE INDIVIDUALLY CONTROLLED IN SEQUENCE, AS REQUIRED, TO MAINTAIN ROOM TEMPERATURE RANGE 60-85°F (ADJUSTABLE).
1. HEATING MODE: ON A CALL FOR SYSTEM HEATING, COMPRESSOR AND REVERSING VALVE SHALL BE ENABLED IN SEQUENCE AS REQUIRED TO SATISFY SPACE HEATING REQUIREMENTS. IF, AFTER A 5 MINUTE TIME DELAY, THE COMPRESSOR HAS NOT RAISED THE ROOM TEMPERATURE, THE ELECTRIC HEATER SHALL BE ENABLED AND MODULATED TO MAINTAIN A MINIMUM LOW LIMIT SUPPLY AIR TEMPERATURE OF 85°F (ADJUSTABLE).
- THE DEFROST SIGNAL STATUS, RESIDENT IN THE HEAT PUMP OUTDOOR SECTION, SHALL BE MONITORED BY THE EMCS AND DISPLAYED WITH OTHER SYSTEM POINTS. UPON RECEIPT OF THIS SIGNAL, ELECTRIC HEATER SHALL BE COMMANDED TO 100% HEAT, DAMPERS AND EMERGENCY HEAT SAFETIES TEMPORARILY DISABLED UNTIL UNIT RETURNS TO NORMAL OPERATION AT DEFROST CONCLUSION.
2. EMERGENCY HEAT MODE: FOLLOWING A TIME DELAY OF 10 MINUTES FOLLOWING THE START OF A NEW HEATING CYCLE, AND IF THE HEAT PUMP FAILS TO DEVELOP A TEMPERATURE RISE ACROSS THE INDOOR COIL OF >15°F (ADJUSTABLE), THE HEAT PUMP SYSTEM SHALL LATCH INTO AN "EMERGENCY HEAT MODE". IN THIS MODE, OPERATION OF COMPRESSOR WILL BE PREVENTED, BOTH A VISUAL AND AUDIBLE ALARM SHALL BE SIGNALLED AT THE OPERATOR'S INTERFACE AND THE ELECTRIC HEATER WILL BE MODULATED TO MAINTAIN ROOM SETPOINT TEMPERATURE. THE AUDIBLE ALARM WILL CONTINUE TO SOUND UNTIL ACKNOWLEDGED AND THE UNIT SHALL REMAIN IN EMERGENCY MODE UNTIL RESET AT THE OPERATOR INTERFACE.
3. COOLING MODE: AS A FIRST STAGE OF COOLING, ELECTRIC HEATER IS DISABLED AND IF OSA IS DETERMINED TO SUITABLE FOR USE IN COOLING, ECONOMIZER DAMPERS SHALL BE MODULATED TO PROVIDE MIXED AIR TEMPERATURE OF 53°F. DAMPERS SHALL RETURN TO MINIMUM POSITION IF THE OSA TEMPERATURE RISES ABOVE AN ADJUSTABLE LOCKOUT TEMPERATURE 76°F DRY BULB. UPON A CALL FOR ADDITIONAL COOLING, COMPRESSOR AND REVERSING VALVE SHALL BE CYCLED IN SEQUENCE TO PROVIDE DX COOLING. WHEN ECONOMIZER COOLING IS LOCKED OUT, DX COOLING SHALL BE USED AS FIRST-STAGE COOLING.
4. EMERGENCY COOLING MODE: SIMILAR TO THE EMERGENCY HEAT MODE, IF AFTER 10 MINUTES OF COMPRESSOR OPERATION A TEMPERATURE DIFFERENTIAL OF AT LEAST 15°F (ADJUSTABLE) IS NOT ATTAINED, LOCKOUT COMPRESSOR OPERATION AND INITIATE AN ALARM AT THE OPERATOR'S TERMINAL. COMPRESSOR SHALL REMAINED LOCKED OUT UNTIL RESET AT THE OPERATOR INTERFACE.
- C. MISCELLANEOUS SAFETIES: VERIFY MANUFACTURER FURNISHED ELECTRIC CONTROLS AND PROVIDE ADDITIONAL INTERLOCKS AS REQUIRED TO PREVENT COMPRESSOR AND ELECTRIC HEAT FROM OPERATING WITHOUT FAN OPERATION. THE INTEGRITY OF INTEGRAL LOW PRESSURE AND HIGH PRESSURE SAFETY SHUTDOWNS OF COMPRESSOR SHALL REMAIN INTACT AND UNAFFECTED BY THE FIELD INSTALLATION OF DDC CONTROLS. AN ALARM SHALL BE ENERGIZED UPON FAILURE OF ANY DEVICE OR IF SPACE TEMPERATURE EXCEEDS 10°F (ADJUSTABLE).

INFORMATION AT TERMINAL
SPACE TEMPERATURE
UNIT COMMANDED MODE (ON/OFF)
FAN ON/OFF
FAN STATUS VIA AIRFLOW SWITCH OR CURRENT SENSING RELAY.
PERCENT COMMANDED COOLING
OUTPUT STATUS
ALARM/TROUBLE CONDITIONS

POINTS LIST	AI	AO	DI	DO
SUPPLY FAN START/STOP				X
SUPPLY FAN STATUS			X	
CHANGEOVER VALVE				X
COMPRESSOR ENABLE				X
SPACE TEMPERATURE	X			
OUTSIDE AIR DAMPER		X		
MIXED AIR TEMPERATURE	X			

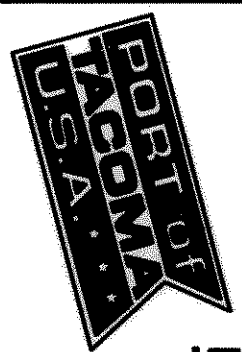

PORT OF TACOMA P.O. BOX 1837
TACOMA, WA 98401 253-883-8841

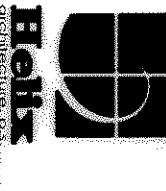

6021 12th Street East
Suite 200
Tacoma, WA 98424
Tel: 253.922.9037
Fax: 253.922.6499

DATE: 11/17/2023
BY: BMM
PROJECT: MARINE

APPROVED

CHIEF ENGINEER - DATE

CHECKED BY - DATE
PROJECT ENGR. - DATE

PORT OF TACOMA
PIERCE COUNTY TERMINAL
MARINE BUILDING
LIGHTING PLAN


EP-5664-17
E3.100
SHEET 79 OF 230

DRAWING DATE: 11/17/2023
PORT ADDRESS: 6021 12th Street East
PORT PANEL: Suite 200



TOWNSHIP: RANGE: SECTION:
DATE: 11/17/2023
DRAWING SCALE: 1/8" = 1'

CONTRACT NUMBER: 998154
E. NUMBER: E1974
PHASE: RECORD DRAWINGS

6321-17

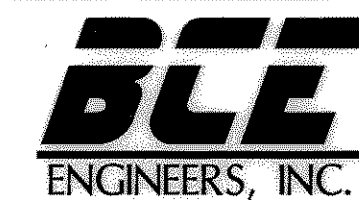

6021 12TH STREET E., SUITE 200
TACOMA, WA 98424
(253) 922-0446 FAX (253) 922-0886

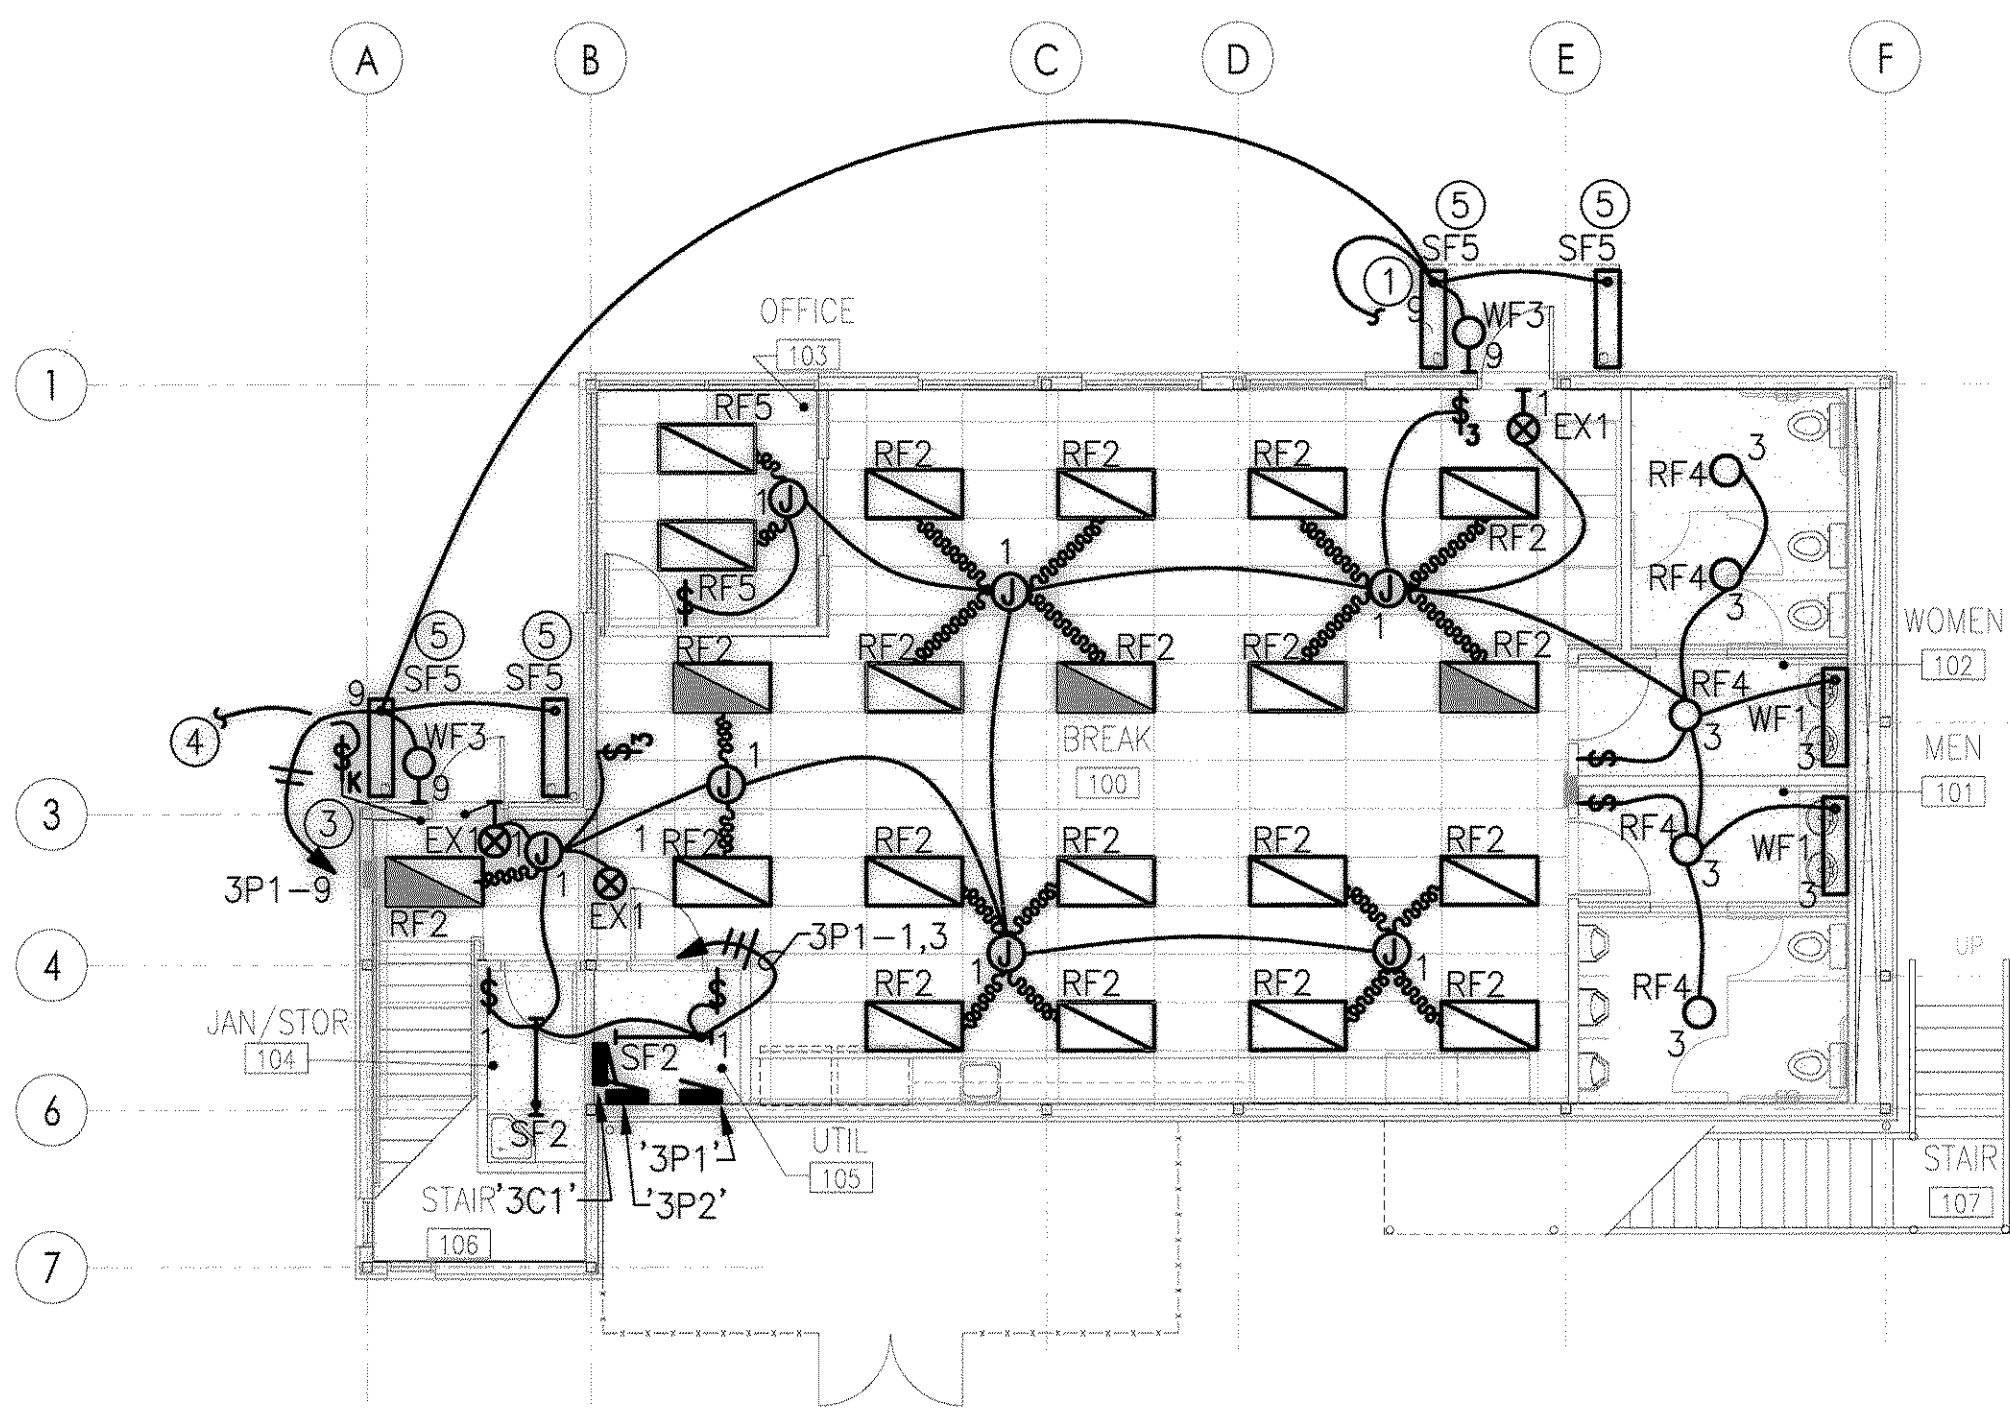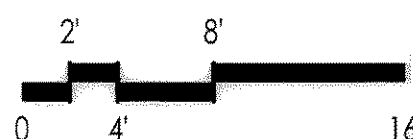


1 FIRST FLOOR LIGHTING PLAN

SCALE: 1/8"=1'-0"

BMM

xtp_marine-23003.dwg

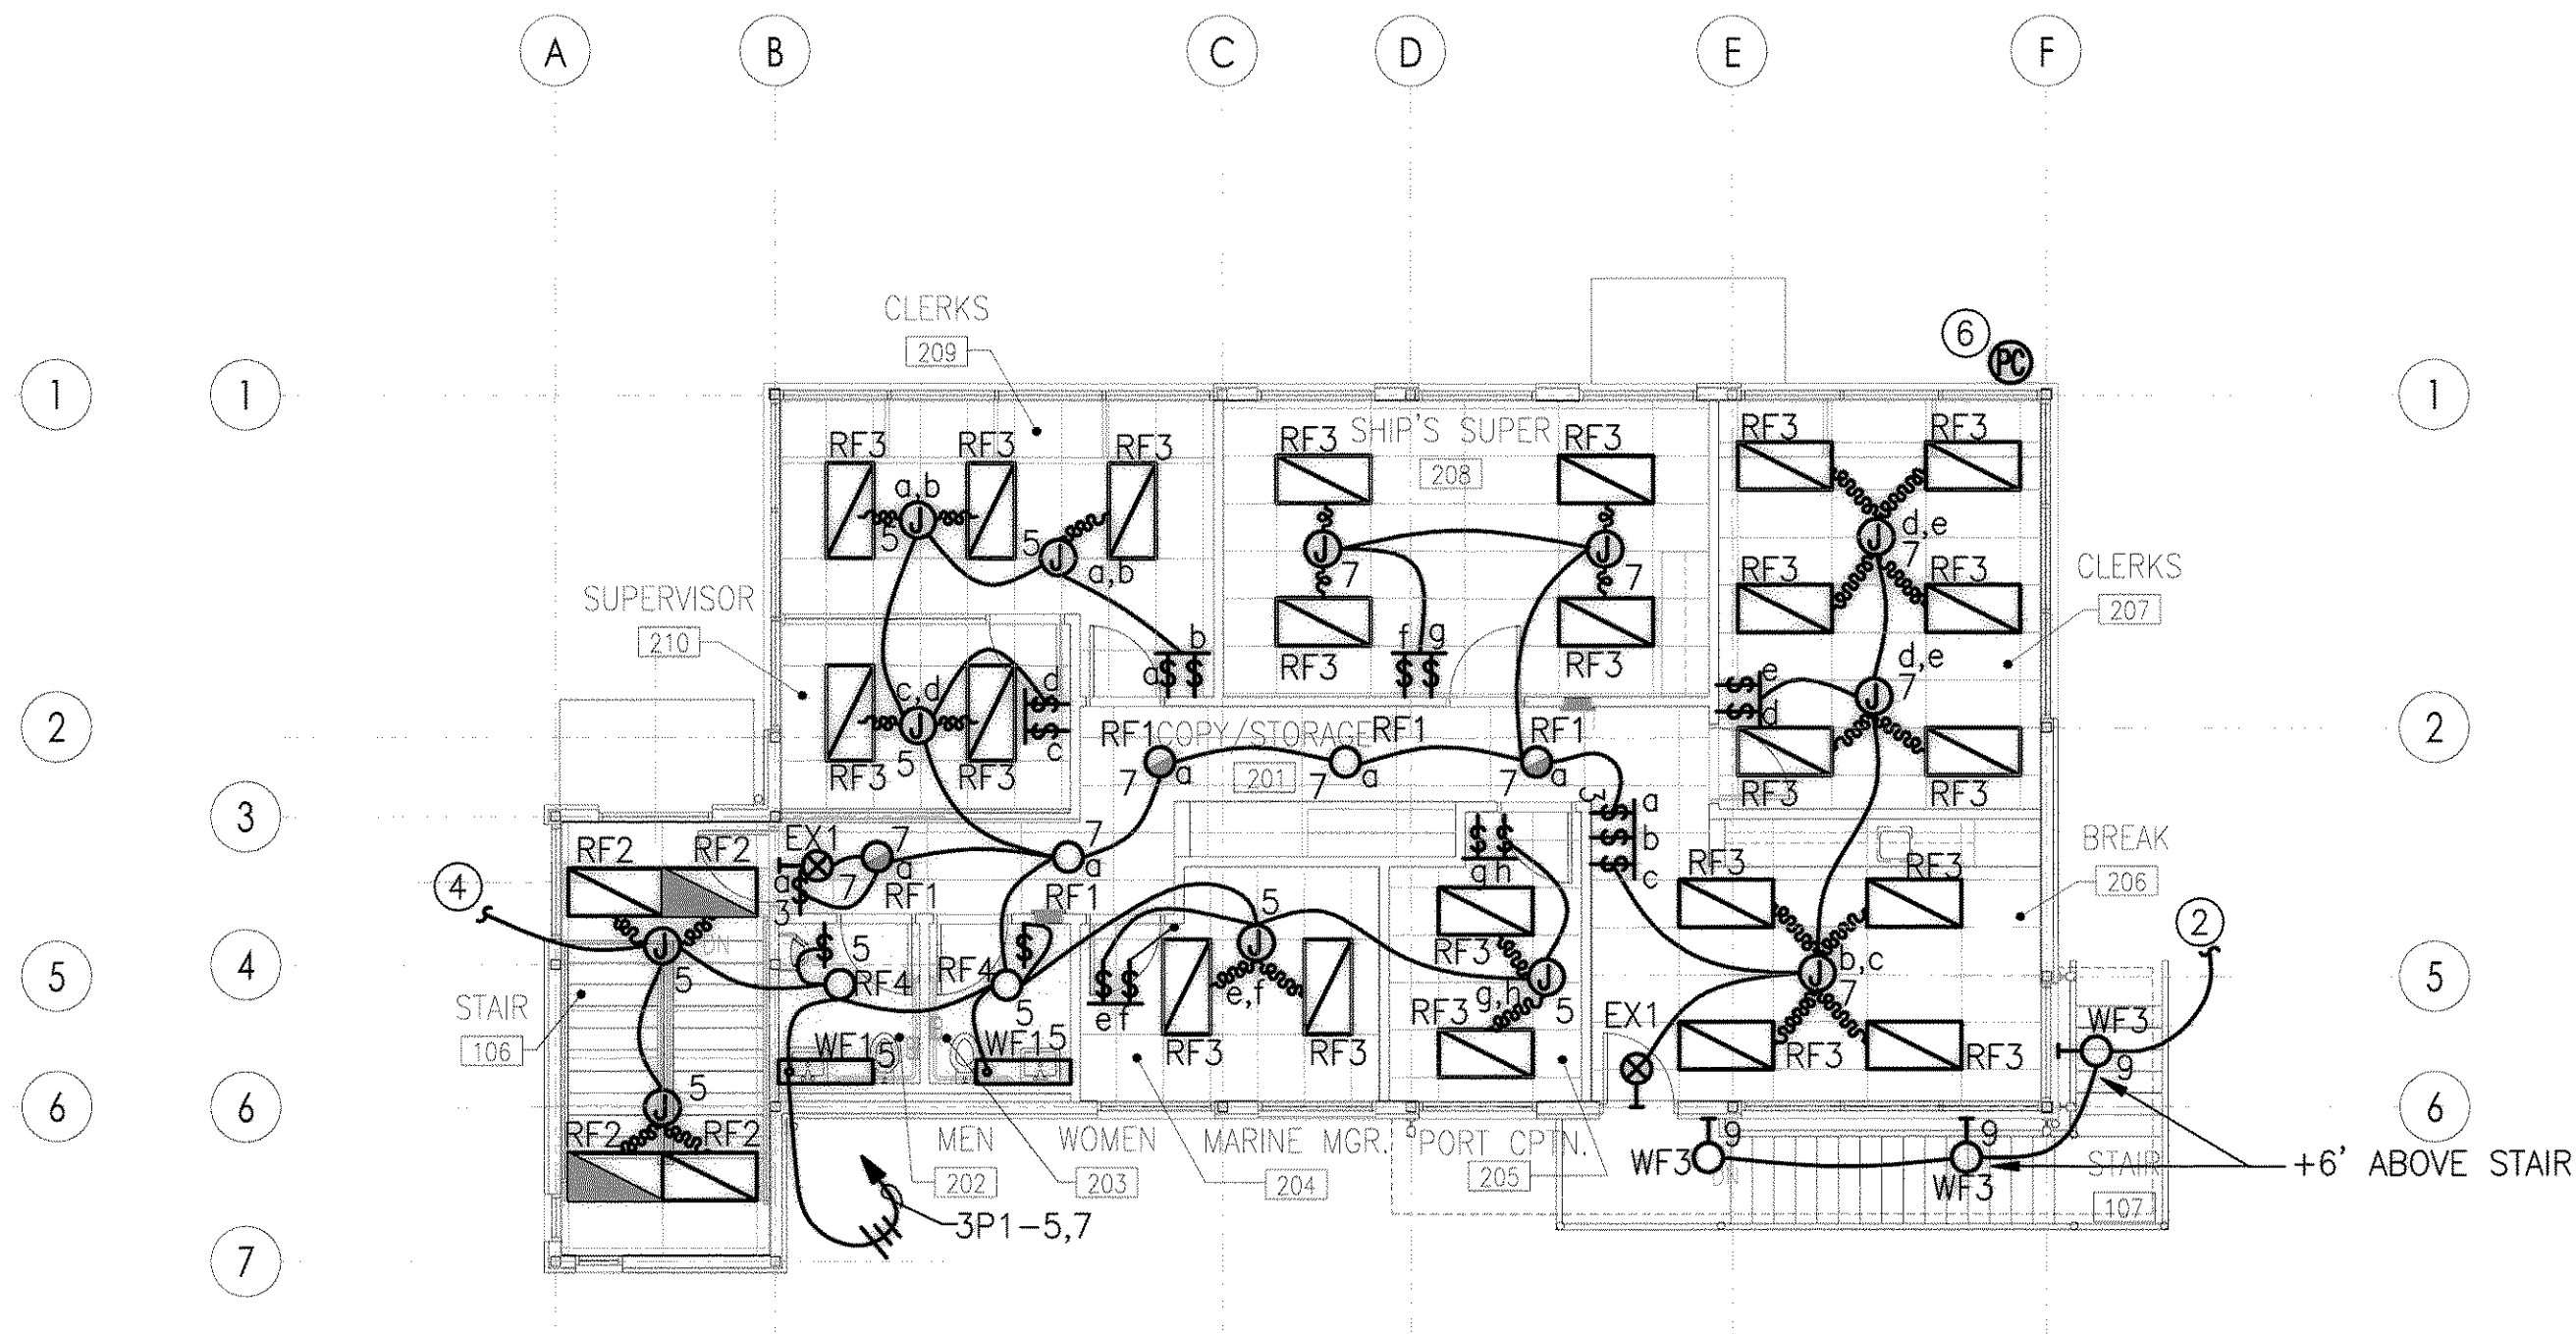

2 SECOND FLOOR LIGHTING PLAN

SCALE: 1/8"=1'-0"

BMM


xtp_marine-23003.dwg

CONSTRUCTION NOTES

1. CIRCUIT CONTINUED TO SECOND FLOOR EXTERIOR LIGHTS.
2. CIRCUIT CONTINUED TO FIRST FLOOR EXTERIOR LIGHTS.
3. ROUTE THROUGH LIGHTING CONTROL CONTACTOR. SEE DETAIL ON SHEET E1.103.
4. SWITCH CIRCUIT CONTINUED FOR STAIRWAY LIGHTING.
5. MOUNT FIXTURE TO INSIDE END OF CANOPY. AIM AT UNDERSIDE OF CANOPY SO AS TO MAXIMIZE UNIFORMITY OF INDIRECT ILLUMINANCE UNDER CANOPY. SEE ARCHITECTURAL DETAIL 13, SHEET A7.606
6. PHOTOCCELL FOR EXTERIOR BUILDING LIGHTS MOUNTED ON ROOF. AIM NORTH, FLASH AND COUNTER FLASH ALL ROOF PENETRATIONS. SEE DETAIL SHEET E1.103.

GENERAL NOTES

1. PANEL CIRCUIT NUMBER ARE SHOWN TO CLARIFY CIRCUITING CONFIGURATION. CONDUCTOR HASH MARKS ARE NOT SHOWN FOR #12 AWG WIRE, SWITCH LEGS, OR GROUNDING CONDUCTORS. ELECTRICAL CONTRACTOR SHALL PROVIDE ALL REQUIRED CONDUCTORS AS NECESSARY IN ORDER TO INSTALL ALL CIRCUITS, SWITCHING, AND GROUNDING COMPLETE.
2. PROVIDE UNSWITCHED HOT LEG FOR ALL EMERGENCY/EXIT FIXTURES.

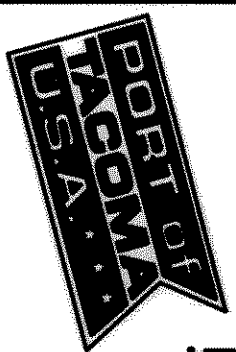

PORT OF TACOMA P.O. BOX 1837
TACOMA, WA 98401 253-883-6841



6021 12th street east
suite 200
Tacoma, WA 98404
Tel: 253-922-0446
Fax: 253-922-0499

DATE: 6/21/17

REVISION	DATE	BY	APPROVED
RECORD DRAWINGS			

APPROVED

CHIEF ENGINEER - DATE



CHECKED BY - DATE
PROJECT ENGR - DATE

PORT OF TACOMA
PIERCE COUNTY TERMINAL
MARINE BUILDING
POWER PLAN

EP-6661-17
E3.200
SHEET 80 OF 230
CONTRACT NUMBER: 998154
DATE: 6/21/17
PROJECT RECORD DRAWINGS

6321-17


BCEE
ENGINEERS, INC.
6021 12TH STREET E. SUITE 200
TACOMA, WA 98404
(253) 922-0446 FAX (253) 922-0499

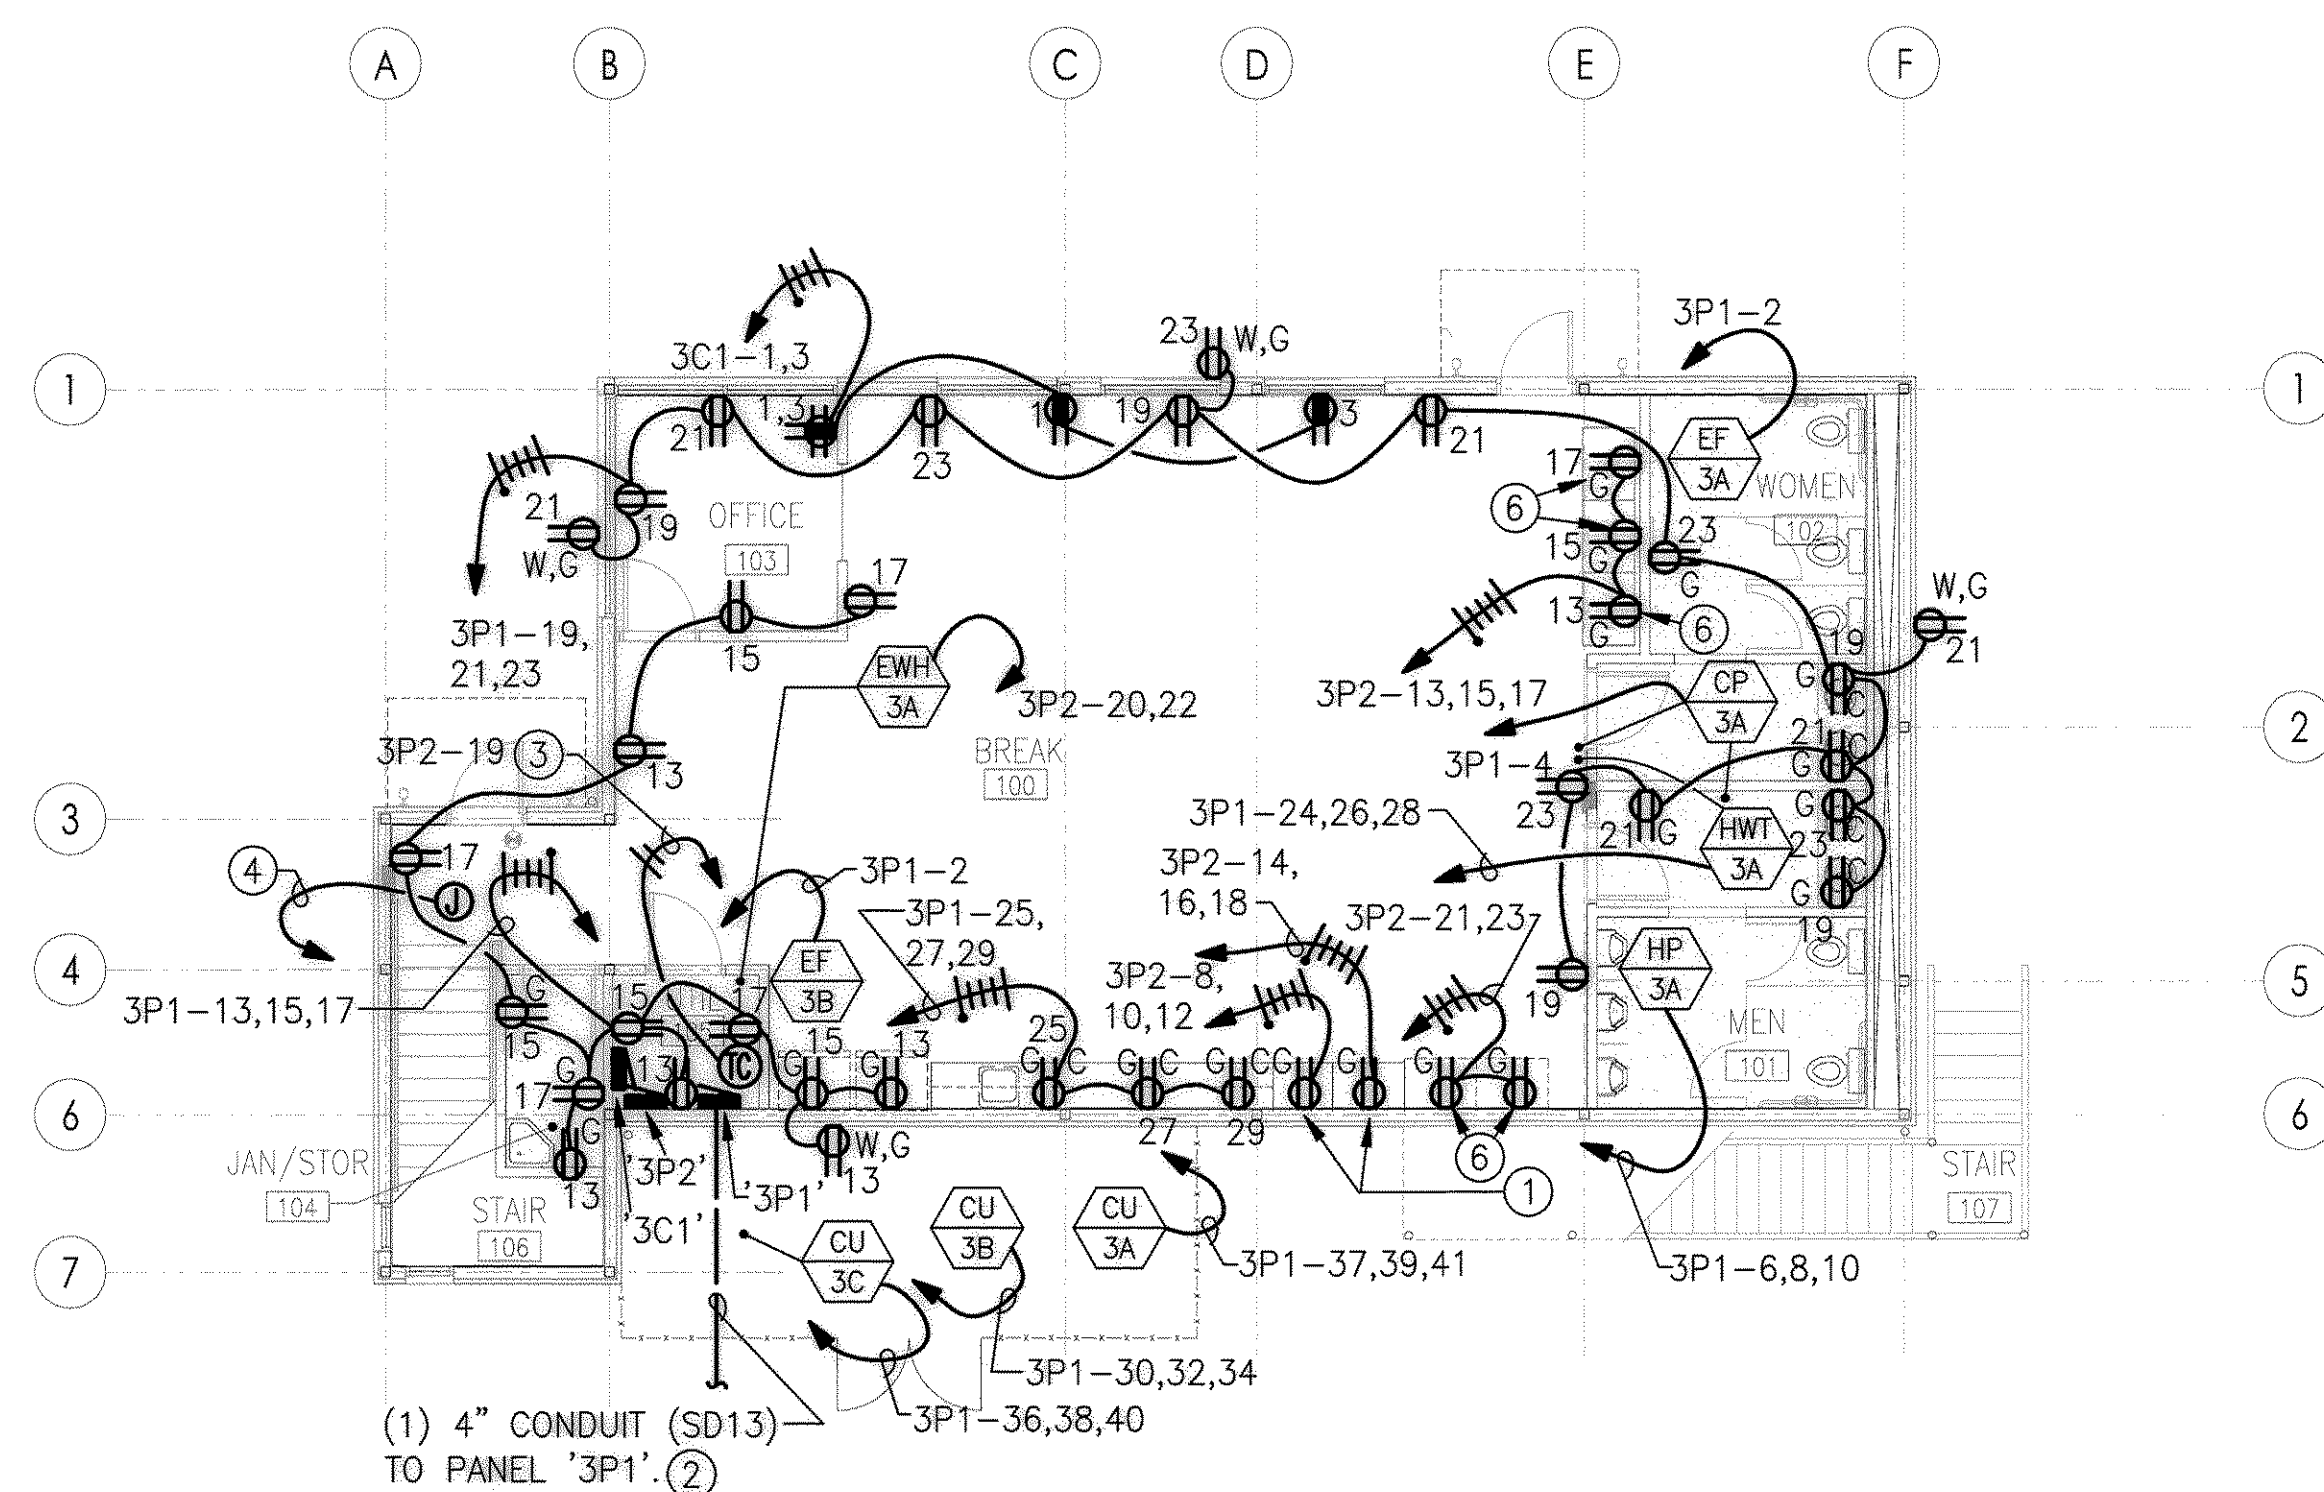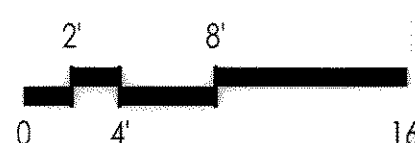

1 FIRST FLOOR POWER PLAN

SCALE: 1/8"=1'-0"

BMM xfp_marine-23003.dwg

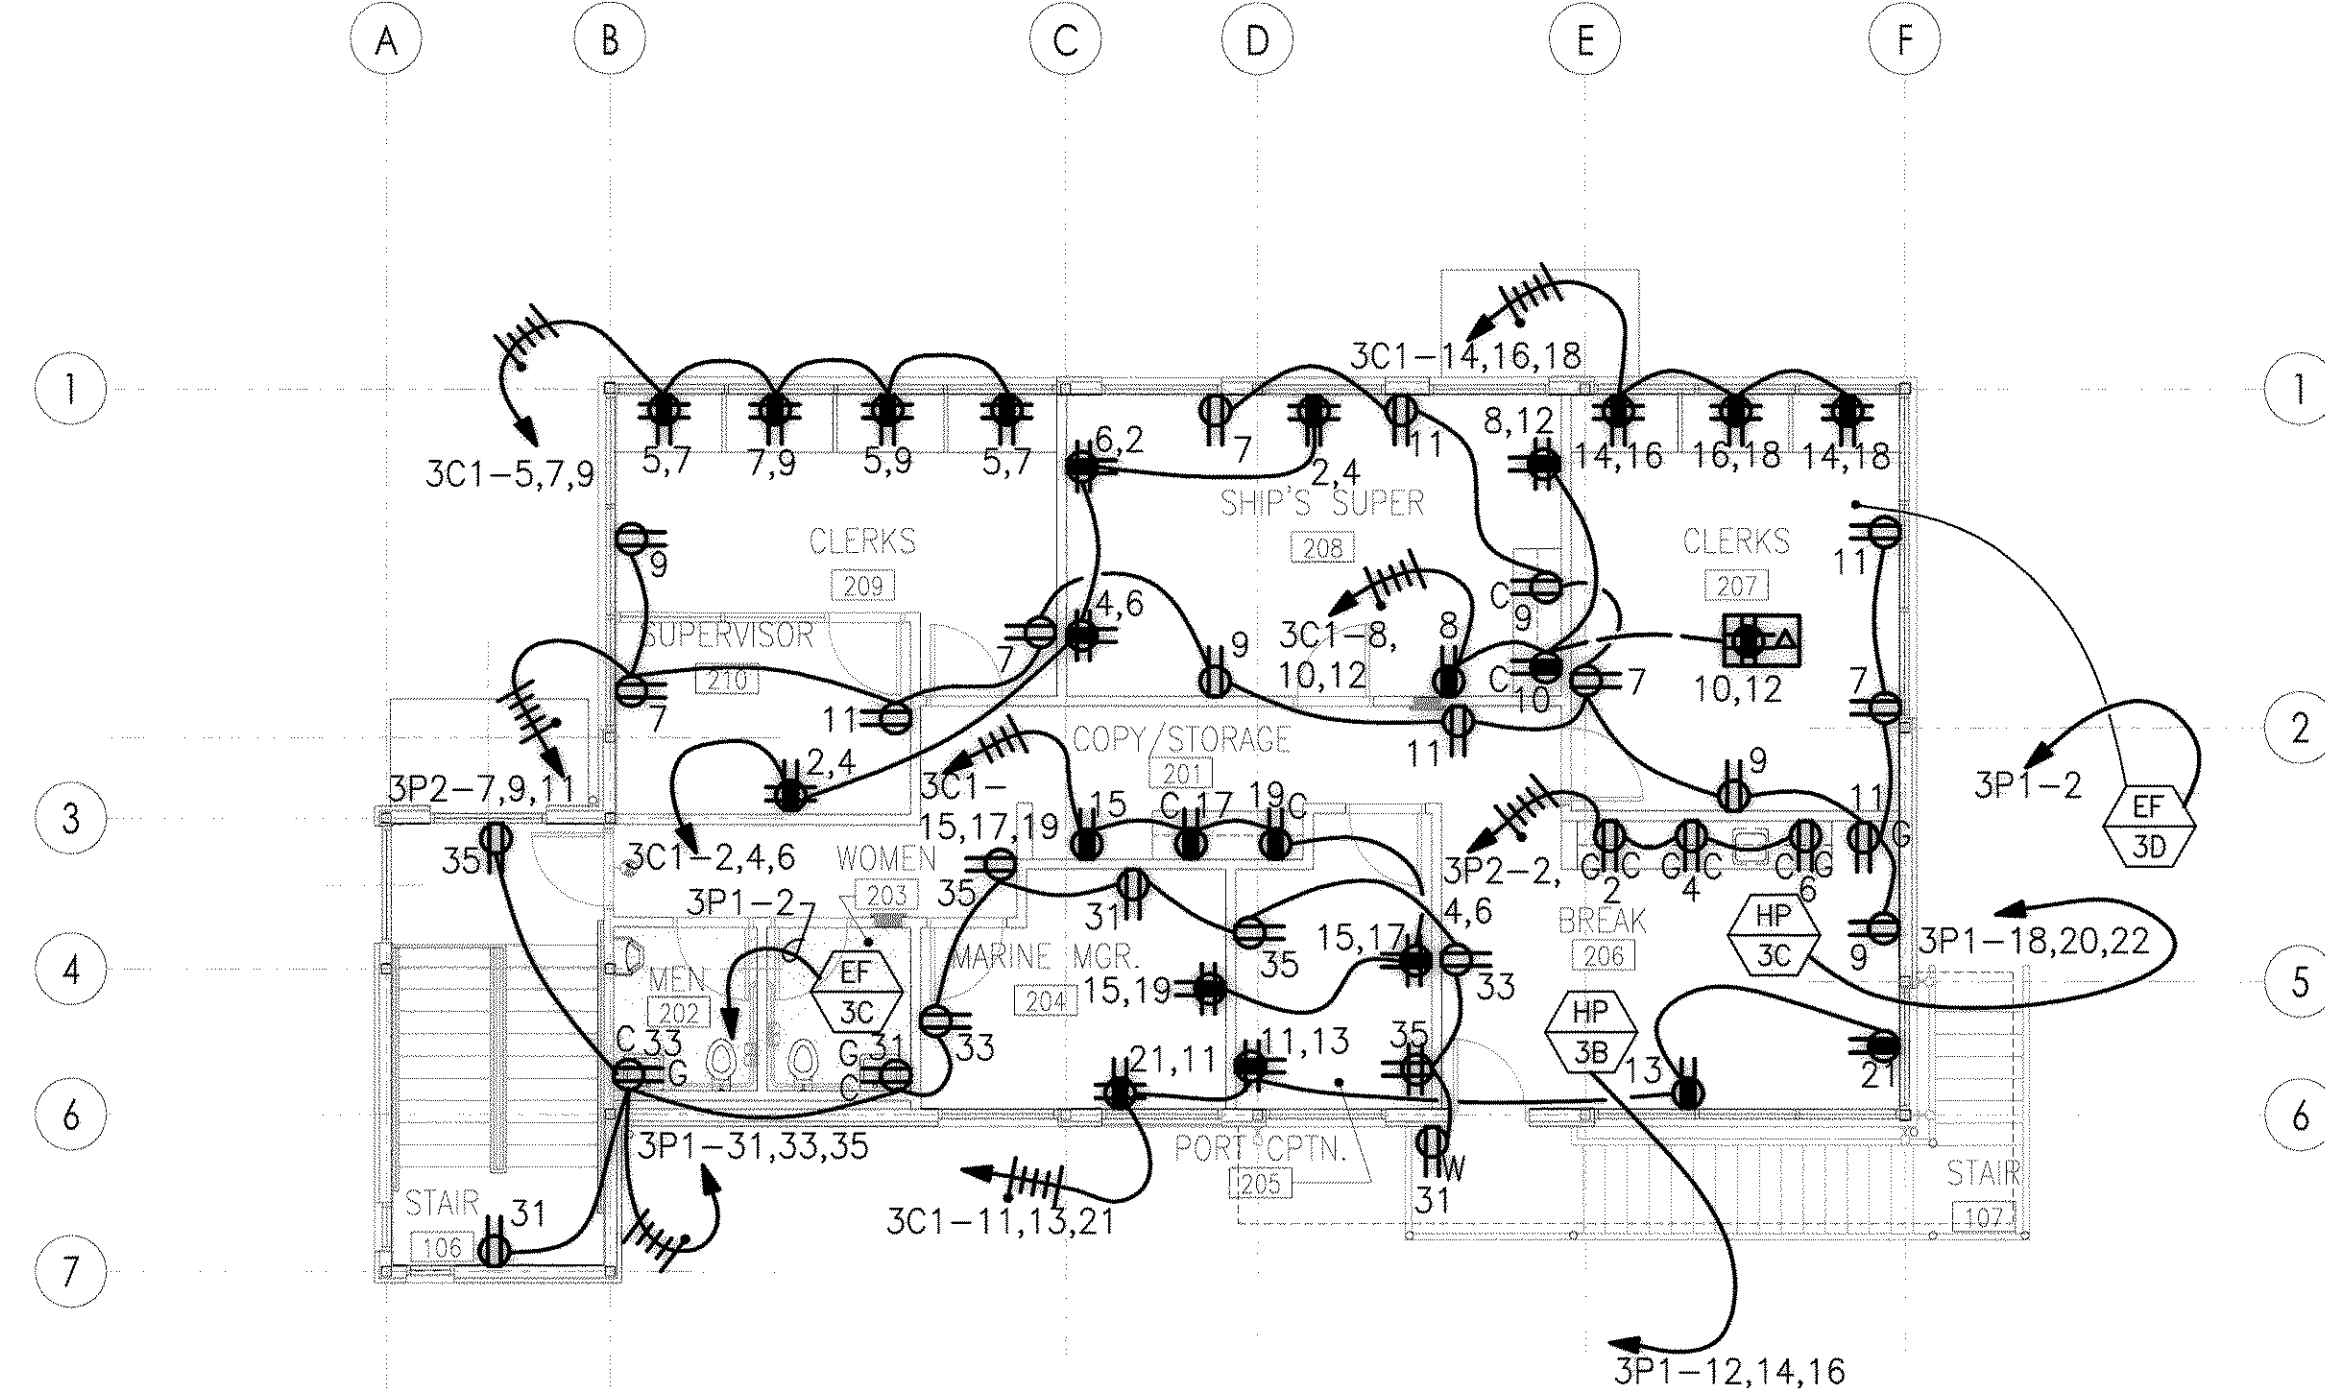

2 SECOND FLOOR POWER PLAN

SCALE: 1/8"=1'-0"


BMM xfp_marine-23003.dwg

GENERAL NOTES

1. LIGHT LINEWEIGHT INDICATES WORK BY OTHERS.
2. PANEL CIRCUIT NUMBER ARE SHOWN TO CLARIFY CIRCUITING CONFIGURATION. CONDUCTOR HASH MARKS ARE NOT SHOWN FOR #12 AWG WIRE, SWITCH LEGS, OR GROUNDING CONDUCTORS. ELECTRICAL CONTRACTOR SHALL PROVIDE ALL REQUIRED CONDUCTORS AS NECESSARY IN ORDER TO INSTALL ALL CIRCUITS, SWITCHING, AND GROUNDING COMPLETE.
3. PROVIDE ALL CONDUITS WITH PULL STRINGS.
4. PROVIDE CONDUIT CAP FOR ALL SPARE AND FOR FUTURE CONDUITS.

CONSTRUCTION NOTES


- ① (3) DEDICATED RECEPTACLES AT EACH LOCATION FOR STACKED MICROWAVES IN CABINETS. COORDINATE MOUNTING HEIGHT WITH CABINET INSTALLER.
- ② BUILDING EC (CONTRACT #998154) TO PROVIDE CONDUIT ONLY TO 15' BEYOND EDGE OF BUILDING. CONDUCTORS, PROVIDED BY SITE EC (CONTRACT #998153) TO BE COILED IN UTILITY ROOM #105 FOR TERMINATION BY CONTRACT #998154 EC. CALLOUTS MATCH CONTRACT #998153 DRAWINGS. COORDINATE ALL CONNECTIONS WITH CONTRACT #998153 CONTRACTOR.
- ③ CONNECTION FOR PHOTOCELL/TIMECLOCK. SEE DETAIL SHEET E1.103.
- ④ PROVIDE J-BOX AND 3/4" CONDUIT WITH PULL STRING TO UTILITY ROOM #105 FOR FUTURE CARD ACCESS SYSTEM.
- ⑤ FIELD VERIFY PHASE ROTATION PRIOR TO CONDUCTOR TERMINATION IN PANEL. PROVIDE ALL NECESSARY COORDINATION WITH CONTRACT #998153 WORK.
- ⑥ VENDING MACHINE.

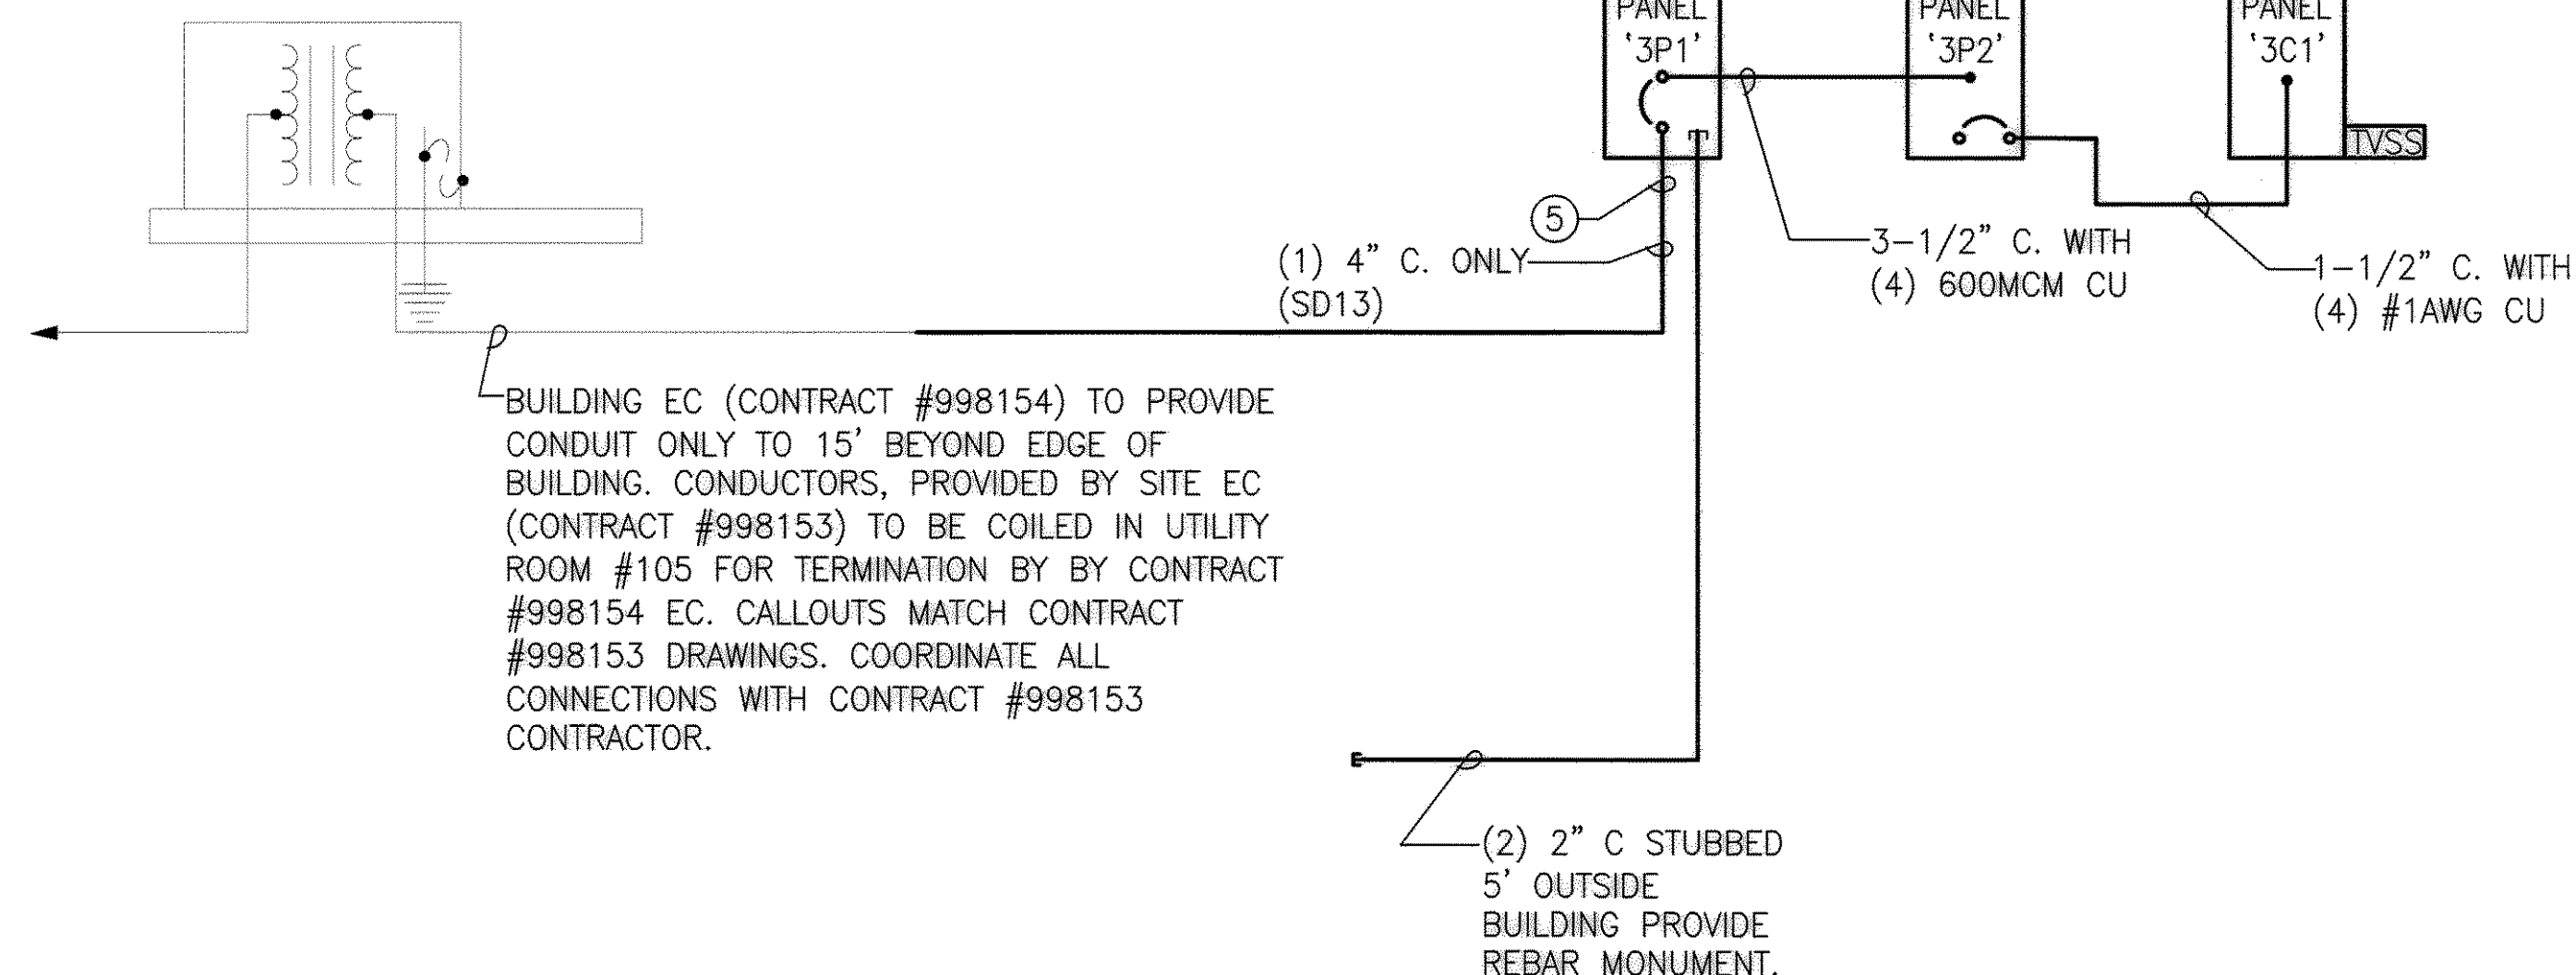


3 RISER DIAGRAM

NOT TO SCALE

BMM xfp_marine-23003.dwg

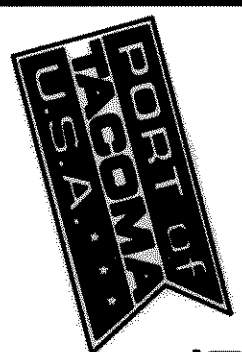

PORT OF TACOMA P.O. BOX 1837
TACOMA, WA 98401 253-383-6841

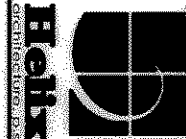

4021 12th street east
Suite 200
Tacoma, WA 98424
tel: 253.922.9037
fax: 253.922.6499

DATE:

REVISION
RECORD DRAWINGS

APPROVED

CHIEF ENGINEER - DATE

CHECKED BY - DATE

PROJECT ENGR. - DATE

PORT OF TACOMA
PIERCE COUNTY TERMINAL
MARINE BUILDING
SYSTEMS PLAN


EP-6654-17

E3.300


SHEET 81 OF 230

CONTRACT NUMBER: 998154
E NUMBER: E1974
PHASE: RECORD DRAWINGS

6321-17

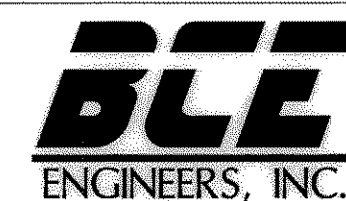

6021 12TH STREET E., SUITE 200
TACOMA, WA 98424
(253) 922-0446 FAX (253) 922-0886

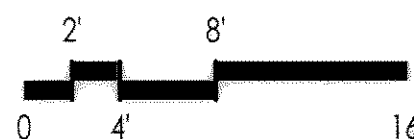


GENERAL NOTES


1. PROVIDE ALL CONDUITS WITH PULL STRINGS.
2. PROVIDE CONDUIT CAP FOR ALL SPARE AND FOR FUTURE CONDUITS.

CONSTRUCTION NOTES


- ① NOT USED.
- ② J-BOX FOR FUTURE CARD READER. MOUNT AT +48", SEE DETAIL ON SHEET E1.105.
- ③ J-BOX ABOVE CEILING FOR FUTURE CARD ACCESS SYSTEM. SEE DETAIL ON SHEET E1.105.
- ④ BUILDING EC (CONTRACT #998154) TO PROVIDE CONDUIT ONLY TO 15' BEYOND EDGE OF BUILDING. CALLOUTS MATCH CONTRACT #998153 DRAWINGS. COORDINATE ALL CONNECTIONS WITH CONTRACT #998153 CONTRACTOR.

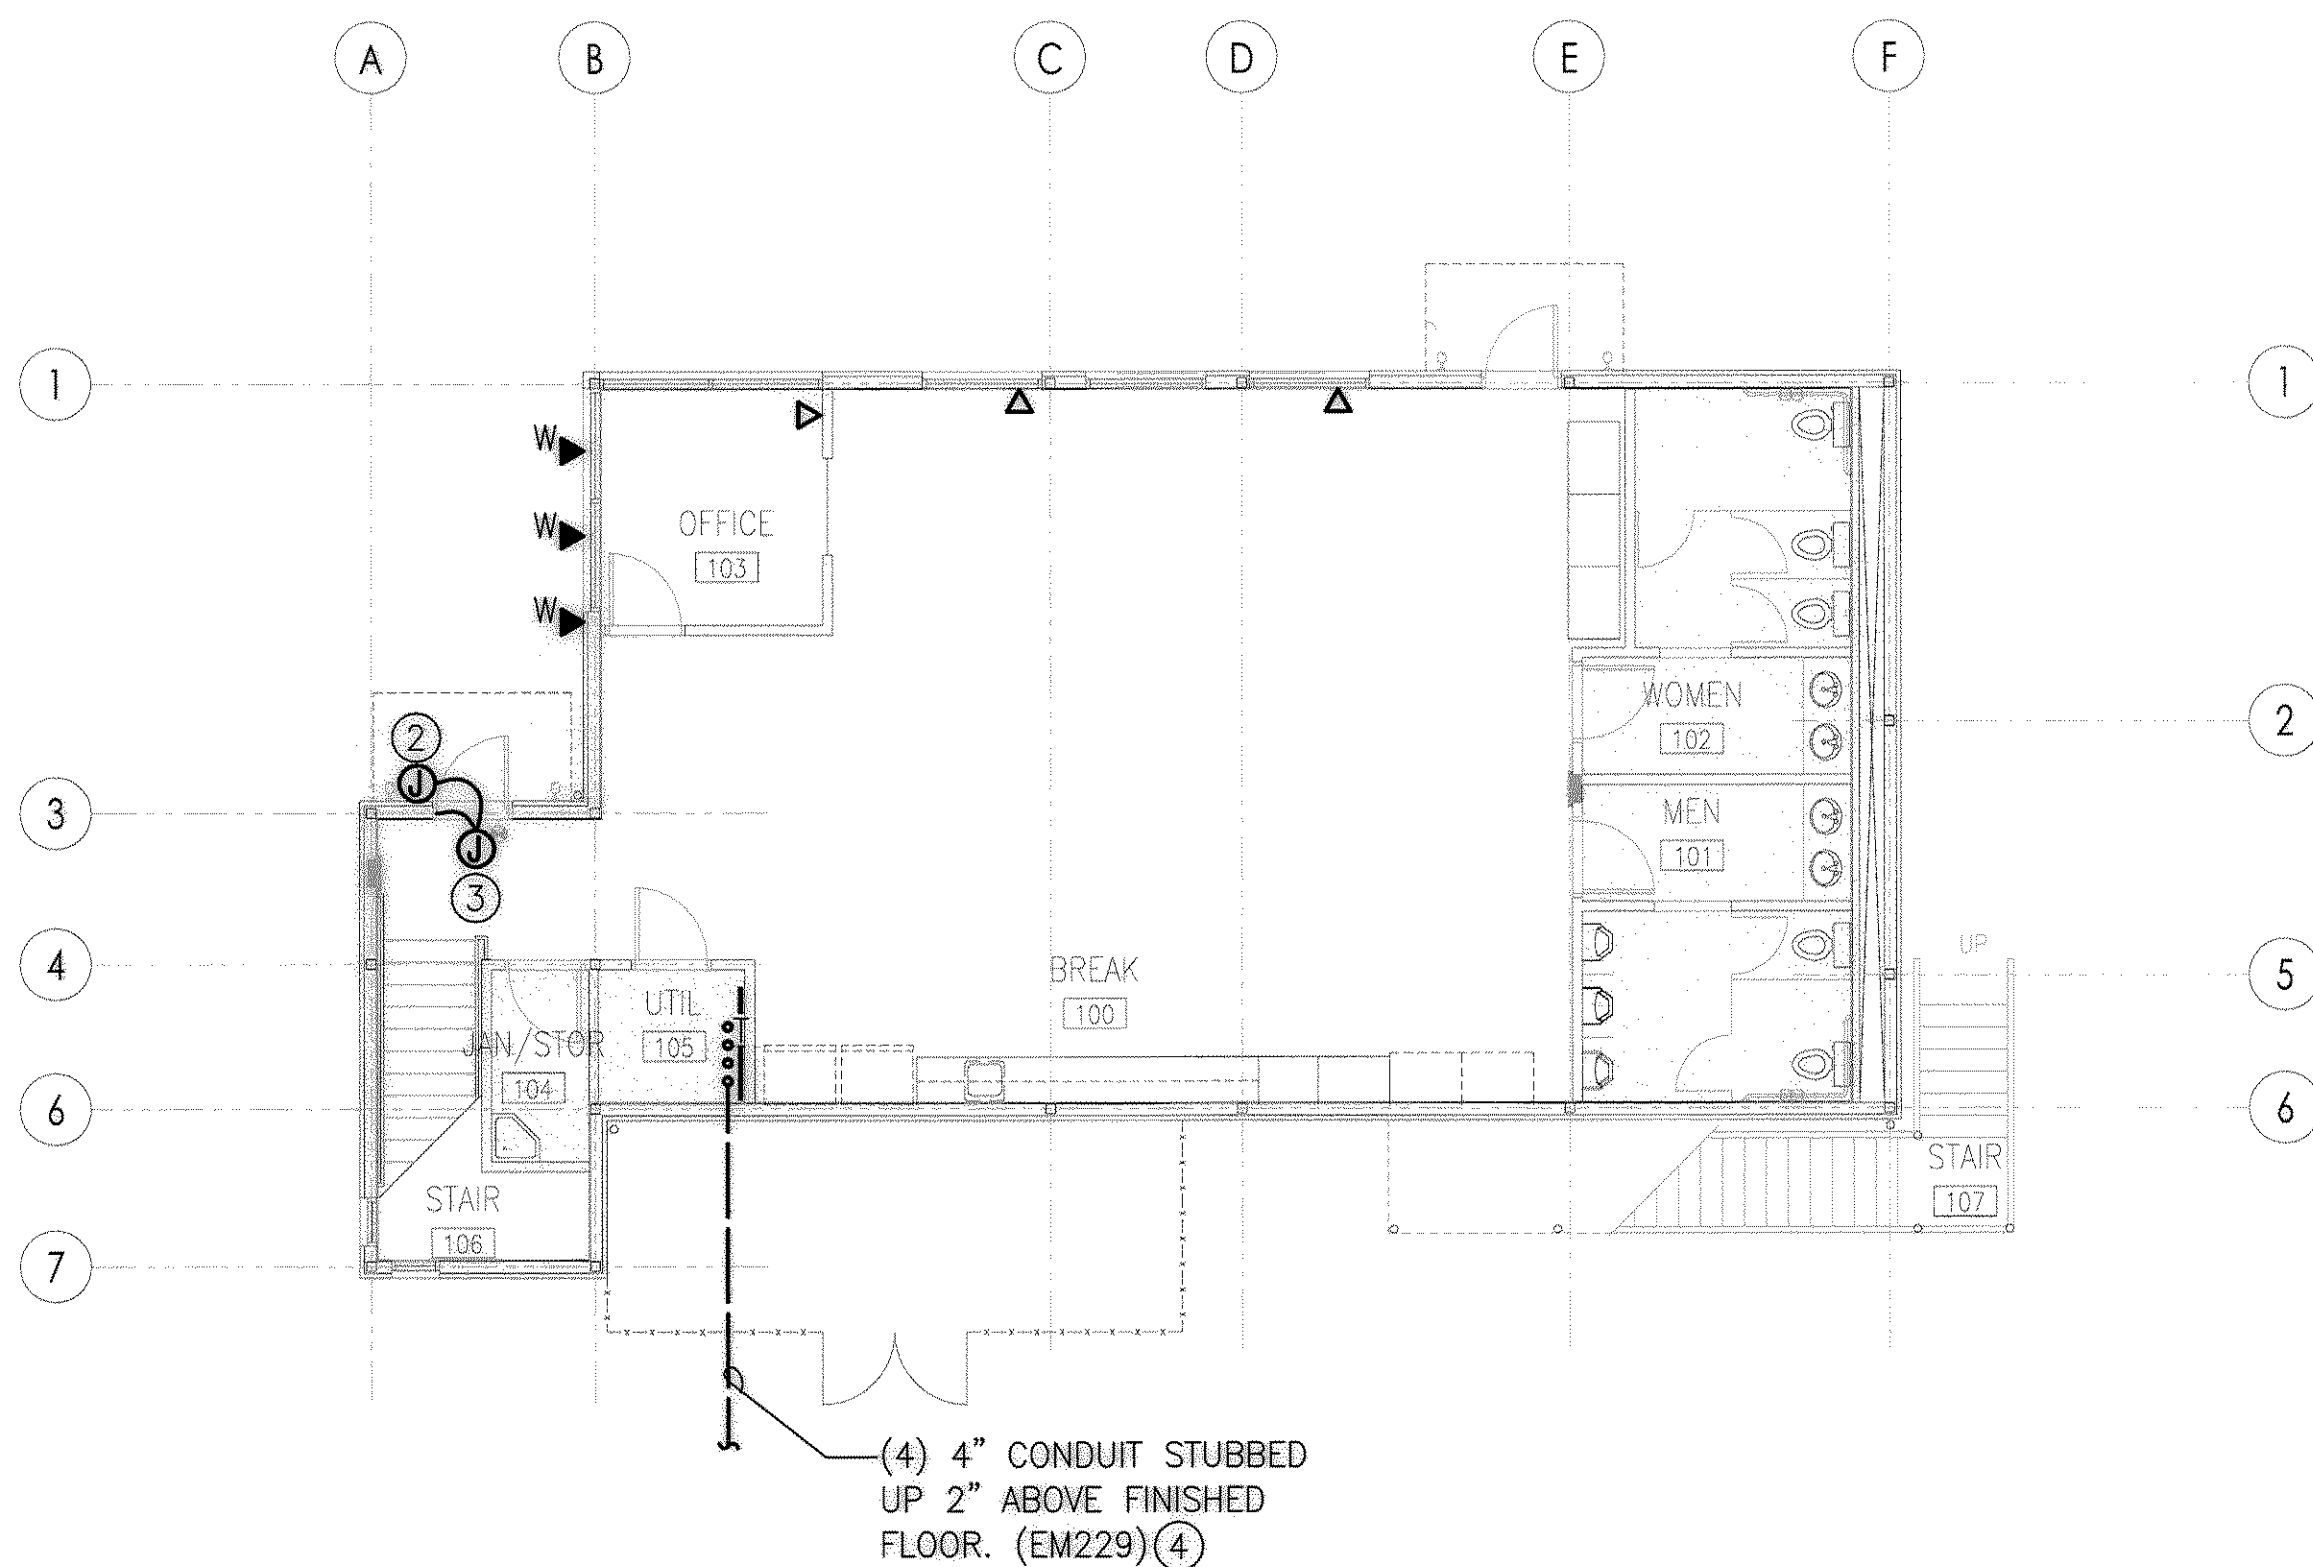

1 FIRST FLOOR SYSTEMS PLAN
SCALE: 1/8"=1'-0" BMW xfp_marine-23003.dwg

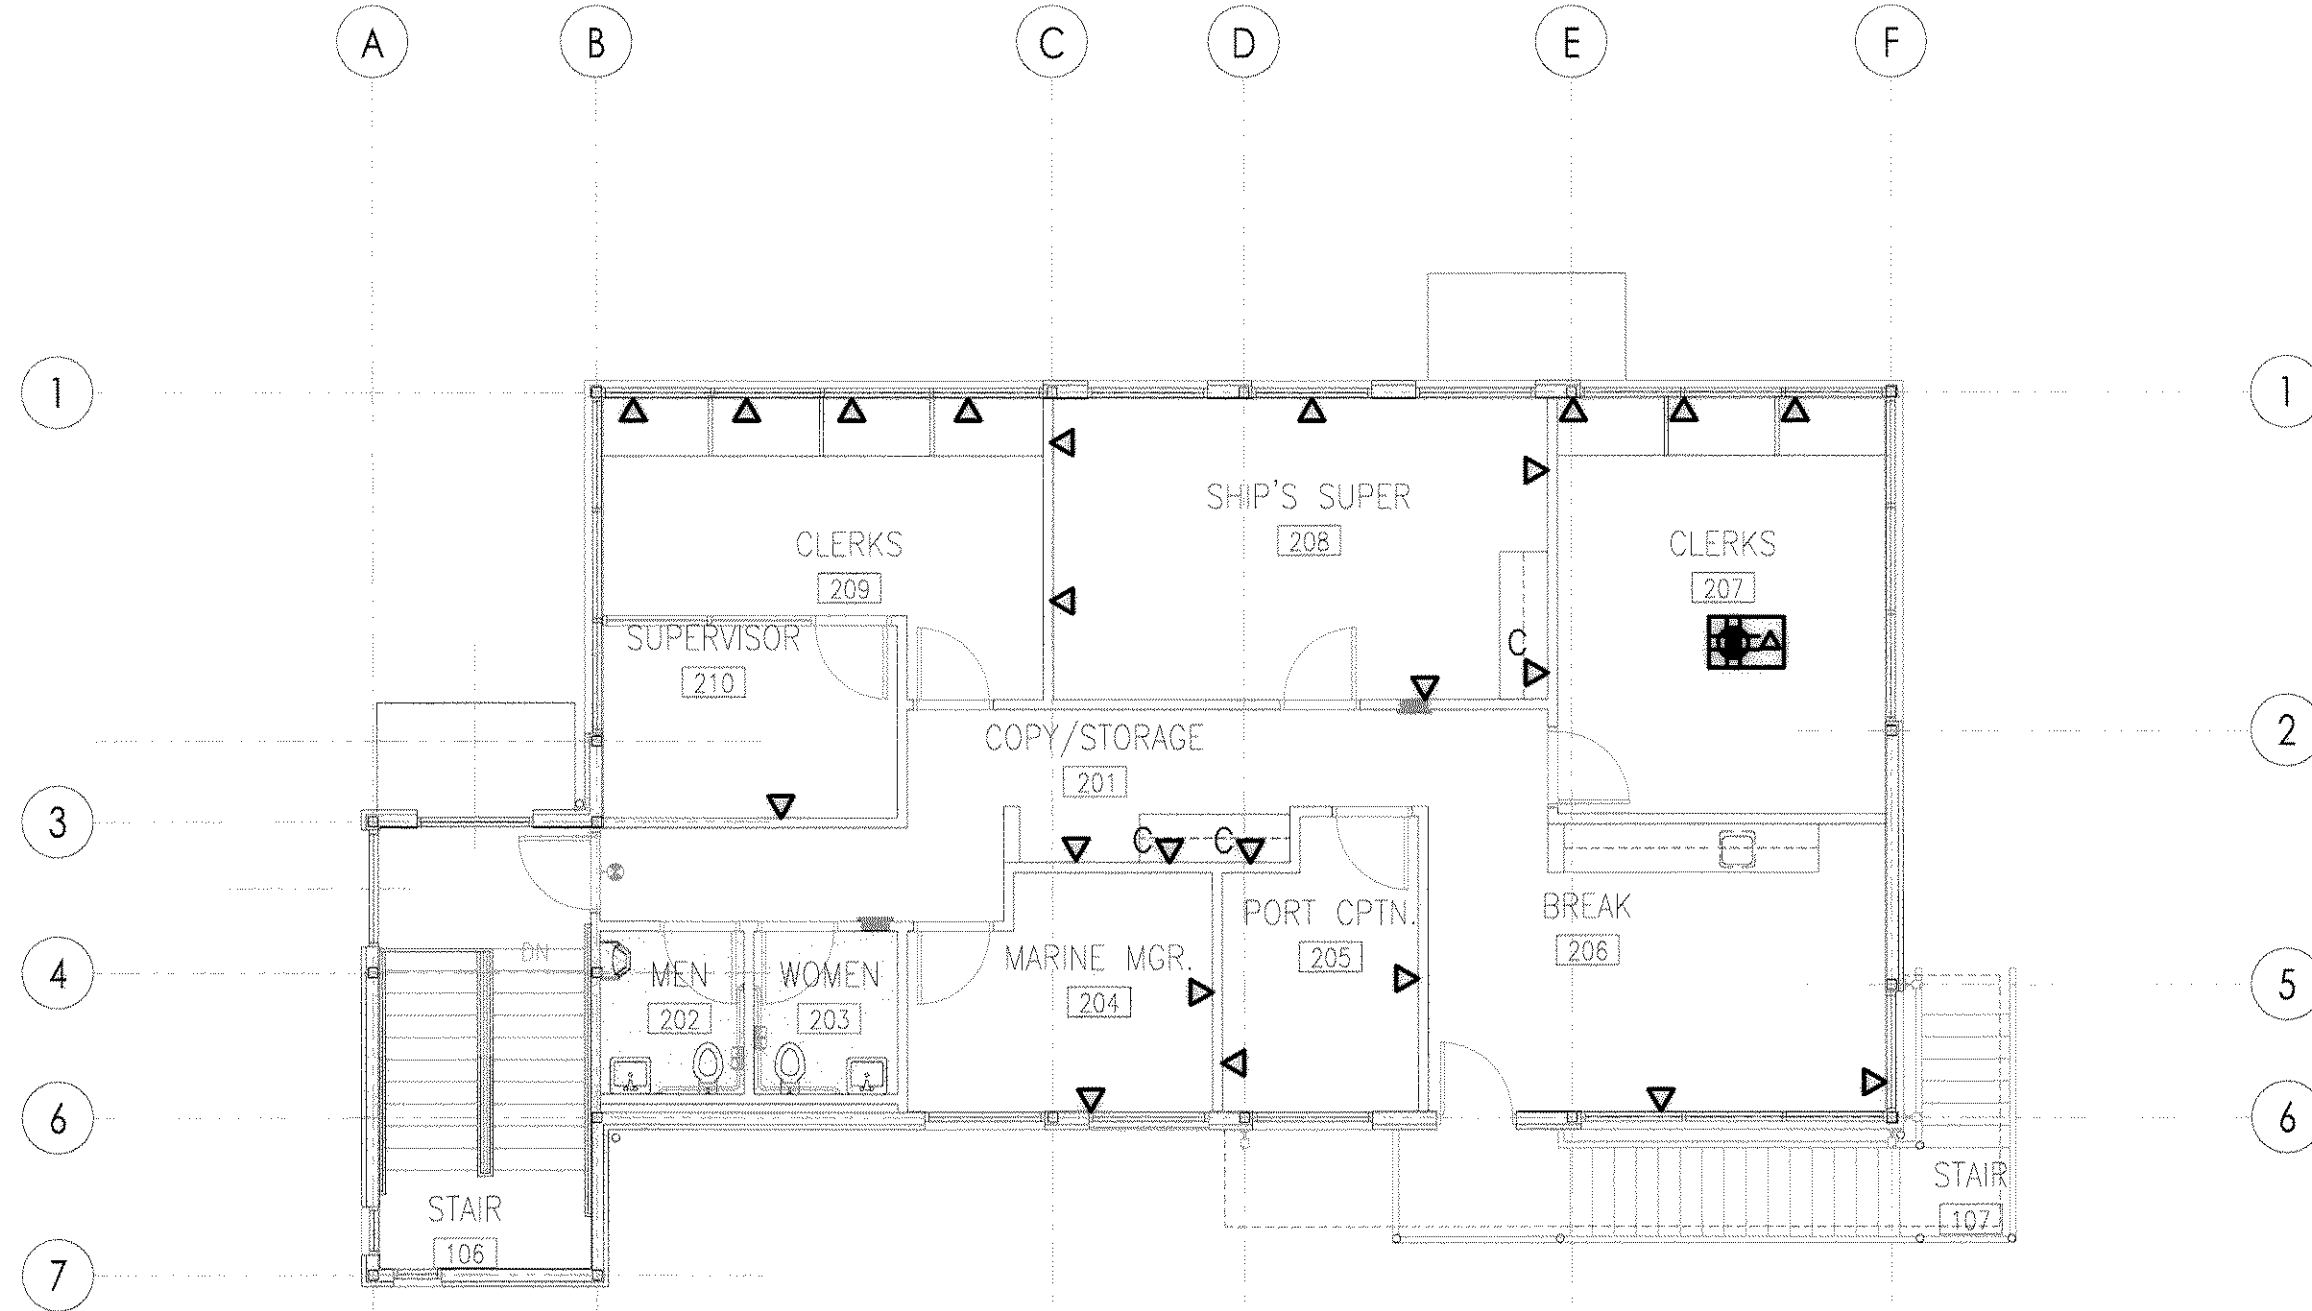

2 SECOND FLOOR SYSTEMS PLAN
SCALE: 1/8"=1'-0" BMW xfp_marine-23003.dwg

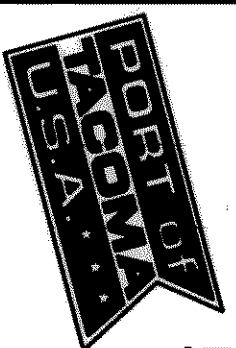

PORT OF TACOMA P.O. BOX 1887
TACOMA, WA 98401 253-883-6841



6021 12th street east
suite 201
tacoma, wa 98424
tel: 253 . 922 . 9037
fax: 253 . 922 . 6499

MARK	REVISION	BY:	DATE:
RECORD DRAWINGS			


APPROVED

PORT OF TACOMA
PIERCE COUNTY TERMINAL
MARINE BUILDING
PANEL SCHEDULES

EP-6661-17

E3.400

6321-17

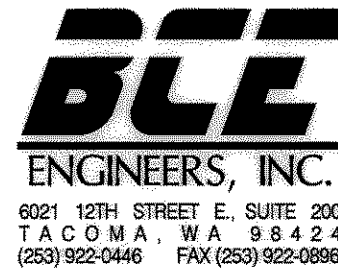


6021 12TH STREET E., SUITE 200
TACOMA, WA 98424
(253) 922-0446 FAX (253) 922-0886

PANEL 3C1												100A MAIN LUGS ONLY			
3 4 WIRE 120/208 VOLTS															
SURFACE MOUNT												42 POLES			
												BOTTOM FEED			
												10,000 AIC MIN			
LOAD	CIRCUIT DIRECTORY	CIR. NO.	CIRC. BRKR.	A	B	C	CIR. BRKR.	CIR. NO.	CIRCUIT DIRECTORY	LOAD					
800	COMP. RECEPT.	1	1P-20A	•			1P-20A	2	COMP. RECEPT.	1200					
800	COMP. RECEPT.	3	1P-20A	•			1P-20A	4	COMP. RECEPT.	1200					
1200	COMP. RECEPT.	5	1P-20A	•			1P-20A	6	COMP. RECEPT.	800					
800	COMP. RECEPT.	7	1P-20A	•			1P-20A	8	COMP. RECEPT.	800					
800	COMP. RECEPT.	9	1P-20A	•			1P-20A	10	COMP. RECEPT.	800					
800	COMP. RECEPT.	11	1P-20A	•			1P-20A	12	COMP. RECEPT.	800					
800	COMP. RECEPT.	13	1P-20A	•			1P-20A	14	COMP. RECEPT.	800					
1200	COMP. RECEPT.	15	1P-20A	•			1P-20A	16	COMP. RECEPT.	800					
800	COMP. RECEPT.	17	1P-20A	•			1P-20A	18	COMP. RECEPT.	800					
800	COMP. RECEPT.	19	1P-20A	•			1P-20A	20	SPARE						
800	COMP. RECEPT.	21	1P-20A	•			1P-20A	22	SPARE						
	SPARE	23	1P-20A	•			1P-20A	24	SPARE						
	SPARE	25	1P-20A	•				26							
	SPARE	27	1P-20A	•				28							
	SPARE	29	1P-20A	•				30							
		31		•				32							
		33		•				34							
		35		•				36							
		37		•			3P	38	PANEL 3C1	17600					
		39		•				40							
		41		•			100A	42							
9600	TOTAL VA= 17,600 DIVERSITY % DEMAND VA= 17,600								CURRENT 49 AMPS						8000
									DEMAND CURRENT 49 AMPS						

PANEL 3P2												400A MAIN LUGS ONLY			
3 4 WIRE 120/208 VOLTS															
SURFACE MOUNT												42 POLES			
												BOTTOM FEED			
												10,000 AIC MIN			
LOAD	CIRCUIT DIRECTORY	CIR. NO.	CIRC. BRKR.	A	B	C	CIR. BRKR.	CIR. NO.	CIRCUIT DIRECTORY	LOAD					
	SPARE	1	1P-20A	•			1P-20A	2	RECEPT	1000					
	SPARE	3	1P-20A	•			1P-20A	4	RECEPT	1000					
	SPARE	5	1P-20A	•			1P-20A	6	RECEPT	1000					
900	RECEPT	7	1P-20A	•			1P-20A	8	RECEPT - MICROWAVE	1000					
900	RECEPT	9	1P-20A	•			1P-20A	10	RECEPT - MICROWAVE	1000					
900	RECEPT	11	1P-20A	•			1P-20A	12	RECEPT - MICROWAVE	1000					
500	VENDING MACHINE	13	1P-20A	•			1P-20A	14	RECEPT - MICROWAVE	1000					
500	VENDING MACHINE	15	1P-20A	•			1P-20A	16	RECEPT - MICROWAVE	1000					
500	VENDING MACHINE	17	1P-20A	•			1P-20A	18	RECEPT - MICROWAVE	1000					
500	TIMECLOCK/PHOTOCELL	19	1P-20A	•			2P	20	EWB-3A	1125					
500	VENDING MACHINE	21	1P-20A	•			20A	22							
		23	1P-20A	•				24							
		25	1P-20A	•				26							
		27	1P-20A	•				28							
		29	1P-20A	•				30							
		31	1P-20A	•				32							
		33	1P-20A	•				34							
		35	1P-20A	•				36							
		37	1P-20A	•			3P	38	PANEL 3C1	17600					
		39	1P-20A	•				40							
		41	1P-20A	•			100A	42							
5700	TOTAL VA= 33,425 DIVERSITY % DEMAND VA= 29,525								CURRENT 93 AMPS						27725
									DEMAND CURRENT 82 AMPS						

PANEL 3P1												400A MAIN BREAKER			
3 4 WIRE 120/208 VOLTS															
SURFACE MOUNT												42 POLES			
												BOTTOM FEED			
												10,000 AIC MIN			
LOAD	CIRCUIT DIRECTORY	CIR. NO.	CIRC. BRKR.	A	B	C	CIR. BRKR.	CIR. NO.	CIRCUIT DIRECTORY	LOAD					
13400	CU-3A	7	3P	•			3P	2							
		9		•				4	HP-3A	37260					
		11	60A	•			125A	6							
1389	RECEPT	13	1P-20A	•			1P-20A	8	EF-3A, EF-3B, EF-3C, EF-3D	564					
268	RECEPT	15	1P-20A	•			1P-20A	10	CP-3A	500					
	SPARE	17	1P-20A	•			3P	12	HP-3B	11425					
900	RECEPT	19	1P-20A	•				14							
720	RECEPT	21	1P-20A	•			40A	16							
720	RECEPT	23	1P-20A	•			3P	18	HP-3C	11425					
900	RECEPT	25	1P-20A	•				20							
1080	RECEPT	27	1P-20A	•			40A	22							
900	RECEPT	29	1P-20A	•			2P	24	HWT-3A	6000					
500	RECEPT	31	1P-20A	•			40A	26							
500	RECEPT	33	1P-20A	•				28	SPACE						
500	RECEPT	35	1P-20A	•			3P	30	CU-3B	9000					
720	RECEPT	37	1P-20A	•				32							
540	RECEPT	39	1P-20A	•			30A	34							
720	RECEPT	41	1P-20A	•			3P	36	CU-3C	9000					
1416	LIGHTING - 1ST FLOOR	1	1P-20A	•				38							
249	LIGHTING - 1ST FLOOR	3	1P-20A	•			30A	40							
1148	LIGHTING-2ND FLOOR	5	1P-20A	•			1P-20A	42	SPARE						
26570	TOTAL VA= 111,744 DIVERSITY % DEMAND VA= 115,619								CURRENT 310 AMPS						85174
									DEMAND CURRENT 321 AMPS						

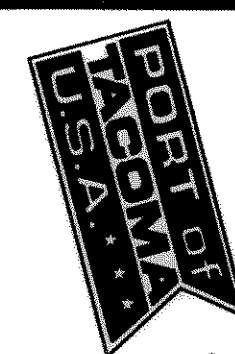

PORT OF TACOMA
TACOMA, WA 98401 253-383-6841



4021 12th Street East
Suite 201
Tacoma, WA 98424
Tel: 253.922.9037
Fax: 253.922.6499

APPROVED

CHIEF ENGINEER - DATE

LC 8/22/03

CHECKED BY - DATE

PROJECT ENGR - DATE

PORT OF TACOMA
PIERCE COUNTY TERMINAL
SITE DETAILS

EP-1 6321-17

A7.600
SHEET 217 OF 230

DRAWING DATE: 12/20/04

PORT ADDRESS:

PORT PARCEL:

TOWNSHIP: RANGE: SECTION:

DUTY: FOR:


DRAWING SCALE: 1-1/2" = 1'-0"

CONTRACT NUMBER: 988154

E NUMBER: E1974

PHASE: RECORD DRAWING

			4 DELETED SCALE: 1-1/2" = 1'-0" PC E1974A7.DT.0
1 CURB DETAIL SCALE: 1-1/2" = 1'-0" PC E1974A7.DT.0	2 SIDEWALK EDGE SCALE: 1-1/2" = 1'-0" PC E1974A7.DT.0	3 ENL'GED PLAN FLAG POLES SCALE: 1/8" = 1'-0" PC E1974A7.DT.0	
5 TEXTURE SIDEWALK SCALE: 1/4" = 1'-0" PC E1974A7.DT.0	6 GUARDRAIL SCALE: 1/2" = 1'-0" PC E1974A7.DT.0	7 BOLLARD - TYPE 3 SCALE: 1/4" = 1'-0" PC E1974A7.DT.0	8 BOLLARD - TYPE 1 SCALE: 1/4" = 1'-0" PC E1974A7.DT.0
9 ENTRANCE APRON SCALE: 1-1/2" = 1'-0" PC E1974A1.DT.0	10 SIDEWALK EDGE @ GRADE SCALE: 1-1/2" = 1'-0" PC E1974A1.DT.1	11 FLAG POLE BASE SCALE: 1-1/2" = 1'-0" PC E1974A1.DT.0	12 CONTROL JOINT SCALE: 1-1/2" = 1'-0" PC E1974A7.DT.0
13 DELETED SCALE: 1-1/2" = 1'-0" PC E1974A1.DT.1	14 DELETED SCALE: 1-1/2" = 1'-0" PC E1974A1.DT.1	15 DELETED SCALE: 1/2" = 1'-0" PC E1974A1.DT.1	16 EXPANSION JOINT SCALE: 1-1/2" = 1'-0" PC E1974A7.DT.0

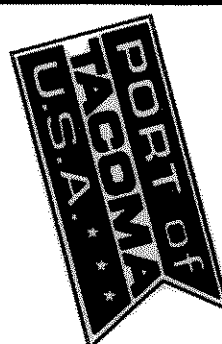

PORT OF TACOMA P.O. BOX 1837
TACOMA, WA 98401 253-383-6841



Heitz Engineering & Construction, Inc.
 6021 12th Street East
 Suite 201
 Tacoma, WA 98424
 Tel: 253.922.9037
 Fax: 253.922.6499

APPROVED

CHIEF ENGINEER - DATE


LC 8/22/03
 CHECKED BY - DATE
 LC 8/22/03
 PROJECT ENGR. - DATE


PORT OF TACOMA
PIERCE COUNTY TERMINAL
EXTERIOR WALL DETAILS









EP-6321-17

SHEET 218 OF 230
A7.601

CONTRACT NUMBER: 980154
 E NUMBER: E1974
 PHASE: RECORD DRAWING

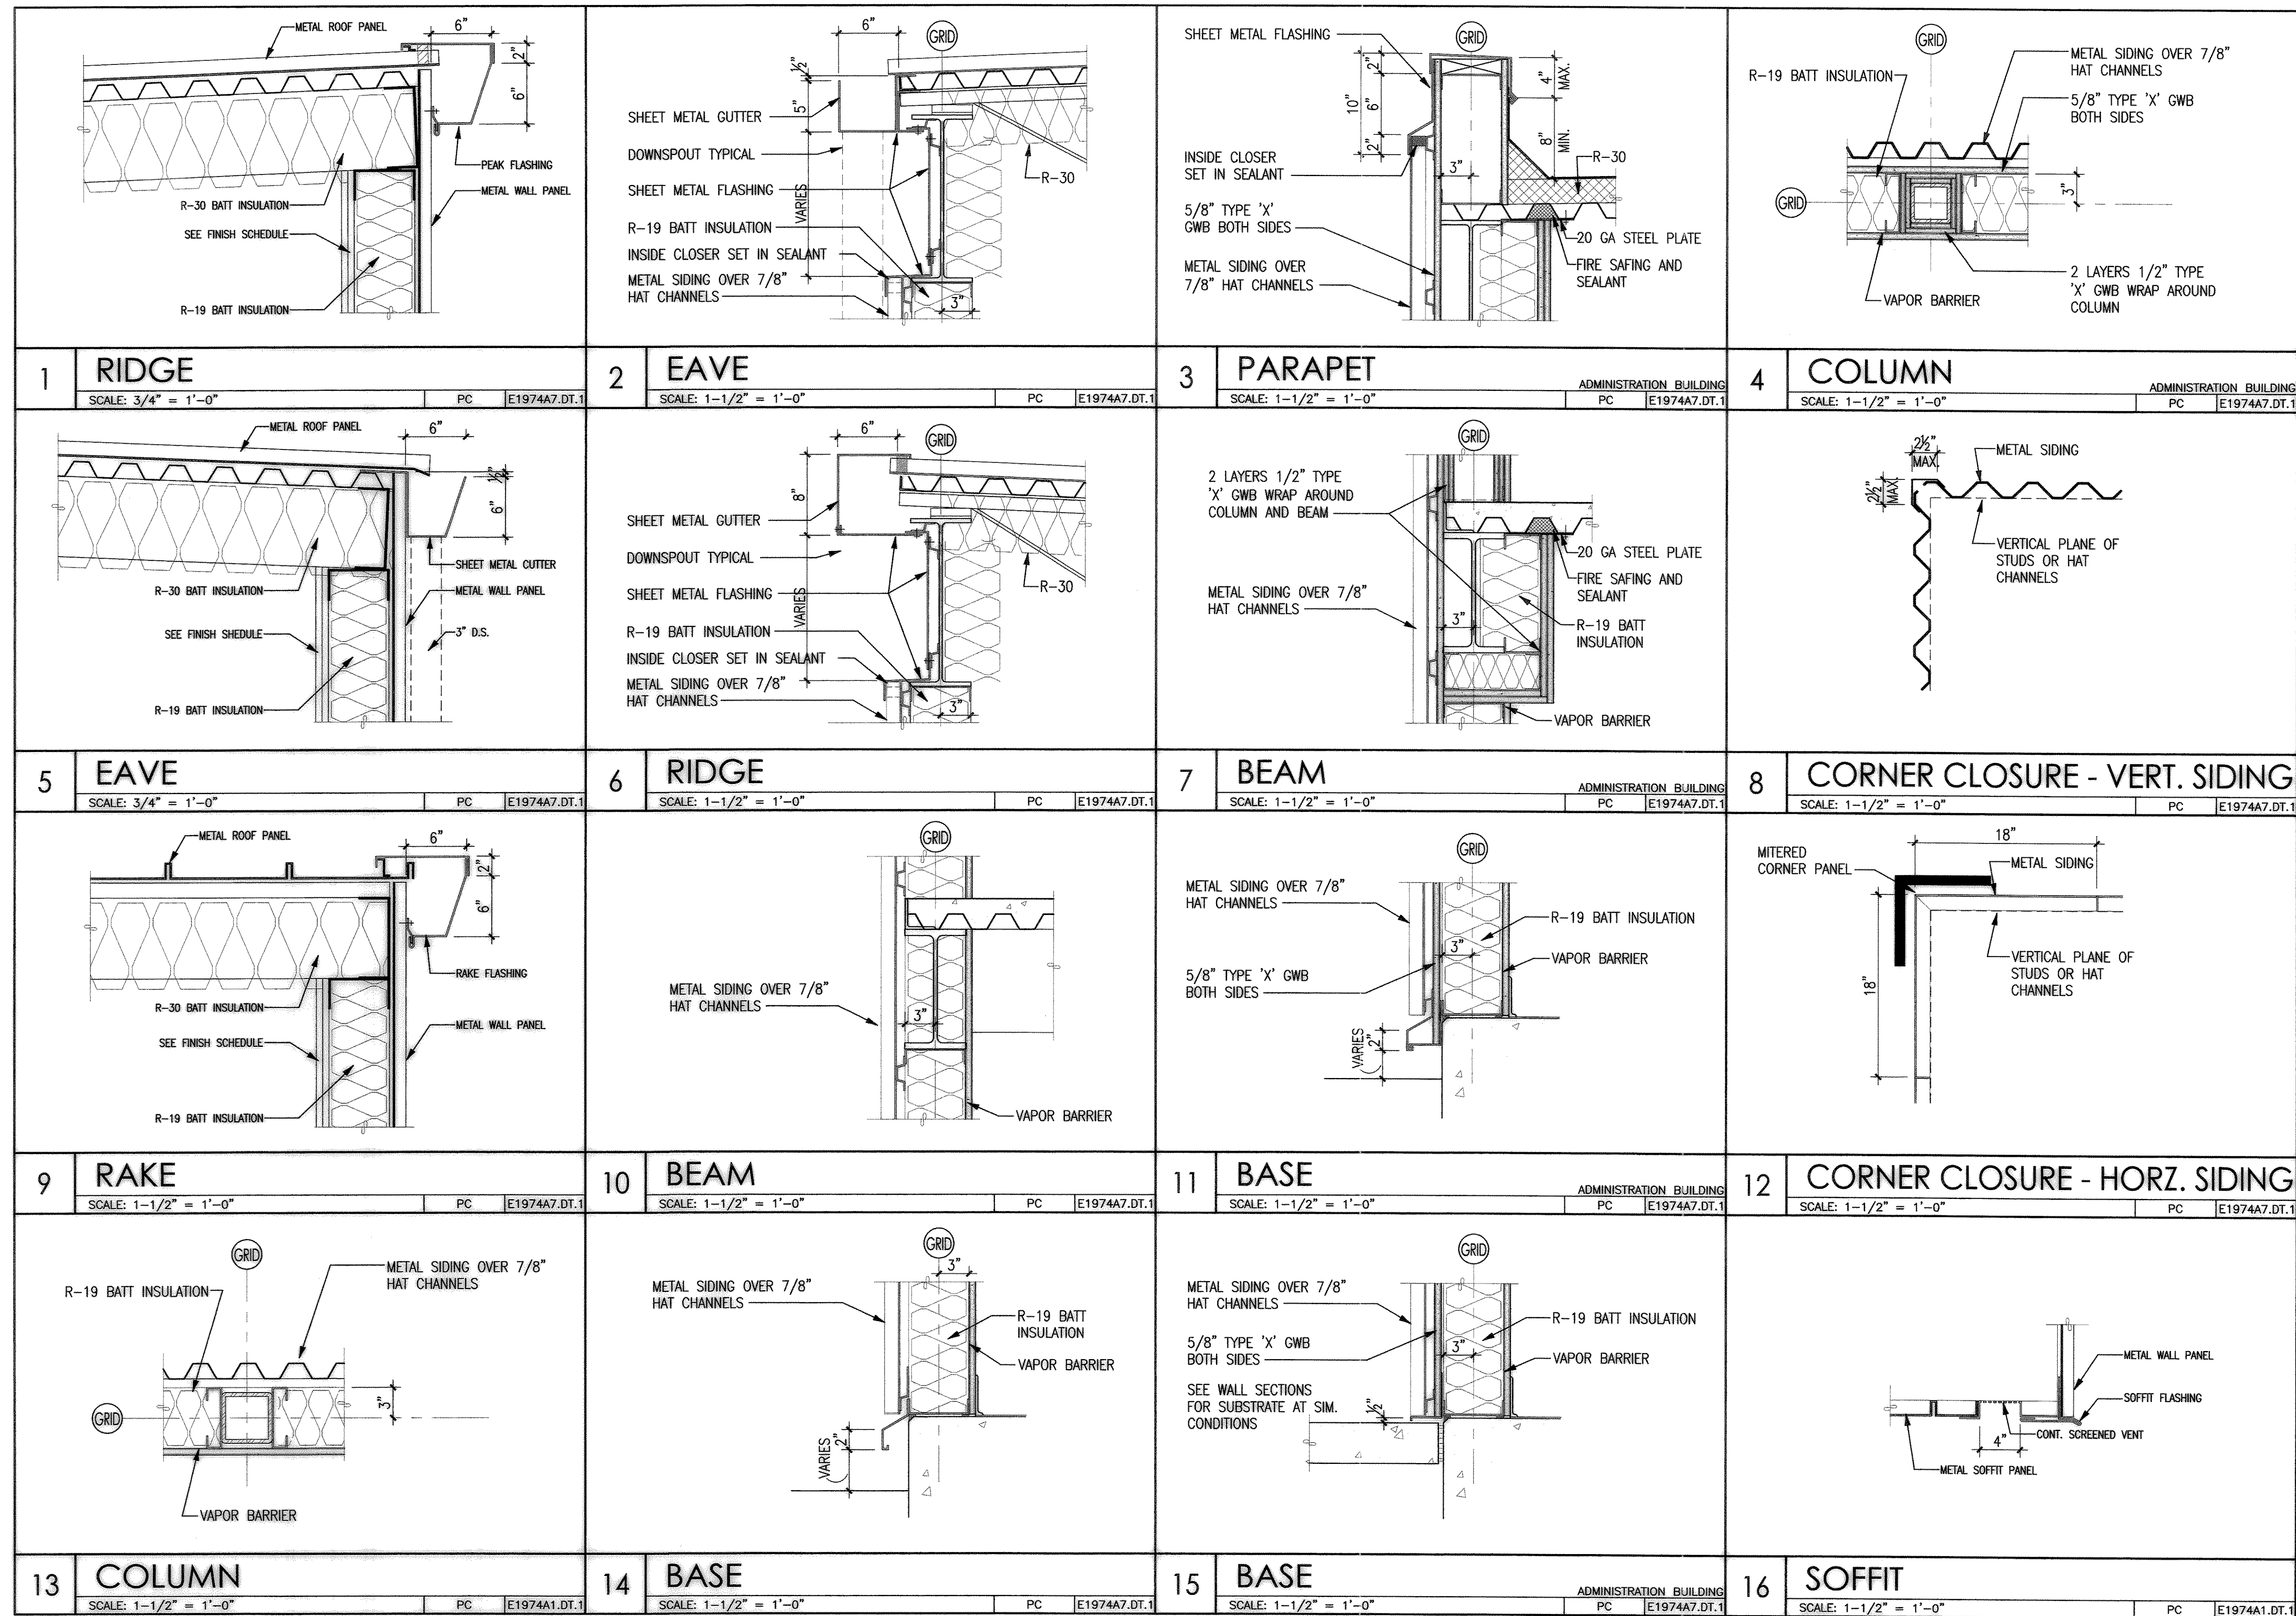


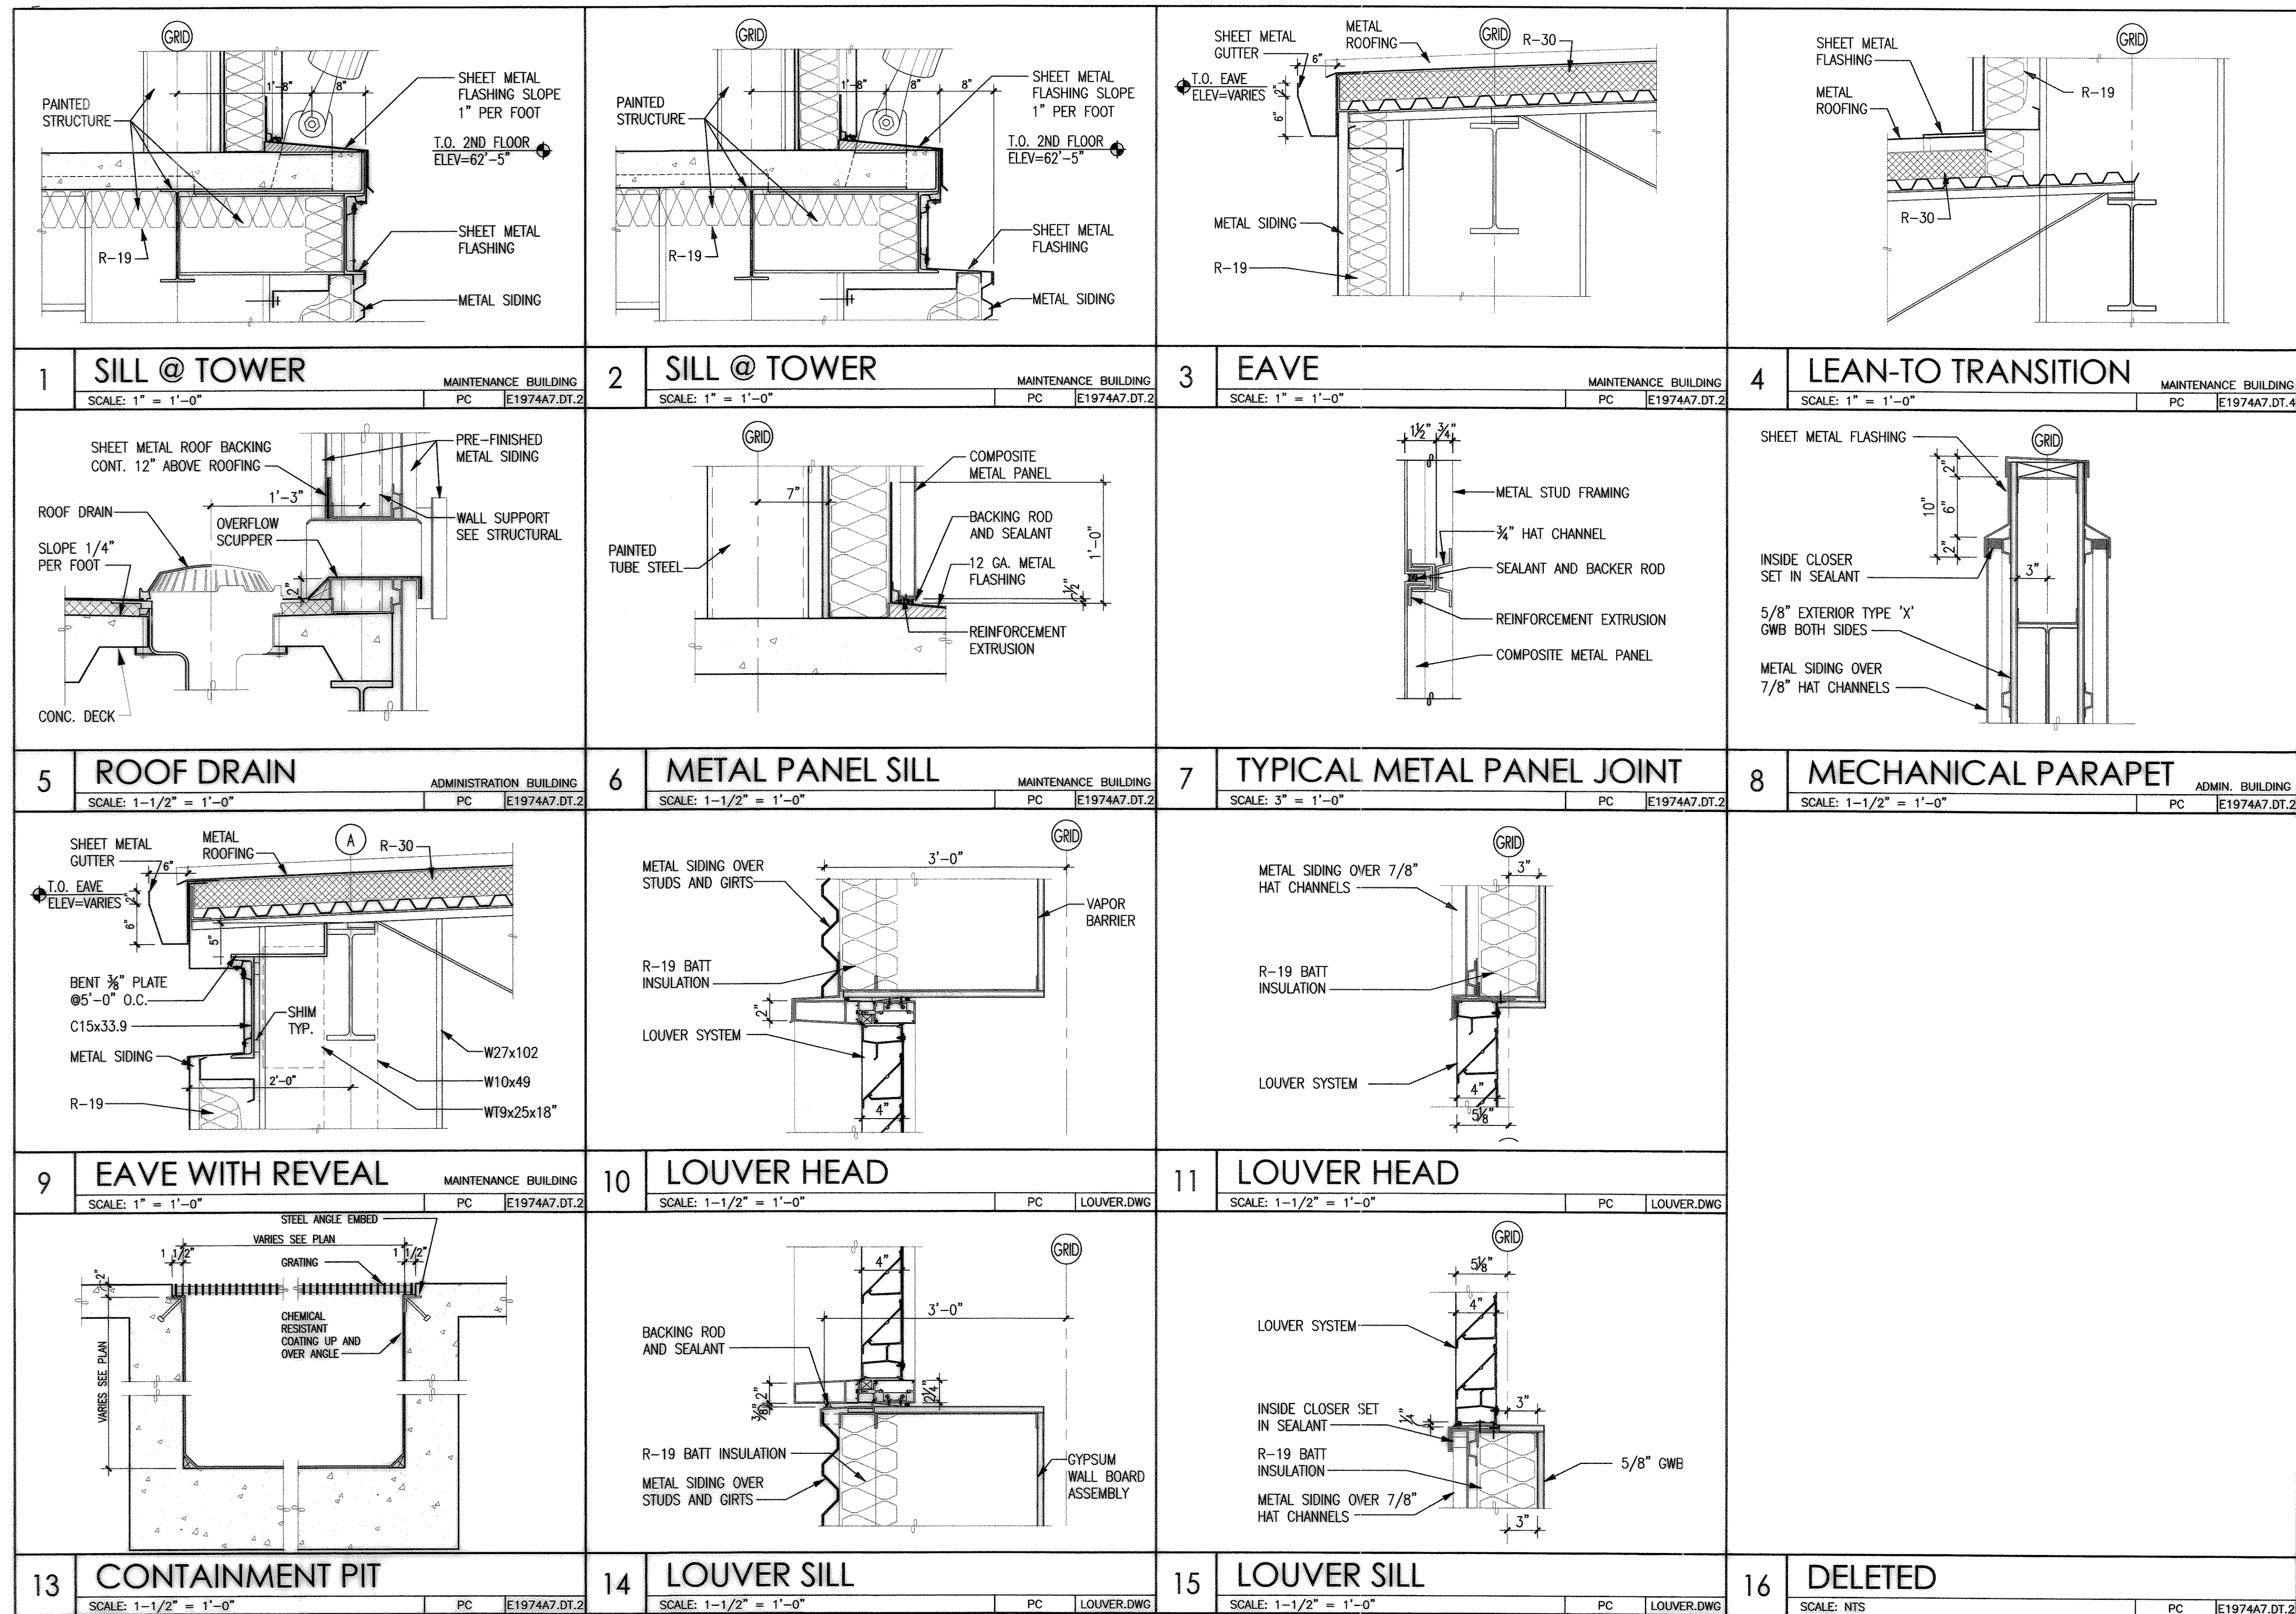

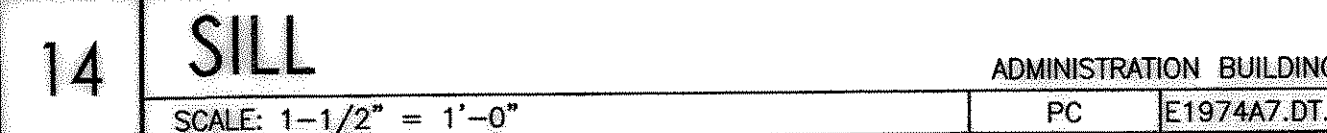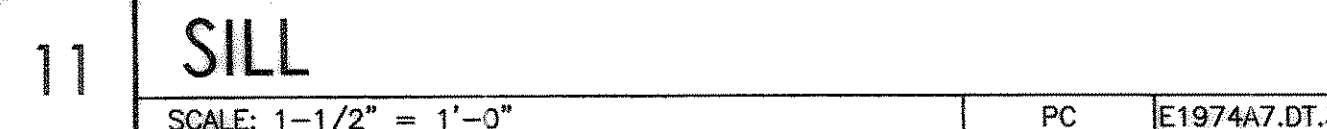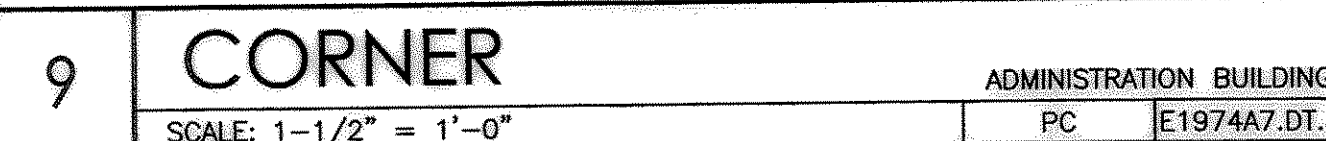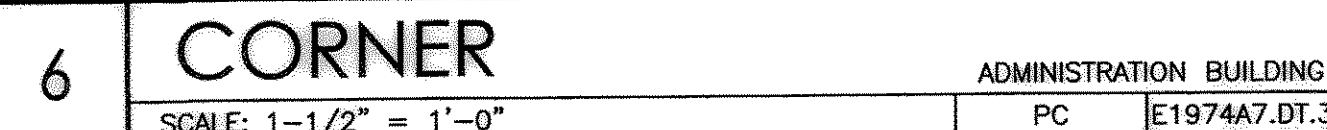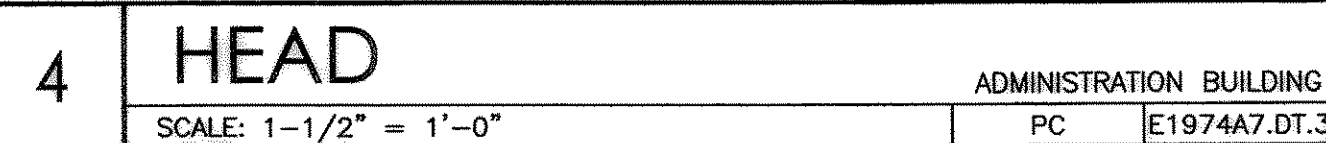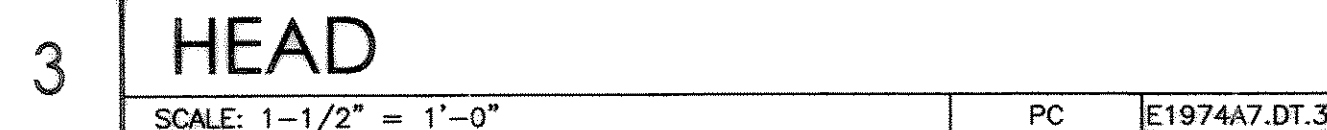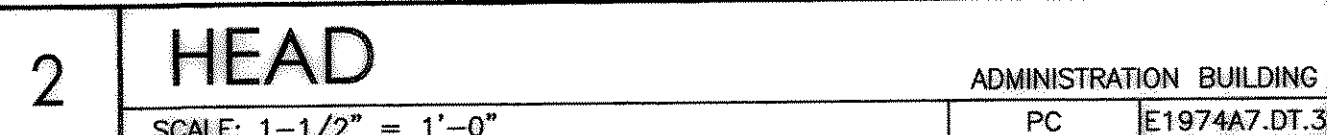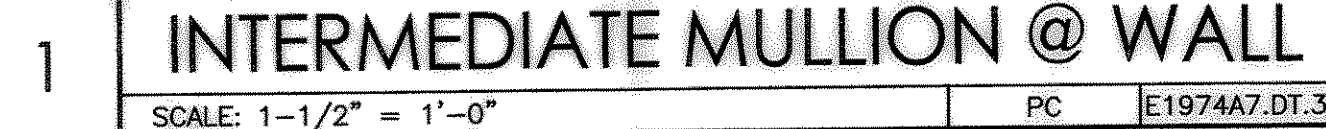

DELETED

15	DELETED		
	SCALE: 1-1/2" = 1'-0"	PC	E1974A7.DT

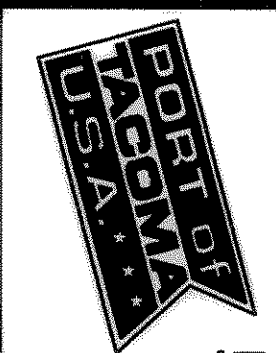


PORT OF TACOMA
TACOMA, WA 98401
253-383-6841
 6021 12th Street East
 Tacoma, WA 98404
 Tel: 253.922.9037
 Fax: 253.922.6499

APPROVED
 CHIEF ENGINEER - DATE
 DRAWING DATE: 12/20/04
 PORT ADDRESS:
 PORT PARCEL:

LC
 CHECKED BY - DATE
 PROJECT ENGR - DATE
 TOWNSHIP: RANGE:
 DATUM: HORIZ. VERT.
 DRAWING SCALE: 1-1/2" = 1'-0"

PORT OF TACOMA
PIERCE COUNTY TERMINAL
WINDOW & STORE FRONT DETAILS
SHEET 221 OF 230
A7.604
 CONTRACT NUMBER: 980154
 E NUMBER: E1974
 PHASE: RECORD DRAWING

1 TOWER SOFFIT PANELS MAINT. BLDG. SCALE: 1-1/2" = 1'-0" PC E1974A7.DT.4	2 EAVE MAINT. BLDG. SCALE: 1" = 1'-0" PC E1974A7.DT.4	3 WINDOW HEAD MAINT. BLDG. SCALE: 1-1/2" = 1'-0" PC E1974A7.DT.4	4 TRANSOM HEAD ADMIN. BLDG. SCALE: 1-1/2" = 1'-0" PC E1974A7.DT.4
5 TOWER STAIR ROOF TRANSITION MAINT. BLDG. SCALE: 1-1/2" = 1'-0" PC E1974A7.DT.4	6 VERTICAL MULLION MAINT. BLDG. SCALE: 1-1/2" = 1'-0" PC E1974A7.DT.4	7 INTERMEDIATE HORIZONTAL MULLION MAINT. BLDG. SCALE: 1-1/2" = 1'-0" PC E1974A7.DT.4	8 STOREFRONT ADMIN. BLDG. SCALE: 1-1/2" = 1'-0" PC E1974A7.DT.4
9 SLIDING WINDOW HEAD GUARD SHACK SCALE: 1-1/2" = 1'-0" PC E1974A7.DT.4	10 WINDOW HEAD MAINT. BLDG. SCALE: 1-1/2" = 1'-0" PC E1974A7.DT.4	11 CORNER MULLION MAINT. BLDG. SCALE: 1-1/2" = 1'-0" PC E1974A7.DT.4	12 STOREFRONT SIDELIGHT ADMIN. BLDG. SCALE: 1-1/2" = 1'-0" PC E1974A7.DT.4
13 SLIDING WINDOW SILL GUARD SHACK SCALE: 1-1/2" = 1'-0" PC E1974A7.DT.4	14 WINDOW SILL MAINT. BLDG. SCALE: 1-1/2" = 1'-0" PC E1974A7.DT.4	15 SILL @ METAL PANEL MAINT. BLDG. SCALE: 1-1/2" = 1'-0" PC E1974A7.DT.4	16 STOREFRONT HEAD ADMIN. BLDG. SCALE: 1-1/2" = 1'-0" PC E1974A7.DT.4

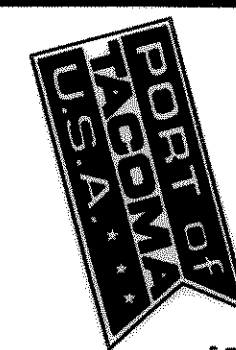

PORT OF TACOMA
TACOMA, WA 98401
P.O. BOX 1837
253-383-5841



6021 12th Street East
Tacoma, WA 98401
Tel: 253.922.6493
Fax: 253.922.6499

APPROVED

CHIEF ENGINEER - DATE

LC 8/22/03

CHECKED BY - DATE
LC 8/22/03

PROJECT ENGR - DATE

PORT OF TACOMA
PIERCE COUNTY TERMINAL
OVERHEAD & HM DOOR DETAILS

EP. 6321-17

A7.605
SHEET 222 OF 230


RECORD DRAWING


DRAWING DATE: 12/20/04

TOWNSHIP: RANGE: SECTION:



CONTRACT NUMBER: 998154
DATE: 08/22/03
PHASE: RECORD DRAWING

HEAD SIM.			
1 WOOD DOOR - INTERIOR JAMB SCALE: 1-1/2" = 1'-0" PC E1974A7.DT.5	2 HOLLOW METAL HEAD & THRESHOLD SCALE: 1-1/2" = 1'-0" PC E1974A7.DT.5	3 FABRIC DOOR MOTOR MAINT. BLDG SCALE: 1/2" = 1'-0" PC E1974A7.DT.5	4 COILING DOOR HEAD SCALE: 1/2" = 1'-0" PC E1974A7.DT.5
5 DELETED SCALE: 1-1/2" = 1'-0" PC E1974A7.DT.5			
5 DELETED SCALE: 1-1/2" = 1'-0" PC E1974A7.DT.5	6 HOLLOW METAL DOOR & JAMB SCALE: 1-1/2" = 1'-0" PC E1974A7.DT.5	7 FABRIC DOOR HEAD MAINT. BLDG SCALE: 1/2" = 1'-0" PC E1974A7.DT.5	8 COILING DOOR JAMB SCALE: 1/2" = 1'-0" PC E1974A7.DT.5
9 DELETED SCALE: 1-1/2" = 1'-0" PC E1974A7.DT.5			
9 DELETED SCALE: 1-1/2" = 1'-0" PC E1974A7.DT.5	10 ELEVATOR SILL SCALE: 1-1/2" = 1'-0" PC E1974A7.DT.5	11 FABRIC DOOR JAMB MAINT. BLDG SCALE: 1/2" = 1'-0" PC E1974A7.DT.5	12 COILING THRESHOLD SCALE: 1/2" = 1'-0" PC E1974A7.DT.5
			16 DELETED SCALE: 1-1/2" = 1'-0" PC E1974A7.DT.5
13 ELEVATOR JAMB HEAD SIM SCALE: 1-1/2" = 1'-0" PC E1974A7.DT.5	14 ELEVATOR SILL SCALE: 1-1/2" = 1'-0" PC E1974A7.DT.5	15 FABRIC DOOR THRESHOLD MAINT. BLDG SCALE: 1/2" = 1'-0" PC E1974A7.DT.5	16 DELETED SCALE: 1-1/2" = 1'-0" PC E1974A7.DT.5


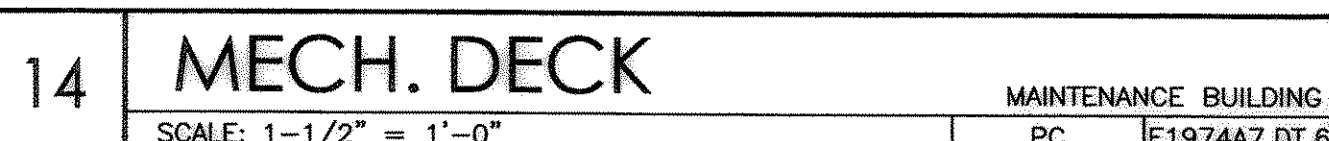


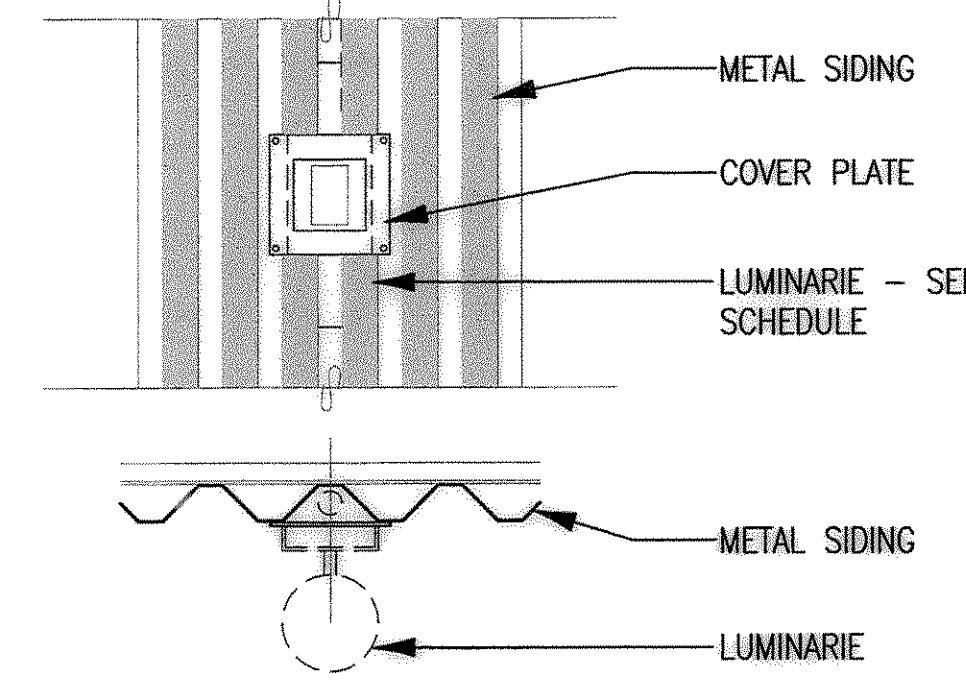



1	LUMINARE BRACKET		
	SCALE: 1-1/2" = 1'-0"	PC	E1974A7.DT.2

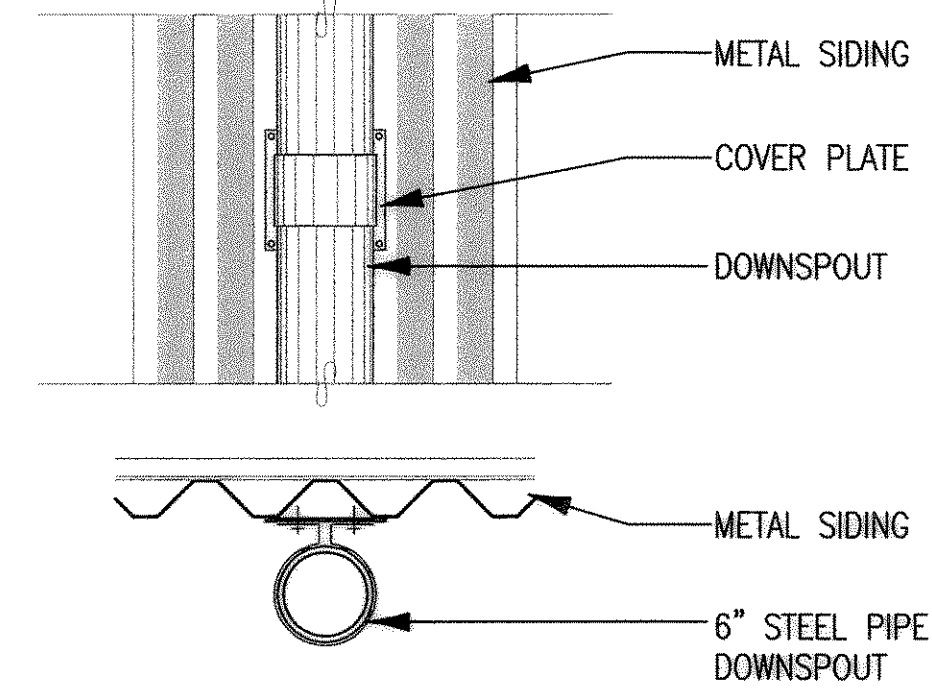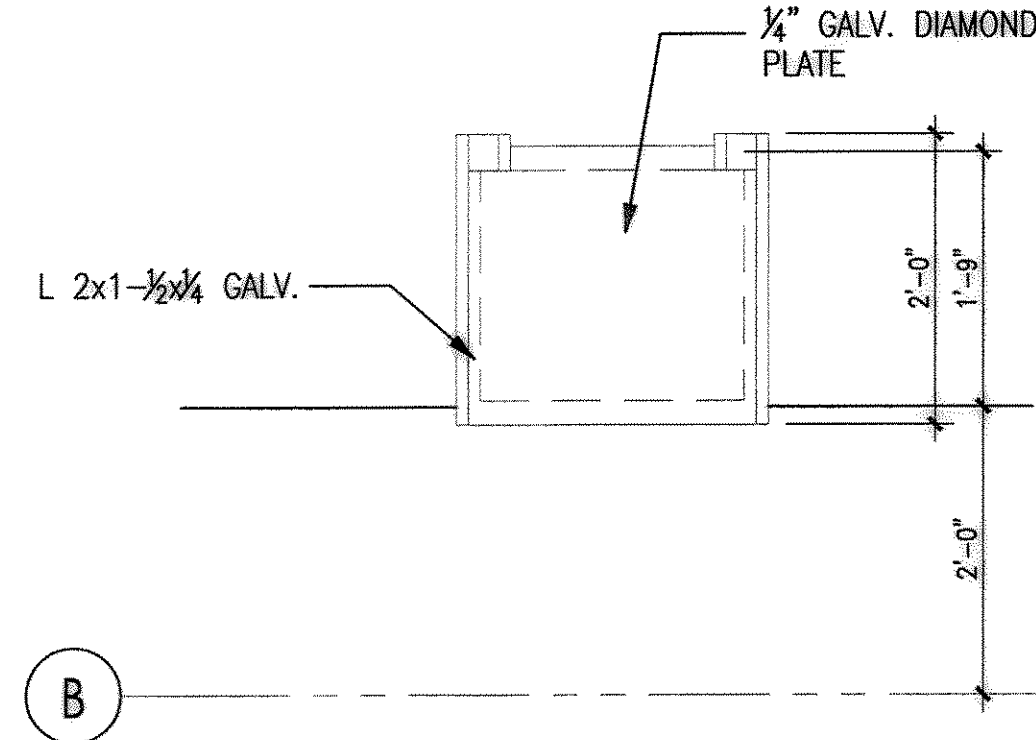


2	DOWNSPOUT BRACKET		
	SCALE: 1-1/2" = 1'-0"	PC	E1974A7.DT.2

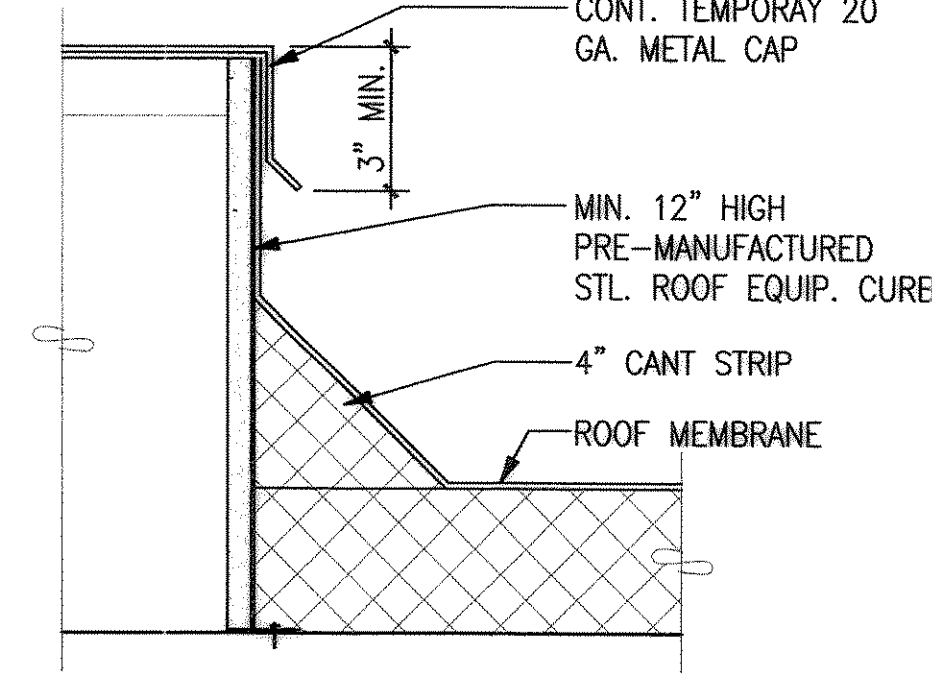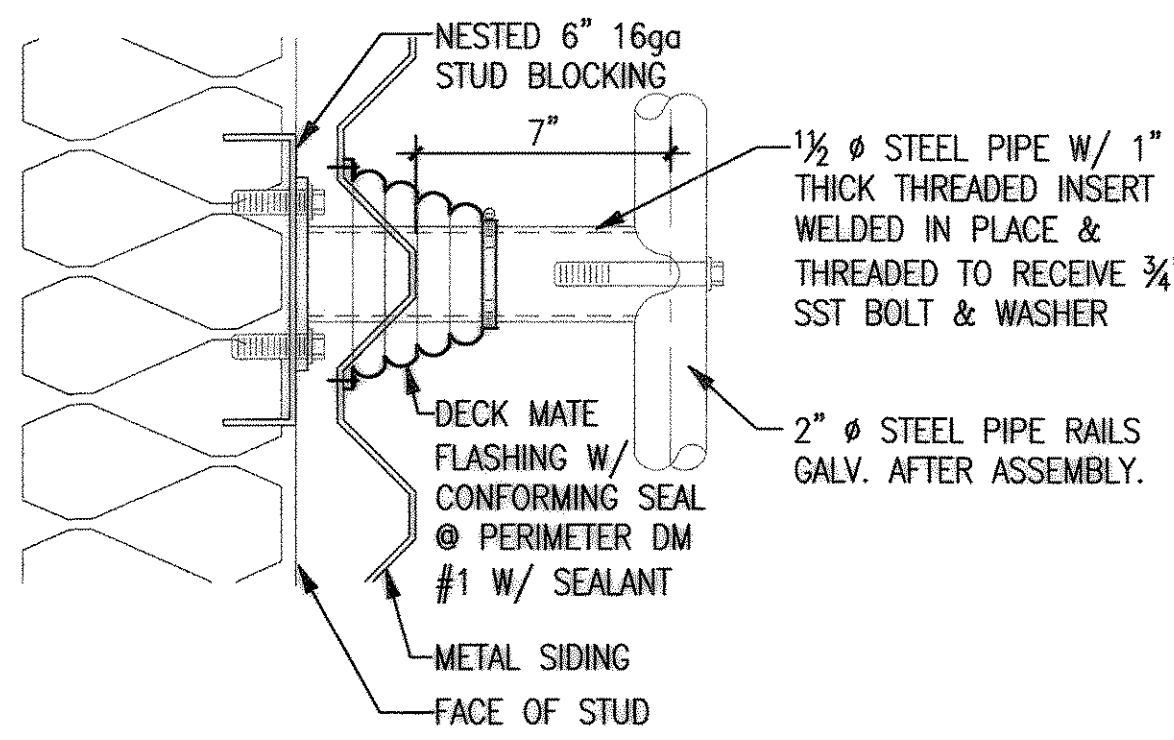


3	HVAC CURB		
	SCALE: 3" = 1'-0"	PC	E1974A7.DT.

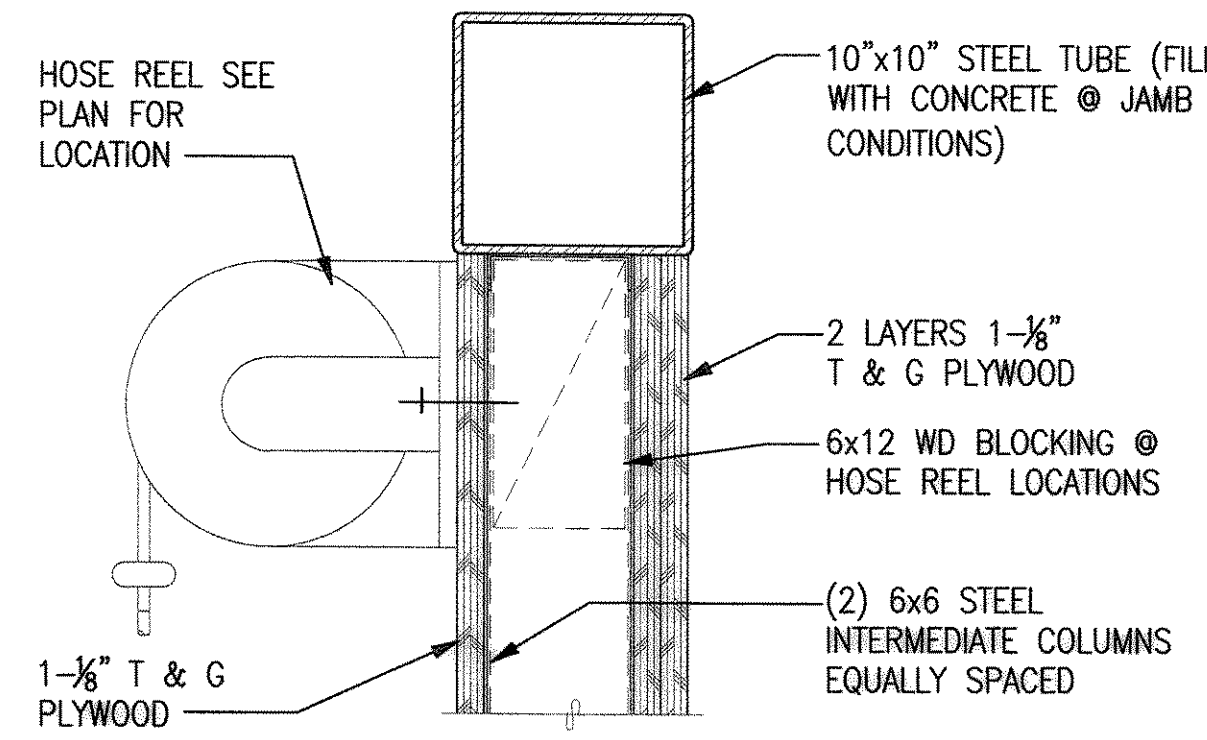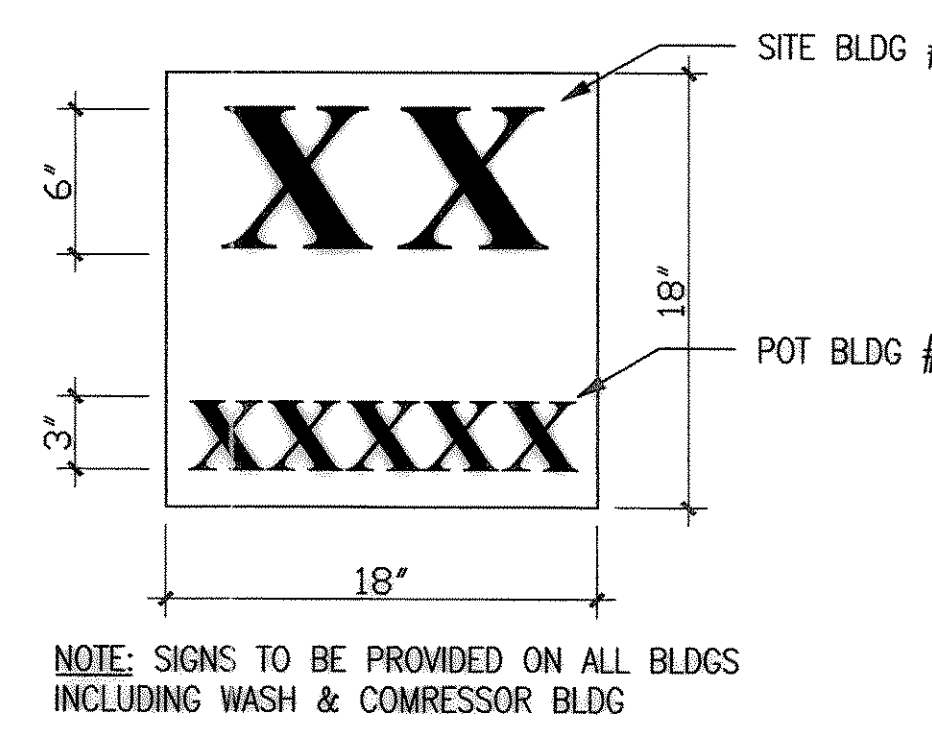

4 PARTITION WALL WITH LUBE REEL

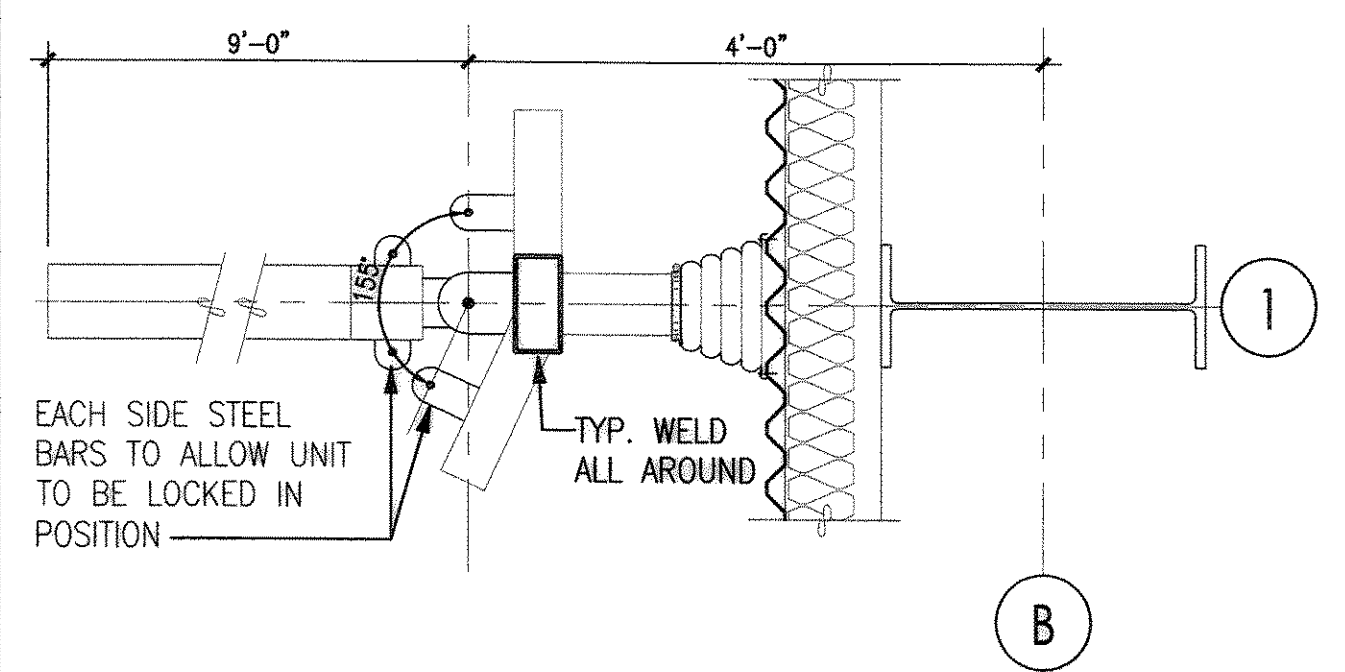


5	PLATFORM @ RIDGE		MAINT. BLDG
	SCALE: 3/4" = 1'-0"	PC	E1974A7.DT.2

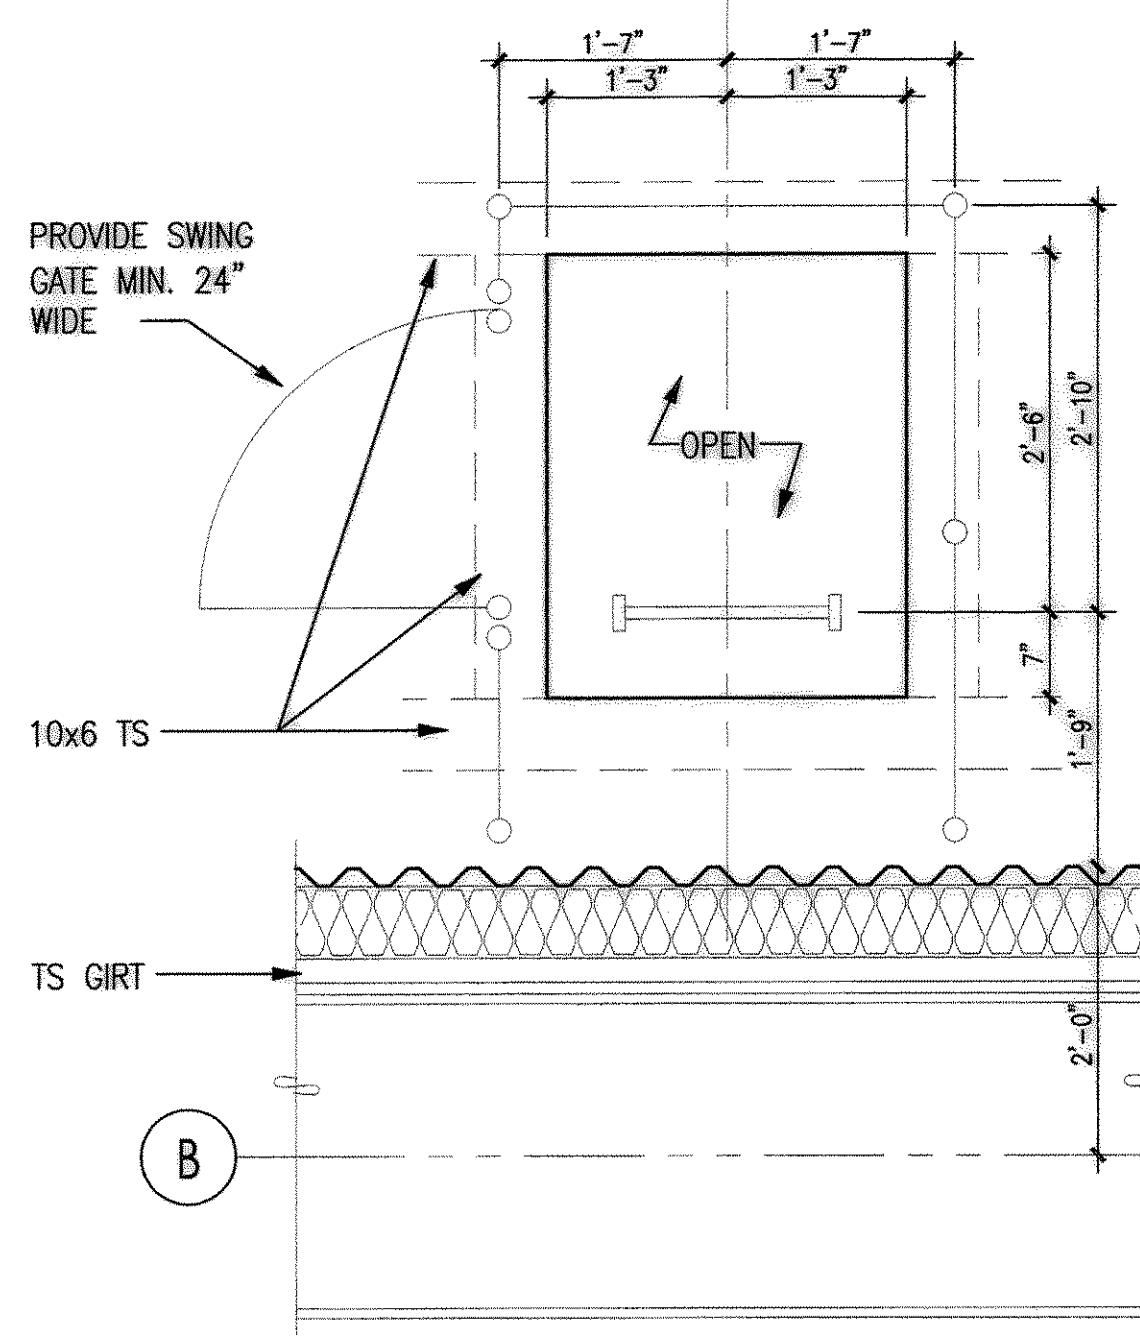


13	PLATFORM @ MECH. MEZZ.		
	SCALE: 3/4" = 1'-0"	PC	E1974A7.DT.2

6	STANDOFF DETAIL		
	SCALE: 3" = 1'-0"	PC	E1974A7.DT.2

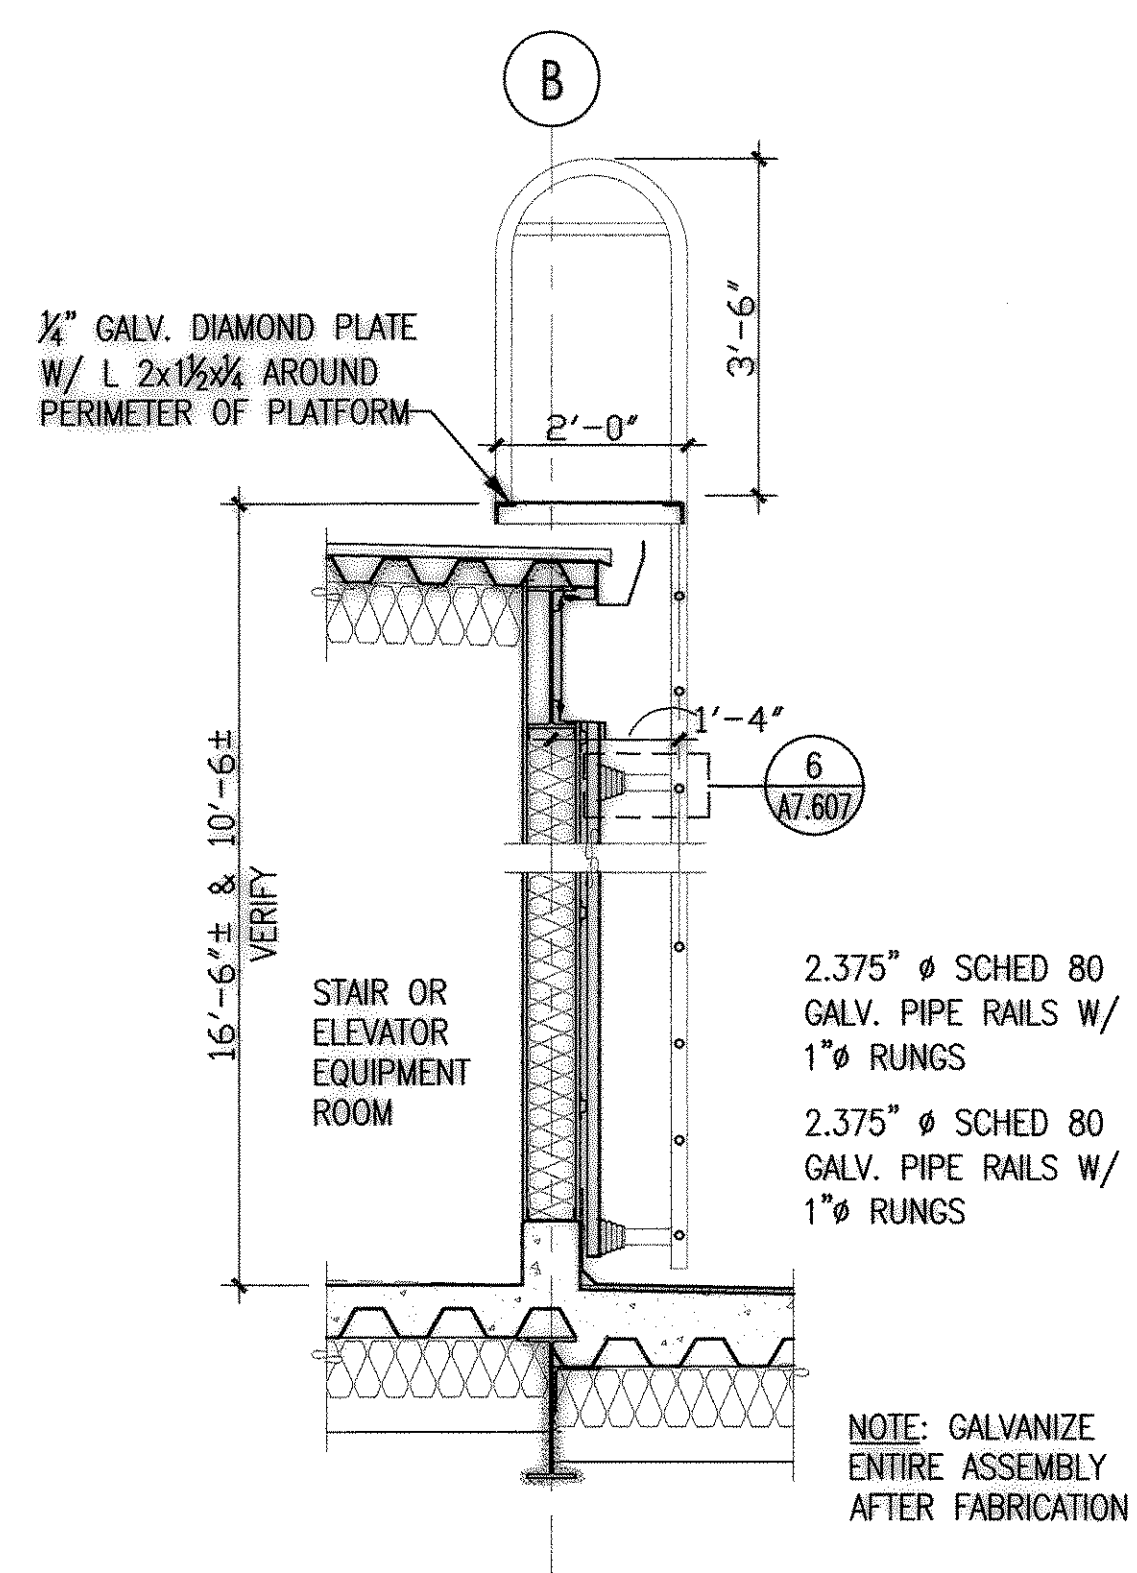


14	ROOF LADDER		ADMIN. BLDG	
	SCALE: 1/2" = 1'-0"	PC	E1974A7.DT.2	

7	BLDG. SIGNS		
	SCALE: 1'-1/2" = 1'-0"	PC	E1974A7.DT.

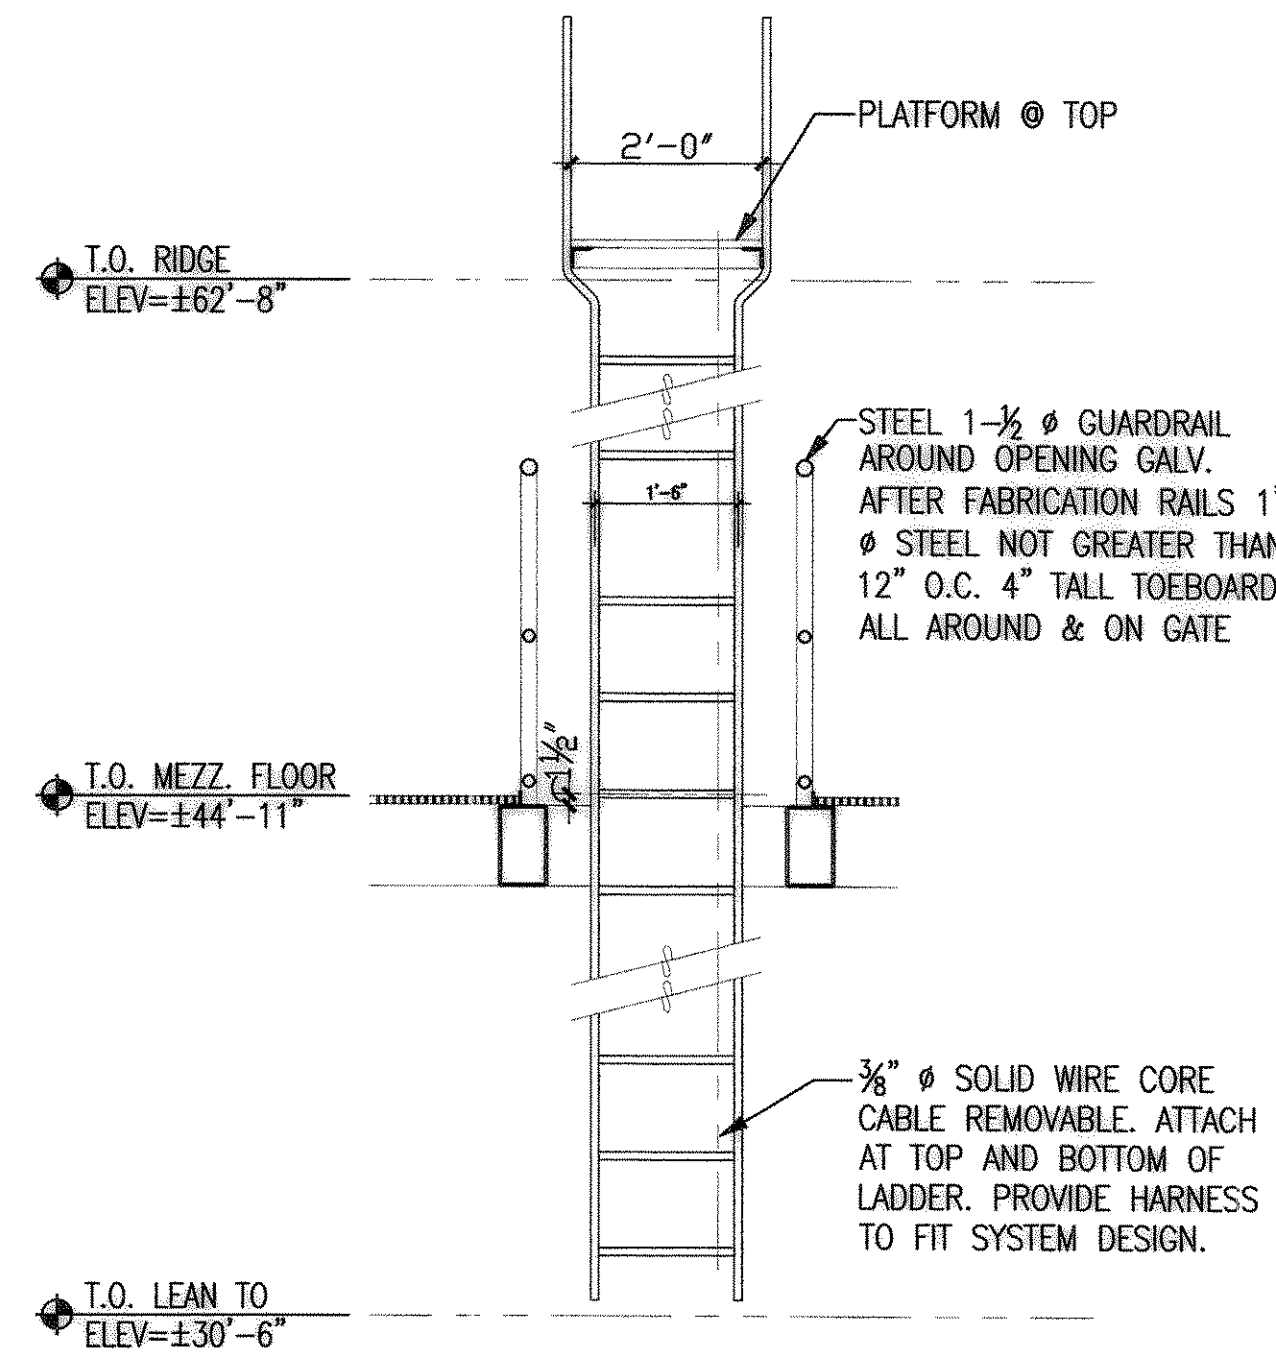


15	ROOF LADDER		MAINT. BLDG
	SCALE: 1/2" = 1'-0"	PC	E1974A7.DT.

8	JIB CRANE PLAN		MAINT. BLDG
	SCALE: 1/2" = 1'-0"	PC	E1974A7.DT.2

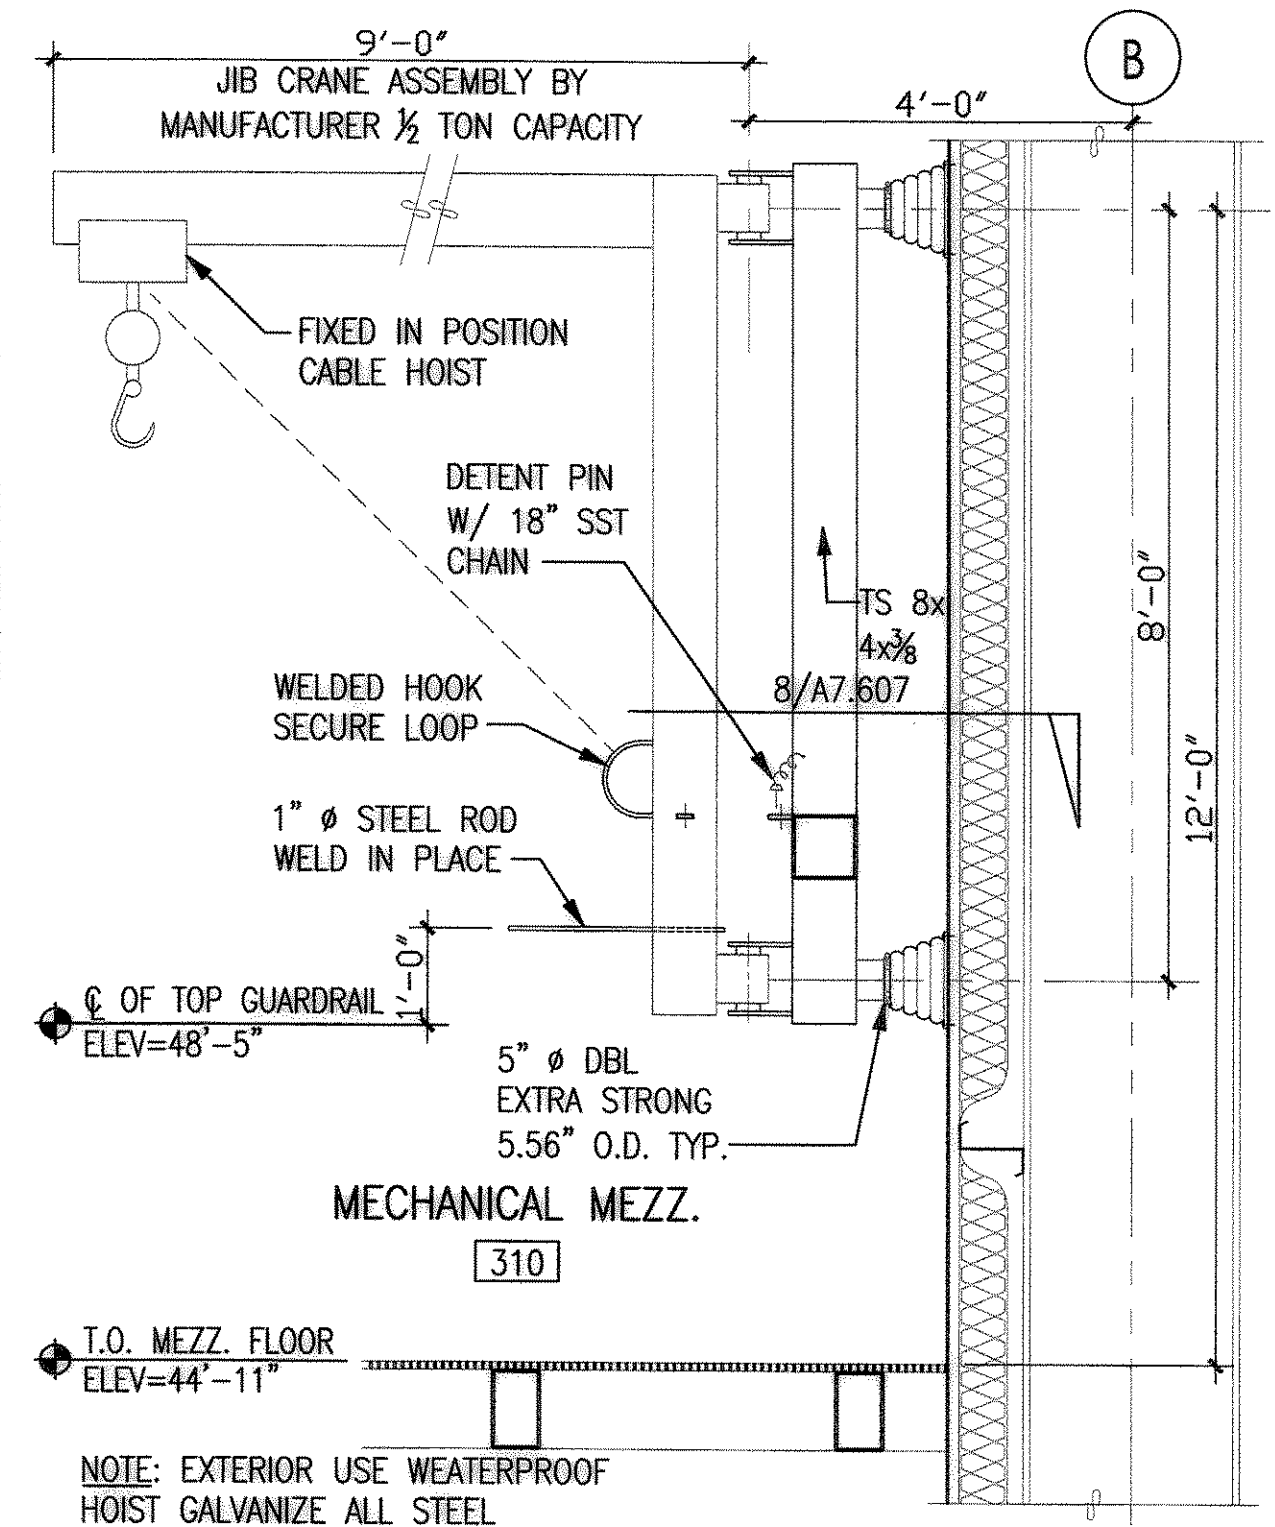

16	JIB CRANE SECTION		MAINT. BLDG
	SCALE: 1/2" = 1'-0"	PC	E1974A7.DT.2

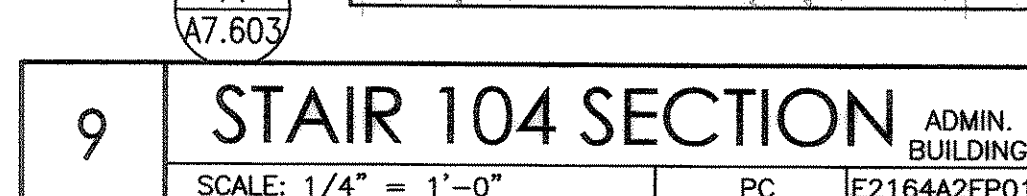

PORT OF TACOMA
U.S.A.

RECORD DRAWING

PORT OF TACOMA
TACOMA, WA 98401

6021 12th Street, Suite 201
Tacoma, WA 98424
Tel: 253.922.9037
Fax: 253.922.6499

253-383-5841

P.O. BOX 1837

APPROVED

LC 8/22/03

CHECKED BY - DATE 8/22/03

PROJECT ENGR - DATE

CHIEF ENGINEER - DATE

DRAWING DATE: 12/20/04

PORT ADDRESS:

PORT PARCEL:

PORT OF TACOMA

PIERCE COUNTY TERMINAL

DECK & CANOPY

DETAILS

EP. 6321-17


A7.609

SHEET 226 OF 230


CONTRACT NUMBER: 980154

E NUMBER: E1974


PHASE: RECORD DRAWING

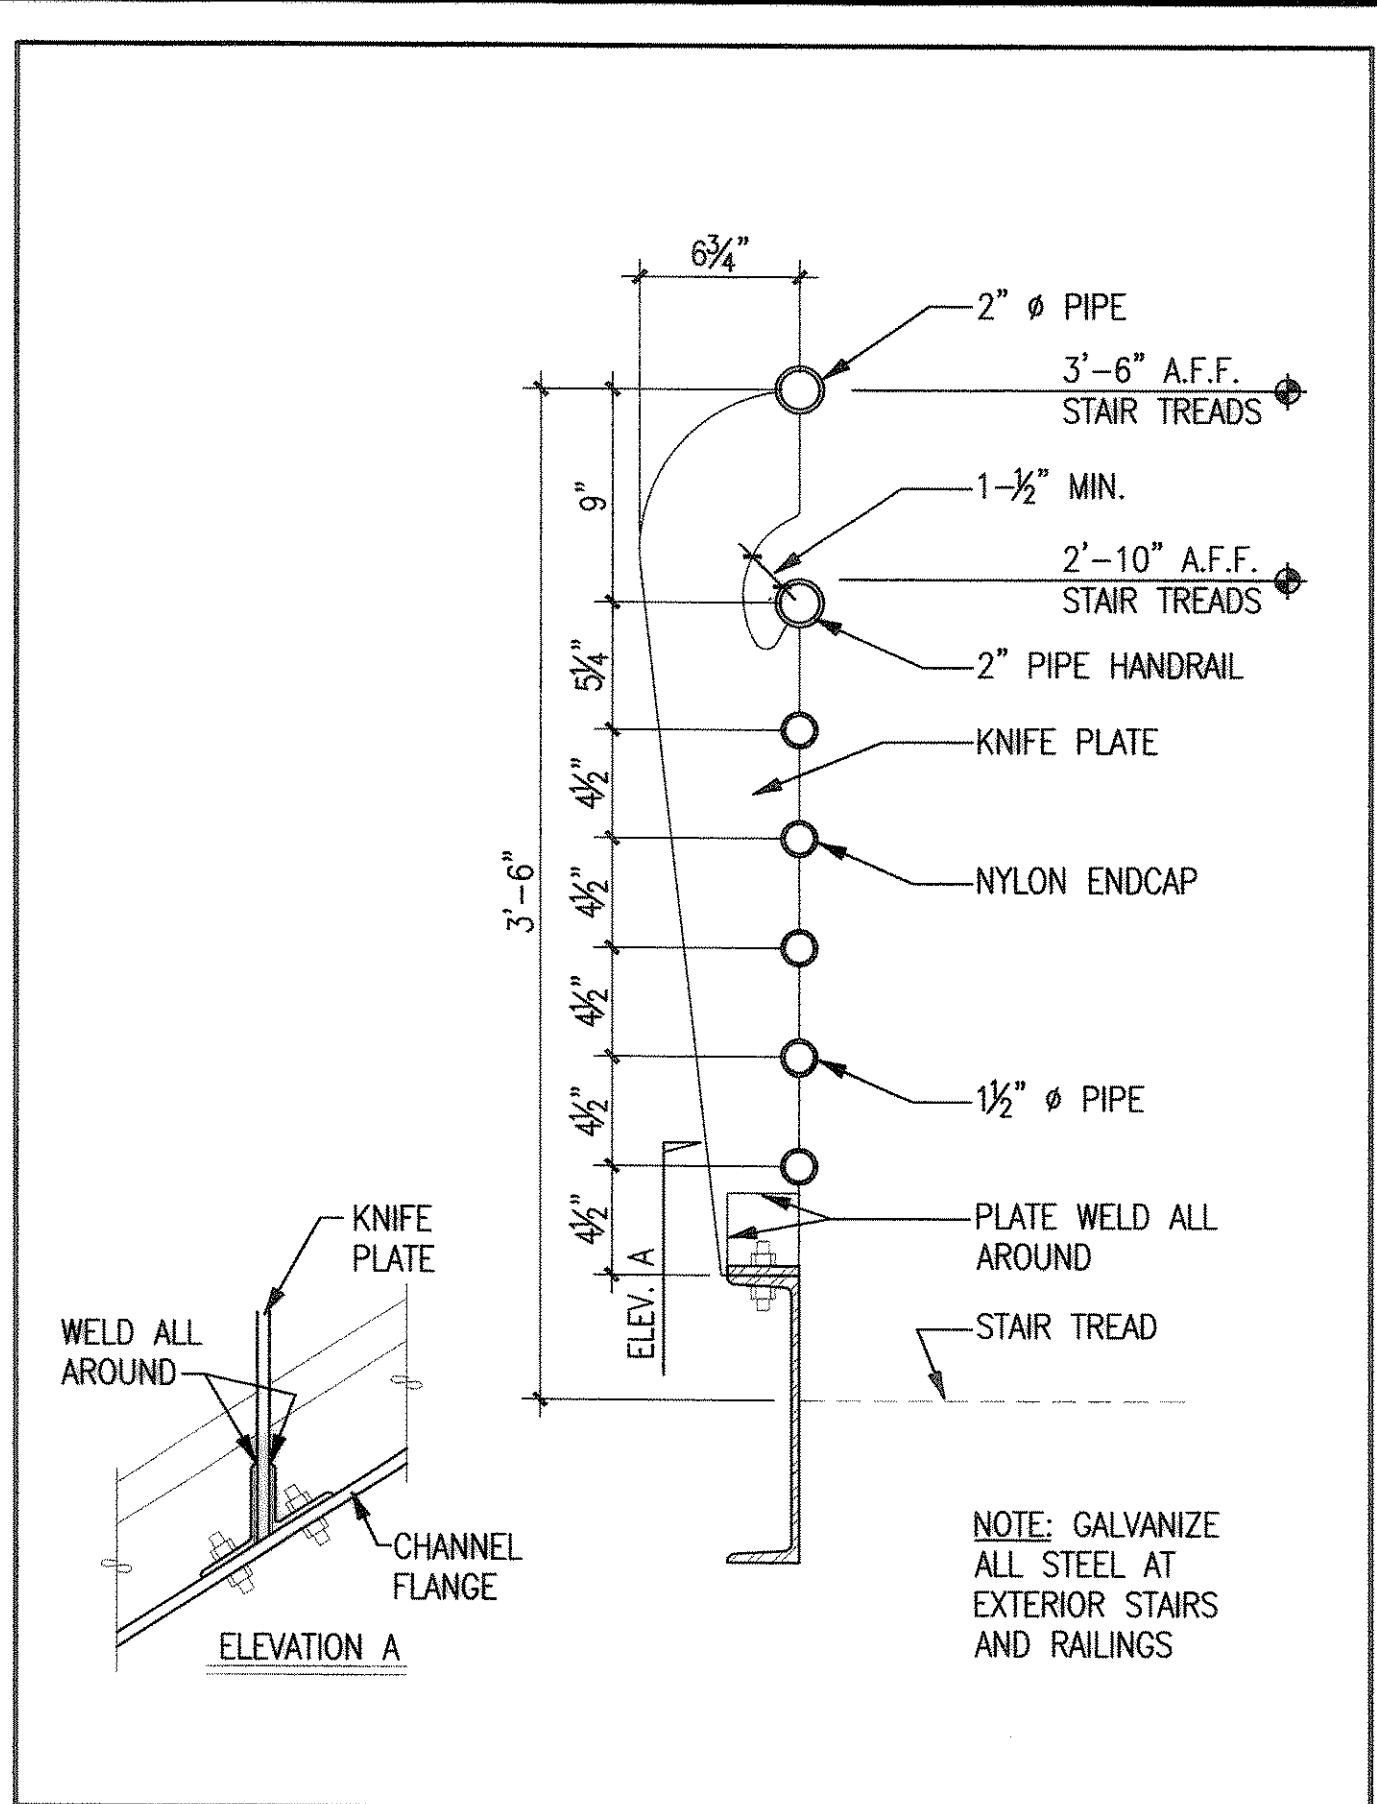


7 HANDRAIL
SCALE: 1-1/2" = 1'-0" PC E1974A1.DT.1

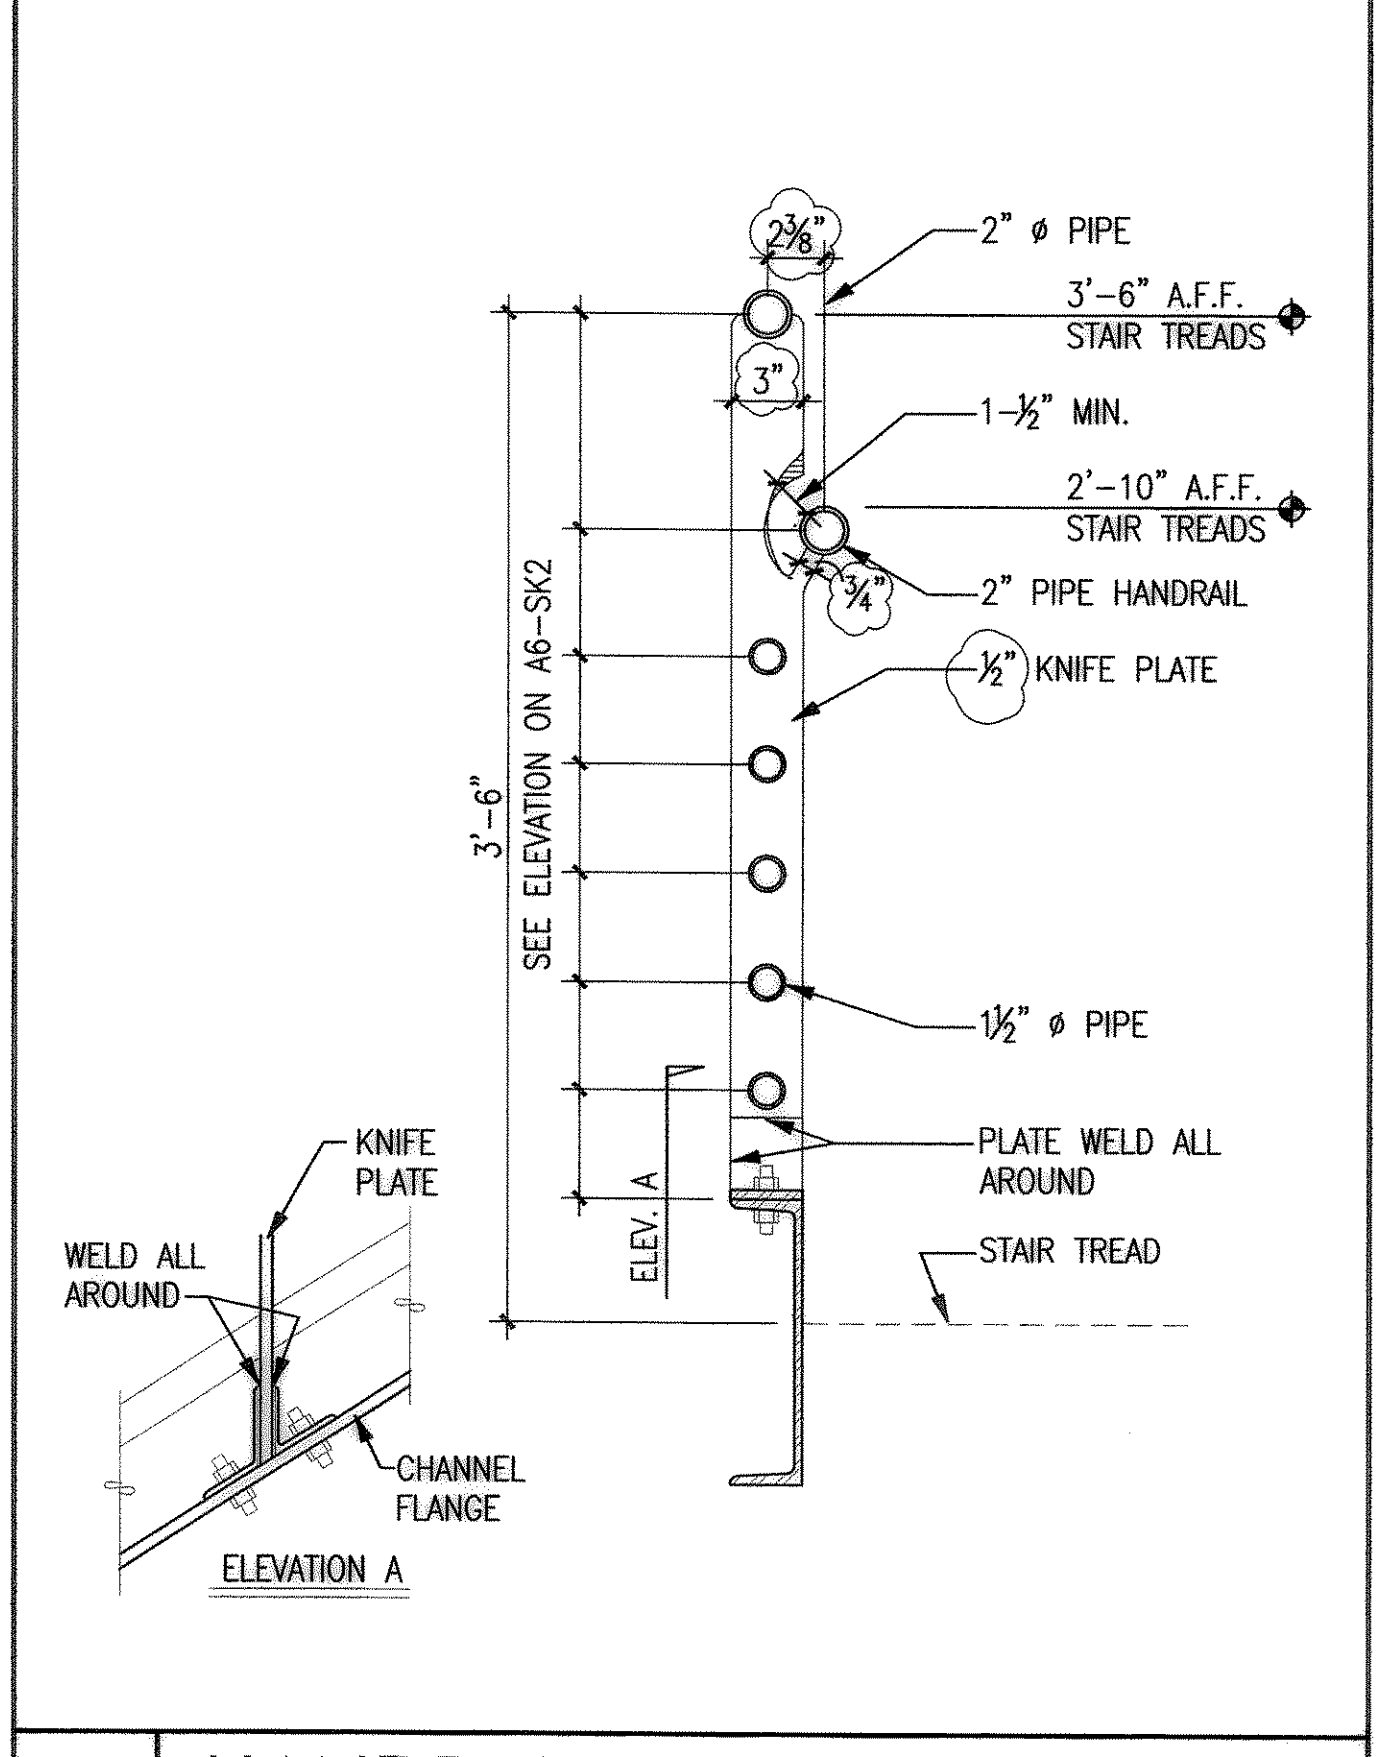


8 HANDRAIL
SCALE: 1-1/2" = 1'-0" PC E1974A1.DT.1

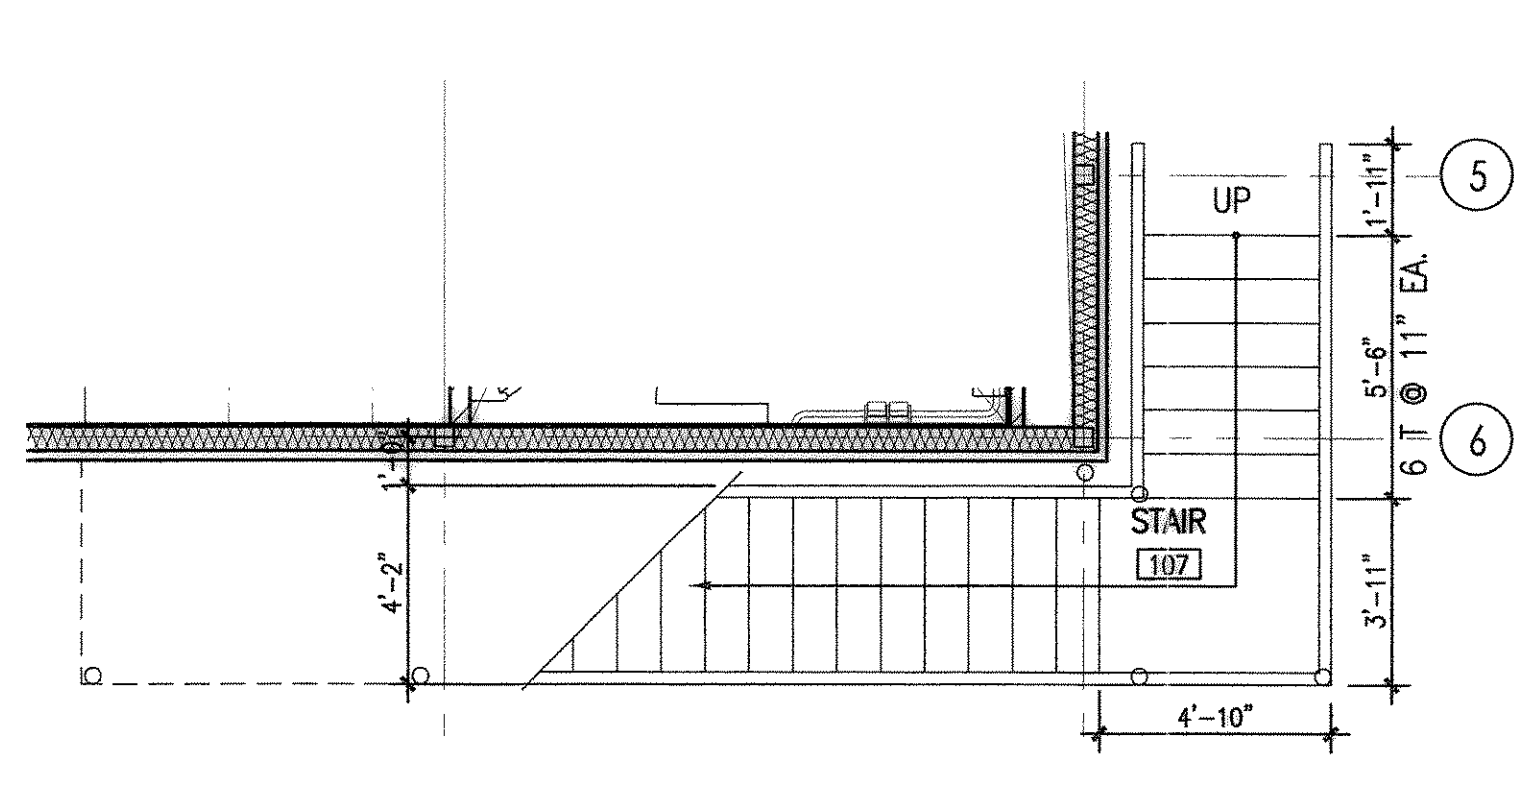


4 STAIR 107 1st FLR
SCALE: 1/4" = 1'-0" PC E2164A2FP01

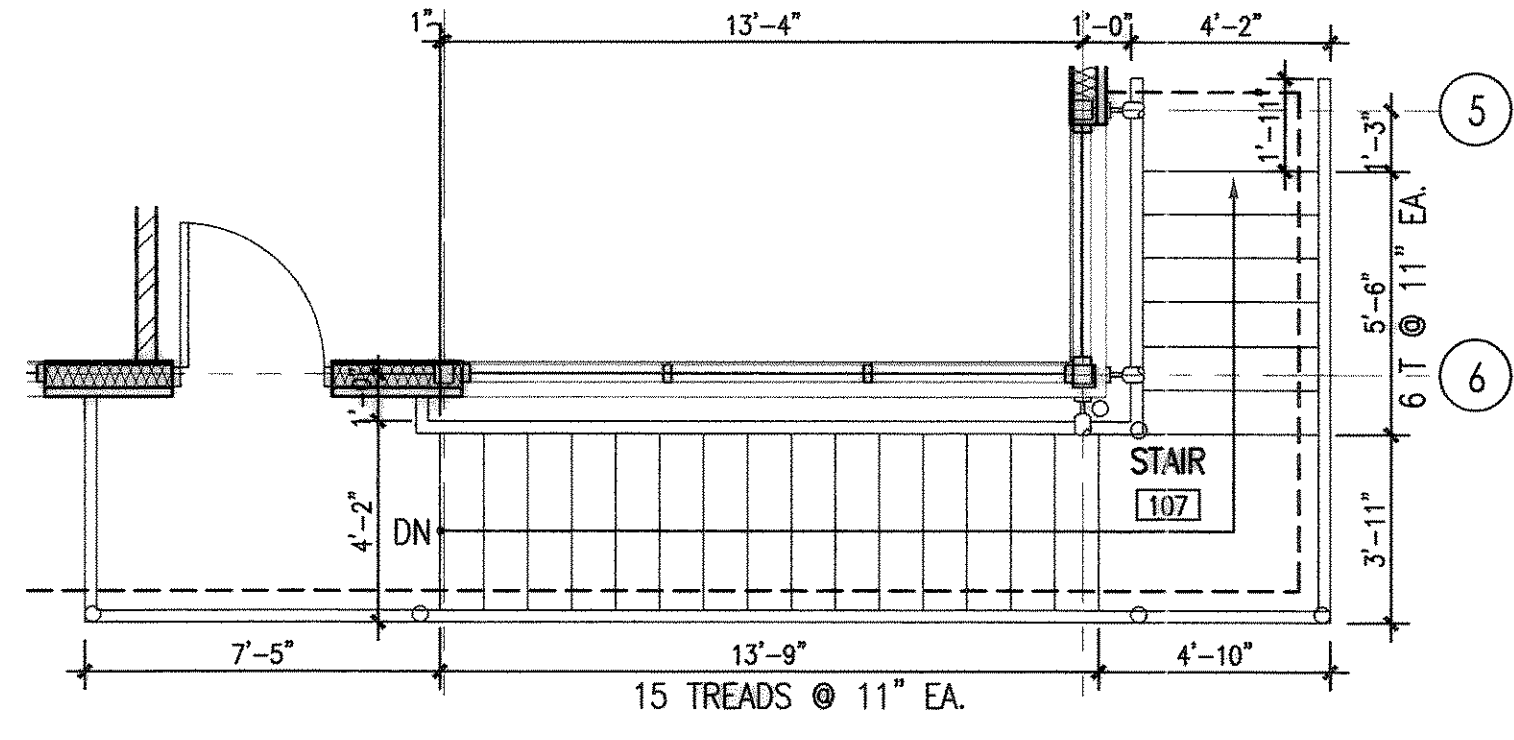


5 STAIR 107 2nd FLR
SCALE: 1/4" = 1'-0" PC E2164A2FP01

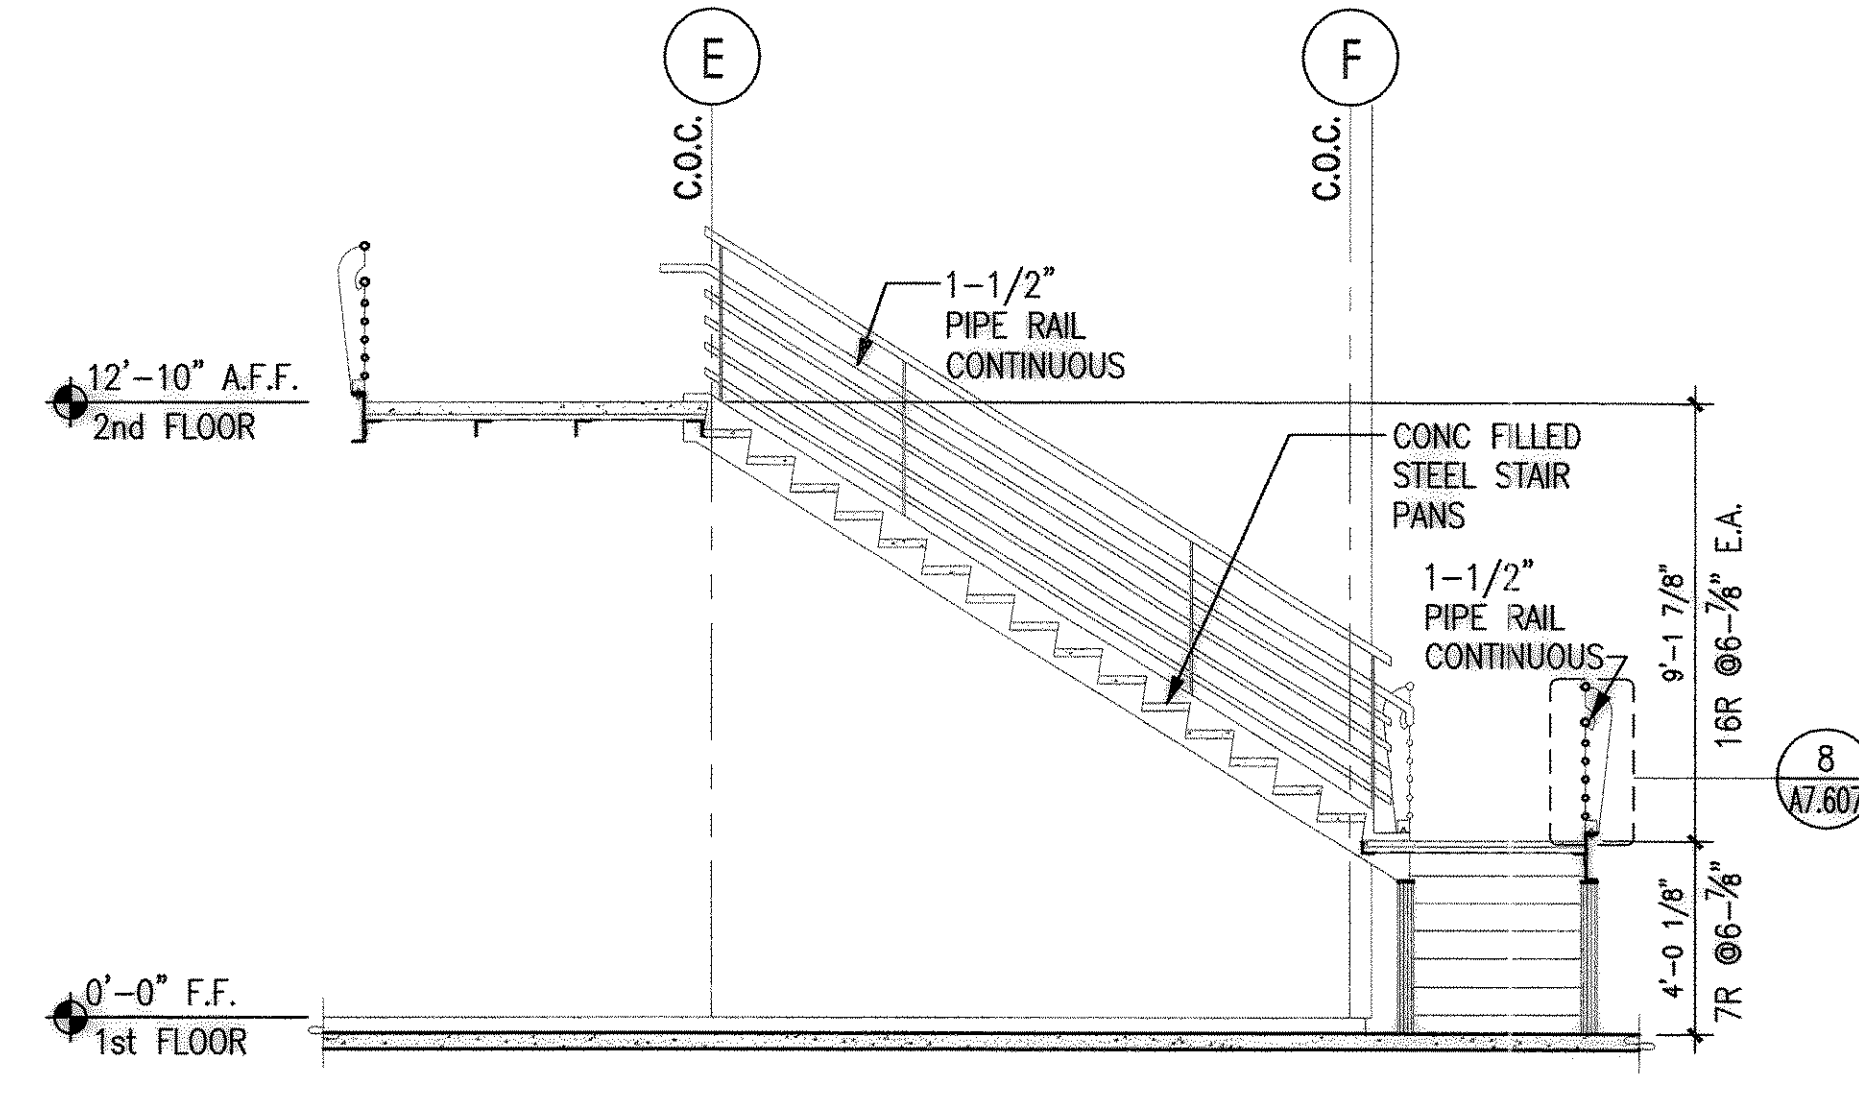


6 STAIR 107 SECTION
SCALE: 1/4" = 1'-0" PC E2164A2FP01

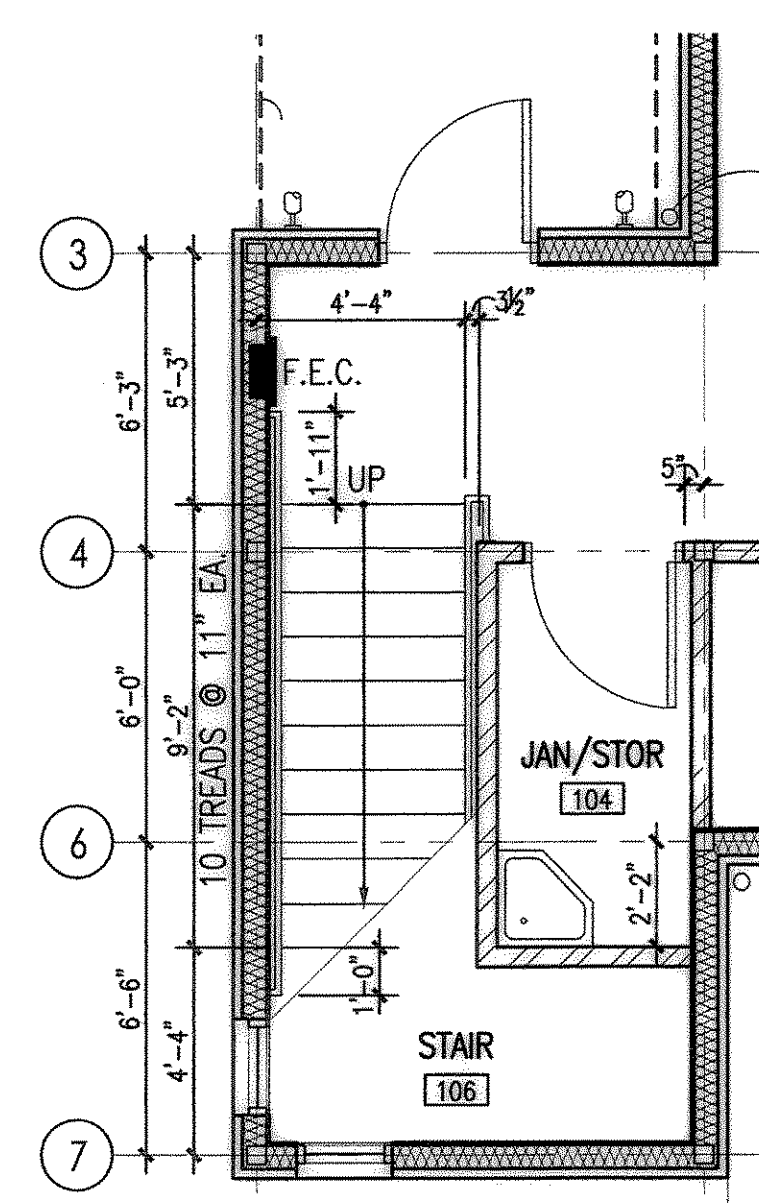


1 STAIR 106 1st FLR
SCALE: 1/4" = 1'-0" PC E2164A3FP01

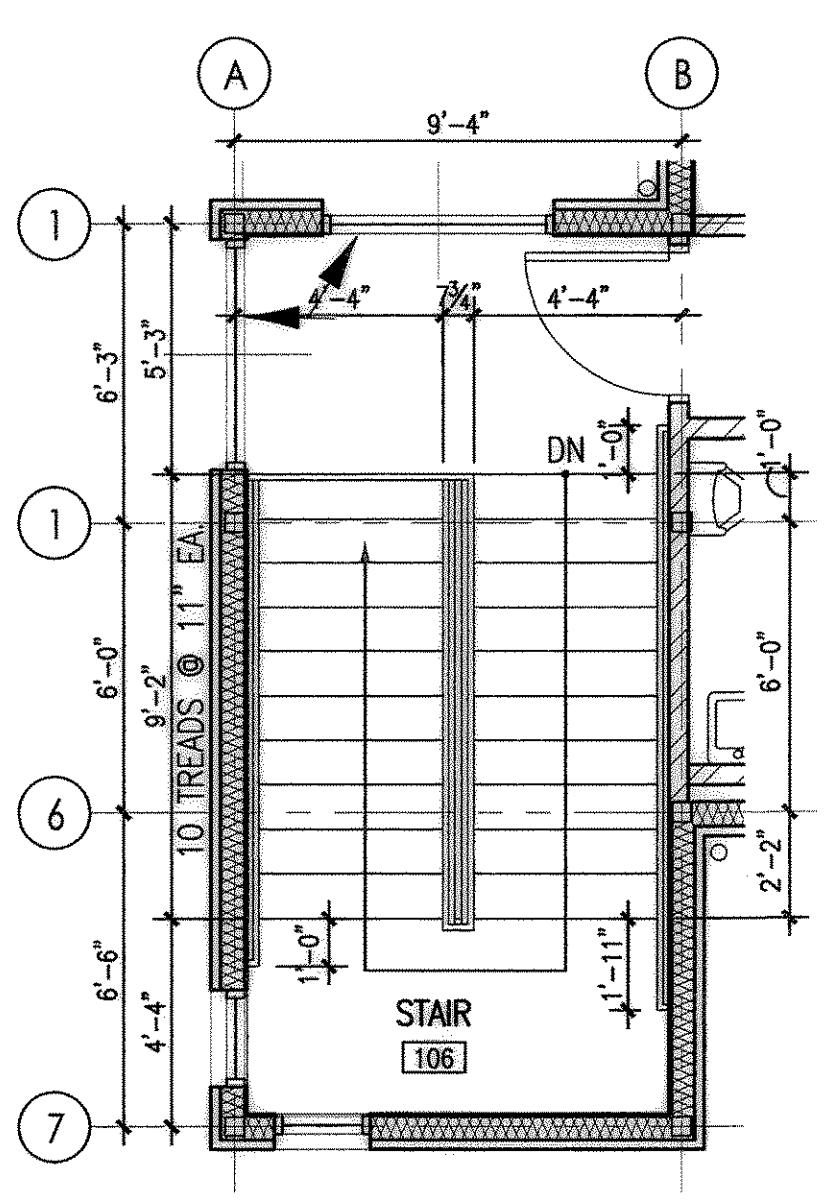

2 STAIR 106 2nd FLR
SCALE: 1/4" = 1'-0" PC E2164A3FP01

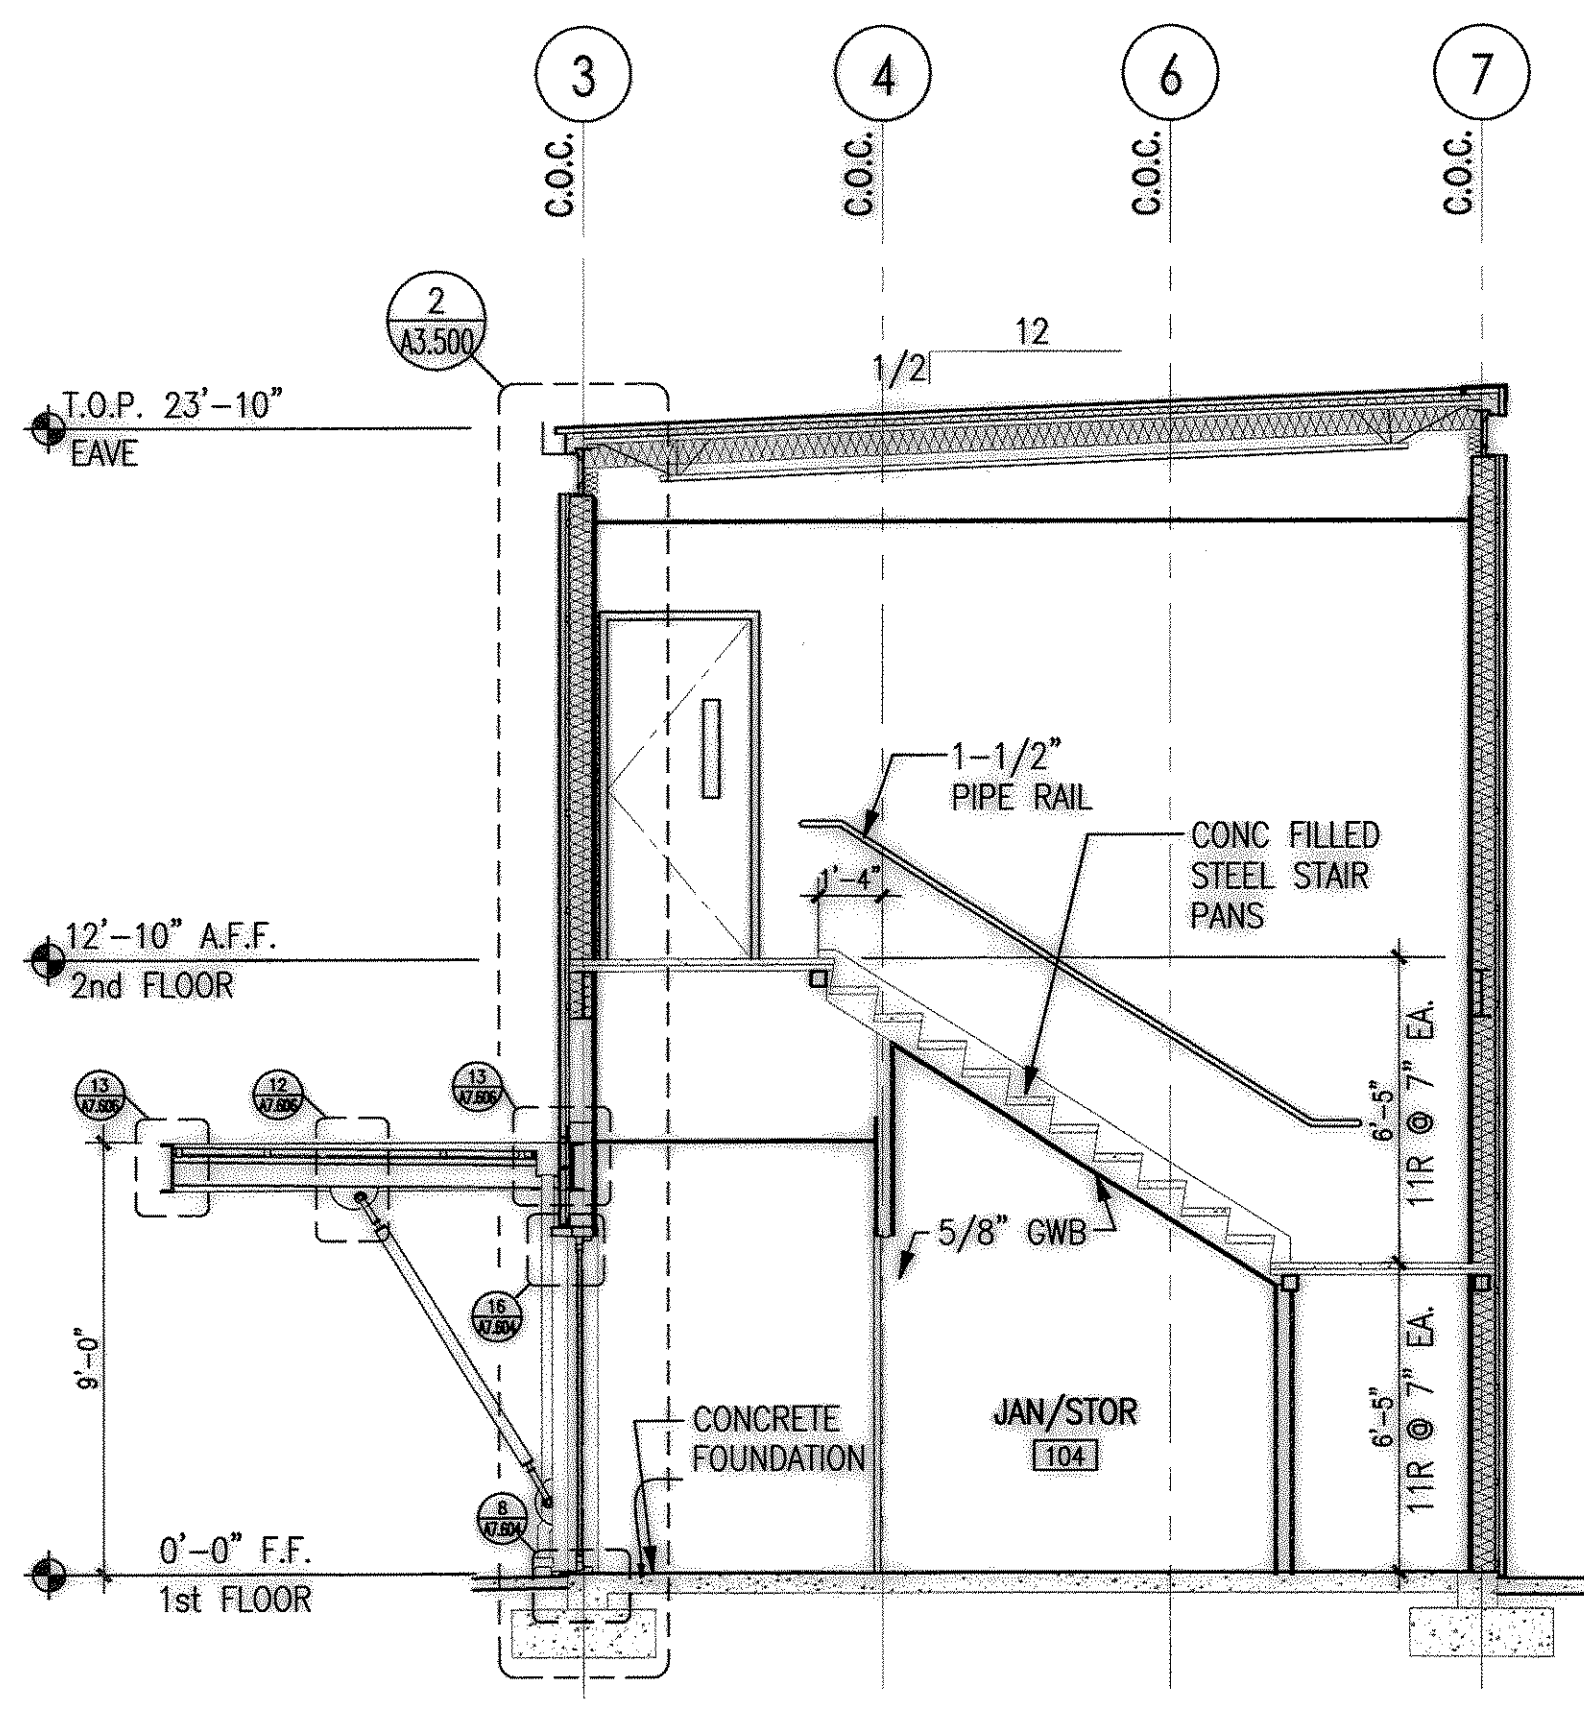

3 STAIR 106 SECTION
SCALE: 1/4" = 1'-0" PC E2164A2BS02

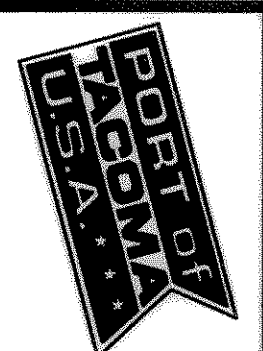

PORT OF TACOMA
TACOMA, WA 98401
P.O. BOX 1837
253-383-5841



6021 12th Street East
Tacoma, WA 98401
Tel: 253.922.9037
Fax: 253.922.6499

APPROVED

CHIEF ENGINEER - DATE

LC 8/22/03
CHECKED BY - DATE
PROJECT ENGR. - DATE

PORT OF TACOMA
PIERCE COUNTY TERMINAL
DECK & CANOPY
DETAILS


EP. 6321-17

A7.610
SHEET 227 OF 230


DRAWING DATE: 12/20/04

TOWNSHIP: RANGE: SECTION:
DATE: HORIZ. VERT. SCALE: 1-1/2" = 1'-0"


CONTRACT NUMBER: 998154
DRAWING NUMBER: 119
PHASE: RECORD DRAWING

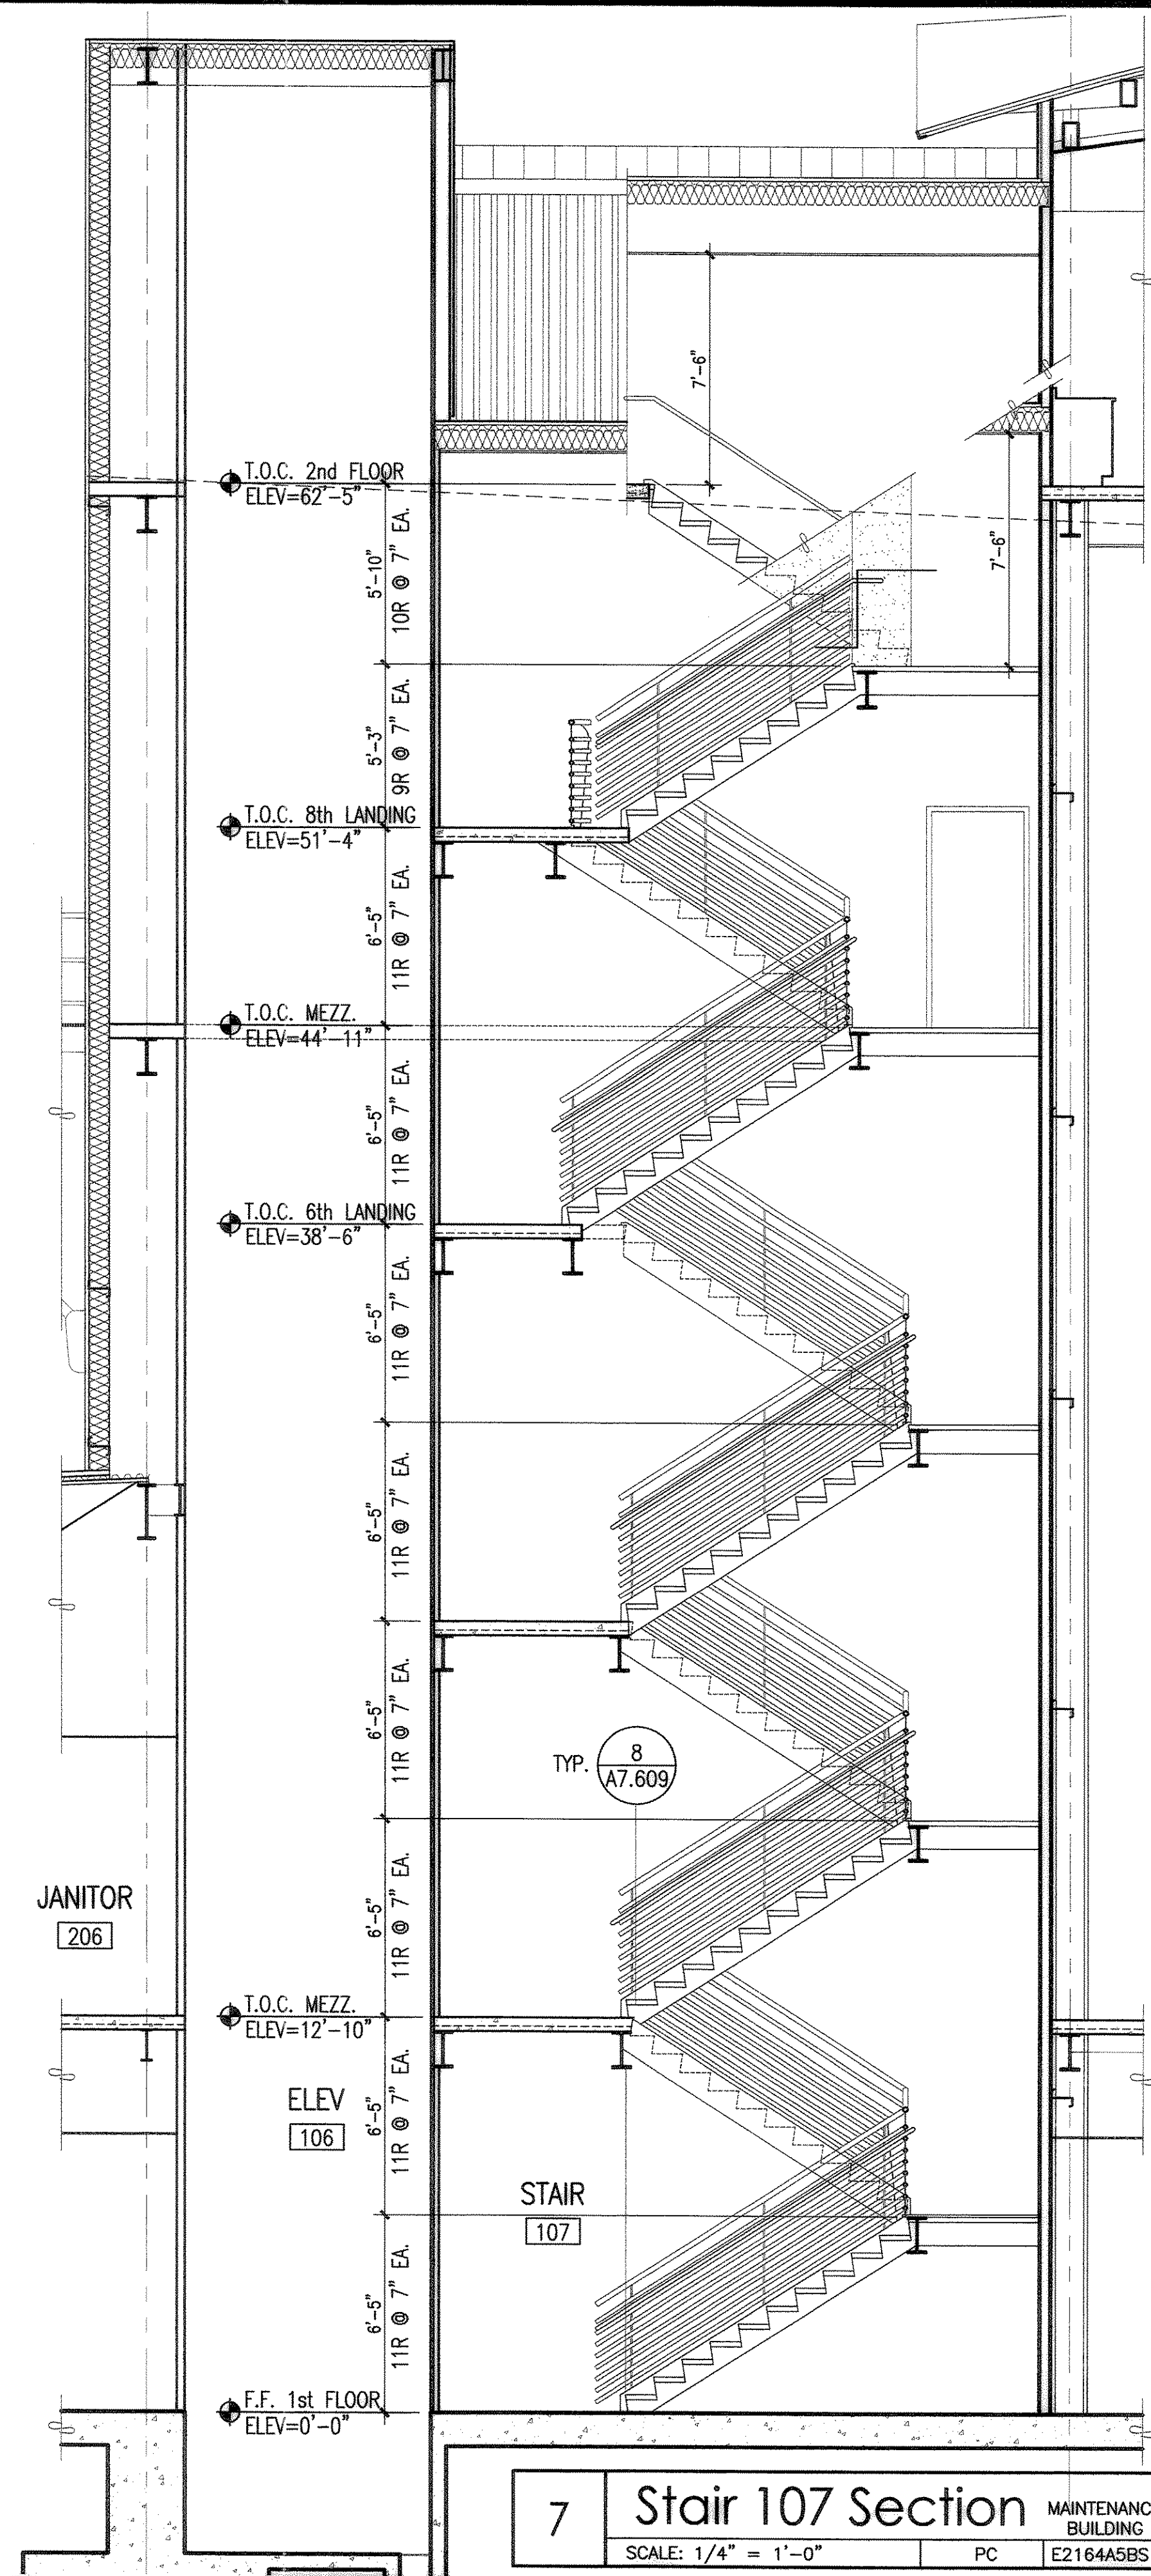


7 Stair 107 Section MAINTENANCE BUILDING
SCALE: 1/4" = 1'-0" PC E2164A5B51

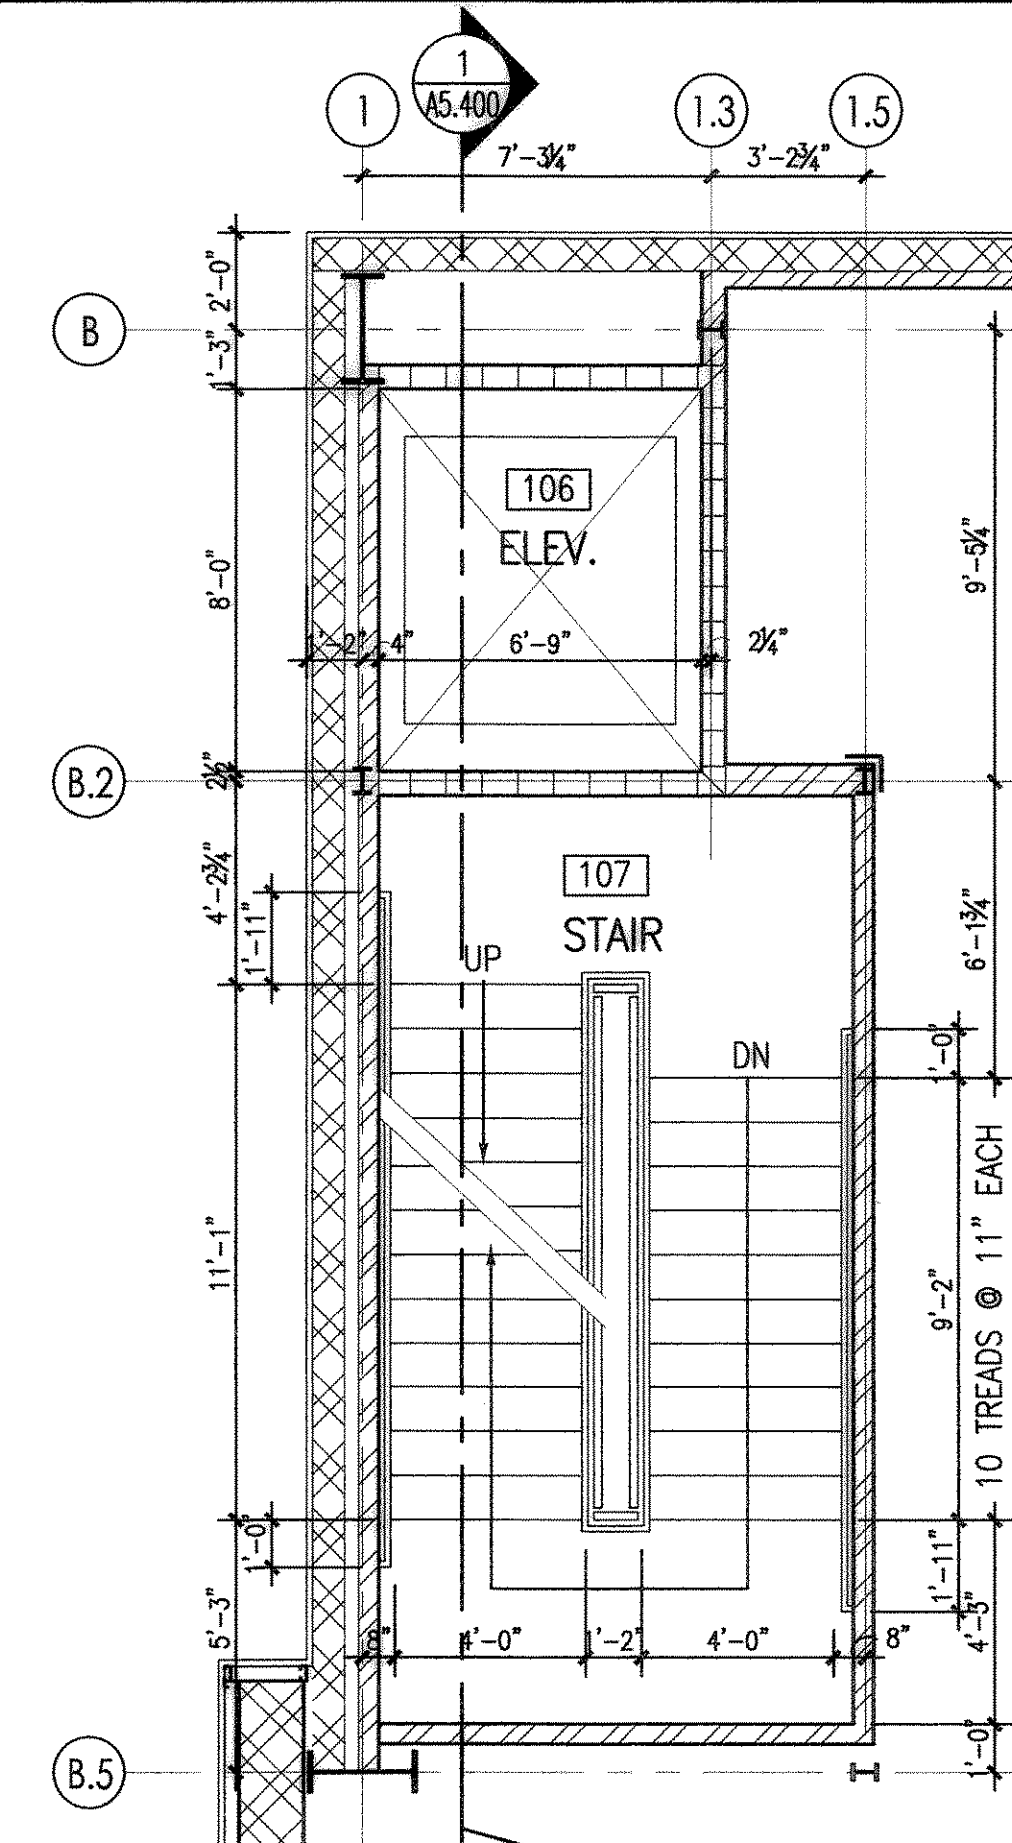


3 6th Landing MAINT. BUILDING
SCALE: 1/4" = 1'-0" PC E2164A5FP01

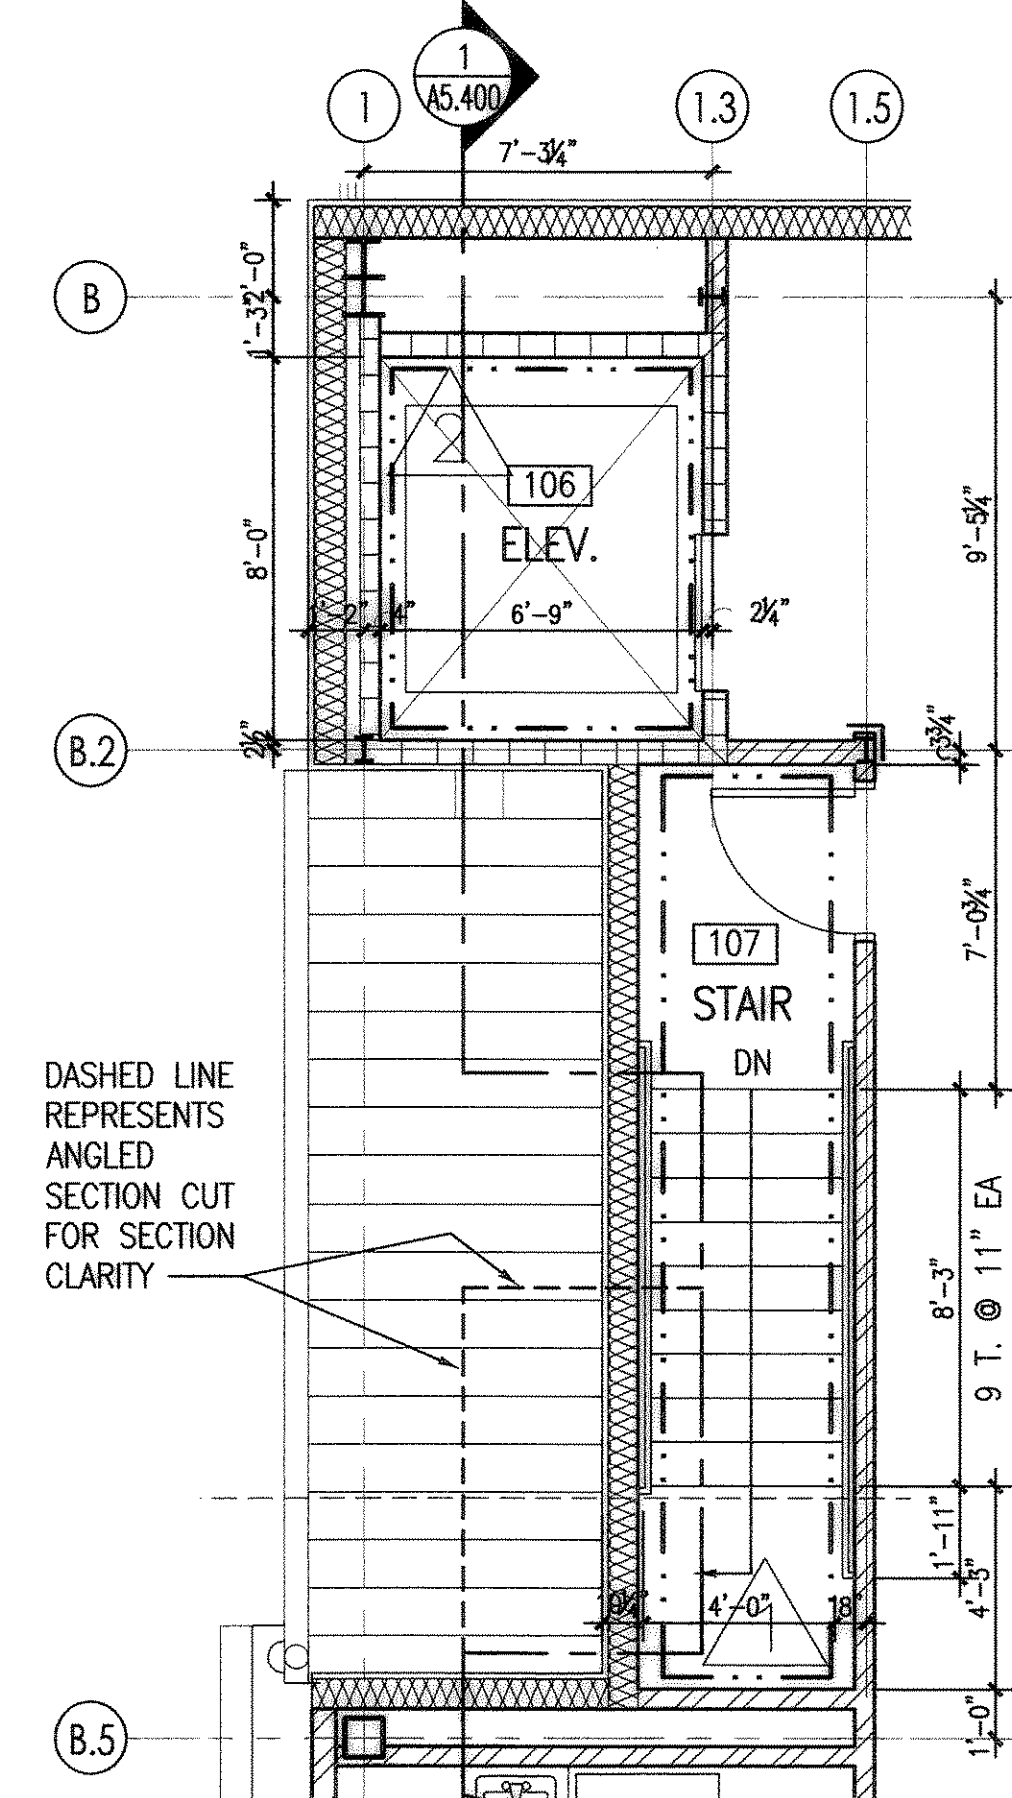


6 Stair 107 2nd FLR MAINT. BUILDING
SCALE: 1/4" = 1'-0" PC E2164A5FP01

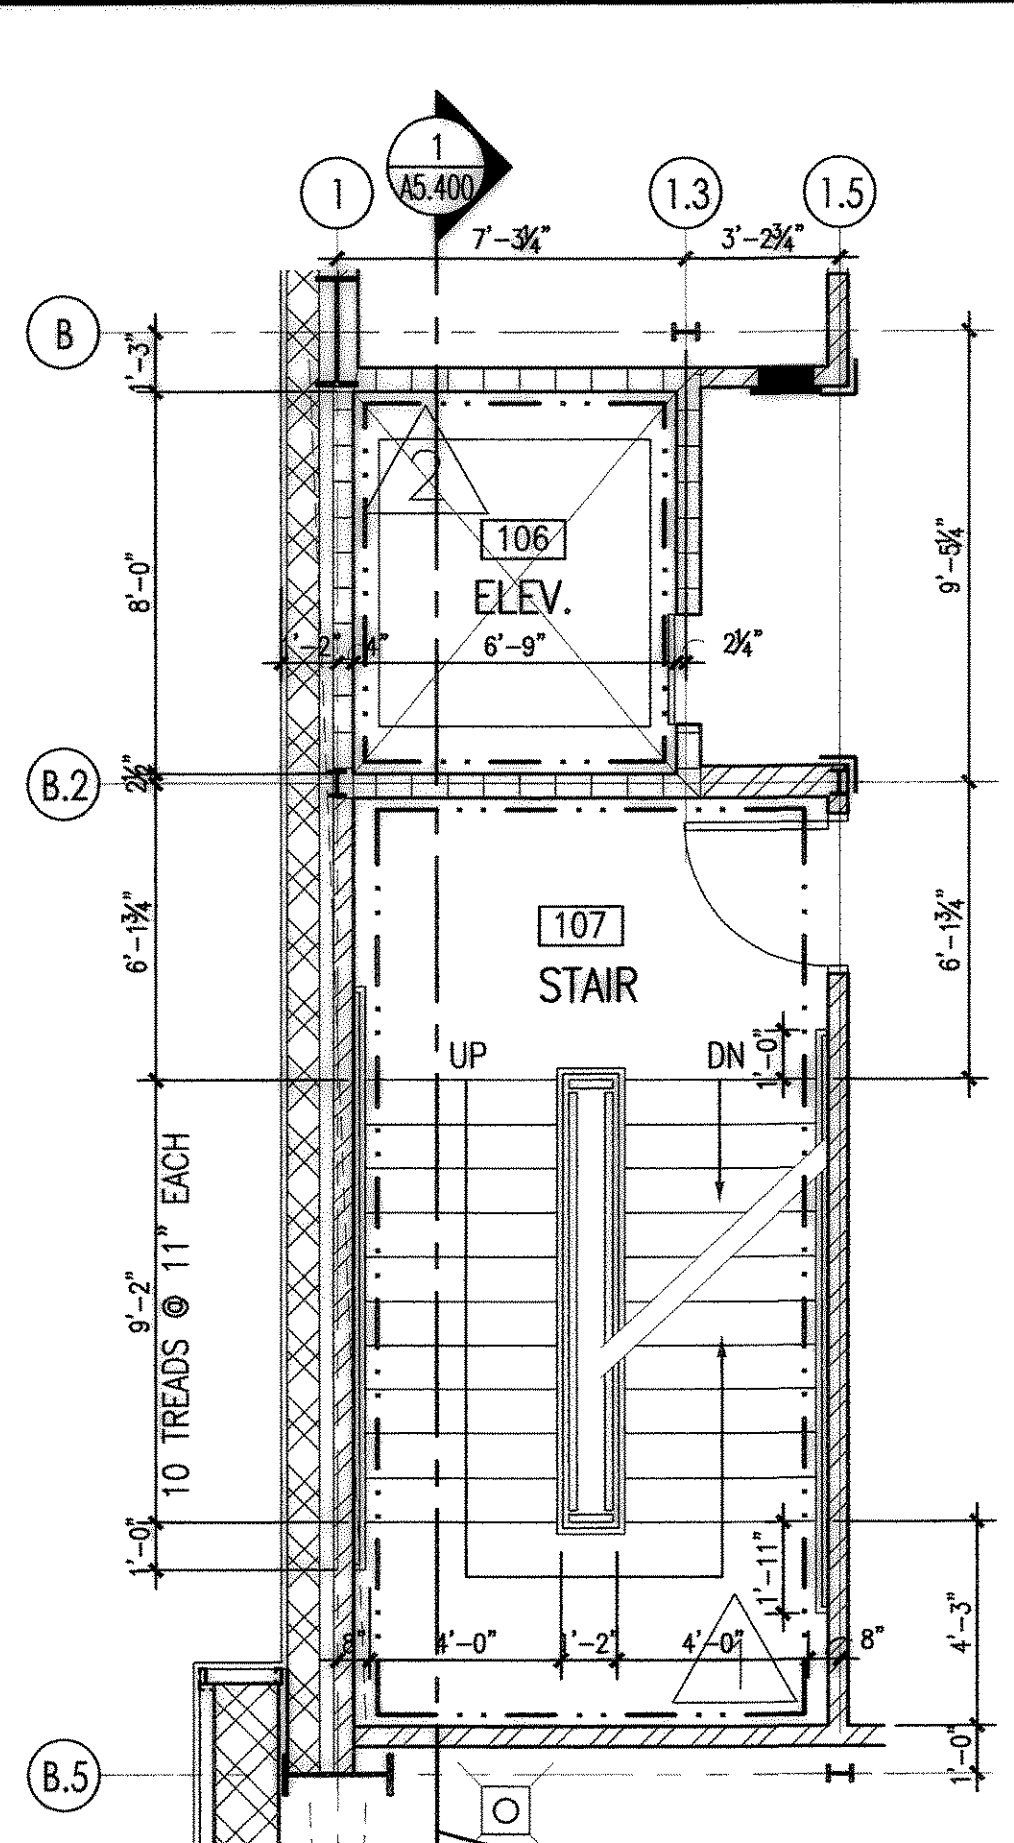


2 Stair 107 Mezz. FLR MAINT. BUILDING
SCALE: 1/4" = 1'-0" PC E2164A5FP01

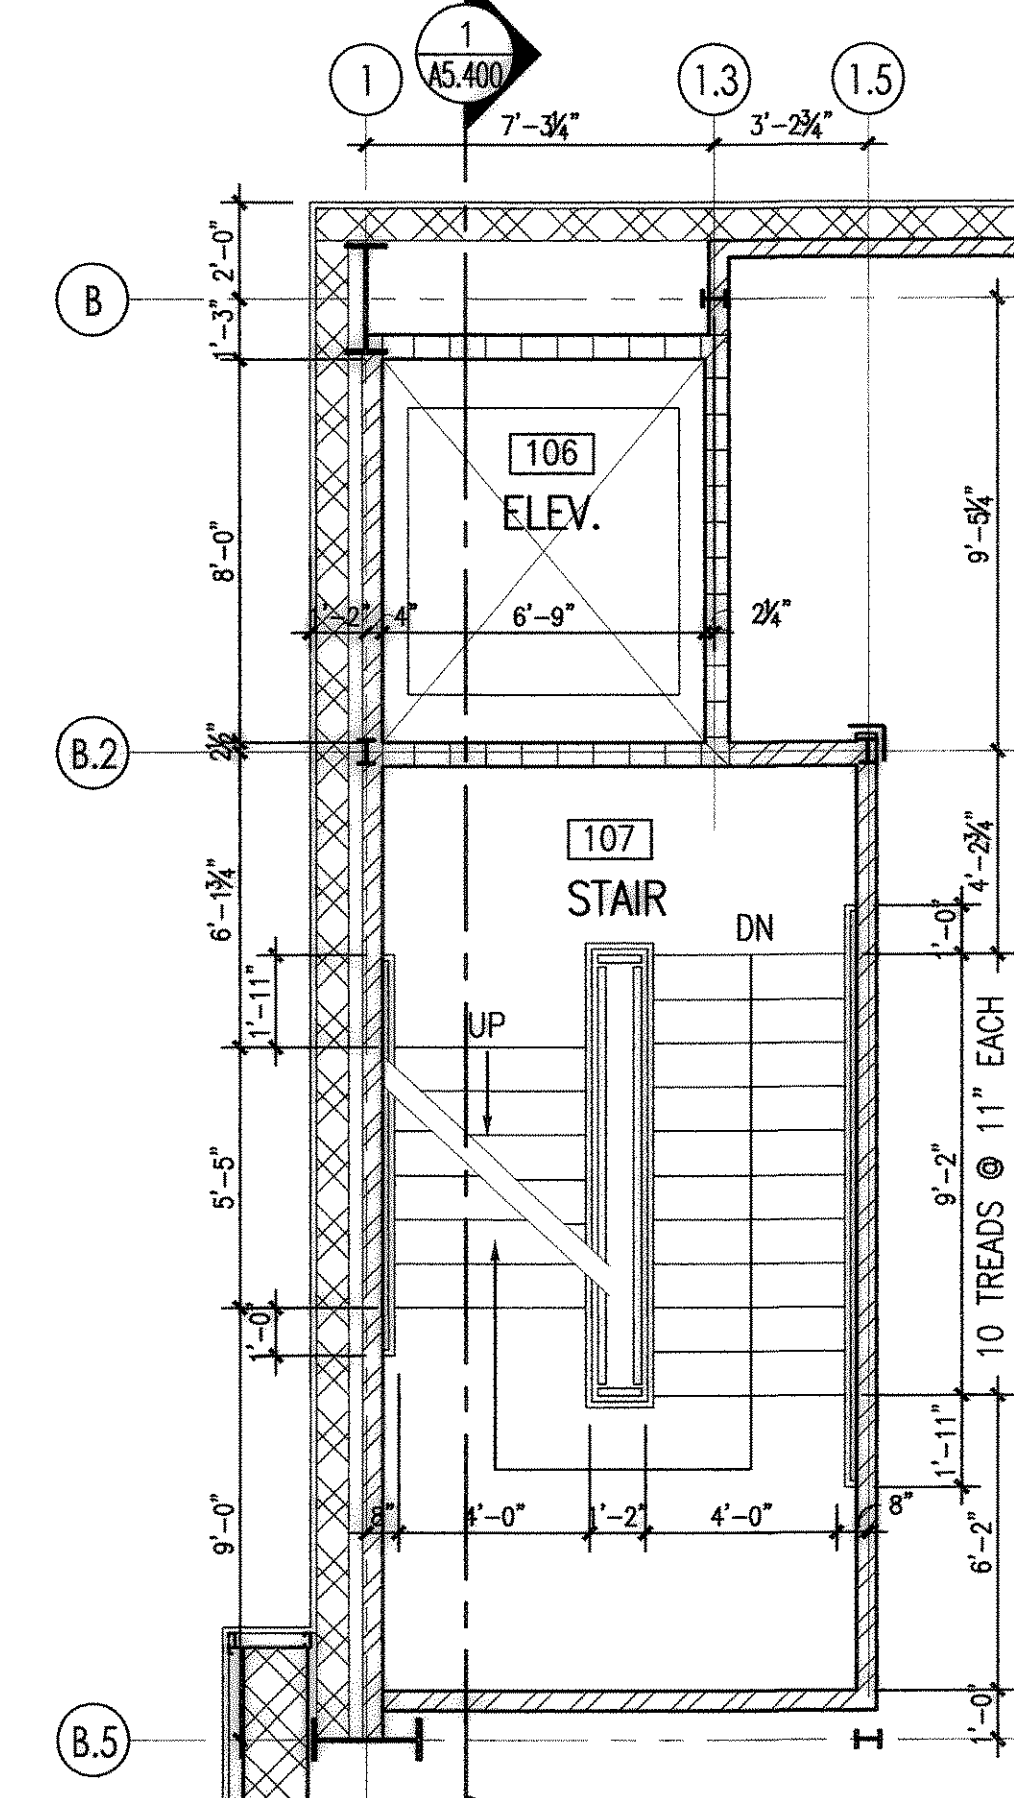


5 8th landing MAINT. BUILDING
SCALE: 1/4" = 1'-0" PC E2164A5FP01

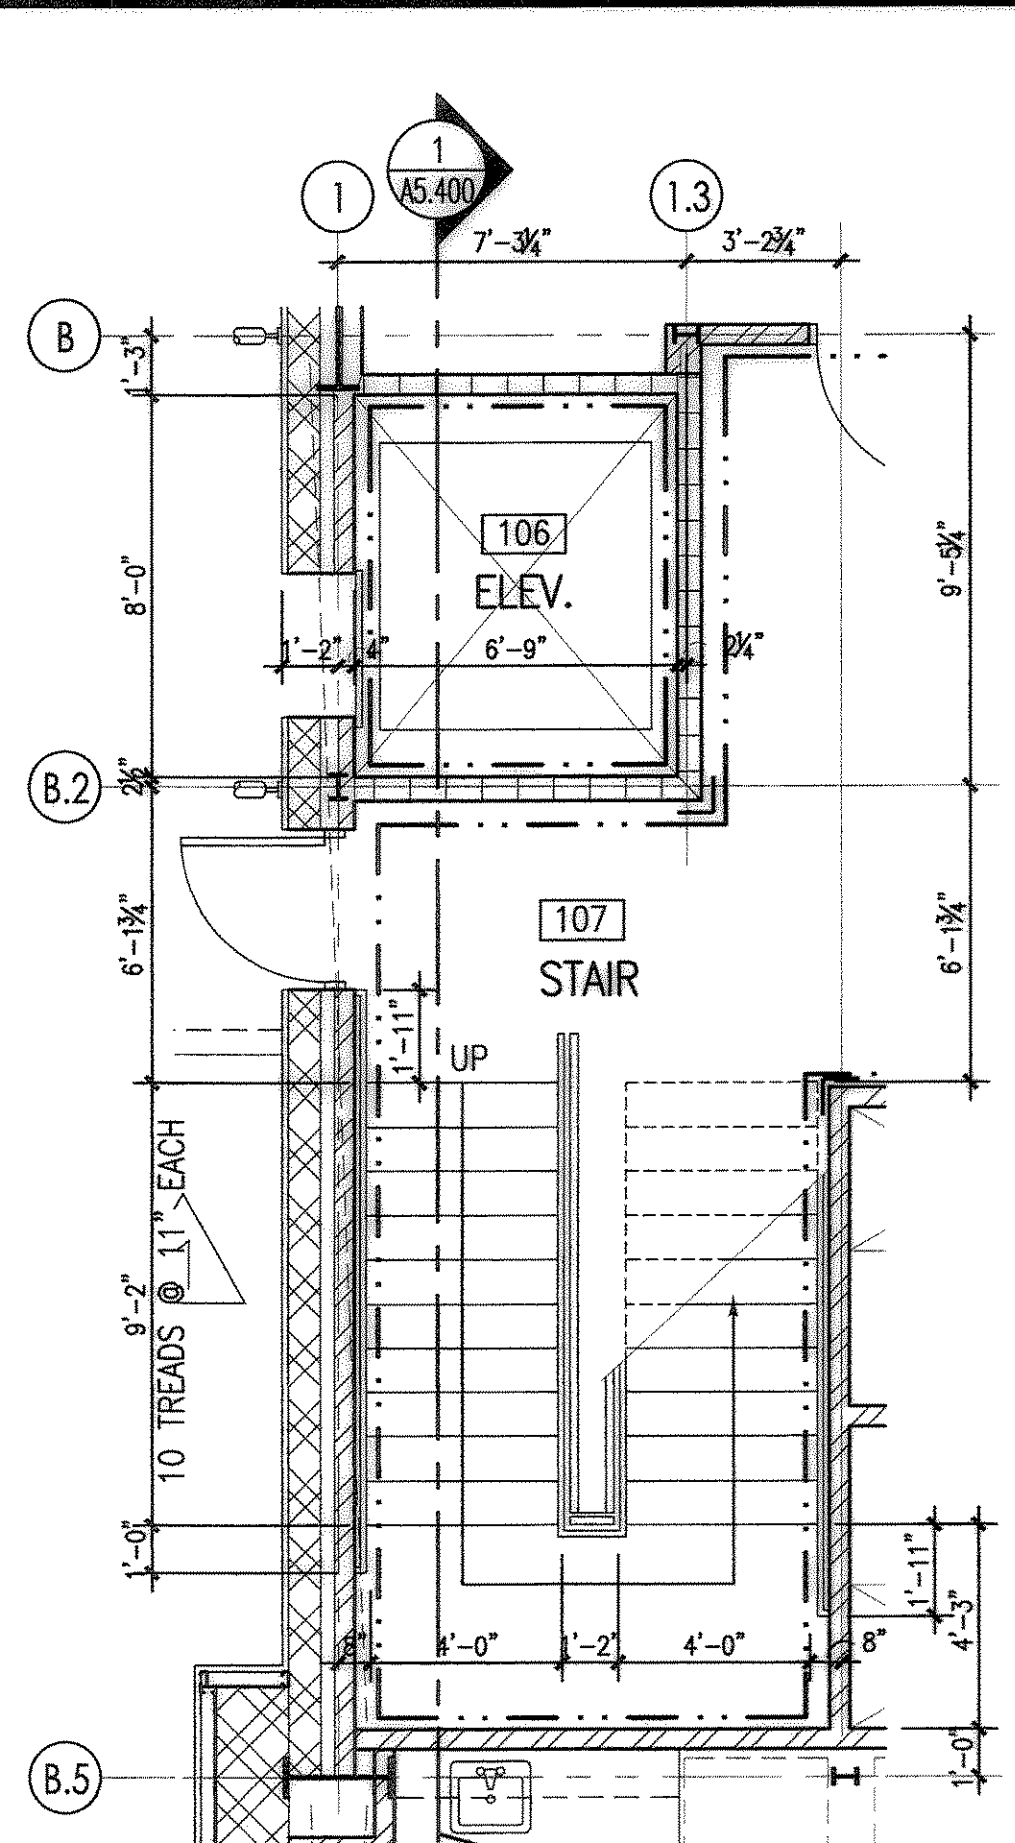

1 Stair 107 1st FLR MAINT. BUILDING
SCALE: 1/4" = 1'-0" PC E2164A5FP01

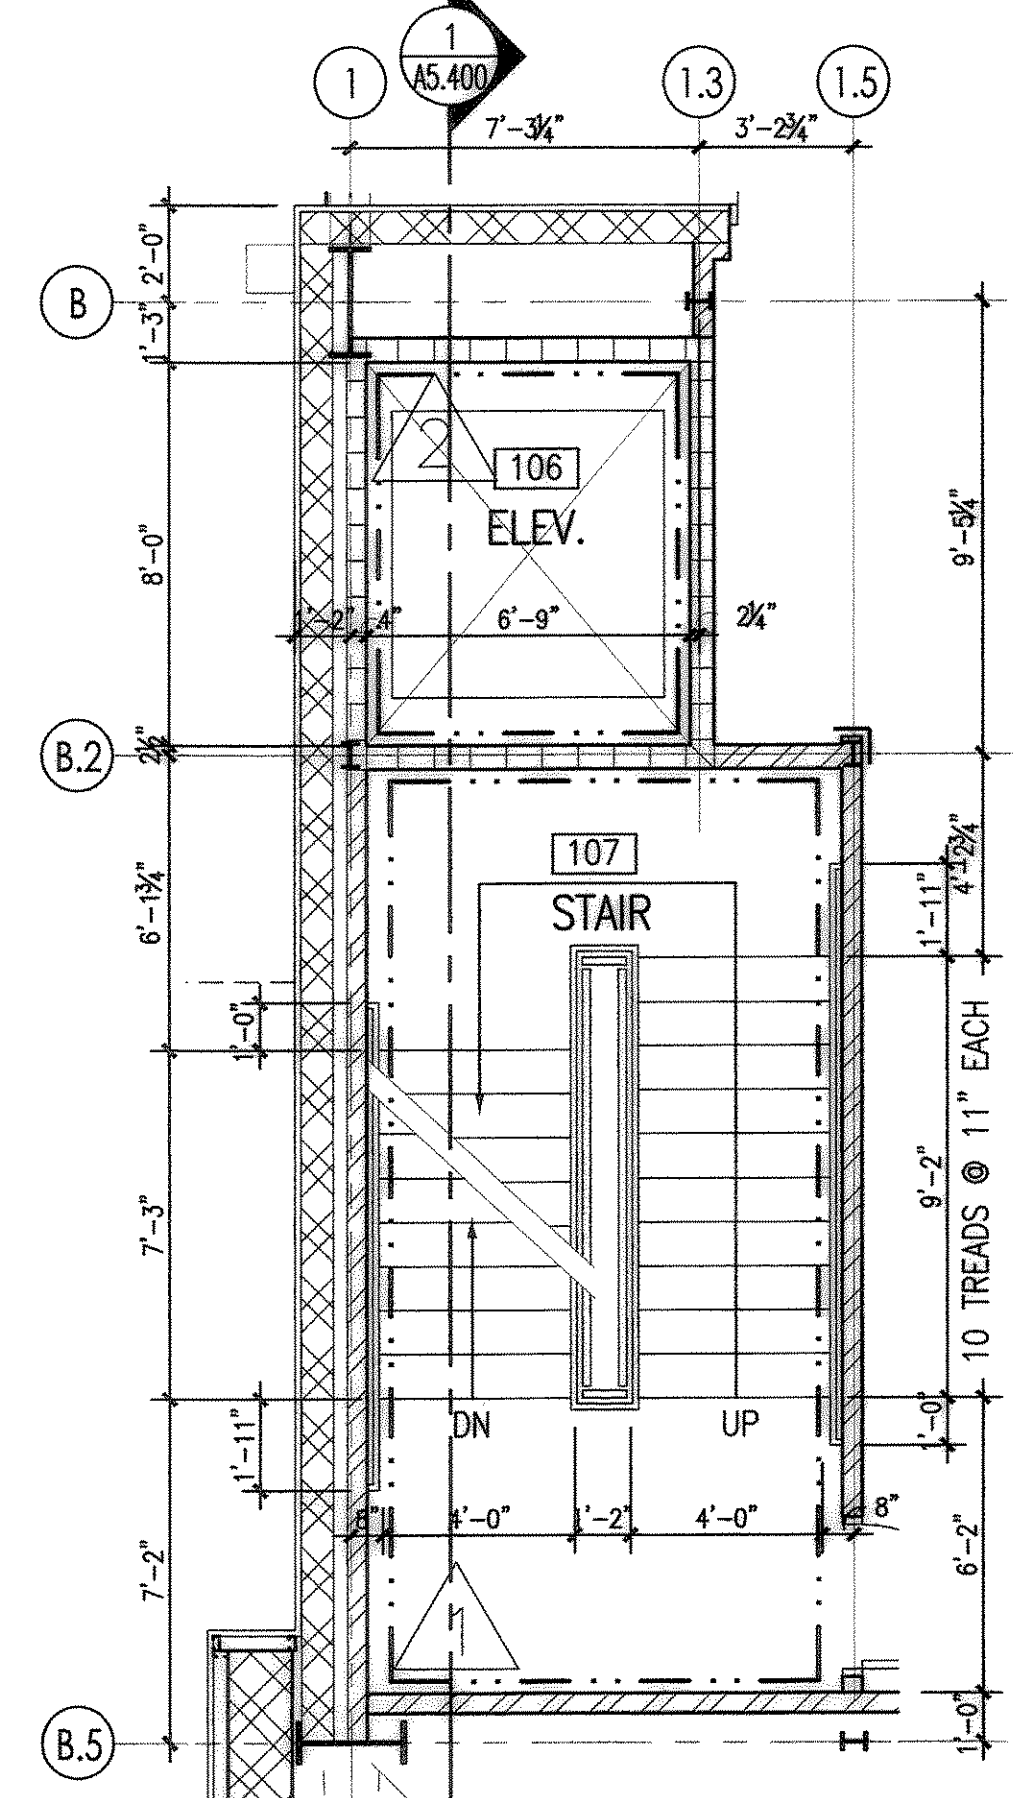

4 St. 107 Mech Mezz MAINT. BUILDING
SCALE: 1/4" = 1'-0" PC E2164A5FP01

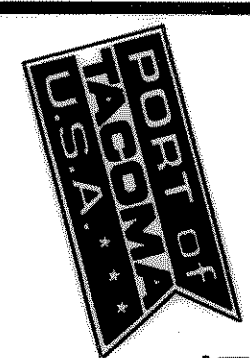

PORT OF TACOMA P.O. BOX 1887
TACOMA, WA 98401 253-863-8841

Helix
6021 12th Street East
Tacoma, WA 98424
Tel: 253-922-9037
Fax: 253-922-8497

RECORD DRAWING

APPROVED

CHIEF ENGINEER - DATE

LC
CHECKED BY - DATE
PROJECT ENGR. - DATE

PORT OF TACOMA
PIERCE COUNTY TERMINAL
CASEWORK ELEVATIONS

EP. 6321-17

A7.611

SHEET 228 OF 230

CONTRACT NUMBER: 98B154


E NUMBER: 12/20/04

PHASE: RECORD DRAWING

TOWNSHIP: RANGE: SECTION:

DATUM: NORTH

DRAWING SCALE: 1/4" = 1'-0"

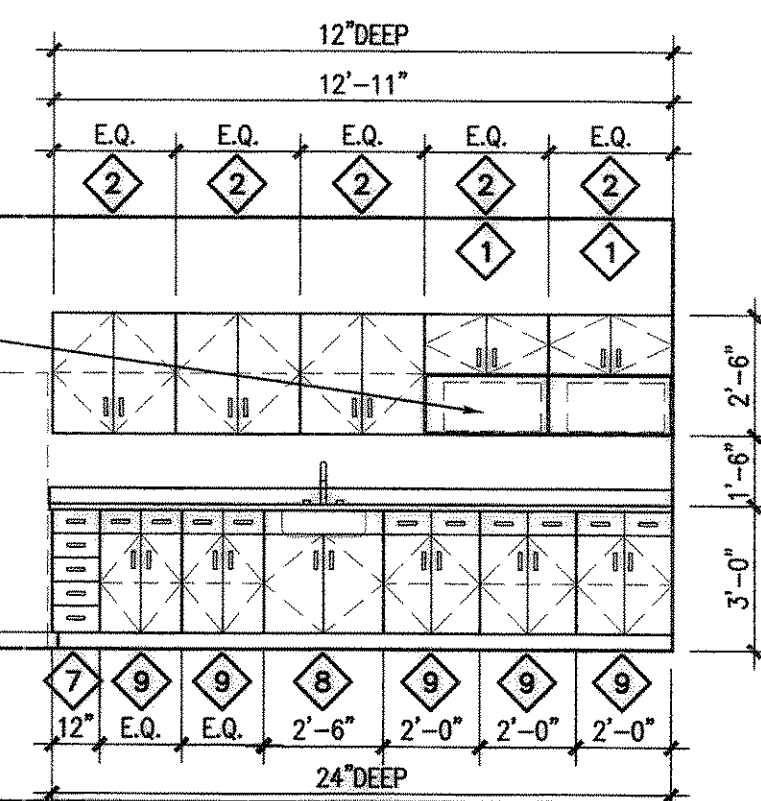

MICROWAVE
PROVIDED BY
OTHERS


REFRIGERATORS
PROVIDED BY
OTHERS

3 BREAK ROOM - MAINT. BLDG.

SCALE: 1/4"=1'-0"

DB


109

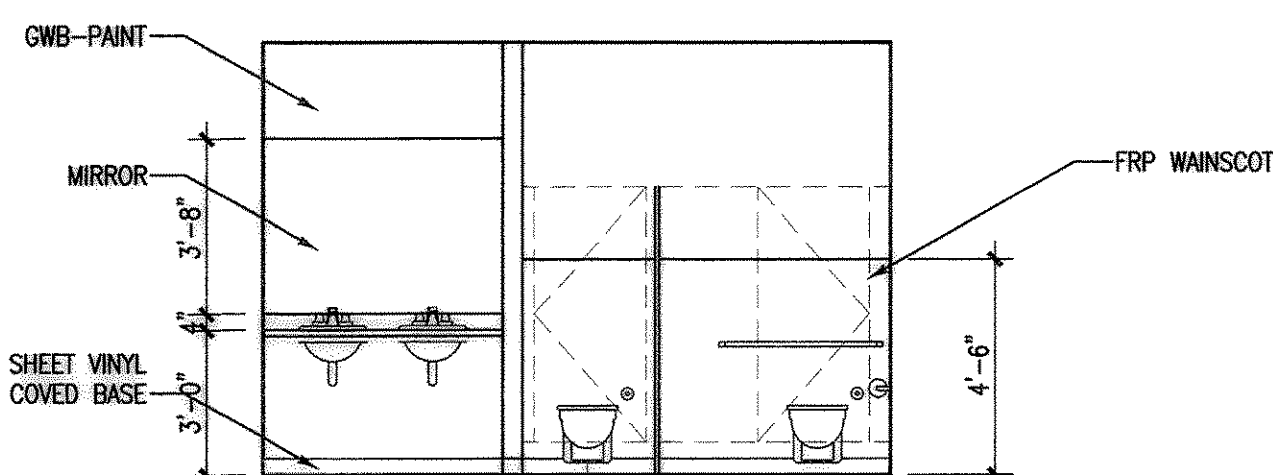**2 MEN- MARINE BLDG.**

SCALE: 1/4" = 1'-0"

DB


101

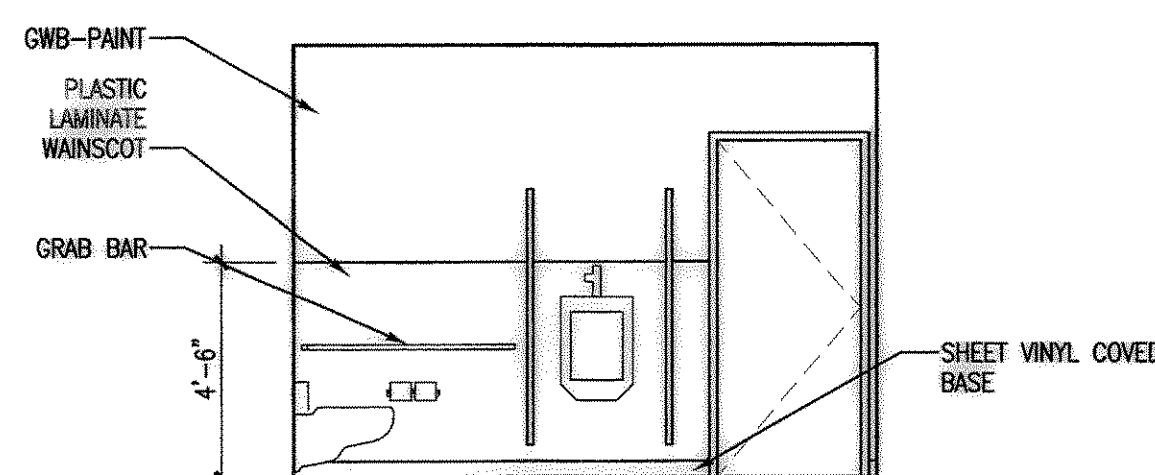**1 MEN - ADMIN. BLDG.**

SCALE: 1/4" = 1'-0"

DB


107

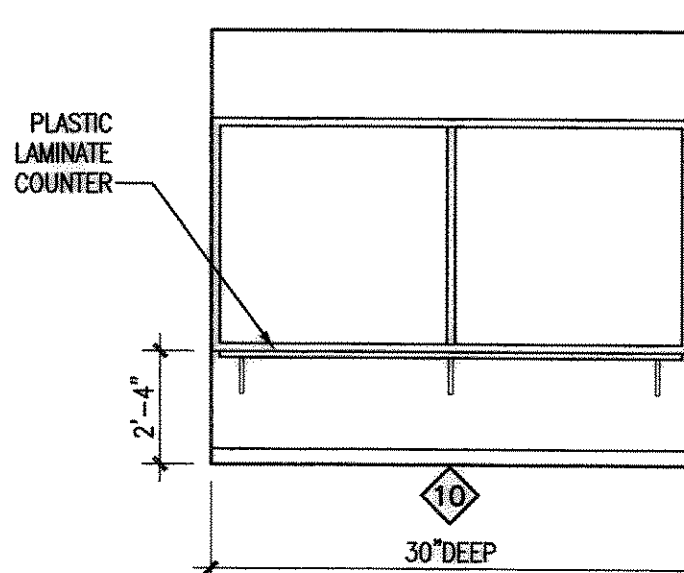**7 OFFICE - GATE SHACKS**

SCALE: 1/4"=1'-0"

DB


100/102/104

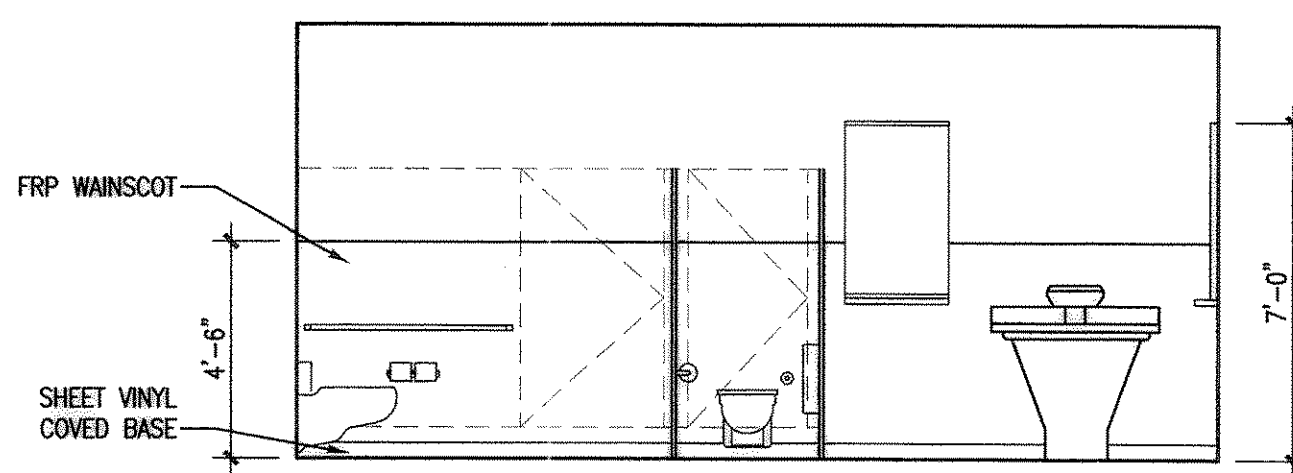**6 WOMEN - MAINT. BLDG.**

SCALE: 1/4"=1'-0"

DB


108

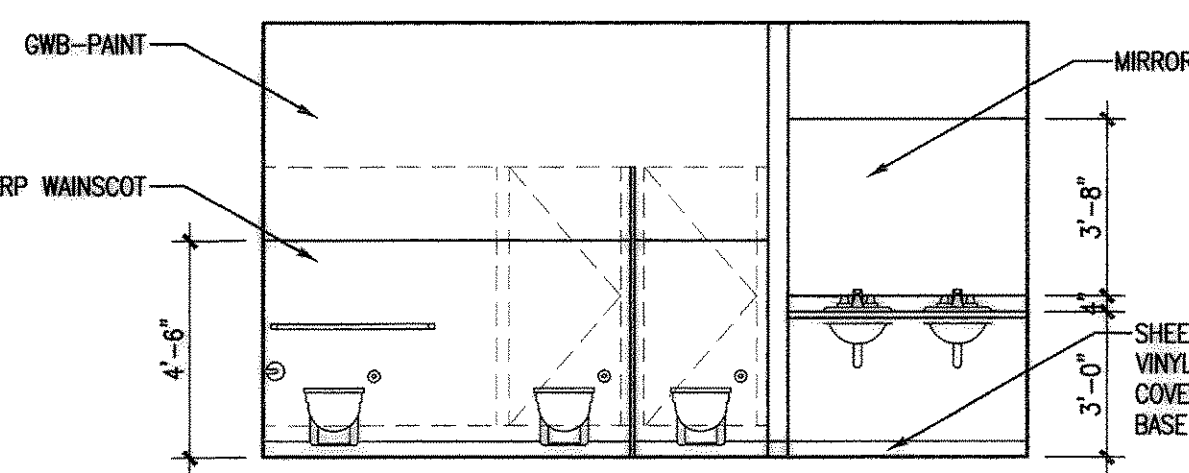**5 WOMEN - MARINE BLDG.**

SCALE: 1/4"=1'-0"

DB


102

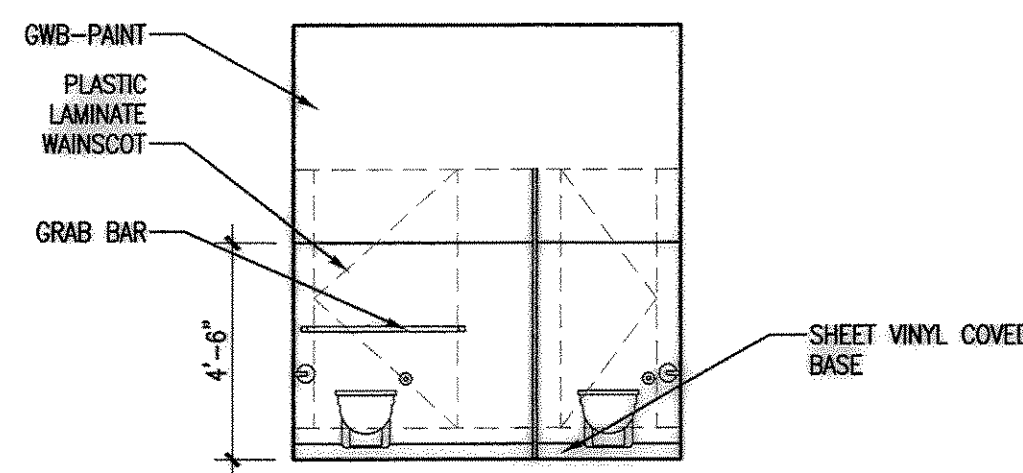**4 WOMEN - ADMIN. BLDG.**

SCALE: 1/4"=1'-0"

DB


105

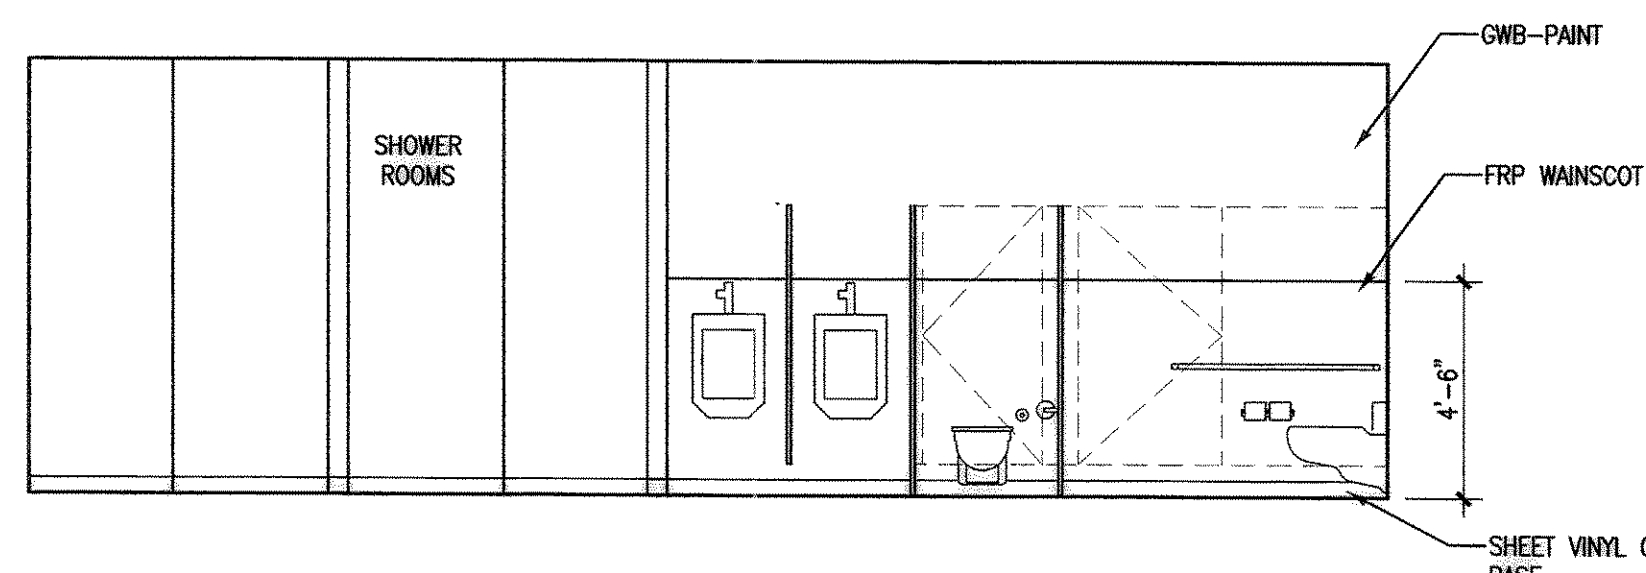**10 MEN'S LOCKER - MAINT. BLDG.**

SCALE: 1/4"=1'-0"

DB


103

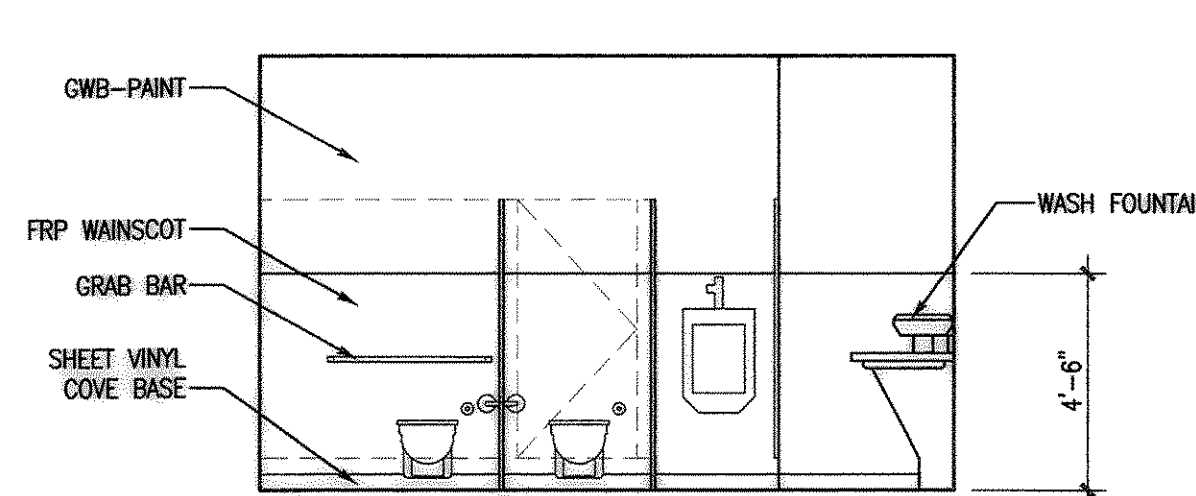**9 MEN - MAINT. BLDG.**

SCALE: 1/4"=1'-0"

DB


101

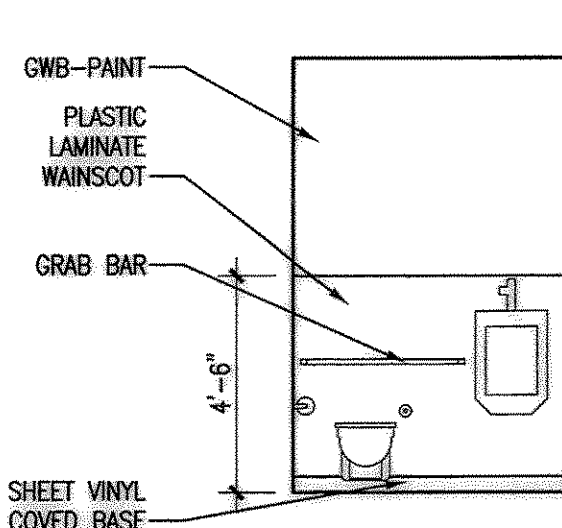**8 MEN - ADMIN. BLDG.**

SCALE: 1/4"=1'-0"

DB


202

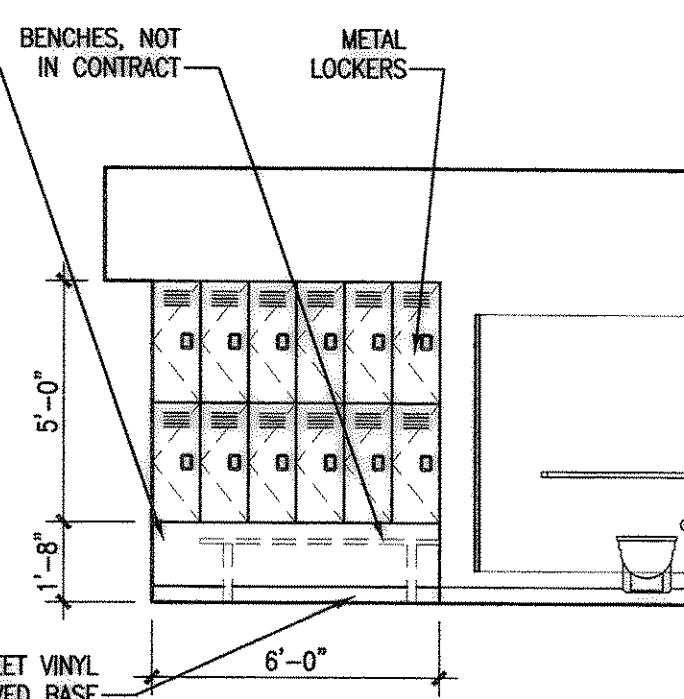**14 WOMEN'S LOCKER - MAINT. BLDG.**

SCALE: 1/4"=1'-0"

DB


108

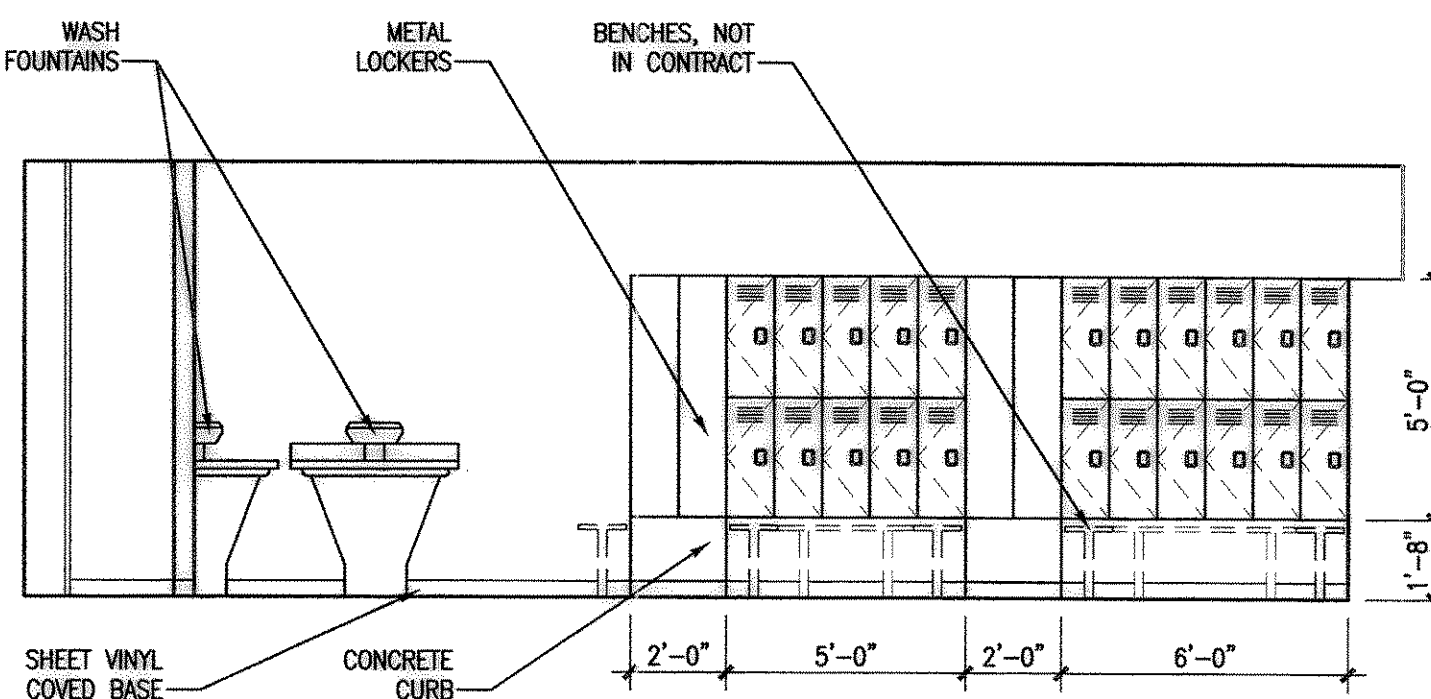**13 MEN'S LOCKER - MAINT. BLDG.**

SCALE: 1/4"=1'-0"

DB


103

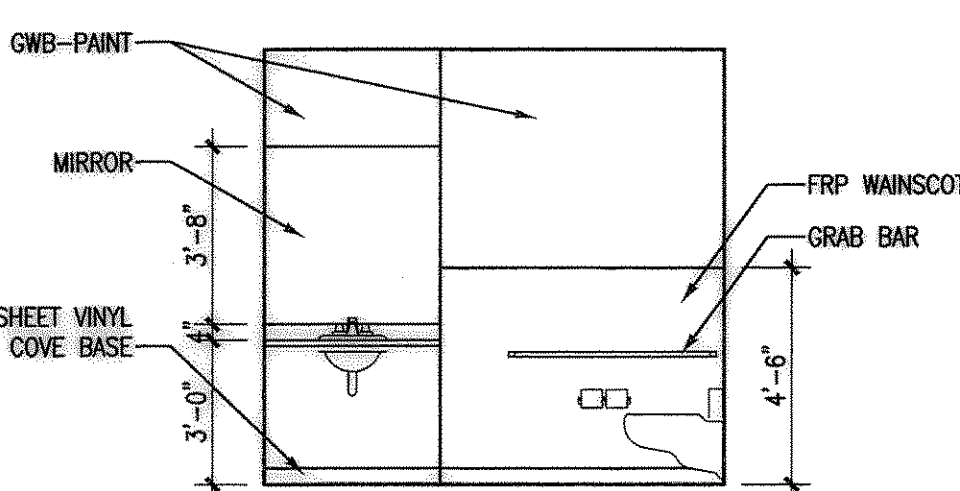**12 WOMEN - MAINT. BLDG.**

SCALE: 1/4"=1'-0"

DB

102

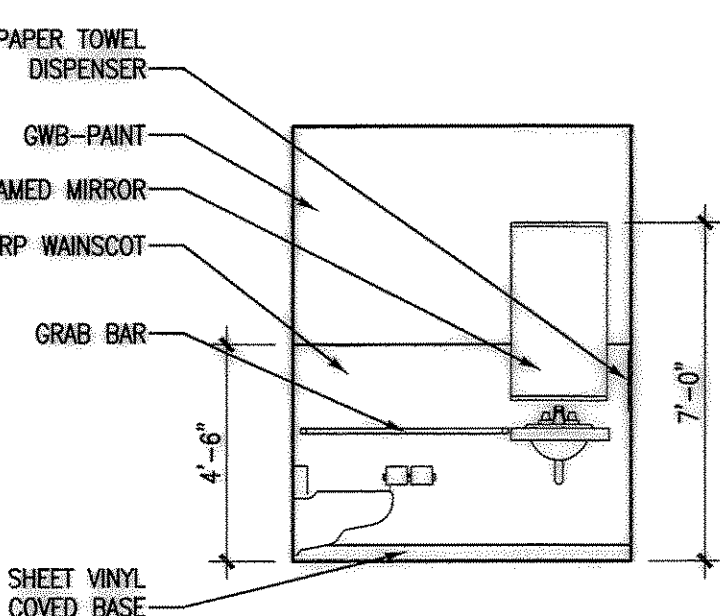**11 WOMEN - ADMIN. BLDG.**

SCALE: 1/4"=1'-0"

DB

203



PORT OF TACOMA P.O. BOX 1897
TACOMA, WA 98401 253-883-8841

6021 12th Street SE
Tacoma, WA 98424
Tel: 253-922-9037
Fax: 253-922-6499

Heitz

RECORD DRAWING

APPROVED

CHIEF ENGINEER - DATE

LC 8/22/03
CHECKED BY - DATE
LC 8/22/03
PROJECT ENGR - DATE

PORT OF TACOMA
PIERCE COUNTY TERMINAL
CASEWORK ELEVATIONS

EP 6321-17

SHEET 229 OF 230

DRAWING DATE: 12/20/04


TOWNSHIP: RANGE: SECTION:


DRAWING SCALE: 1/4" = 1'-0"

DATE: 12/20/04

CONTRACT NUMBER: 998154

PHASE: RECORD DRAWING

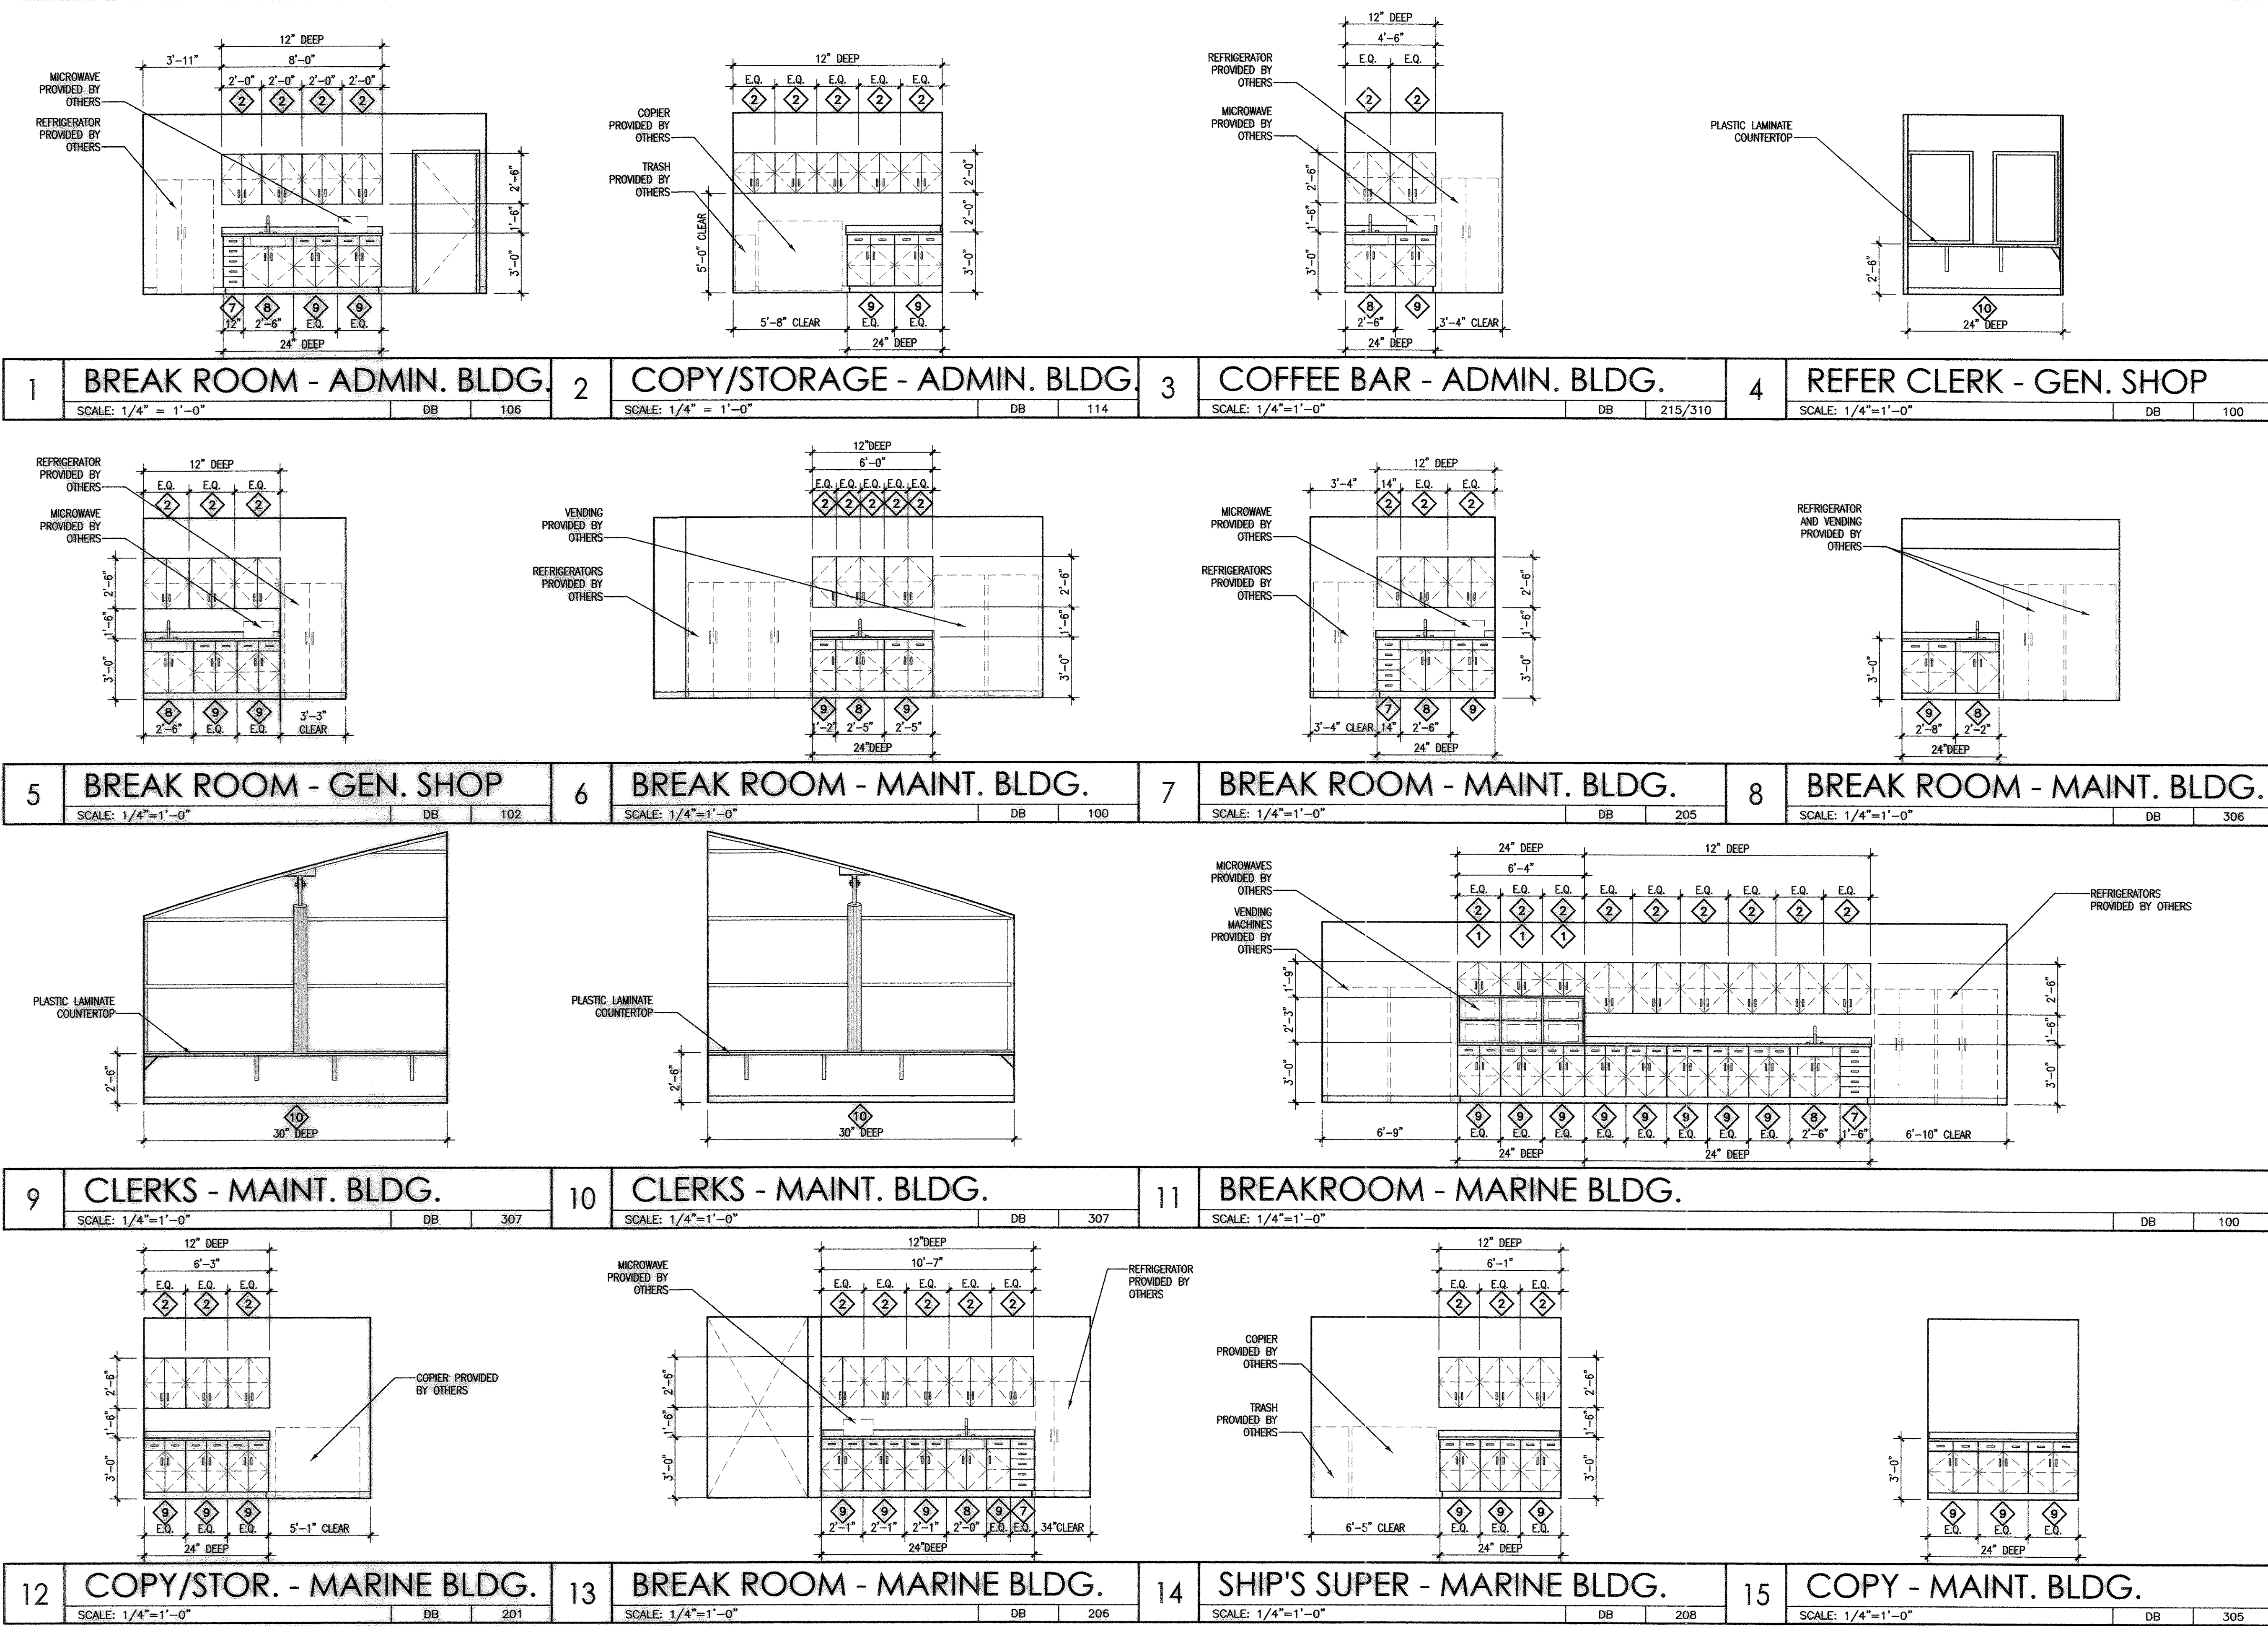

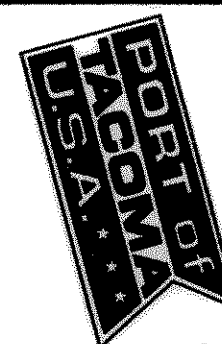

PORT OF TACOMA
TACOMA, WA 98401 253-383-8841

602 12th Street East
Tacoma, WA 98404
Tel: 253.922.9037
Fax: 253.922.6499

RECORD DRAWING

APPROVED

CHIEF ENGINEER - DATE

LC 8/22/03
CHECKED BY - DATE
8/22/03
PROJECT ENGR - DATE


PORT OF TACOMA
PIERCE COUNTY TERMINAL
CASEWORK ELEVATIONS
AND INTERIOR DETAILS

EP-6554-17

A7.613
SHEET 230 OF 230


CONTRACT NUMBER: 998154
E NUMBER: E1974
PHASE: RECORD DRAWING

6321-17

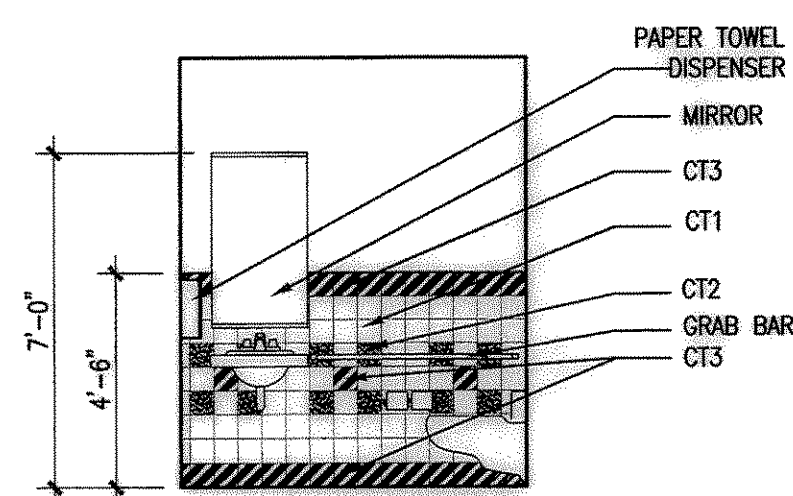


1 MEN'S - ADMIN. BLDG.

SCALE: 1/4"=1'-0" DB 302

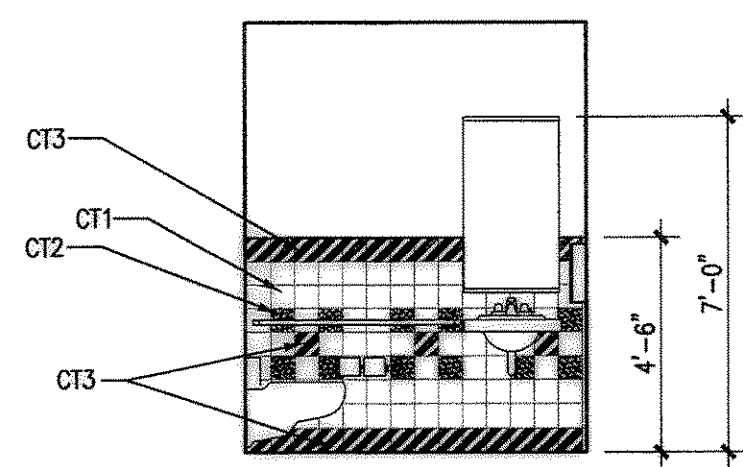


2 WOMENS - ADMIN. BLDG.

SCALE: 1/4"=1'-0" DB 303

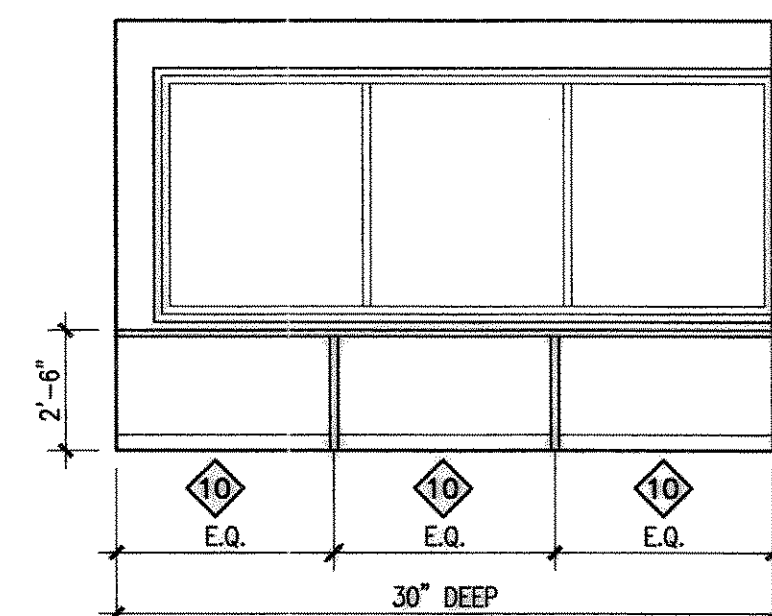


3 CLERKS - MARINE BLDG.

SCALE: 1/4"=1'-0" DB 207

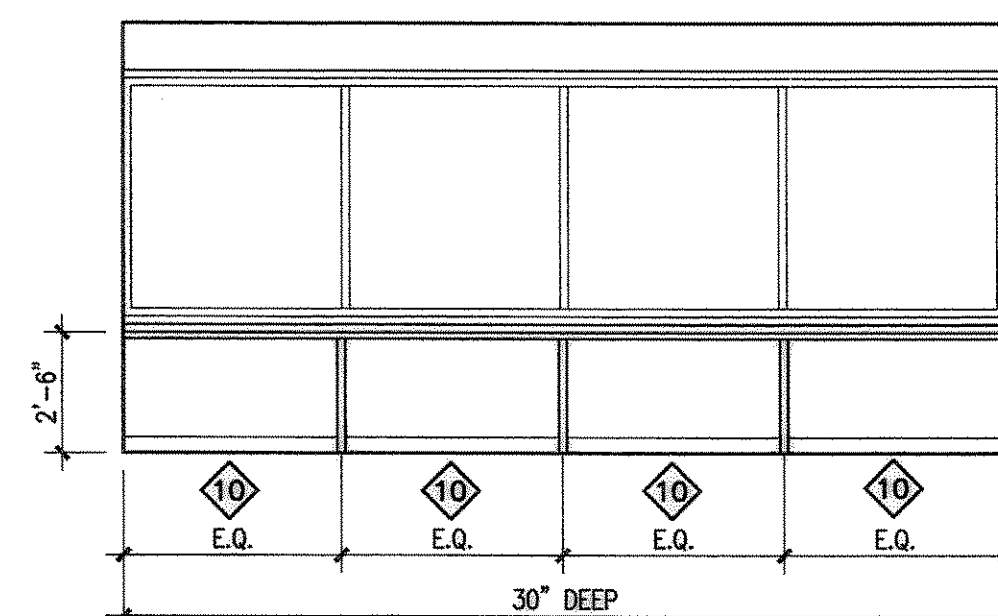


4 CLERKS - MARINE BLDG.

SCALE: 1/4"=1'-0" DB 209

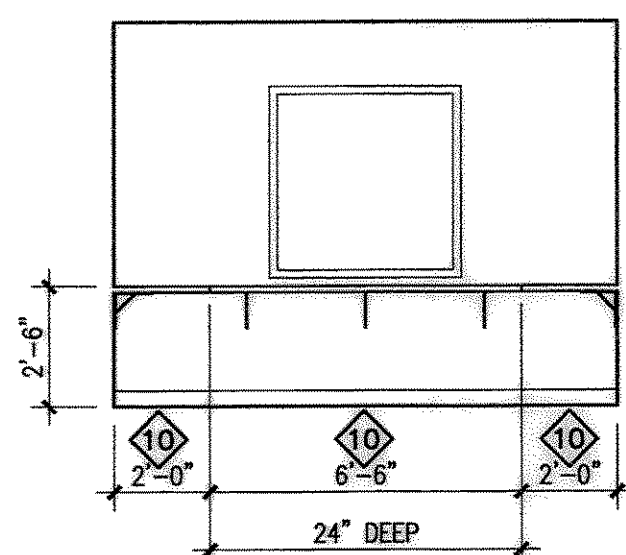


5 OFFICE - ROADABILITY BLDG.

SCALE: 1/4"=1'-0" DB 112

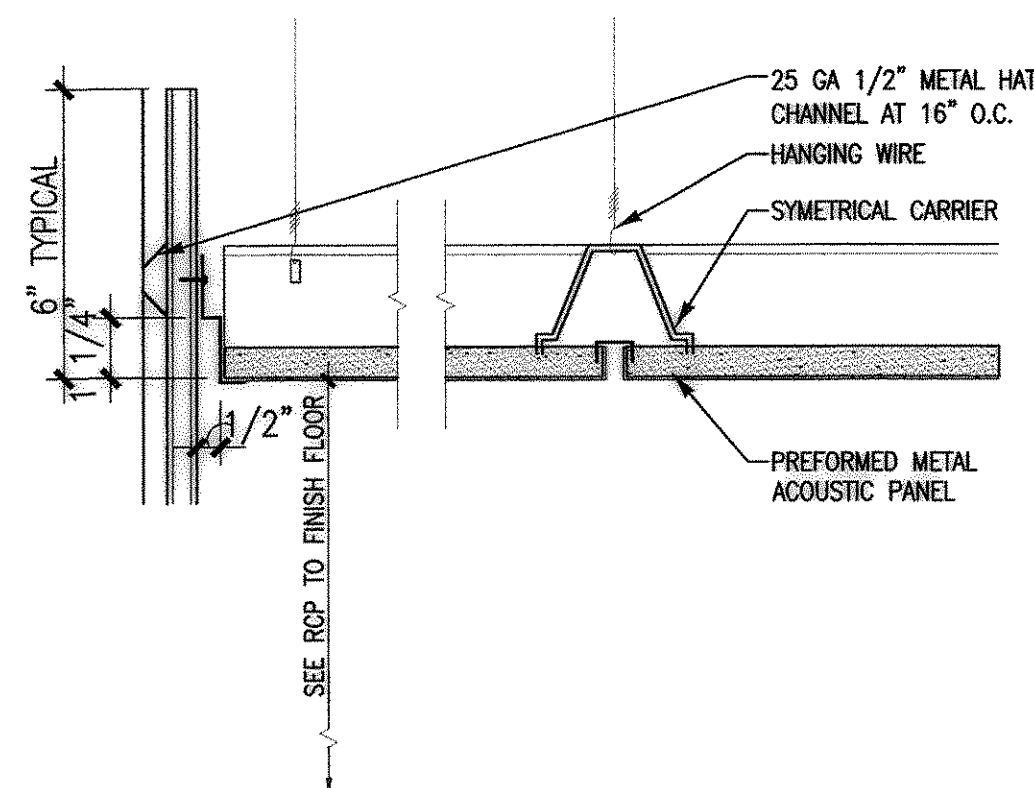


6 PANEL DETAIL

SCALE: 3/8"=1'-0" DB -

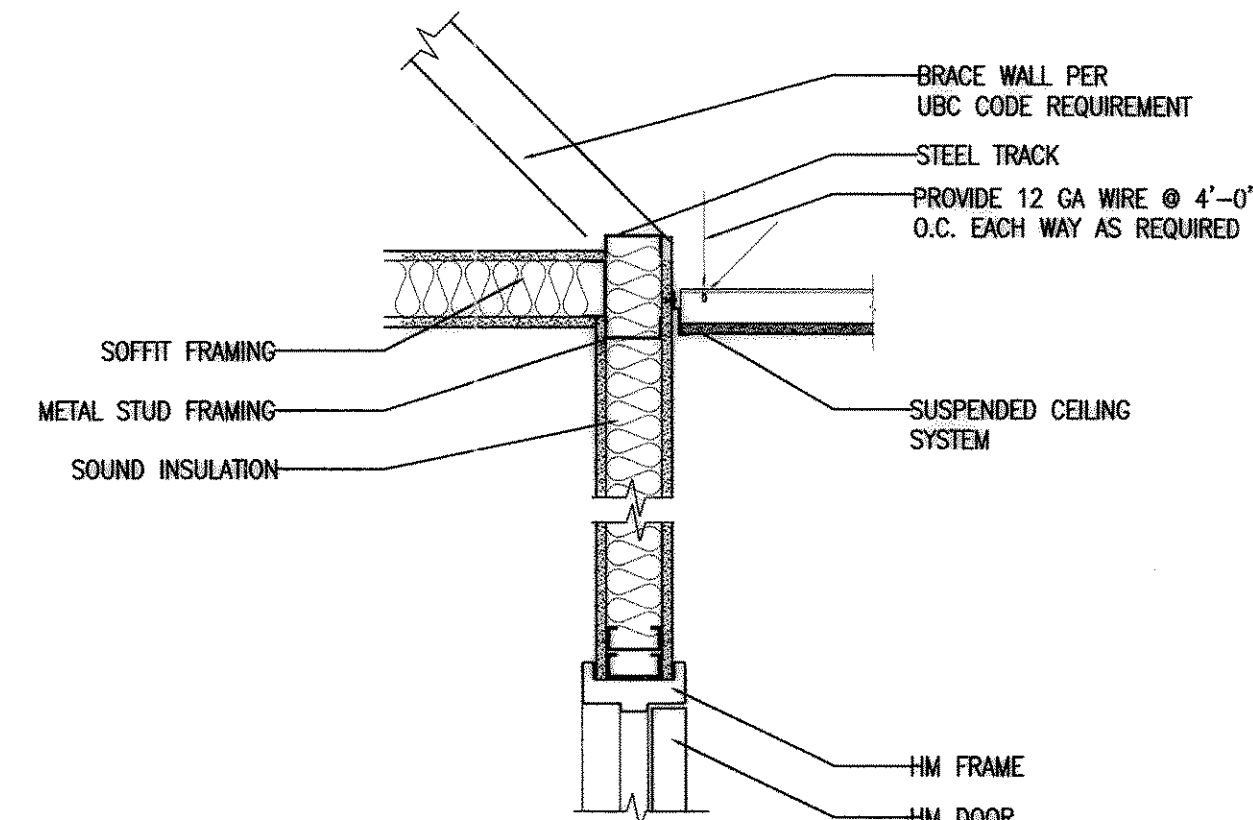


7 LAT. BRACING / DOOR DETAIL

SCALE: 1"=1'-0" DB -

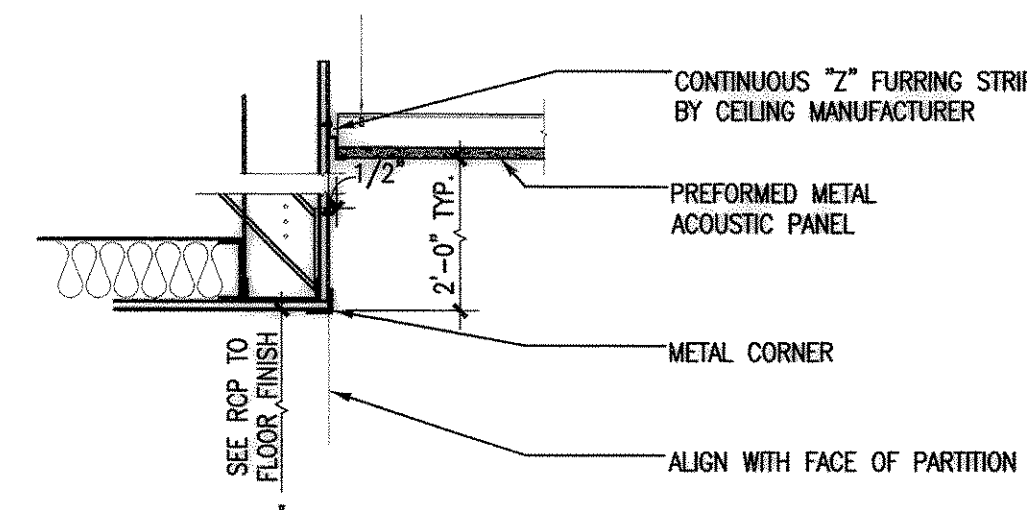


8 SOFFIT / ACT DETAIL

SCALE: 1"=1'-0" DB -

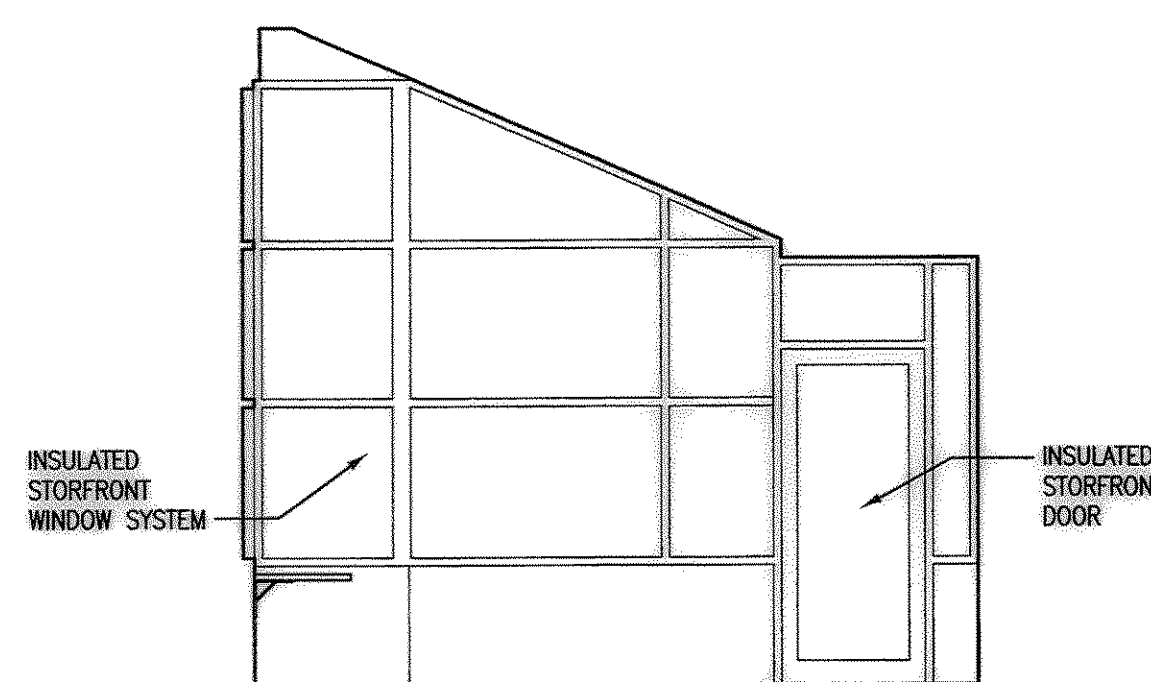


9 CLERKS - MAINT. BLDG.

SCALE: 1/4"=1'-0" PC 307

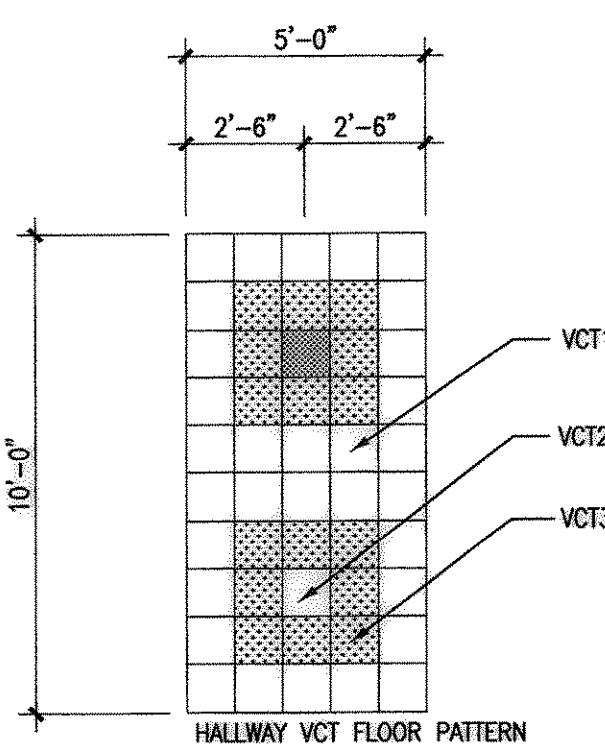


10 VCT FLOOR PATTERN

SCALE: 1/4"=1'-0" DB 307

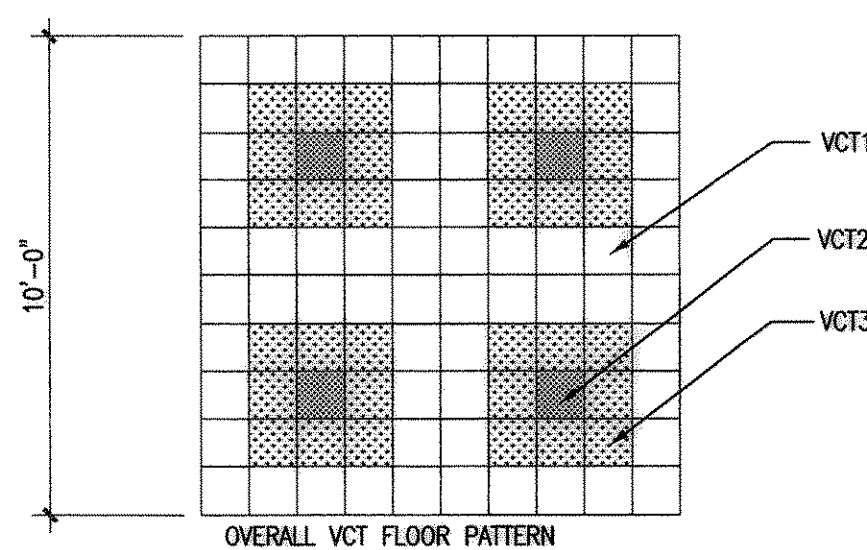


11 HALF HEIGHT WALL CAP

SCALE: 3/8"=1'-0" PEC -

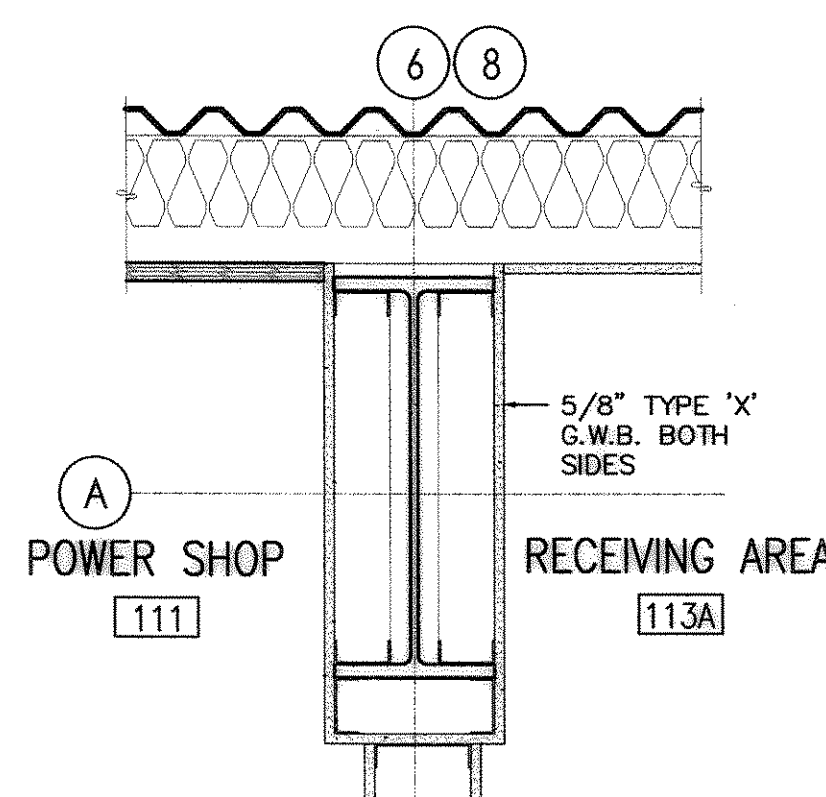


12 1 HOUR COLUMN

SCALE: 1"=1'-0" PEC -

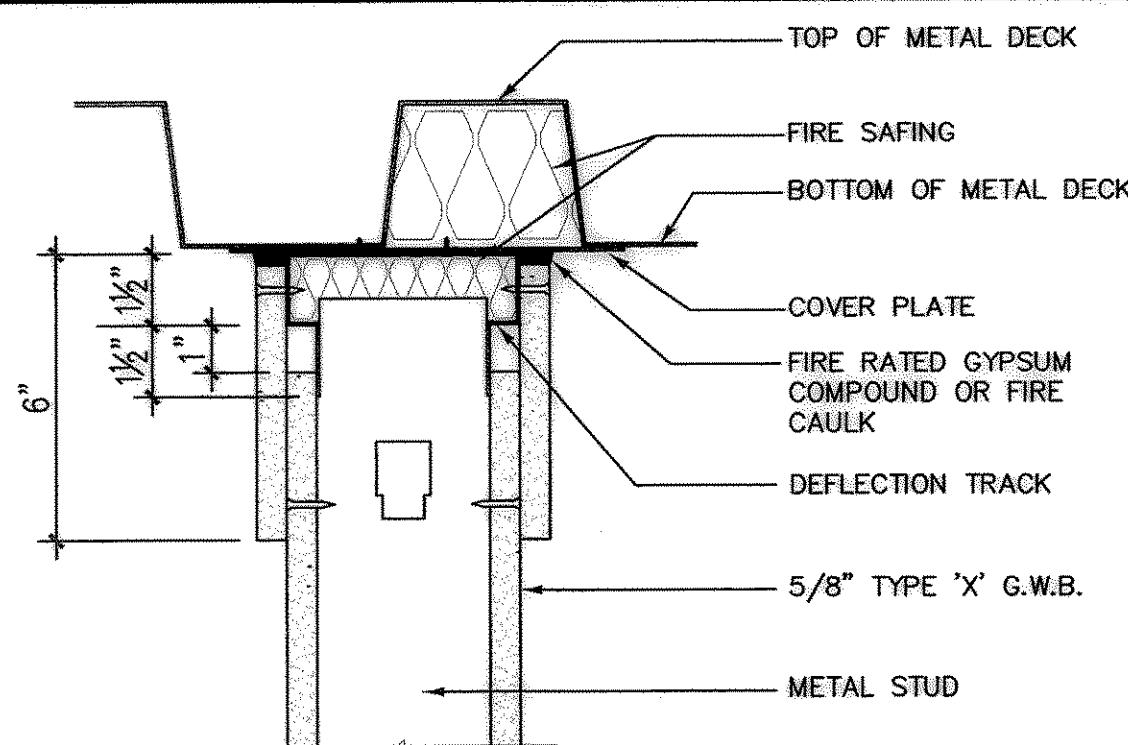

13 DEFLECTION HEAD

SCALE: 3/8"=1'-0" PEC -

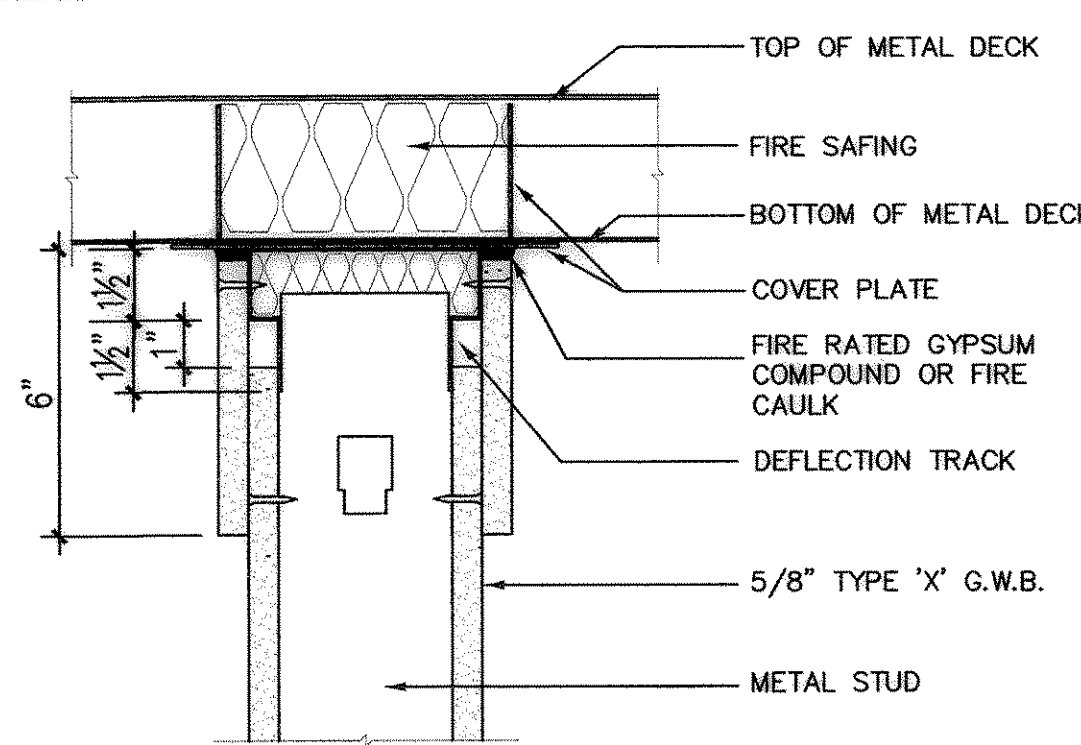

14 DEFLECTION HEAD

SCALE: 3/8"=1'-0" PEC -