

TACOMA TERMINALS INC.

PORT COMMISSIONERS

1984

ROBERT G. EARLEY
JACK A. FABULICH
JOE E. FAKER
JOHN A. McCARTHY
PATRICK O'MALLEY

CHARLES E. DOAN ACTING EXECUTIVE
DIRECTOR
JOHN J. TERPSTRA PROJECT MANAGER

ARCHITECT

McGRANAHAN, MESSENGER ASSOCIATES
950 S. FAWCETT, SUITE 300
TACOMA, WA 98402 383-3084




PORT OF TACOMA PHASE III

STRUCTURAL ENGINEER


ADAMS-HODSDON ENGINEERS, INC.
5308 12th STREET EAST
TACOMA, WA 98424 922-1600

MECHANICAL/ELECTRICAL ENGINEER

TRES WEST ENGINEERS, INC.
2719 ROCHESTER STREET WEST, SUITE 2
TACOMA, WA 98466 565-6252

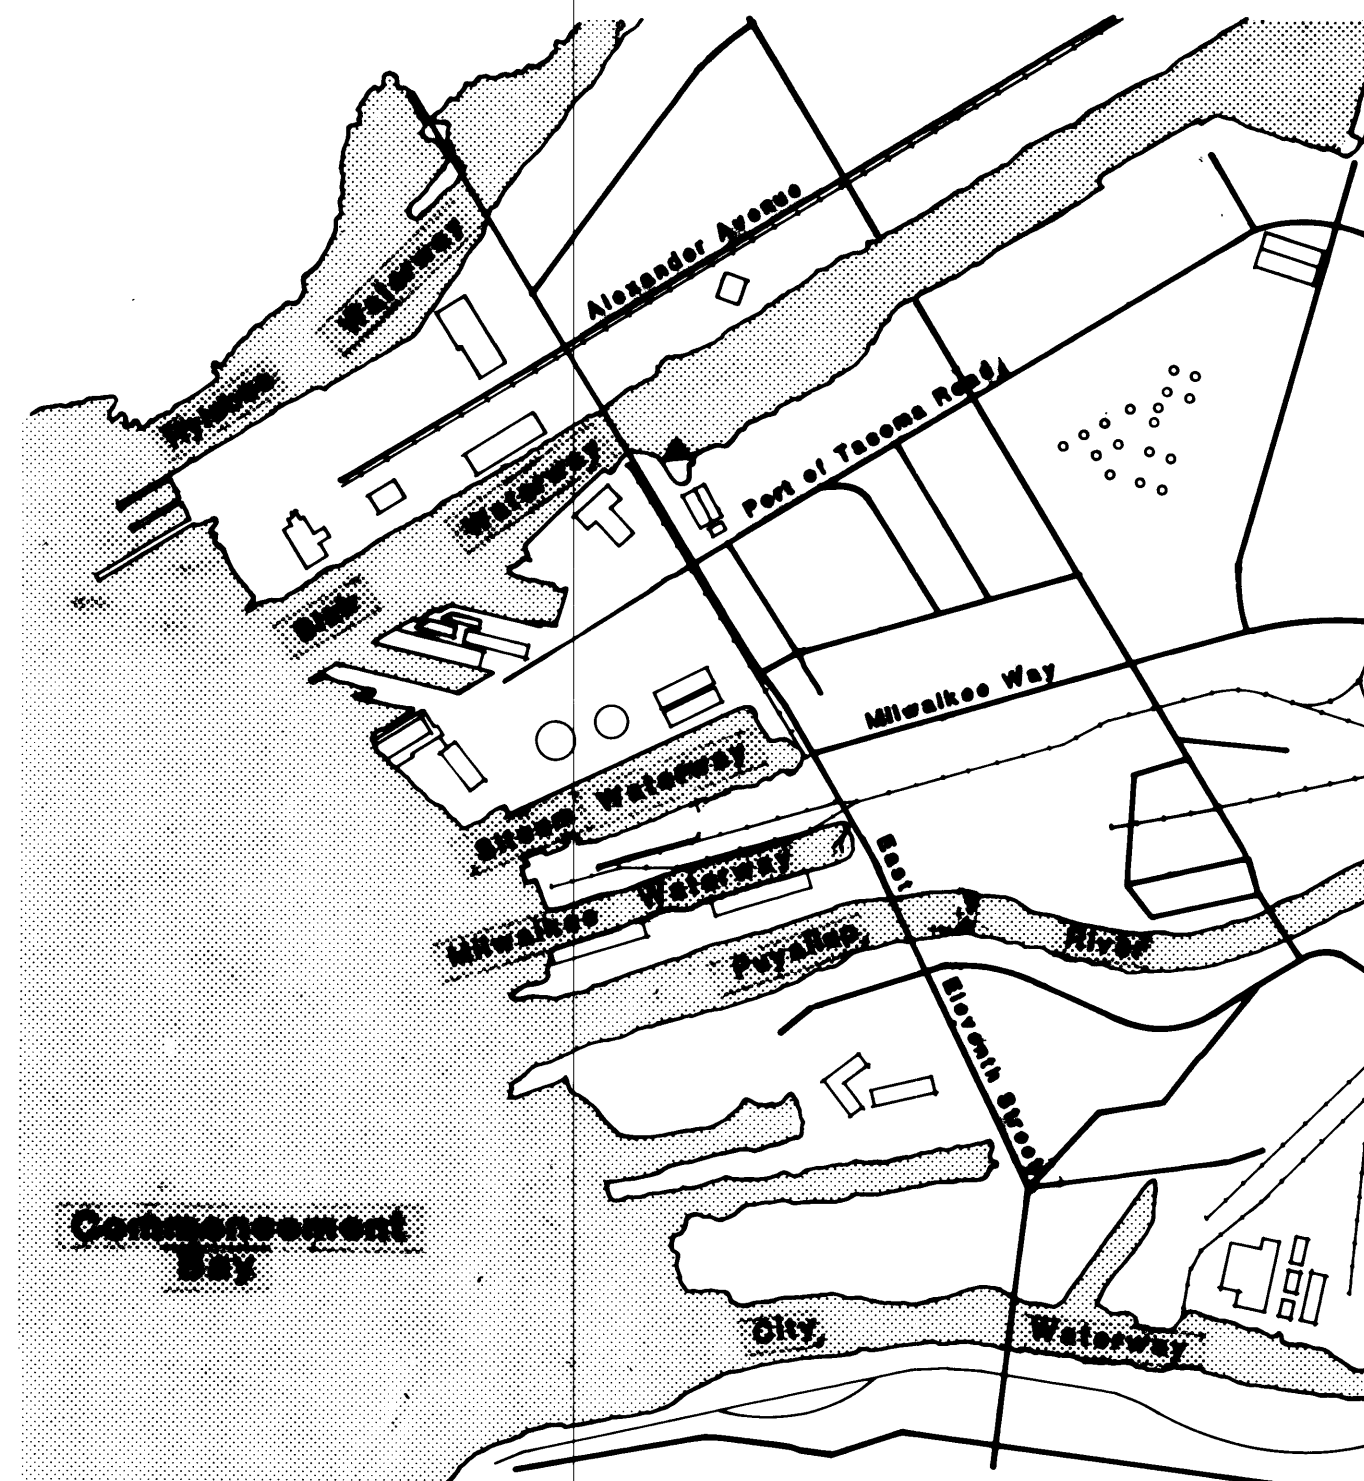

VICINITY MAP

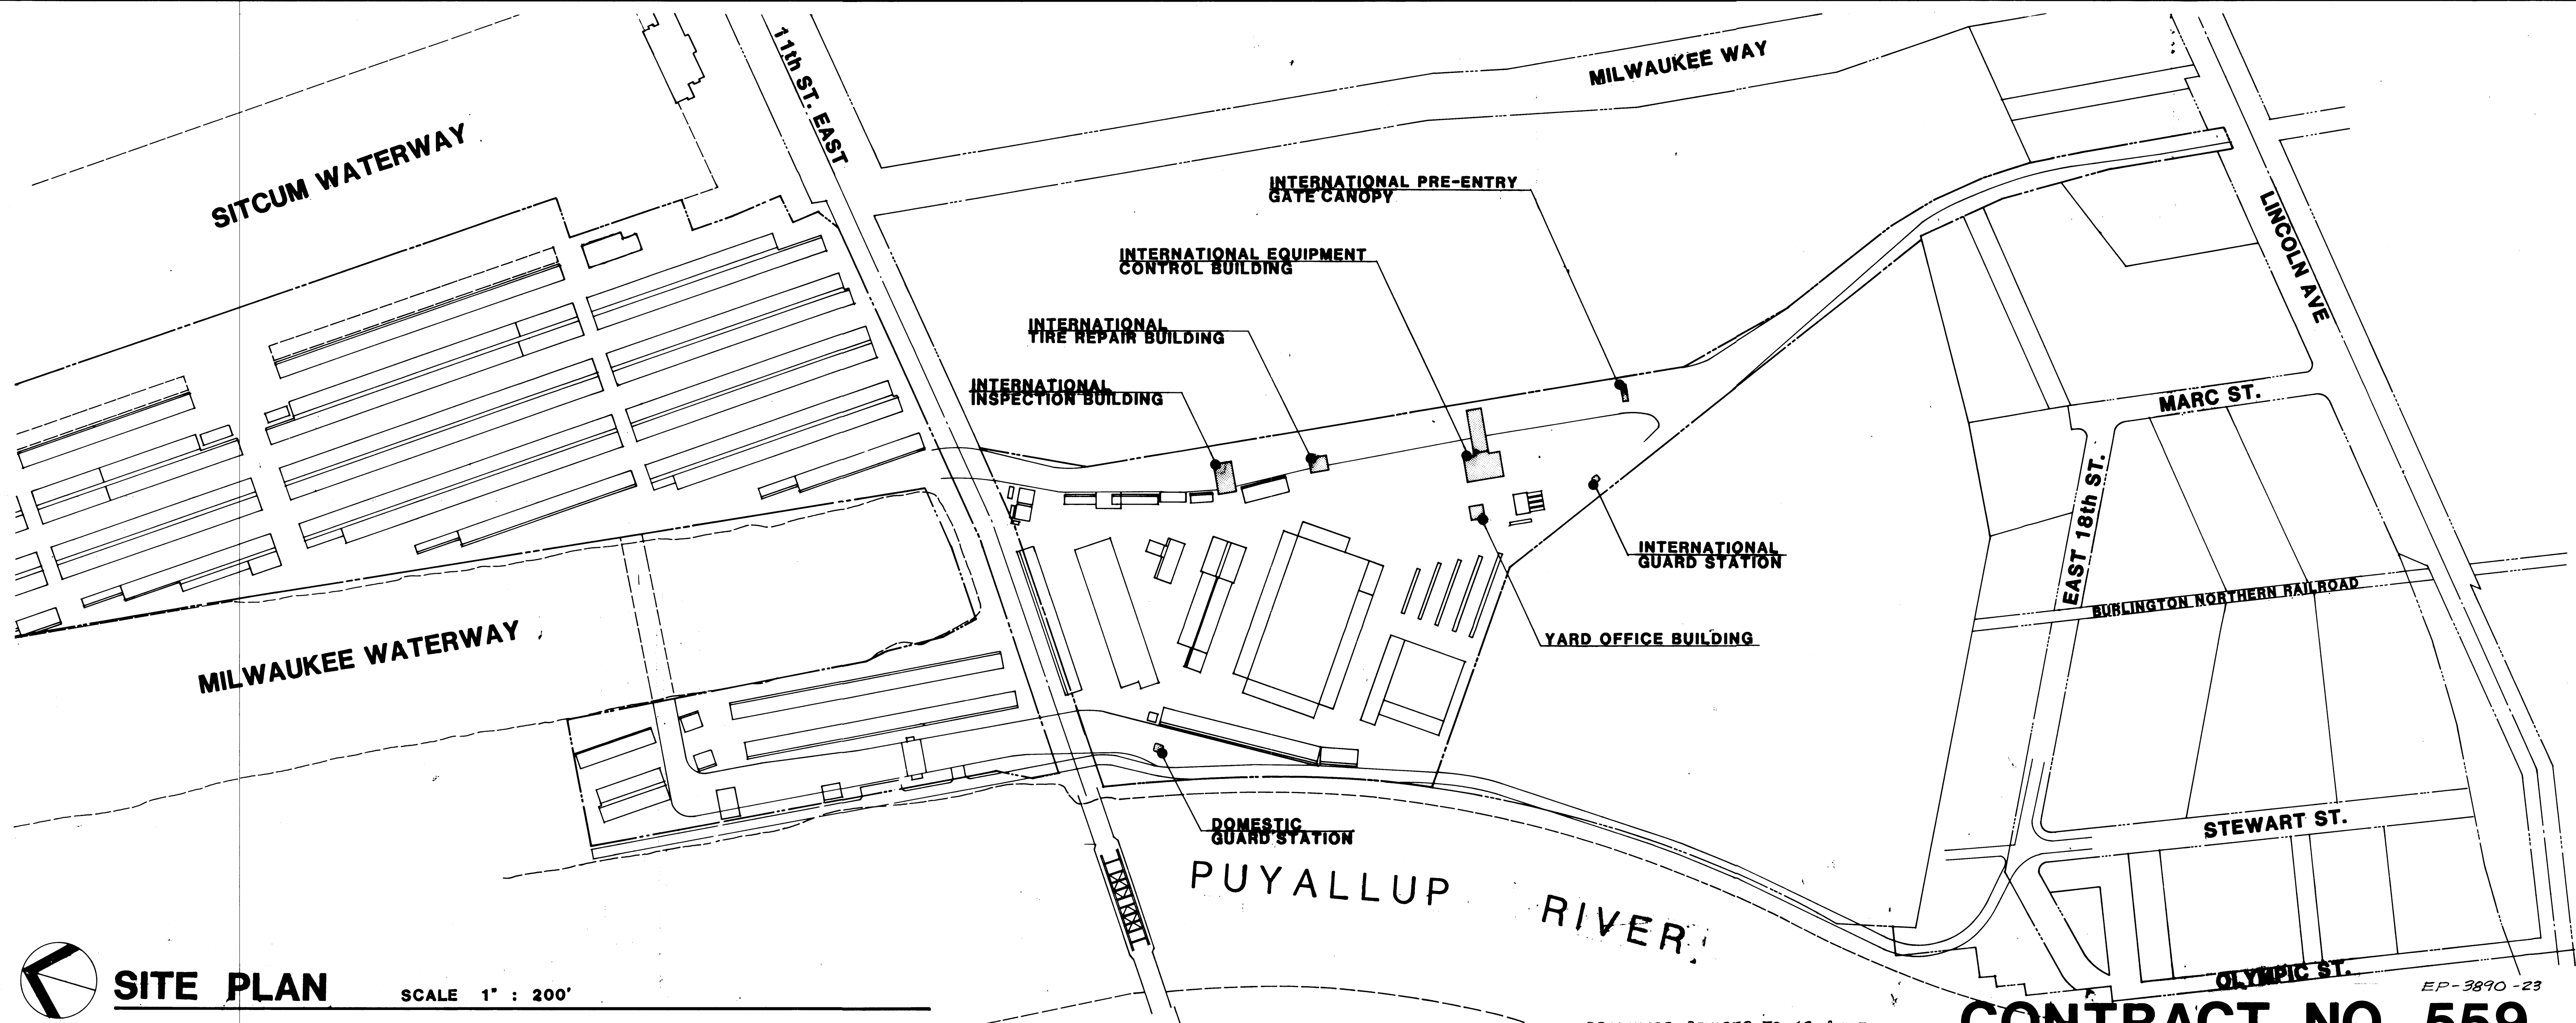

INDEX OF DRAWINGS

- 6-A0-1 INDEX OF DRAWINGS KEY TO SYMBOLS & CODE DATA
- 6-E0-1 ELECTRICAL SCHEDULES

BUILDING NO. 1: INTERNATIONAL EQUIPMENT CONTROL

- 6-A5-1 FIRST LEVEL FLOOR PLAN
- 6-A5-2 SECOND LEVEL FLOOR PLAN / DOOR, FRAMES, & WINDOW TYPES
- 6-A5-3 FIRST LEVEL REFLECTED CEILING PLAN
- 6-A5-4 SECOND LEVEL REFLECTED CEILING PLAN / STAIR PLANS & SECTIONS
- 6-A5-5 ROOF PLAN
- 6-A5-6 EXTERIOR ELEVATIONS
- 6-A5-7 INTERIOR ELEVATIONS
- 6-A5-8 WALL SECTIONS
- 6-S5-1 FOUNDATION PLAN
- 6-S5-2 SECOND FLOOR FRAMING
- 6-S5-3 ROOF FRAMING
- 6-M5-1 MECHANICAL FOUNDATION PLAN / PLUMBING RISER DIAGRAMS
- 6-M5-2 PLUMBING & HVAC: FIRST FLOOR /
- 6-M5-3 PLUMBING & HVAC: SECOND FLOOR 1/4" PLANS & SECTIONS
- 6-M5-4 PLUMBING & HVAC: SECOND FLOOR CEILING PLAN
- 6-E5-1 FIRST FLOOR LIGHTING PLAN
- 6-E5-2 SECOND FLOOR LIGHTING PLAN & PANEL SCHEDULES
- 6-E5-3 FIRST FLOOR POWER PLAN
- 6-E5-4 SECOND FLOOR POWER PLAN & SYSTEM RISER DIAGRAM

BUILDING NO. 2: YARD OFFICE

- 6-A6-1 FLOOR PLAN, EXTERIOR ELEVATIONS, INTERIOR ELEVATIONS, AND DOOR, FRAMES, & WINDOW TYPES
- 6-A6-2 BUILDING SECTIONS, WALL SECTIONS, ROOF PLAN, REFLECTED CEILING PLAN, AND 1/4" TOILET ROOM PLAN
- 6-S6-1 STRUCTURAL PLANS
- 6-M6-1 HVAC & PLUMBING PLANS
- 6-E6-1 ELECTRICAL PLANS

BUILDING NO. 3: INTERNATIONAL INSPECTION BUILDING

- 6-A7-1 FLOOR PLAN, ELEVATIONS, BUILDING SECTIONS & INTERIOR ELEVATIONS
- 6-A7-2 ROOF PLAN, REFLECTED CEILING PLAN & WALL SECTIONS
- 6-S7-1 FOUNDATION PLAN, ROOF FRAMING PLAN & DETAILS
- 6-M7-1 PLUMBING & HVAC
- 6-E7-1 LIGHTING PLAN, POWER & RISER DIAGRAM

BUILDING NO. 4: INTERNATIONAL TIRE REPAIR BUILDING

- 6-A8-1 FLOOR PLAN, ELEVATIONS, BUILDING SECTIONS & INTERIOR ELEVATIONS
- 6-A8-2 ROOF PLAN, REFLECTED CEILING PLAN & WALL SECTIONS
- 6-S8-1 FOUNDATION PLAN & FRAMING PLANS
- 6-M8-1 PLUMBING & HVAC
- 6-E8-1 LIGHTING PLAN, POWER PLAN & SYSTEMS RISER DIAGRAM

