


PANEL SCHEDULES

PANEL	CUT. NO.	SERVICE	AMPS	POLES	LOAD	PANEL	CUT. NO.	SERVICE	AMPS	POLES	LOAD	PANEL	CUT. NO.	SERVICE	AMPS	POLES	LOAD
'A'	1A 1/2" 10B	LIGHTING	20	1	29.6 KW	'E'	1A 1/2" 9B 11C	LIGHTING 7 SPARE	20	1	28.9 KW	'K'	1A 1/2" 3B	LIGHTING	20	1	5.5 KW
	11B 12	SPARES 11-LIGHTING	20	1	4.0 KW		10B 12C	SPARES	20	1	4.0 KW		1A 1/2" 4B 6C 8C	SPARES	20	1	8.0 KW
	13 14 15	OUTDOOR HEAT PUMP	20	3	25.1 KW		13 14	POWER DOORS	20	3	8.6 KW		7 8	HYDRAULIC RAMP	20	3	12.6 KW
	20 25 26 27	OUTDOOR HEAT PUMP	20	3	45.0 KW		17	PUL. 'E'	20	3	16.8 KW		19A B	PUL. 'N'	26	2	7.5 KW
	31A	WALL HEATER	20	1	1.5 KW		20	TENCH COMPRESSOR	20	3	17.4 KW		(8) SPACES				
	32A 1/2" 36C	RECEPTACLES 2ND FLOOR	20	1	18.0 KW		25A 1/2" 36C	SPARES 27-"V" & "X" FIXTURES (12) SPACES	20	1	18.0 KW						
	37	FIRE EXTINGUISHER AIR COMPRESSOR	20	3	4.0 KW												
	38 39 40	REFRIGERATION RECEPT.'S	20	3	182.0 KW												
	45	PUL. 'P'	20	3	15.0 KW												
	75	REFRIGERATION RECEPT.'S	20	3	18.5 KW												
TOTAL CONNECTED LOAD					335.1 KW	TOTAL CONNECTED LOAD					84.5 KW	TOTAL CONNECTED LOAD					95.6 KW
'B'	1A	LIGHTING	20	1	1.7 KW	'F'	1A 1/2" 3B 4C	LIGHTING	20	1	3.9 KW	'L'	1A 1/2" 13	REFRIGERATION RECEPT.'S	20	3	73.0 KW
	2A 1/2" 36A	RECEPT.'S	20	1	99.9 KW		2A 1/2" 4B 6C	RECEPT.'S	20	1	2.7 KW		14A 16B 18C	SPARES	20	1	6.0 KW
	3A 4B 5B	SPARES	20	1	8.5 KW		7A	TOOL CHED 1-BAY	20	1	1.0 KW		17	PUL. 'M'	20	3	15.0 KW
	57B	SPARE	20	1	1.0 KW		8B	LIGHTING	20	1	1.0 KW		20 1/2" 36A	CONVEYOR	20	3	116.3 KW
	57C 5 1/2" 6C	SPARES	20	1	6.7 KW		10B	T.V. CAMERAS	20	1	2.5 KW		30A 32B 34C	SPARES (10) SPACES	20	1	6.0 KW
	60C	P.A. PUL.	20	1	1.0 KW		12C 1/2" 36B	CABLES CONTROL POWER FOR TIRE ELEVATOR ARRIVAL PANEL 'E'	20	1	6.0 KW						
	62A 6 1/2" 6B	RECEPT.'S	20	1	1.0 KW												
	64B	INTERCOM BLAST CARD READER POWER MODULE	20	1	1.0 KW												
	65C 1/2" 12C	SEC. CONTROL POWER FOR TIRE ELEVATOR	20	1	8.0 KW												
	70A 70B 70C	INDOOR HEAT PUMP	20	3	15.6 KW	'G'	1A 1/2" 3B 4C	LIGHTING	20	1	6.7 KW	'M'	1A 1/2" 6C	LIGHTING	20	1	7.0 KW
	75	DUCT HEATING COIL (5) SPACES	20	3	8.0 KW		2A 1/2" 4B 6C	RECEPT.'S	20	1	9.9 KW		2A 1/2" 7B	RECEPT.'S	20	1	1.4 KW
TOTAL CONNECTED LOAD					280.0 KW		8A 1/2" 12C	SPARES	20	1	5.0 KW		2A 1/2" 10B 11C 12C	SPARES (10) SPACES	20	1	8.0 KW
'C'	1A 1/2" 5C	LIGHTING	20	1	18.4 KW												
	4C 5 1/2" 6A	H.W. HEATERS	20	1	16.6 KW												
	7	ELEVATOR	20	3	28.5 KW	'H'	1A 1/2" 4B	LIGHTING	20	1	18.0 KW	'N'	1 1/2" 3	RECEPT.'S	20	1	1.5 KW
	10B 11C	SPARES	20	1	4.0 KW		2C 1/2" 7A	SPARES	20	1	4.0 KW		4	SPARE	20	1	1.0 KW
	13 14 15	OUTDOOR HEAT PUMP	20	3	16.3 KW		4C 5 1/2" 6A	LIGHTING	20	1	5.1 KW		5	LIGHTING	20	1	1.2 KW
	17A	WALL HEATER	20	1	4.5 KW		7 8 11C	WALL HEATERS	20	1	6.0 KW		6 1/2" 8	SPARES	20	1	3.0 KW
	20	INDOOR HEAT PUMP	20	3	20.0 KW		10B 11C	SPARES	20	1	6.0 KW						
	21B	SPARE	20	1	9.7 KW		13A 15B 17C	PUL. 'J'	20	1	6.0 KW	'O'	1A 1/2" 3B	RECEPT.'S	20	1	6.0 KW
	23C	SPARE	20	1	8.0 KW		16	(10) SPACES	20	3	90.0 KW		3C	RECEPT.	20	1	1.0 KW
	25A	ENH. P.W.	20	1	1.4 KW								5C	RECEPT.	20	1	7.0 KW
	26	DUCT HEAT. COIL	20	3	10.0 KW								57A	T.V. CAMERAS	20	1	1.0 KW
	27B 1/2" 2C	SPARES (10) SPACES	20	1	4.0 KW								58A	RECEPT.	20	1	1.0 KW
TOTAL CONNECTED LOAD					156.7 KW								58B 1/2" 4C	SPARES	20	1	4.0 KW
'D'	1A 1/2" 2A	LIGHTING 11-RECEPTACLES, EXHIBIT LIGHTS	20	1	7.4 KW	'I'	1A	LIGHTING	20	1	7.0 KW	'P'					
	3B 1/2" 6C	SPARES	20	1	8.0 KW		2	CRANE	40	3	11.6 KW						
	7 1/2" 9C	BATTERY CHARGERS	20	3	75.0 KW		3B 1/2" 6C	RECEPT.'S	20	1	1.5 KW						
	37A 1/2" 41C	SPARES	20	1	11.0 KW		1A 1/2" 12C	SPARES 11-RECEPTACLES (10) SPACES	20	1	6.0 KW						
	REC	WALL HT'S	20	1	1.5 KW												
TOTAL CONNECTED LOAD					105.9 KW												

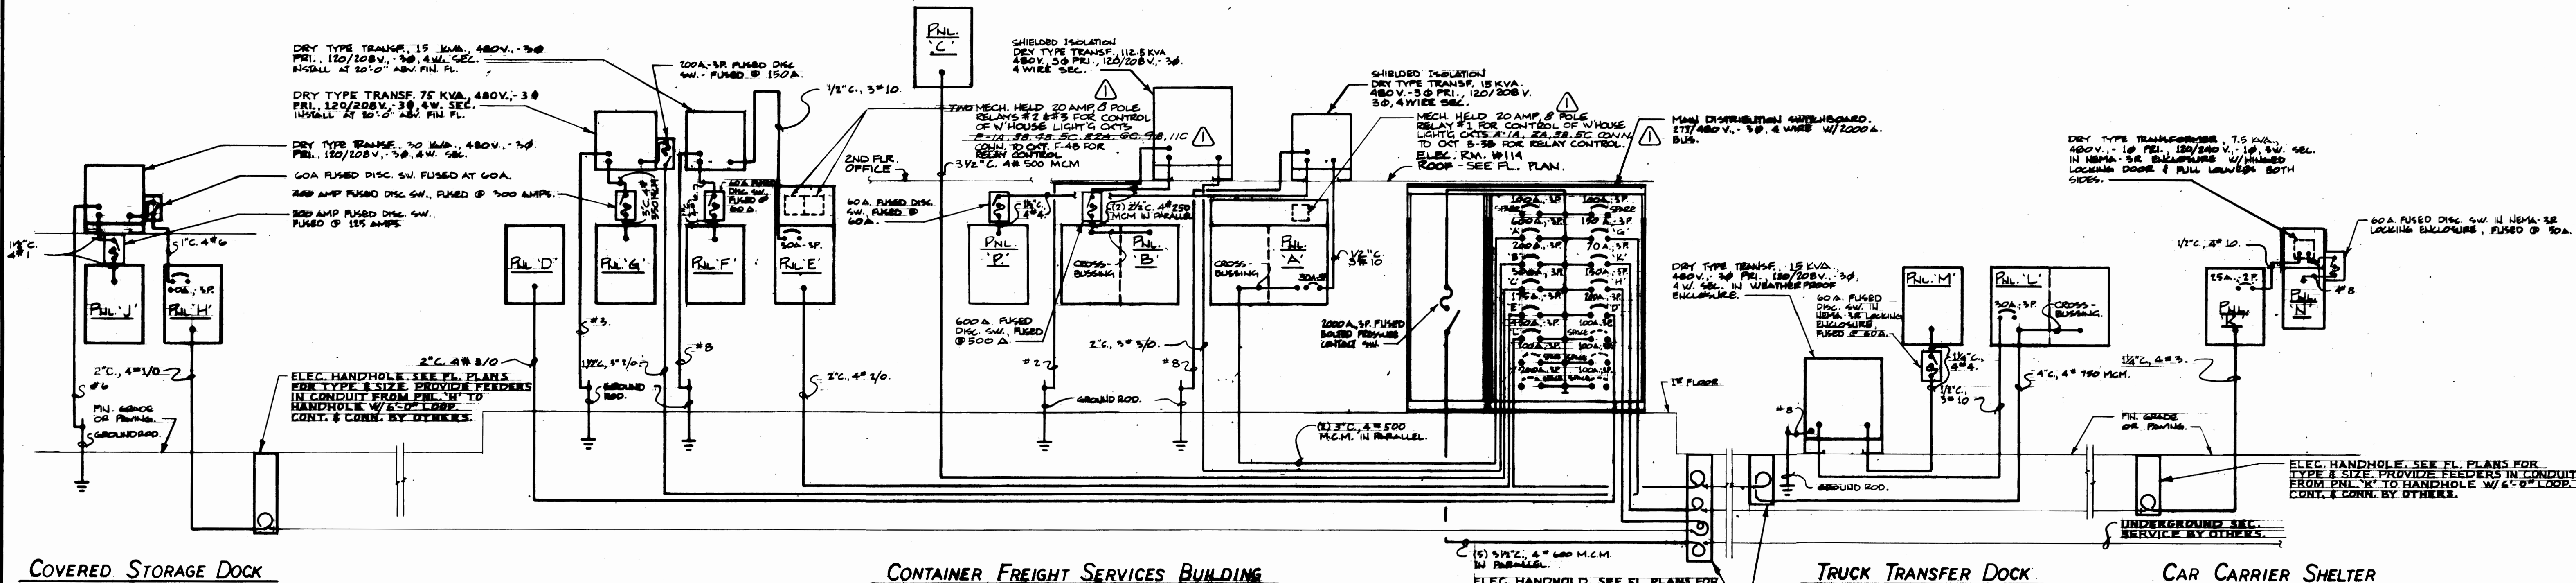

ELECTRICAL DISTRIBUTION DIAGRAM

DIAGRAMMATIC




Allen V. Green, Inc.
Consulting Engineers
31 University, Suite 301
Tacoma, WA 98401
(206) 888-4118
800 3rd Avenue, Suite 301
Tacoma, WA 98402
(206) 382-6787

MARK	REVISION	BY	APP.	DATE
	REVISED TO AS BUILT	R.J.S.	E.V.G.	

DRAWN _____		DATE _____	
CHECKED _____		DATE _____	
CHECKED _____		DATE _____	
CONT. NO. 557		FIELD BOOK (S) _____	
APPROVED _____		DATE 3/30/84	
PROJECT MANAGER _____		DATE 3/30/84	
CHIEF ENGINEER _____		DATE _____	
SCALE _____		DRAWING NO. _____	
TACOMA TERMINALS, INC.		EP 3579-23 E106	
PANEL SCHEDULES & ELEC. DIST. DIAG.		SHEET 42 OF 71	


ELECTRICAL SYMBOLS

SYMBOL	DESCRIPTION	C. M.T.G. HT.	SYMBOL	DESCRIPTION	C. M.T.G. HT.
	FLUORESCENT FIXTURE-SURFACE	—		THERMOSTAT	4'-0"
	FLUORESCENT FIXTURE-RECESSED	—		FIRE DETECTOR	—
	FIXTURE ON EMERGENCY CIRCUIT	—		SMOKE DETECTOR	—
	CEILING SURFACE MOUNTED FIXTURE	—		FIRE ALARM PULL STATION	4'-0"
	WALL MOUNTED FIXTURE	—		FIRE ALARM HORN W/ALARM LIGHT	—
	SQUARE RECESSED INCANDESCENT FIXTURE	—		FIRE ALARM HORN W/ALARM LIGHT	—
	ROUND RECESSED INCANDESCENT FIXTURE	—		WALL MTD. FLUSH JUNCTION BOX	—
	FIXTURE ON NIGHT LIGHTING	—		FLUSH JUNCTION BOX	—
	EXIT FIXTURE, CEILING	—		PROGRAM CLOCK W/BUZZER	—
	EXIT FIXTURE, WALL MOUNTED	—		CLOCK HANGER RECEPTACLE	—
	EXIT FIXTURE, W/DIRECTIONAL ARROW	—		FLUSH FLOOR BOX	—
	SINGLE-POLE SWITCH	4'-0"		LOW VOLTAGE TRANSFORMER	—
	TWO-POLE SWITCH	4'-0"		MICROPHONE OUTLET	4'-0"
	3-WAY SWITCH	4'-0"		TELEPHONE OUTLET	4'-0"
	4-WAY SWITCH	4'-0"		TELEPHONE FLOOR BOX & OUTLET	4'-0"
	KEY-SWITCH	4'-0"		PHOTO-ELECTRIC RELAY	—
	SWITCH W/PILOT LIGHT	4'-0"		PROGRAM GONG	—
	FAN SWITCH FURNISHED BY MFG., INSTALLED BY ELEC.	4'-0"		PANELBOARD	—
	DOOR SWITCH	—		SURFACE METAL RACEWAY	—
	SWITCH W/TIMER	4'-0"		CONDUIT ANY FLOOR OR GRADE	—
	DUPLEX RECEPTACLE	4'-0"		CONDUIT RISE	—
	DUPLEX RECEPTACLE, HORIZONTAL	—		CONDUIT DROP	—
	RECEPTACLE IN FLOOR BOX	—		CONDUIT RUN BELOW FLOOR OR FINISHED GRADE	—
	WEATHERPROOF RECEPTACLE	—		NO. OF CONDUCTORS IN CONDUIT	—
	RANGE RECEPTACLE	—		RUN TO PANEL & NO. OF CIRCUITS	—
	SPECIAL RECEPTACLE, LETTERING INDICATES TYPE	—		MOUNTING HEIGHT ANY FIN. FLOOR	—
	HEAT OUTLET, 120 V, 1-Φ	—		C.R.T. (COMPUTER REMOTE TERMINAL) OUTLET	4'-0"
	HEAT OUTLET, 240 V, 2-Φ	—		C.R.T. FLOOR BOX & OUTLET	—
	POWER OUTLET, 120 V, 1-Φ	—		C.R.T. FLOOR BOX W/BLANK COVER PLATE	—
	POWER OUTLET, 240 V, 2-Φ	—		TELEPHONE FLOOR BOX W/BLANK COVER PLATE	—
	SPEAKER OUTLET, CEILING MFG.	—		INTRUSION ALARM J-BOX	—
	SPEAKER OUTLET, WALL MFG.	—			
	PAGING SYSTEM TEL. OUTLET	—			
	VOLUME CONTROL	—			
	MANUAL DINGER	—			
	MOTORIZED DINGER	—			
	CHIME	—			
	TELEVISION SYSTEM OUTLET	—			

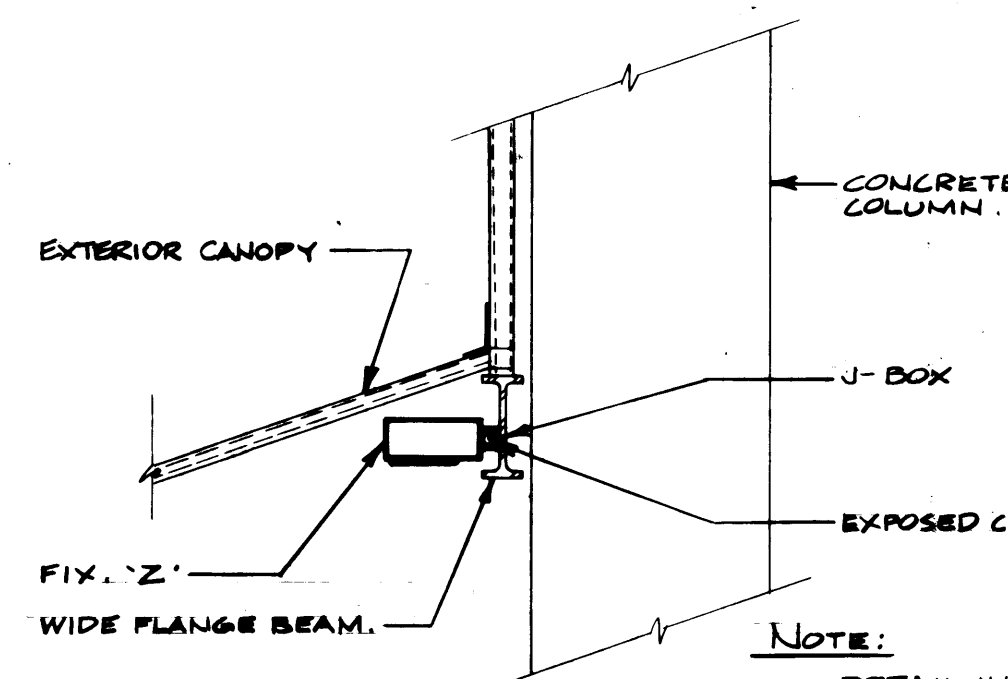


TYPICAL FIXTURE 'Z' INSTALLATION DET.

NOT TO SCALE

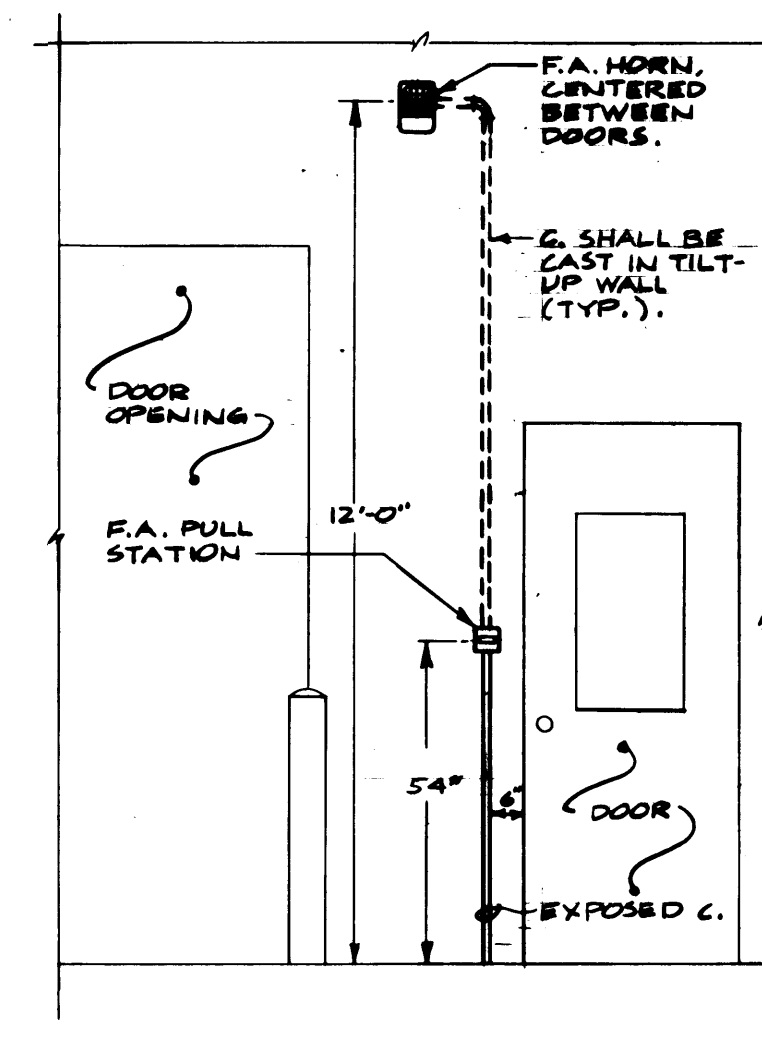


TYP. F. A. HORN & PULL STA. INSTALLATION DET.

NOT TO SCALE

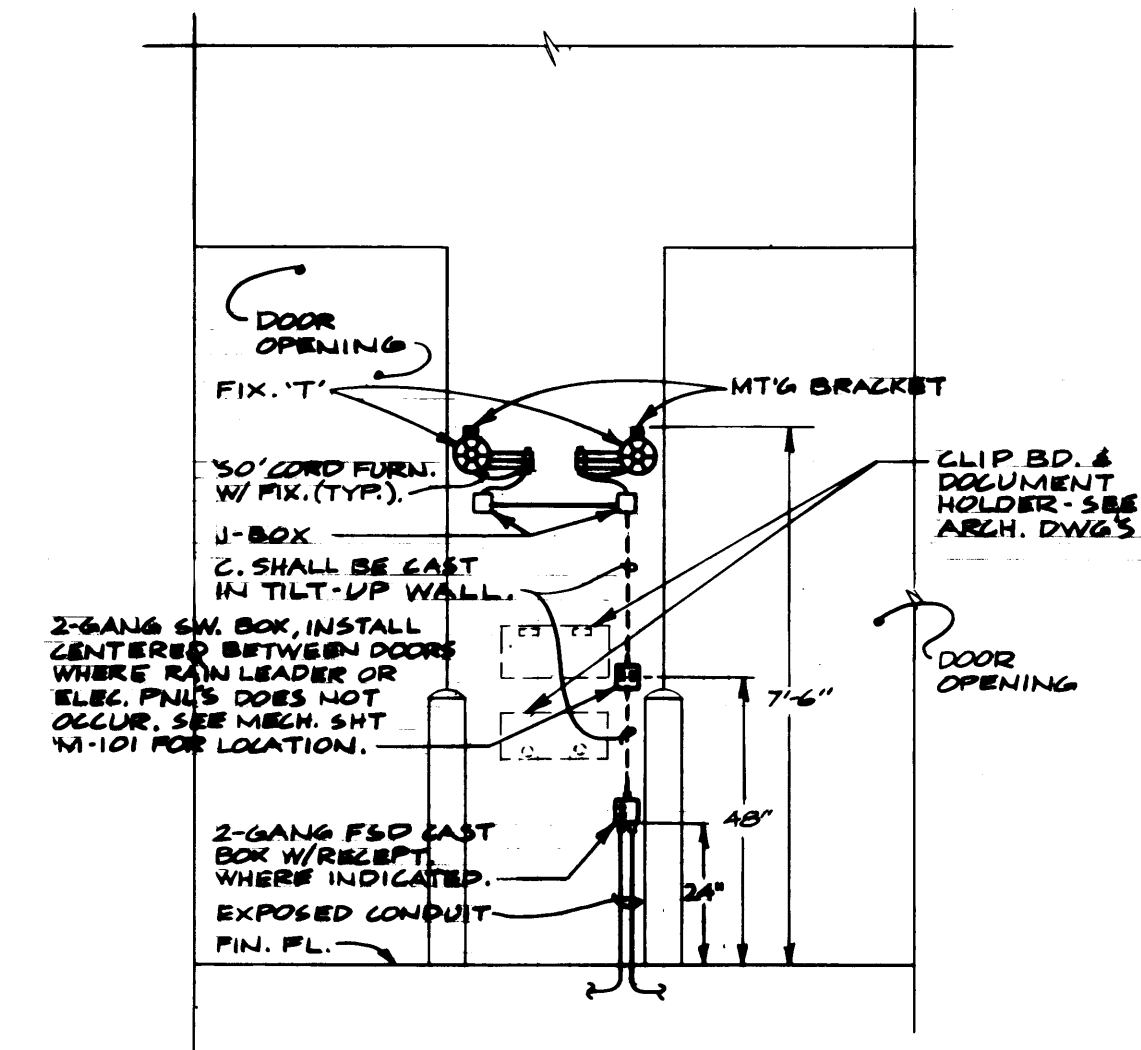


TYP. FIX. 'T' & RECEPT. INSTALLATION DET.

NOT TO SCALE

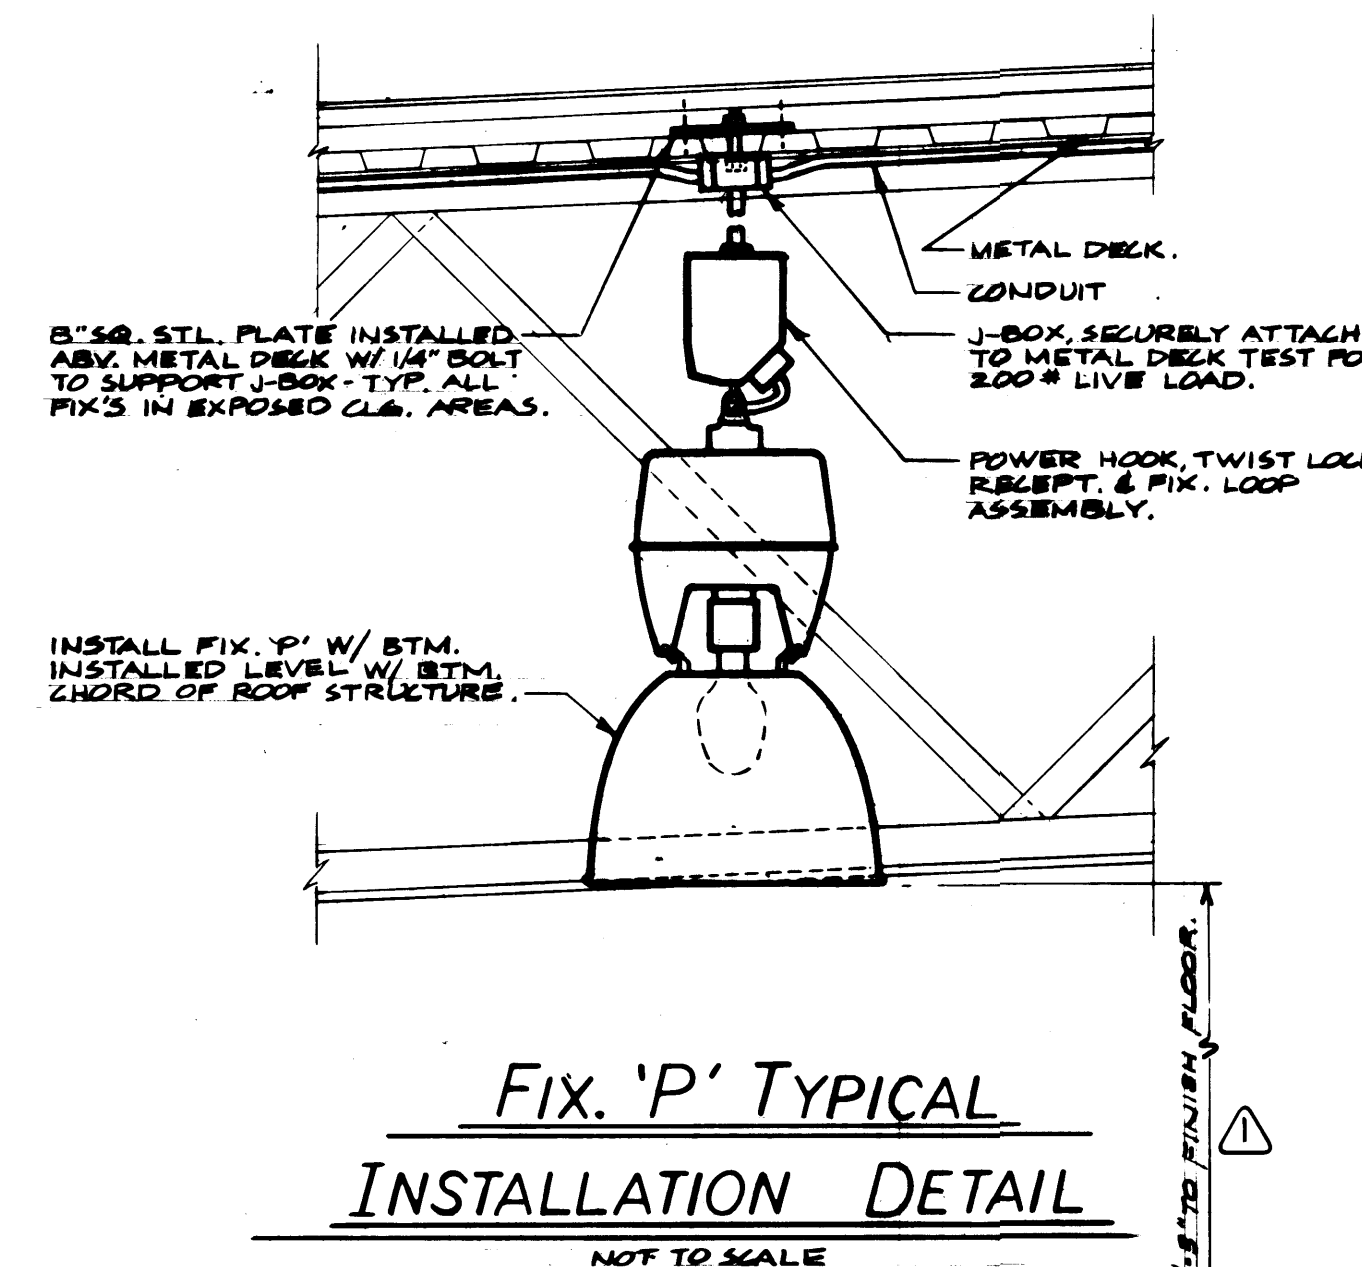


FIX. 'P' TYPICAL INSTALLATION DET.

NOT TO SCALE

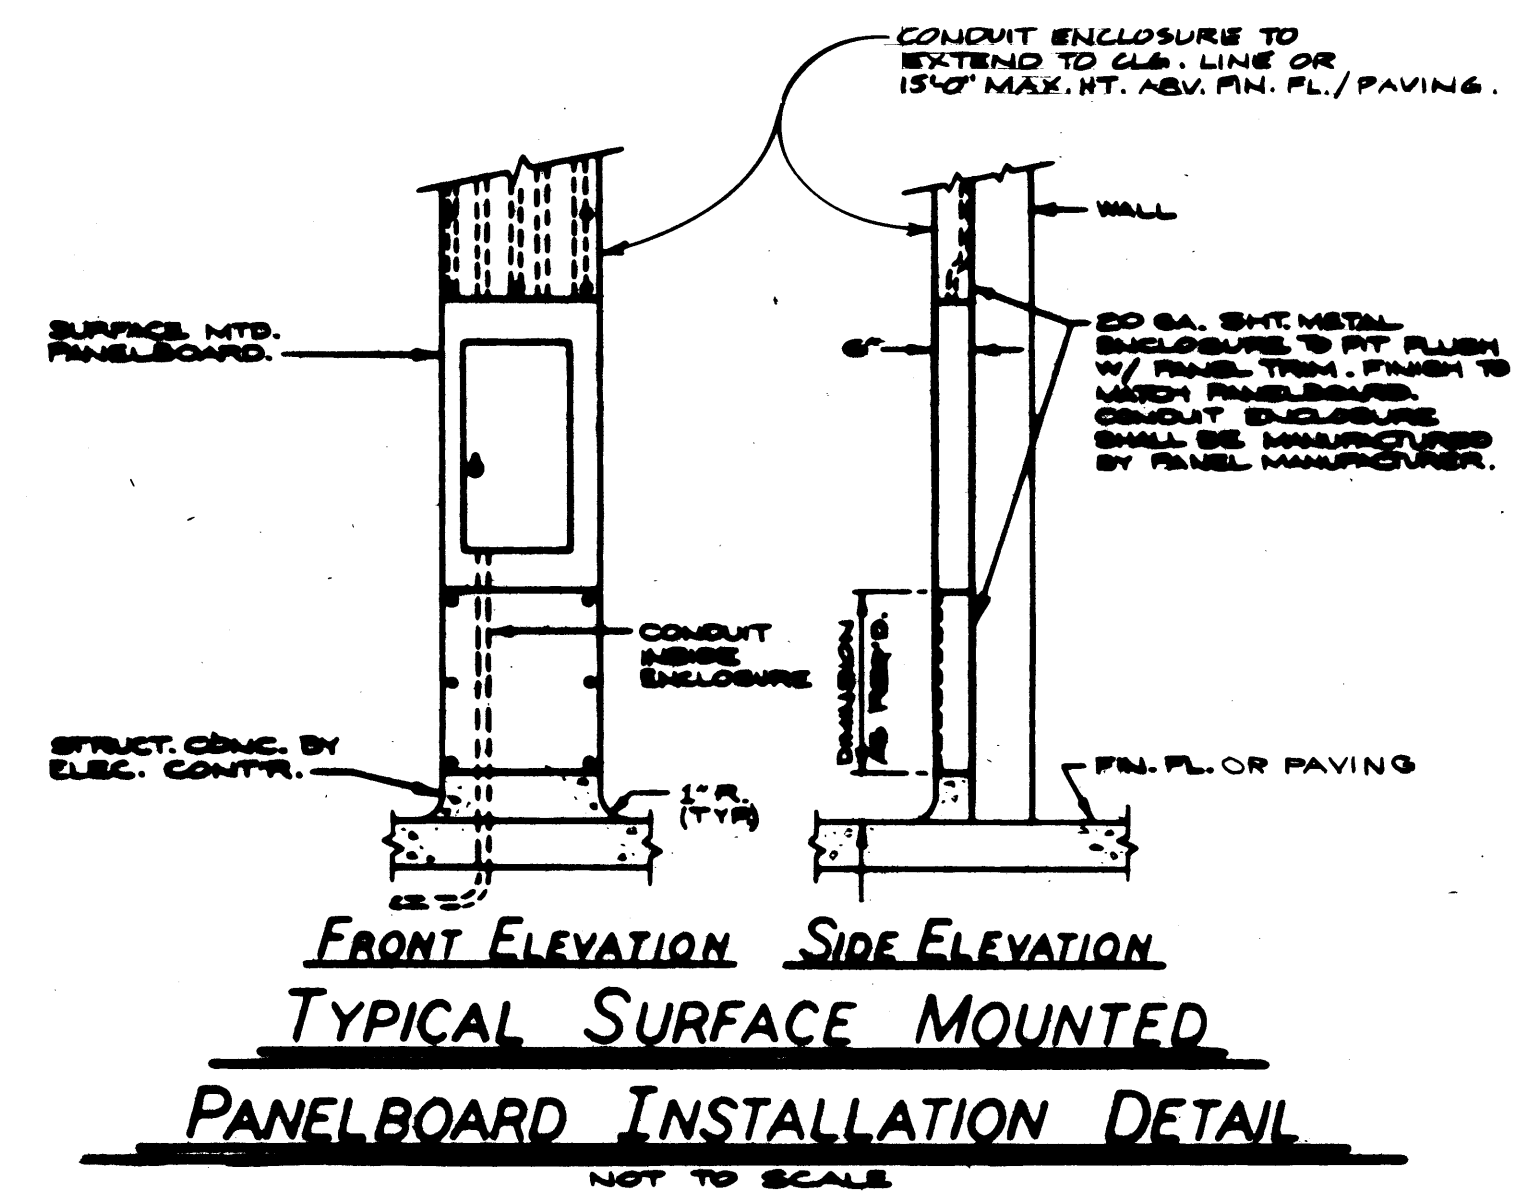


FRONT ELEVATION SIDE ELEVATION TYPICAL SURFACE MOUNTED PANELBOARD INSTALLATION DET.

NOT TO SCALE

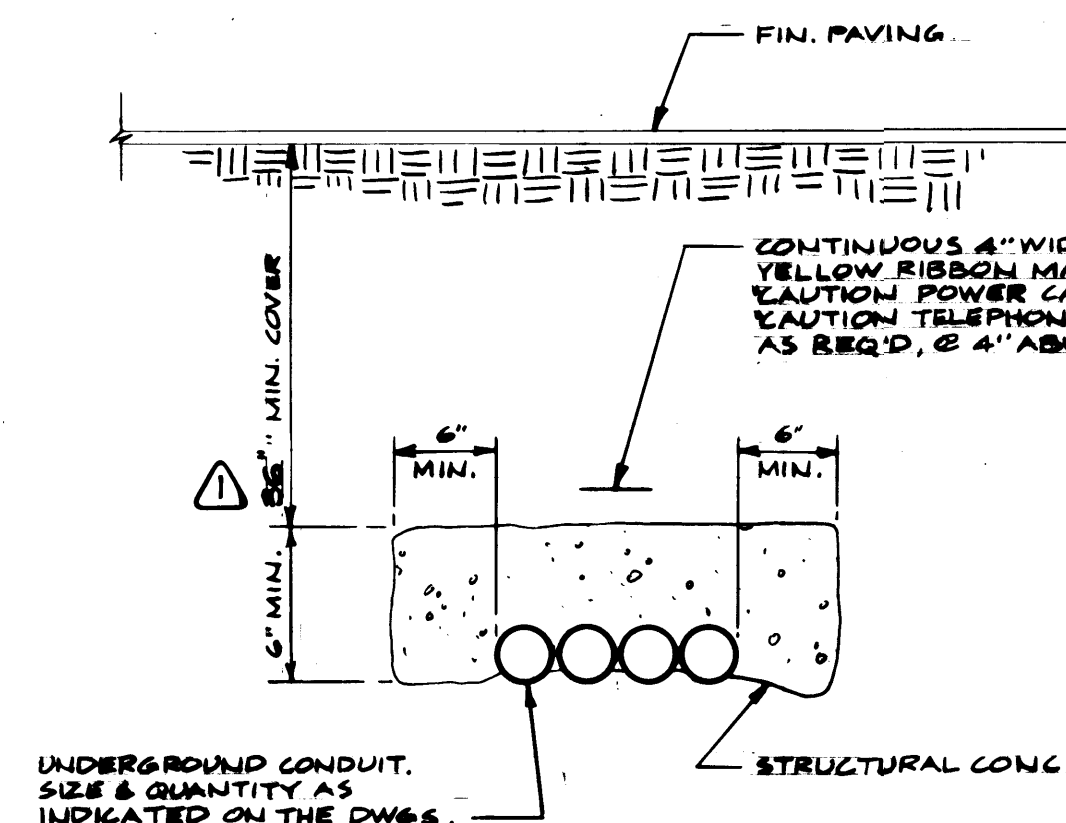

TYPICAL UNDERGROUND CONDUIT INSTALLATION DET.

NOT TO SCALE

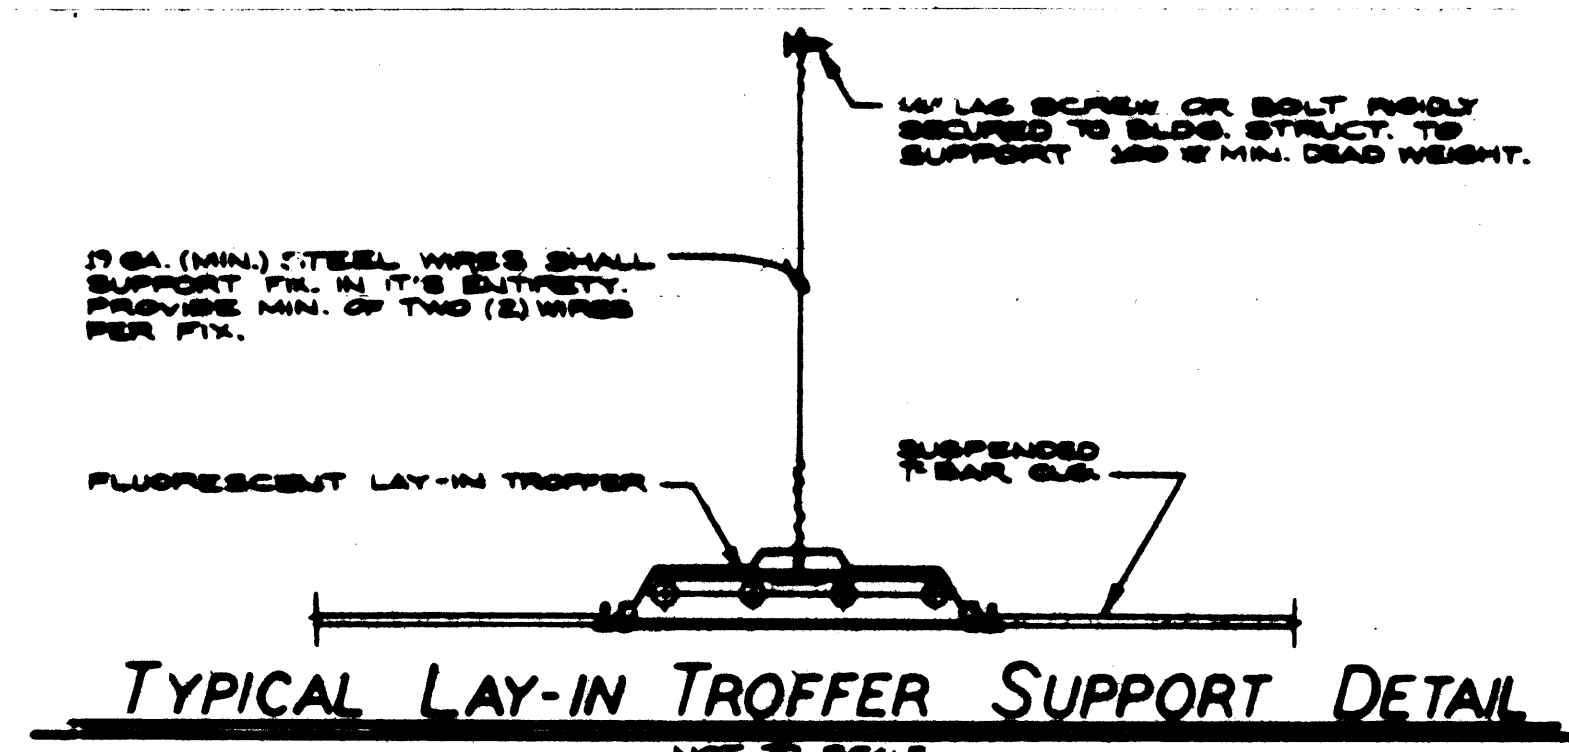

TYPICAL LAY-IN TROFFER SUPPORT DET.


NOT TO SCALE



Alan V. Contino, Inc.
Consulting Engineers
51 University, Suite 301
Tacoma, WA 98401
(206) 885-4116
500 So. Front, Suite 304
Tacoma, WA 98402
(206) 252-4757

MARK	REVISION	BY	APP.	DATE
	REVISED TO AS-BUILT	RJS		8-6-88

DRAWN _____		DATE _____		PORT OF TACOMA	
CHECKED _____		DATE _____		TACOMA TERMINALS, INC.	
CHECKED _____		DATE _____		ELEC. SYMBOLS & DETAILS	
CHECKED _____		DATE _____			
CONT. NO. 557		FIELD BOOK (S) _____		SCALE _____	
APPROVED _____		DATE 3/30/84		DRAWING NO. _____	
PROJECT MANAGER _____		DATE 3/30/84		EP 3079-23 E105	
CHIEF ENGINEER _____		DATE _____		SHEET 42 OF 71	

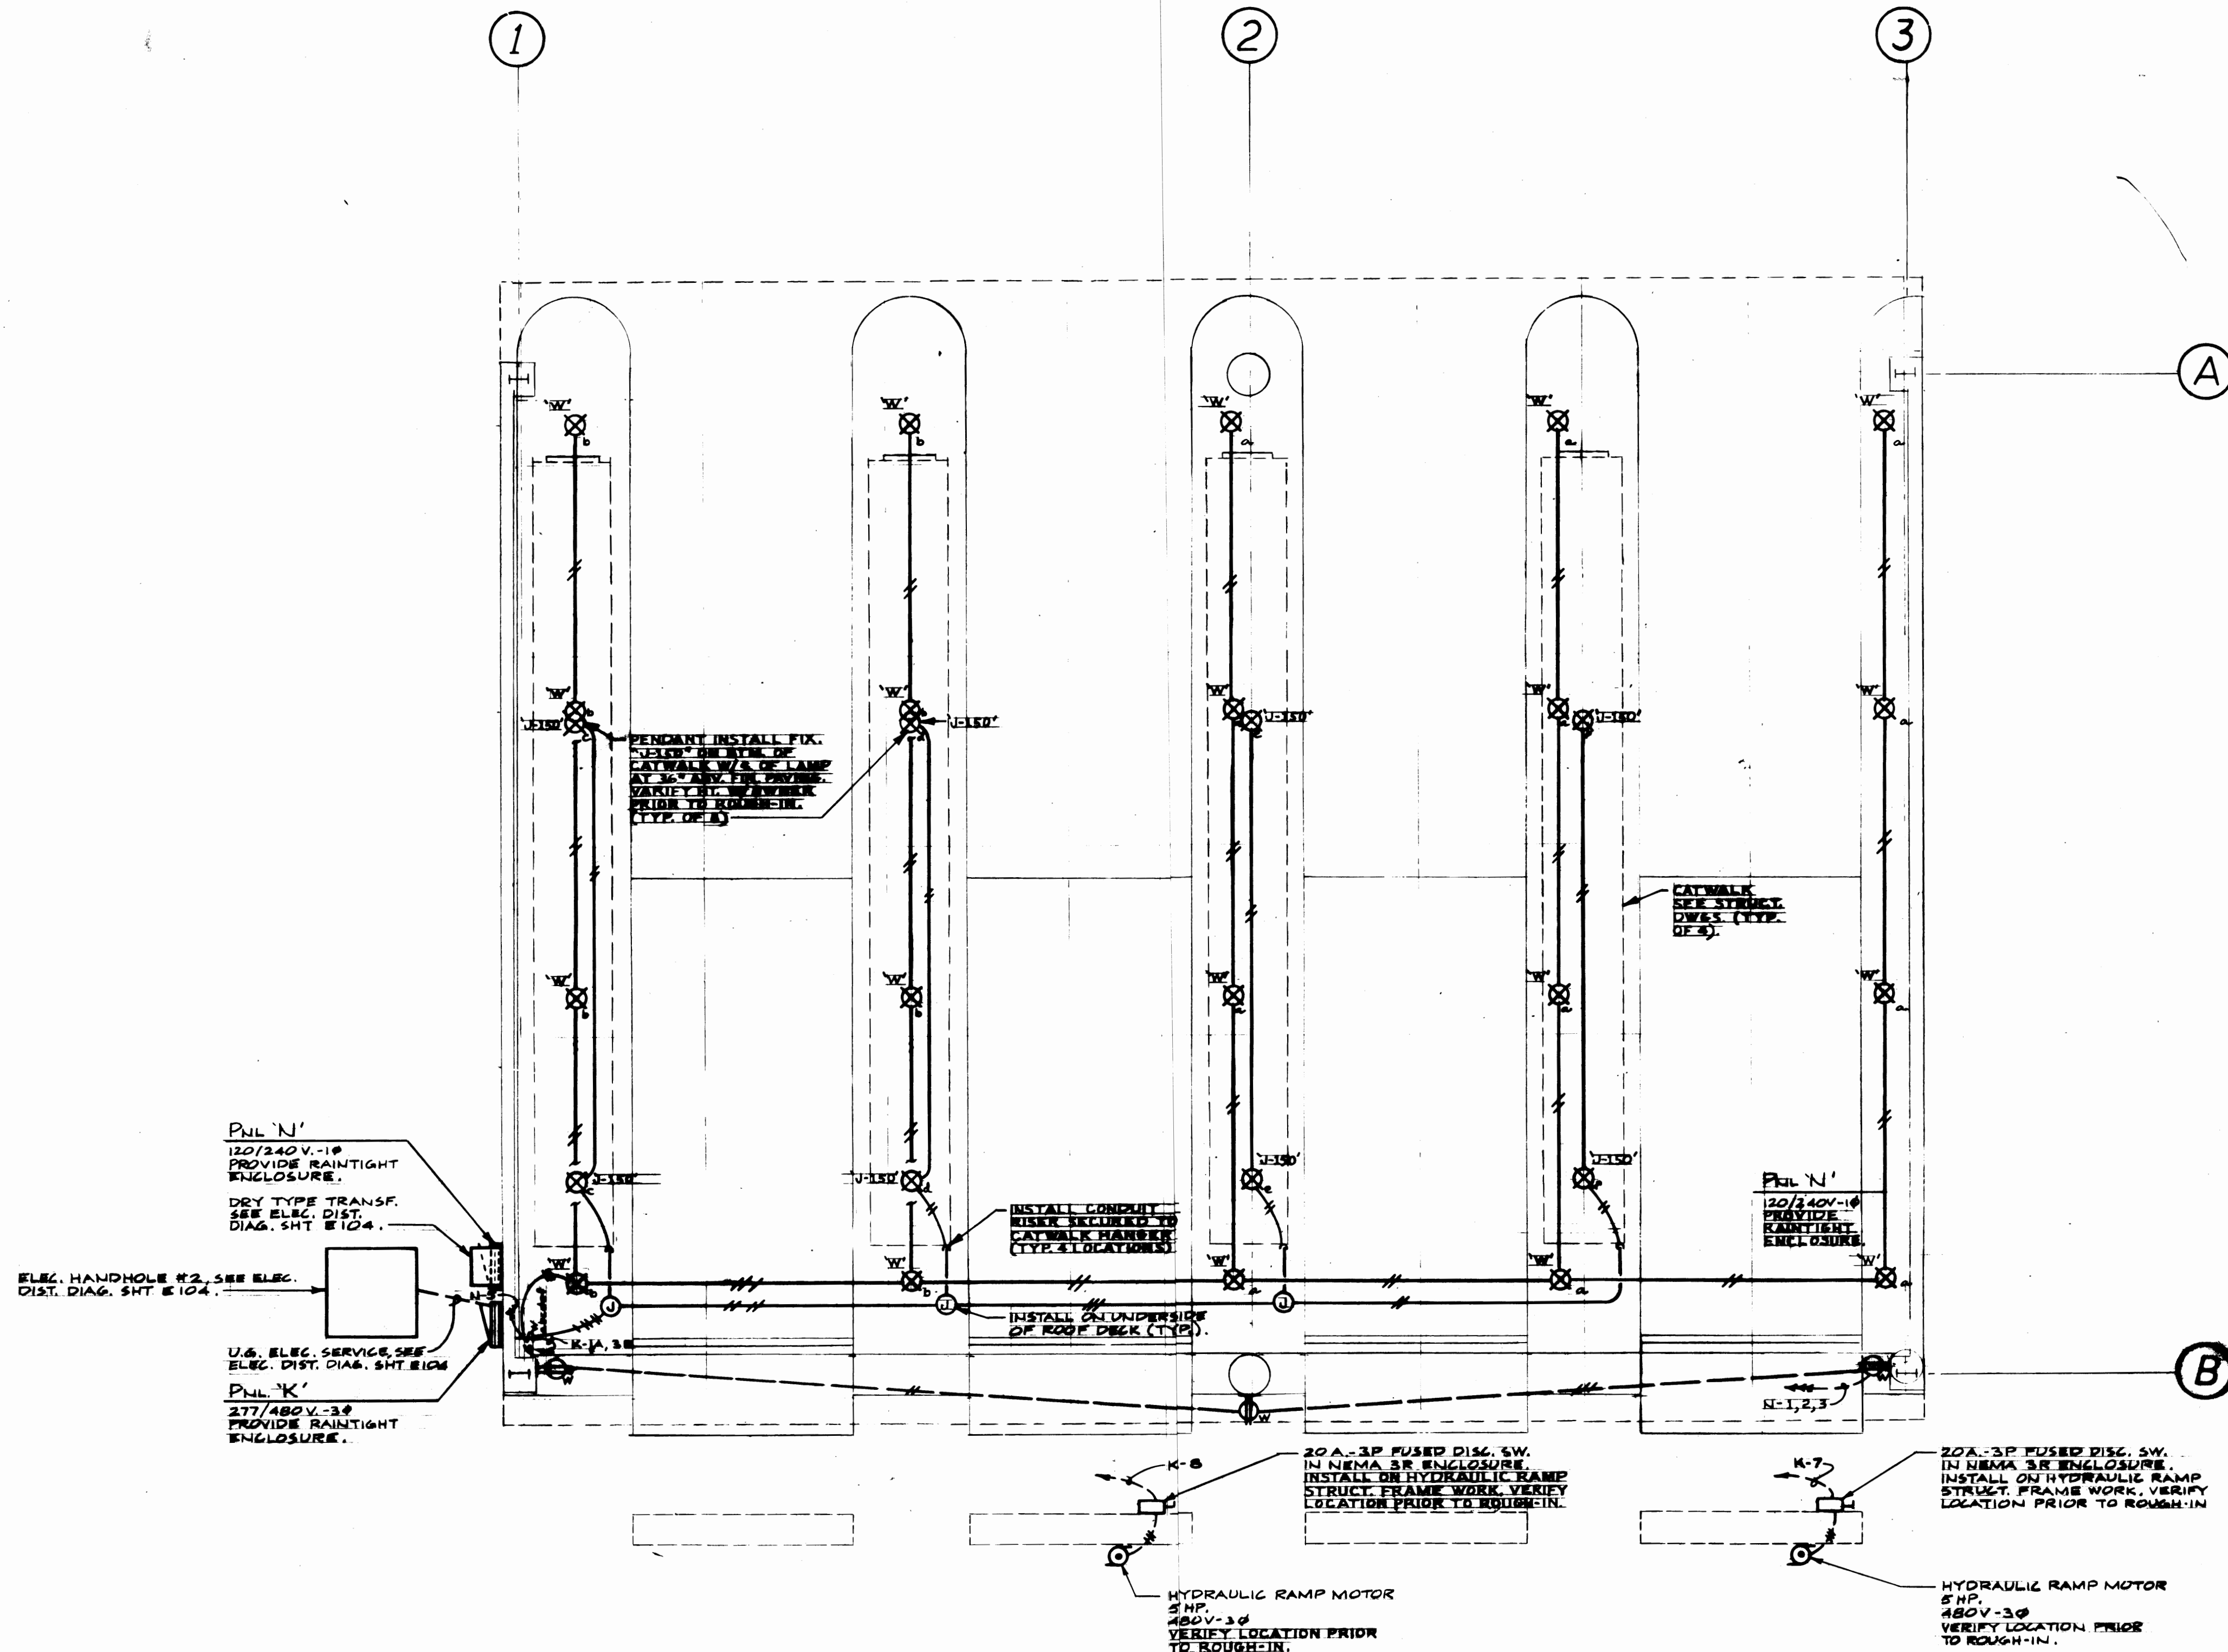

CAR CARRIER SHELTER~FLOOR PLAN~ELEC.


SCALE 1/4" = 1'-0"




Station Engineer, Inc.
Consulting Engineers
21 University, Suite 201
Seattle, WA 98101
206 465-4710
206 465-4711
206 465-4712

MARK	REVISION	BY	APP.	DATE
	NO AS-BUILT CHANGES			3/20/84

DRAWN _____		PORT OF TACOMA	
DATE _____		TACOMA TERMINALS, INC.	
CHECKED _____		CAR CARRIER SHELTER - FL. PLAN -	
DATE _____		ELEC.	
CHECKED _____		CONT. NO. 557	
DATE _____		FIELD BOOK (S) _____	
APPROVED _____		SCALE _____	
DATE 3/30/84		DRAWING NO. EP 3079-23 E401	
DATE 3/20/84		SHEET 71 OF 71	

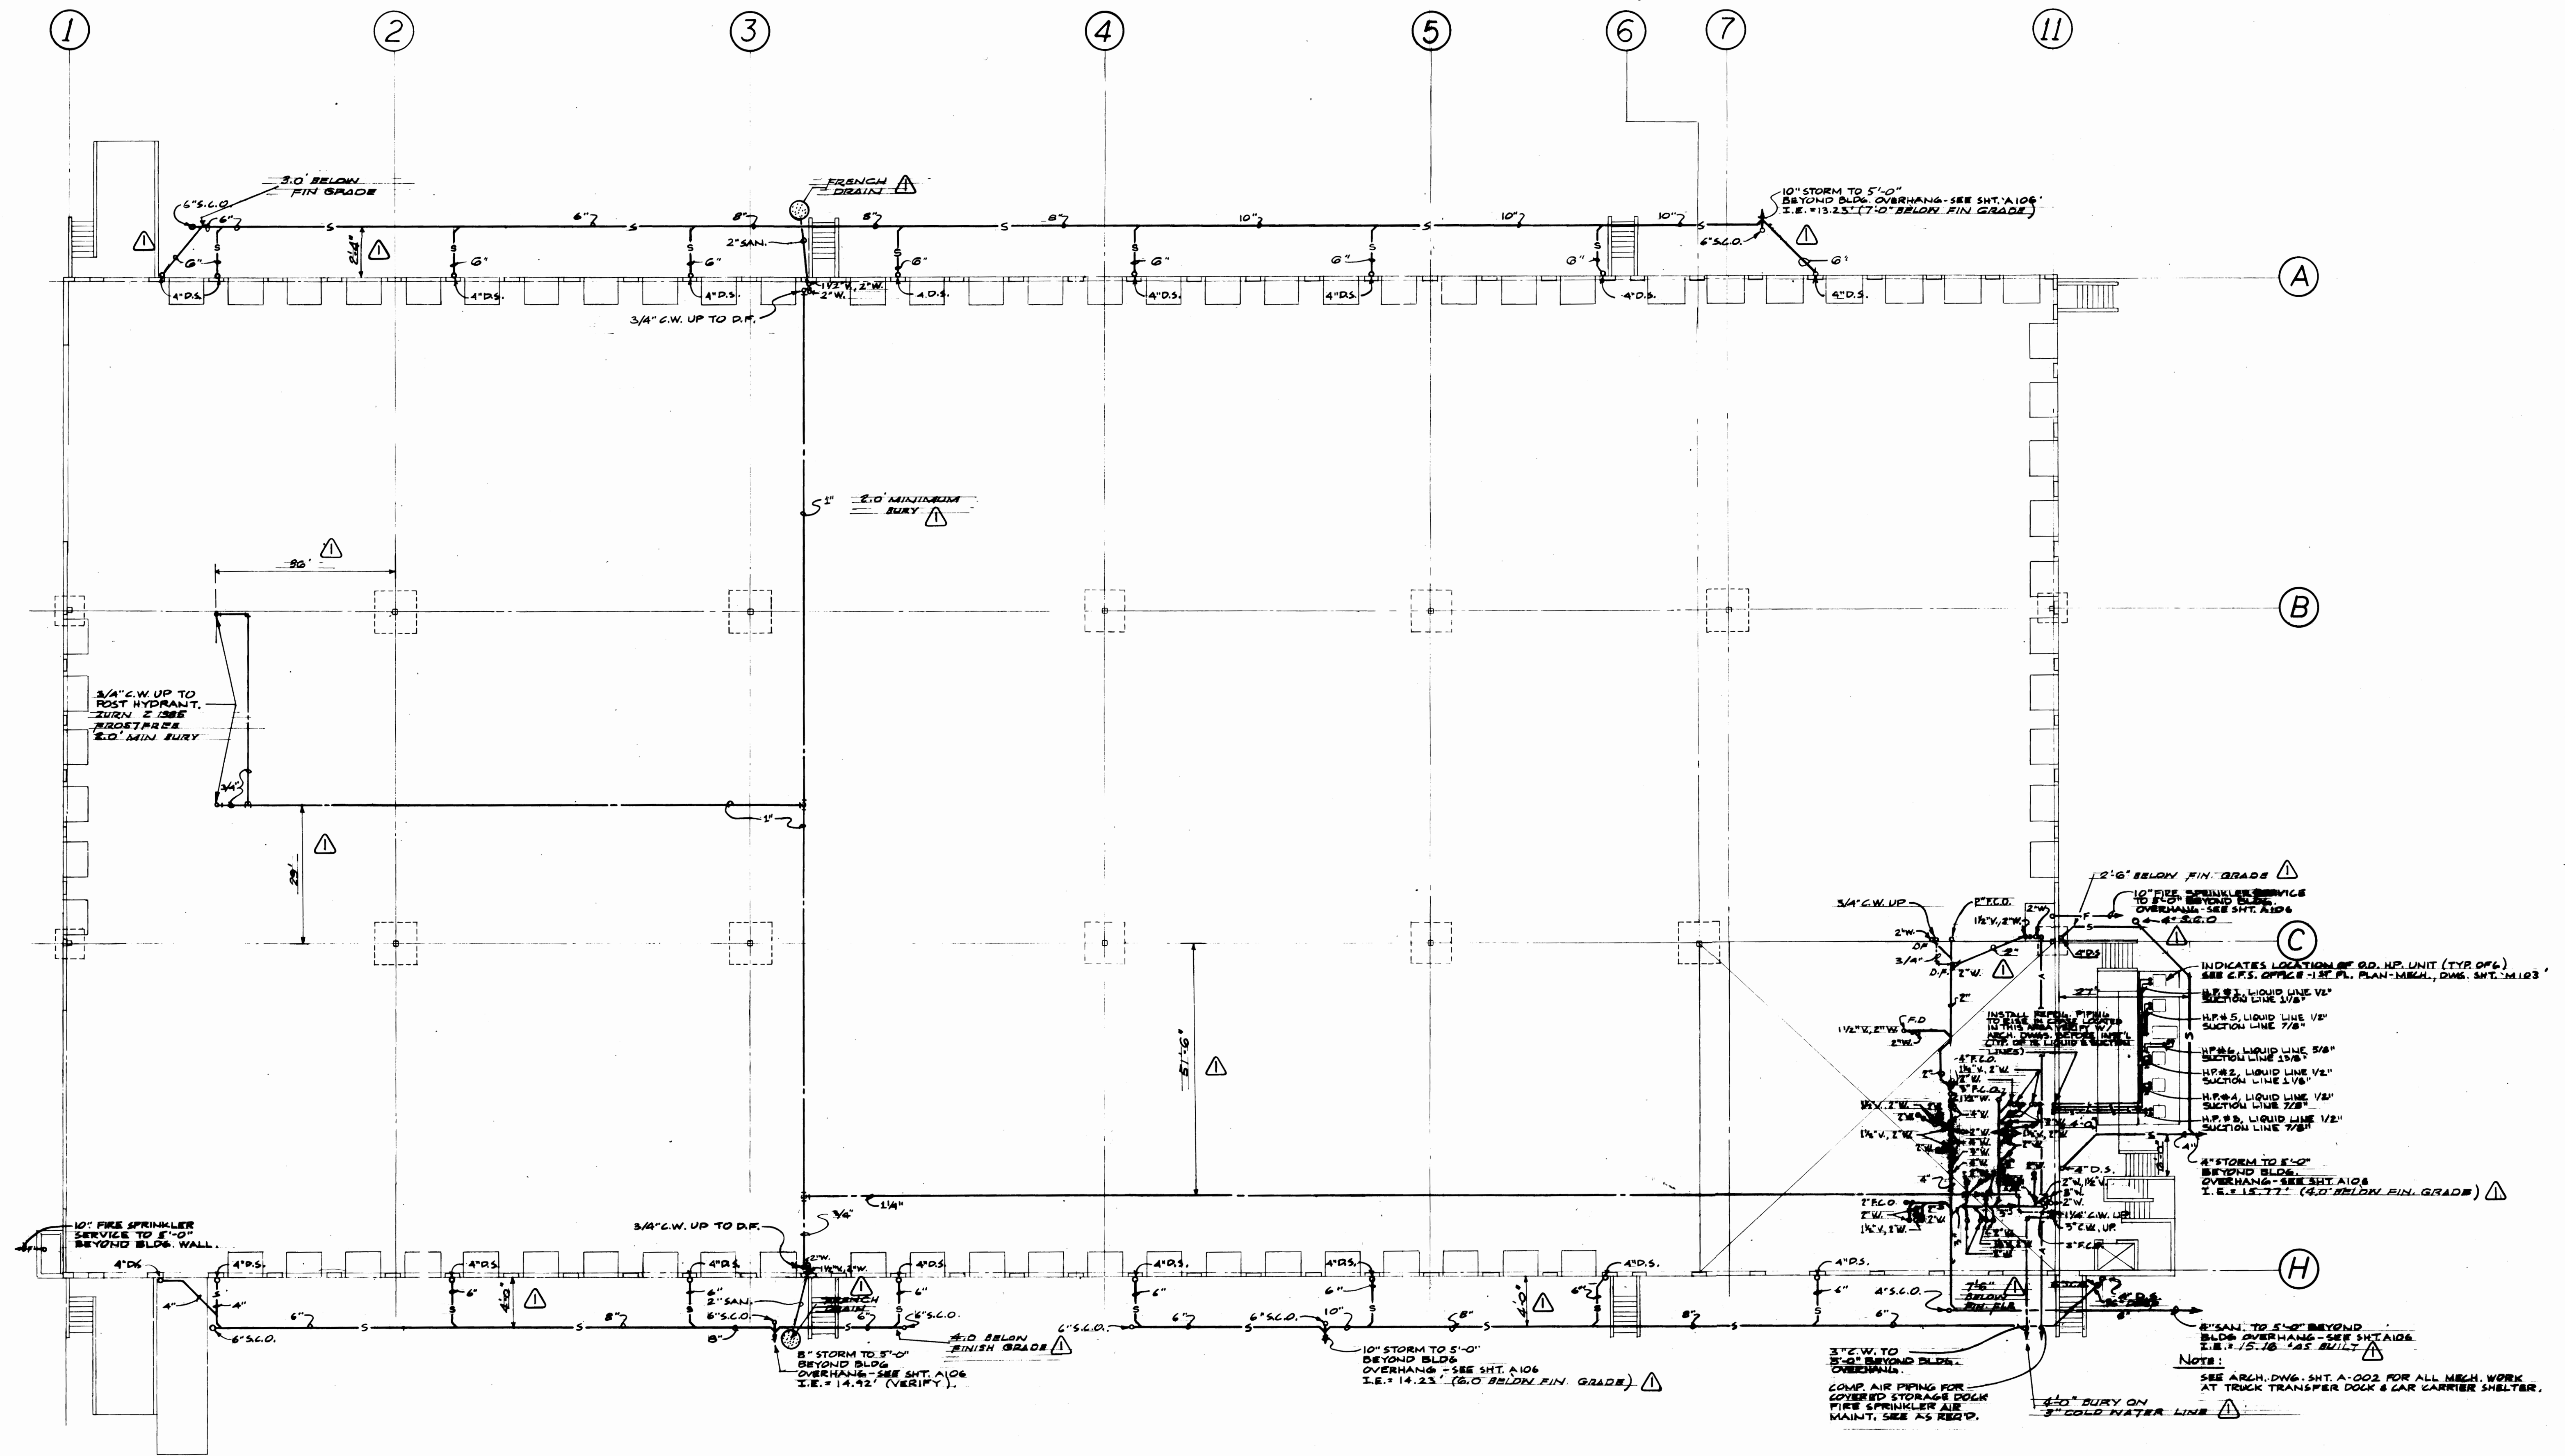




WAREHOUSE - FOUNDATION PLAN
SCALE: 1/16" = 1'-0"

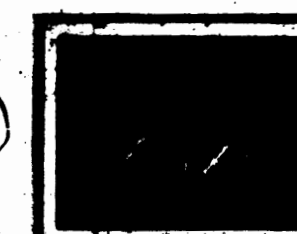

Shelley Engineering, Inc.
Consulting Engineers
51 University, Suite 301
Bristol, VA 22101
(803) 968-4118
800 6th, Forest, Suite 301
Tacoma, WA 98402
(206) 260-2787

REVISION	BY	APP.	DATE
REVISED TO AS-BUILT	R.J.S.	A.V.L.	3/30/84


DRAWN _____		PORT OF TACOMA	
DATE _____		TACOMA TERMINALS, INC.	
CHECKED _____		WAREHOUSE - FOUNDATION PLAN	
DATE _____			
CHECKED _____			
DATE _____			
CONT. NO. 587			
FIELD BOOK (S) _____		SCALE _____	
APPROVED _____		DRAWING NO. _____	
DATE 3/30/84		SHEET 22 OF 21	

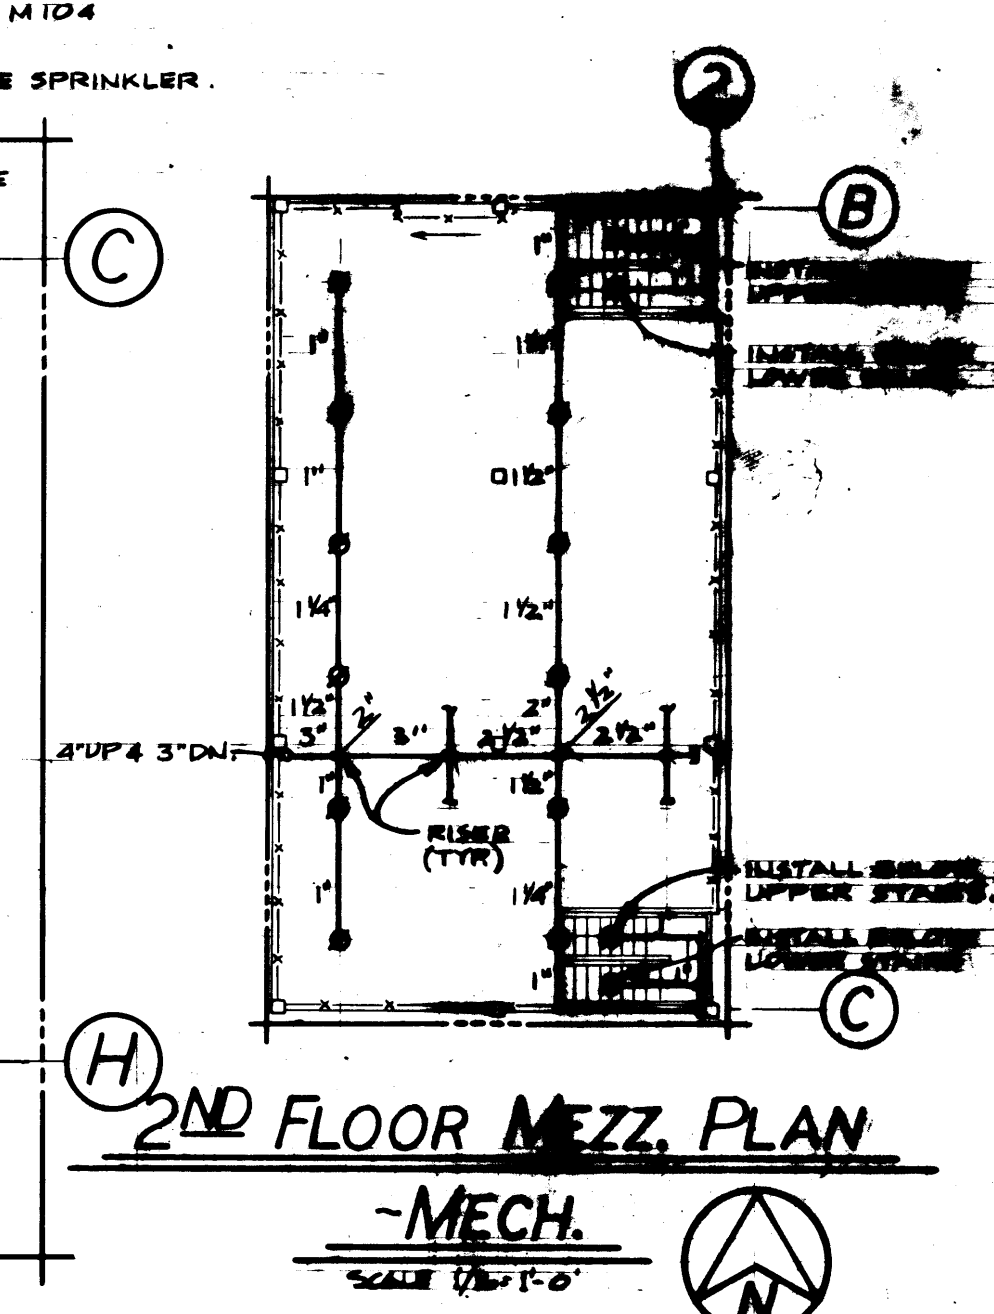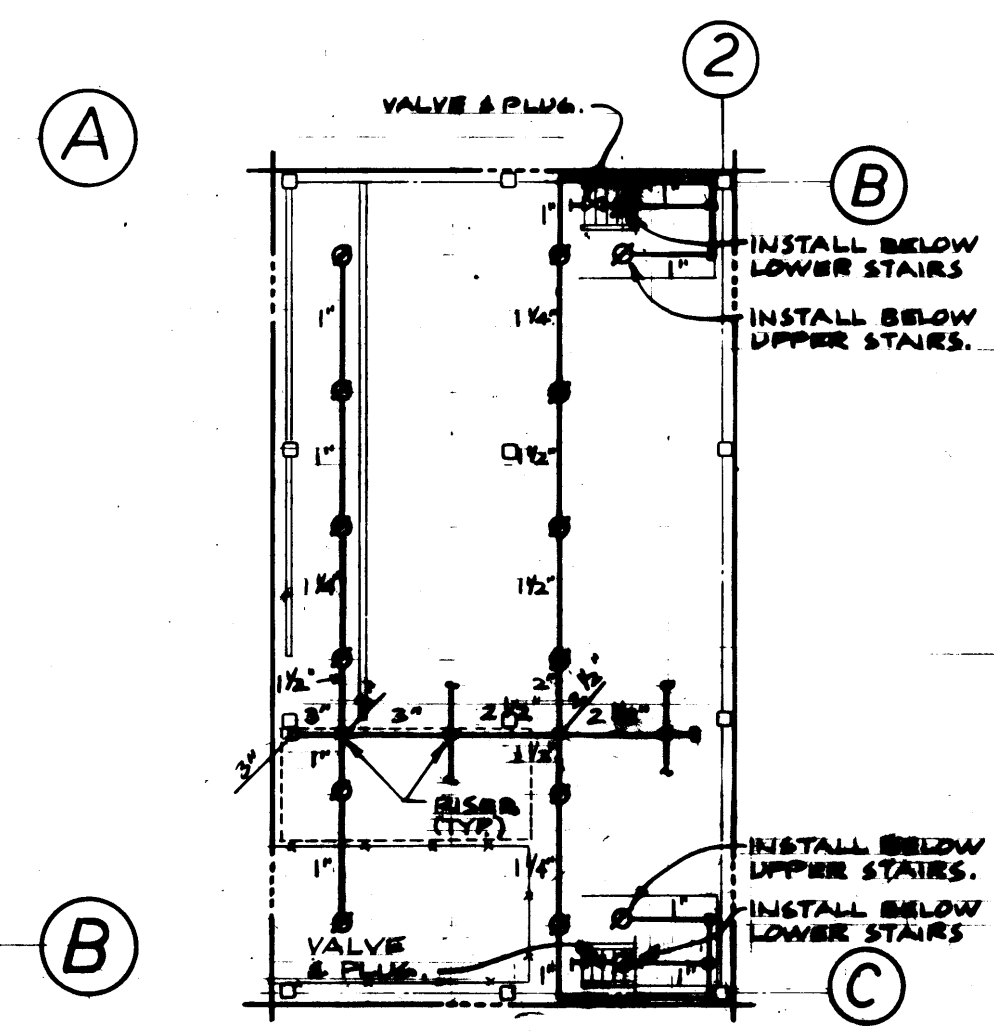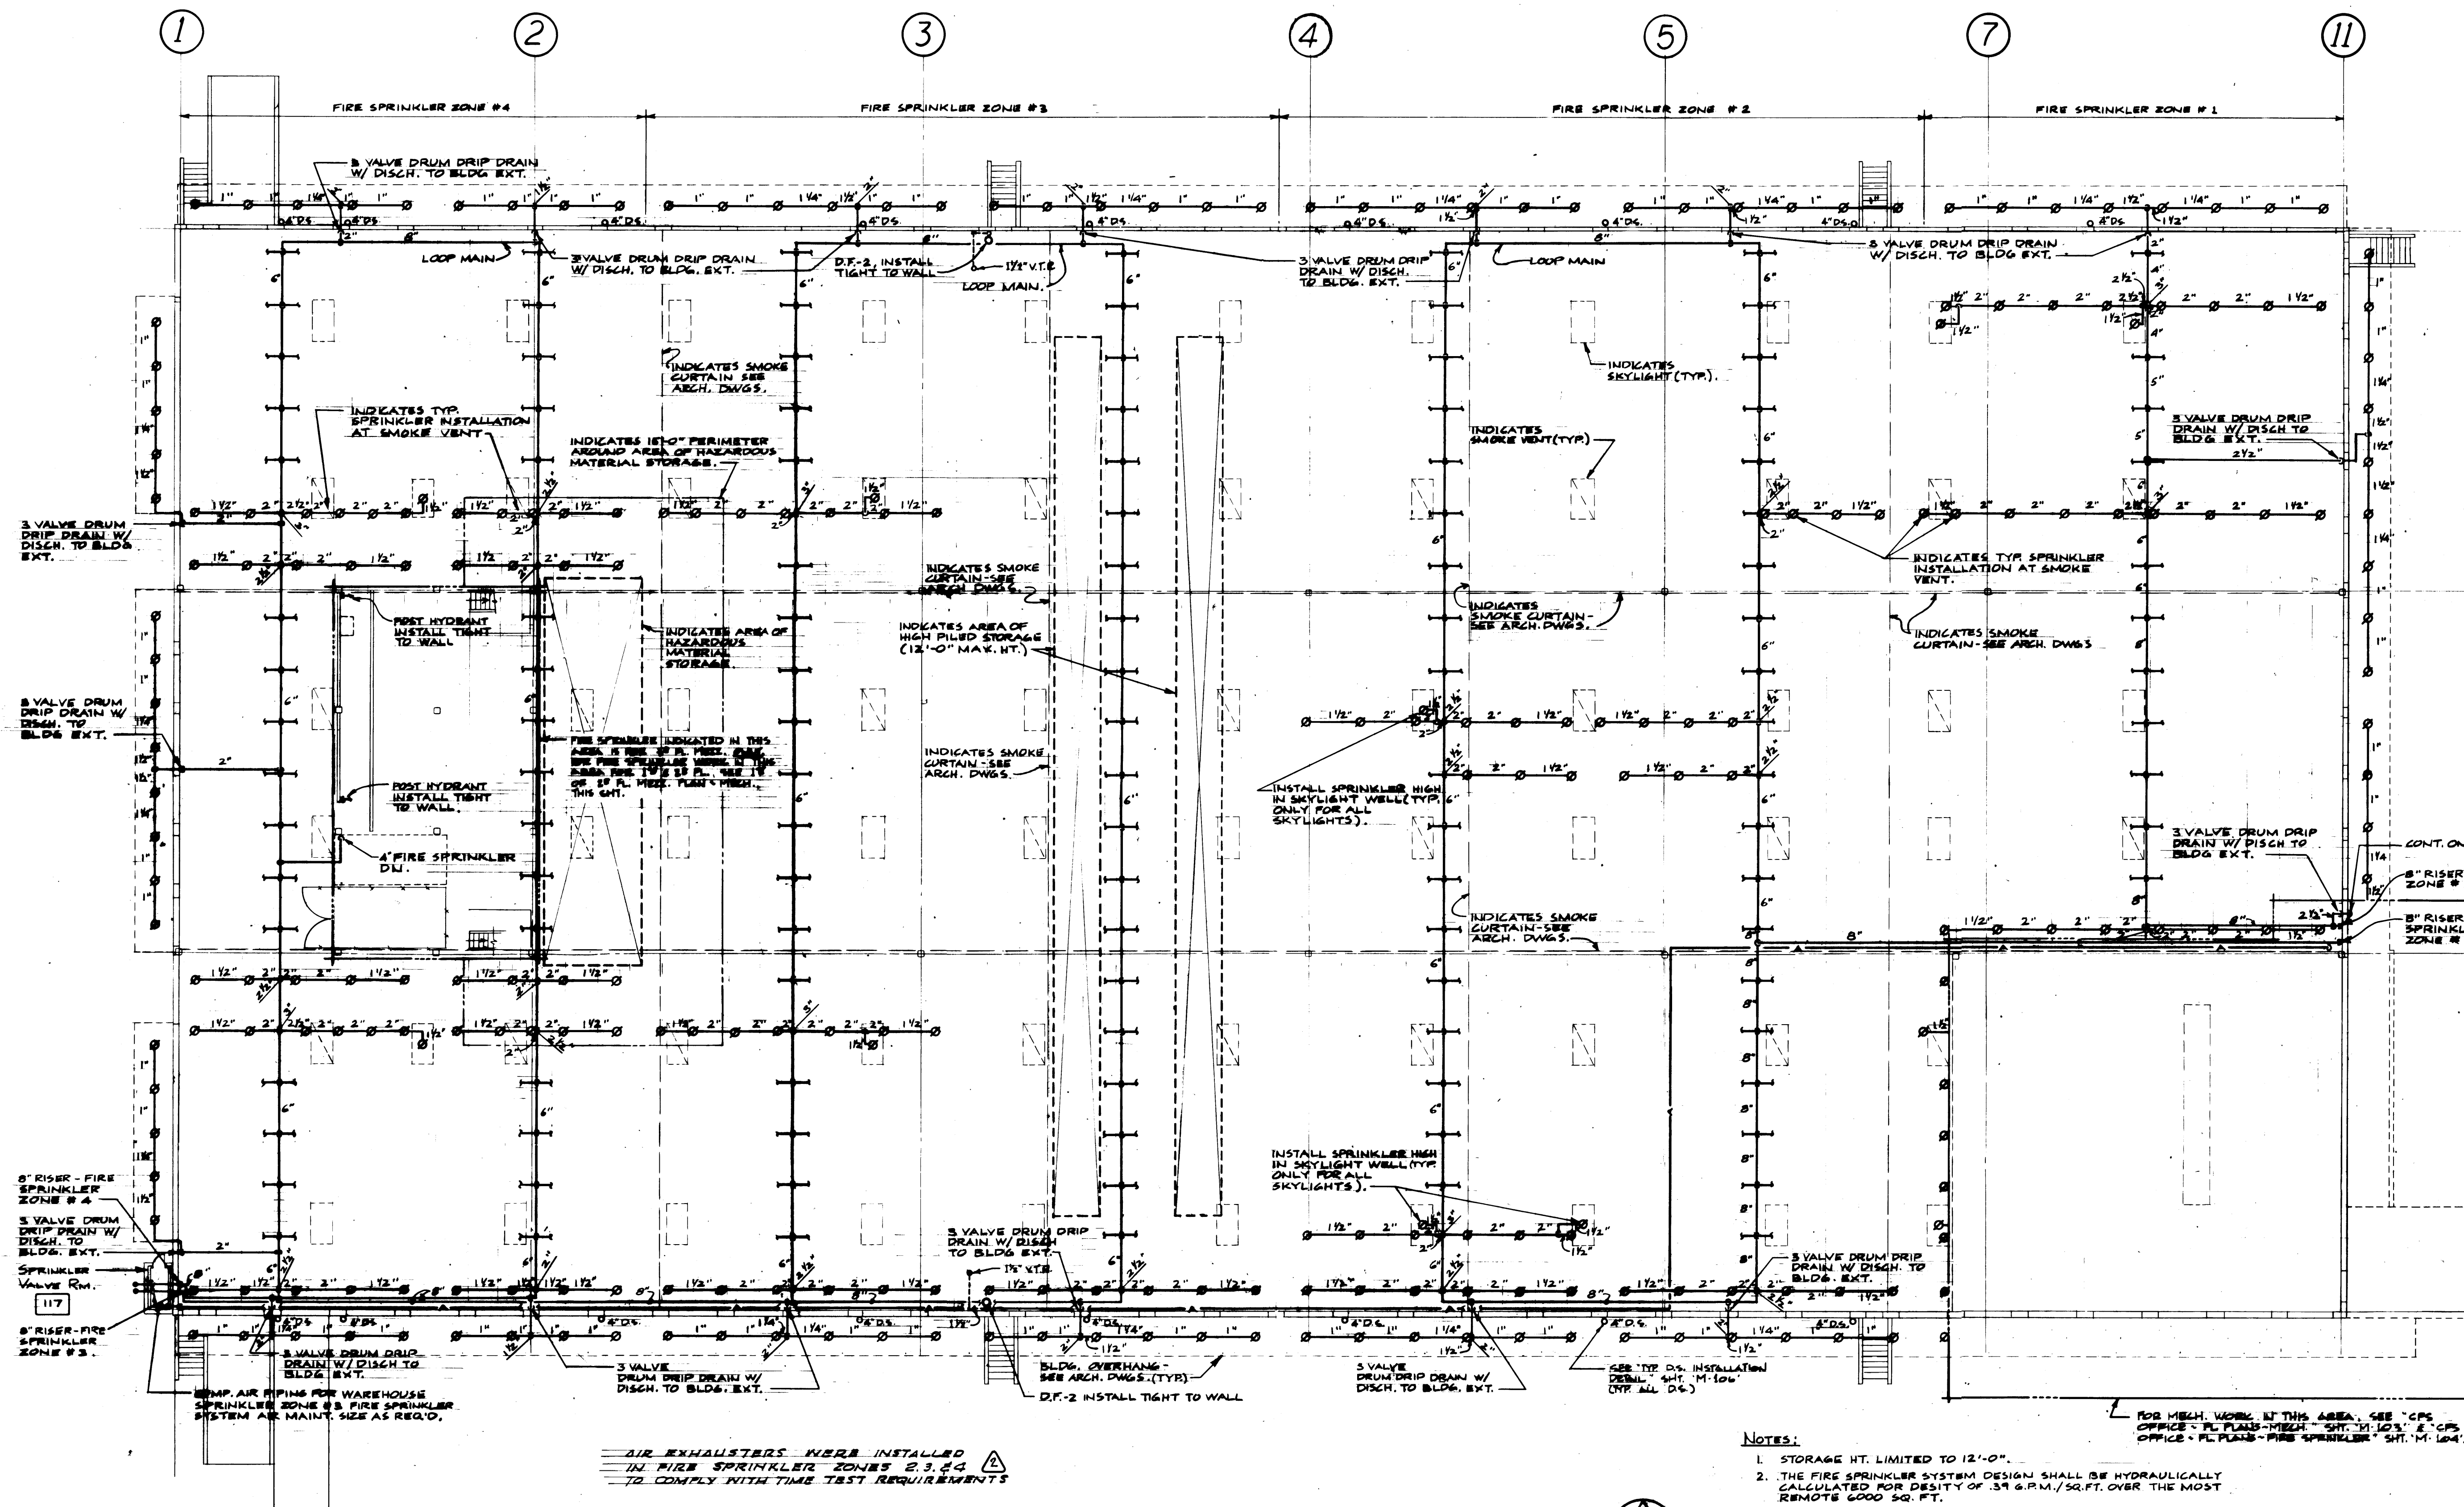

NO.	REVISION	DATE	BY	APP.
1.	MODIFY & ADD SIZES TO SPRINKLER SYSTEM	8/15		
2.	REVISED TO AS BUILT	8/15		


NO.	REVISION	DATE	BY	APP.
1.	MODIFY & ADD SIZES TO SPRINKLER SYSTEM	8/15		
2.	REVISED TO AS BUILT	8/15		

DRAWN: _____		DATE: _____	
CHECKED: _____		DATE: _____	
CHECKED: _____		DATE: _____	
CONT. NO. 557		FIELD BOOK (S) _____	
APPROVED: _____		DATE: 8/30/04	
TACOMA TERMINALS, INC.		DRAWING NO. EP 5877-23	
WAREHOUSE - FL. PLAN - MECH., 1st FL. MEZZ. PLAN - MECH., & 2nd FL. MEZZ. PLAN - MECH.		SHEET 54 OF 54	

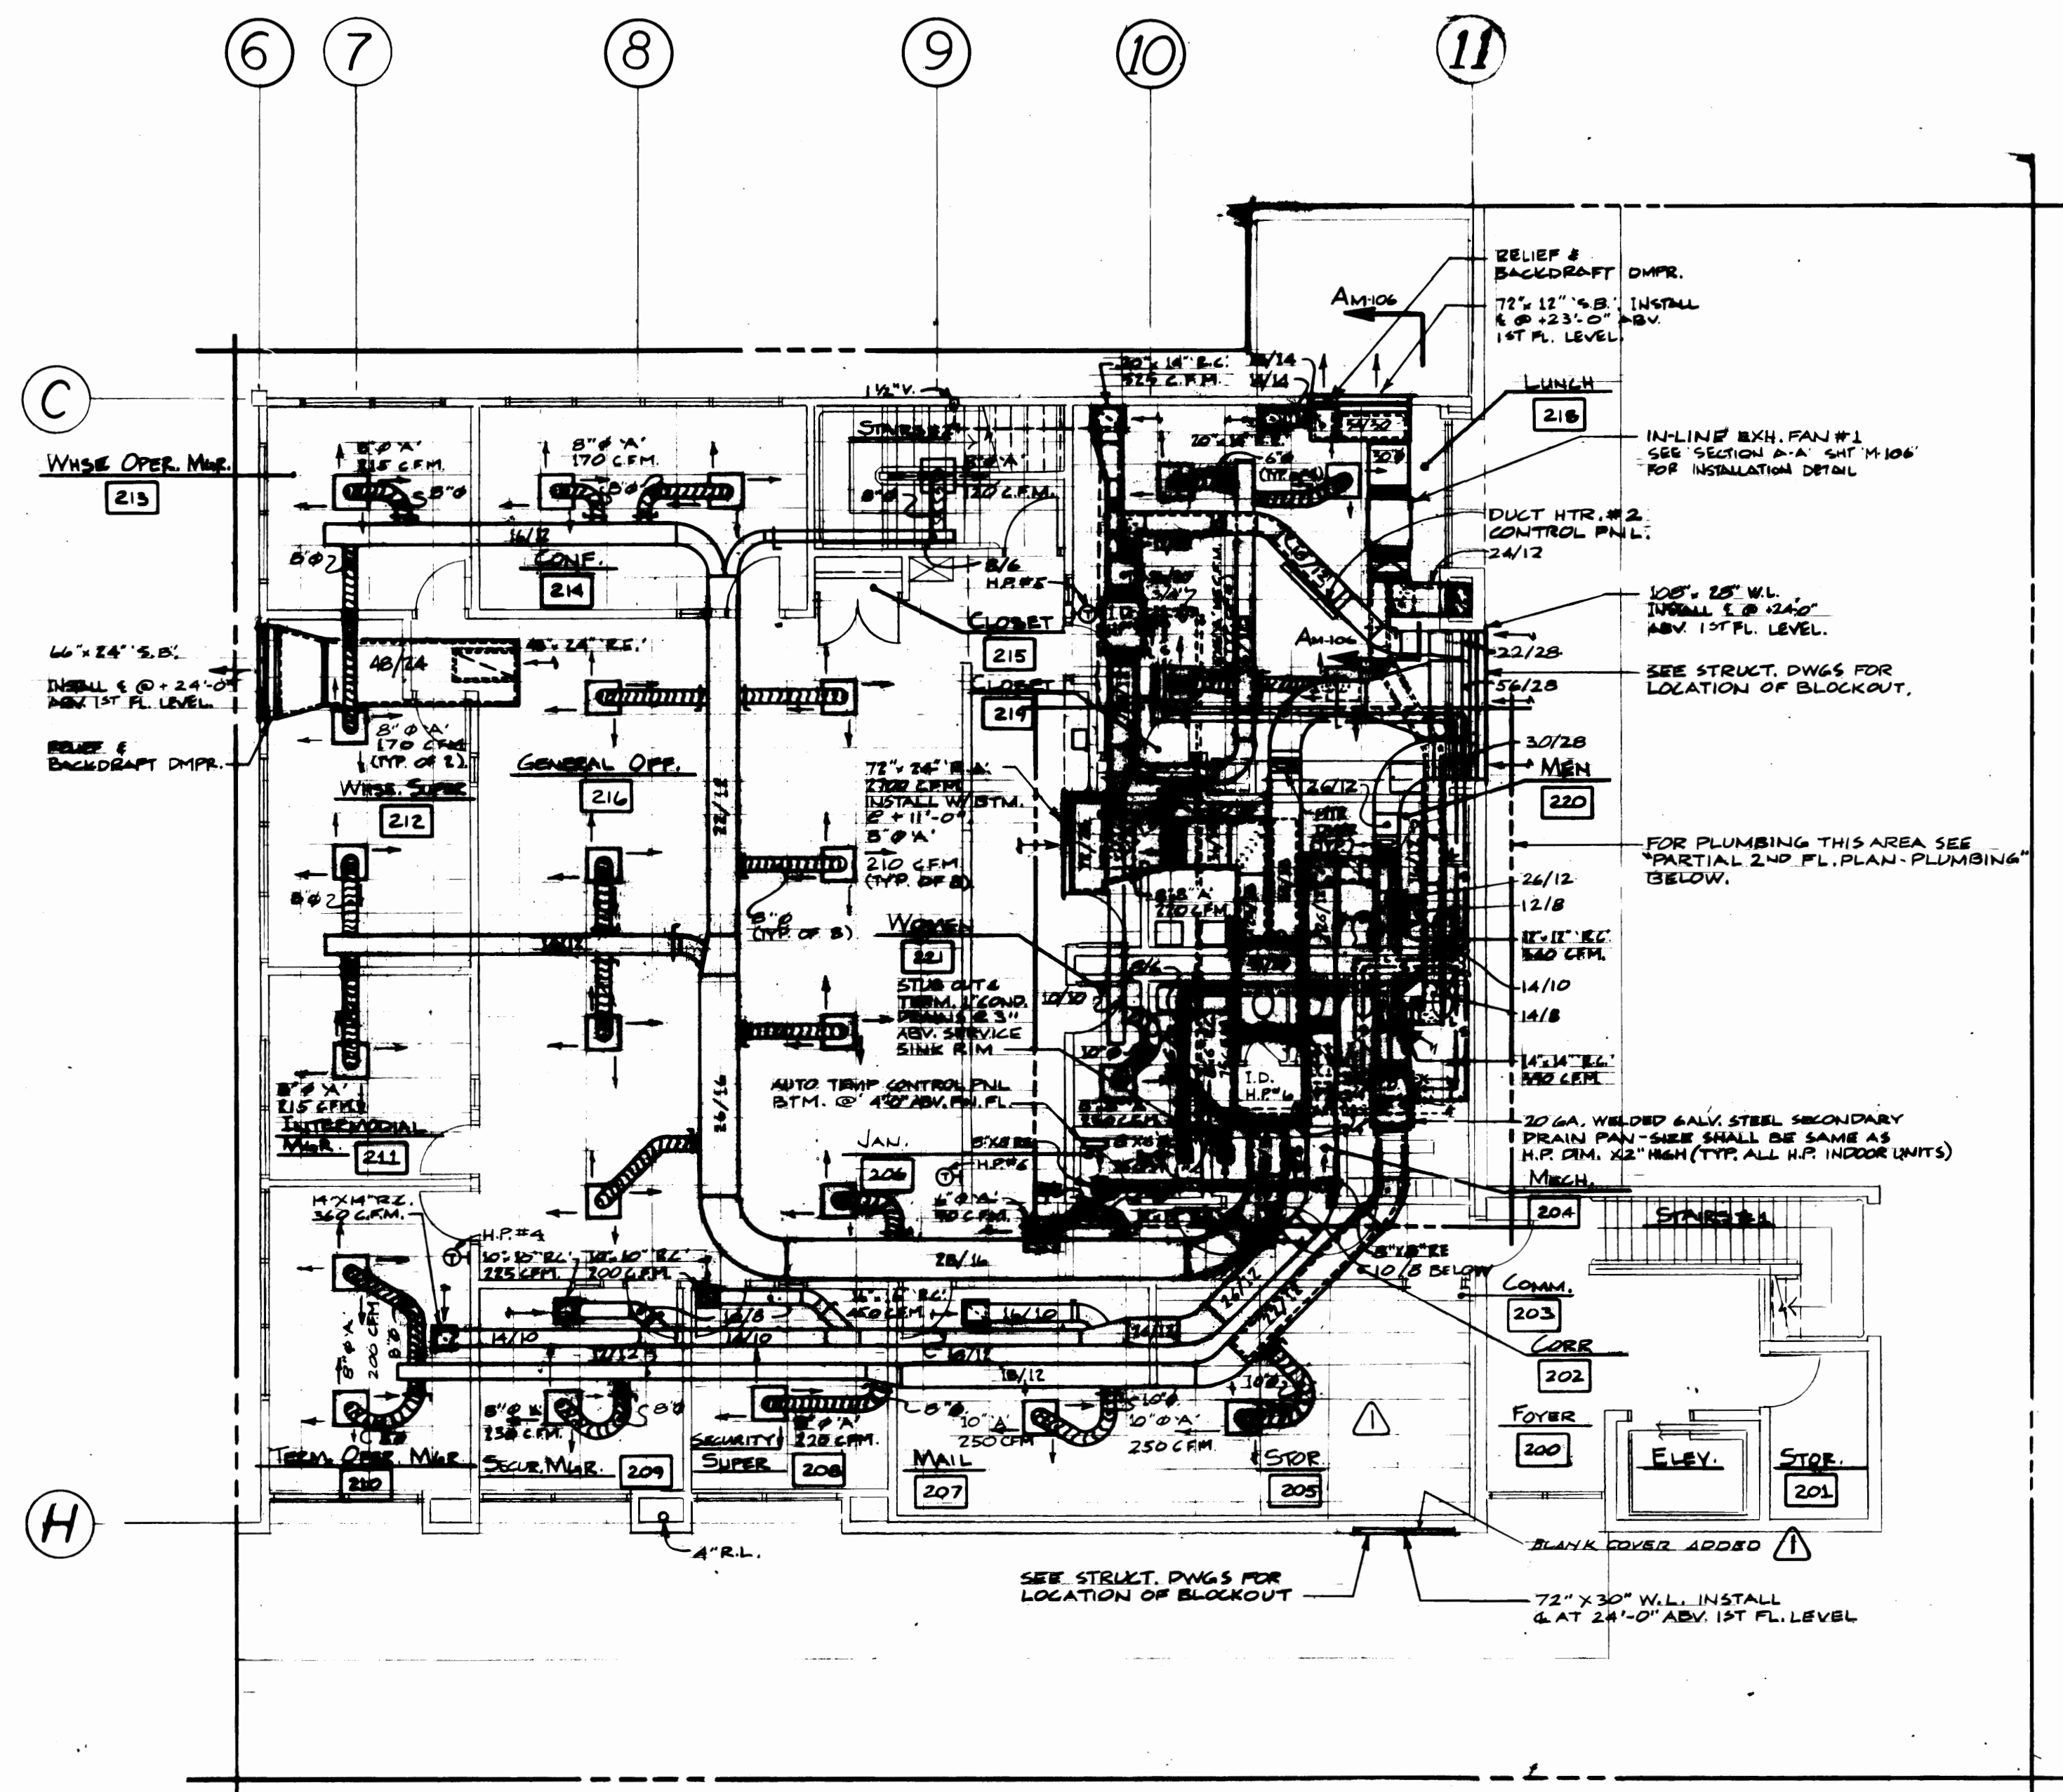


CFS OFFICE - 2ND FLOOR PLAN - MECH.

SCALE 1/8" = 1'-0"

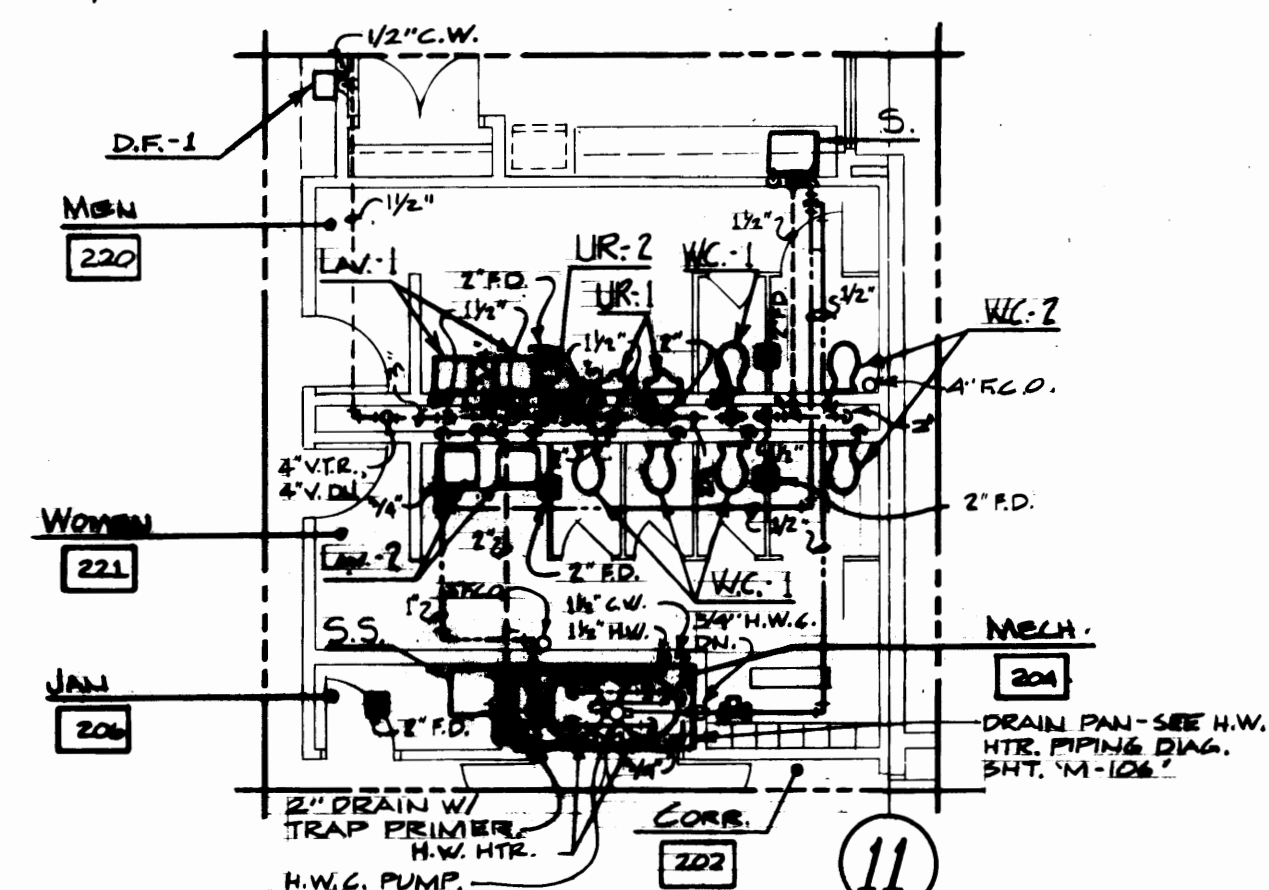


PARTIAL 2ND FLOOR PLAN - PLUMBING

SCALE 1/8" = 1'-0"

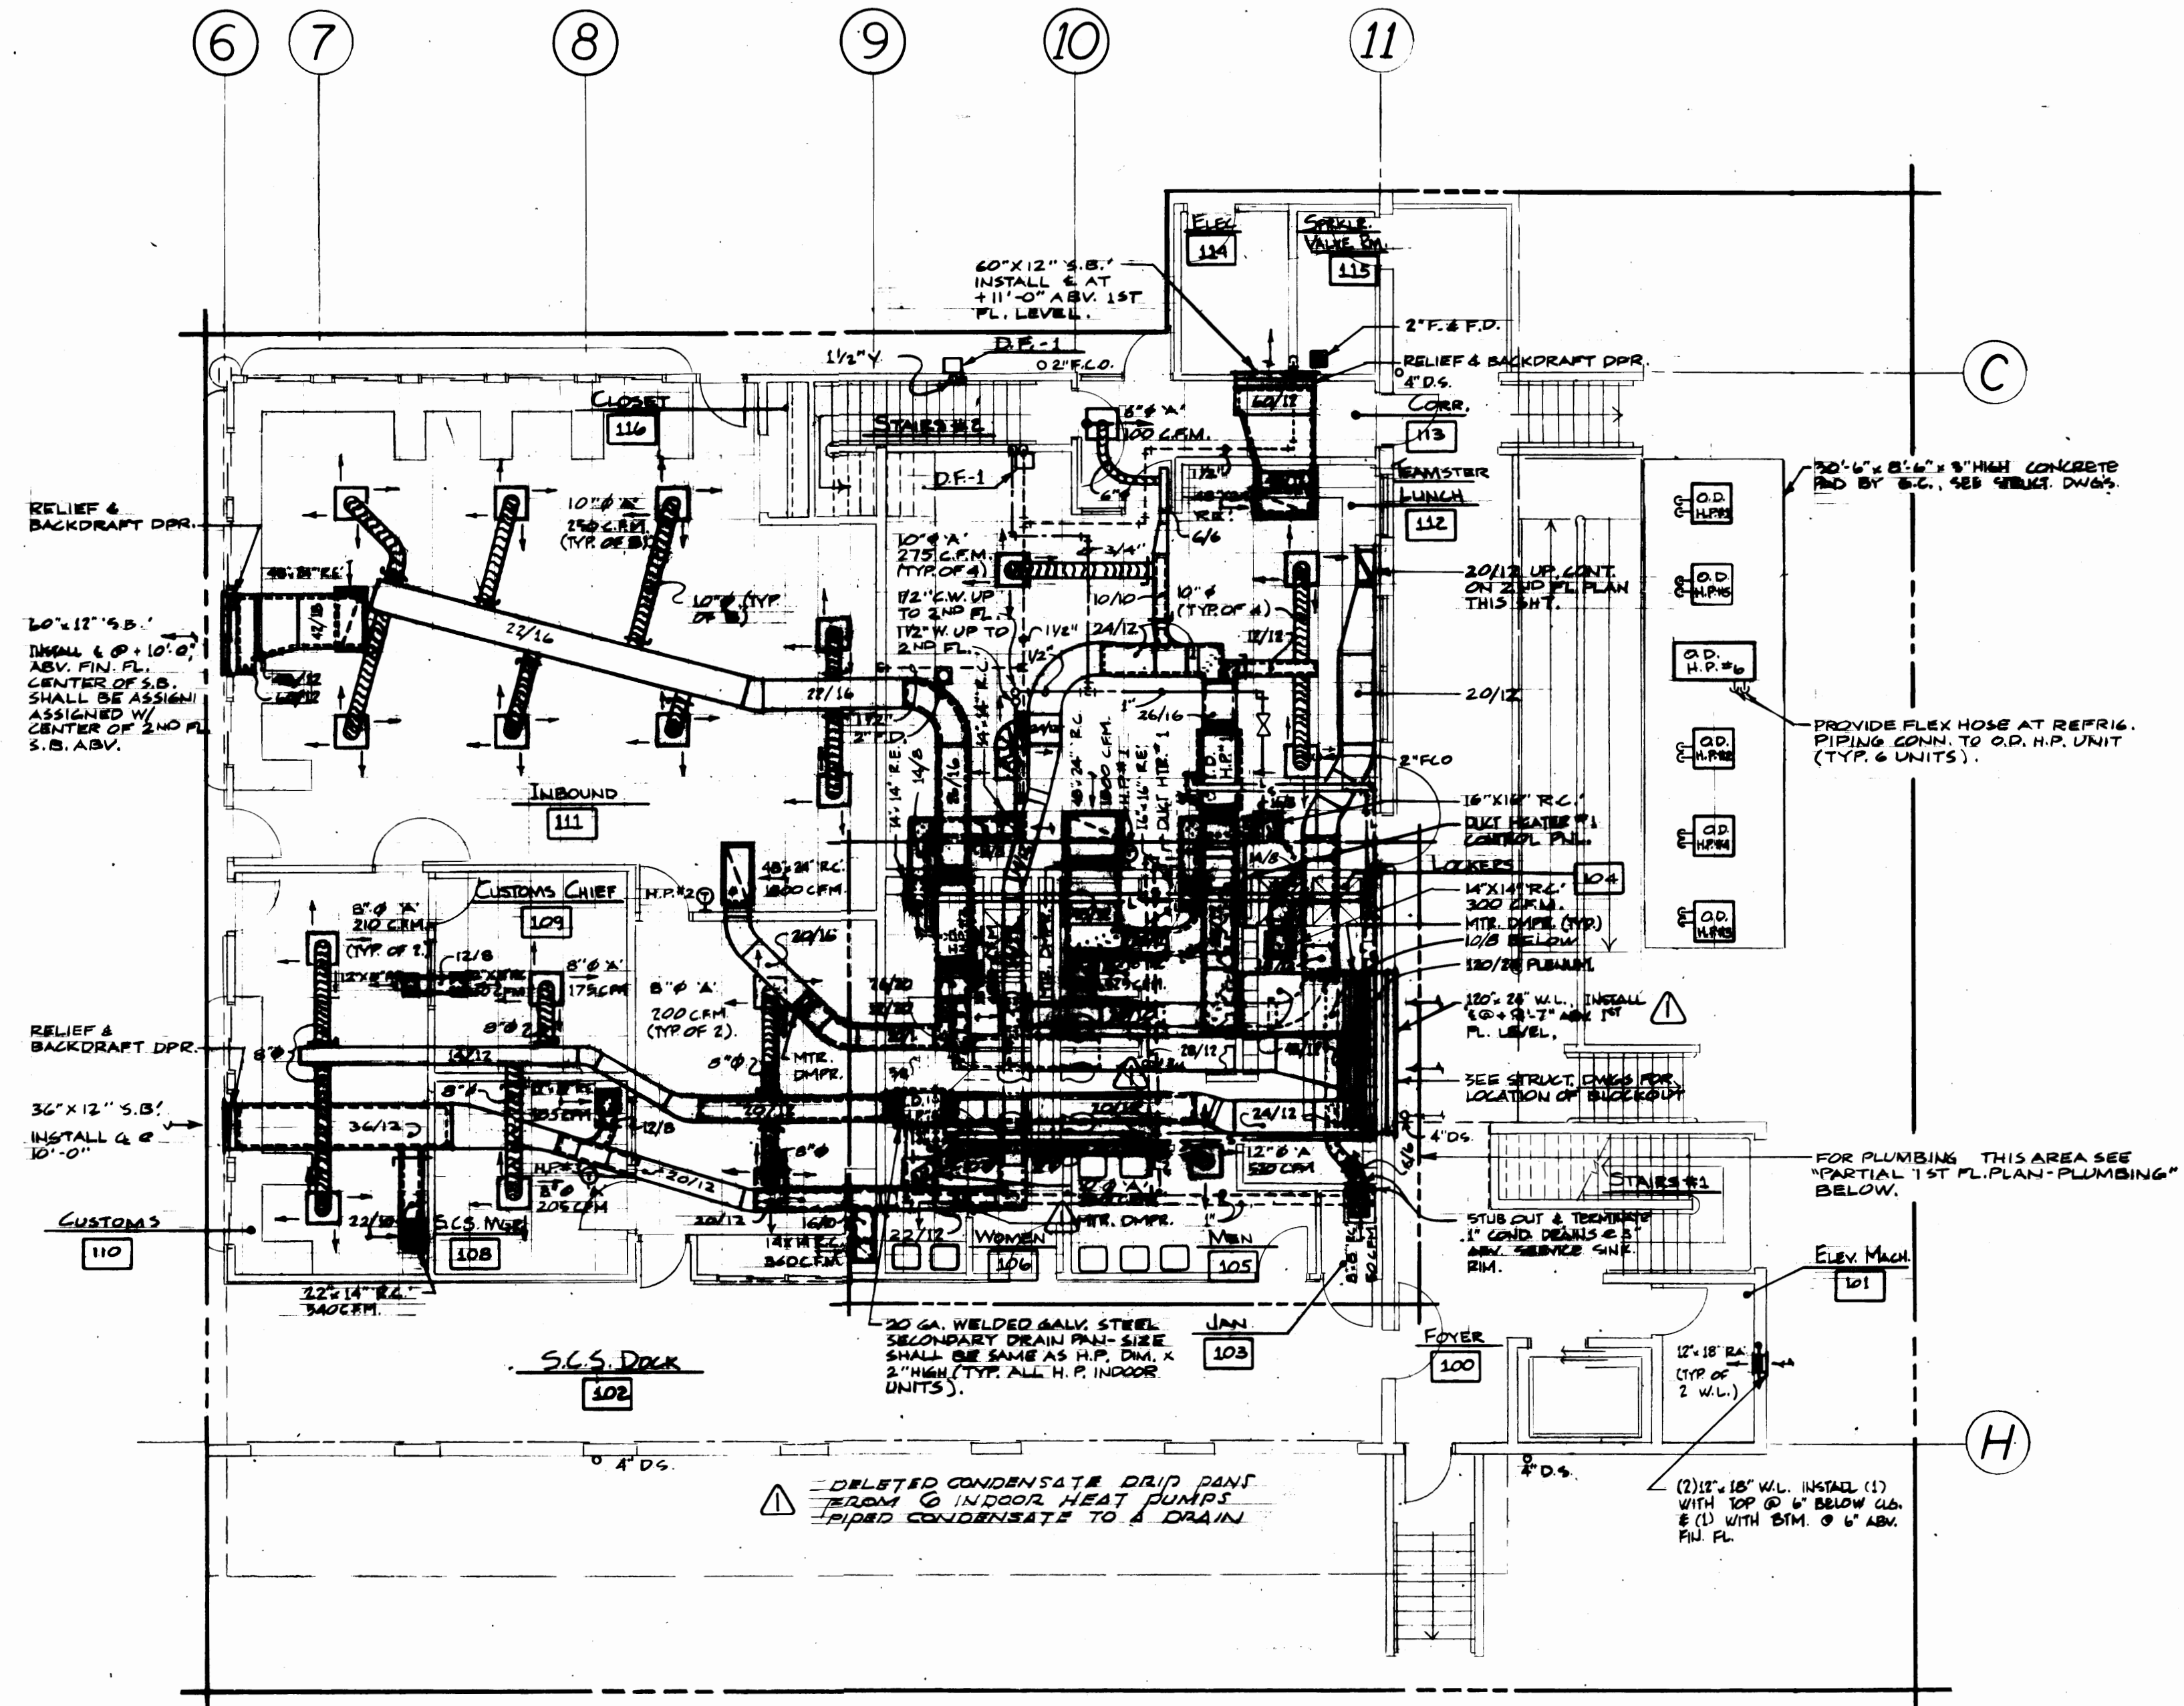

CFS OFFICE - 1ST FLOOR PLAN - MECH.

SCALE 1/8" = 1'-0"

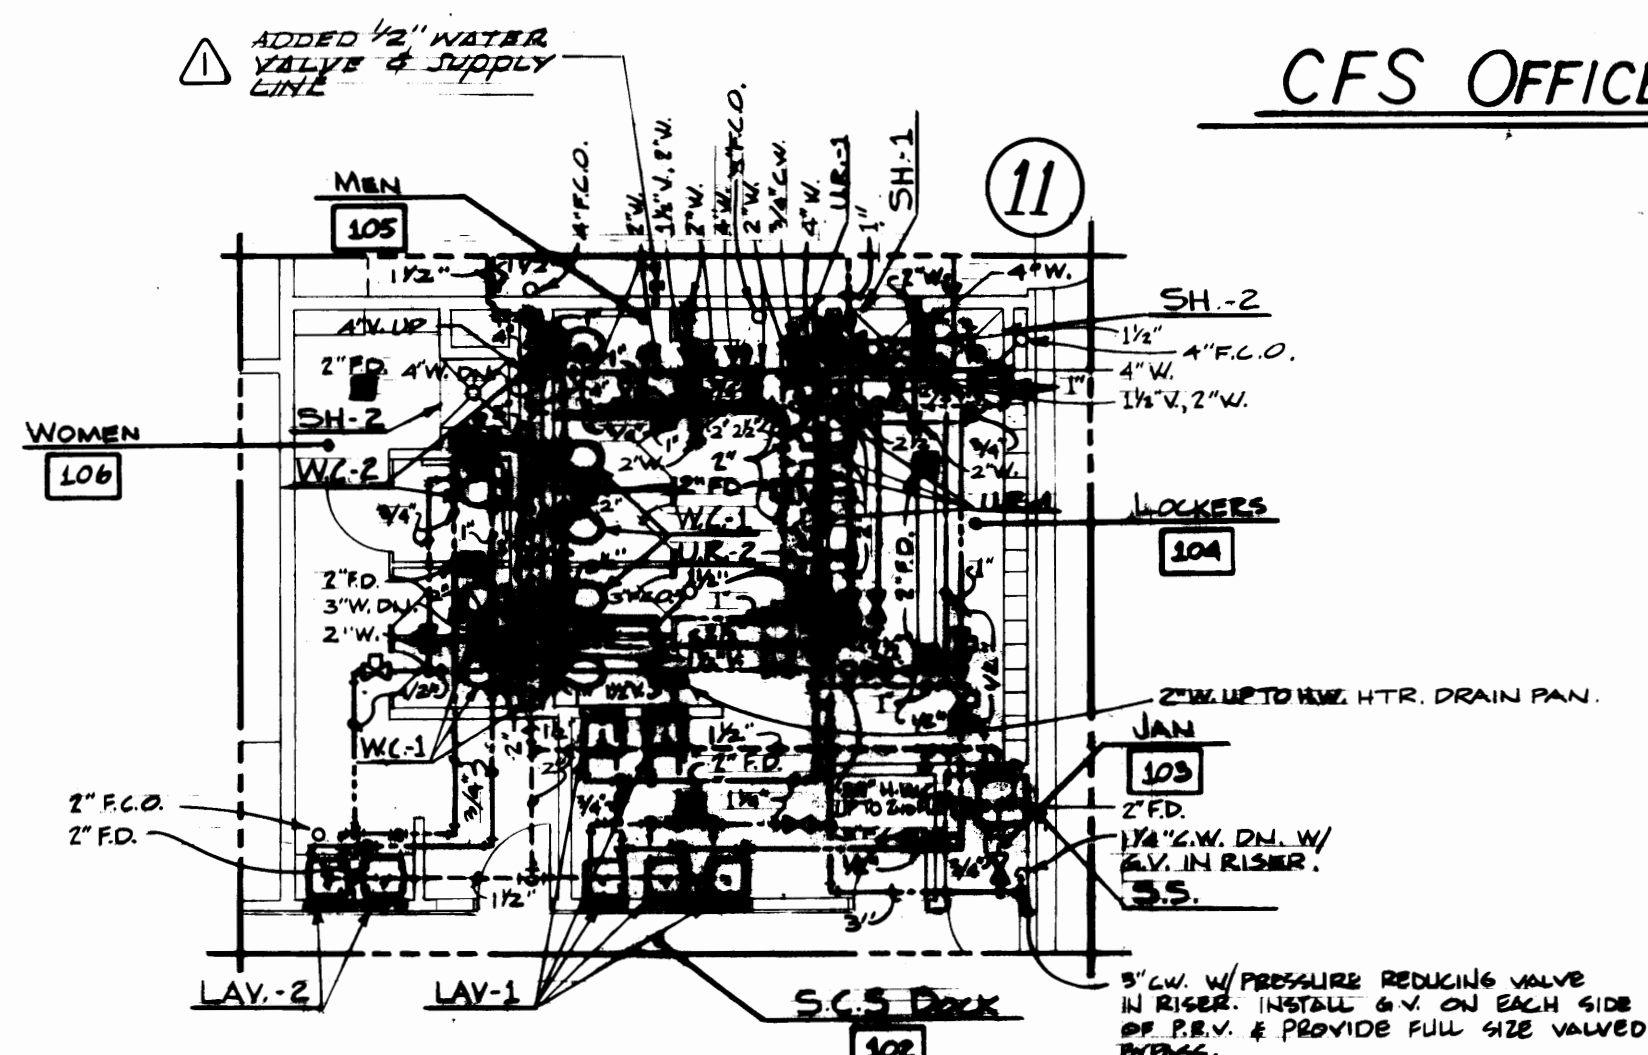

PARTIAL 1ST FLOOR PLAN - PLG


SCALE 1/8" = 1'-0"

NOTE:
SEE "WAREHOUSE - FOUNDATION PLAN", DWG. SHT. M-101
FOR ALL H.P. LIG. & SUCT. SIZES.

DRAWN		DATE		CHECKED		DATE		CHECKED		DATE		CONT. NO. 557		FIELD BOOK (S)		APPROVED		DATE		DRAWING NO.	
PORT OF TACOMA TACOMA TERMINALS, INC. CFS OFFICE - 1ST FL. PLAN - MECH., CFS OFFICE - 2ND FL. PLAN - MECH., PART. 1ST FL. PLAN - PLG., & PART. 2ND FL. PLAN - PLG.																					
REVISOR REVISION BY APP. DATE												3/30/84 DATE 3/30/84 DATE SHEET 35 OF 71									



Shelton Engineers, Inc.
Consulting Engineers
51 University, Suite 301
Tacoma, WA 98401
(206) 886-4116
1800 So. Tacoma, Suite 301
Tacoma, WA 98402
(206) 886-4117

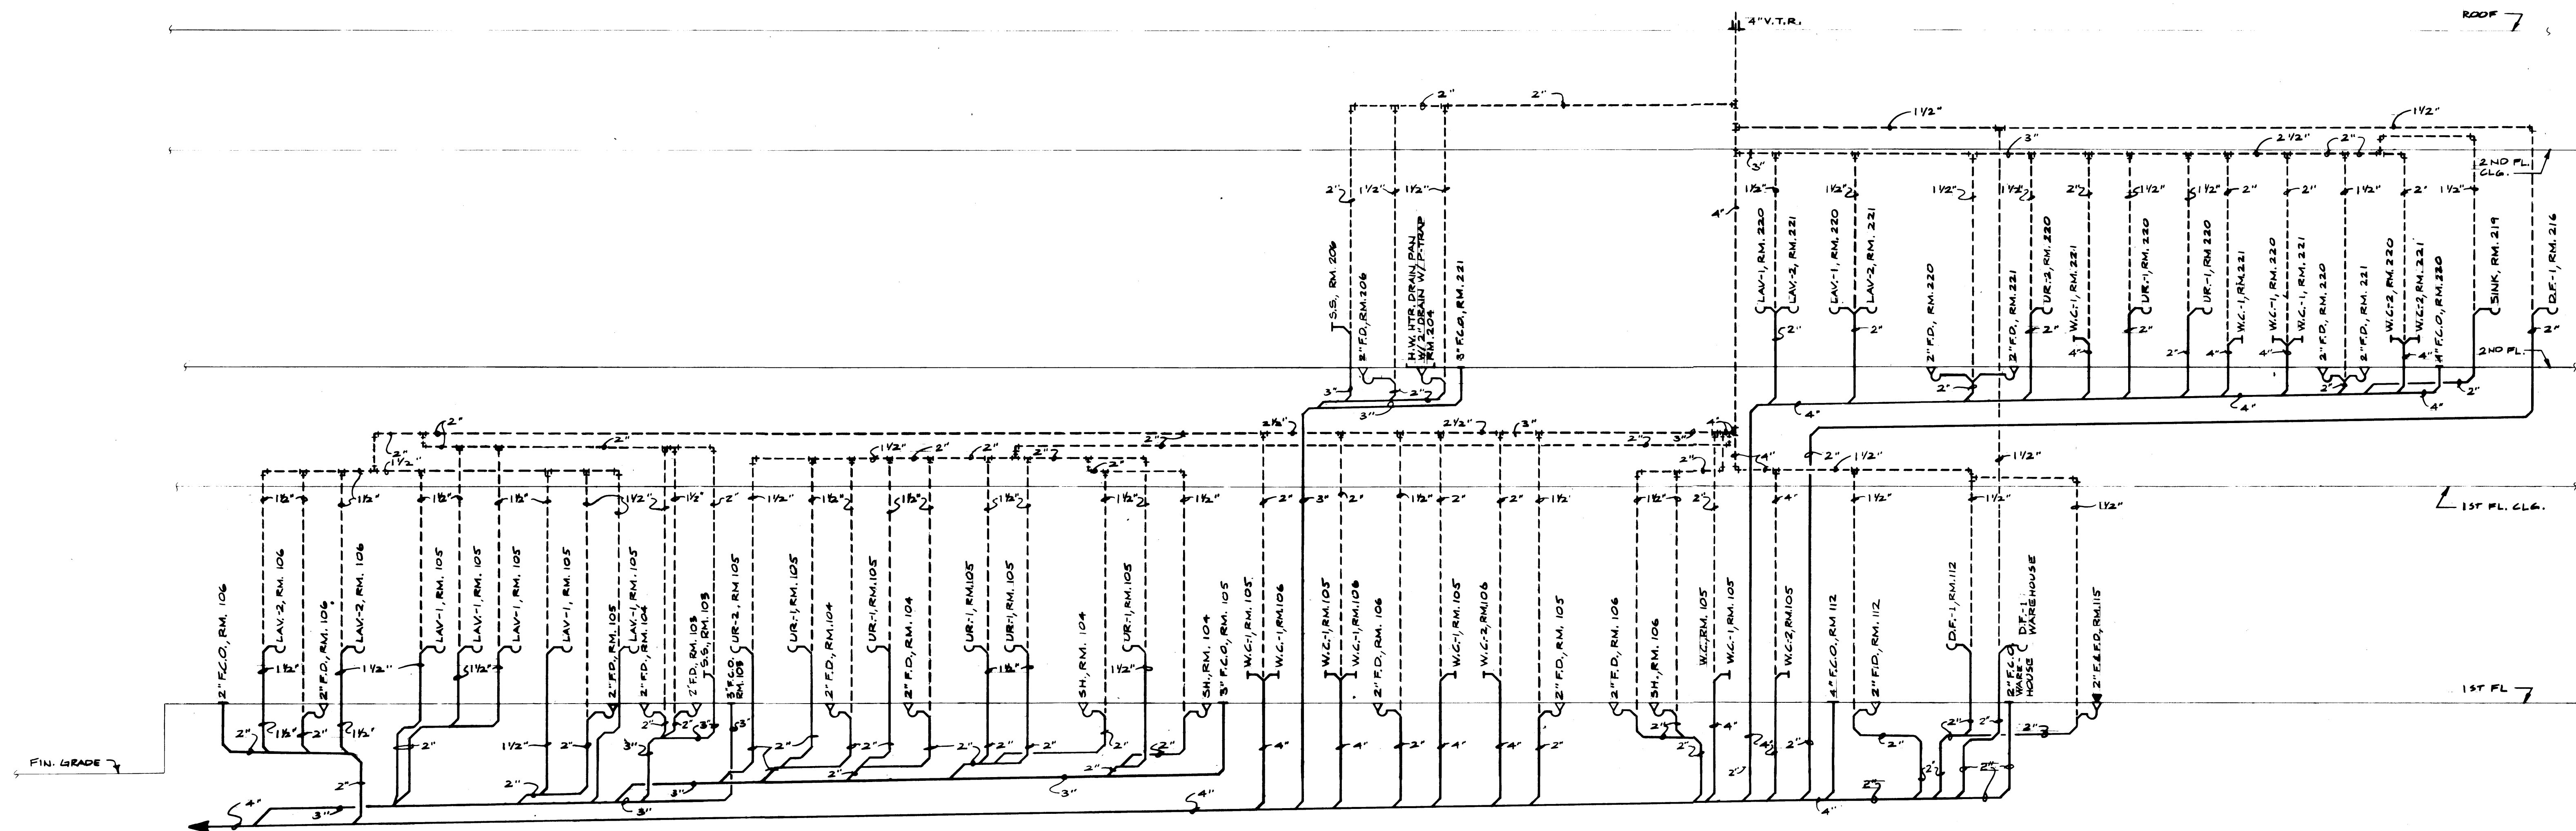

PLUMBING RISER DIAGRAM
DIAGRAMATIC

PLUMBING FIXTURE SCHEDULE







SYMBOL	FIXTURE	C.W.	H.W.	W.	V.	REMARKS
W.C.-1	WATER CLOSET	1"	-	4"	2"	WALL HUNG
W.C.-2	WATER CLOSET	1"	-	4"	2"	WALL HUNG - H/CAPPED
UR.-1	URINAL	3/4"	-	2"	1 1/2"	WALL HUNG
UR.-2	URINAL	3/4"	-	2"	1 1/2"	WALL HUNG - H/CAPPED
LAV.-1	LAVATORY	1/2"	1/2"	1 1/2"	1 1/2"	WALL HUNG
LAV.-2	LAVATORY	1/2"	1/2"	1 1/2"	1 1/2"	COUNTER TOP
S.	SINK	1/2"	1/2"	1 1/2"	1 1/2"	COUNTER TOP SINGLE COMPT.
S.S.	SERVICE SINK	3/4"	3/4"	3"	2"	WALL
D.F.-1	DRINKING FOUNTAIN	1/2"	-	1 1/2"	1 1/2"	WALL HUNG
D.F.-2	DRINKING FOUNTAIN	1/2"	-	1 1/2"	1 1/2"	PEDESTAL
SH.-1	SHOWER	1/2"	1/2"	2"	1 1/2"	
SH.-2	SHOWER	1/2"	1/2"	2"	1 1/2"	



Structural Engineers, Inc.
Consulting Engineers
31 University, Suite 301
Tacoma, WA 98401
(206) 862-4116
280 So. Pacific, Suite 301
Tacoma, WA 98402
(206) 383-2797





MARK	REVISION	BY	APP.	DATE
	NO AS BUILT CHANGES	R.J.S.		6-4-88

DRAWN _____		DATE _____	
CHECKED _____		DATE _____	
CHECKED _____		DATE _____	
CONT. NO. 557			
FIELD BOOK (B) _____		SCALE _____	
APPROVED _____		DATE 3/30/84	
PROJECT MANAGER _____		DATE 3/30/84	
CHIEF ENGINEER _____		DATE _____	
DRAWING NO. EP 3879-23 M106		SHEET 27 OF 71	

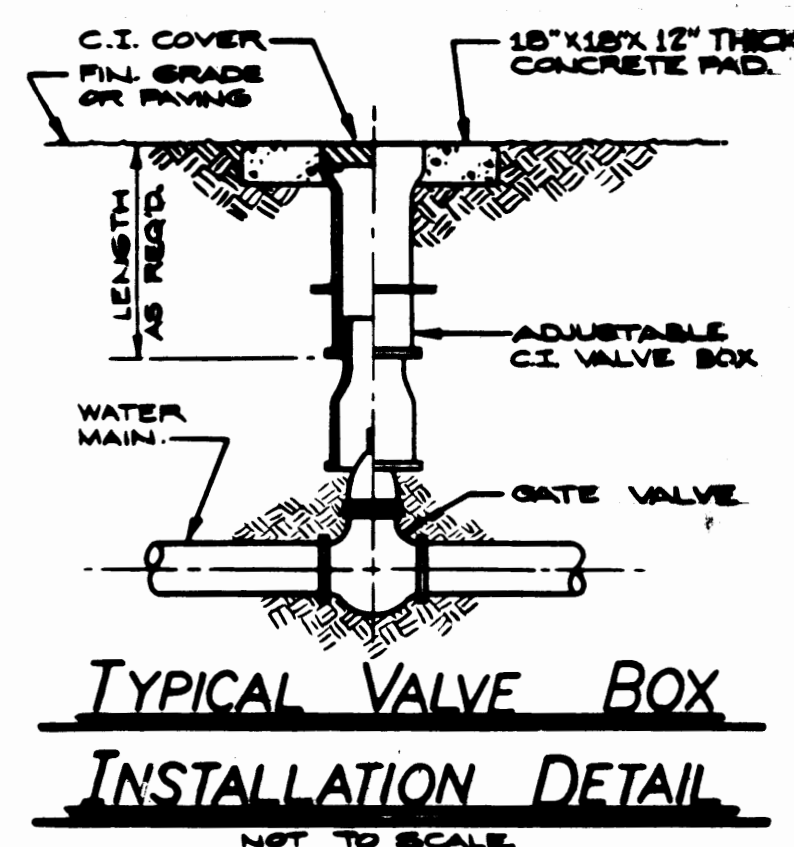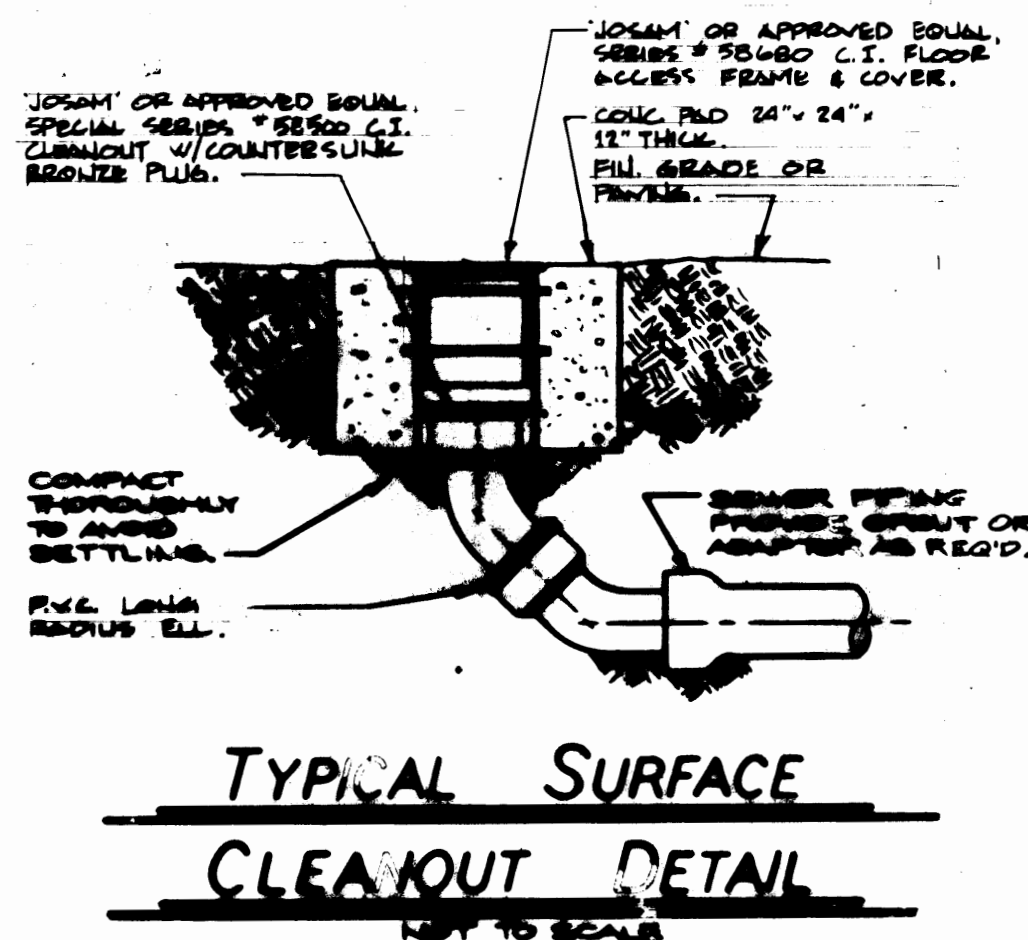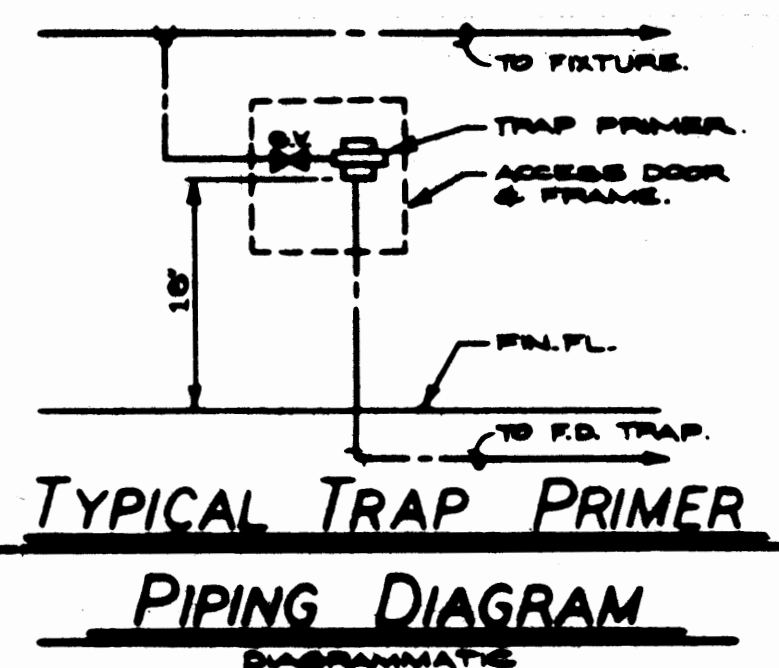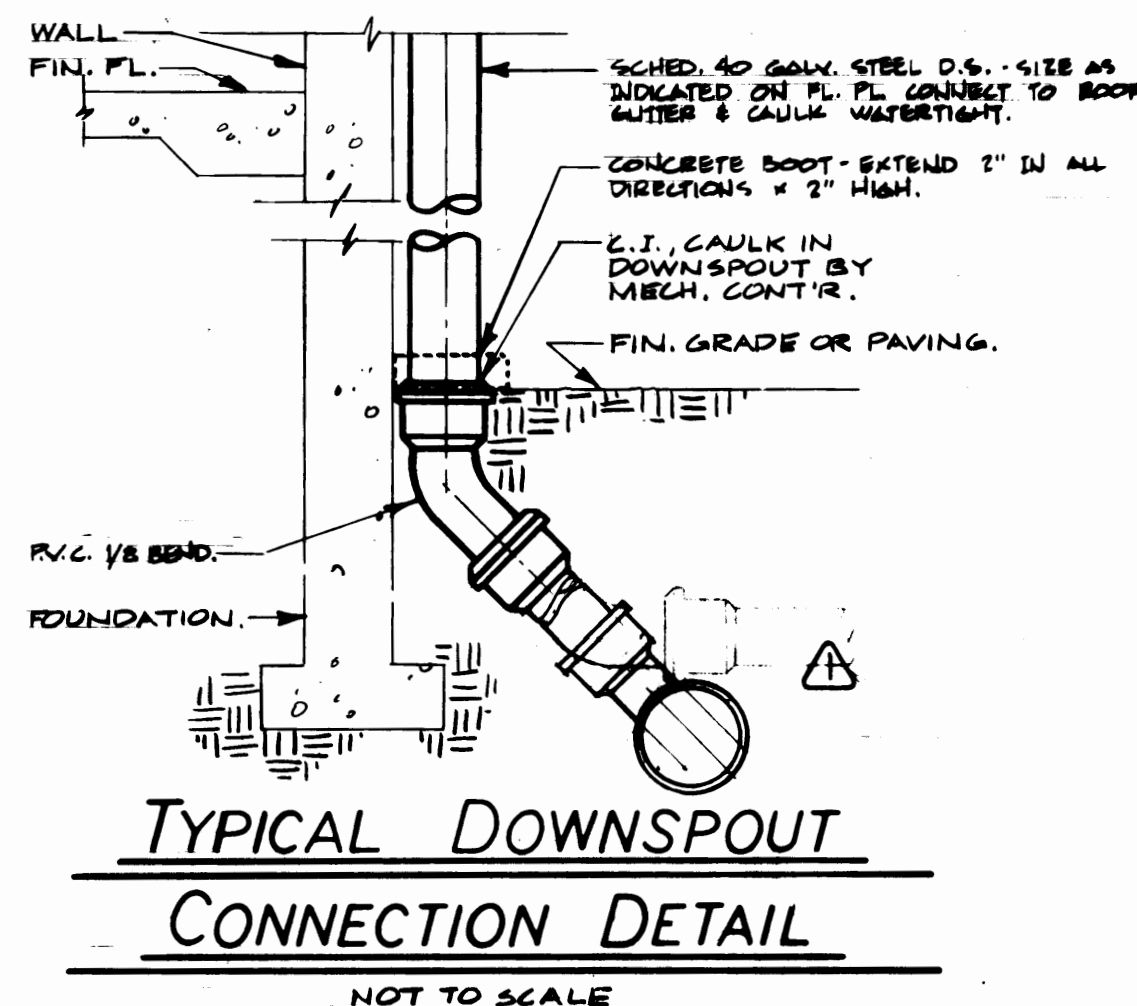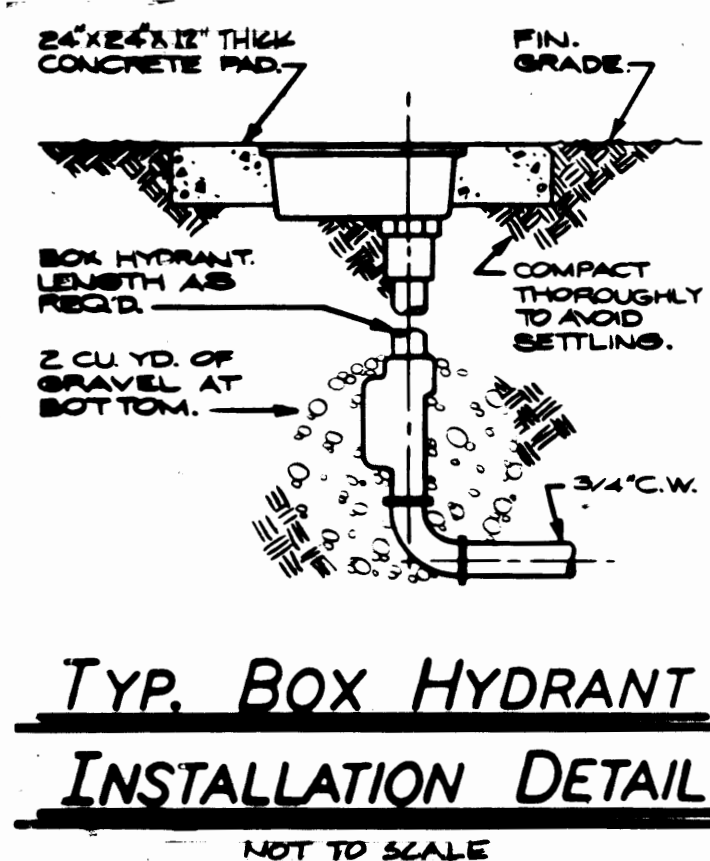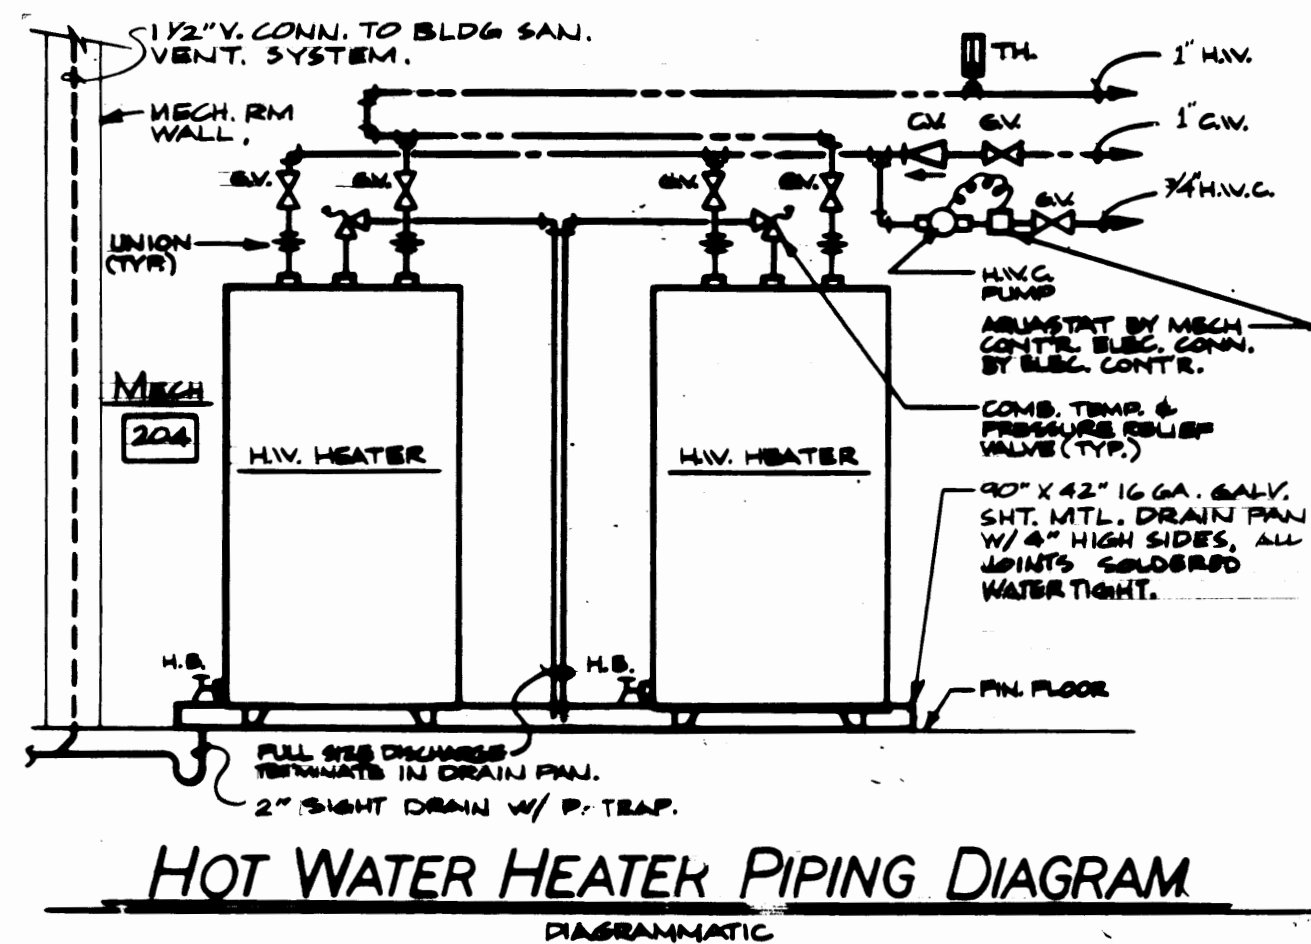

MECHANICAL SYMBOLS

SYMBOL	ABBR.	DESCRIPTION	SYMBOL	ABBR.	DESCRIPTION
		BUTTERFLY VALVE		FOS	FUEL OIL SUPPLY
		BALL VALVE		FOR	FUEL OIL RETURN
	GV	GATE VALVE		CWS	CHILLED WATER SUPPLY
		GLOBE VALVE		CWR	CHILLED WATER RETURN
	CV	CHECK VALVE		O ₂	OXYGEN PIPING
	PRV	PRESSURE REDUCING VALVE		N ₂ O	NITROGEN OXIDE PIPING
		BACKFLOW PREVENTER		A	COMPRESSED AIR PIPING
		AIR RELIEF VALVE		V	VACUUM PIPING
		CONTROL VALVE		FD	FLOOR DRAIN
		3 WAY CONTROL VALVE		F & TD	FLOOR & TUNNEL DRAIN
	BC	BALANCING COCK			
	UN	UNION		FCO	FLOOR CLEAN OUT
	BH	BOX HYDRANT		SCO	SURFACE CLEAN OUT
		GATE VALVE & VALVE BOX		CB	CATCH BASIN
	HB	HOSE BIB		PH	FIRE HYDRANT
	WH	WALL HYDRANT FREEZEPROOF			THRUST BLOCK
		TRAP PRIMER		F & T	FLOAT & THERMOSTATIC TRAP
		CIRCULATING PUMP			BUCKET TRAP
	PG	PRESSURE GAUGE			OXYGEN WALL OUTLET
	TH	THERMOMETER			COMPRESSED AIR OUTLET
		FLEXIBLE CONNECTION			SINGLE VACUUM WALL OUTLET
	AAV	AUTOMATIC AIR VENT			DOUBLE VACUUM WALL OUTLET
	STR	STRAINER		T-STAT	ROOM THERMOSTAT - 6" & 5'-4" ABOVE FIN. FLOOR
	CW	COLD WATER PIPING			DUCT RISING-AIR FLOW UP
	HW	HOT WATER PIPING			DUCT RISING AIR FLOW UP
	HWC	HOT WATER CIRCULATING			DUCT DROP-AIR FLOW DN.
	V	SANITARY VENT PIPING			DUCT DROP-AIR FLOW UP
	SS	SANITARY SEWER PIPING			SOURLINED DUCT
	S	STORM SEWER PIPING			FLEXIBLE DUCT
	R	HEATING RETURN PIPING		TV	TURNING VANES
	F	HEATING FLOW PIPING		VD	MANUAL VOLUME DAMPER
	ACID	ACID RESISTANT PIPING		F DFR	FIRE DAMPER
	G	GAS PIPING		O.D.	OUTDOOR
	SH	STEAM PIPING		I.D.	INDOOR
	CR	CONDENSATE RETURN PIPING			
	F	FIRE MAIN			

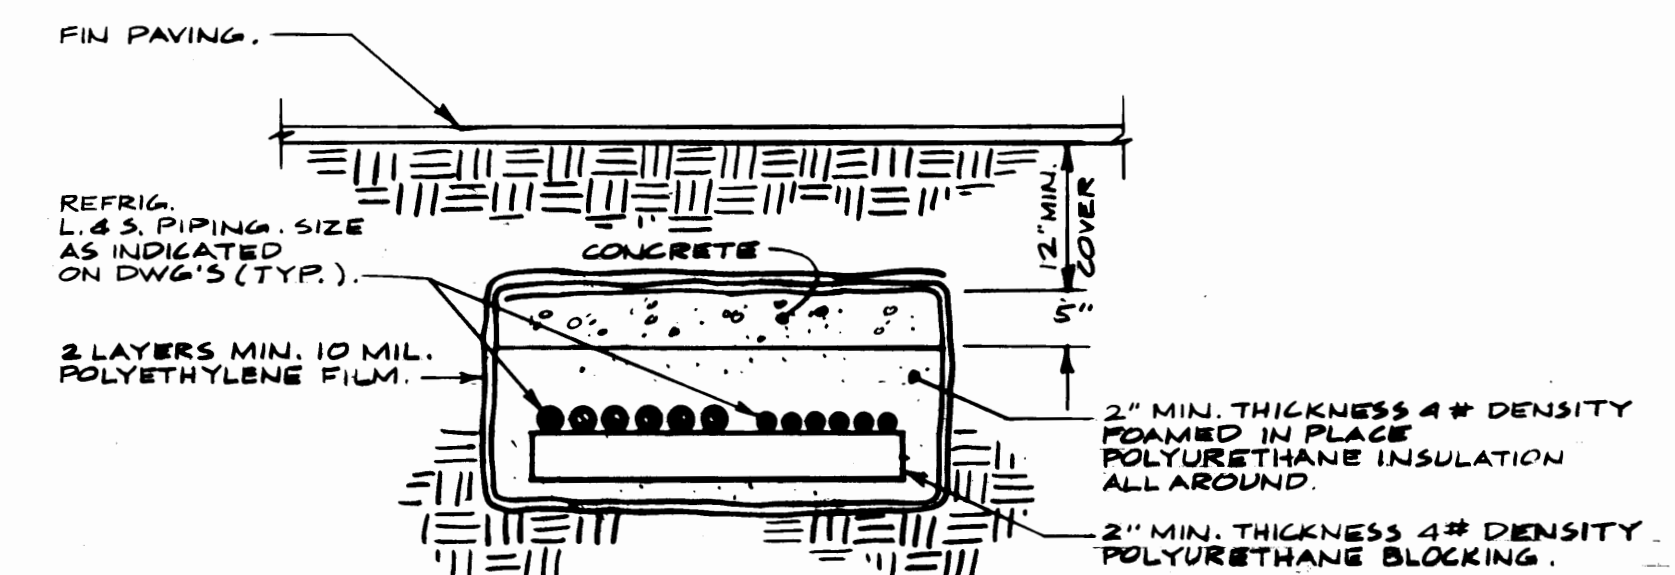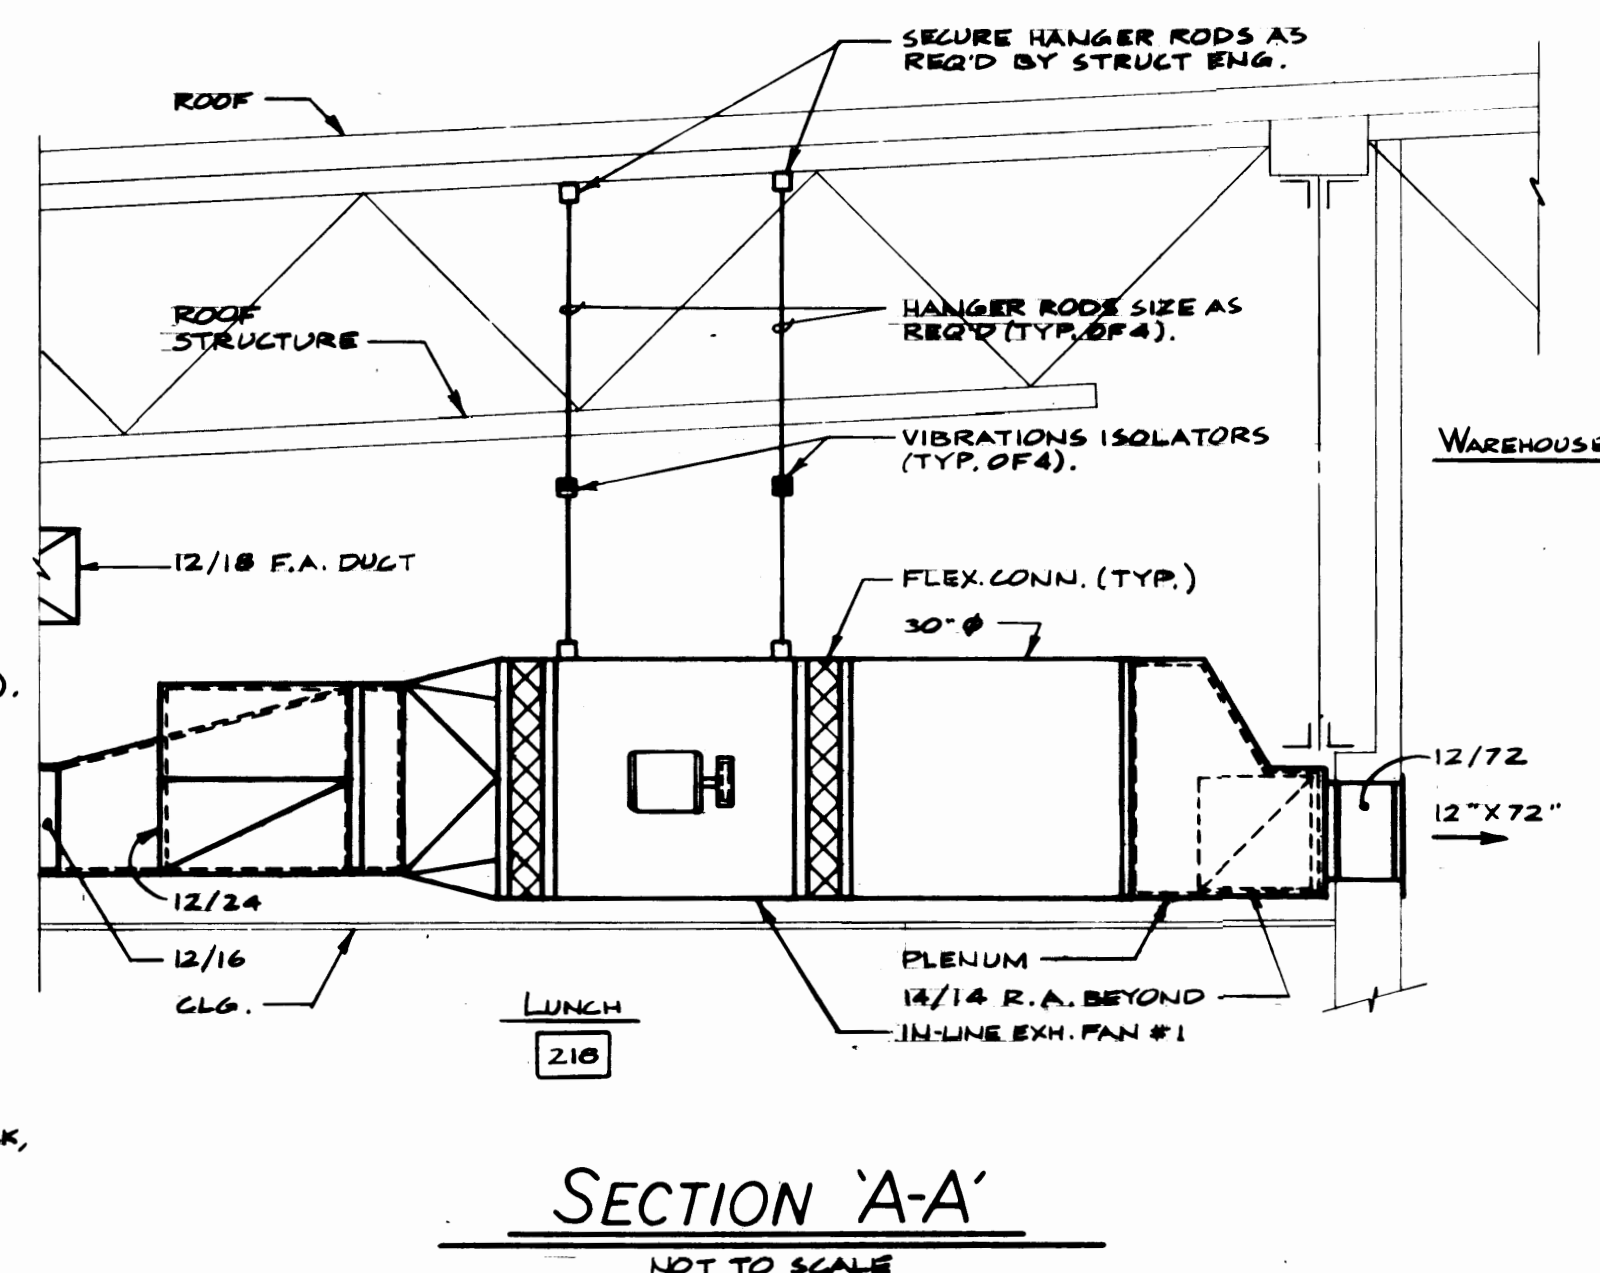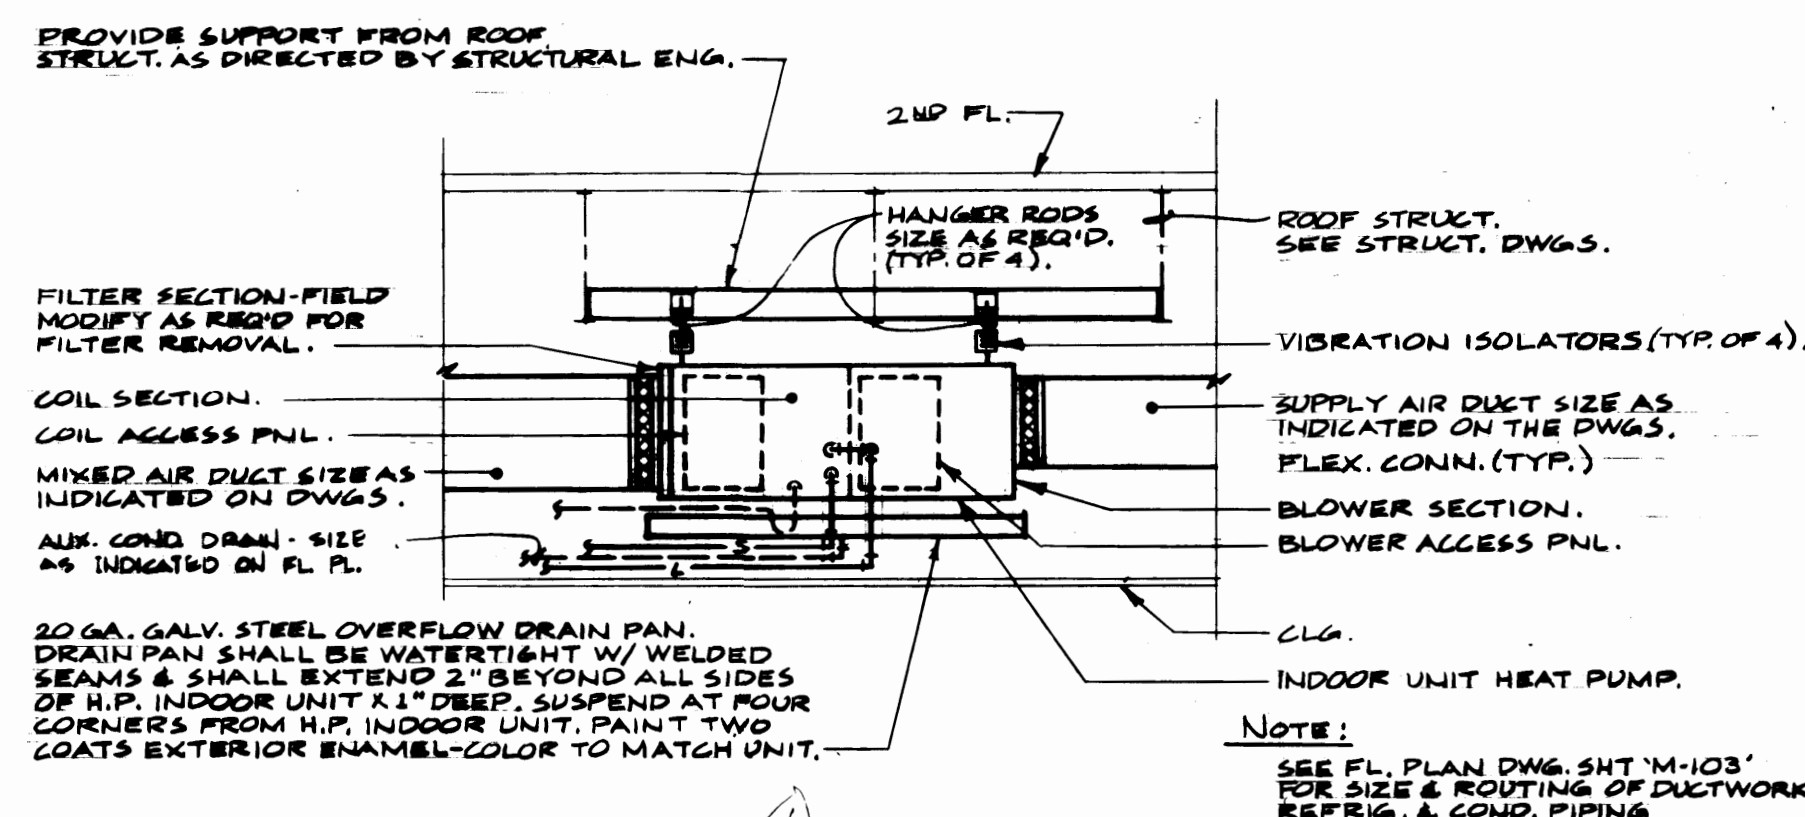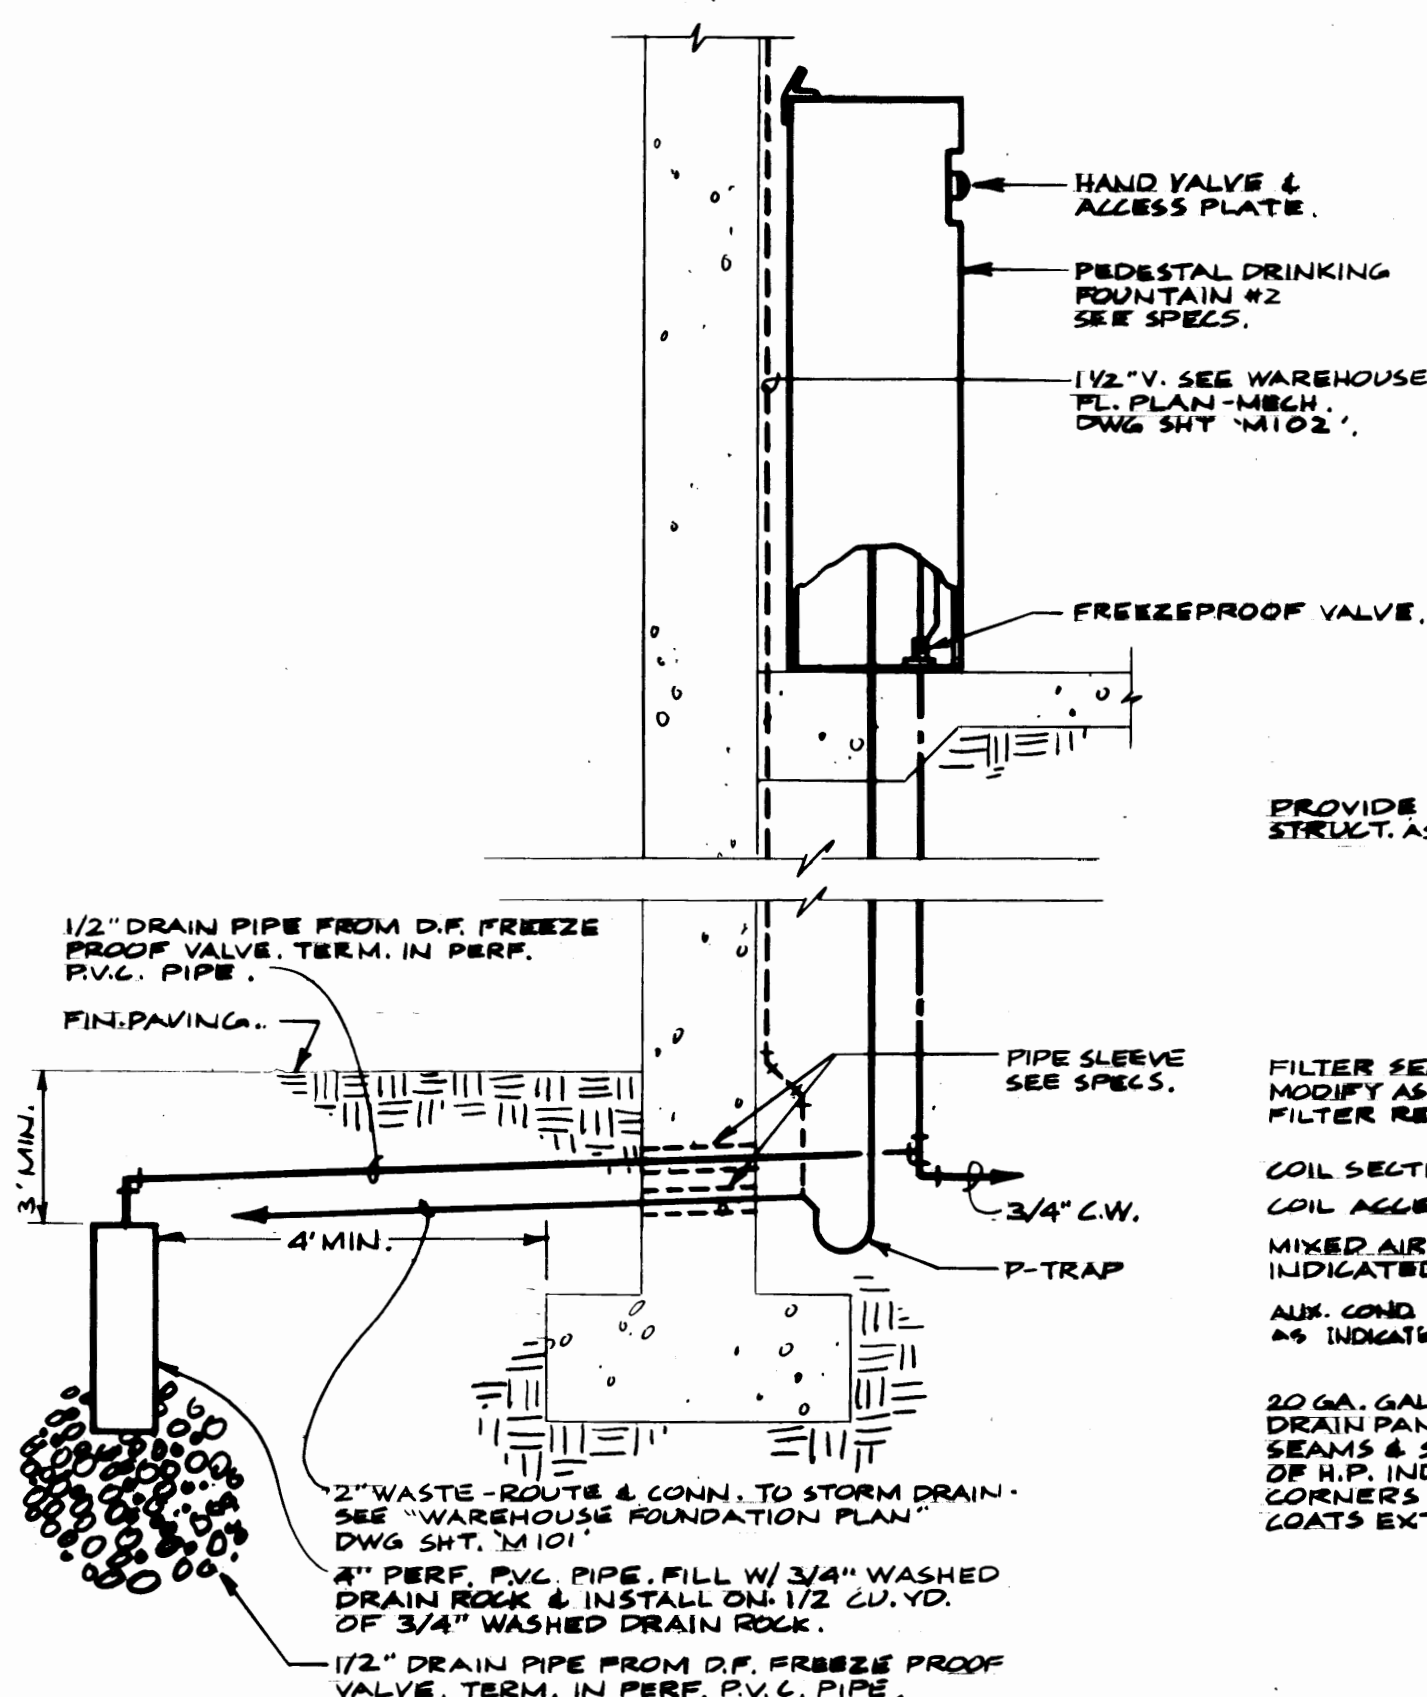


DRAWN _____		DATE _____		CHECKED _____		DATE _____		CHECKED _____		DATE _____		CONT. NO. 557		FIELD BOOK (B)		APPROVED _____		DATE 3/30/84		PROJECT MANAGER _____		DATE 3/30/84		CHIEF ENGINEER _____		SCALE _____		DRAWING NO. EP 3819-23 M106		SHEET 38 OF 71	
PORT OF TACOMA		TACOMA TERMINALS, INC.		MECH. SYMBOLS, DETAILS, DIAGRAMS & SECTIONS																											



Shaffer Engineering, Inc.
Consulting Engineers
51 University, Suite 301
Baltimore, MD 21201
(410) 662-4110
2920 So. Federal, Suite 301
Towson, MD 21204
(410) 386-2787

MARK	REVISION	BY	APP.	DATE
	REVISED TO AS-BUILT	AJS		3-3-84

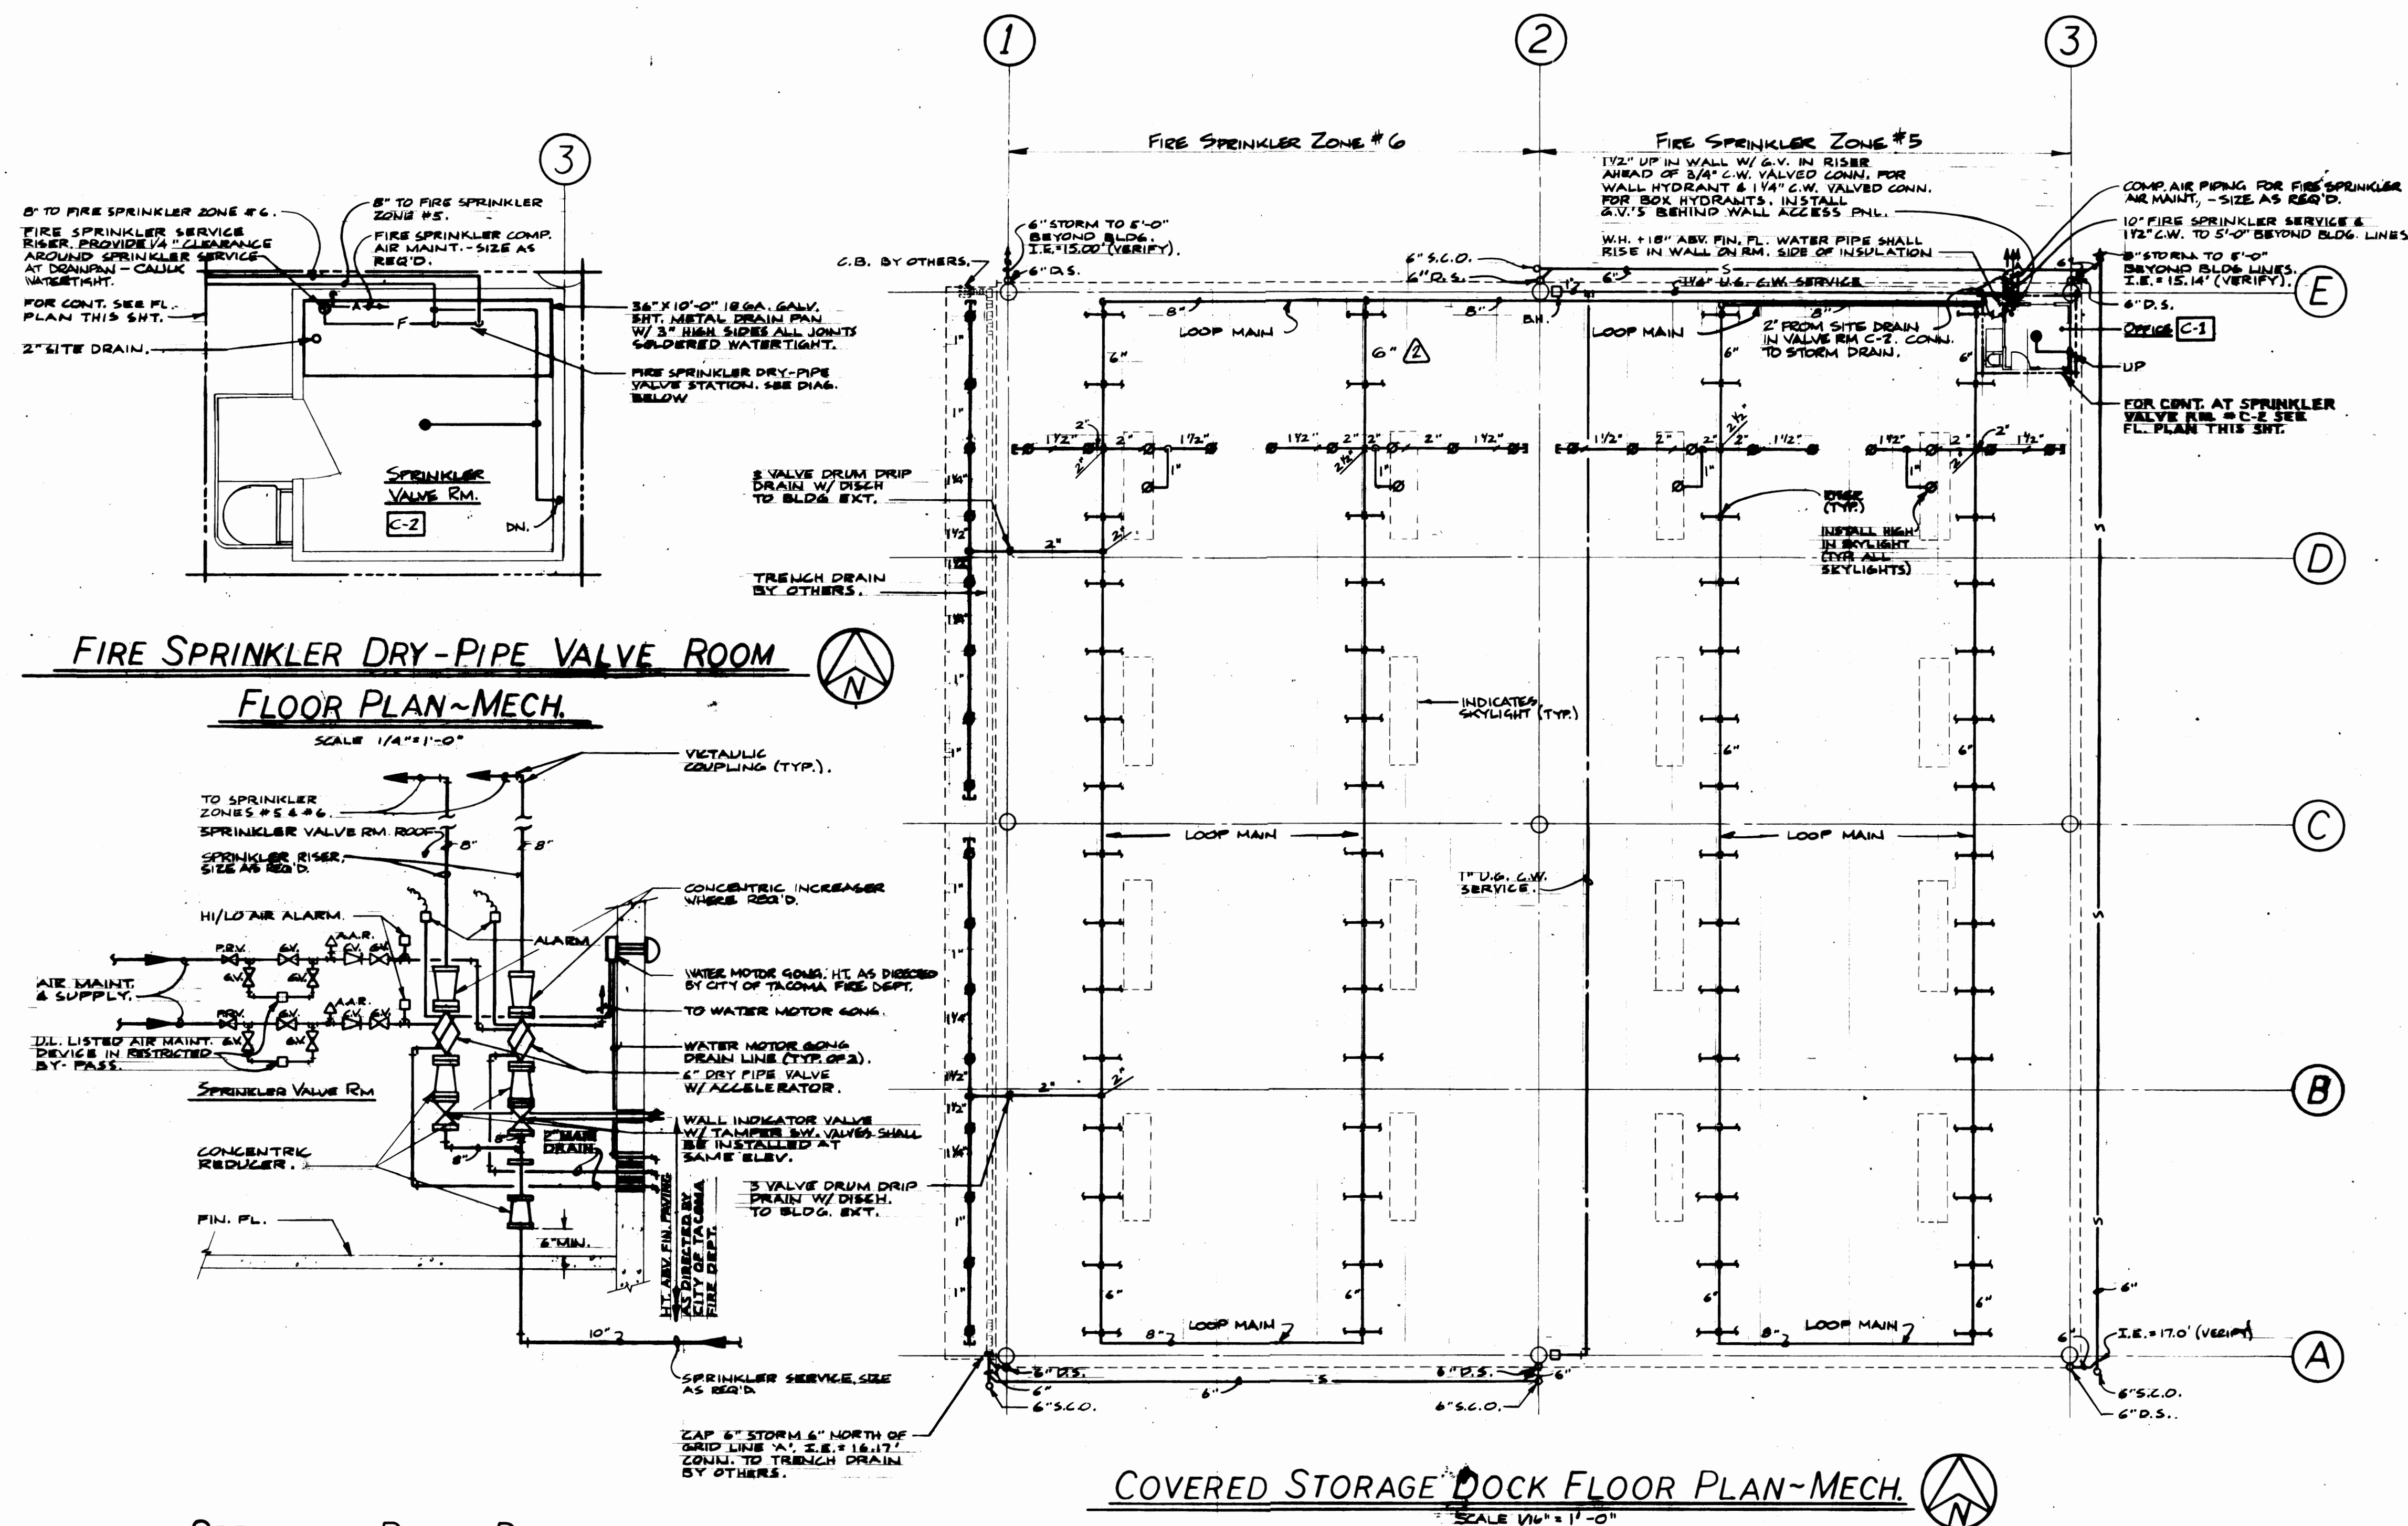

NOTE: SEE TROJAN FIRE PROTECTION CO. SHOP DRAWINGS FOR FINAL VALVE ROOM CONFIGURATION

ADDENDUM # 1
PORT OF TACOMA
TACOMA TERMINALS, INC.
COVERED STORAGE DOCK FL. PLAN-MECH., FIRE SPRINKLER DRY-PIPE VALVE RM. PL. PLAN-MECH., & DETAILS.



Checked by: [Signature]
By: [Signature]
Date: 3/30/84
Title: [Title]

MARK	REVISION	BY	APP.	DATE
1	ADOPT & ADD ISSUES TO SPRINKLER SYSTEM & ADD TWO (2) FIRE HYDRANTS & C.W. SERVICE	A.S.		3/30/84
2	REVISOR TO AS BUILT			

DRAWN	DATE	CHECKED	DATE	CHECKED	DATE	CONT. NO. 557
FIELD BOOK (S)						SCALE
APPROVED [Signature] 3/30/84						DRAWING NO. 12 3456-23 M72
DATE 3/30/84						SHEET 55 OF 7

GENERAL NOTES

These General Notes are to be used as a supplement to the Specifications. Any discrepancies found among the Drawings, the Specifications, these General Notes and the site conditions shall be reported to the Engineer, who shall correct such error or omission in writing. Any work done by the Contractor after discovery of such error shall be done at the Contractor's risk. The Contractor shall verify and coordinate dimensions among all drawings prior to proceeding with any work or fabrication. The Contractor is responsible for all bracing and shoring during construction.

Standards

All methods, materials and workmanship shall conform to the 1979 Uniform Building Code (UBC) as amended and adopted by the City of Tacoma.

DESIGN CRITERIA

Vertical Loads:

	Slab on Grade	Roof	Office Floor	Storage Area
Dead Load	Actual	Actual	Actual	Actual
Live Load	500 PSF	25 PSF	50 PSF	125 PSF
Partition Load	---	---	20 PSF	---

Lateral Forces

- Lateral forces are transmitted by diaphragm action of roof and floors to shear walls. Loads are then transferred to foundation by shear wall action where ultimate displacement is resisted by passive pressure of earth and/or sliding friction. Overturning is resisted by dead load of the structure.
- Wind: 25 PSF "Wind-Pressure-Map" Area (20 PSF for Height < 30'-0").
Uplift - Enclosed Roof Areas: 75% of wind load less 2/3 design dead load.
Overhangs and Partly Enclosed Areas: 125% of wind load less 2/3 design dead load.
- Seismic: Zone 3 per 1979 UBC. V-ZIKOSW, V-Base Shear, Z=.75, I=1.00, K=1.33, CS=.14, W=Dead Load of Portion of Building.

Soil Bearing Pressure: 3500 PSF

All footings shall bear on firm, structural backfill. Areas over-excavated shall be backfilled with lean concrete (f'c=2000 PSI) or "Structural Backfill". Areas designated "Structural Backfill" shall be filled with approved well-graded bankrun material. Maximum size of rock 4"-6". Frozen soil, organic material and deleterious matter not allowed. Compact to at least 95% of its maximum density as determined by ASTM D-1557. Contractor shall exercise extreme care during excavation to avoid damage to buried lines, tanks, and other concealed items. Upon discovery, do not proceed with work until receiving written instructions from Engineer. A competent representative of the Owner shall inspect all footing excavations for suitability of bearing surfaces prior to placement of reinforcing steel. Provide drainage around all work to avoid water-softened footings.

CONCRETE

Concrete: Shall be made with Portland Cement ASTM C-150 Type I or Type I-1, coarse and fine aggregate ASTM C-33, water clean and potable and shall be ready-mixed per ASTM C-94 unless otherwise approved. Add to all concrete exposed to weather, an air entraining agent to attain 5% ± 1-1/2% entrained air, by volume, conforming to ASTM C-260. No aluminum (conduit, miscellaneous items, etc.) shall be embedded in any concrete.

Materials

Item	Minimum f'c 28 Days	Normal Slump Inches* Maximum
Footings	3000	5
Tilt-Up Walls	4000	4
Slabs	4000	4
All Other Concrete	4000	4

*At Contractor's option, Contractor may use Master Builders Synergized Performance Systems or approved equal using Pozzolith admixtures to produce flowable concrete. Maximum slump shall not exceed 9". Master Builders concrete technician shall assist in determining proportions for SPS concrete and shall obtain approval of Engineer prior to employing this procedure.

Place concrete per ACI 304 and conform to ACI 604 (306) Winter Concreting and ACI 605 (305) for Hot Weather Concreting. Use interior mechanical vibrators with 7000 RPM minimum frequency. Do not over-vibrate. Concrete shall be poured monolithically between construction or expansion joints. Protect all freshly placed concrete from premature drying, excessive hot or cold temperature for seven days after pouring. Submit drawings with control joint pattern for Engineer's approval prior to placing.

PRECAST CONCRETE PANELS

Reinforcing shown on panel details is designed for forces occurring after panel is in place and tied to roof and floor diaphragms. Use strongbacks and extra reinforcing as required and directed by panel erector for erection purposes.

Panels drawn show typical locations of panel connections and additional reinforcing for most panel openings. NOT ALL embedded items and mechanical and electrical preparations are shown. Contractor shall coordinate penetrations with mechanical and electrical and reinforcing per detail S/S116, or as directed by the Structural Engineer.

Submit shop drawings showing all panel dimensions, blockouts for openings, location of reinforcing steel, connections, inserts and all other embedded items for approval by Engineer.

Drypack Grout: Make from one part ASTM C-150 Type I Portland Cement, one part fine sand ASTM C-33, and one part "Embeco" by Master Builders or equal. Mix dry as can be worked, and pack solid to fill entire space under plates or shapes. Use "Embeco 636" for nonexposed work. Use "Master-flow 713" by Master Builders for exposed work.

Metal Reinforcement (Concrete & Masonry): All reinforcing shall conform to ASTM A-615, Grade 40 for #5 and smaller, Grade 60 for #6 and larger, Grade 40 for all welded bars. Detail, fabricate and place per ACI 315 and ACI 318. Splices shall be 24 bar diameters or 18" minimum (39 bar diameters, 18" minimum for masonry). Welded Wire Fabric shall conform to ASTM A-82 and A-185. Lap one full mesh on sides and ends. Place at mid-depth of slab, or as shown.

MASONRY

Hollow Concrete Masonry Units (CMU): Conform to ASTM C-90, minimum face shell thickness 1-1/2", Grade "N" half and half. Ultimate compressive strength f'm=1350 PSI minimum (f'm=1500 PSI solid grouted).

Mortar: Type S per UBC. Conform to ASTM C-270, f'm=1800 PSI minimum in 28 days.

Grout: Grout for pouring shall be a fluid consistency. Conform to ASTM C-476. f'c=2000 PSI minimum at 28 days.

STRUCTURAL STEEL

Detailing, Fabrication and Erection: Conform to the AISC "Manual of Steel Construction", 8th Edition.

Steel Shapes and Plates: ASTM A-36 (fy=36 ksi).

Steel Structural Tubing: ASTM A-500 (fy=46 ksi).

Machine Bolts (M.B.) and Anchor Bolts (A.B.): ASTM A-307.

Drilled-In Anchors: "Parabolt" by USM, Inc., Molly Fastener Division, or approved equal. Embed bolt into concrete or masonry 7 diameter minimum, except as shown.

Studs: "Nelson Studs" shall be by Nelson Stud Welding Division, Gregory Industries, Inc., or approved equal.

Concrete Anchors: Hooked or headed, smooth dowel stock, shop welded by certified welders.

Finish: Shop paint after fabrication with an approved primer (see Specifications). Galvanize after fabrication all miscellaneous steel exposed to weather or view.

Metal Joists: Shall conform to the Steel Joist Institute (SJI) and American Institute for Steel Construction (AISC) standards and shall be designed to carry the loads listed in the design criterion and those indicated on the framing plans. For special requirements, see structural drawings. Shop drawings shall be submitted bearing the stamp of a structural engineer licensed as such in the State of Washington.

Composite Floor Deck: Shall be "Formlok" (with depth and gauge as shown on Drawings) as manufactured by Verco Manufacturing, Inc., or approved equal. The floor units shall be formed from steel sheets conforming to ASTM A-446-72, and galvanized per ASTM A-525-71. Submit shop drawings showing layout and fastening pattern. All accessories shall be provided to complete the erection of the steel floor.

Metal Roof Deck: Shall contain the minimum properties shown on the structural drawings and specifications. The roof deck shall be formed from steel sheets conforming to ASTM A-446-72 or A-446-72, and shall be galvanized per ASTM A-525. The roof deck shall be placed on the supporting framework with a minimum end lap of two inches.

WELDING

Structural Steel: Weld in accordance with "Structural Welding Code" AWS D-1.1-76.


Reinforcing Steel: Weld in accordance with "Reinforcing Steel Welding Code" AWS D-12.1-75. Weld only with specific approval of the Engineer. In no case will a weld be made within 6 bar diameters of a "cold bend".

Certification: All welding shall be by certified welders.

Electrodes: Use E60 or E70 electrodes.


SUBSTITUTIONS

Substitutions may be allowed only if they meet the requirements of these General Notes and the Specifications, and if complete written engineering data for each condition required for this project is provided to the Project Engineer seven days prior to bid date and approved in written addenda by the Architect. Data is to indicate code basis by year, authority for stresses and stress increases, if any, and amount of expected deflection for flexural members under (1) total load and (2) live load only. All increased costs in mechanical, sprinkler, electrical or general installation and any architectural or structural redesign resulting from substitution will be borne by the General Contractor.

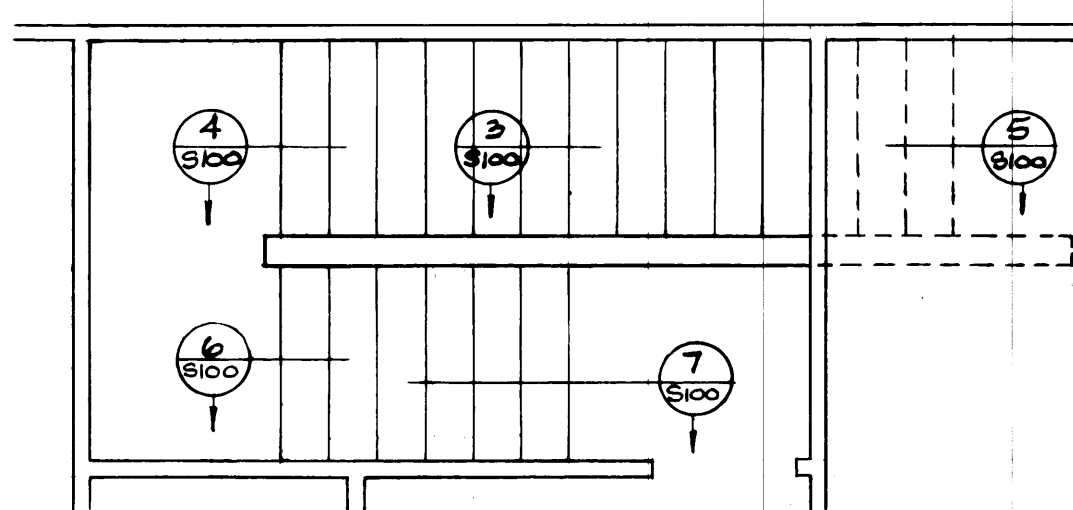


STAIR #2


PLAN

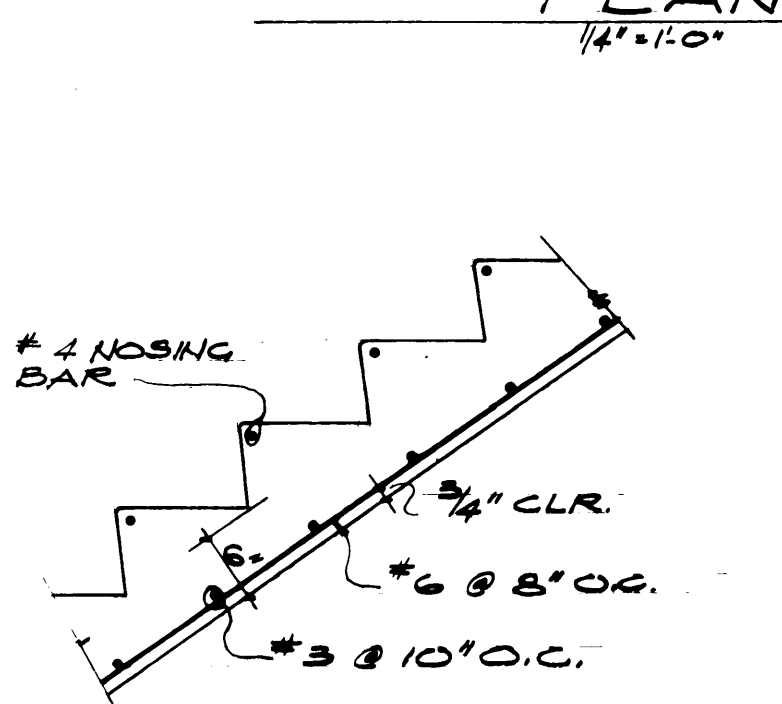

SECTION

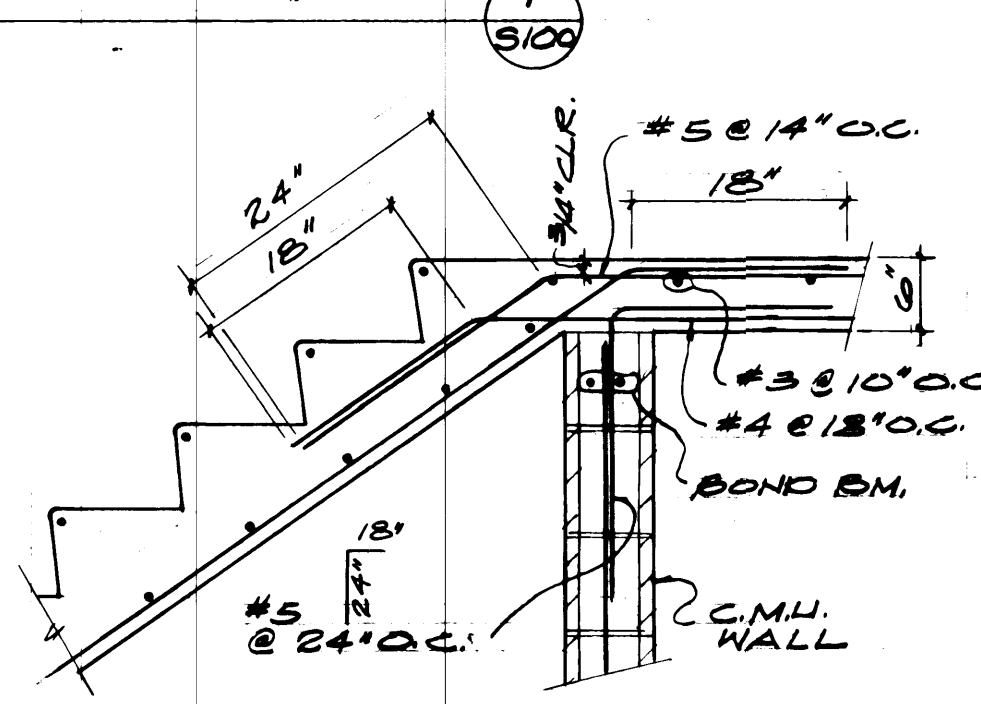


SECTION

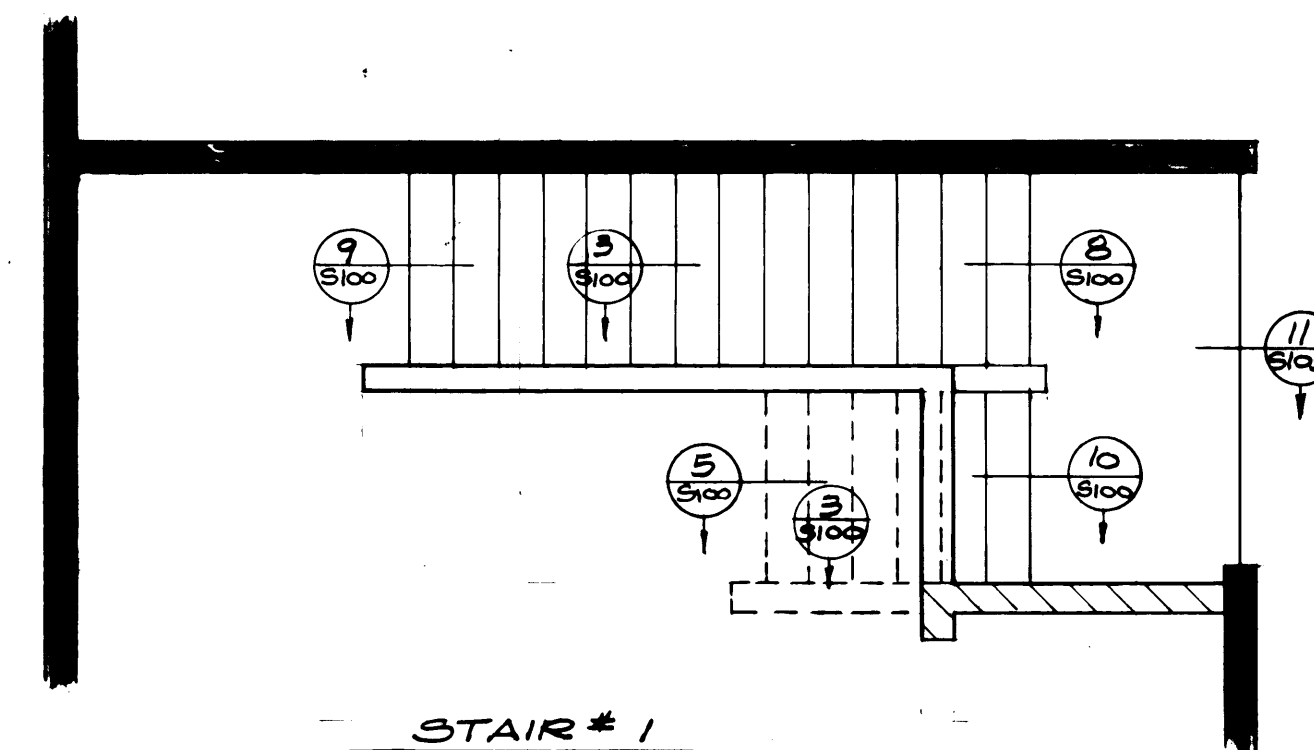


STAIR #1


PLAN

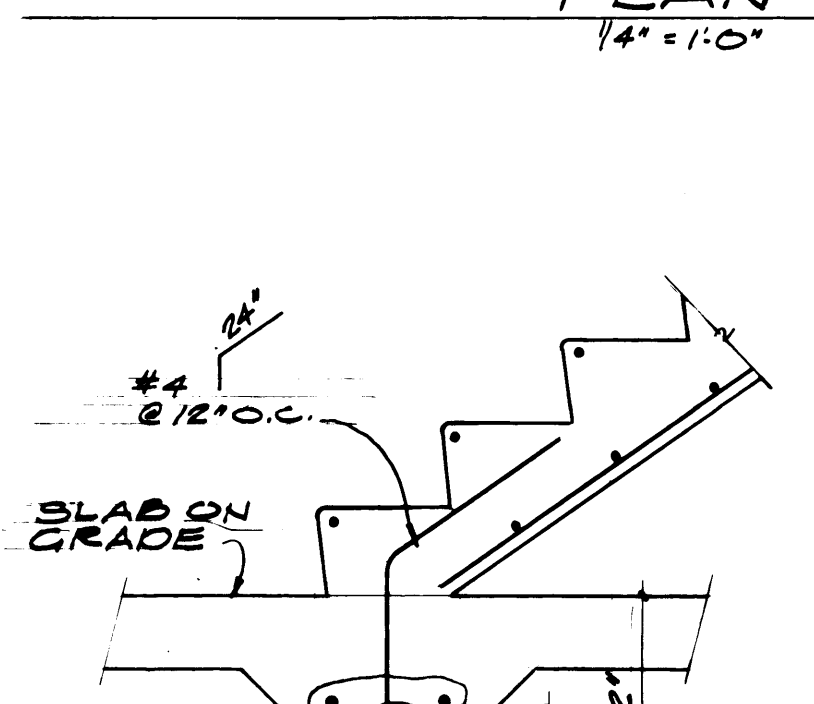


SECTION

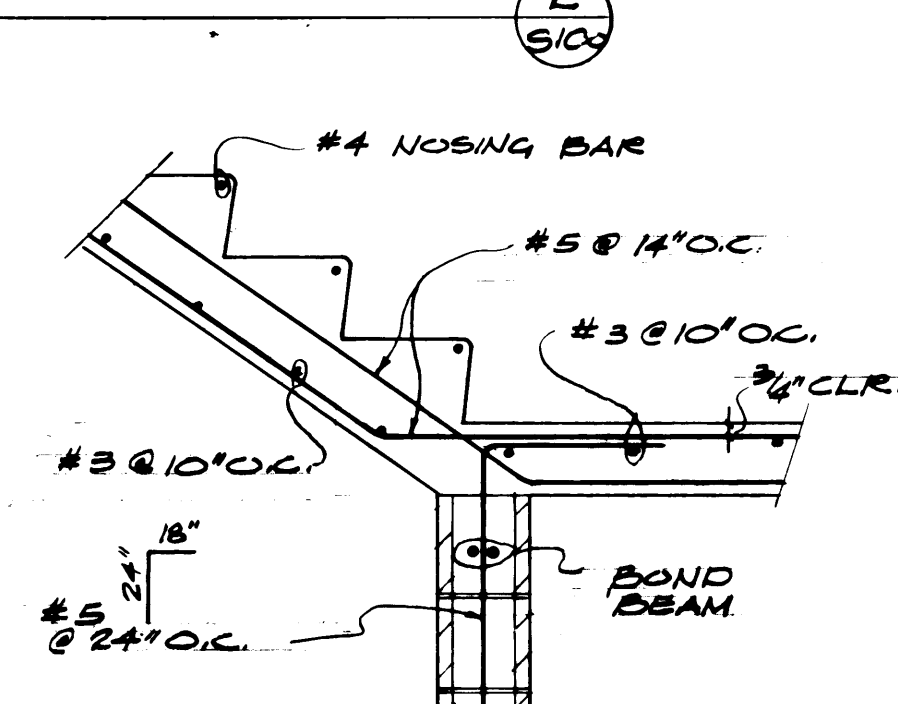


SECTION

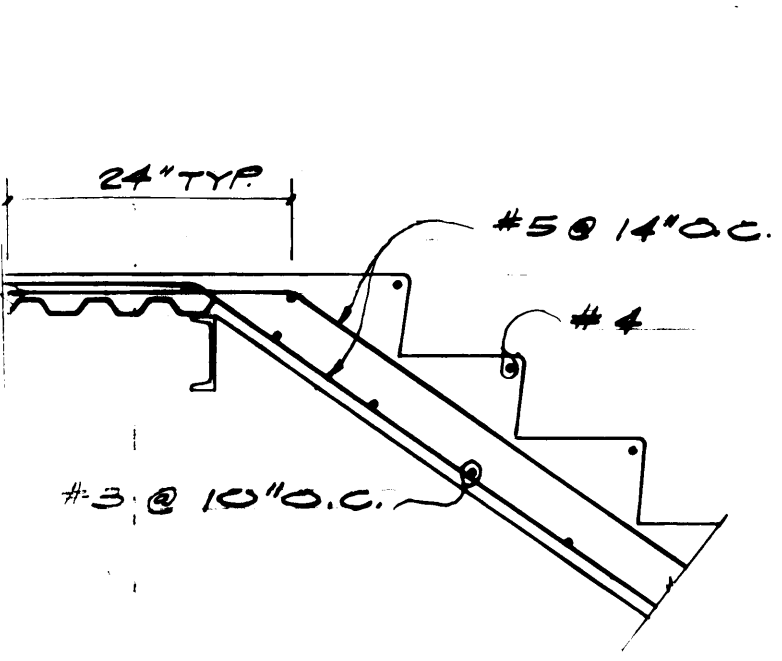


SECTION

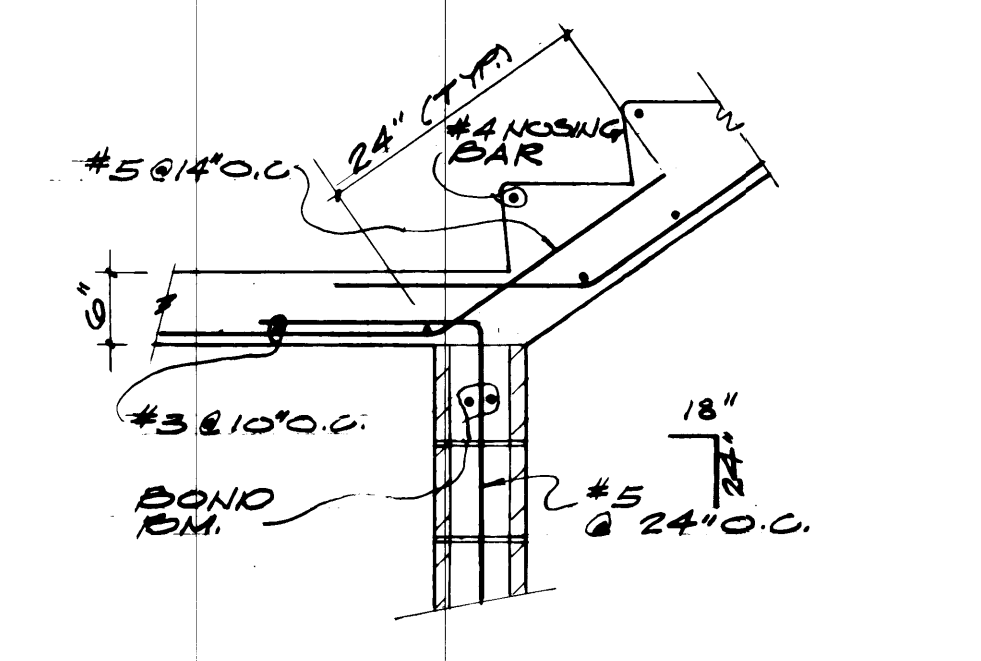


SECTION

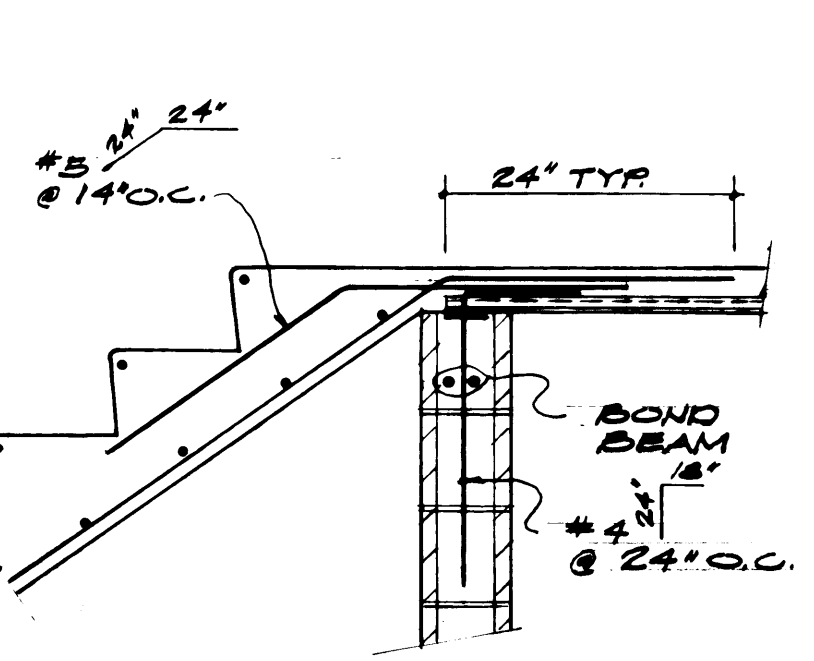


SECTION

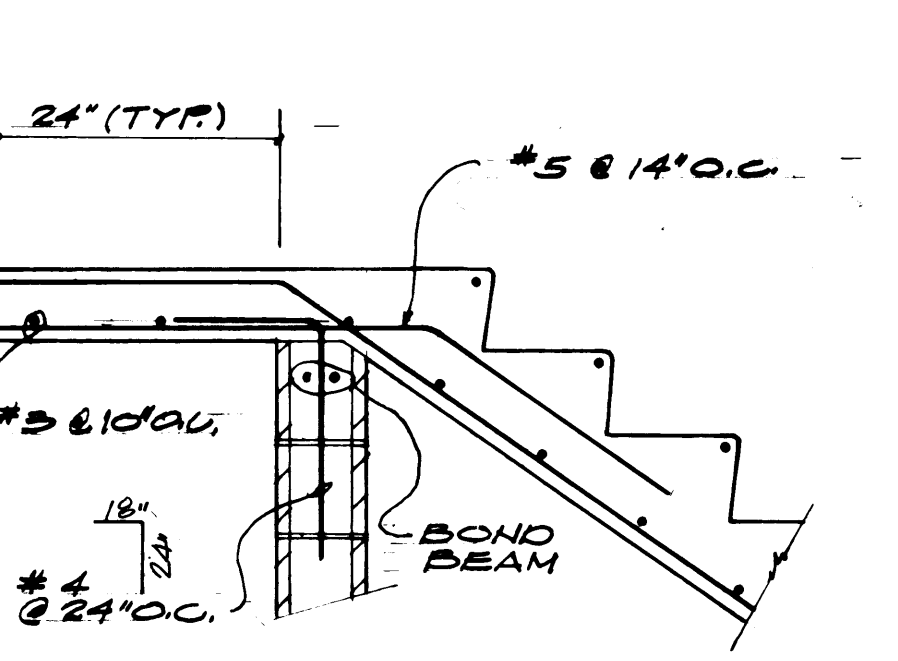


SECTION

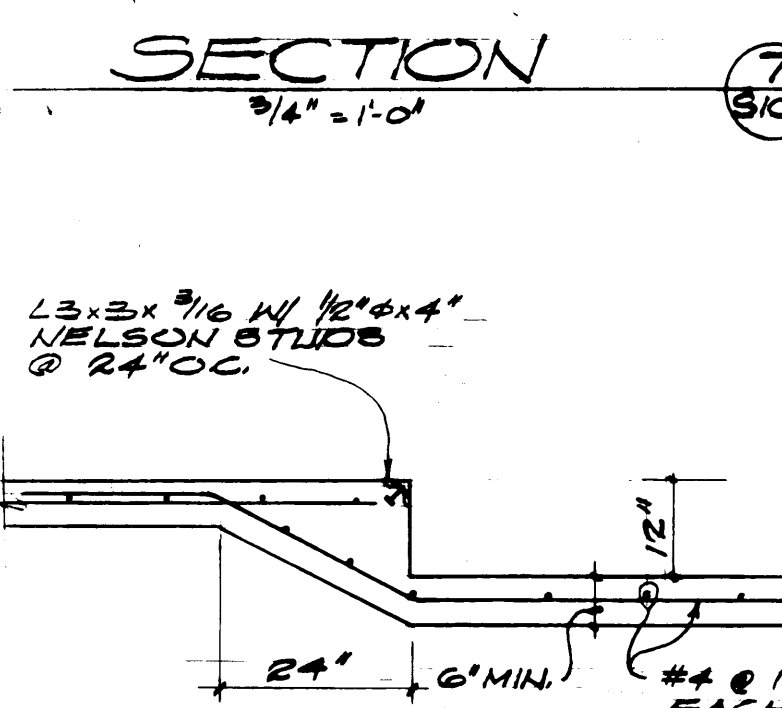


SECTION

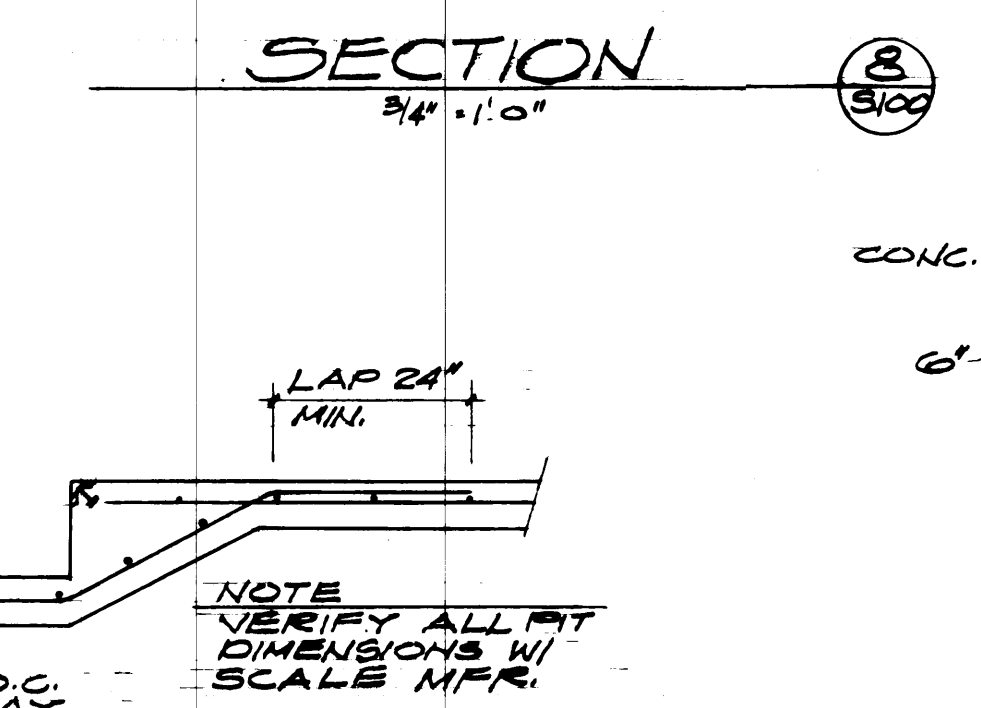

SECTION

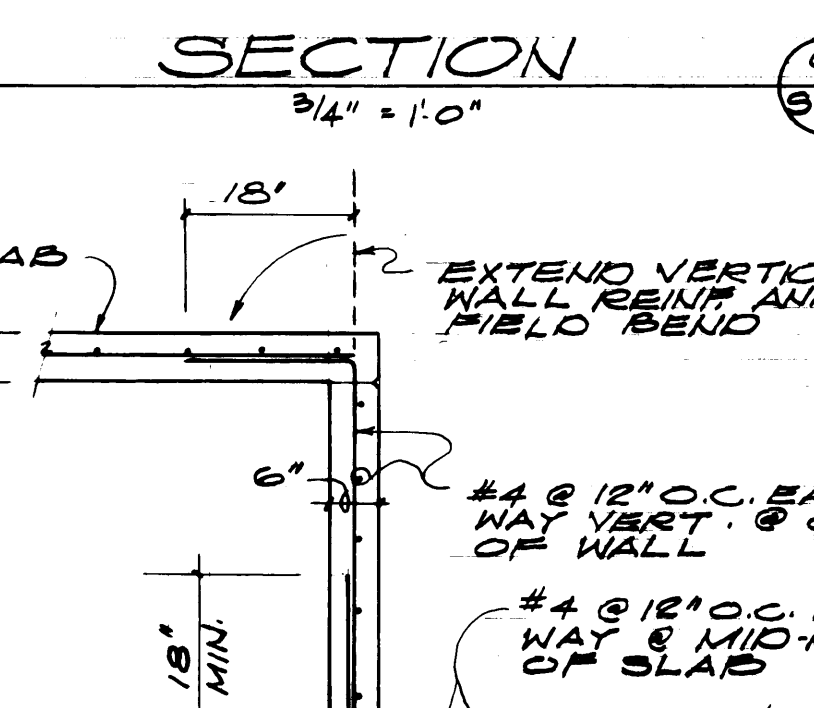

SECTION

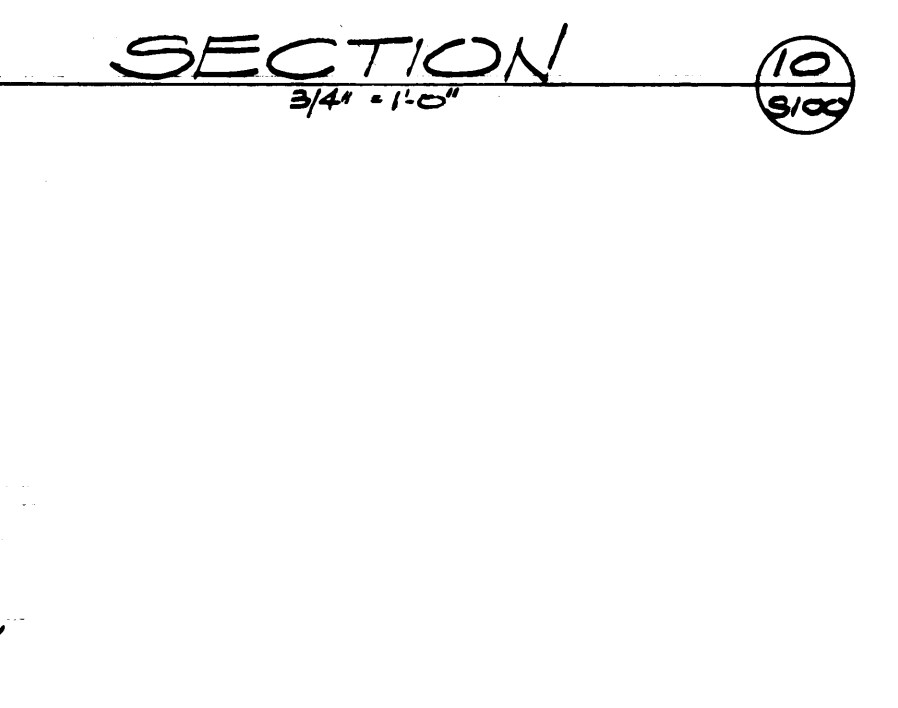

SECTION

DRAWN N.N.
DATE 3-22-84
CHECKED D.S.
DATE 3-22-84
CHECKED D.P.
DATE 3-22-84
CONT. NO. 557


PORT OF TACOMA
TACOMA TERMINALS, INC.
C.F.S. BUILDING
GENERAL NOTES 4
STAIR DETAILS

FIELD BOOK (S)
APPROVED [Signature] 3/30/84
DATE 3/30/84
SCALE
DRAWING NO. EP 3679-23-5100
SHEET 16 OF 71



Gregory Industries, Inc.
Structural Engineers
21 University Blvd 201
Tacoma, WA 98401
(206) 255-4118
280 So. Pioneer Blvd 201
Tacoma, WA 98402
(206) 255-8767

MARK	REVISION	BY	APP.	DATE
	REVISED TO AS-BUILT	R.J.S.		5/31/84

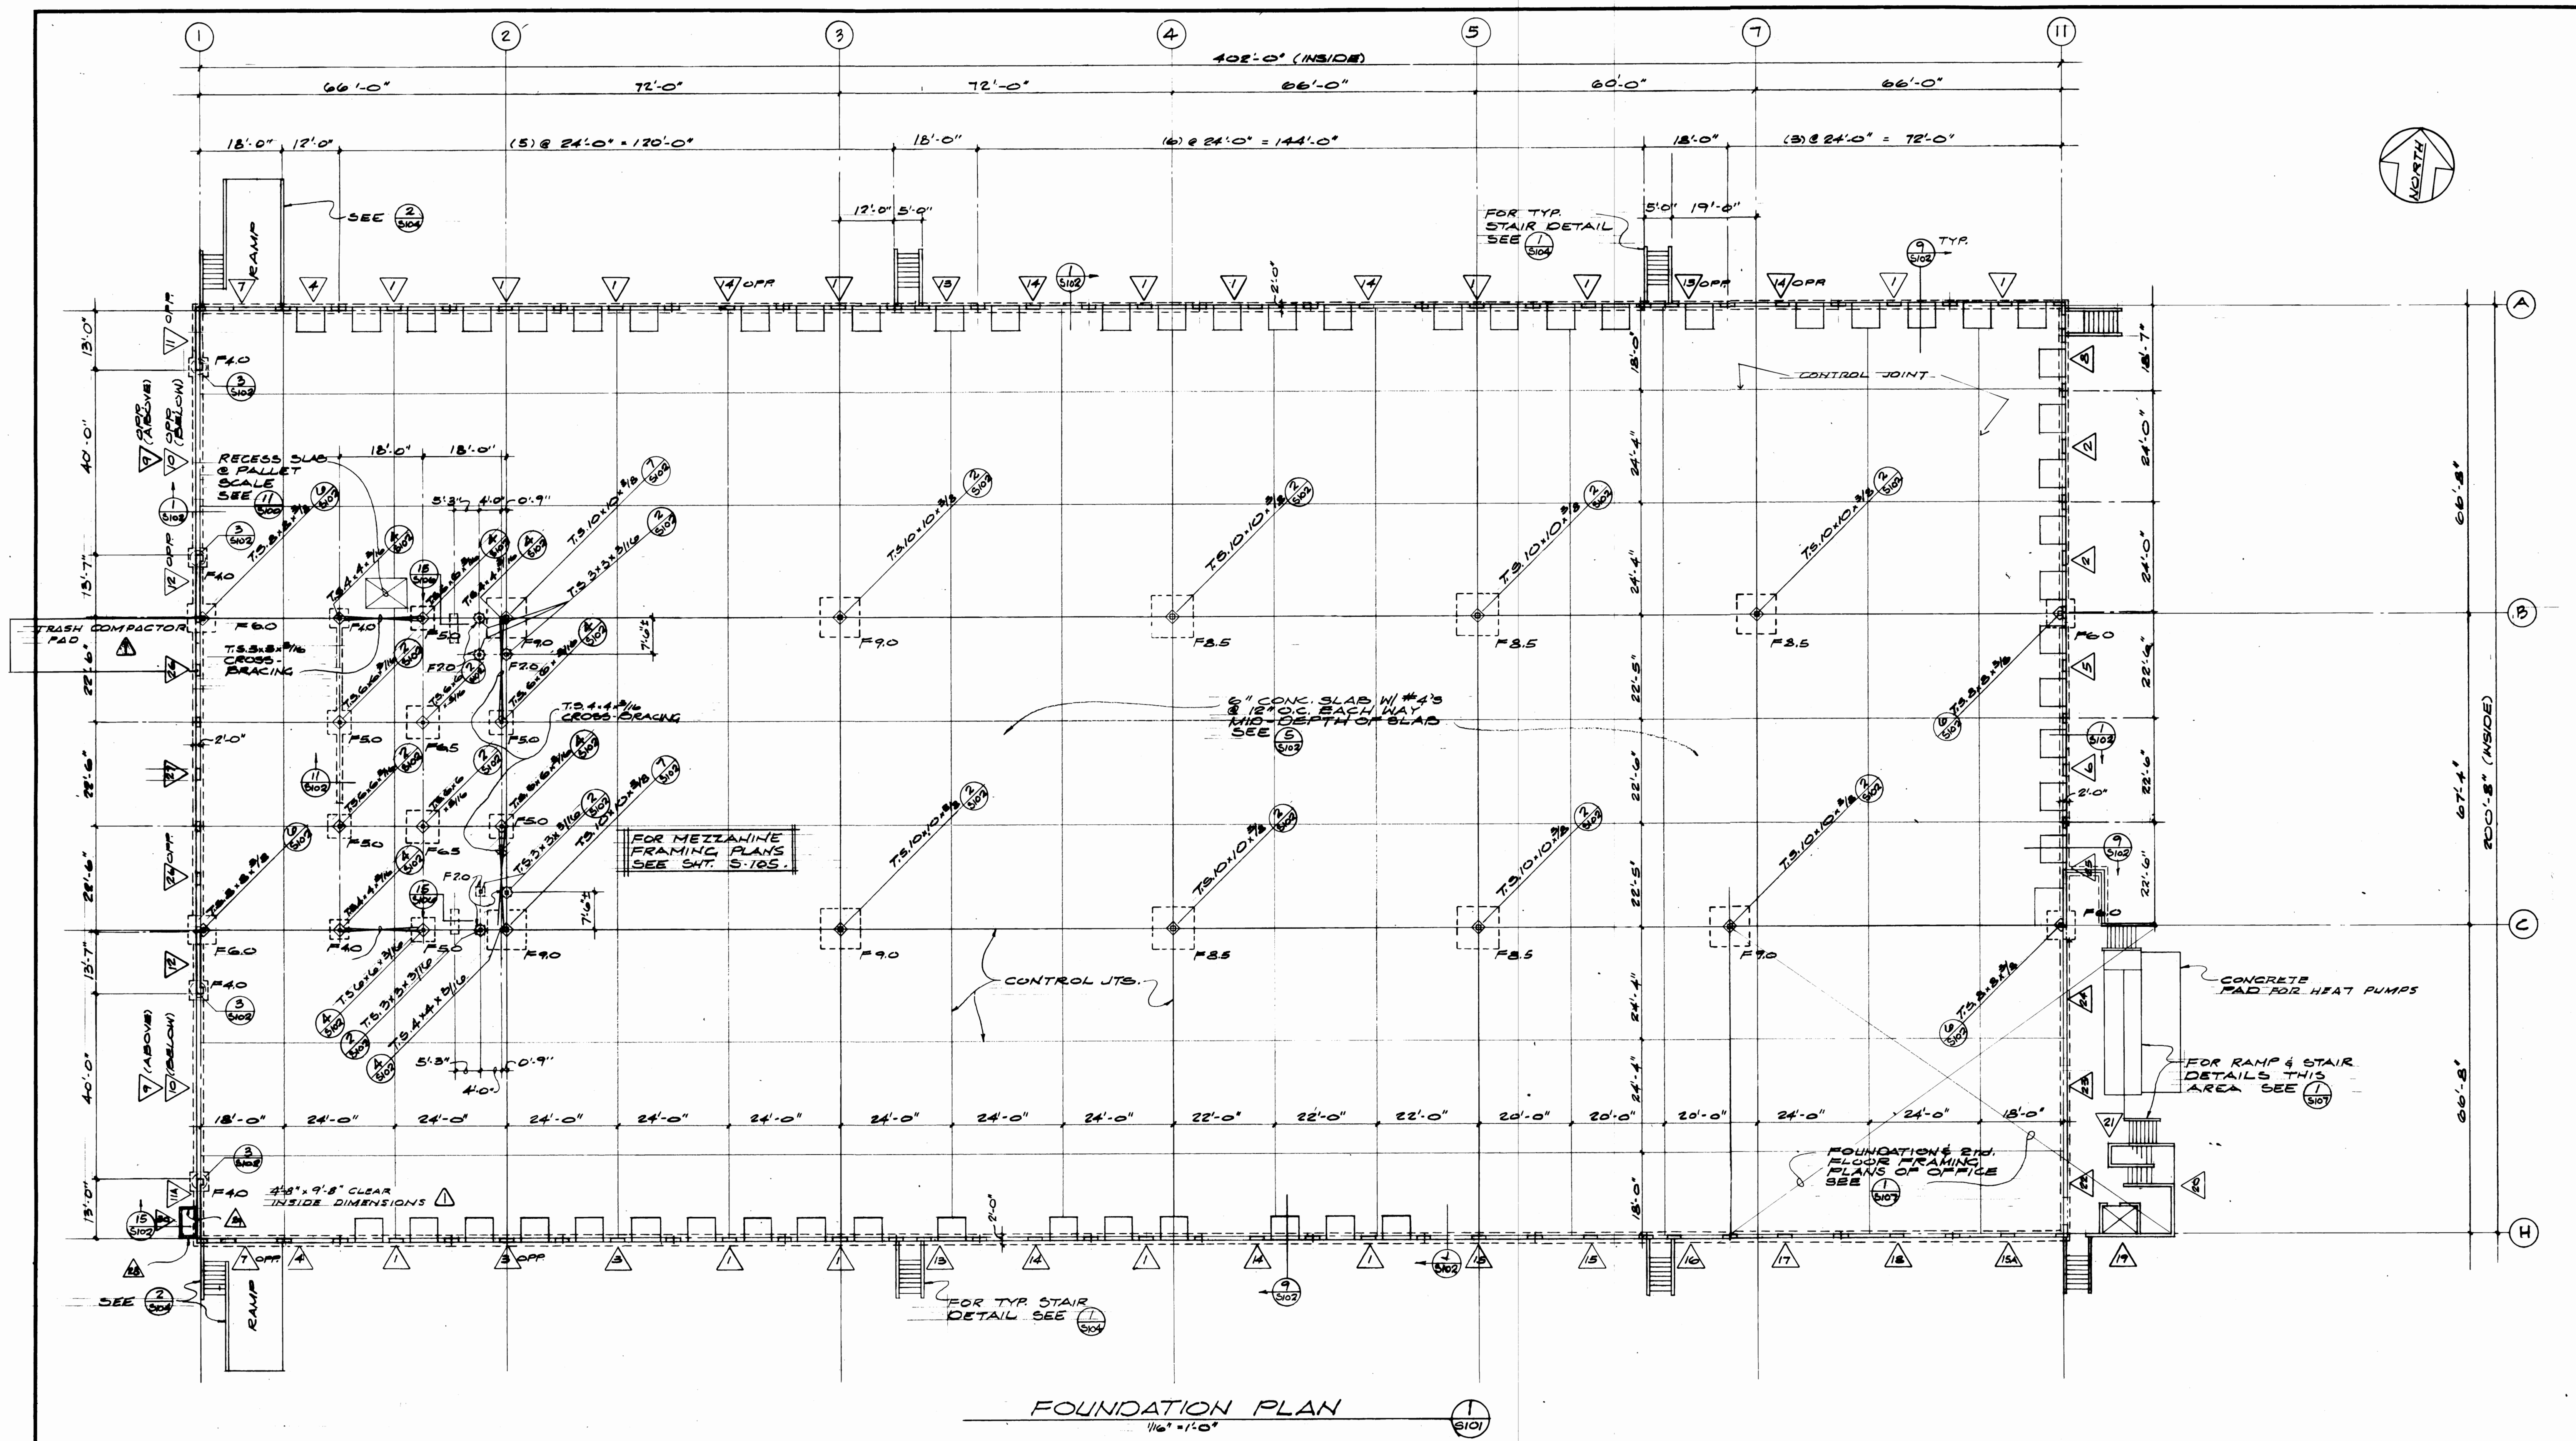


FOUNDATION PLAN
1/16" = 1'-0"

SLAB AND FOUNDATION NOTES

- △ Indicates wall panel types. See Sheets S112 through S115 for panel elevations and details.
- ▬▬▬ Denotes precast concrete wall panel over continuous concrete footing, see 1/S102.
- "F-___" Denotes size of spread footing in feet. For details and reinforcing see 8/S102.
- ▬▬▬ Denotes CMU wall over continuous concrete footing, see 12/S102.
- For details of pipes through concrete footings see 13/S102.
- For details of exterior ramps and stairs see Sheet S104.
















- EXTERIOR CONCRETE PADS FOR HEAT PUMPS AND TRASH COMPACTOR SHALL BE 6" THICK WITH #4'S AT 12" O.C. EACH WAY AT MID-DEPTH OF SLAB.
- DISTANCE FROM EXTERIOR WALL TO FIRST CONSTRUCTION JOINT SHALL BE 18'-0" MINIMUM.

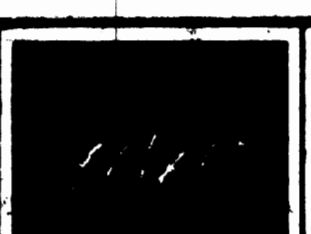

S. J. & S. J. ENGINEERS, INC.
Consulting Engineers
81 University, Suite 301
Tacoma, WA 98401
(206) 255-4116
680 So. Puget, Suite 301
Tacoma, WA 98408
(206) 255-9707

REVISION	BY	APP.	DATE
REVISED TO AS-BUILT	A.J.S.	S.J.	3/30/84

DRAWN H.H. DATE 3-22-84		PORT OF TACOMA TACOMA TERMINALS, INC. C.F.S. BUILDING FOUNDATION PLAN
CHECKED D.B. DATE 3-22-84		
CHECKED D.P. DATE 3-22-84		
CONT. NO. 557		
APPROVED <i>[Signature]</i> 3/30/84		SCALE DRAWING NO. EP 3577-23-501
DATE 3/30/84		SHEET 17 OF 71

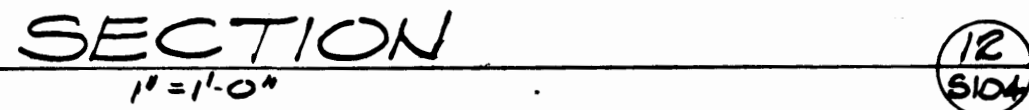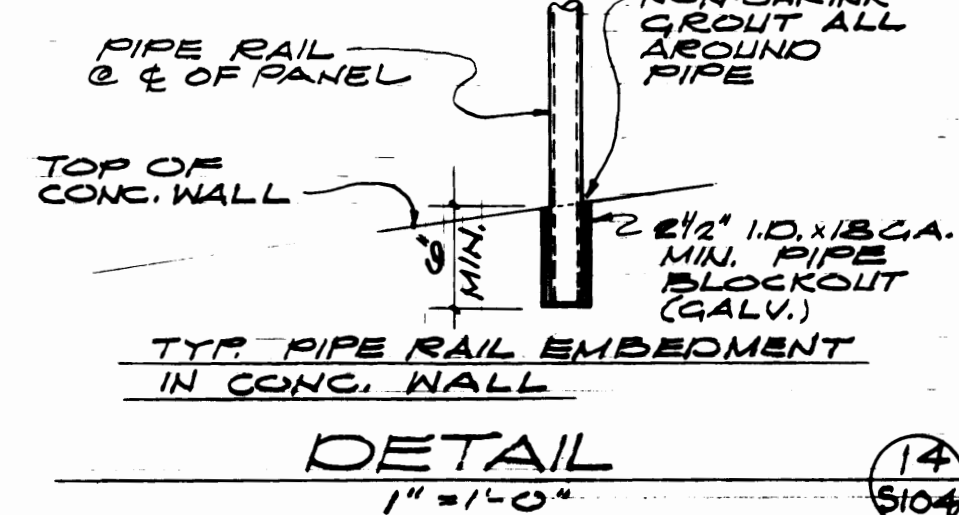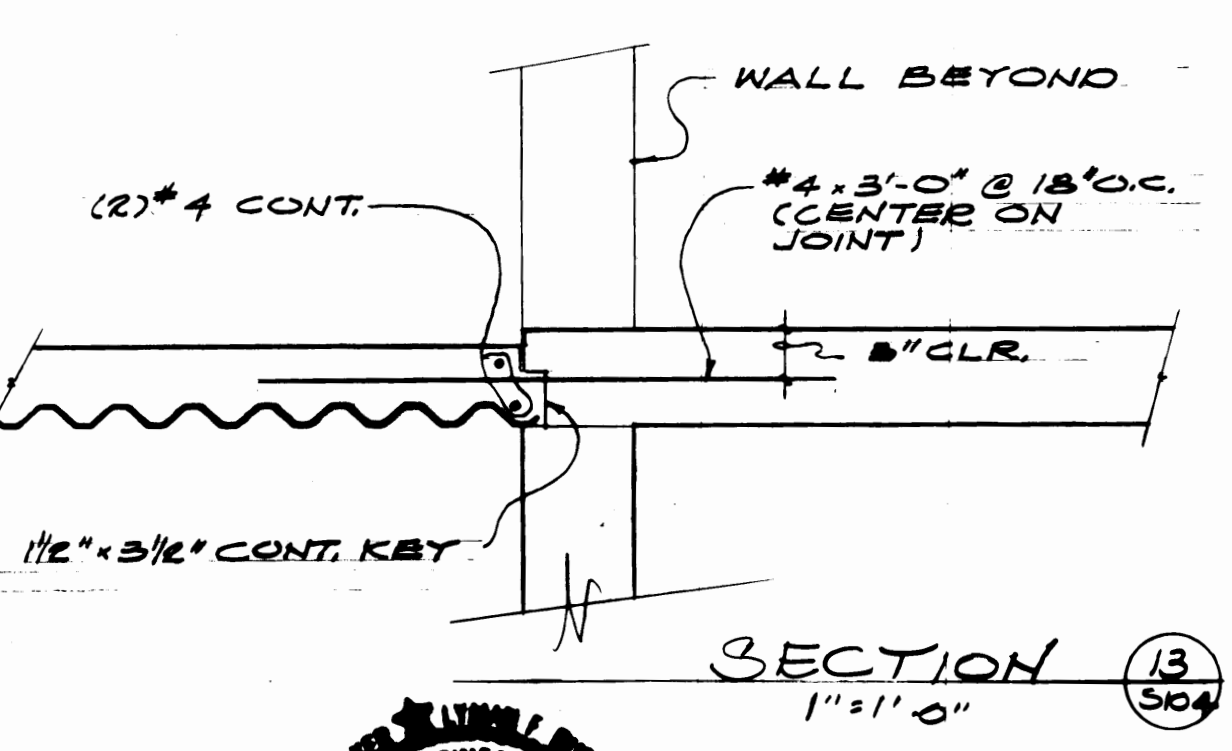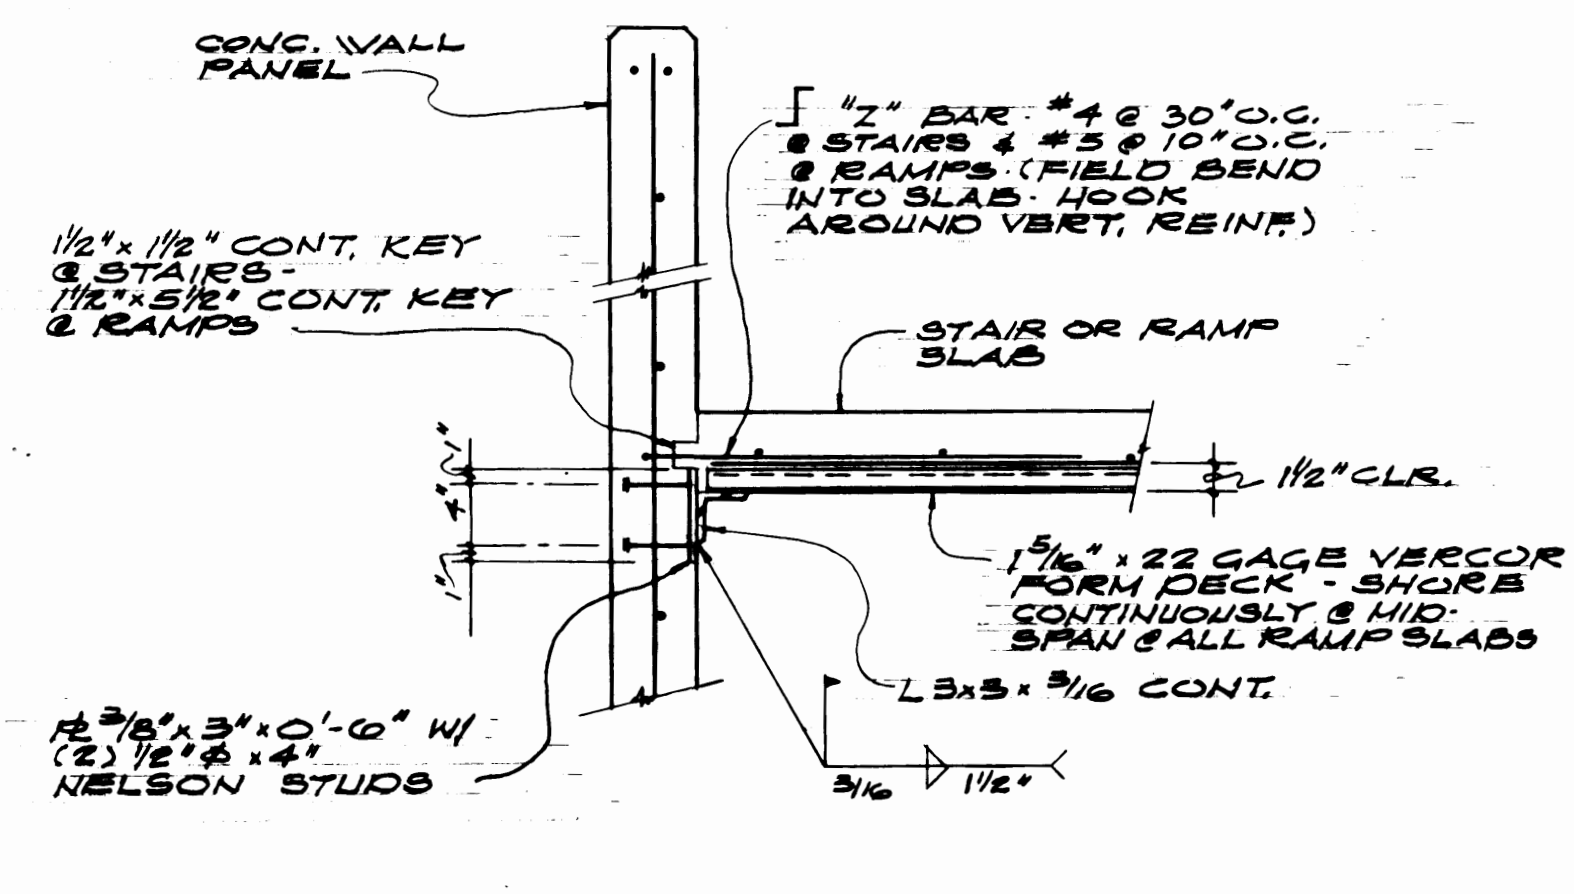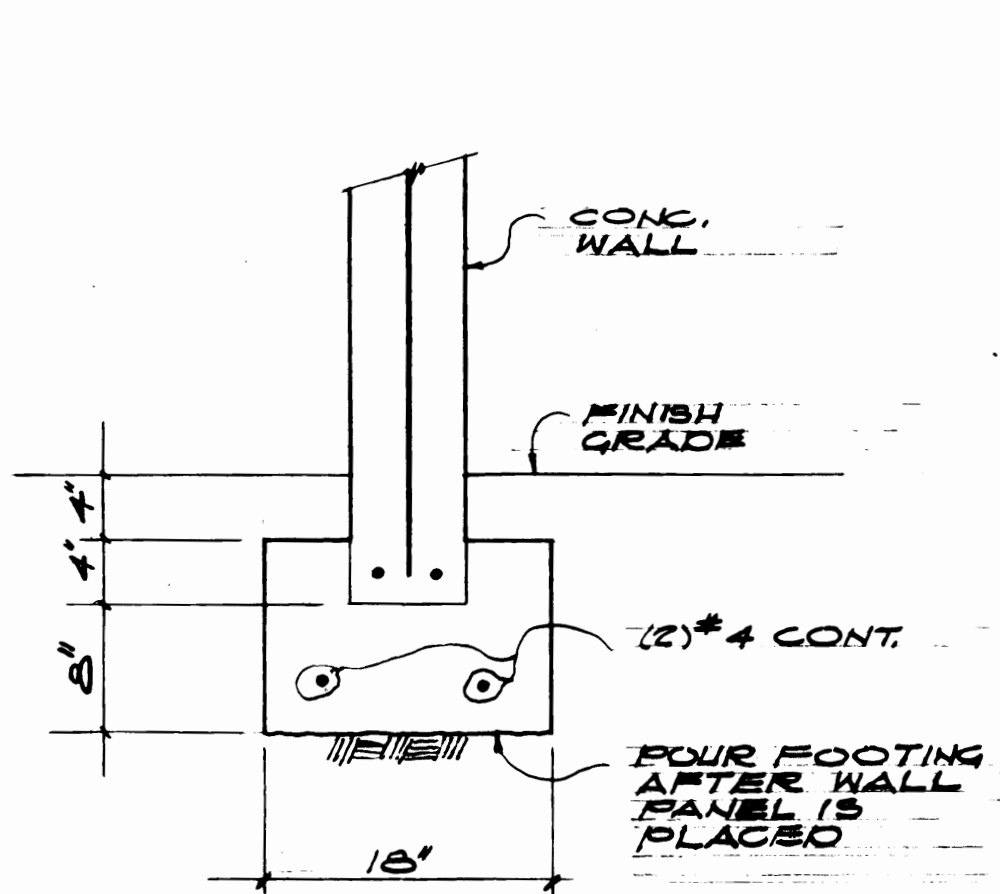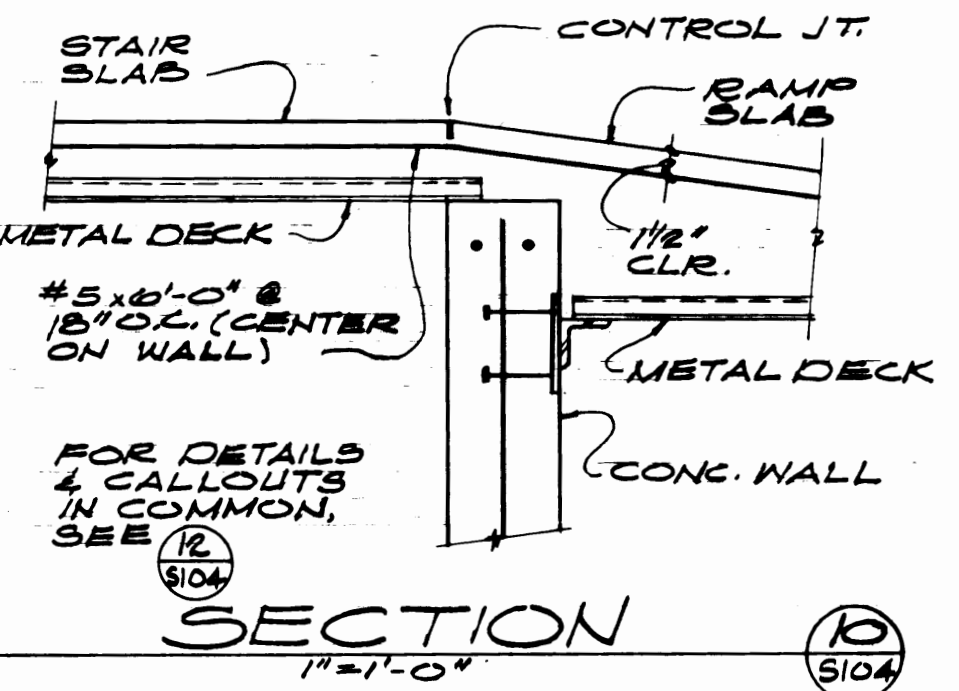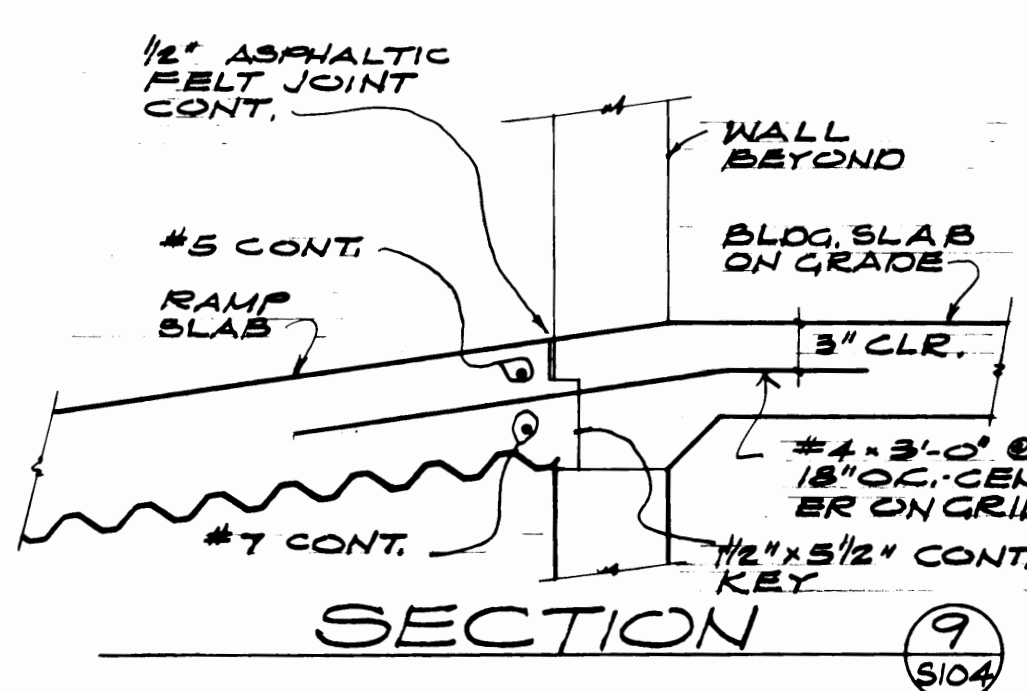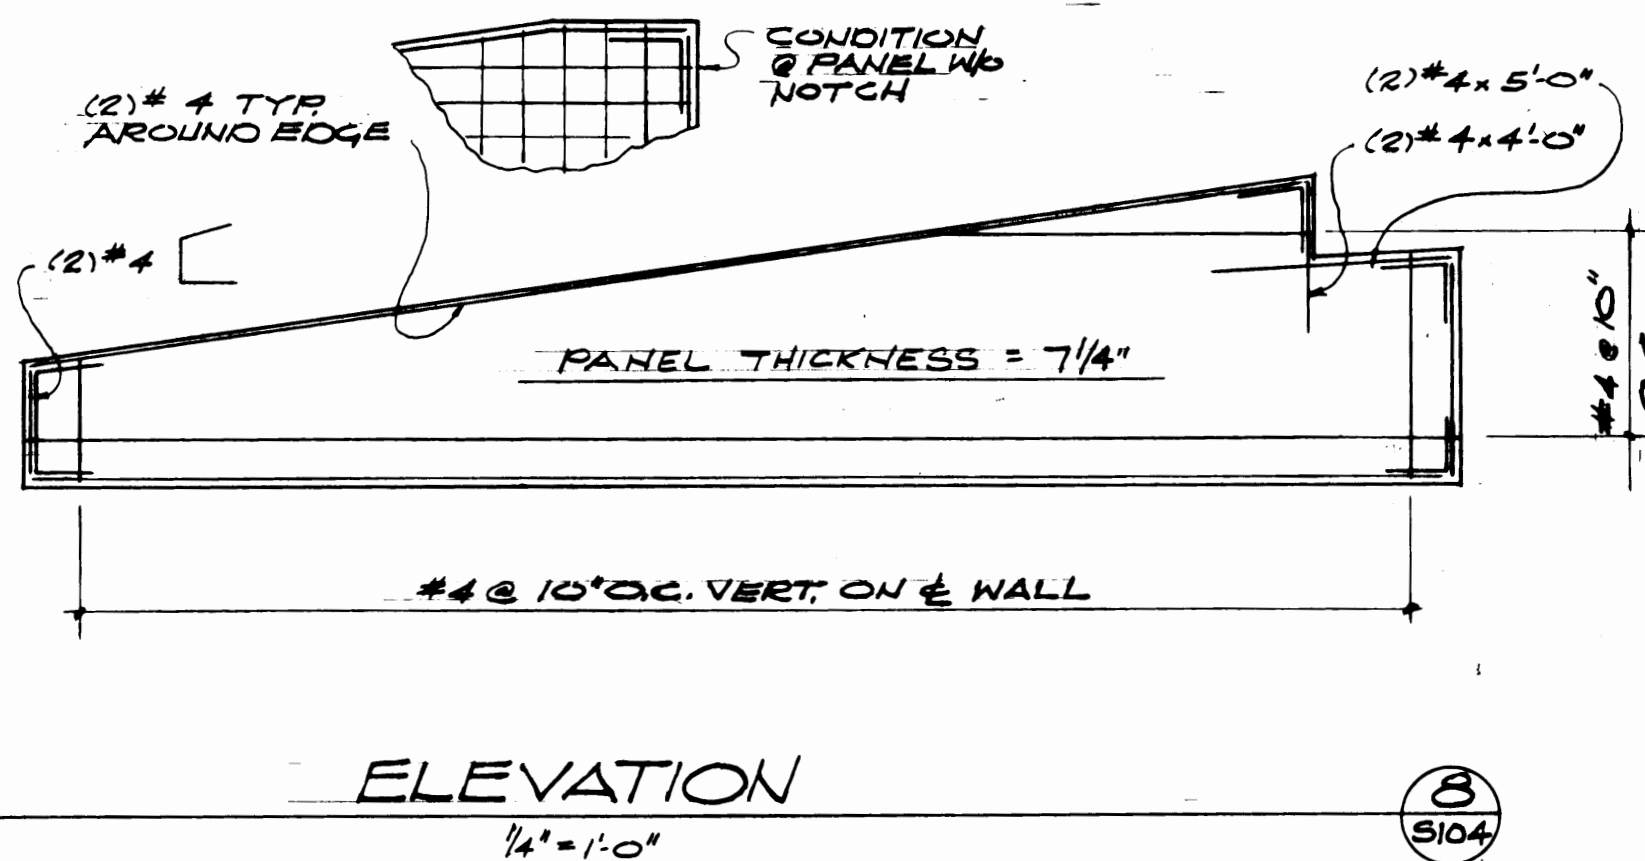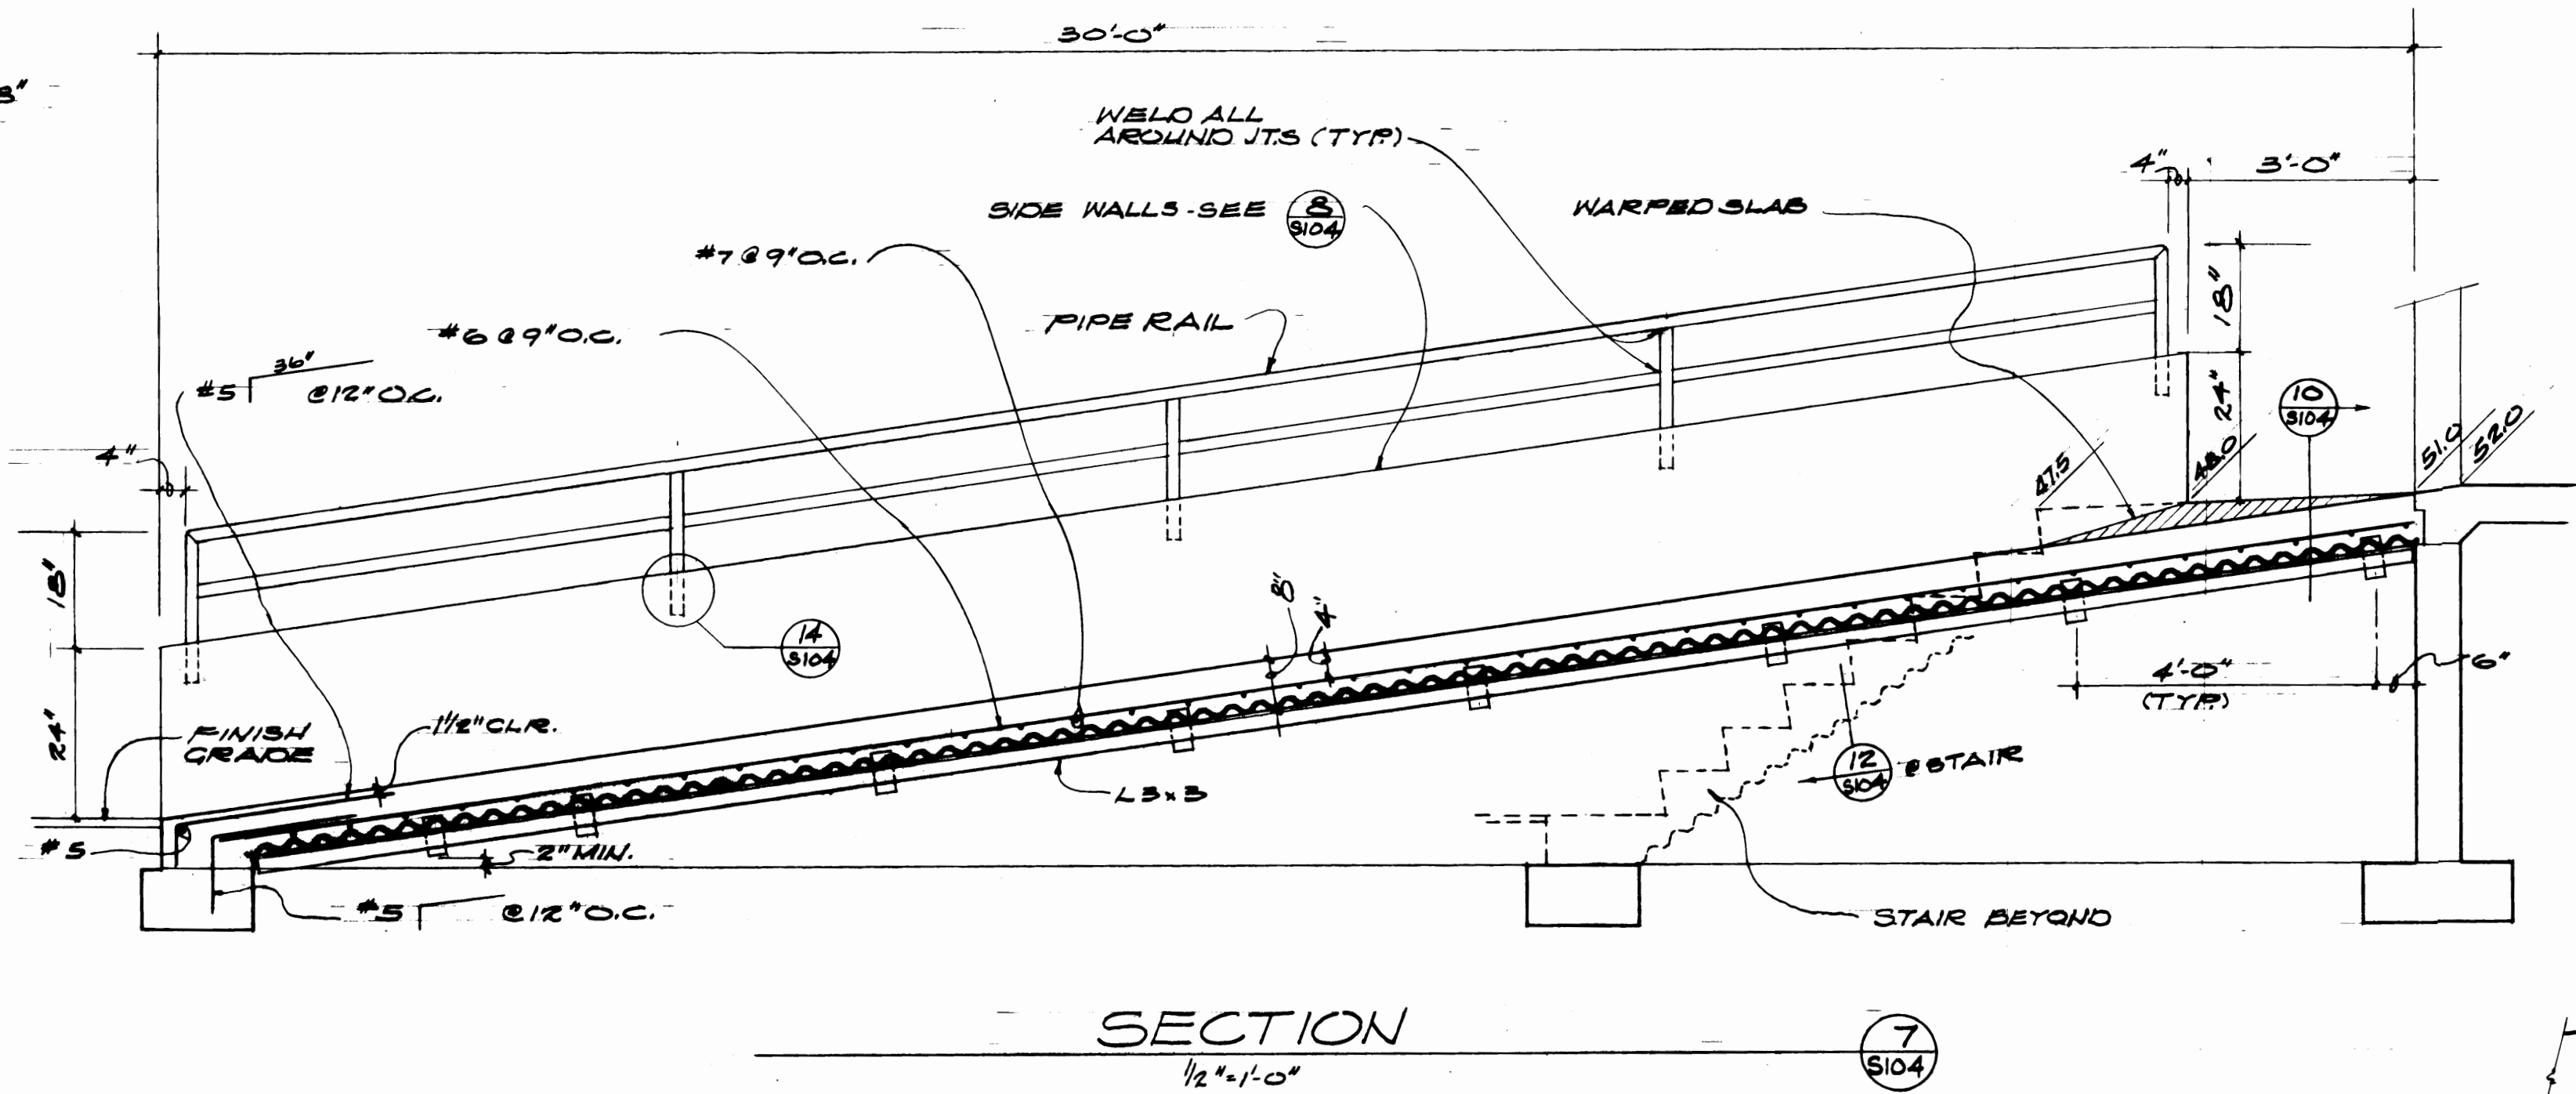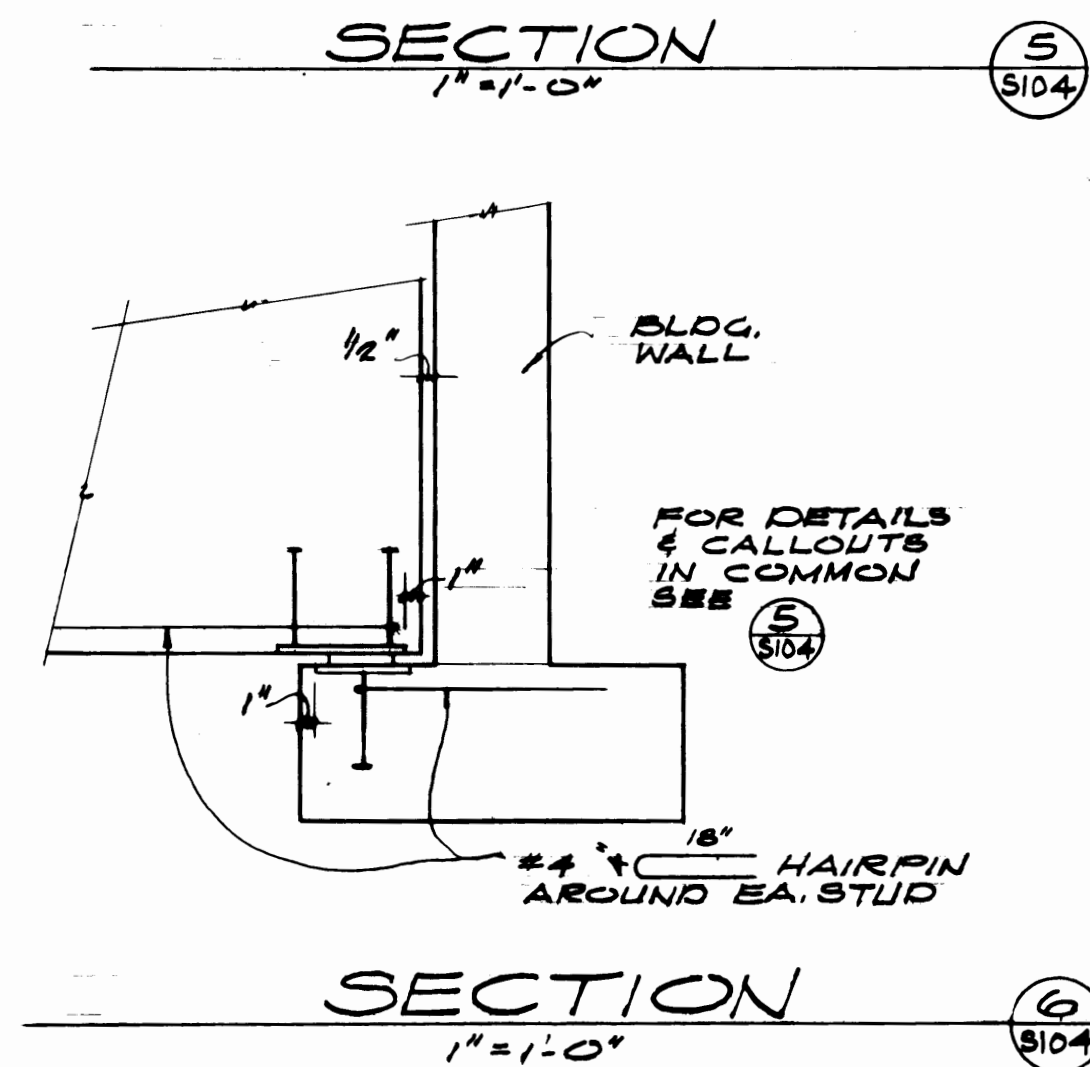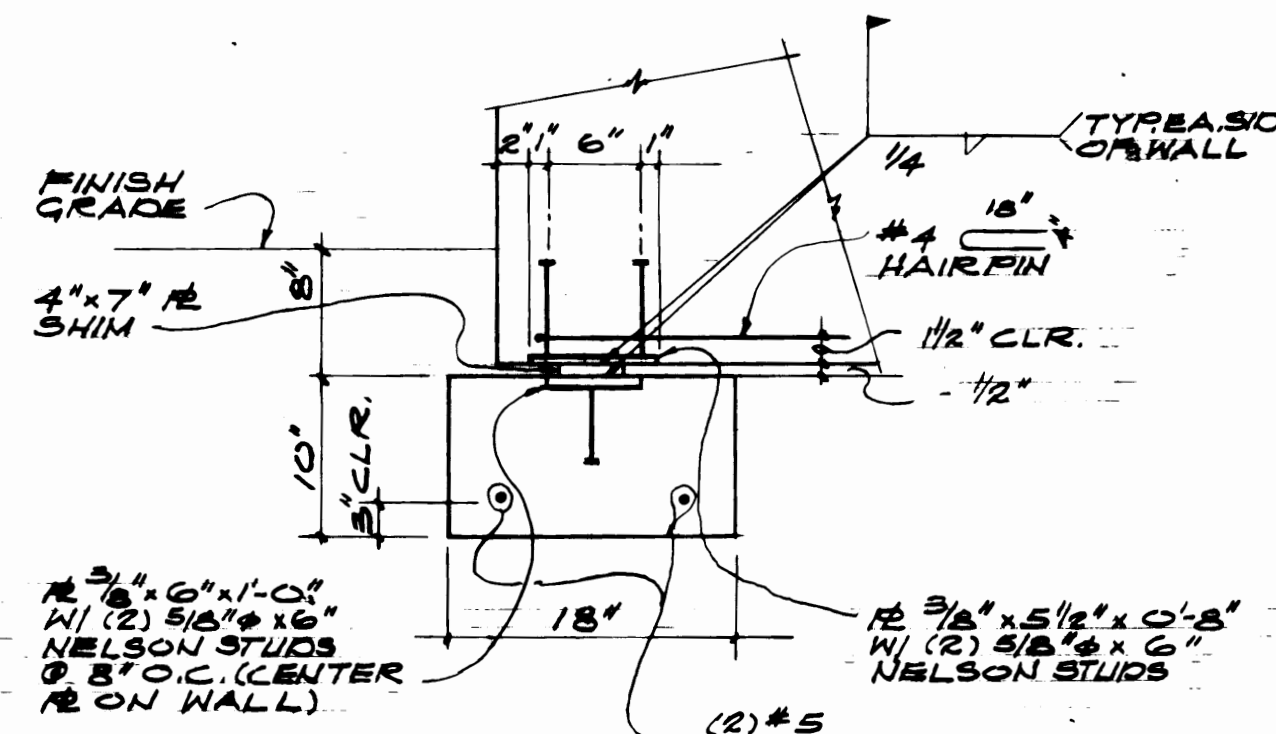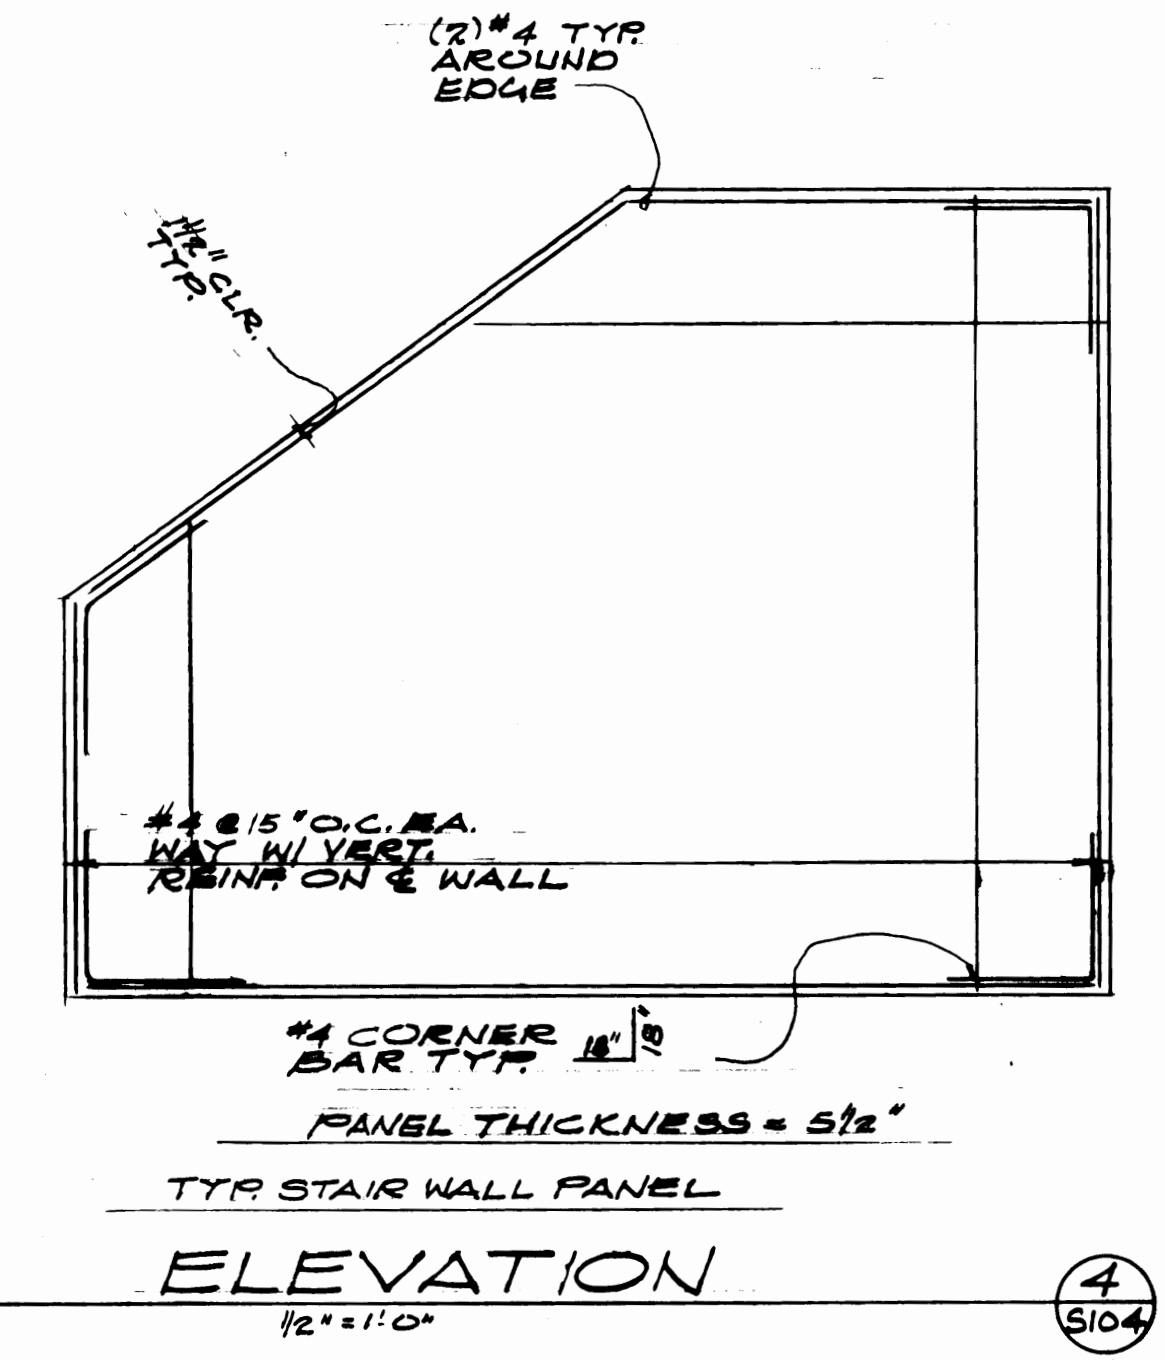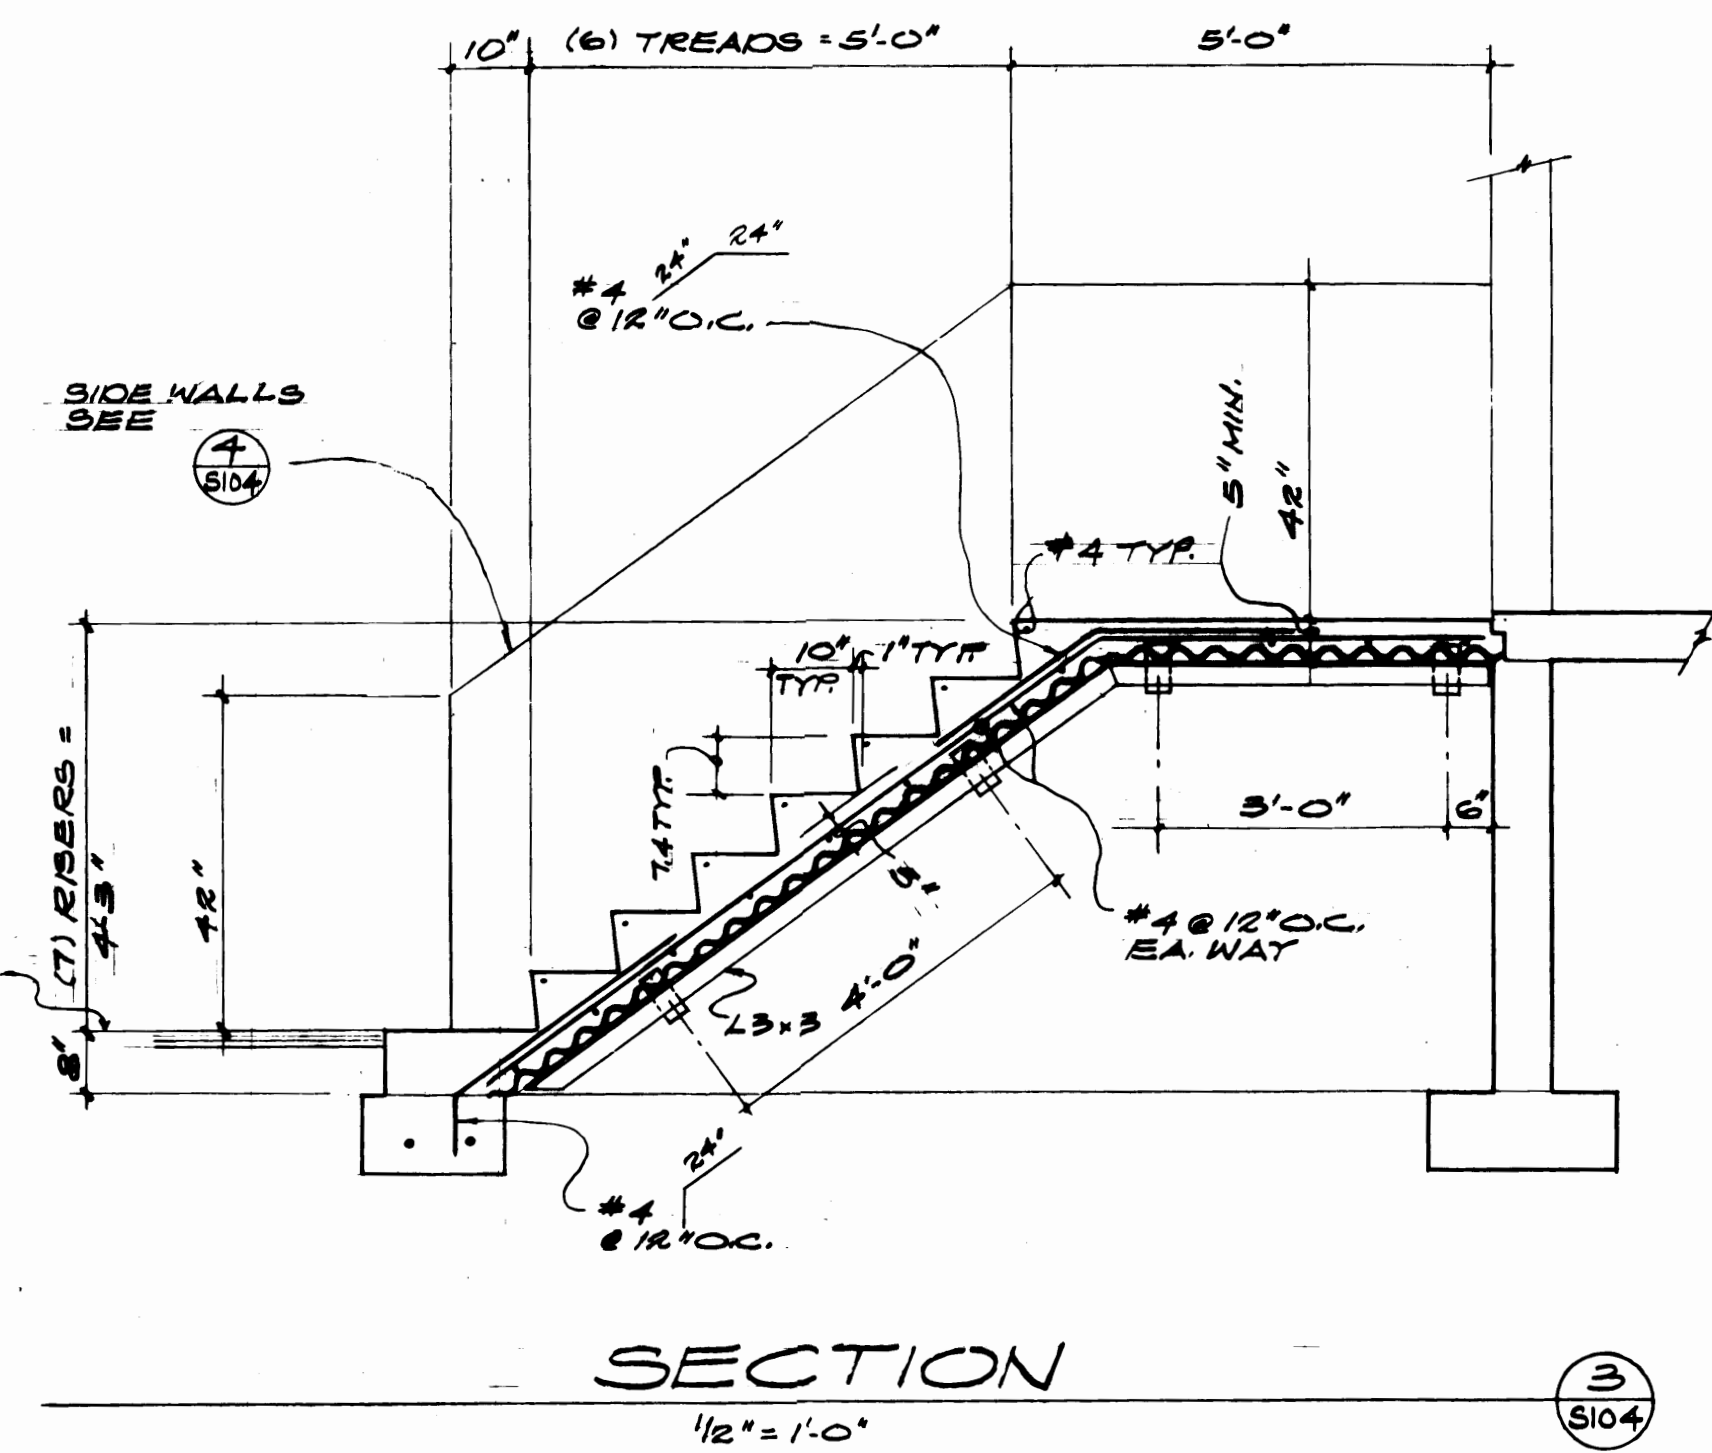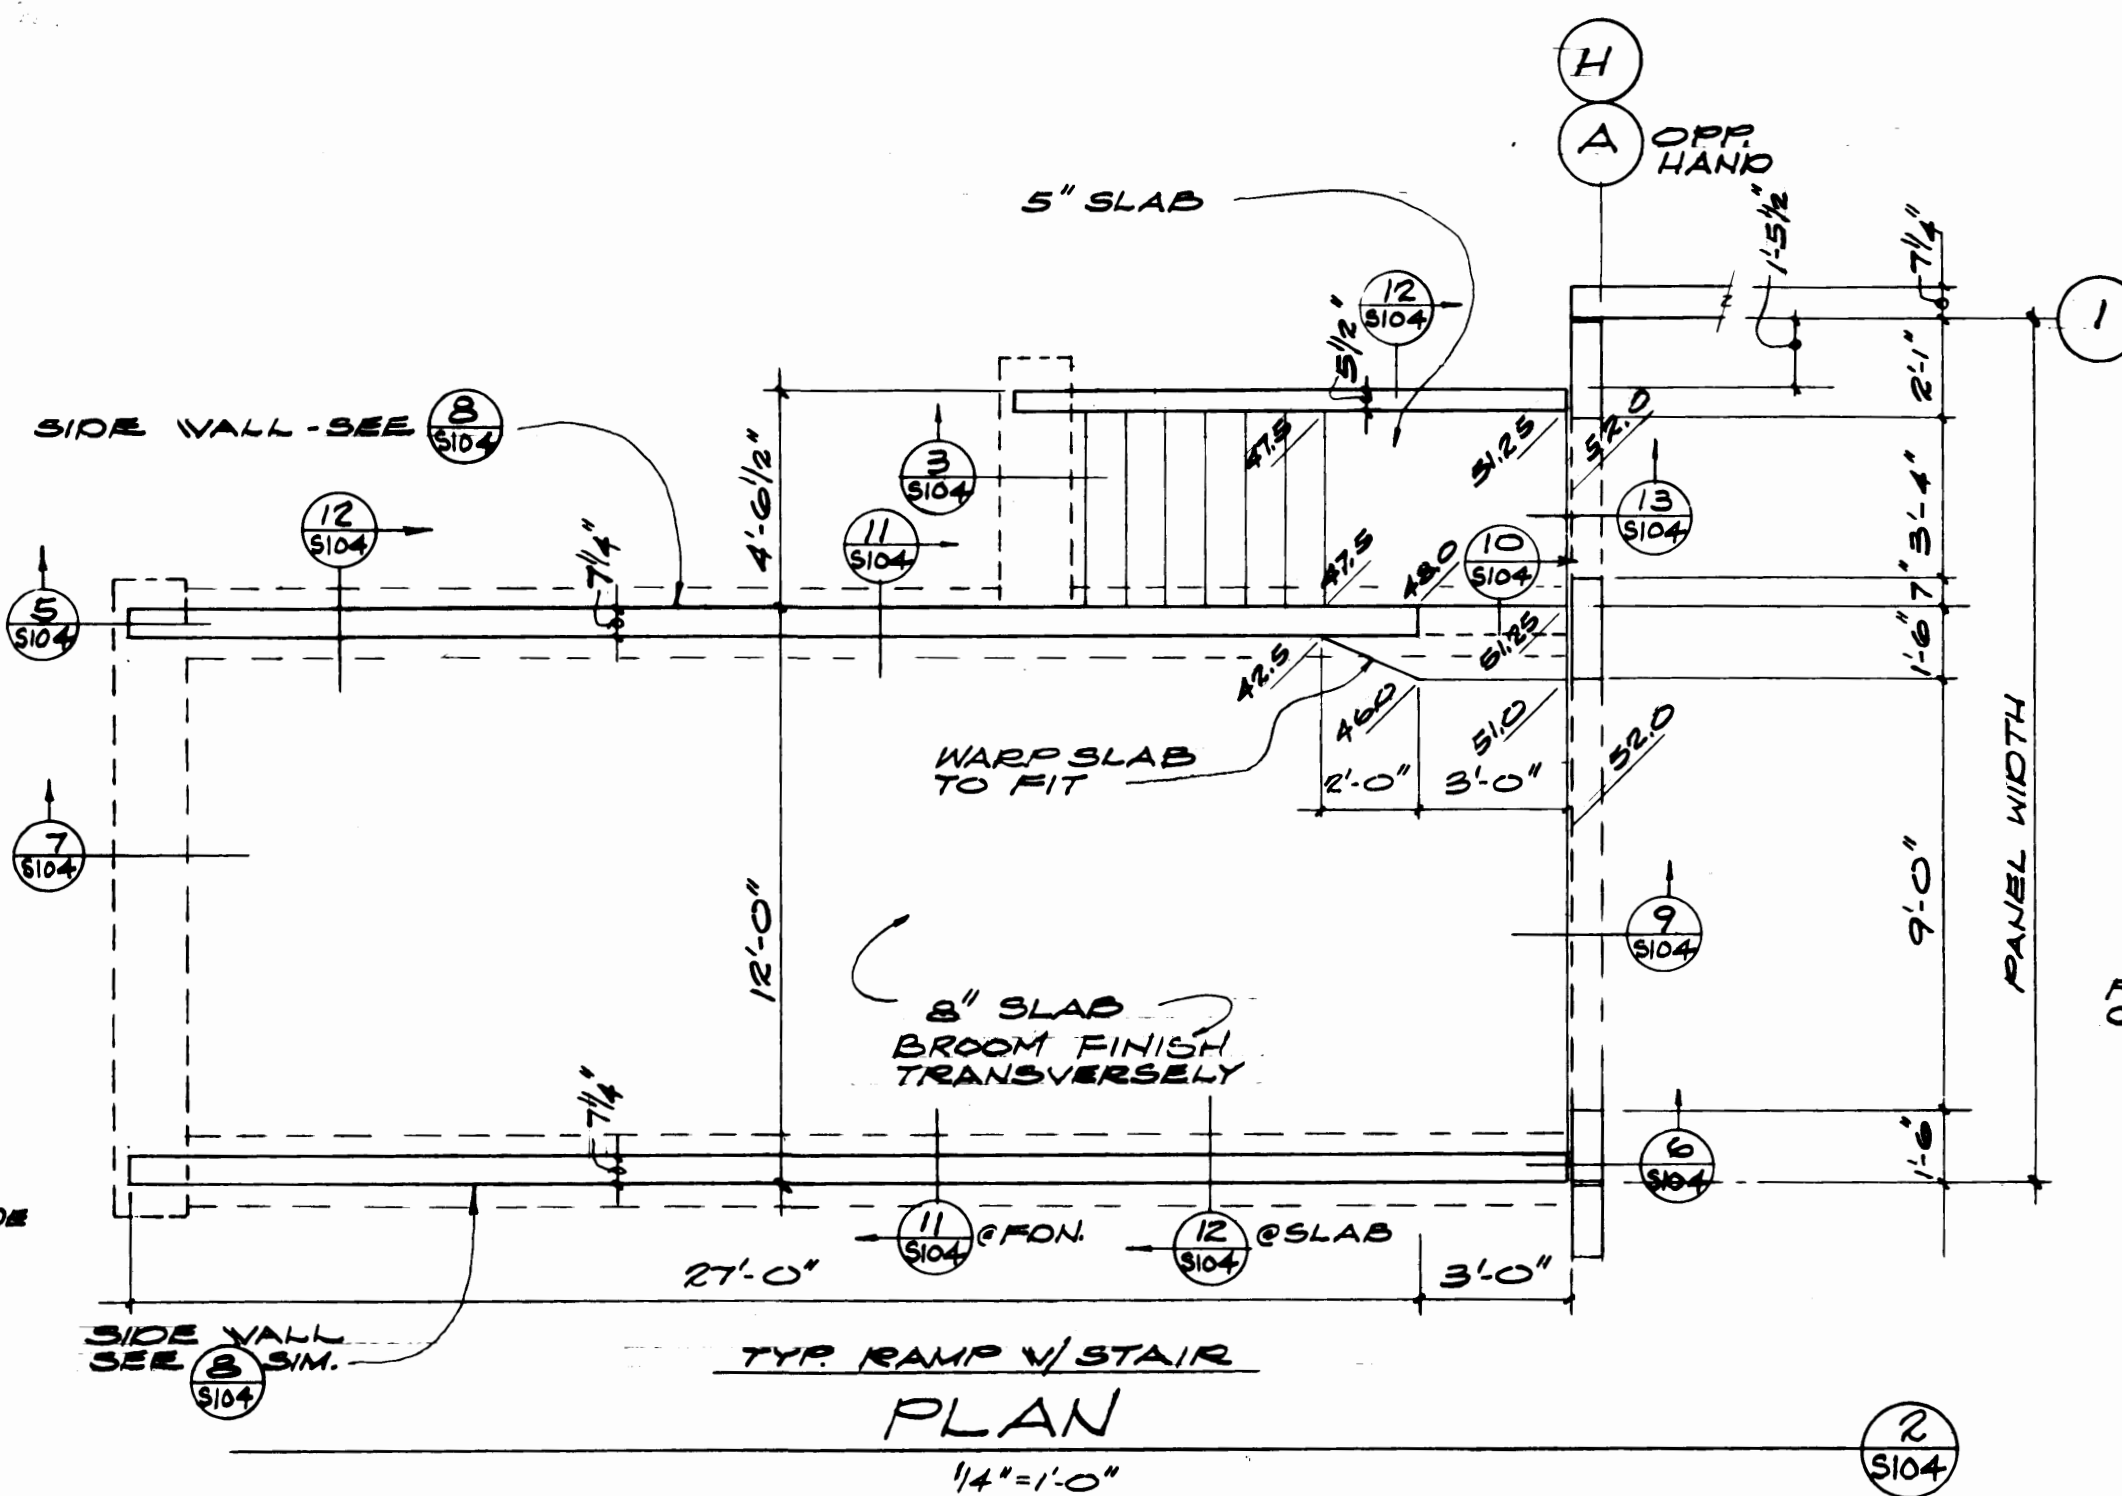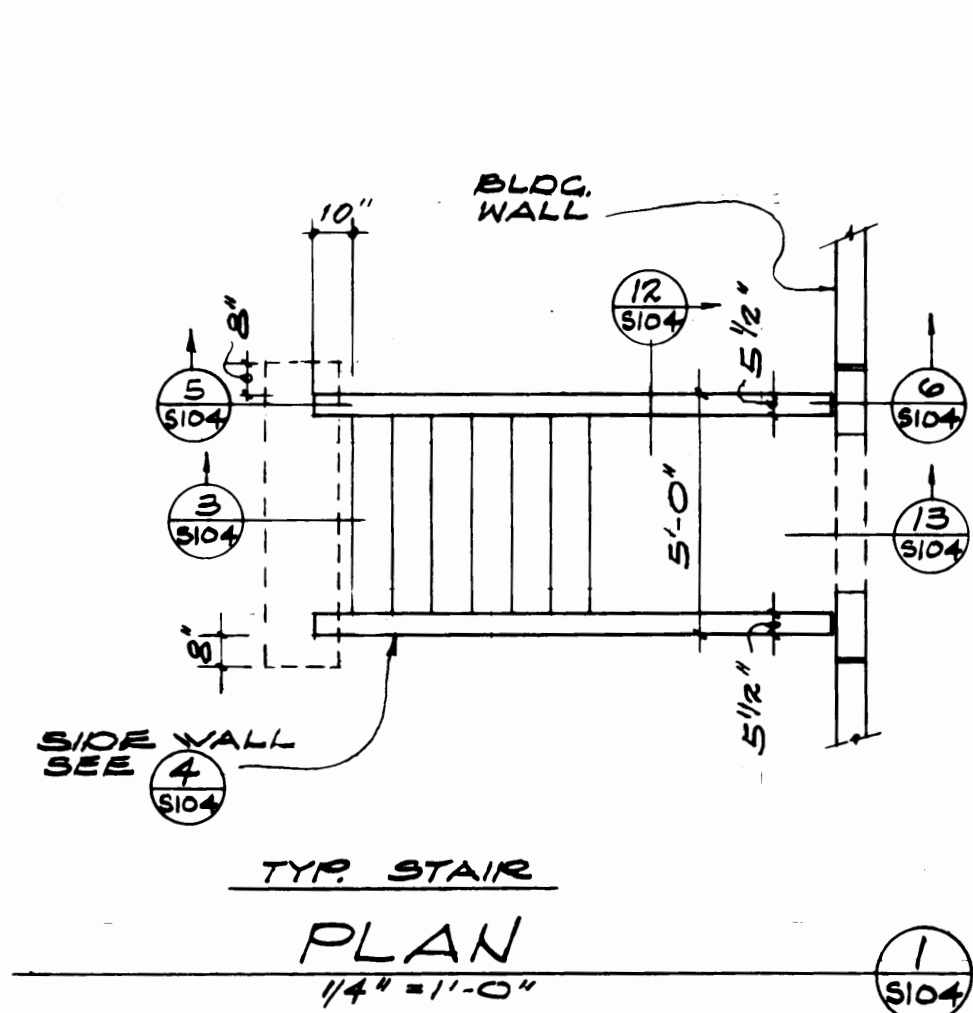

Shelley Engineers, Inc.
Consulting Engineers
51 University, Suite 301
Boulder, VA 20101
(202) 522-4116
950 So. Forest, Suite 301
Tacoma, WA 98402
(206) 383-2787


MARK	REVISION	BY	APP.	DATE

DRAWN N.N.
DATE 3-22-84
CHECKED D.S.
DATE 3-22-84
CHECKED D.R.
DATE 3-22-84
CONT. NO. 227
FIELD BOOK (S)
APPROVED [Signature] 3/30/84
MANAGER [Signature] 3/30/84
CHIEF ENGINEER [Signature]






PORT OF TACOMA
TACOMA TERMINALS, INC.
C.F.S. BUILDING
STAIR & RAMP DETAILS

SCALE	DRAWING NO.
	EP 3879-23-3
SHEET	OF
30	71

J-5585


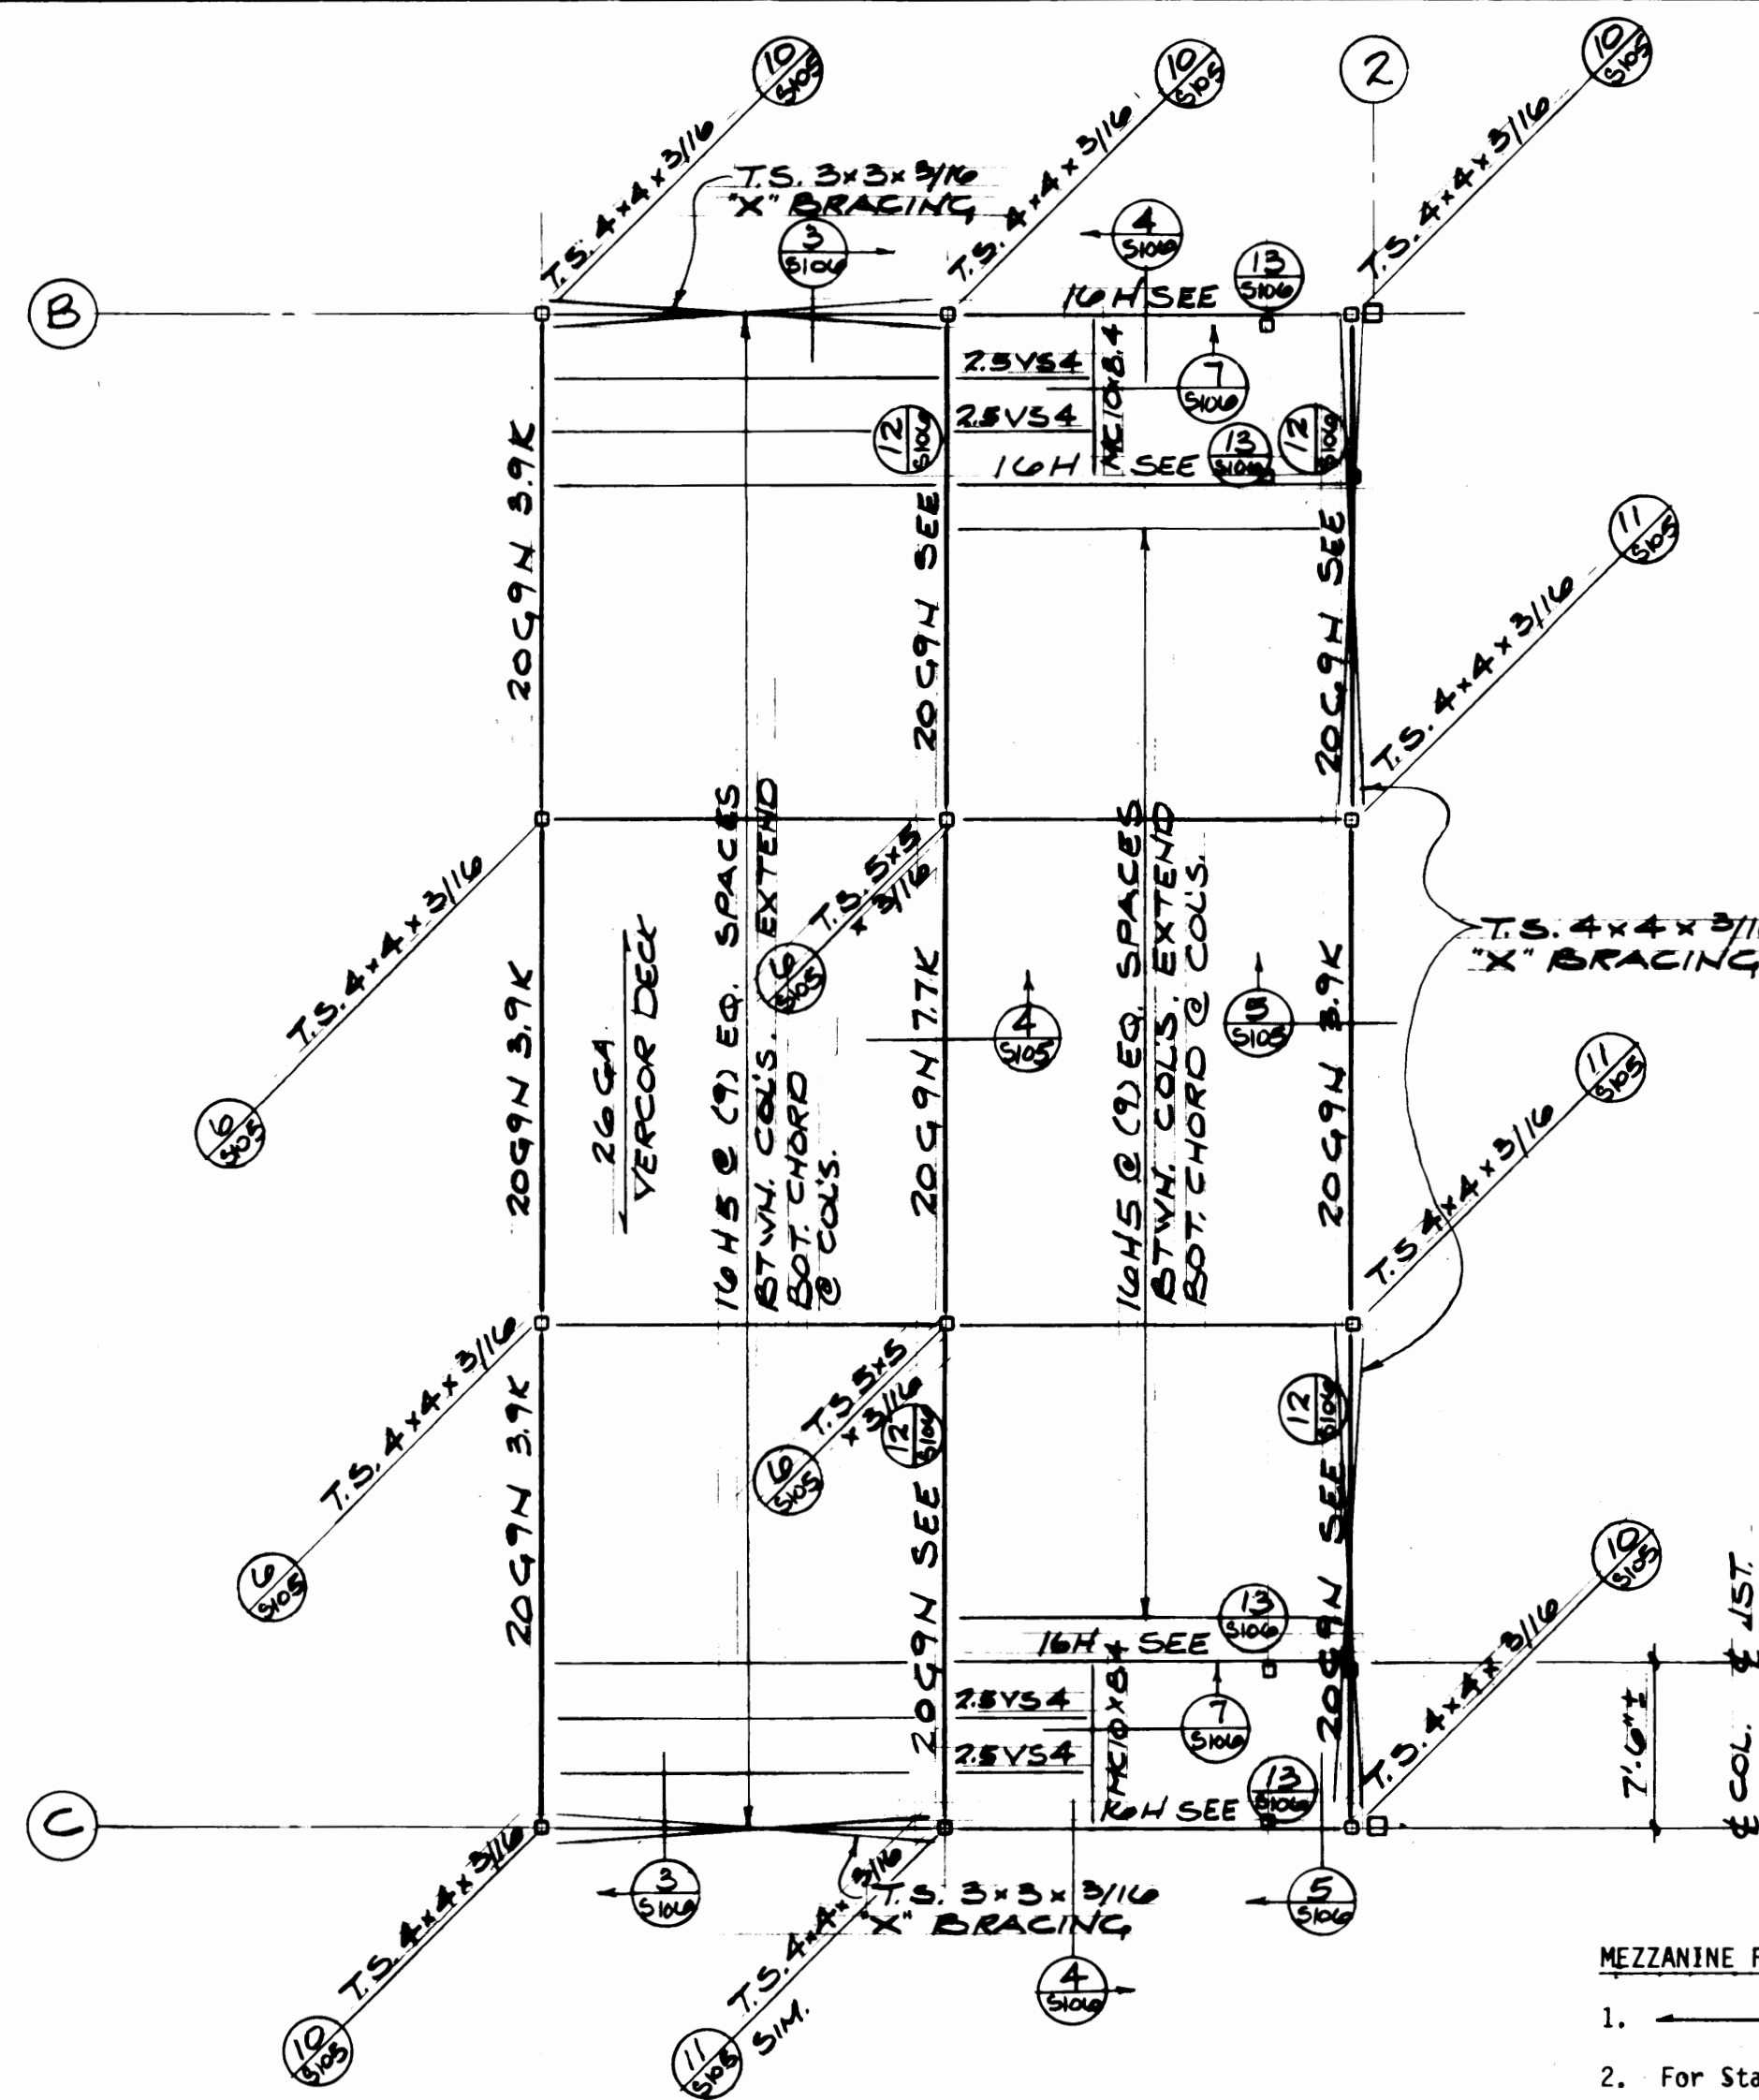


MEZZANINE FRAMING NOTES:
 1. ——— Indicates span of metal deck, see 8/S106.
 2. For Stairway Plan see 9/S106.

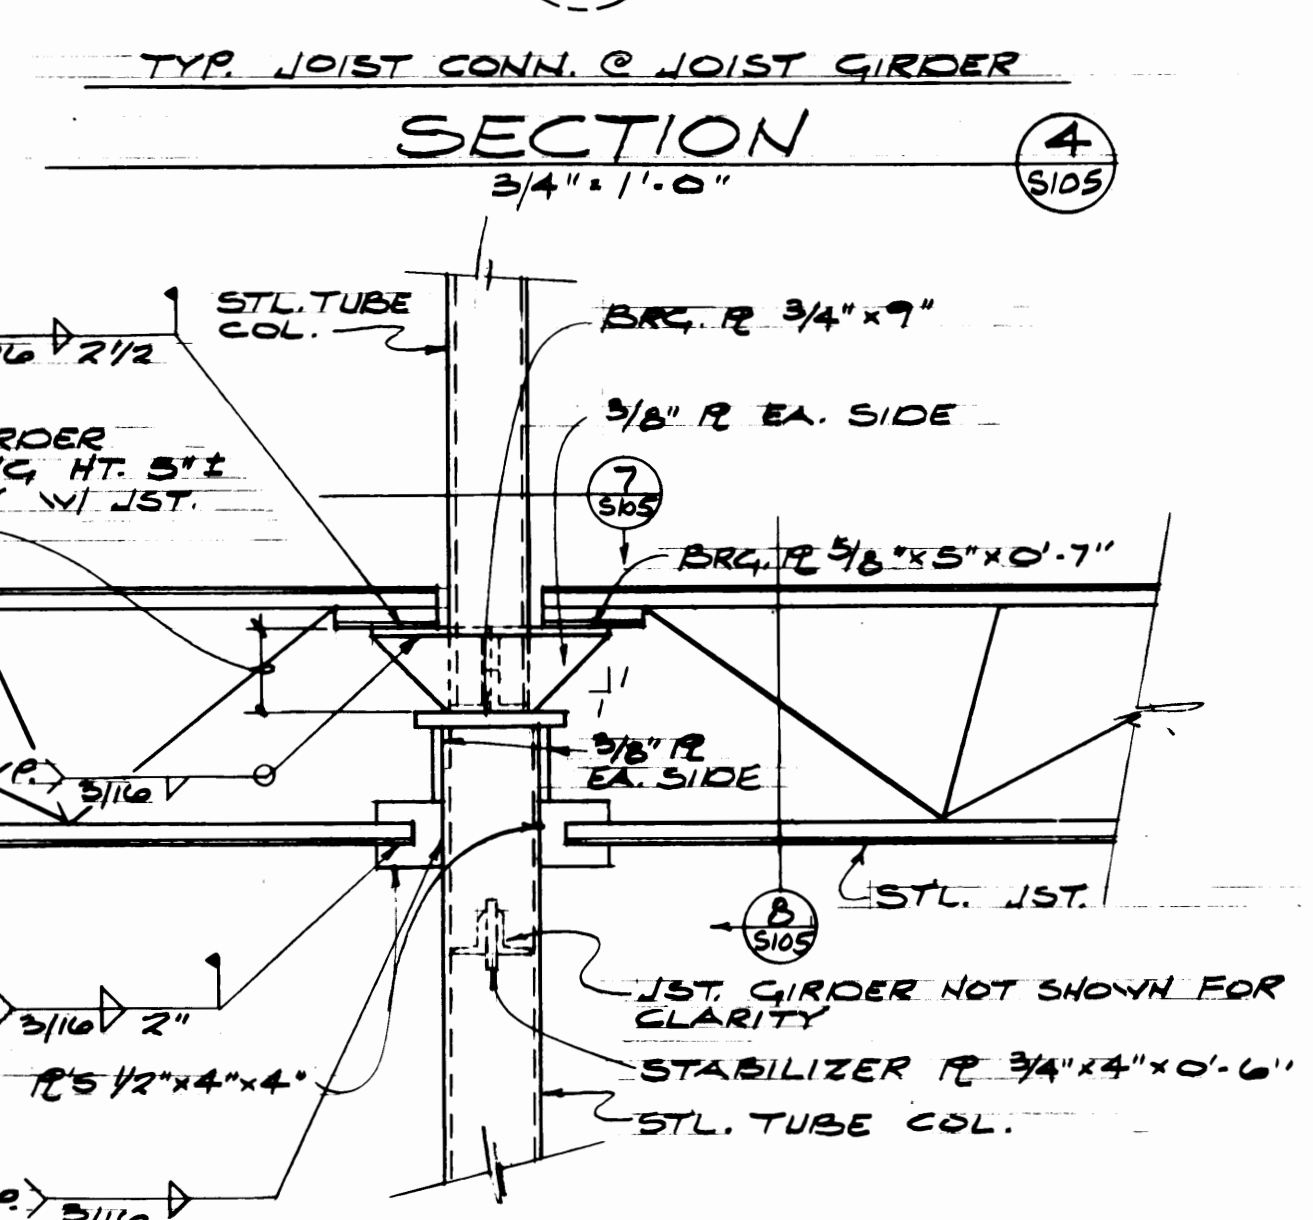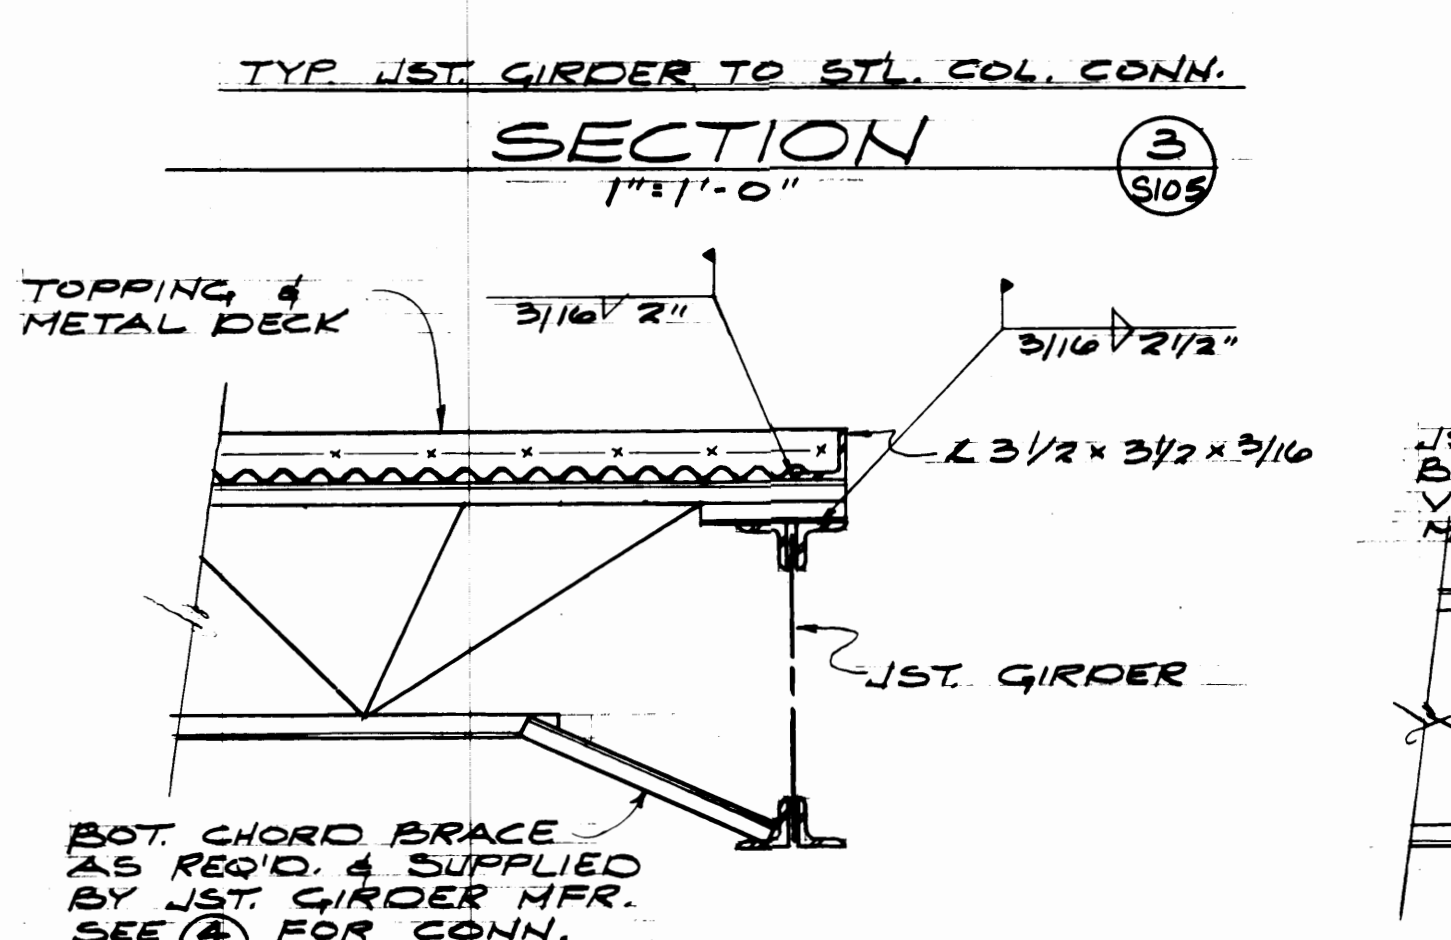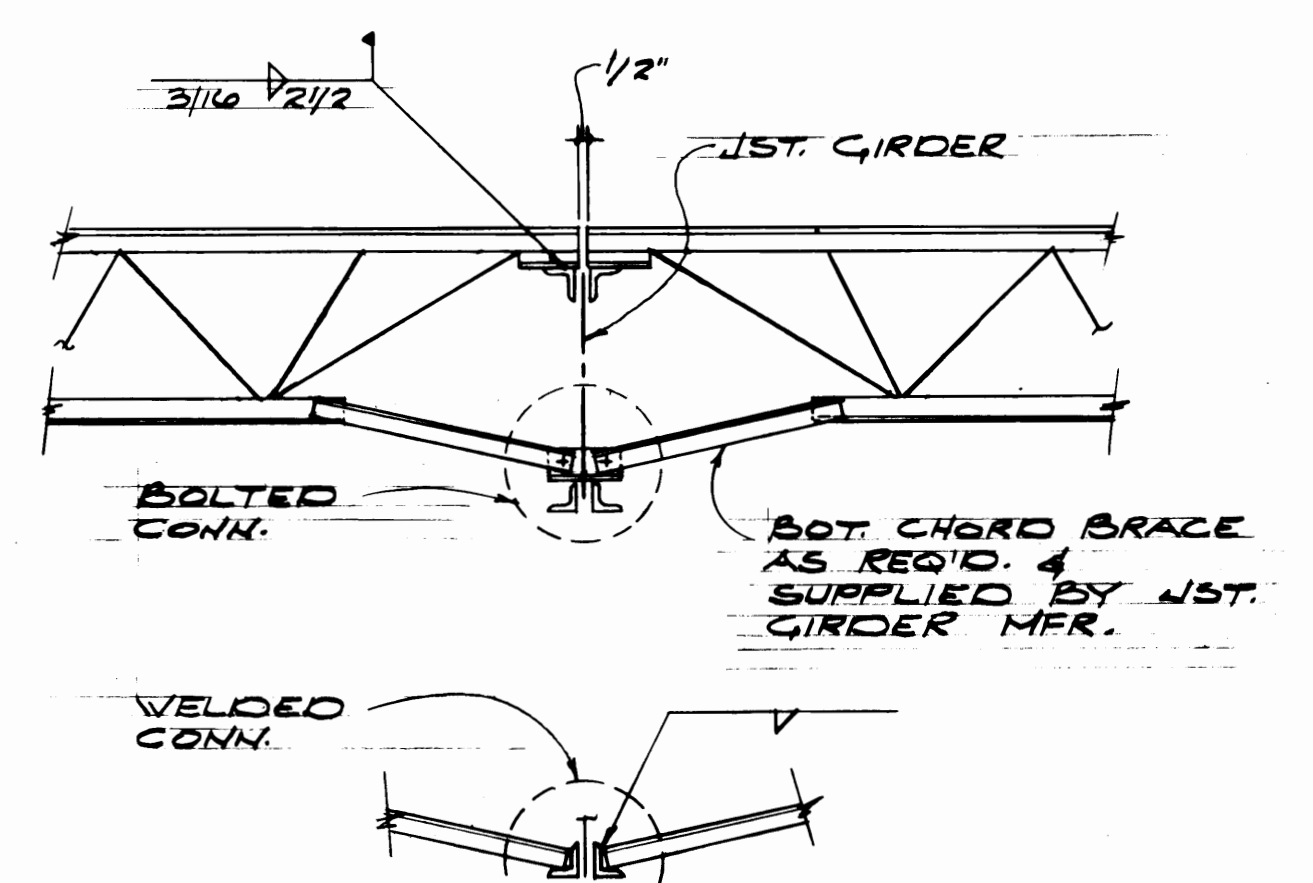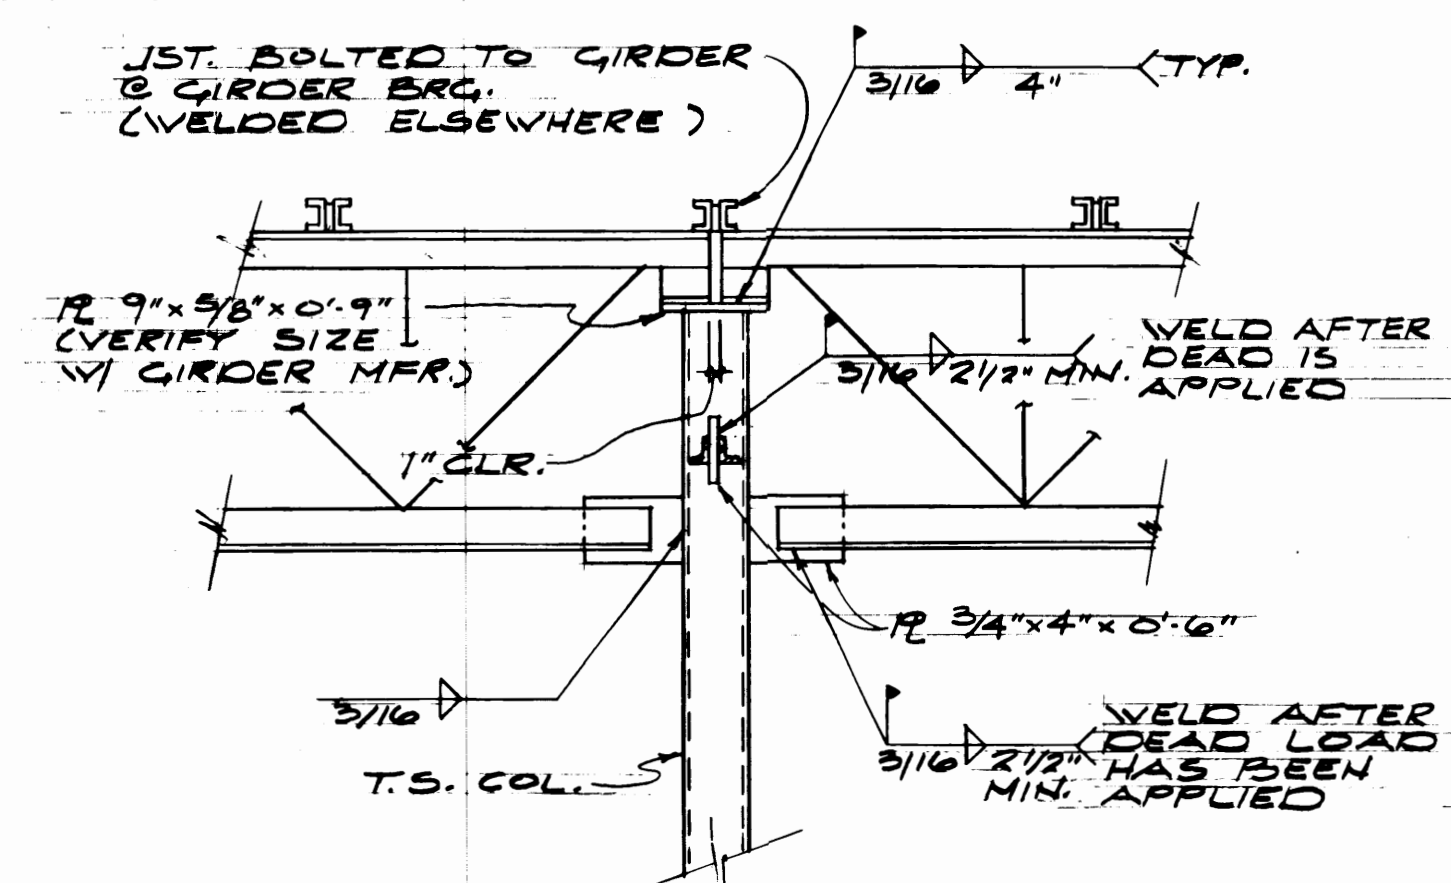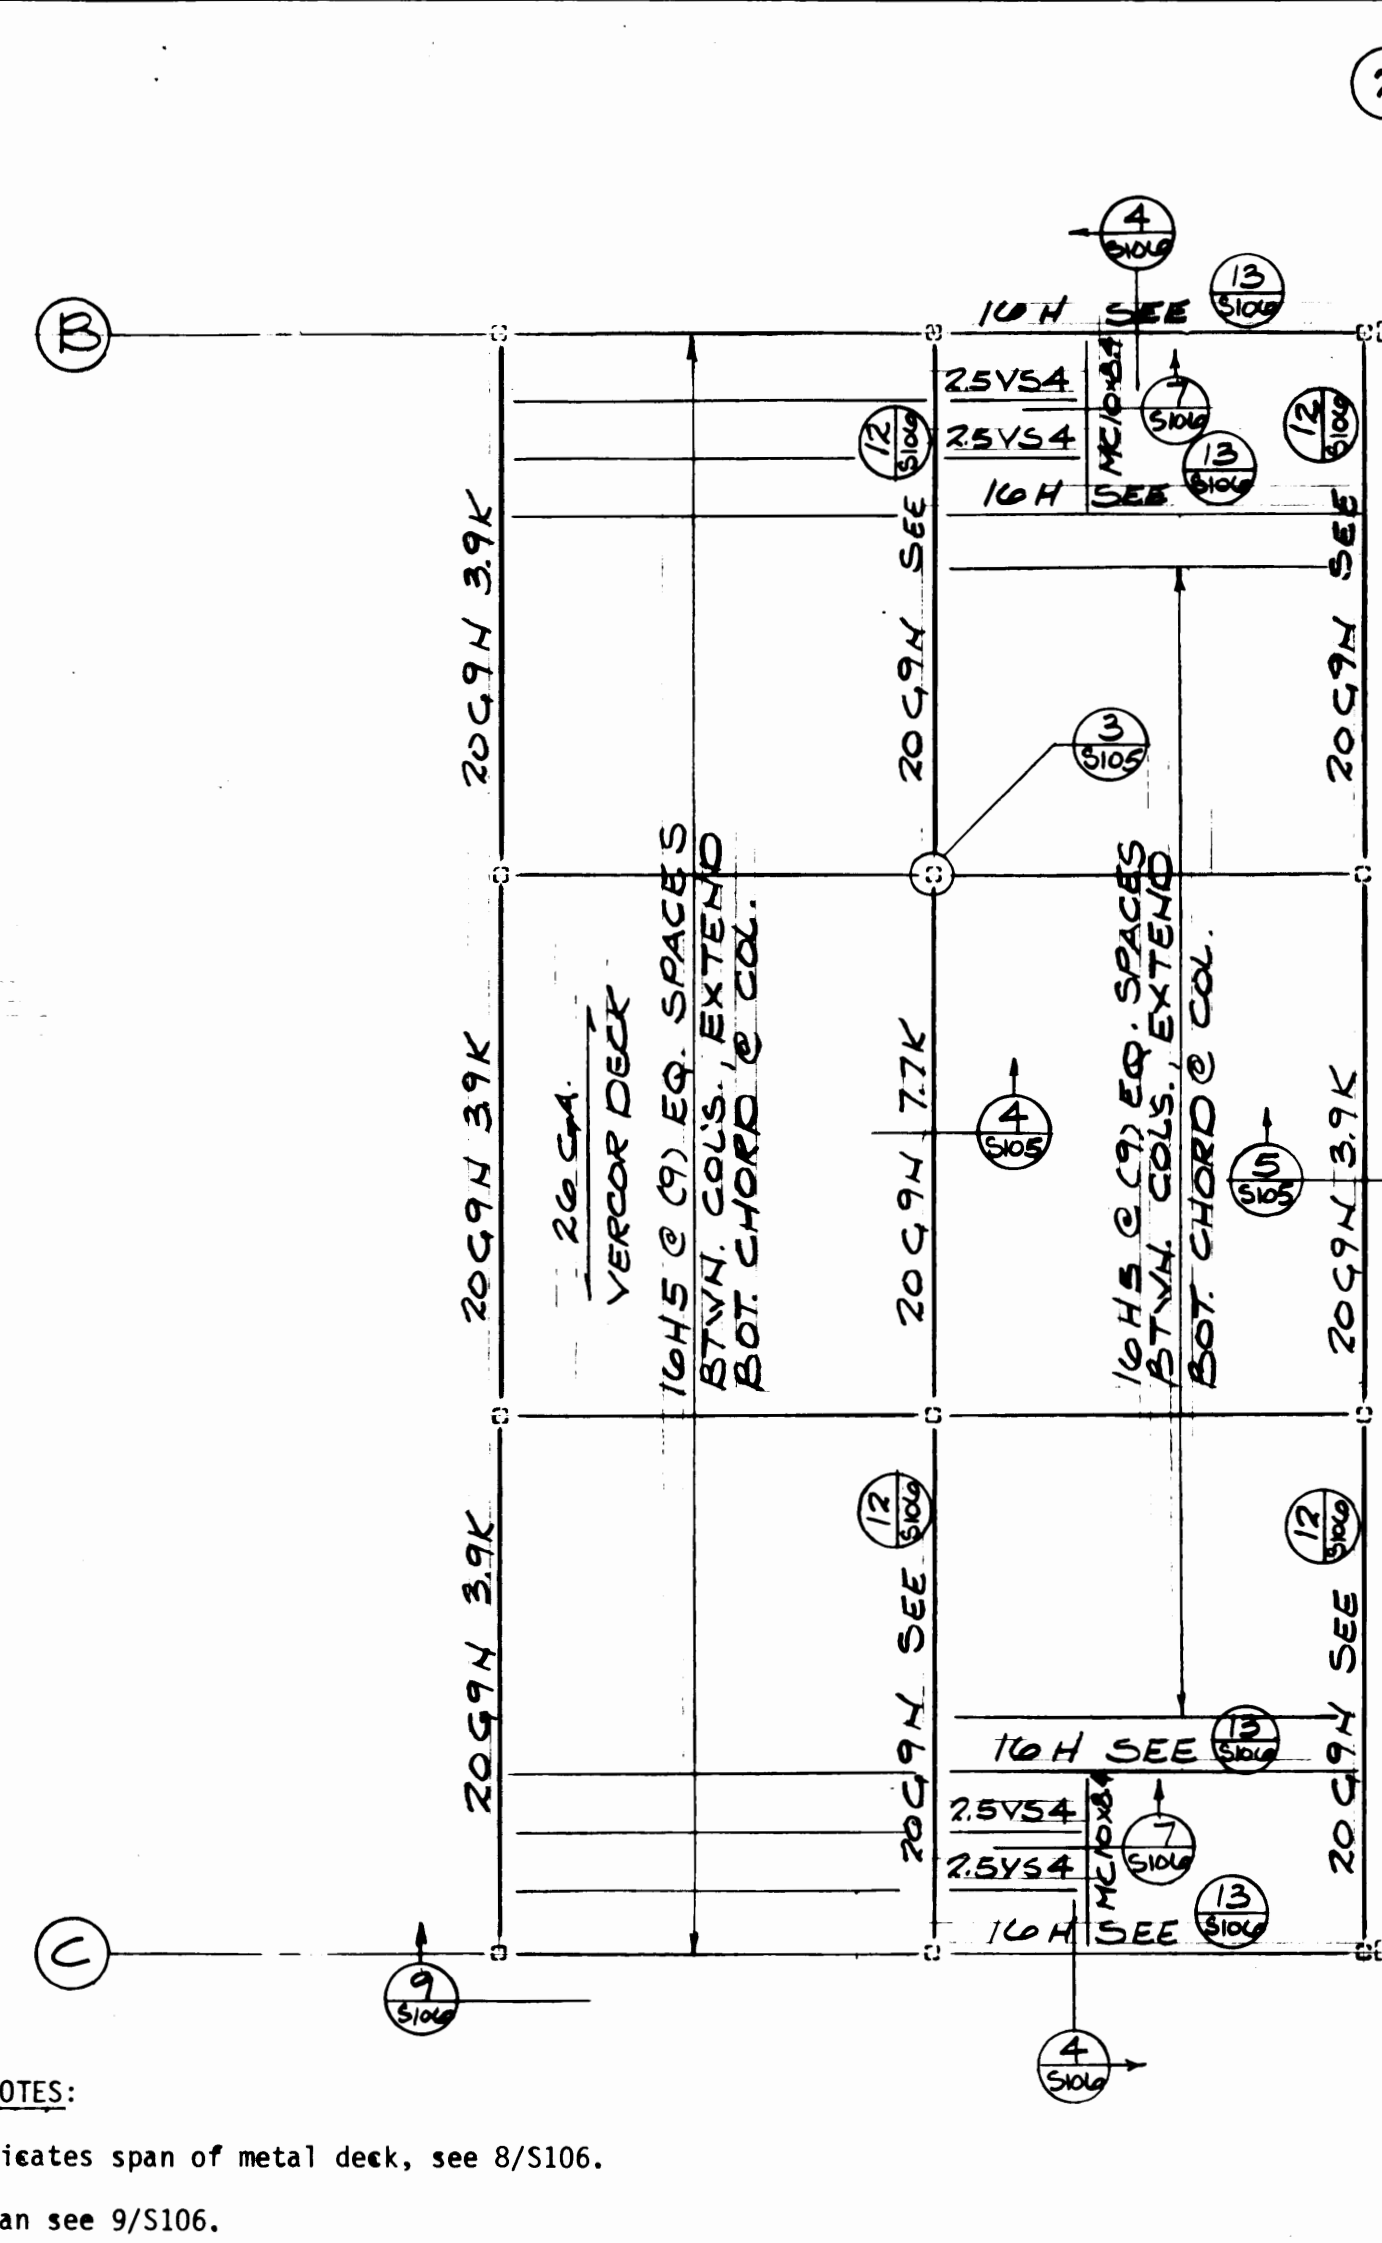



2nd FLOOR MEZZ. FRAMING PLAN
 1/8" = 1'-0"

3rd FLOOR MEZZ. FRAMING PLAN
 1/8" = 1'-0"

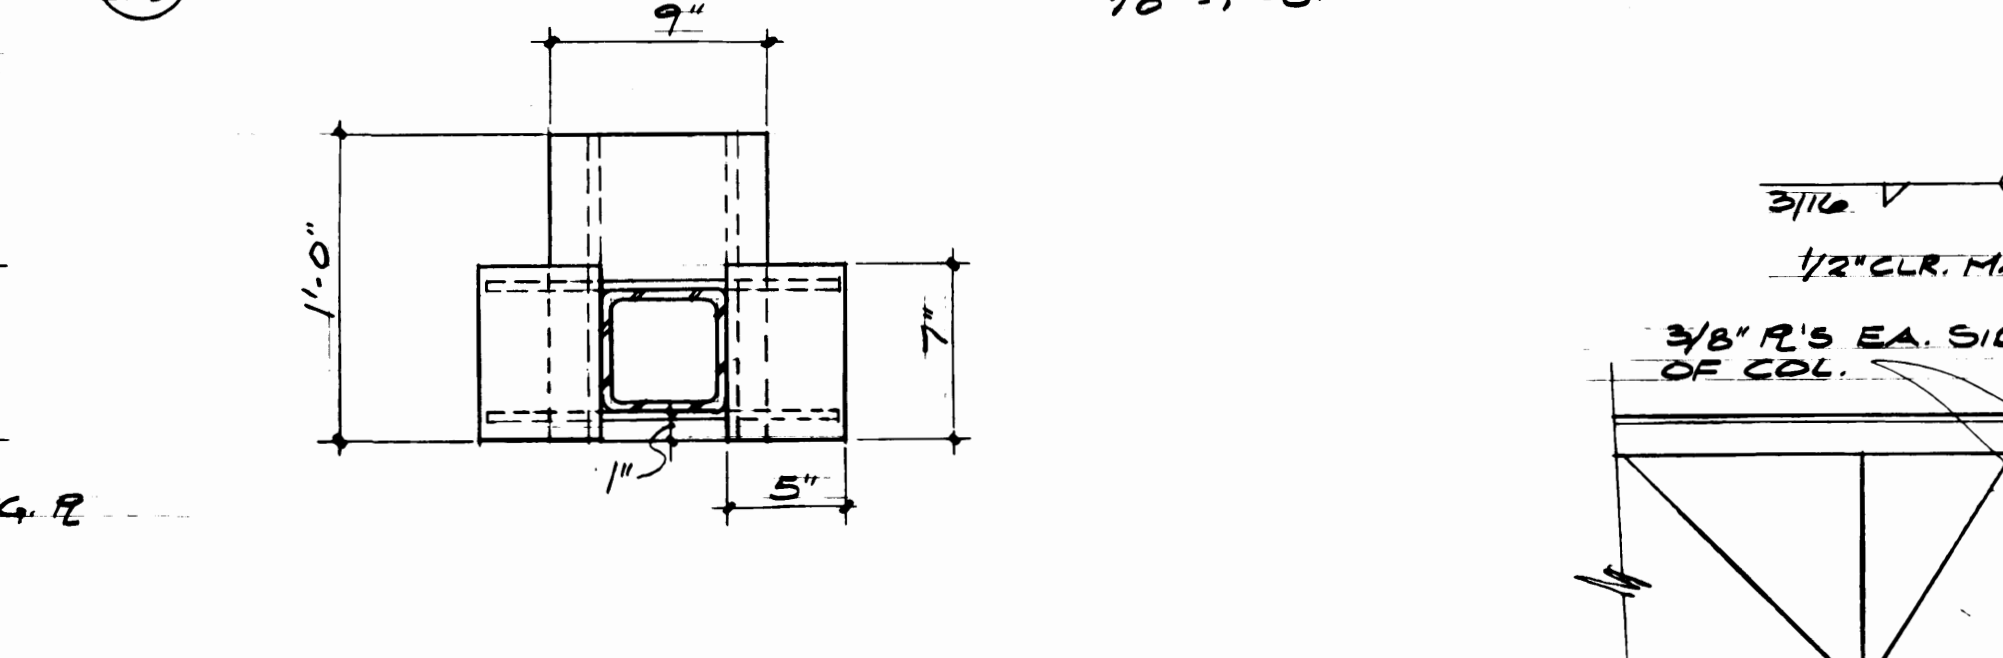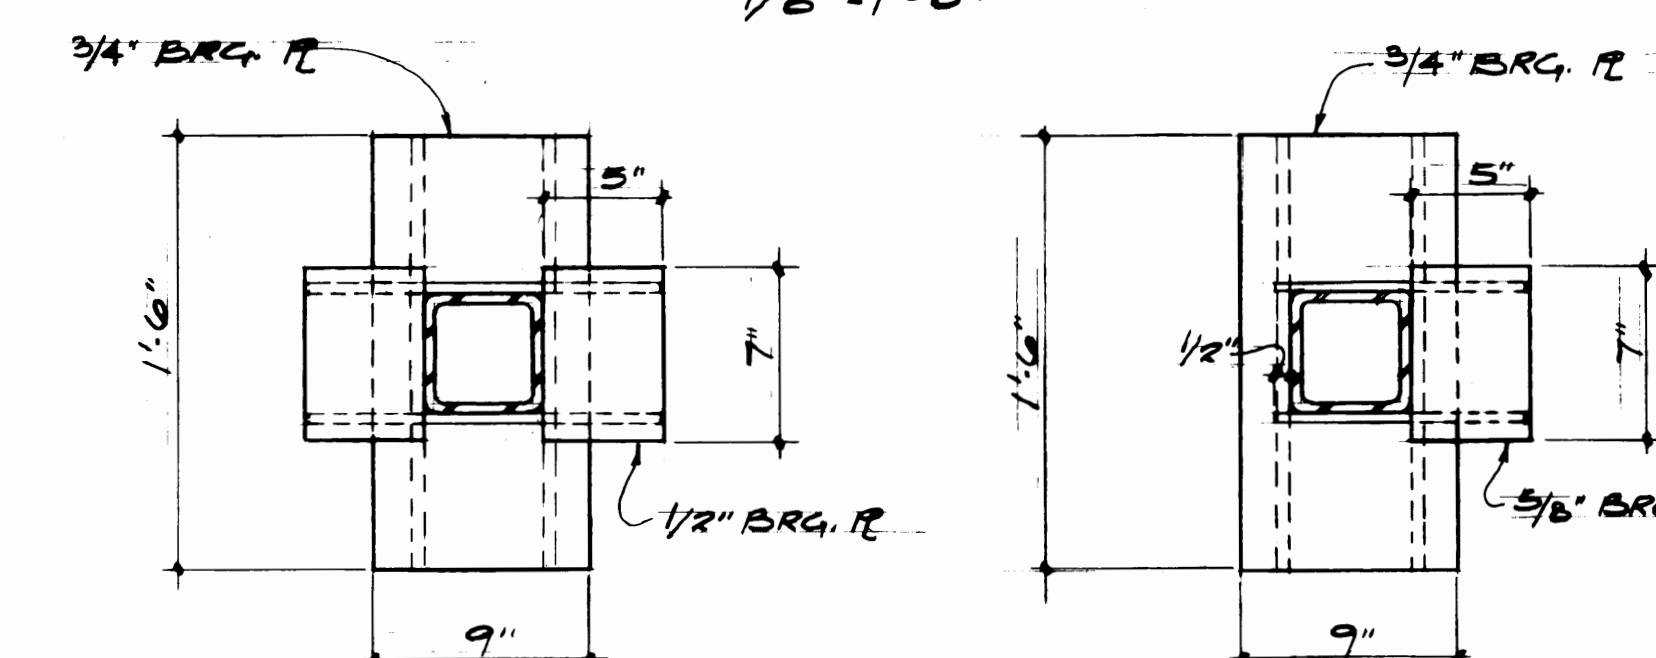



PLAN VIEW OF INTERIOR COL.
 1/2" = 1'-0"

PLAN VIEW OF EXTERIOR COL. W/ JST. GIRDER BRG. EA. SIDE
 1/2" = 1'-0"

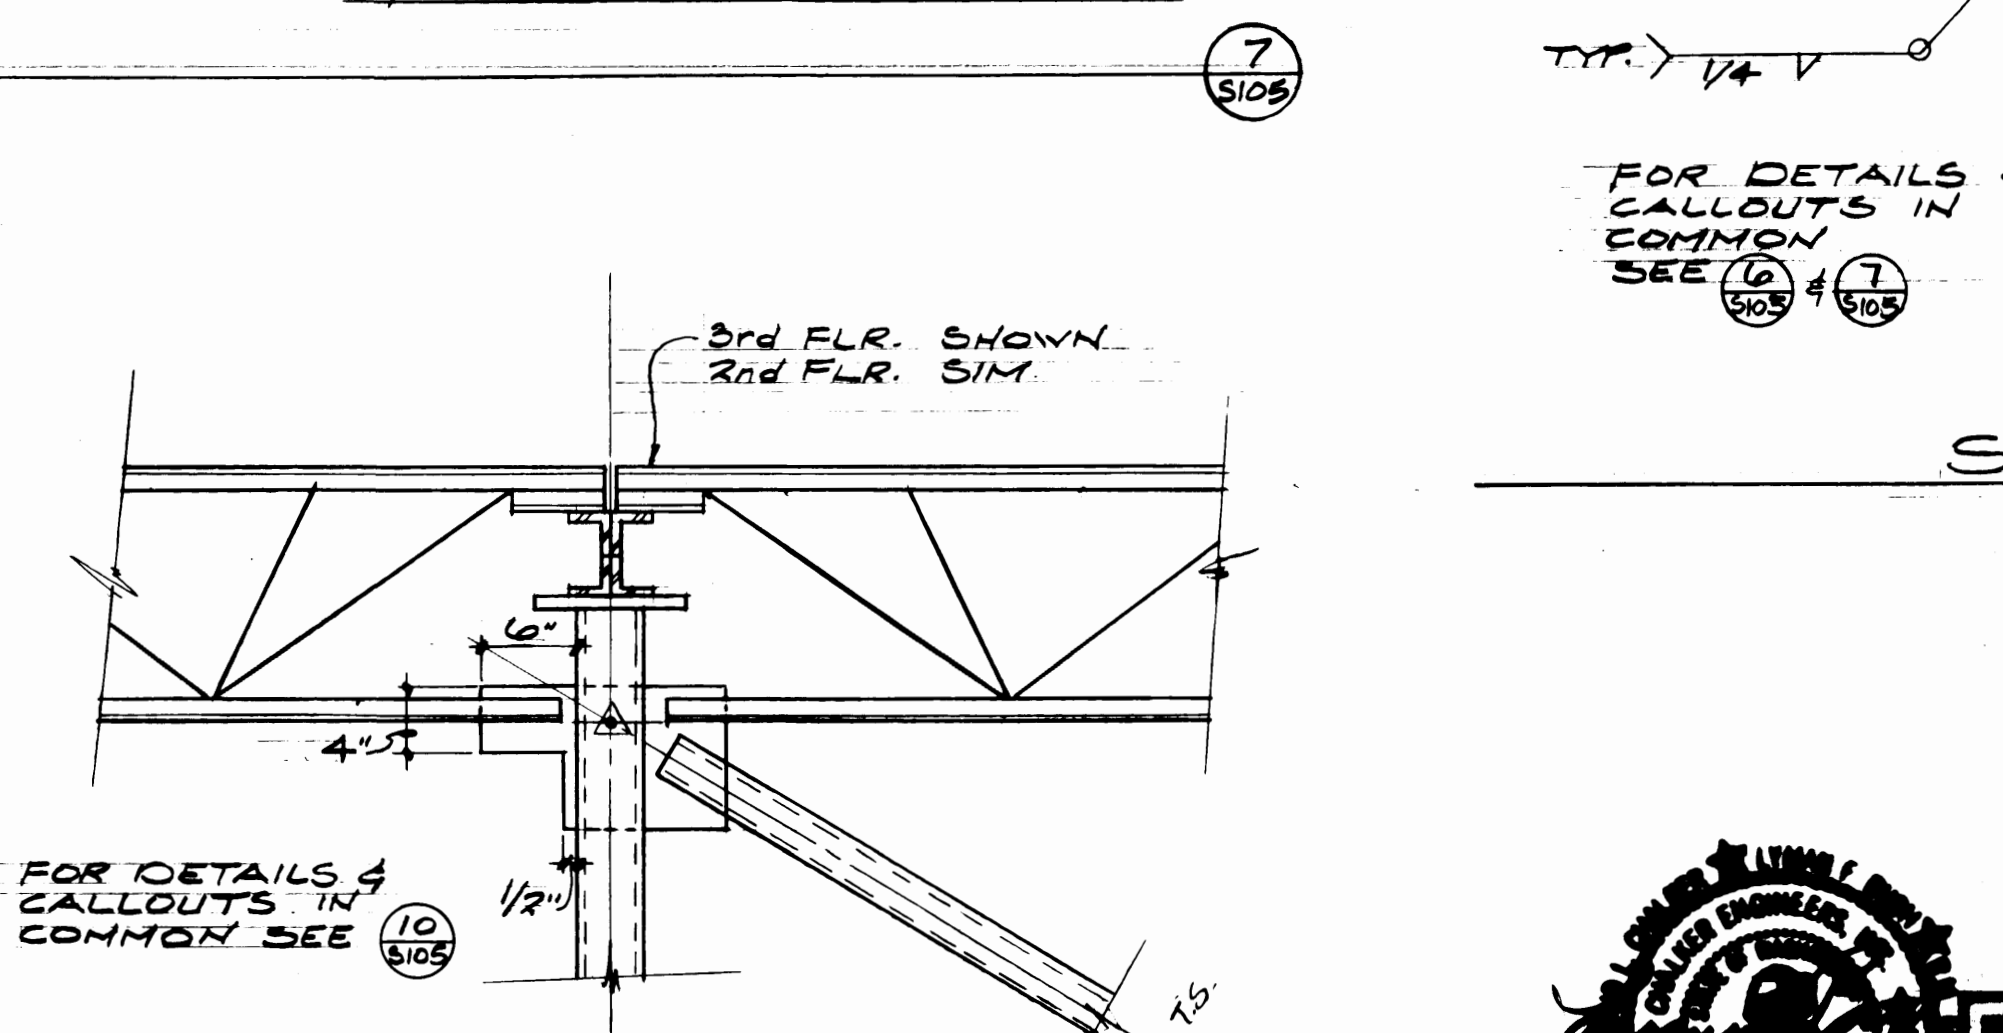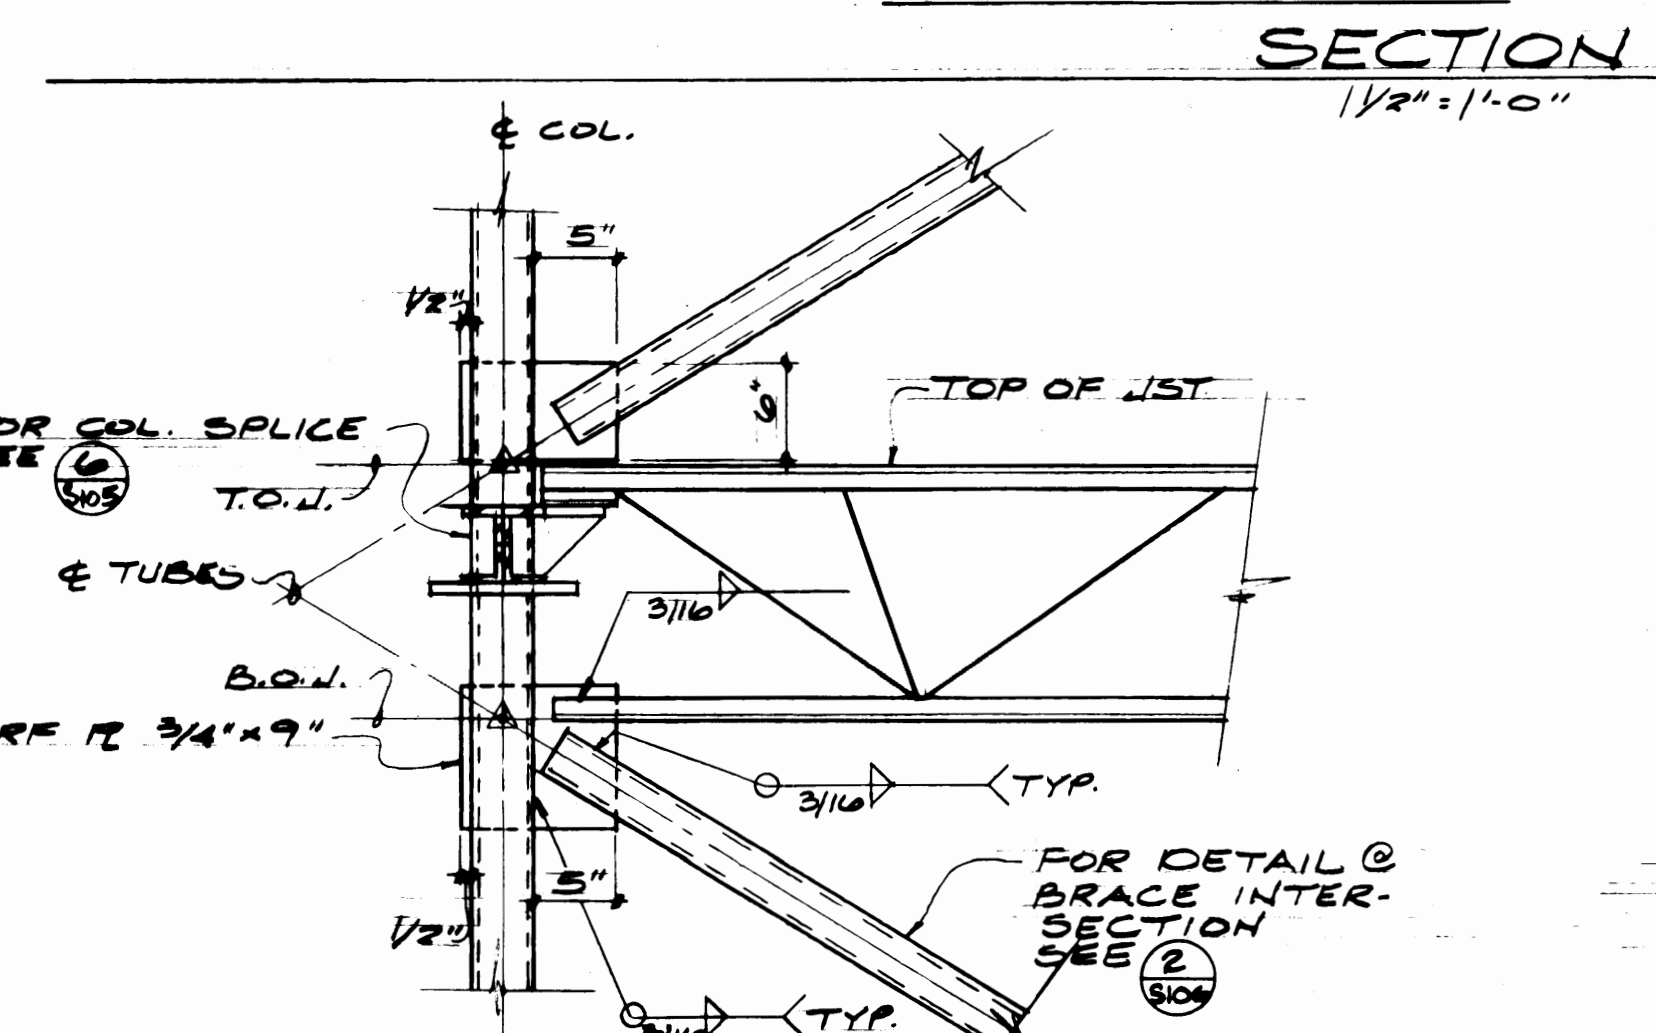

TYP. 'X' BRACE CONN. @ 2ND FLR.
 1/2" = 1'-0"

TYP. 'X' BRACE CONN. @ 3RD FLR.
 1/2" = 1'-0"

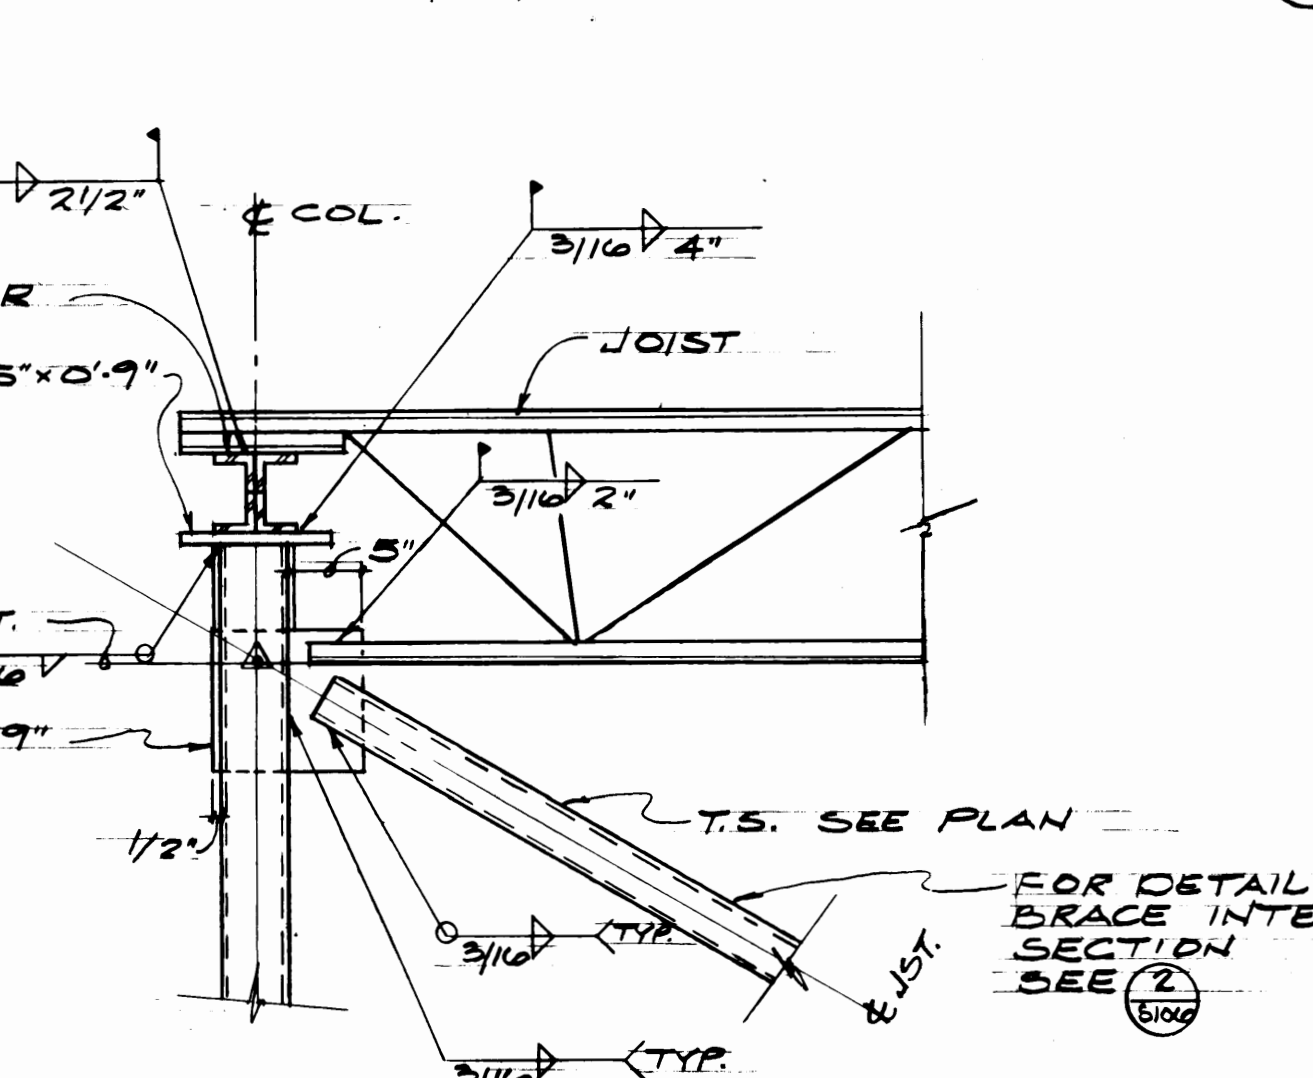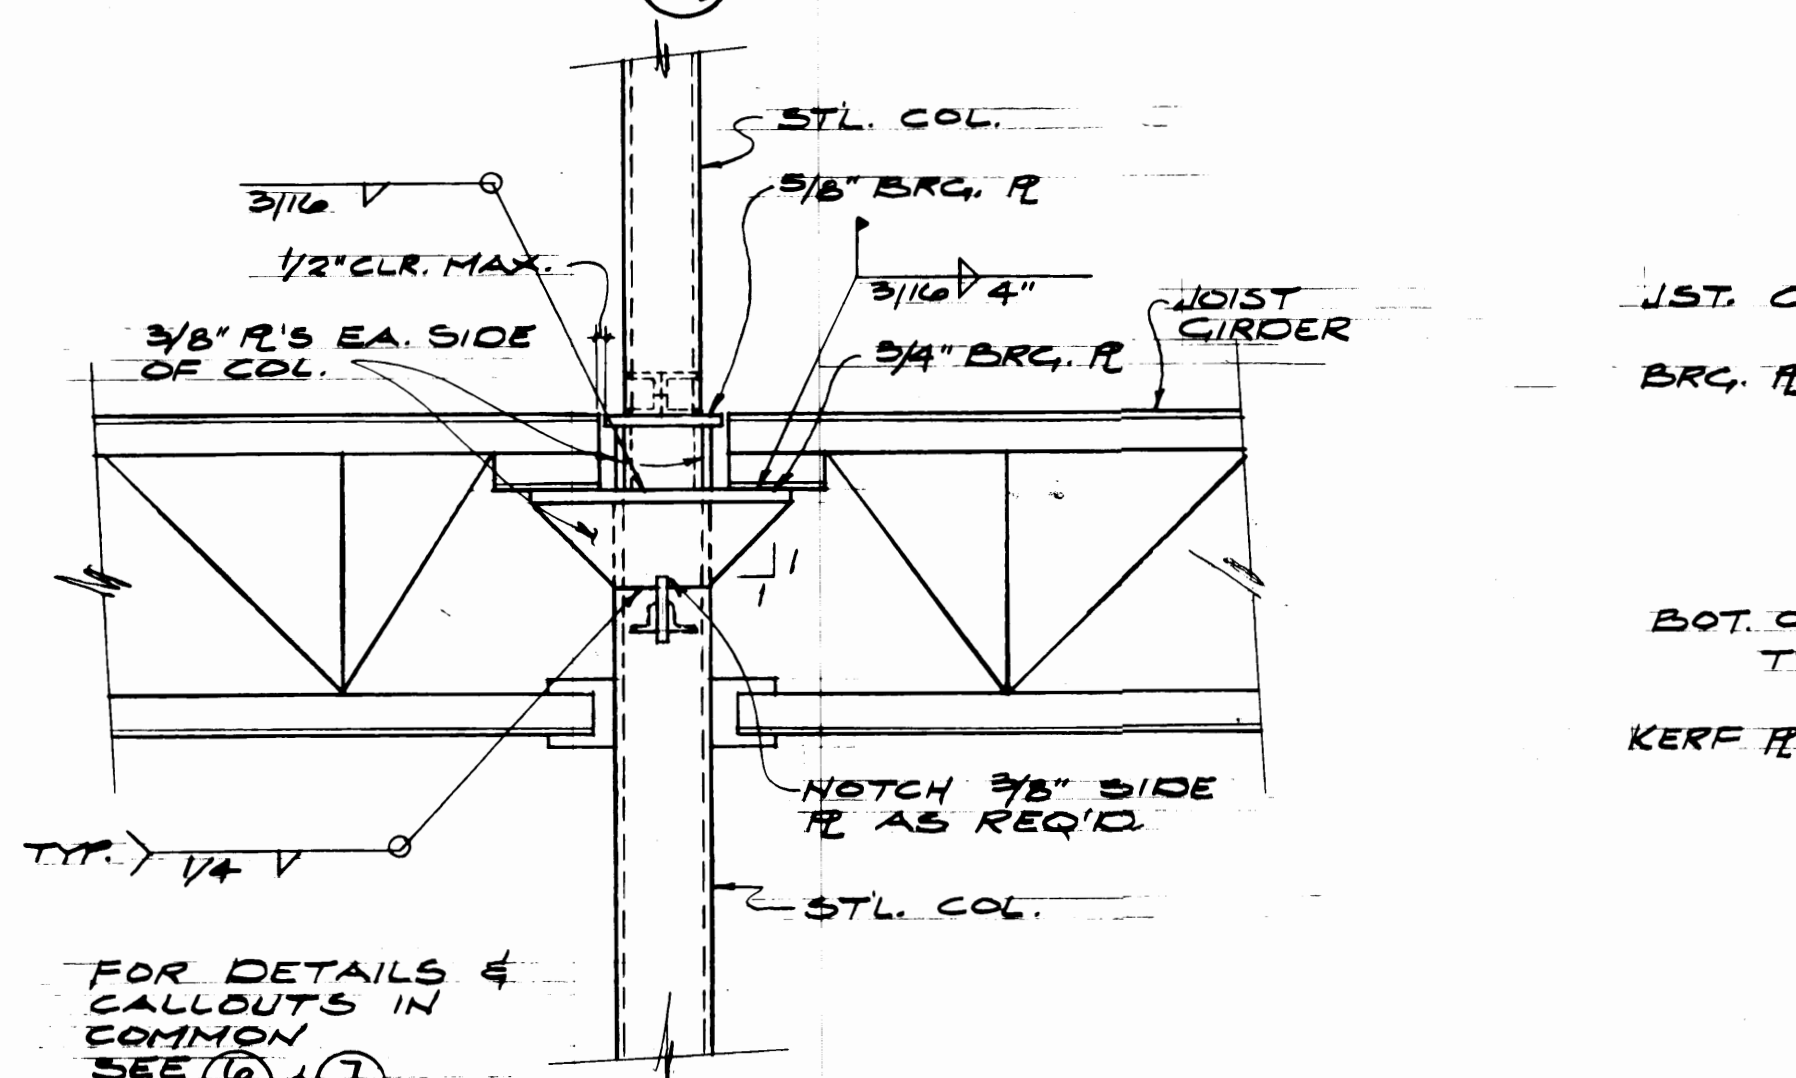

SECTION 9
 1/2" = 1'-0"




















SECTION 10
 1/2" = 1'-0"



Structural Engineers, Inc.
 Consulting Engineers
 51 University, Suite 301
 Seattle, WA 98101
 (206) 462-4116
 980 So. Fremont, Suite 301
 Tacoma, WA 98402
 (253) 383-2797

NO.	REVISION	BY	APP.	DATE
1	NO AS BUILT REVISIONS	R.S.		3/30/84

DRAWN N.N. DATE 3-22-84		PORT OF TACOMA TACOMA TERMINALS, INC. C.F.S. BUILDING MEZZANINE FRAMING PLANS & DETAILS	
CHECKED D.S. DATE 3-22-84	CHECKED D.P. DATE 3-22-84	FIELD BOOK (S)	SCALE
CONT. NO. 557	APPROVED [Signature] DATE 3/30/84	CHIEF ENGINEER	DRAWING NO. EP 3879-23 - 5105
SHEET 21 OF 71		J. 6525	

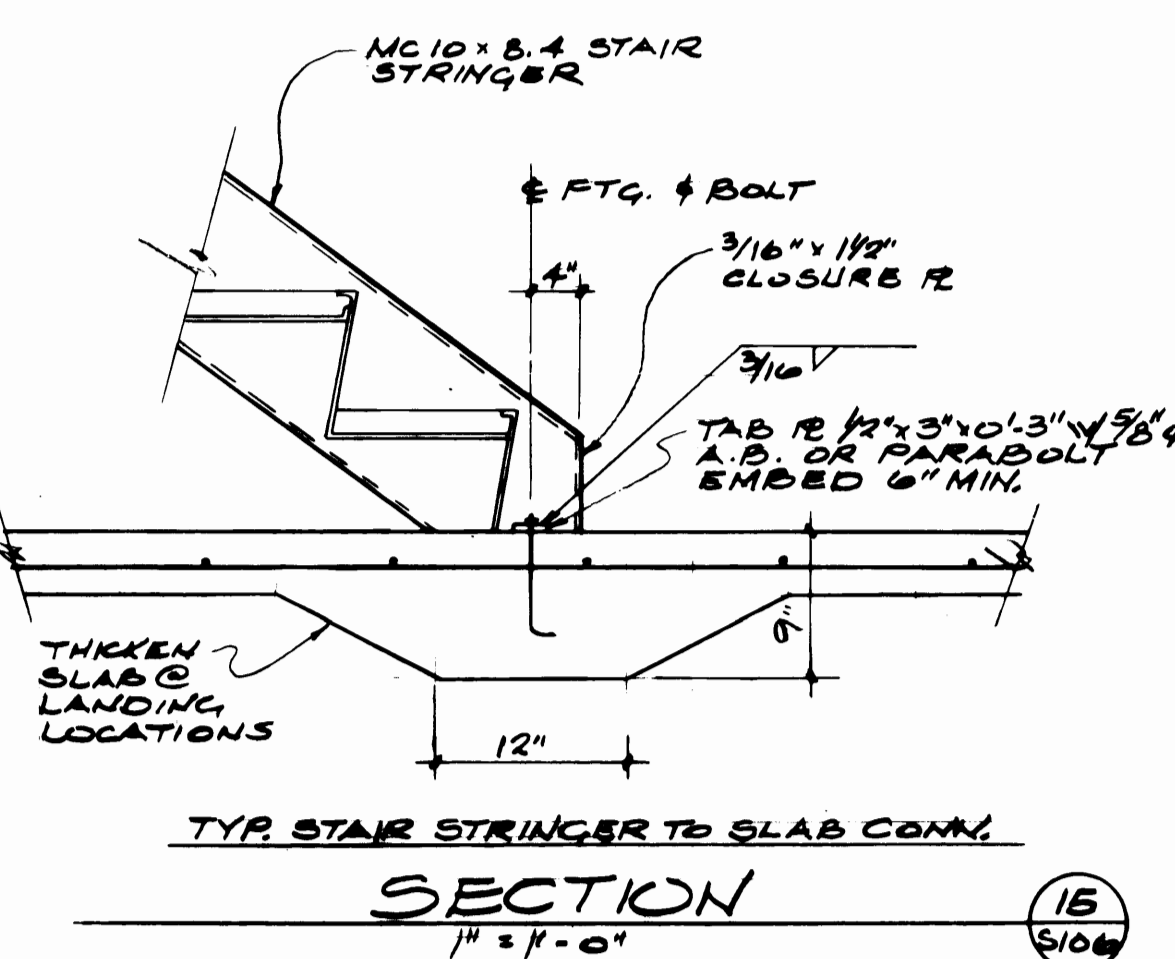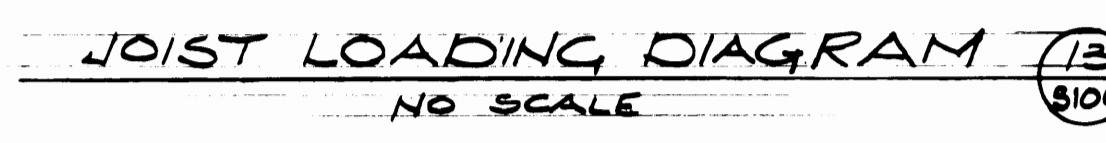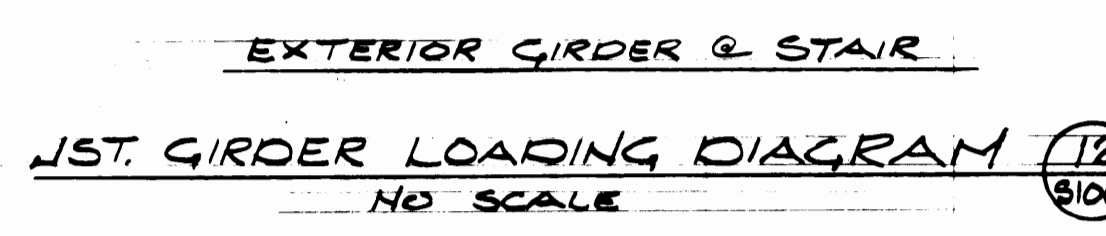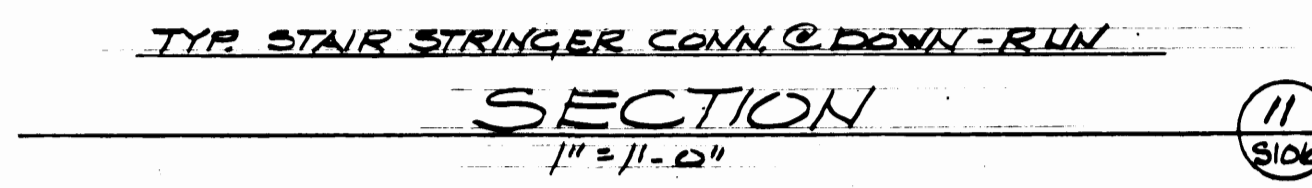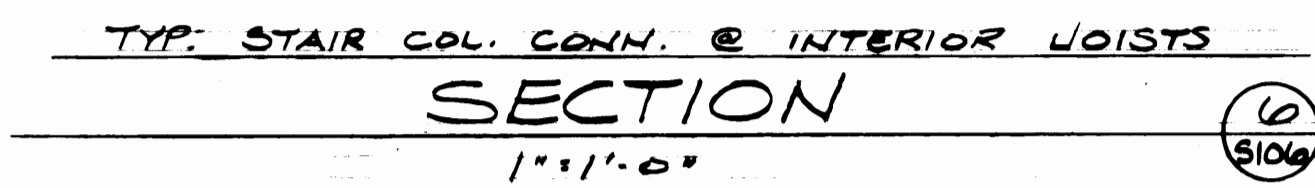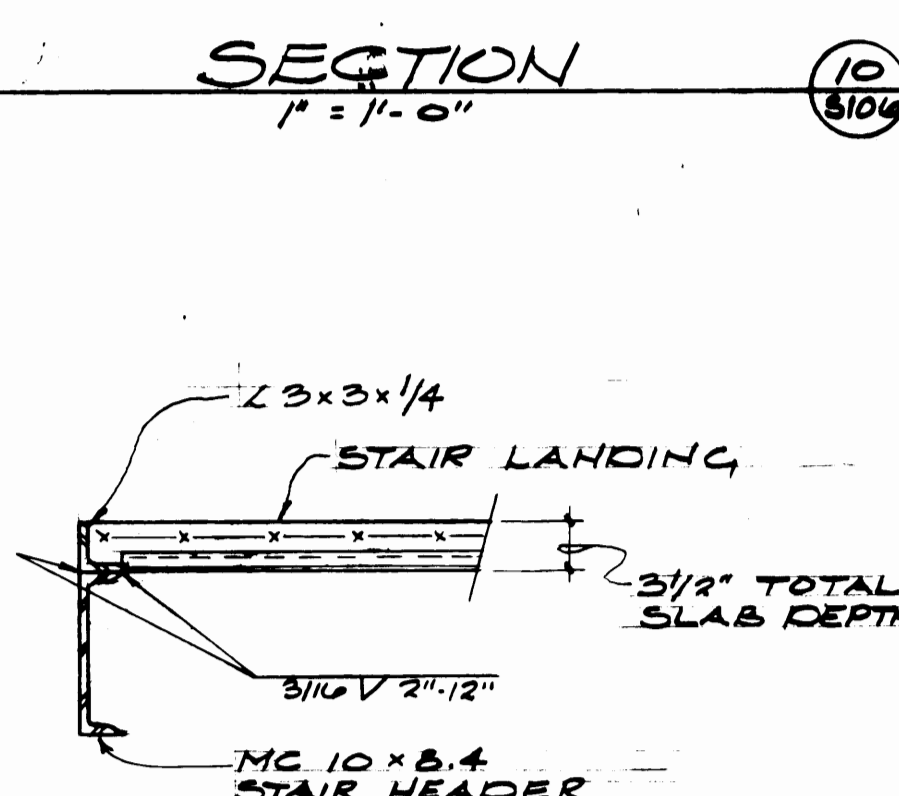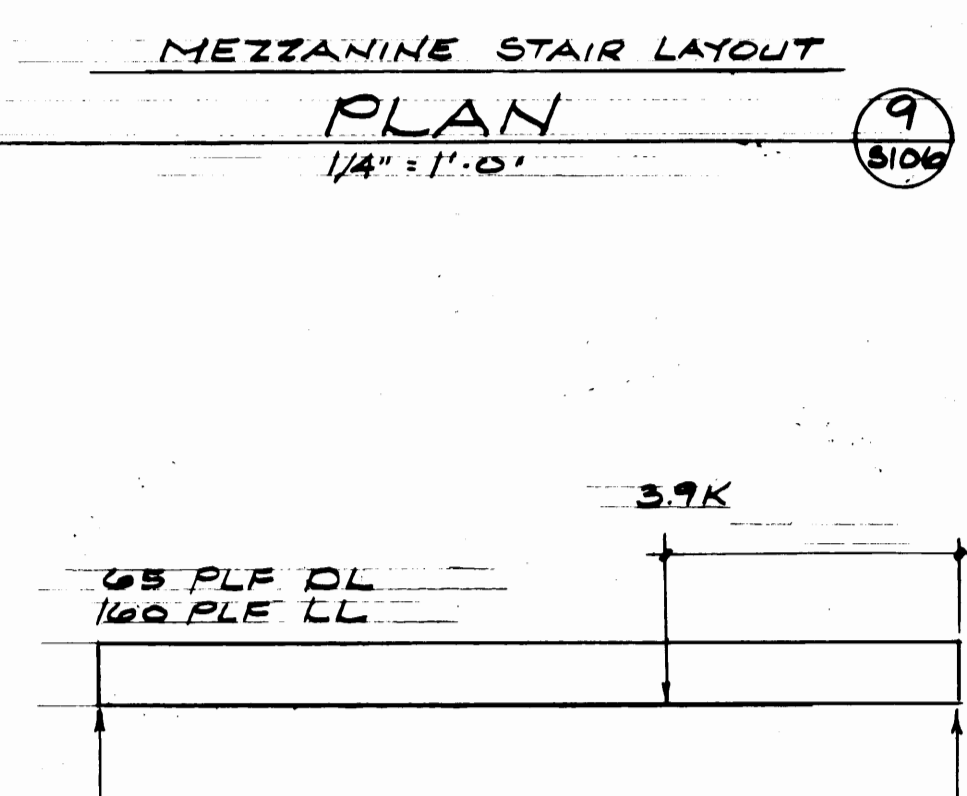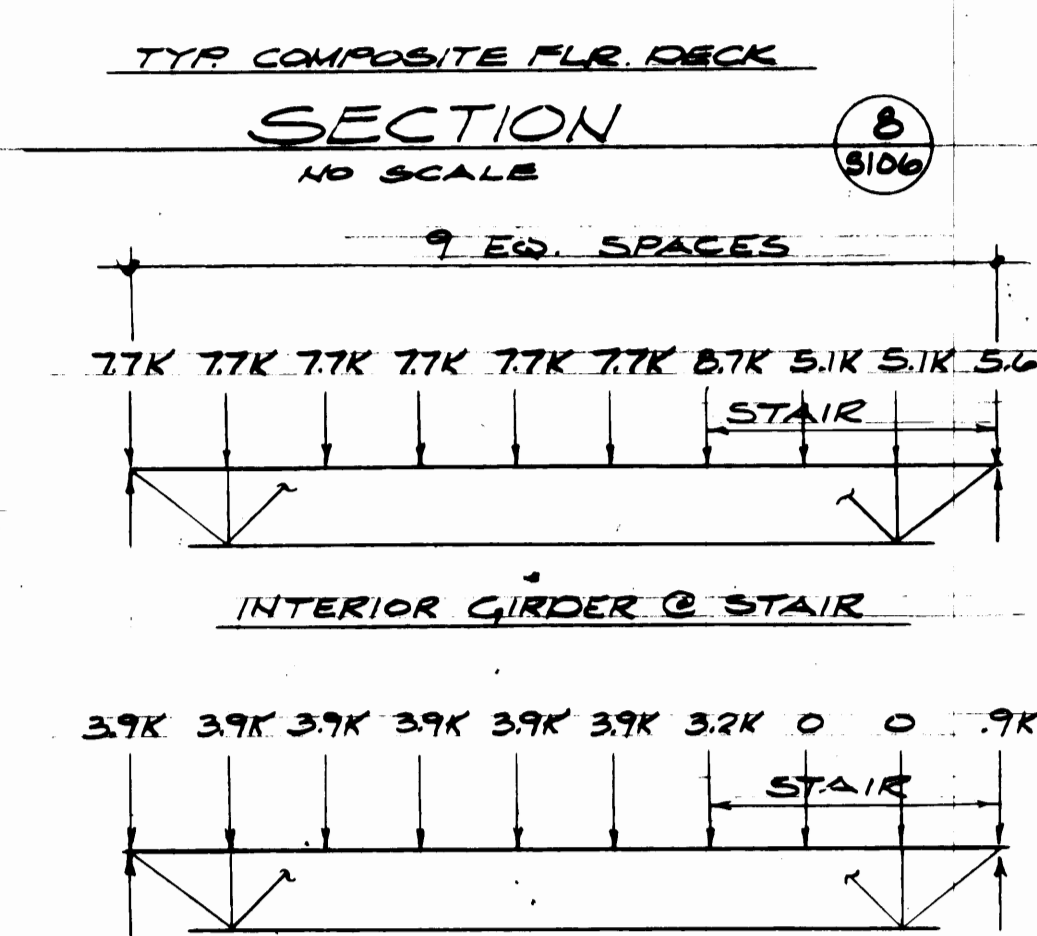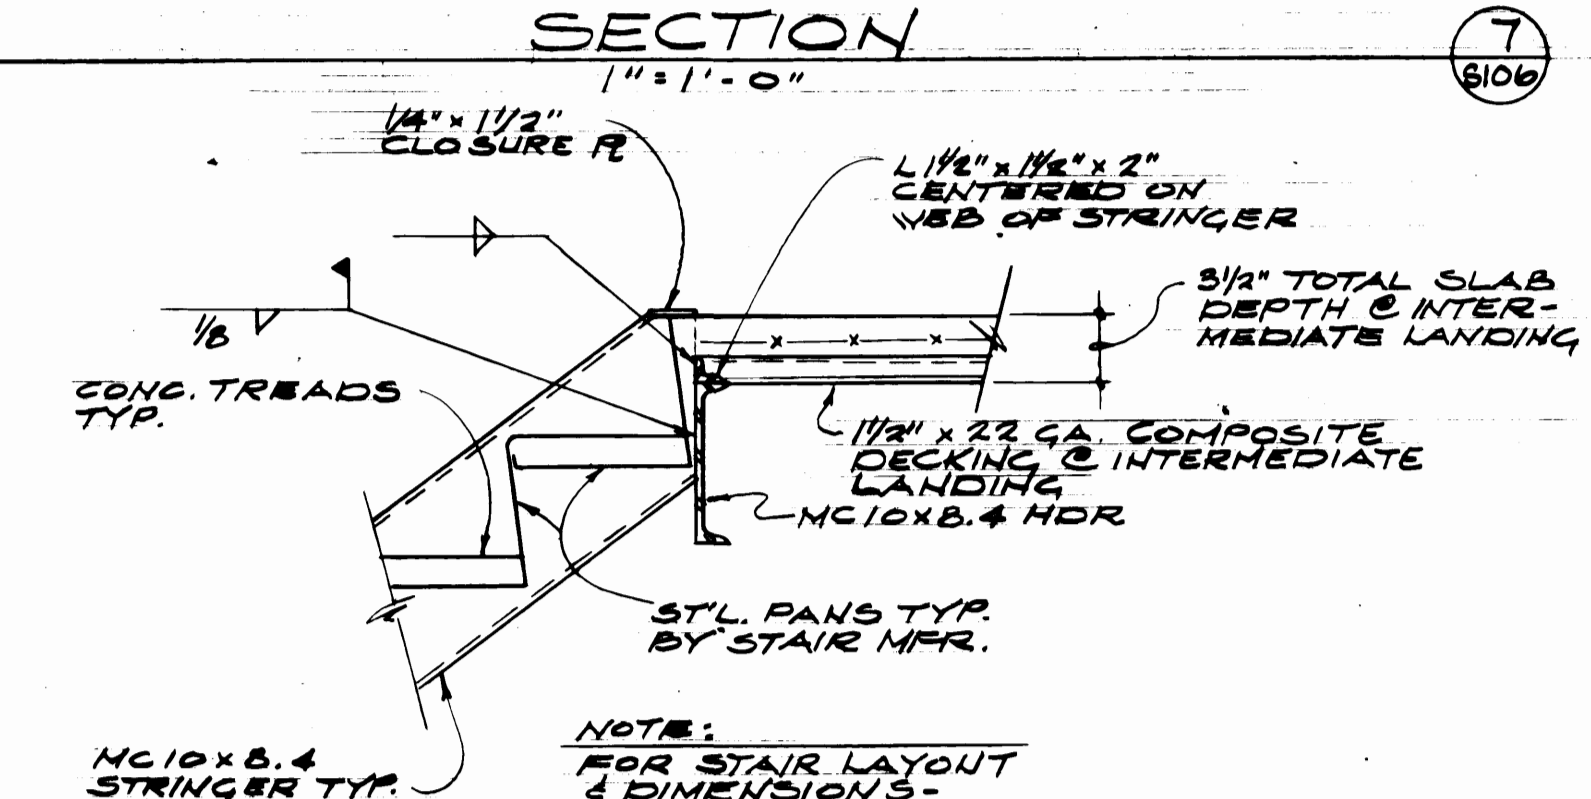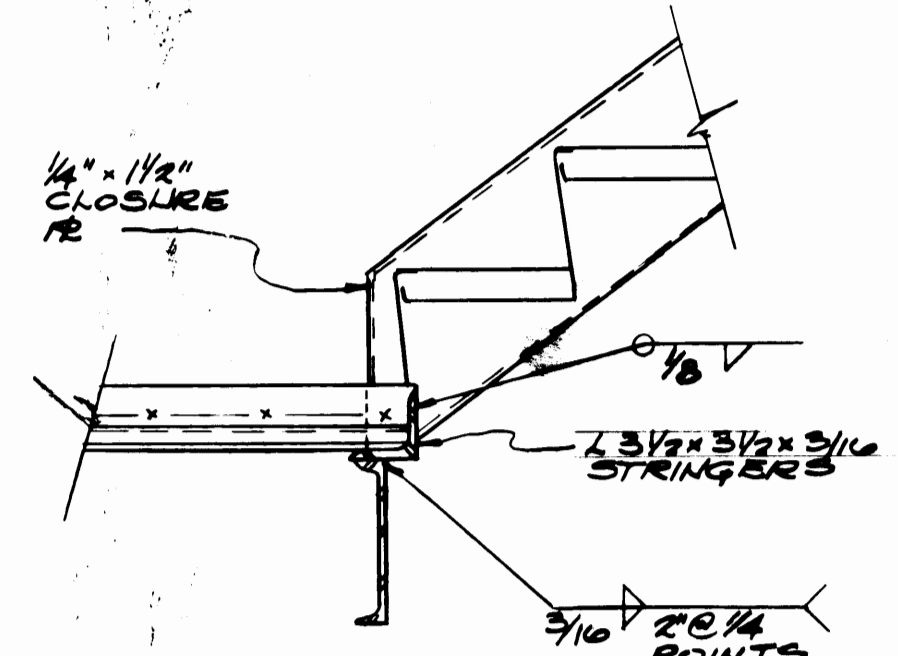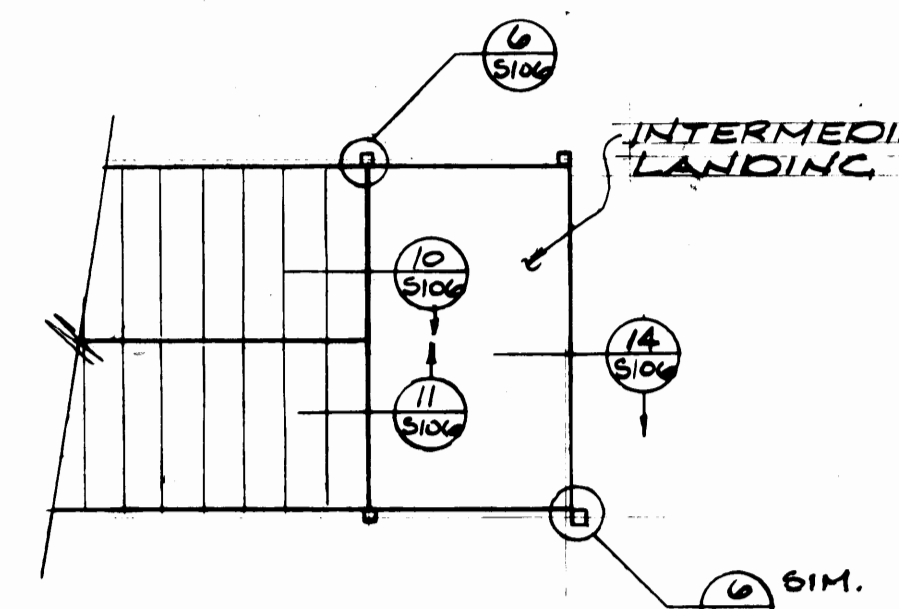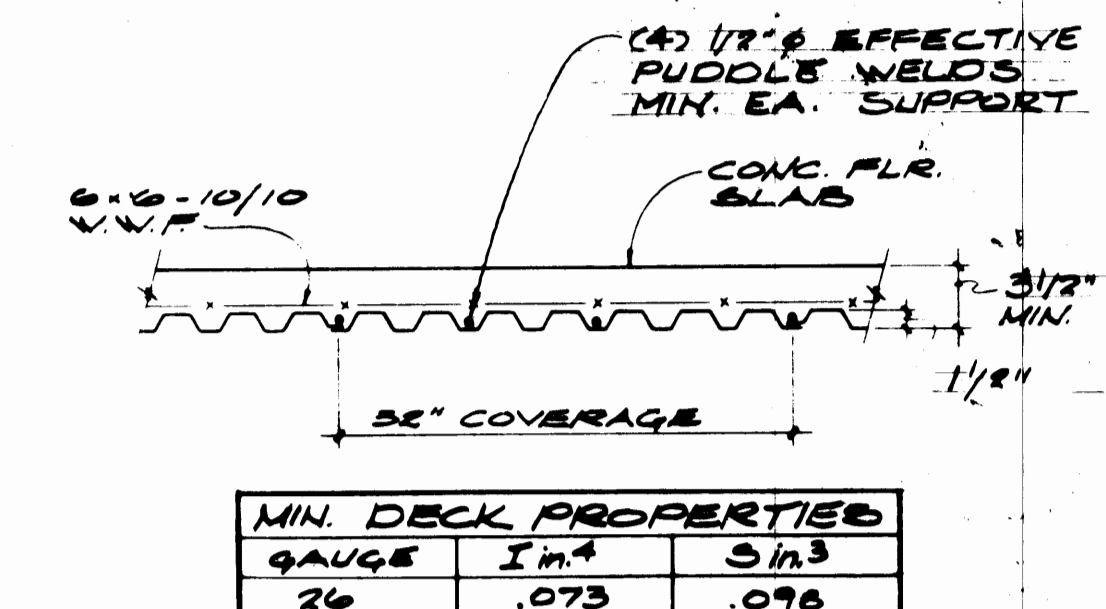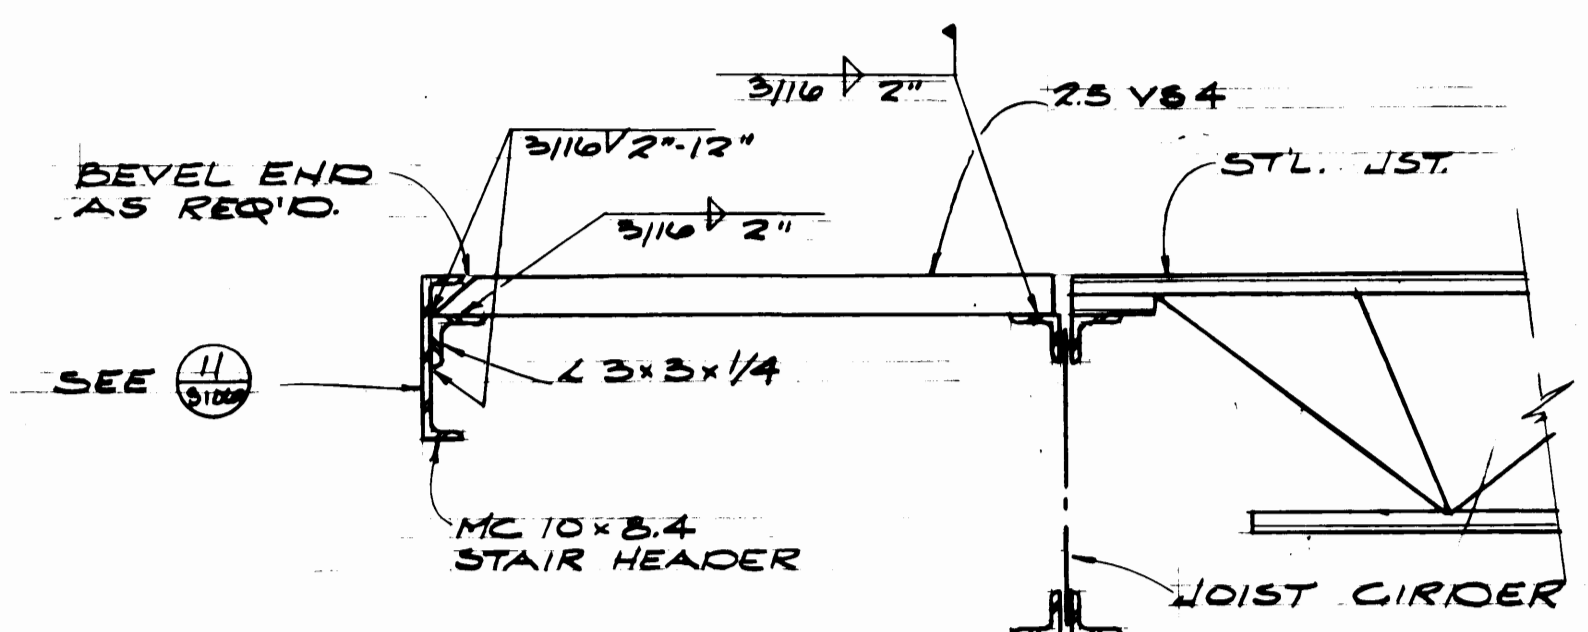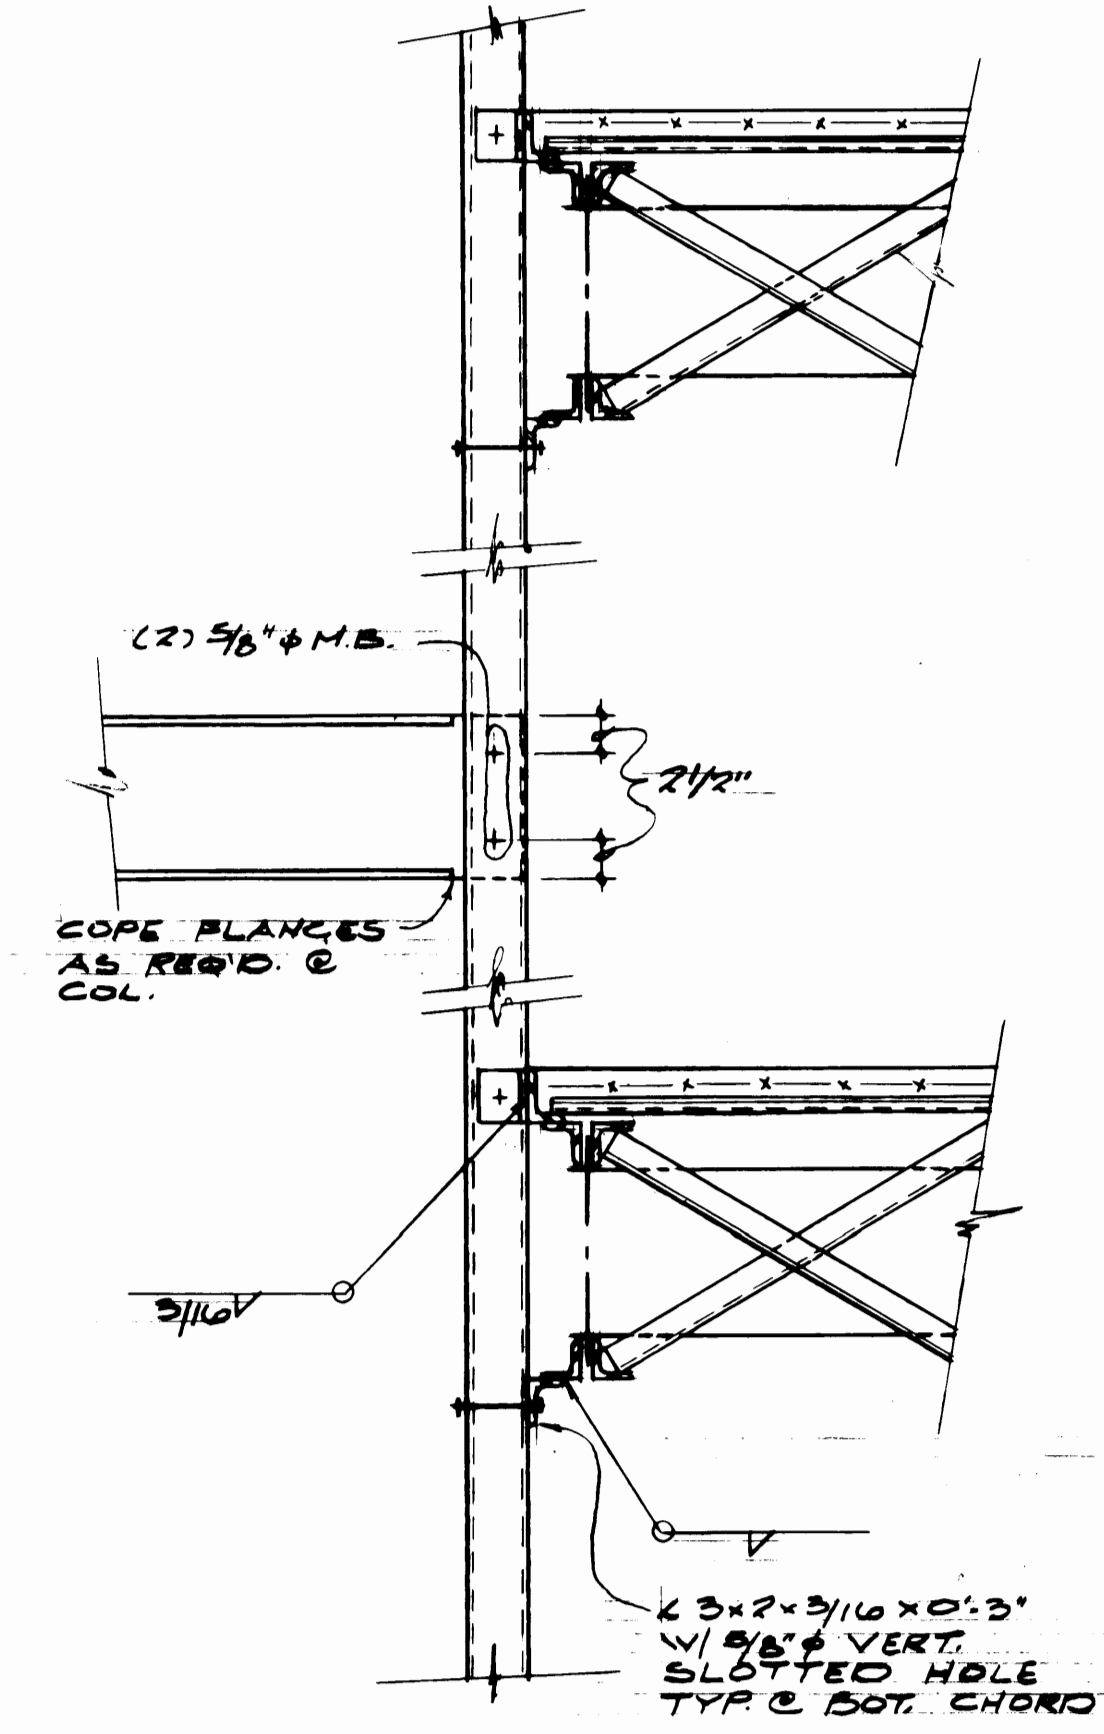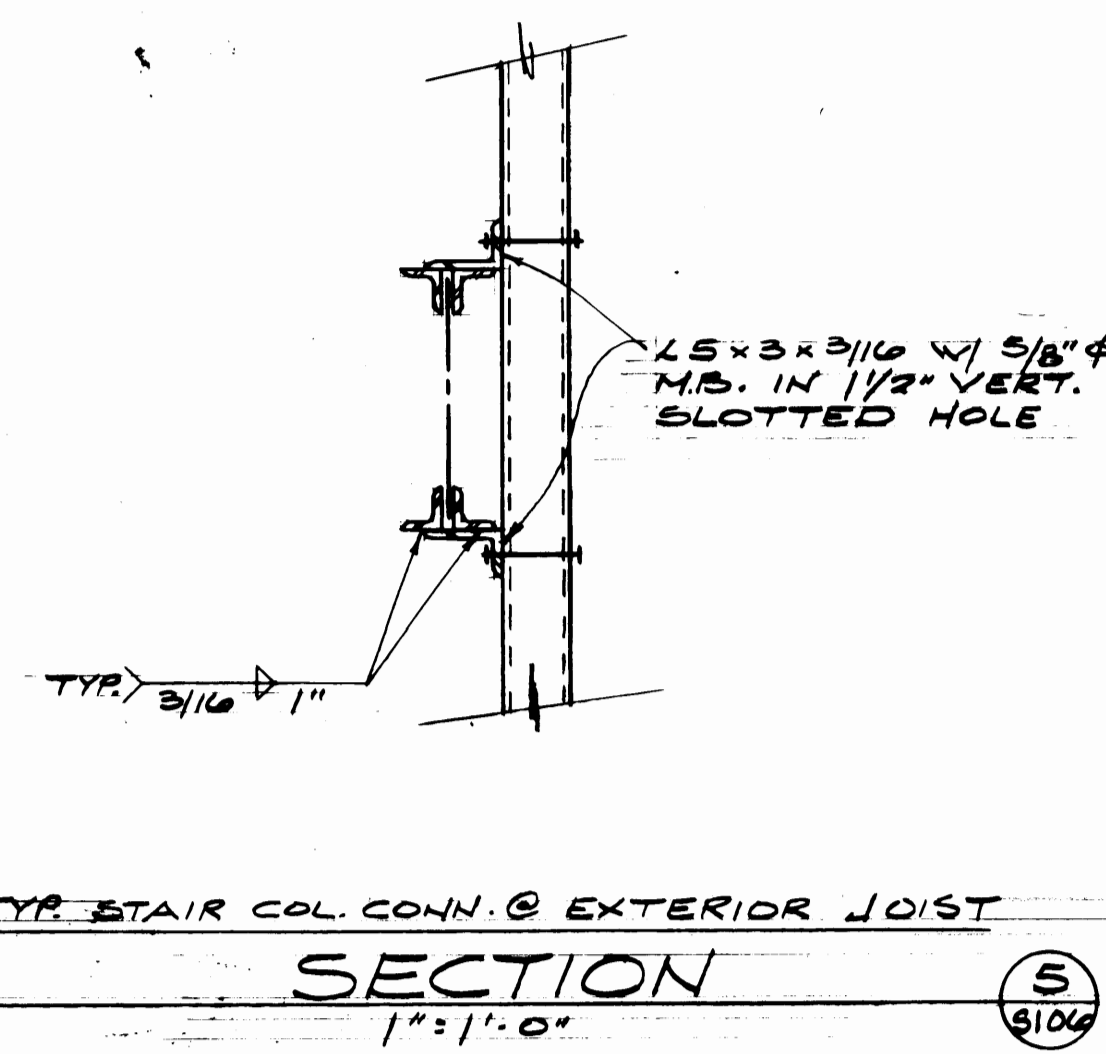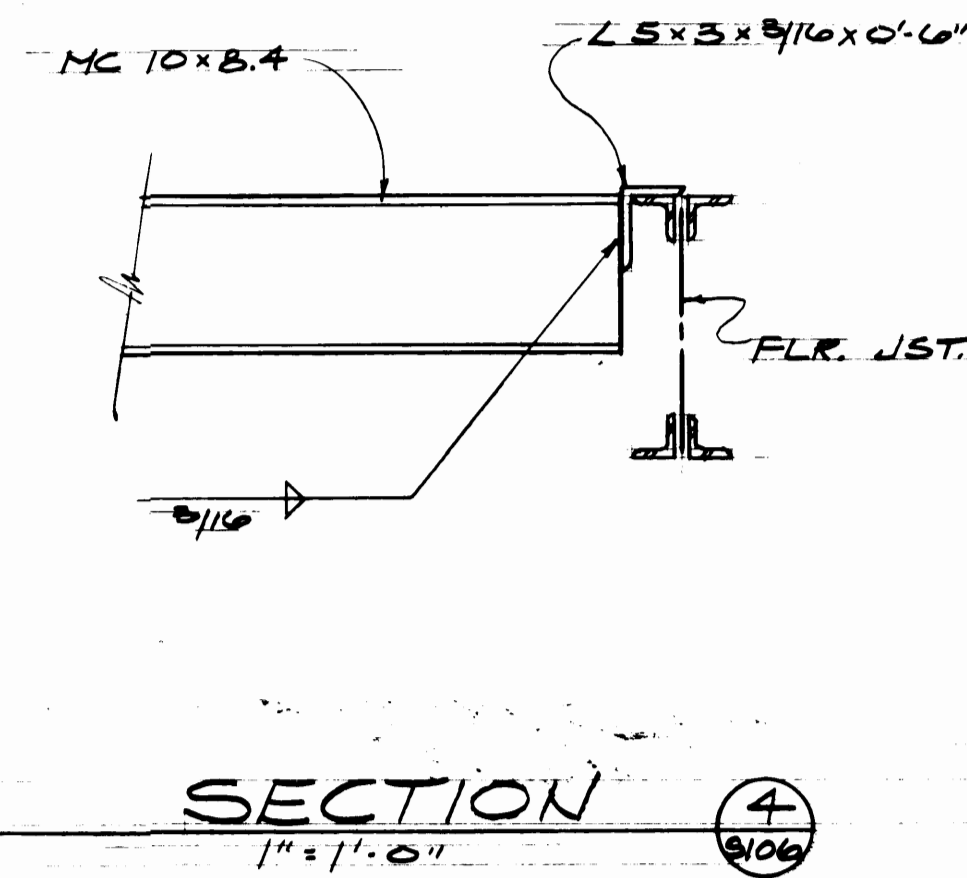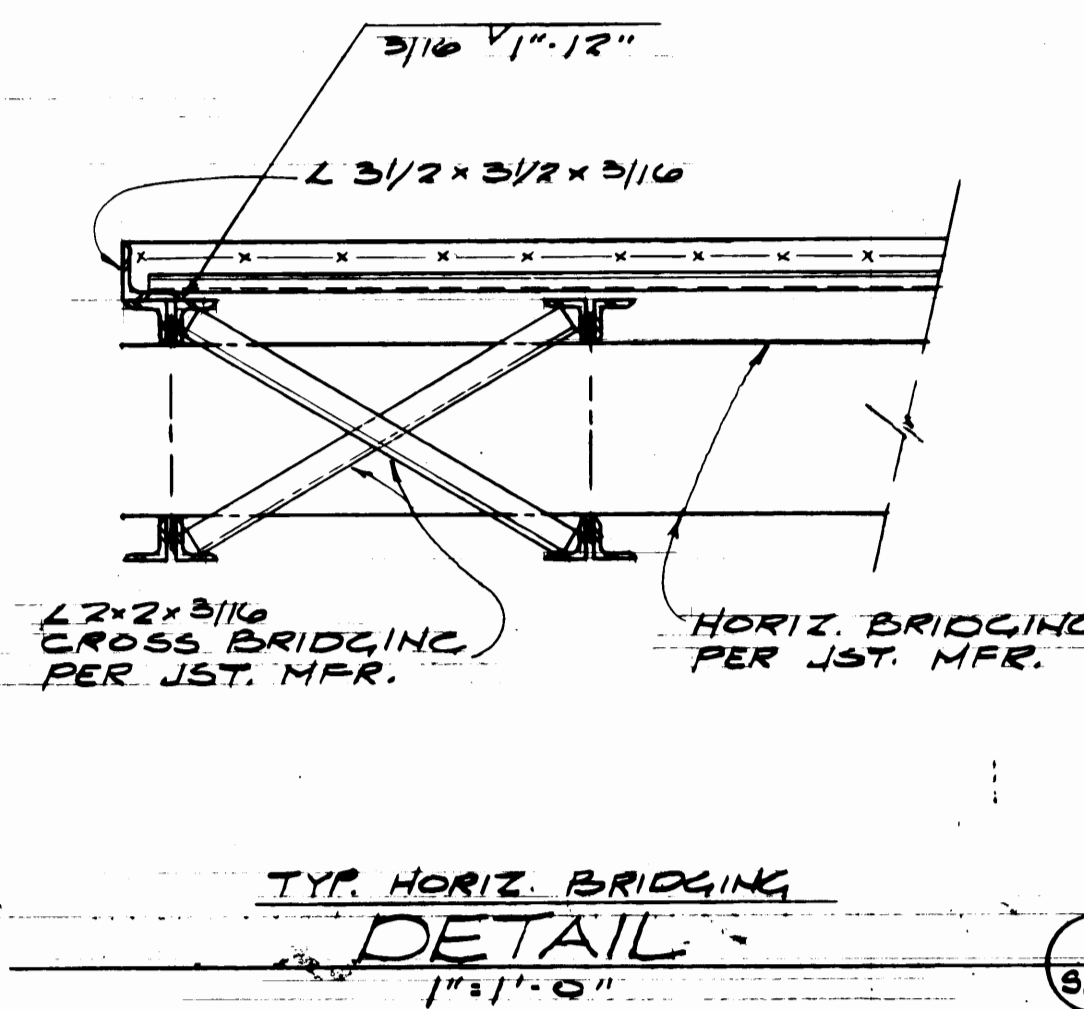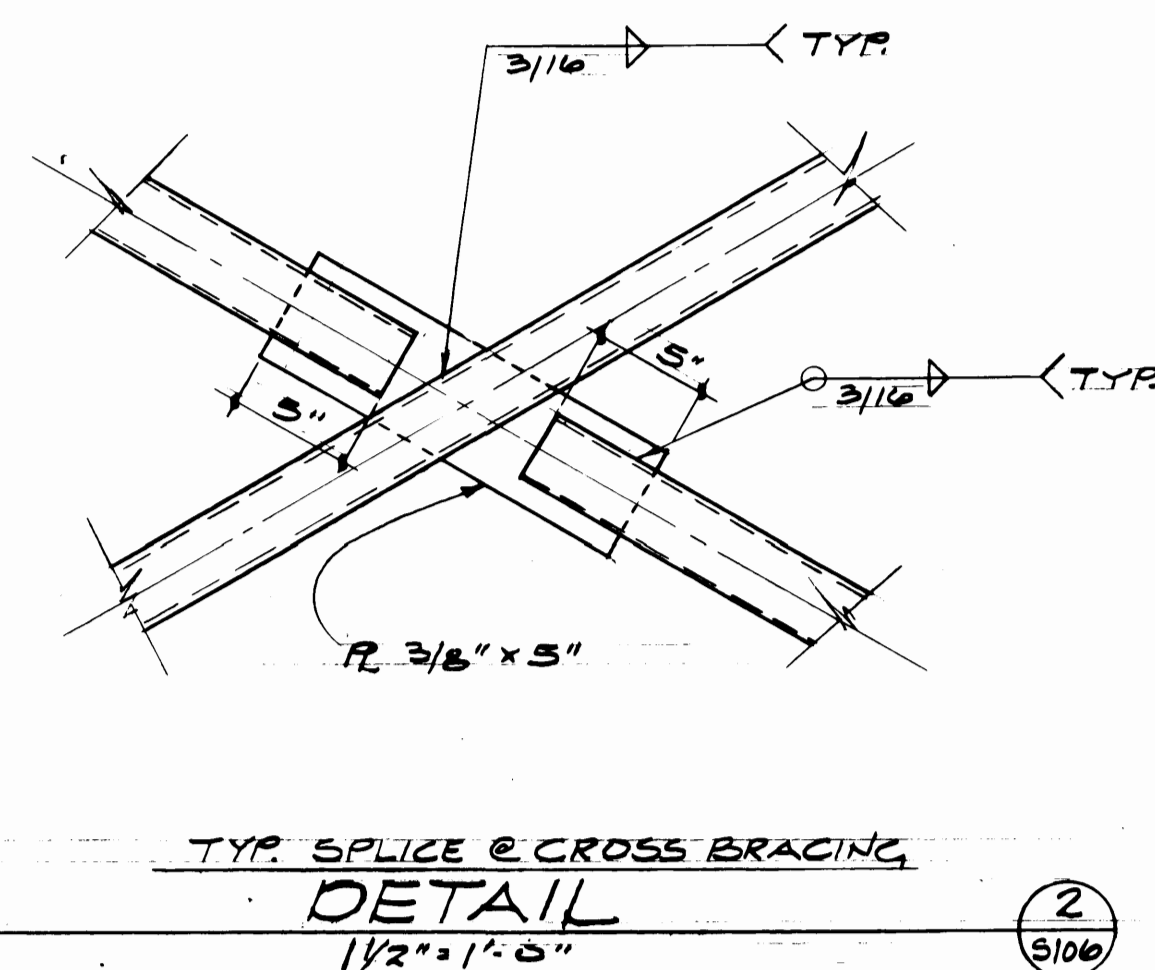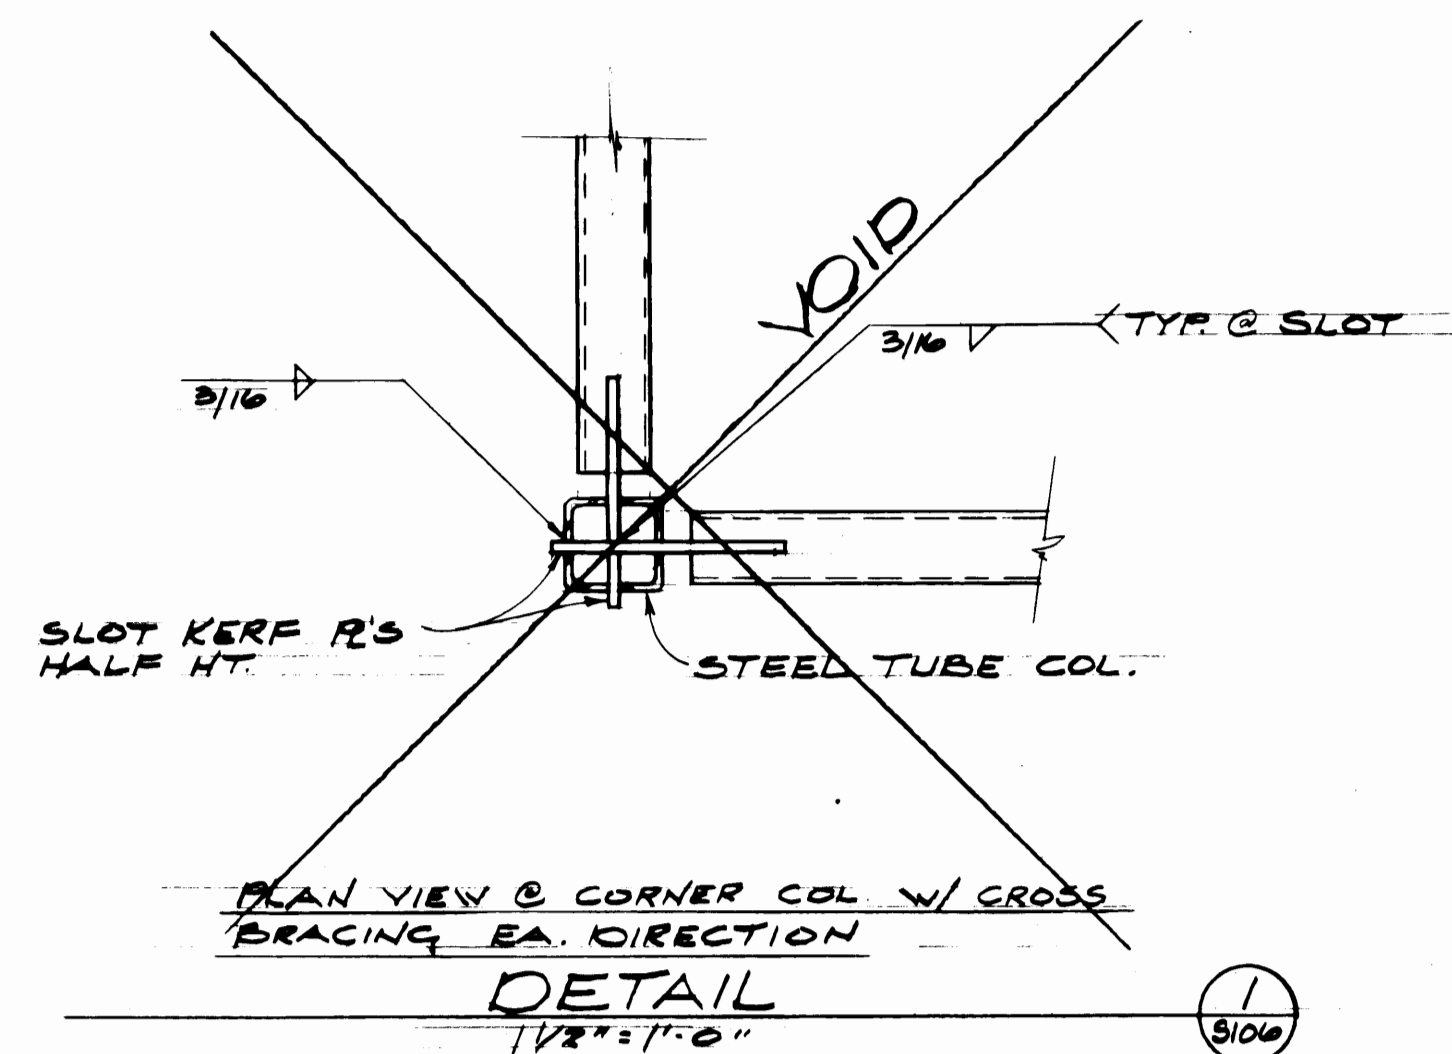


Robert L. Smith
Consulting Engineer
51 University, Suite 301
Tacoma, WA 98401
(206) 865-4118
1800 So. Fremont, Suite 301
Tacoma, WA 98402
(206) 865-4797

MARK	REVISION	BY	APP.	DATE
	NO AS-BUILT REVISIONS	R.L.S.		3/31/84


DRAWN: N.N.		DATE: 3-22-84	
CHECKED: D.S.		DATE: 3-22-84	
CHECKED: D.P.		DATE: 3-22-84	
CONT. NO. 527		FIELD BOOK (S)	
APPROVED: [Signature]		DATE: 3/30/84	
PROJECT MANAGER: [Signature]		DATE: 3/30/84	
CHIEF ENGINEER: [Signature]		DATE: 3/30/84	

PORT OF TACOMA	
TACOMA TERMINALS, INC.	
C.F.S. BUILDING	
MEZZANINE DETAILS	



SCALE	DRAWING NO.
	EP 3879-25-5100
SHEET 22	OF 71

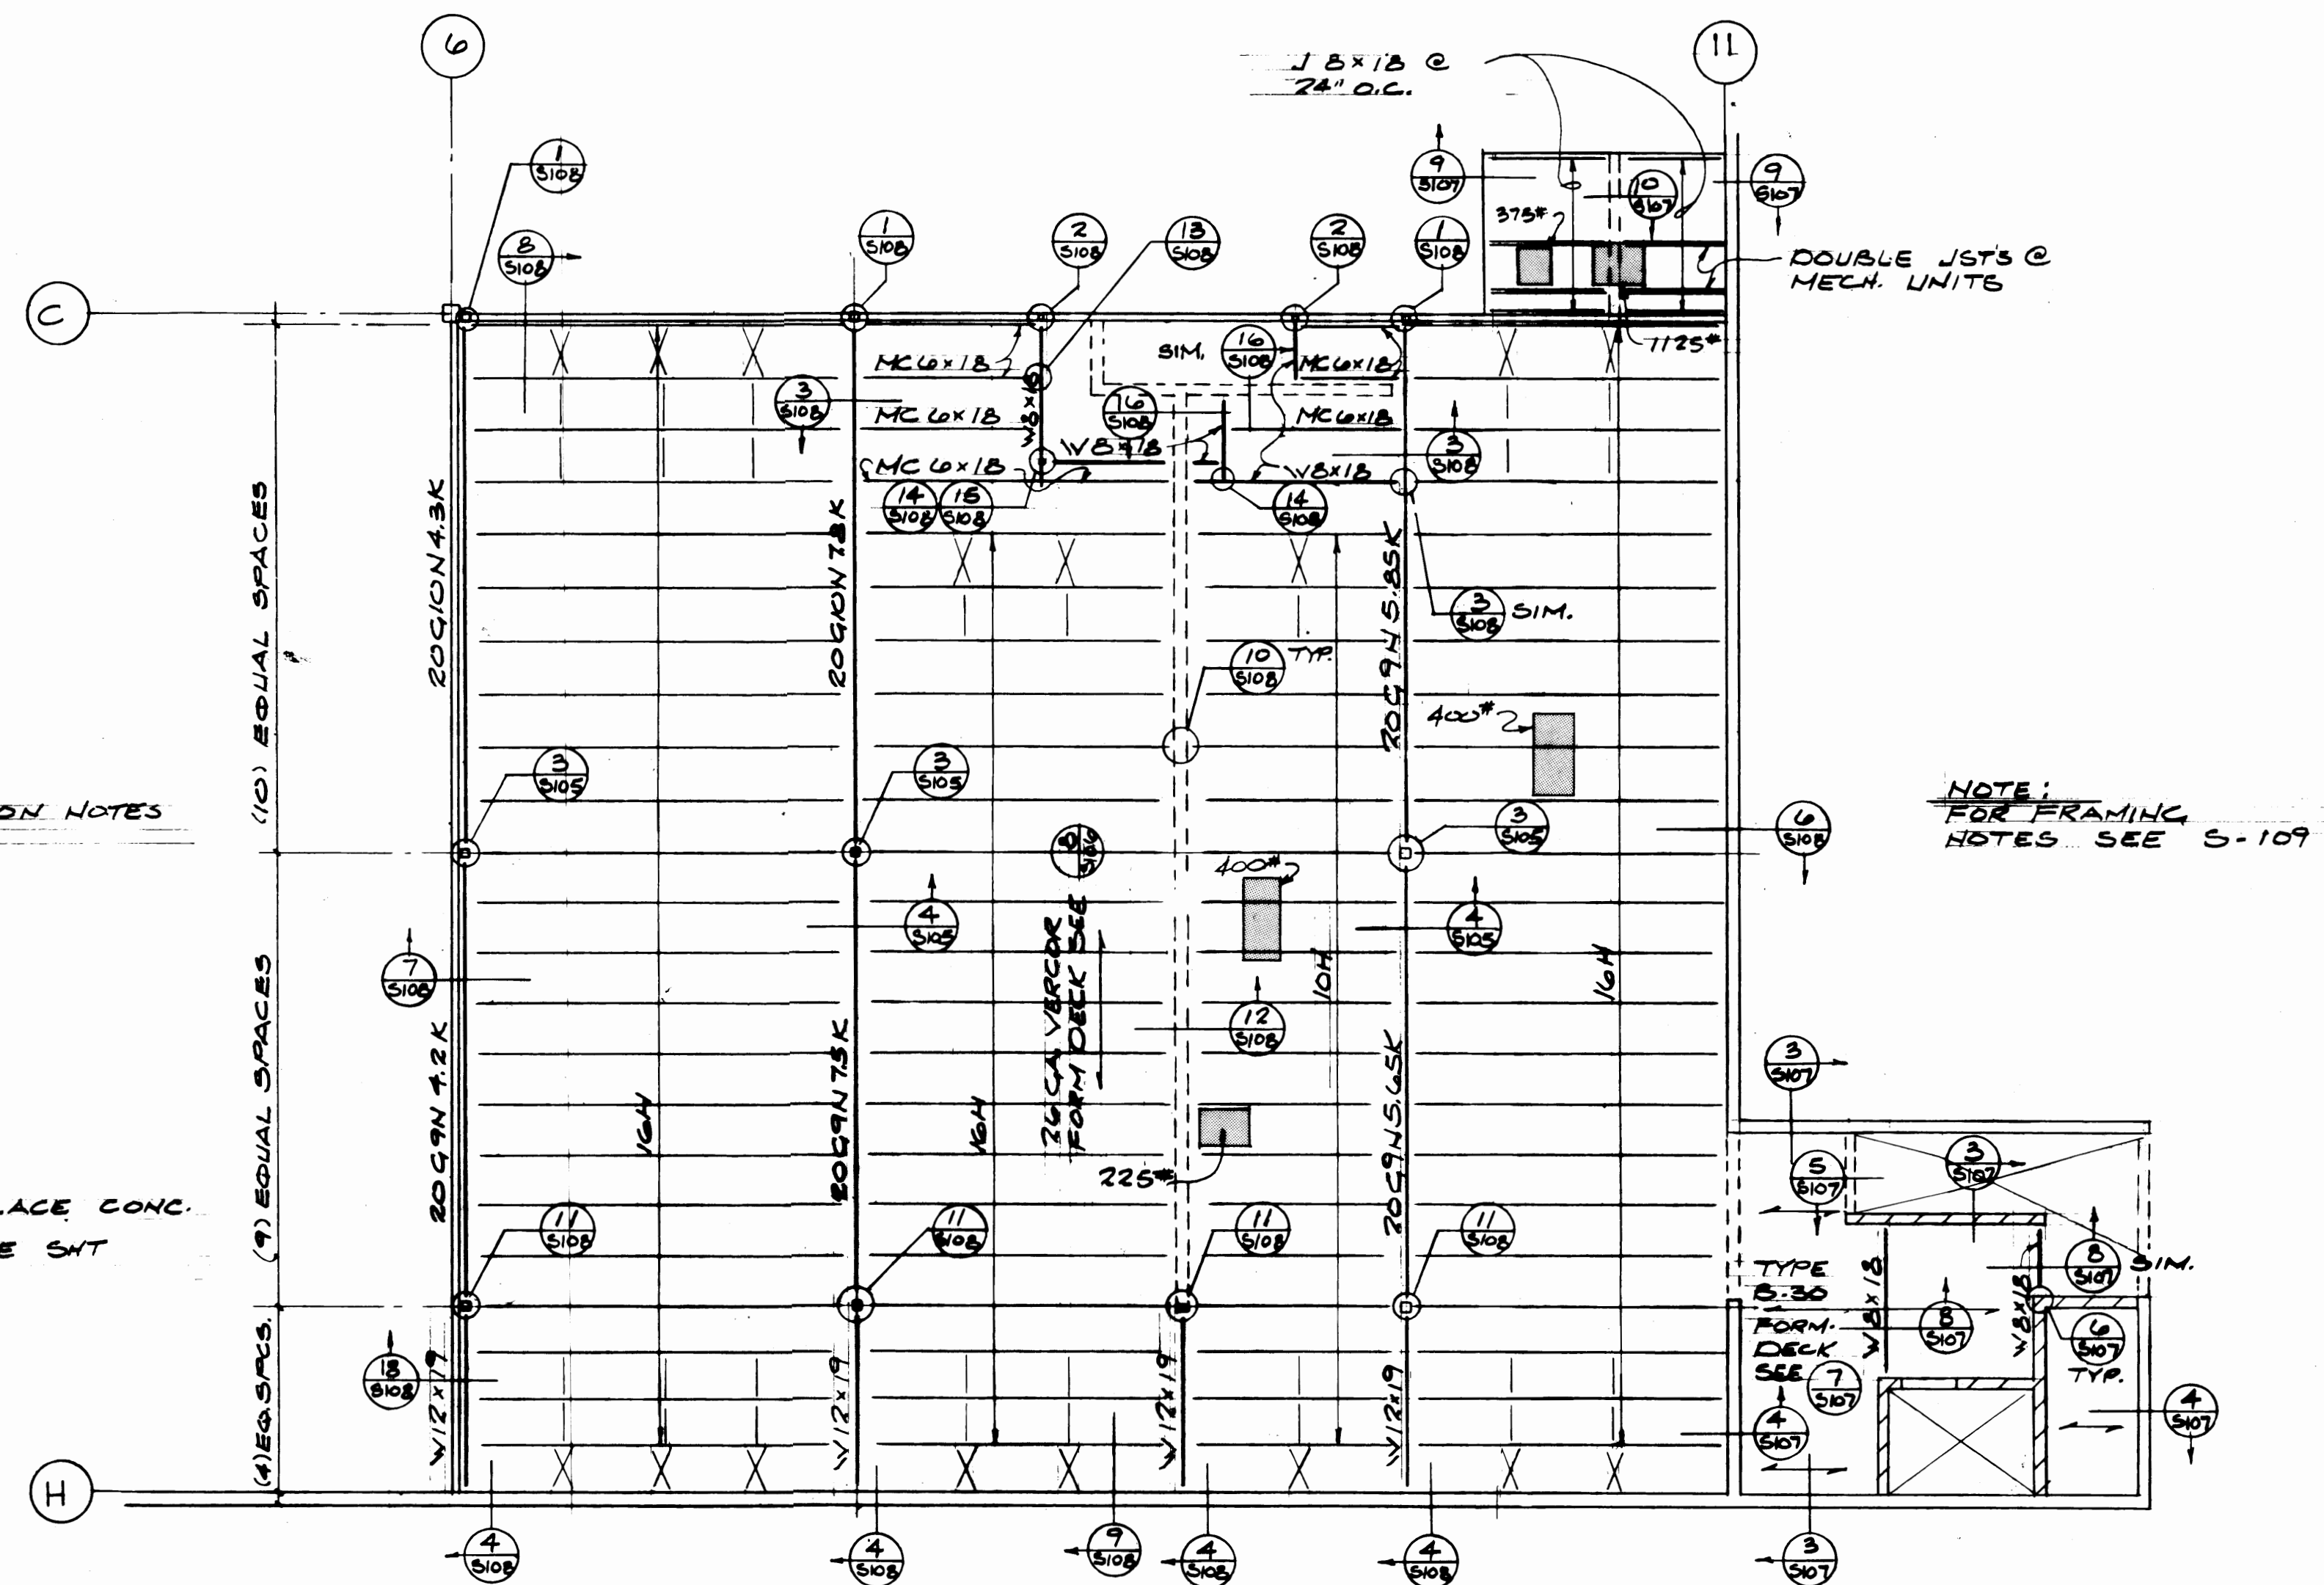


SECOND FLOOR-OFFICE FRAMING

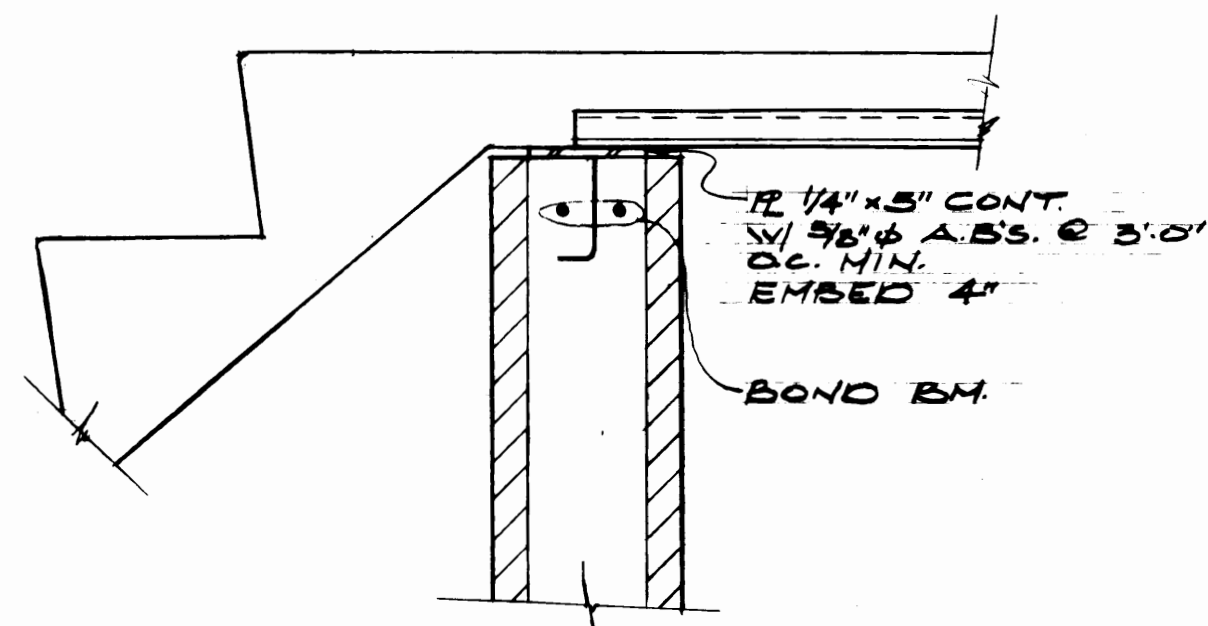


TYP. METAL DECK PERPENDICULAR
TO LEDGER ANGLE CONN.

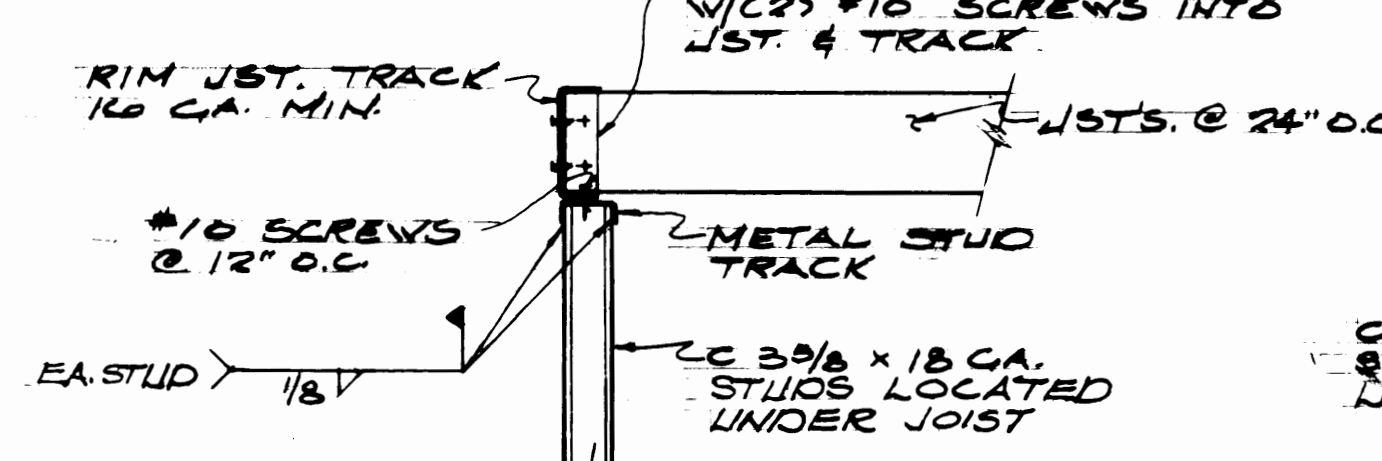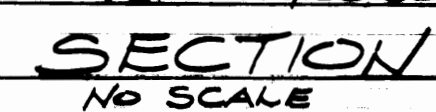

SECTION

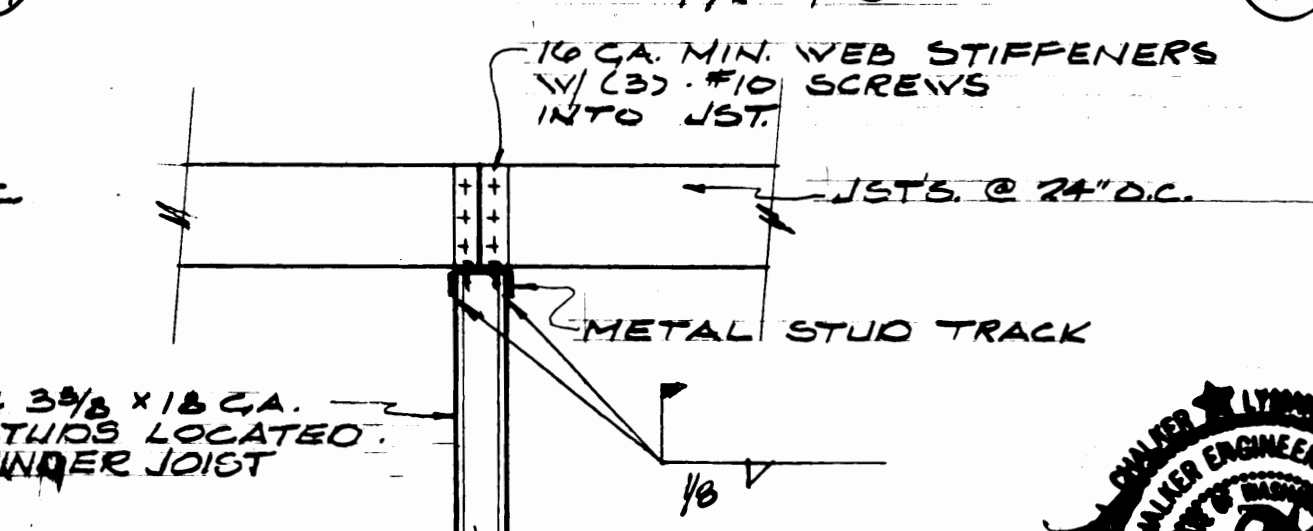

SECTION

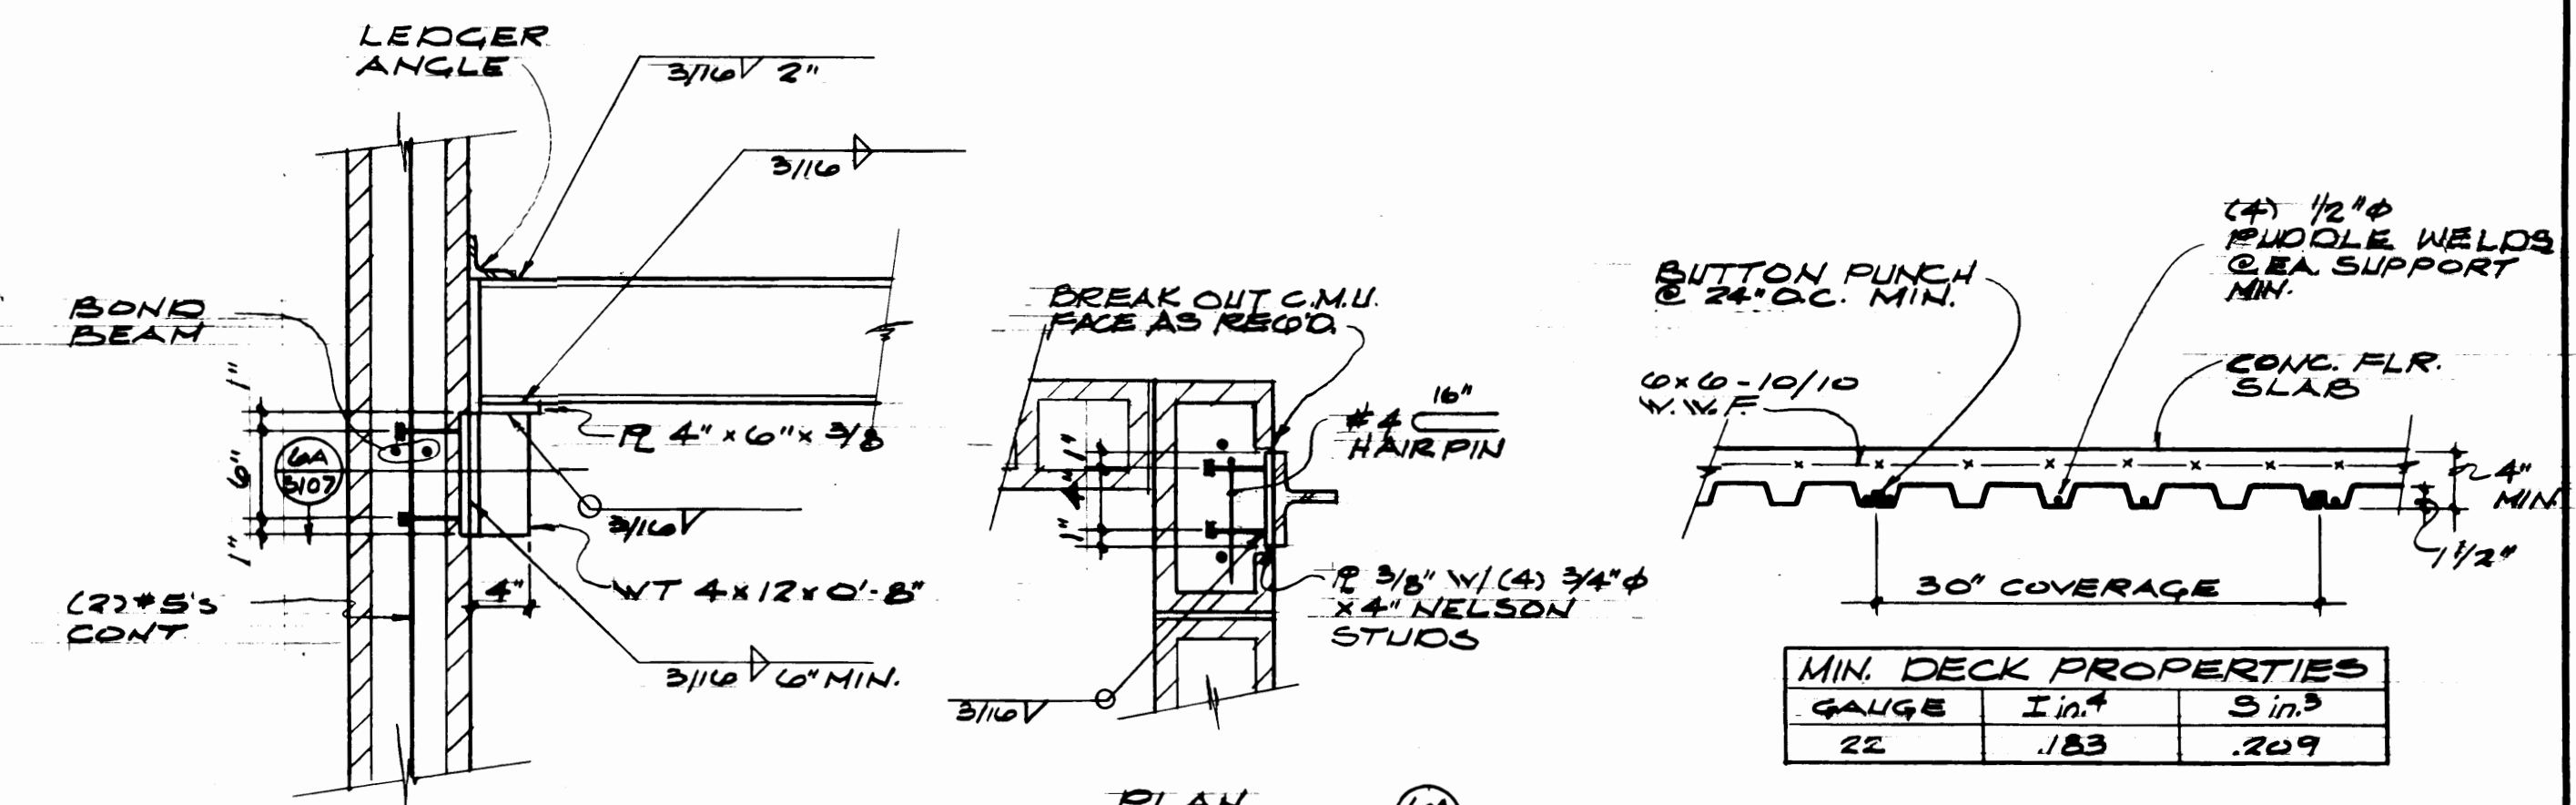


SECTION
1" = 1' 0"

TYP. COMPOSITE FLR. DECK
SECTION
1/8" SCALE


MIN. DECK PROPERTIES		
GAUGE	I in. ⁴	S in. ³
22	.183	.209

DRAWN <u>N.N.</u> DATE <u>3-22-84</u> CHECKED <u>B.S.</u> DATE <u>3-22-84</u> CHECKED <u>D.B.</u> DATE <u>3-22-84</u> CONT. NO. <u>557</u>	PORT OF TACOMA TACOMA TERMINALS, INC. C.F.S. BUILDING OFFICE FOUNDATION & 2nd FLOOR FRAMING PLAN	
FIELD BOOK (S) APPROVED 	DATE <u>3/30/84</u>	SCALE DRAWING NO. <u>EP 3579-23 - 5577</u>
PROJECT MANAGER  CHIEF ENGINEER	DATE <u>3/30/84</u>	SHEET <u>23</u> OF <u>71</u>

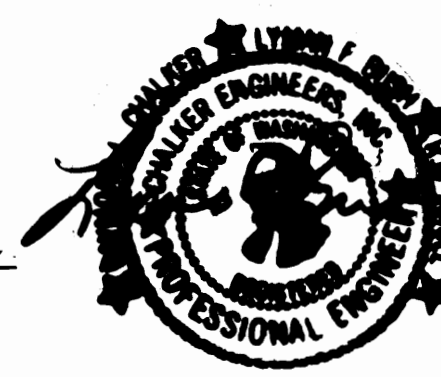


Chaffee Engineers, Inc.
Consulting Engineers
51 University, Suite 301
Seattle, WA 98101
(206) 622-4116


980 So. Fawcett, Suite 301
Tacoma, WA 98402
(206) 383-8787

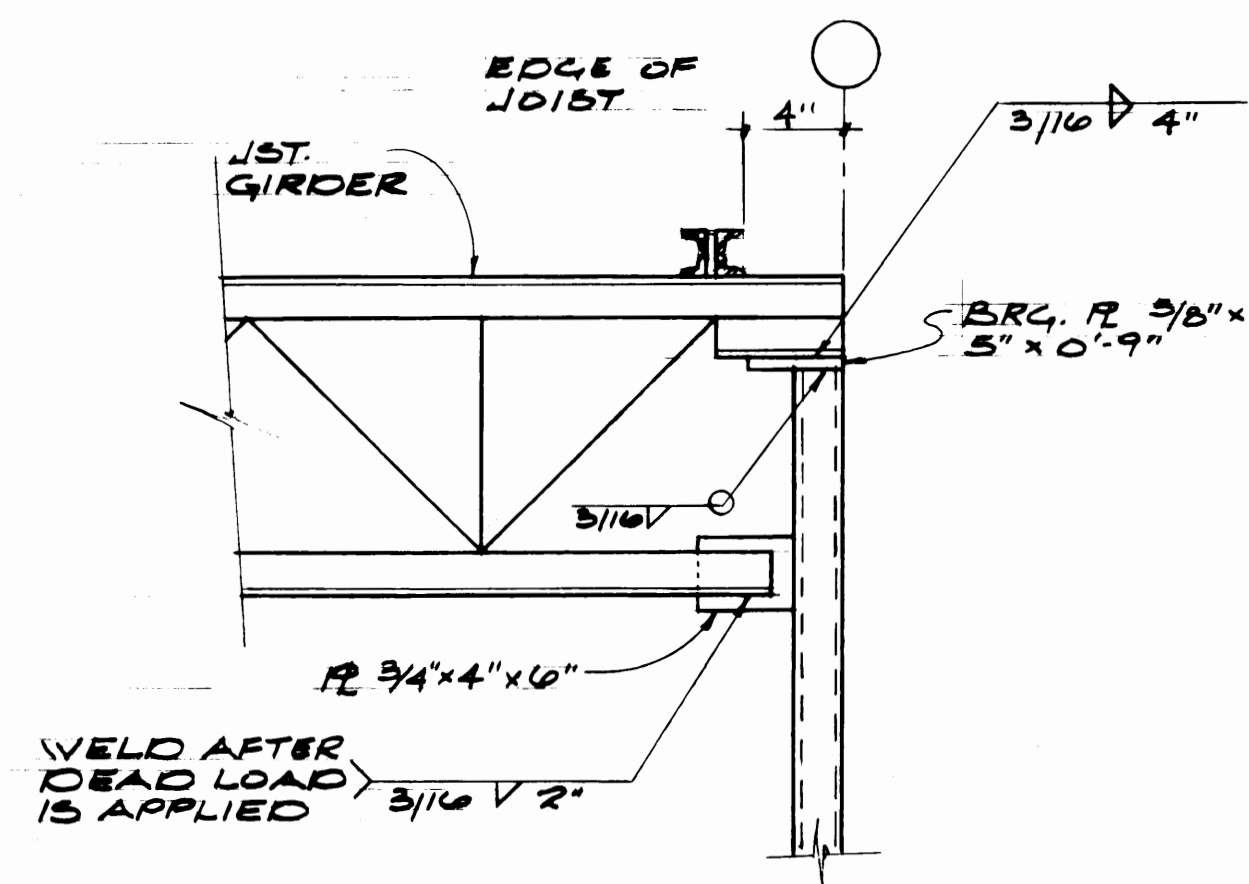


SECTION 1
1/2" x 1'-0"

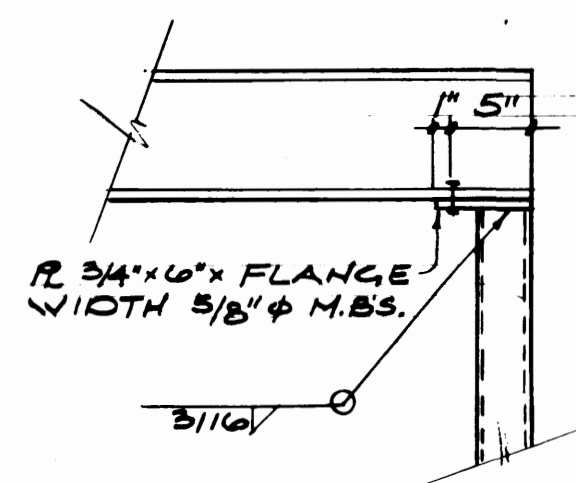


SECTION 2
1/2" x 1'-0"

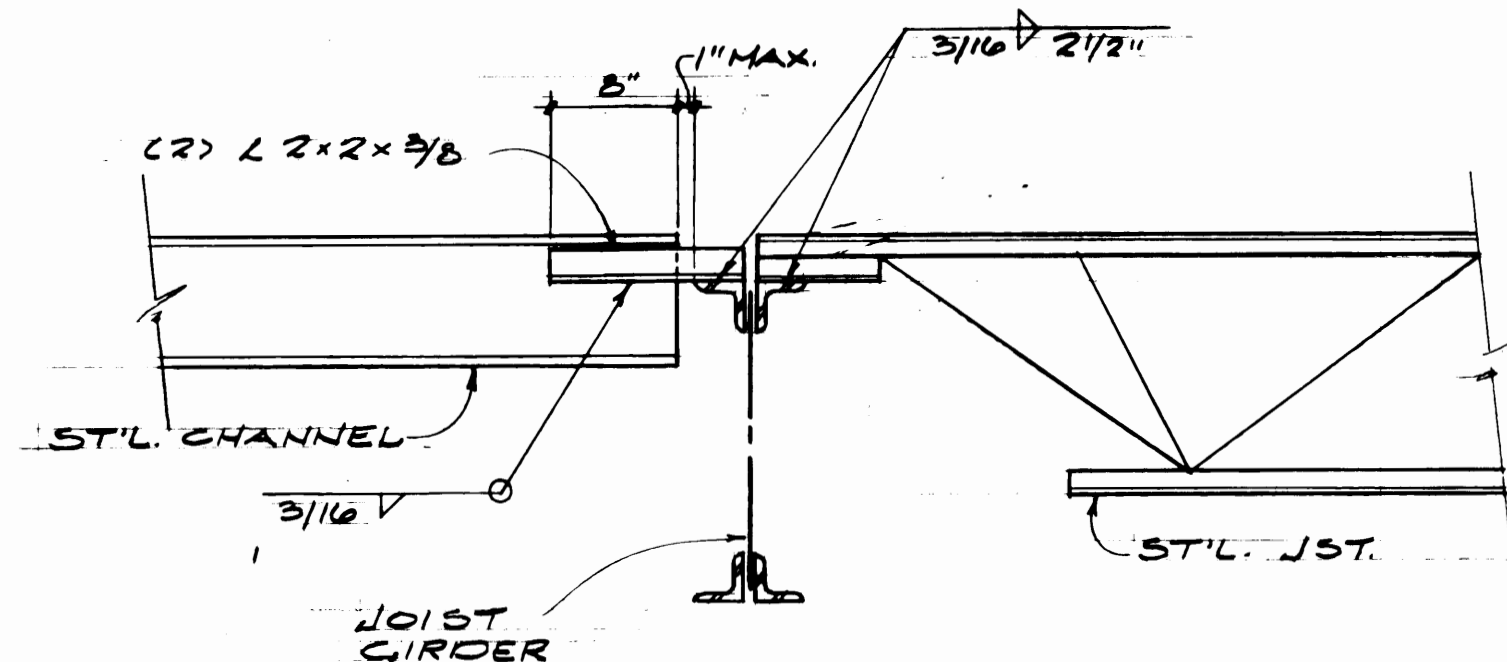


SECTION 3
1/2" x 1'-0"

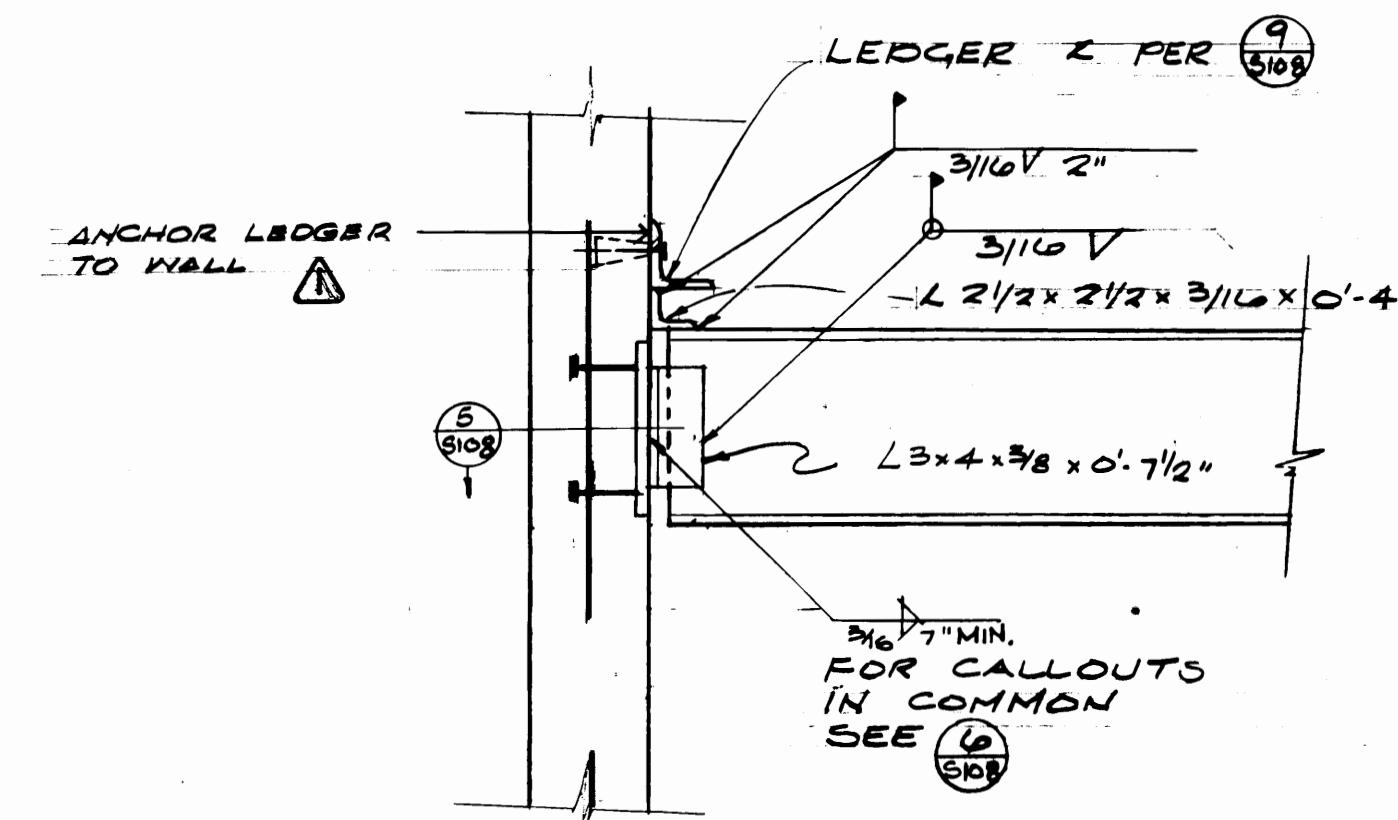


SECTION 4
1/2" x 1'-0"

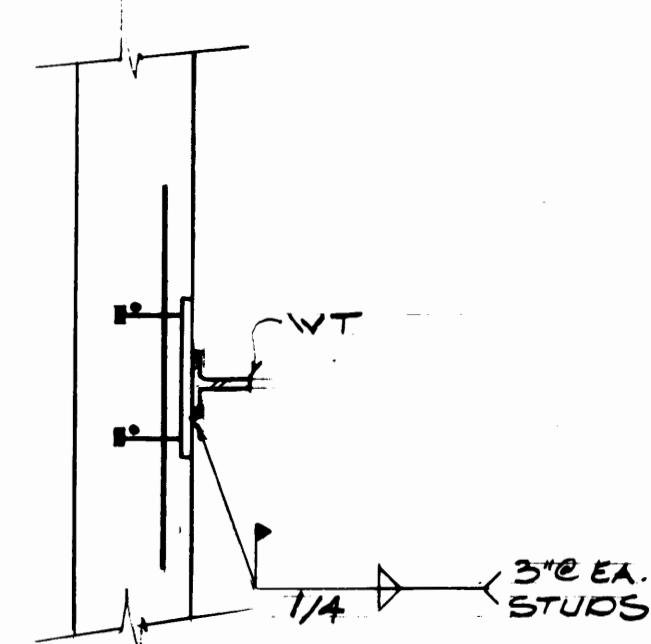


SECTION 5
1/2" x 1'-0"

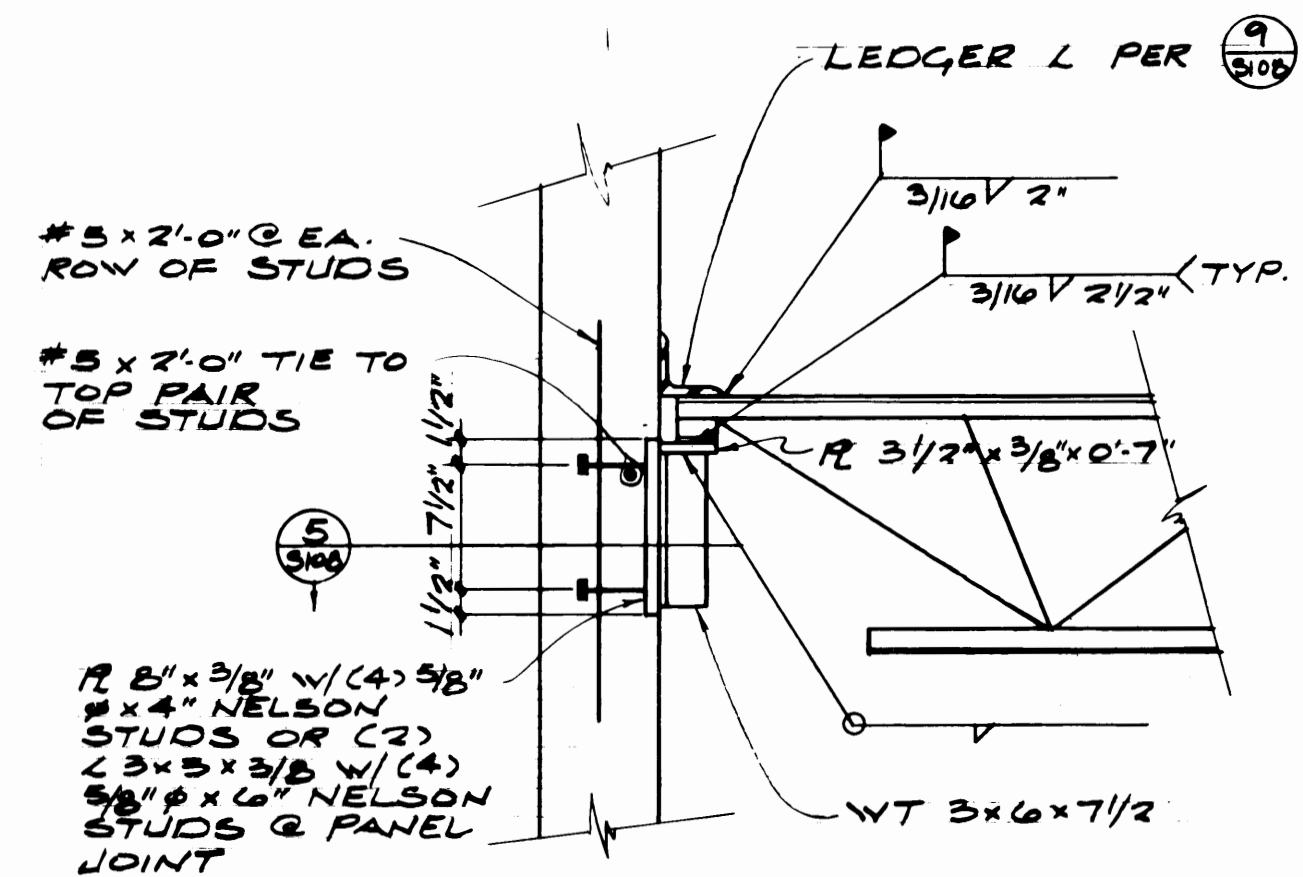


SECTION 6
1/2" x 1'-0"

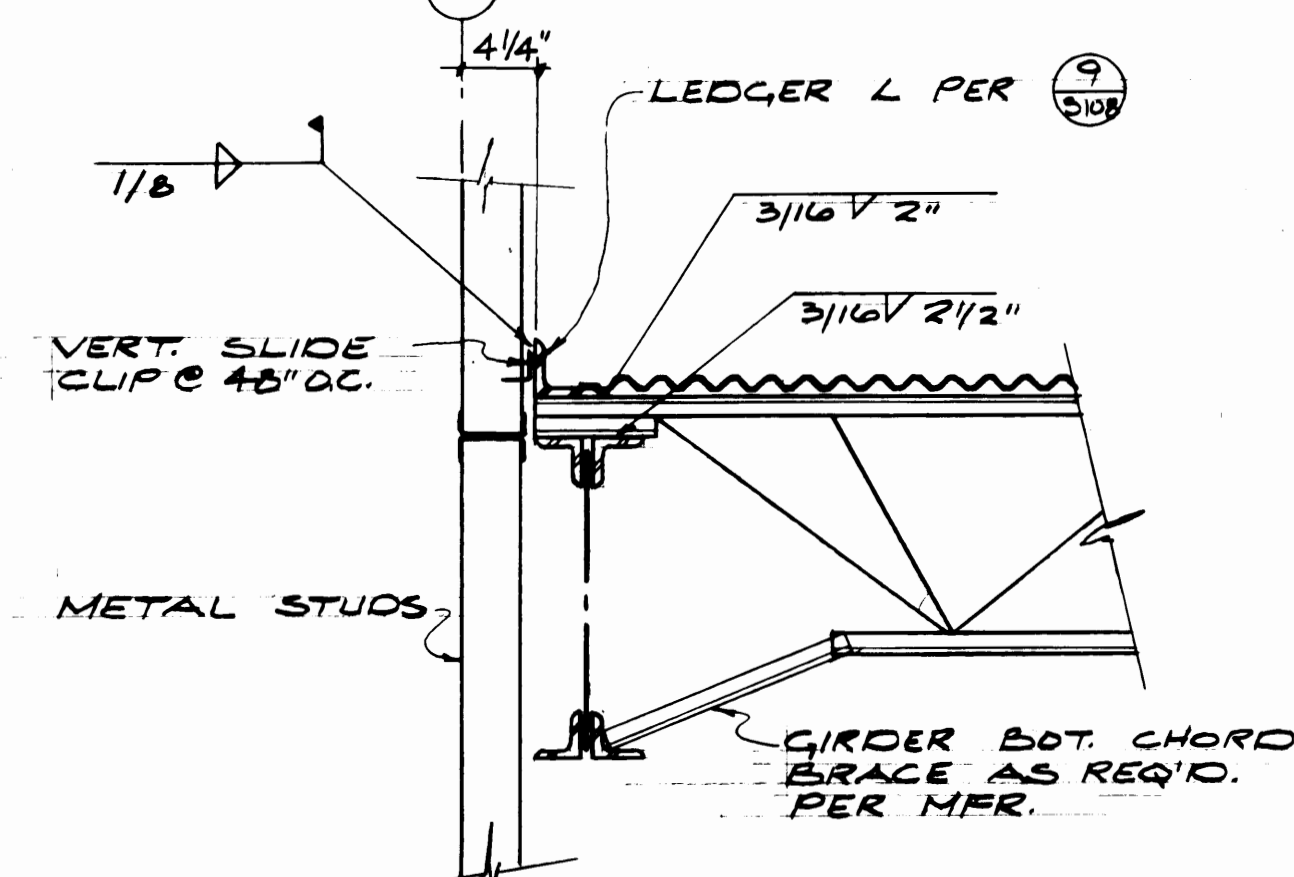


SECTION 7
1/2" x 1'-0"

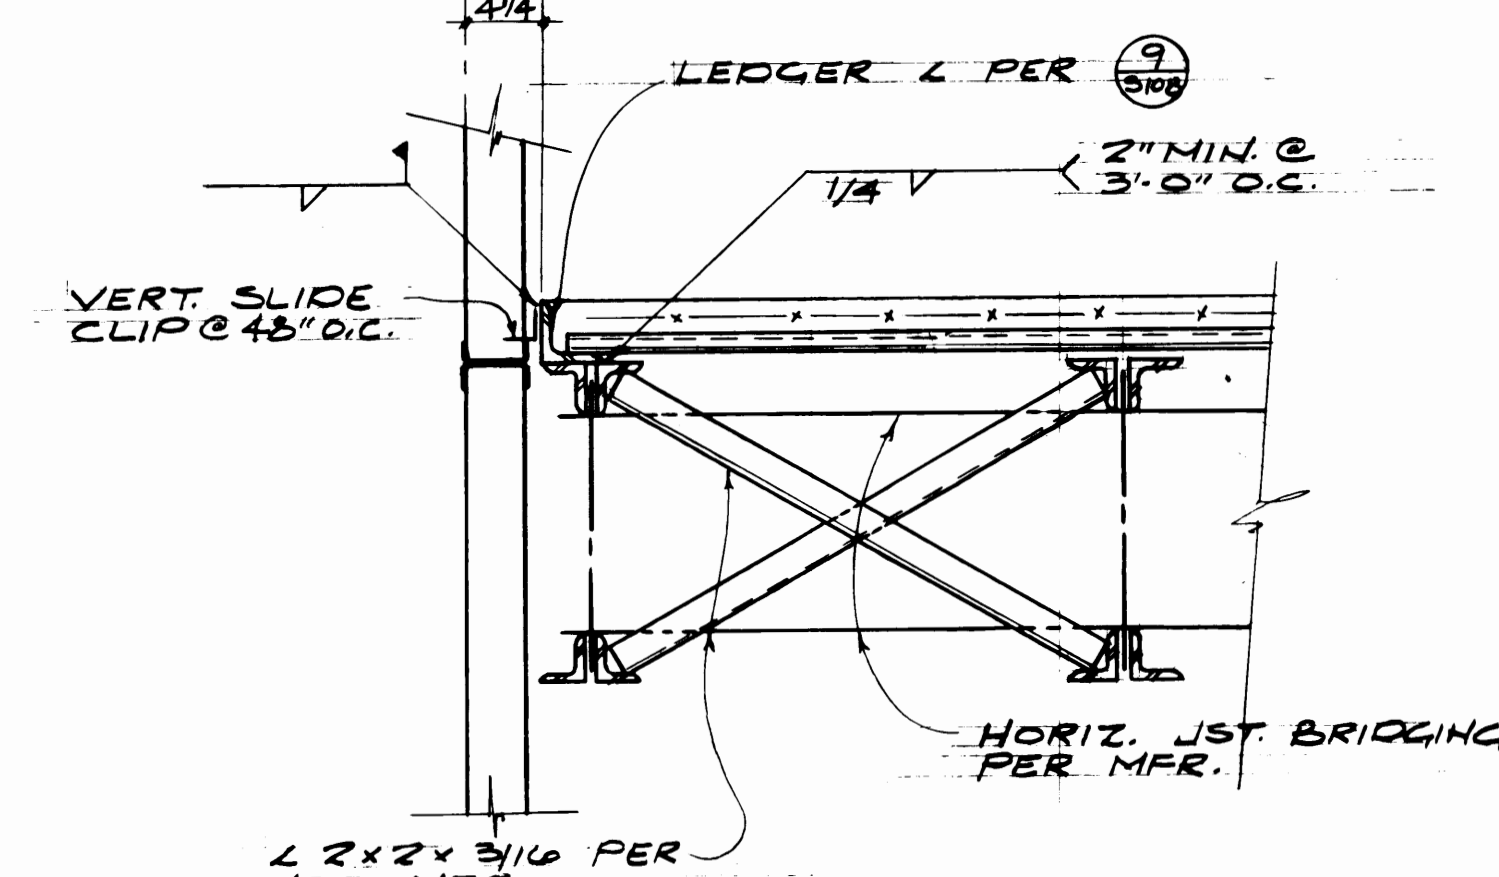


SECTION 8
1/2" x 1'-0"

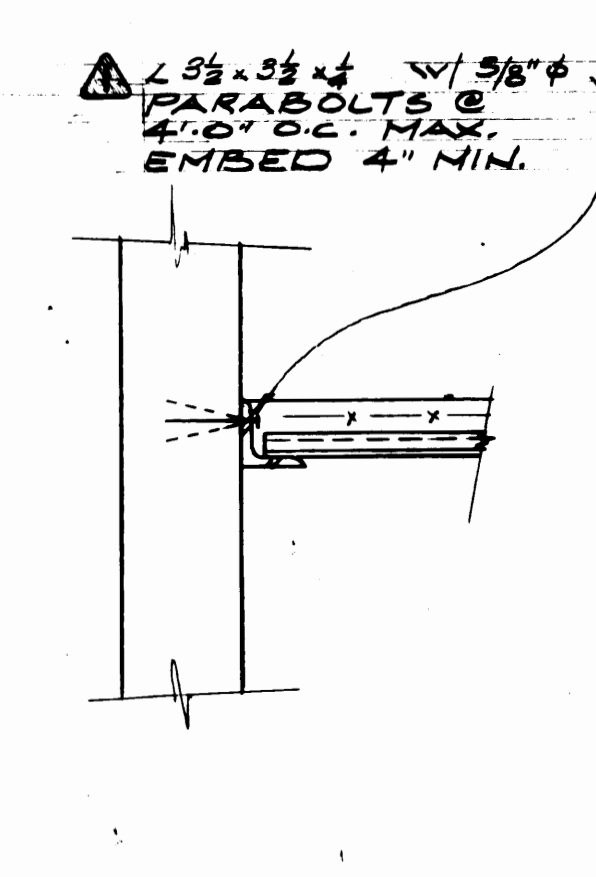


SECTION 9
1/2" x 1'-0"

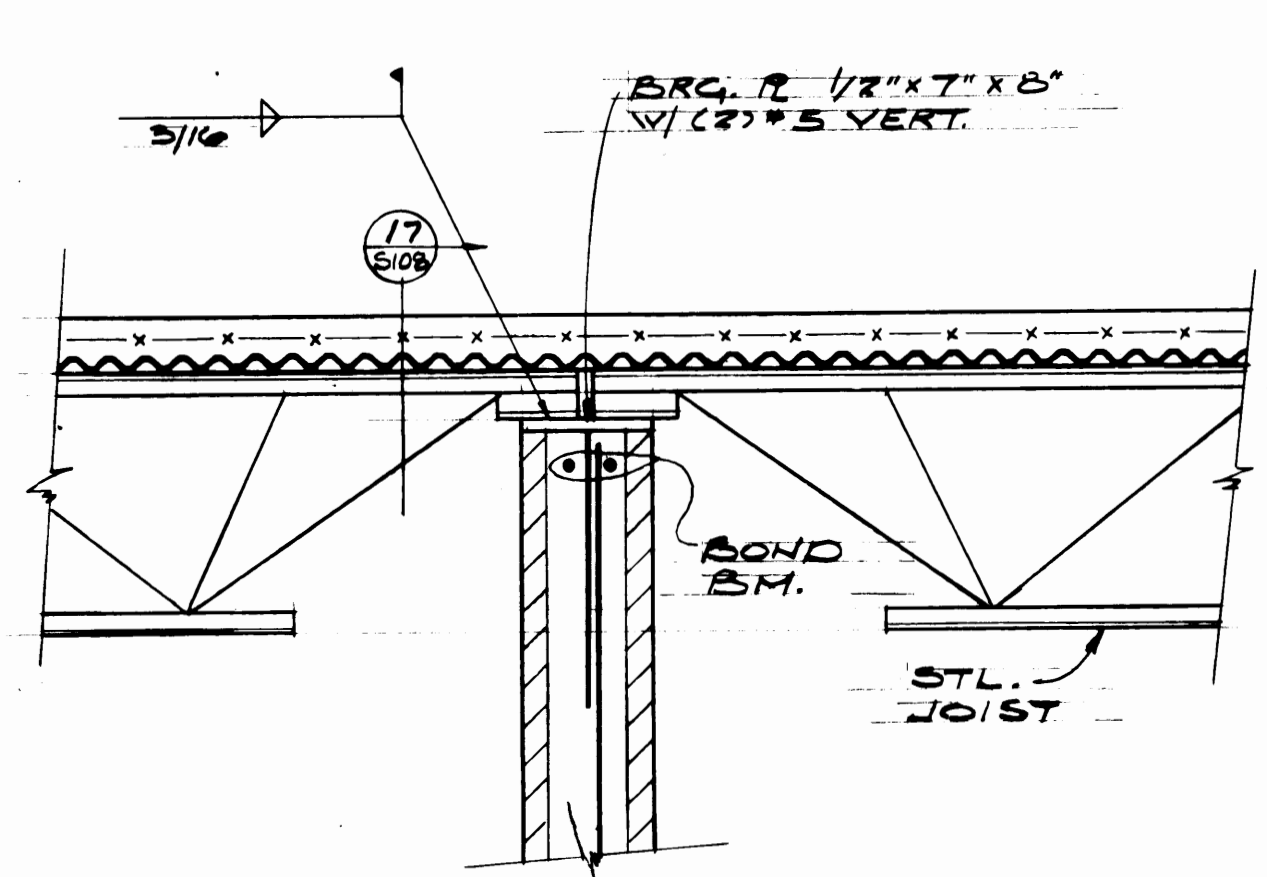


SECTION 10
1/2" x 1'-0"

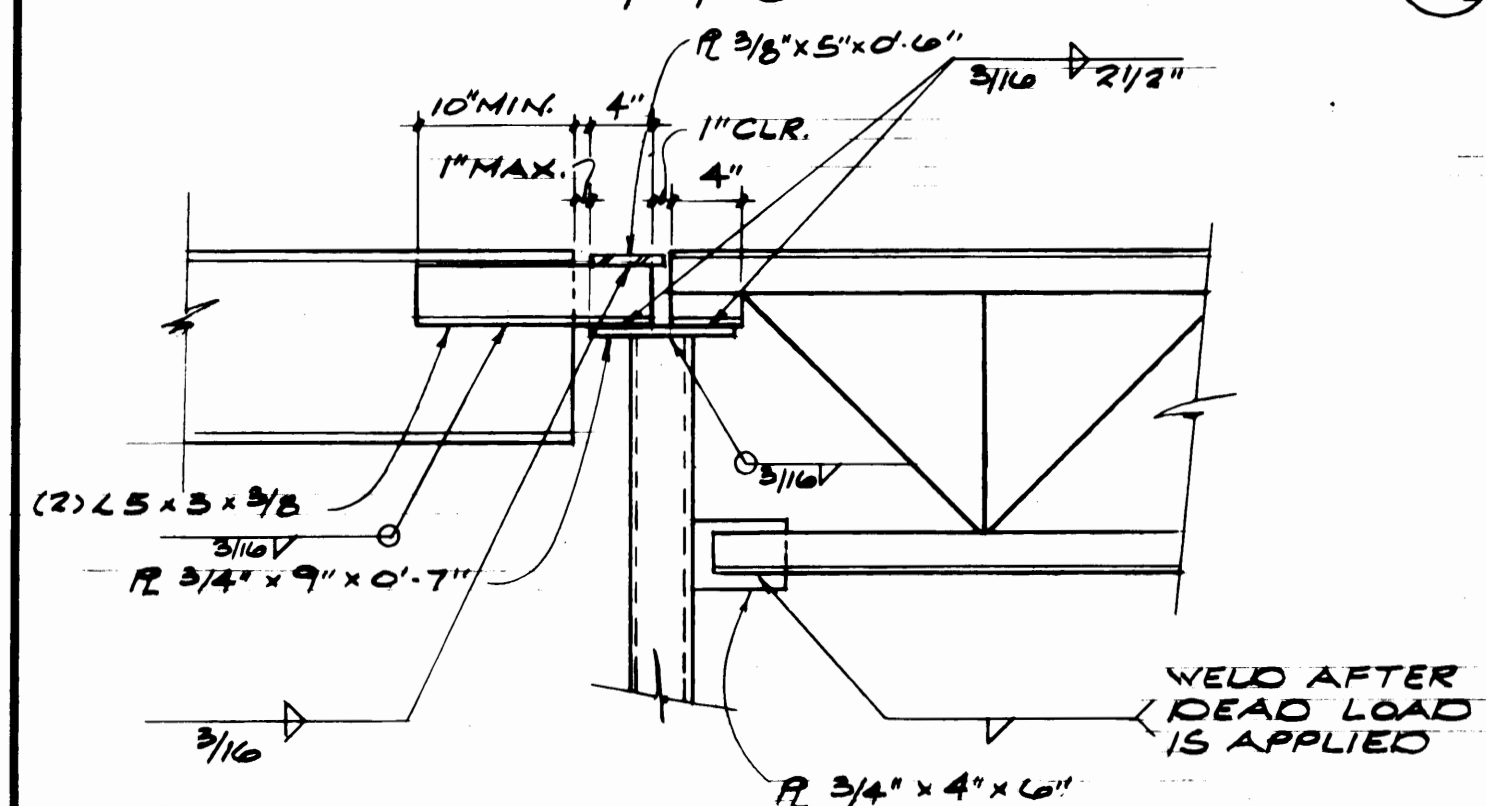


SECTION 11
1/2" x 1'-0"

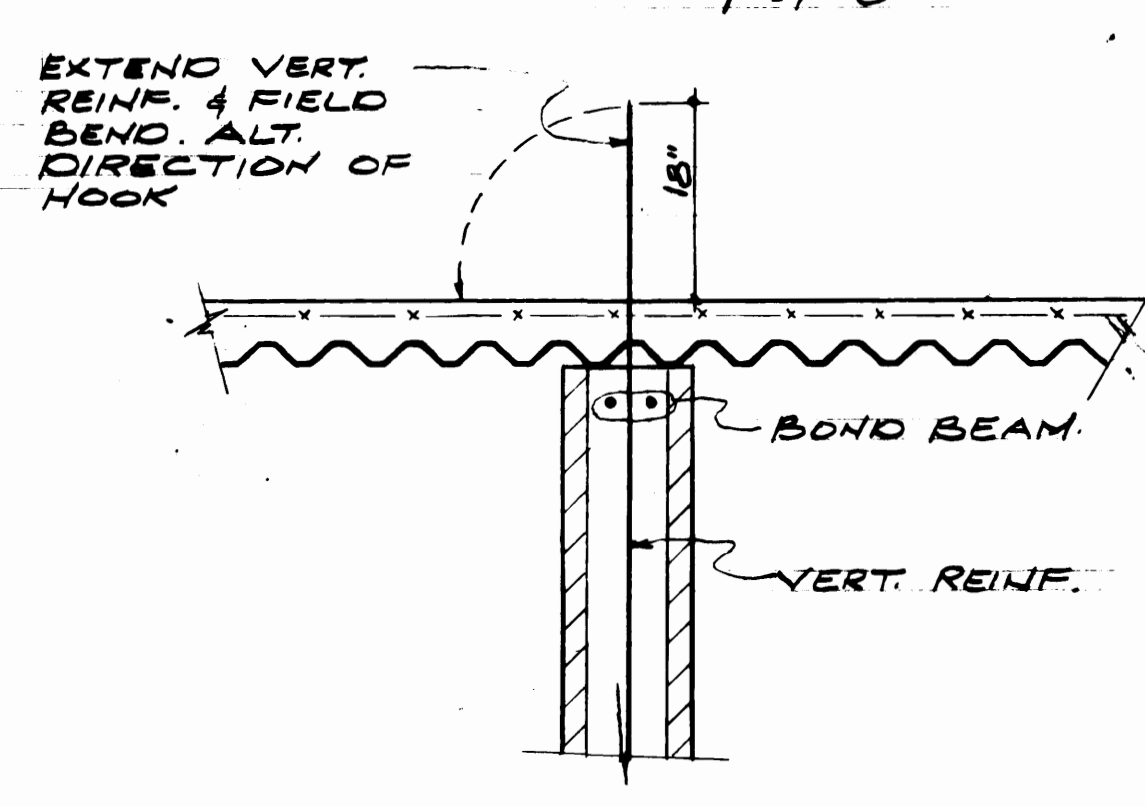


SECTION 12
1/2" x 1'-0"

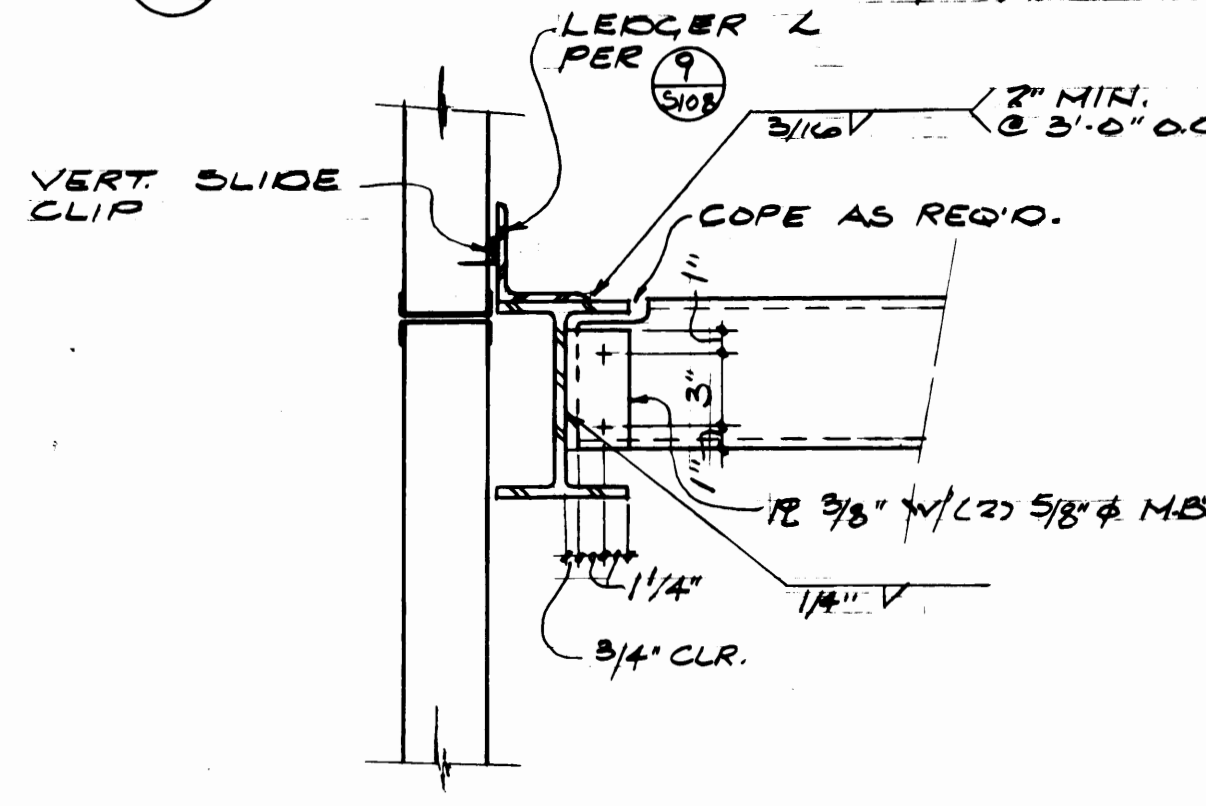


SECTION 13
1/2" x 1'-0"

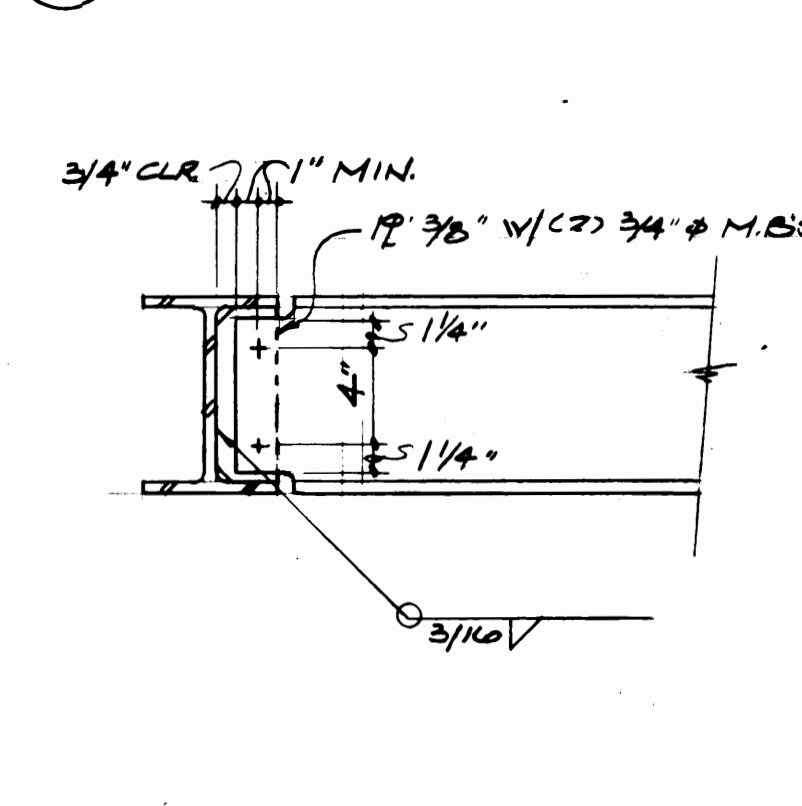


SECTION 14
1/2" x 1'-0"

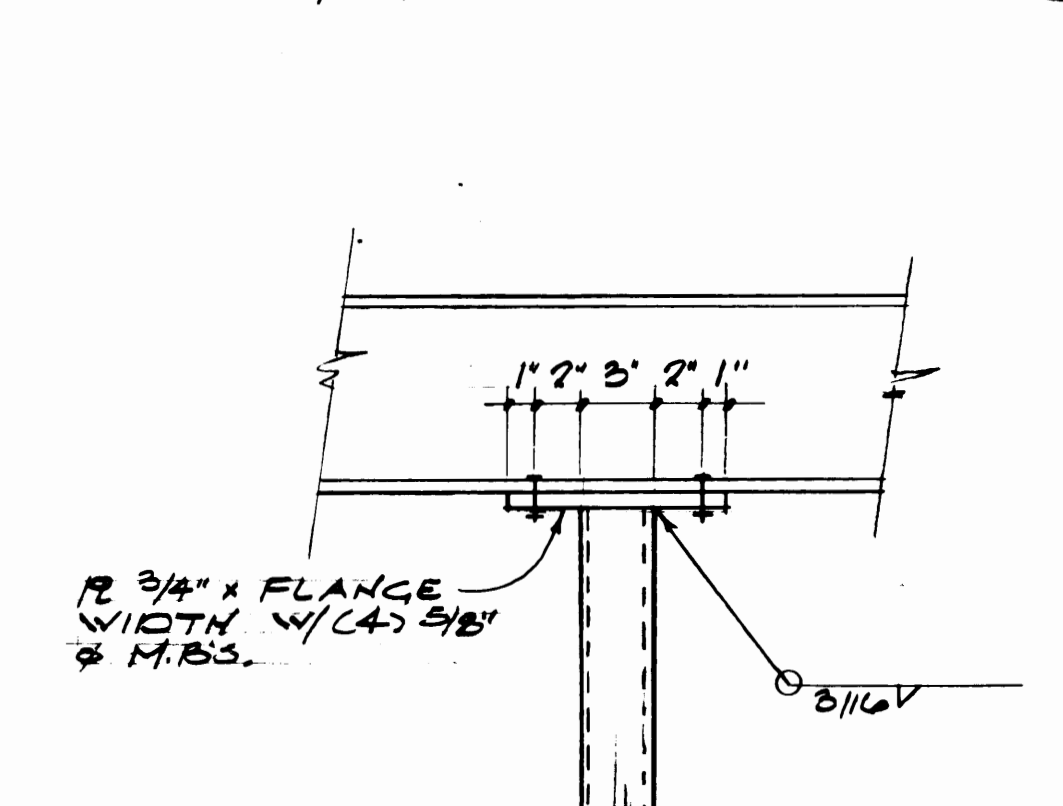


SECTION 15
1/2" x 1'-0"

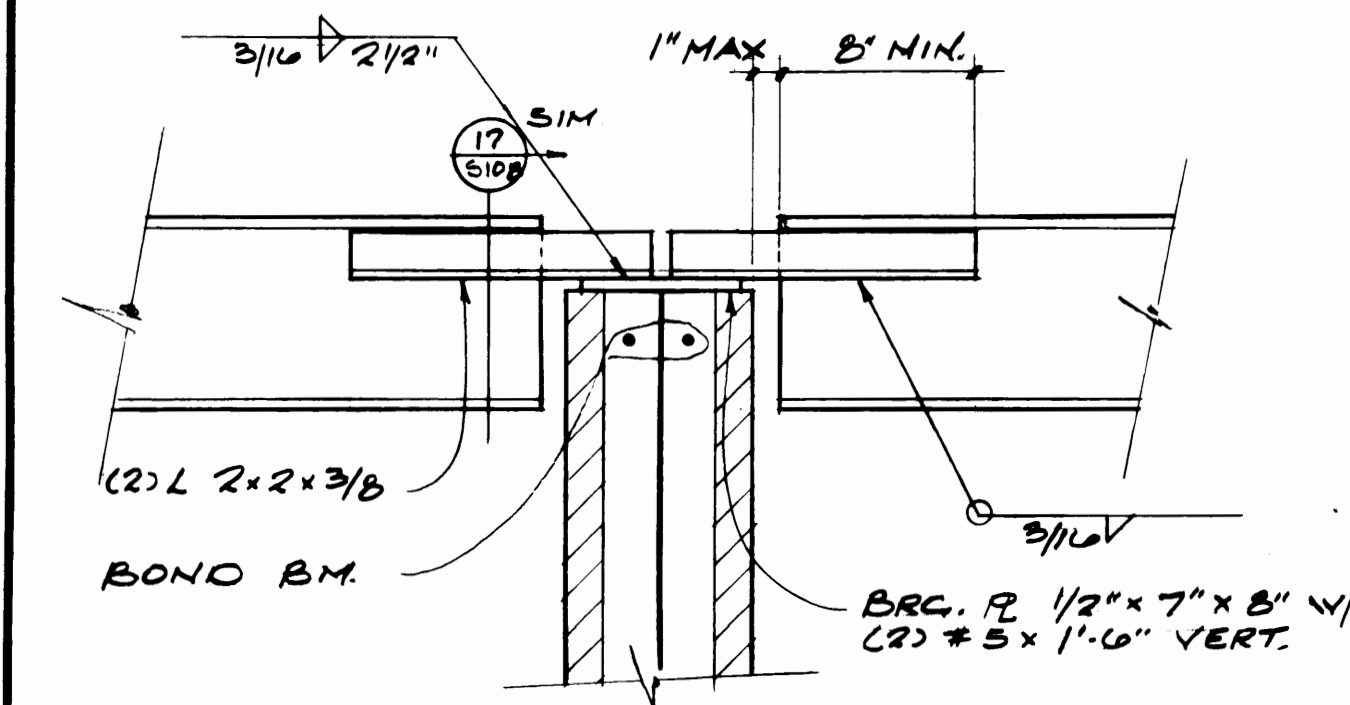

SECTION 16
1/2" x 1'-0"

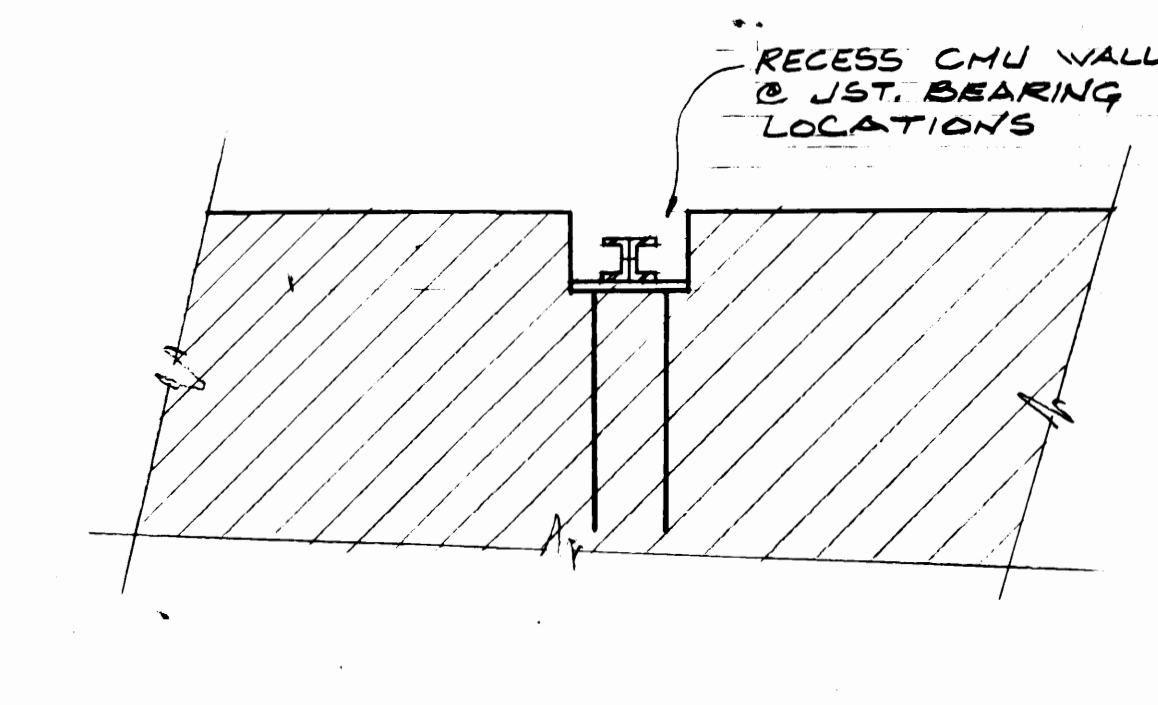

SECTION 17
1/2" x 1'-0"

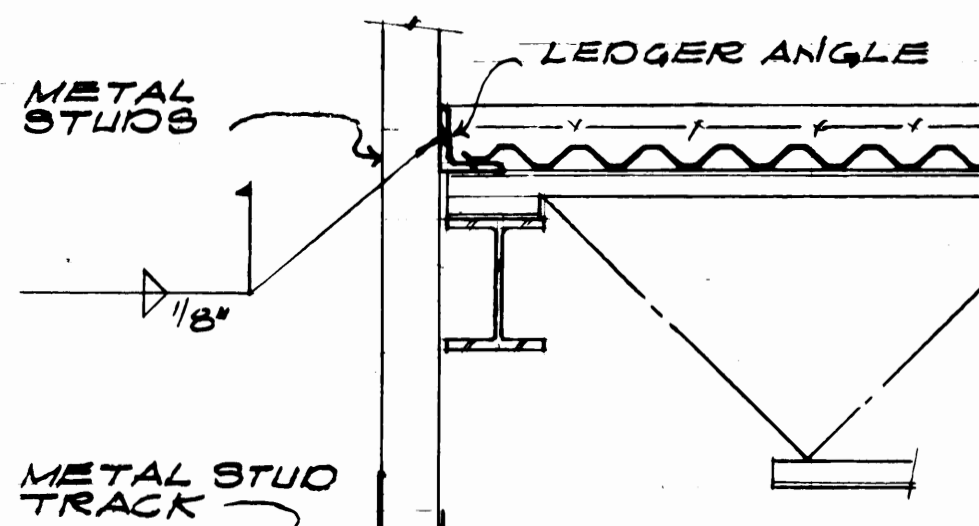


SECTION 18
1/2" x 1'-0"



Consulting Engineers, Inc.
51 University, Suite 301
Baltimore, MD 21201
(410) 528-4118
980 St. Francis, Suite 301
Tacoma, WA 98402
(206) 365-6787

MARK	REVISION	BY	APP.	DATE
	REVISED TO AS-BUILT.	R.J.S.		5-31-86


DRAWN: N.N.		DATE: 3-22-84	
CHECKED: D.S.		DATE: 3-22-84	
CHECKED: D.F.		DATE: 3-22-84	
CONT. NO. 557		FIELD BOOK (S)	
APPROVED: Robert L. Taylor		DATE: 3/30/84	
CHIEF ENGINEER		DATE: 3/30/84	
TACOMA TERMINALS, INC.		DRAWING NO.	
C.F.S. BUILDING		EP 3879-23 5-108	
OFFICE FRAMING DETAILS		SHEET 24 OF 71	

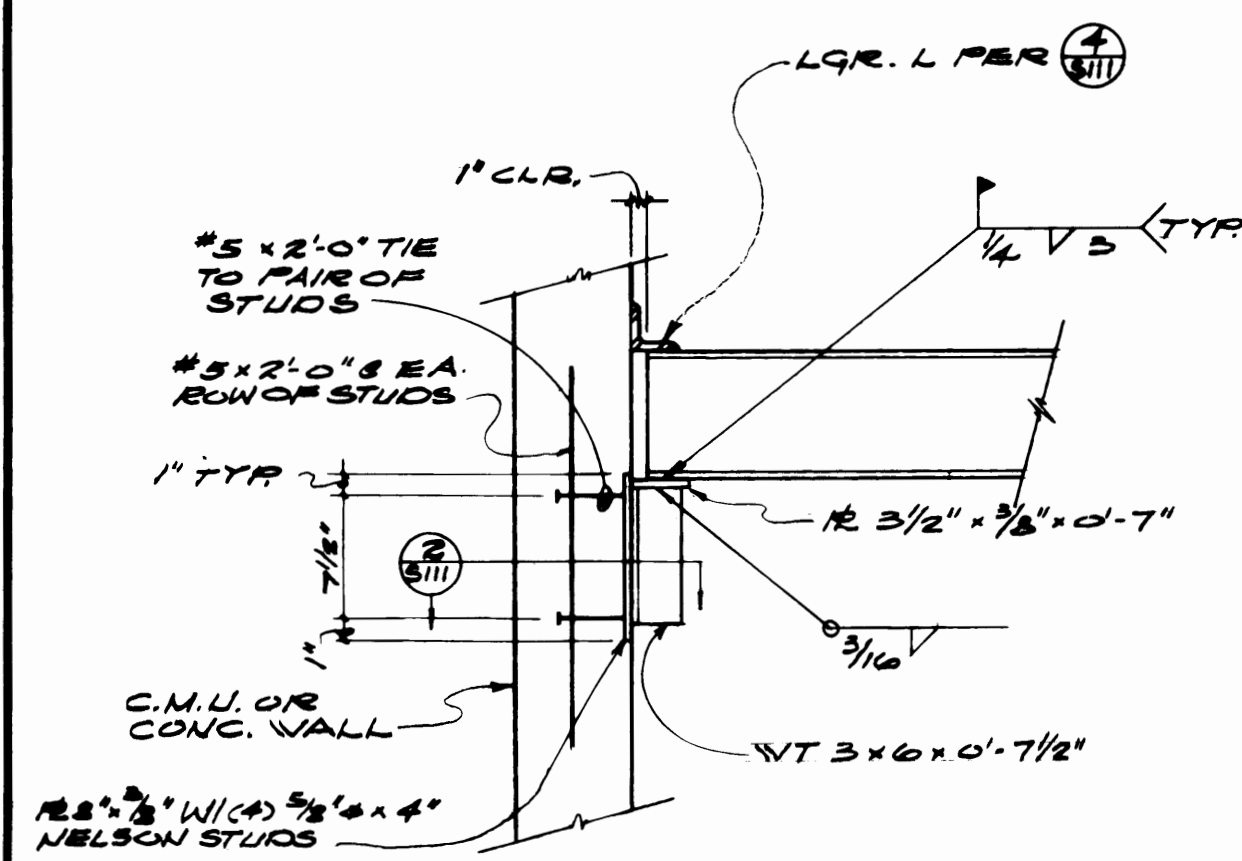

TYP. BEAM TO WALL CONN.


SECTION 1

1/4\"/>

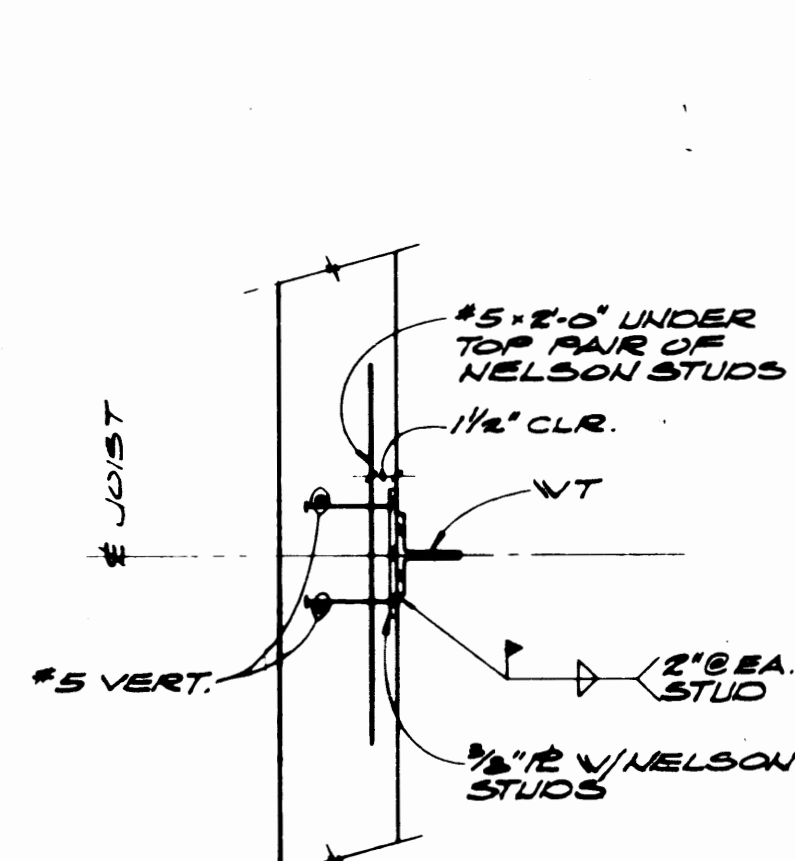

PLAN DETAIL 2


1/4\"/>

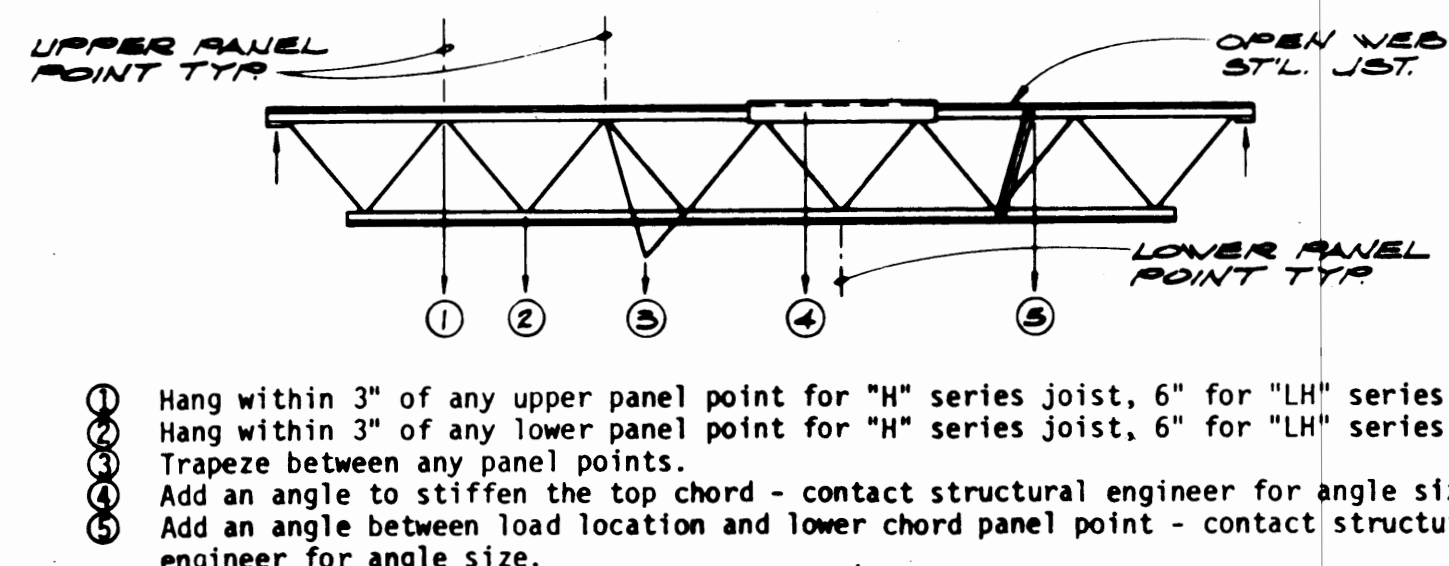

ALLOWABLE METHODS & LOCATIONS FOR HANGING LOADS FROM OPEN WEB STEEL JOIST

DETAIL 3


NO SCALE

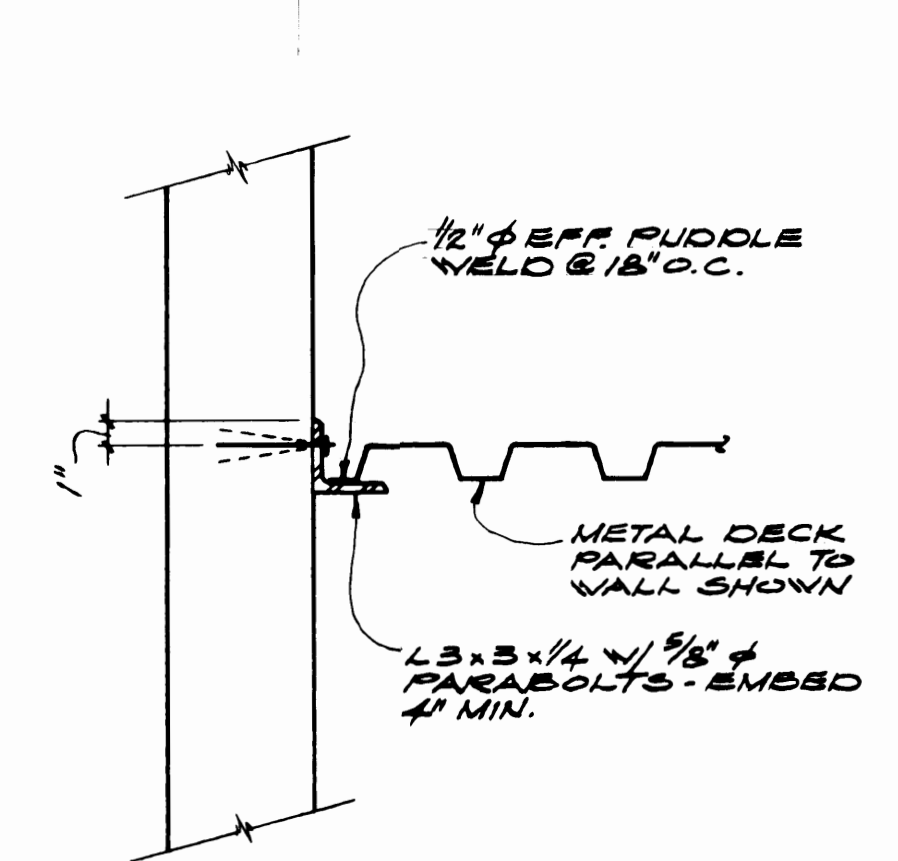

TYP. METAL DECK TO LGR. ANGLE CONN.

SECTION 4


NO SCALE

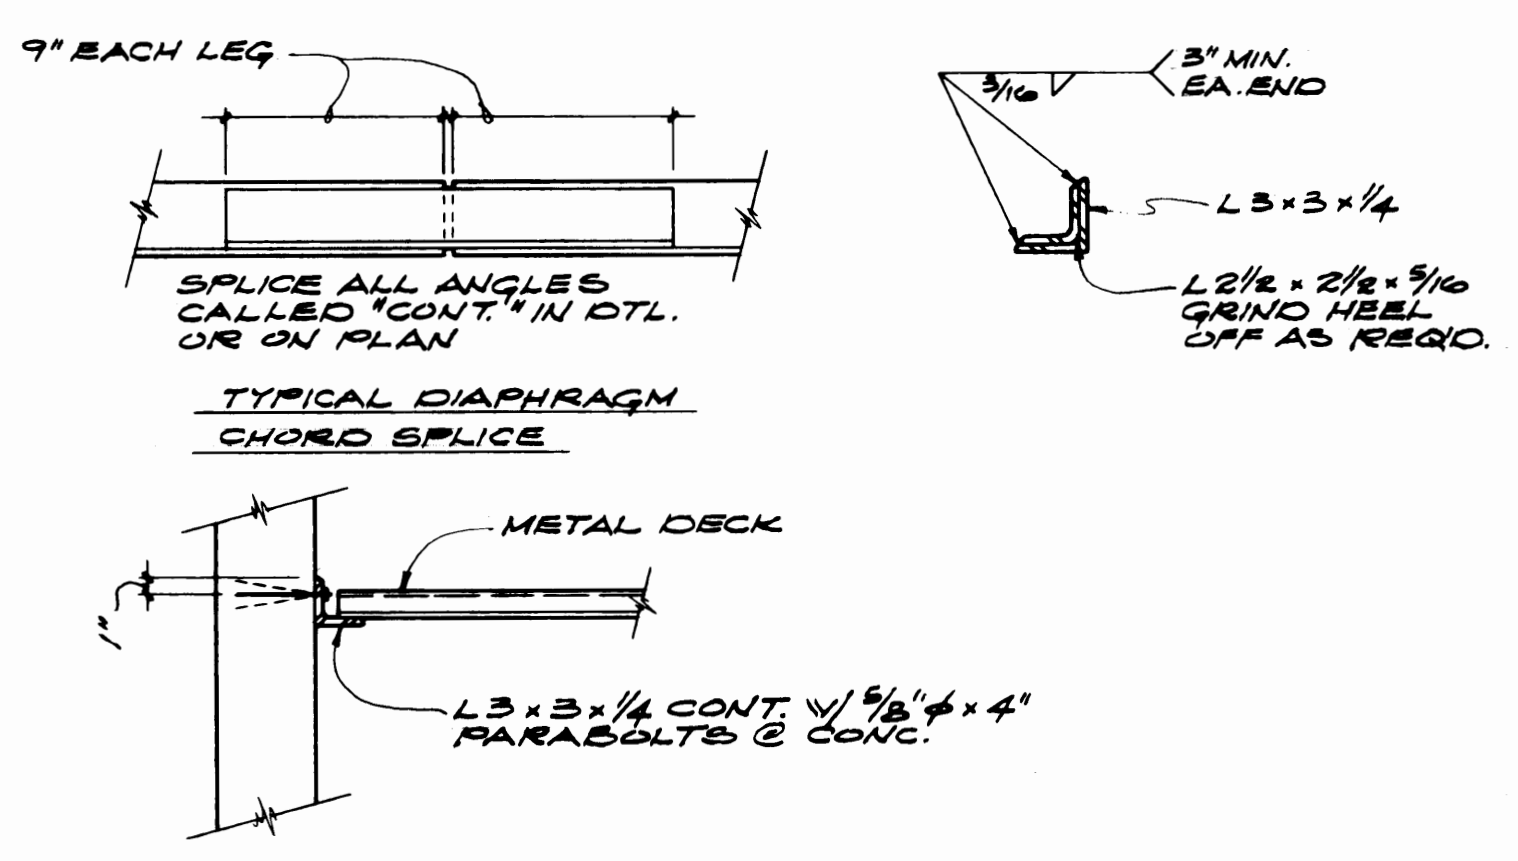

TYPICAL CONN. OF METAL DECK TO WALL EXTENDING ABOVE DECK

SECTION 5


1/4\"/>

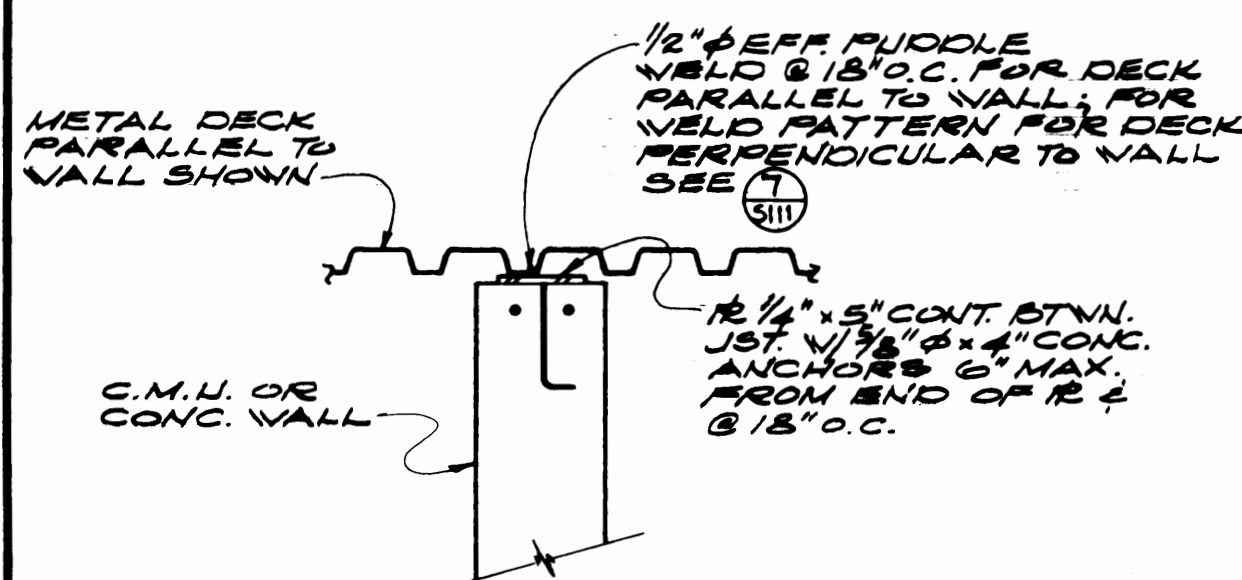

TYP. CONN. OF METAL DECK TO TOP OF WALL

SECTION 6

1/4\"/>

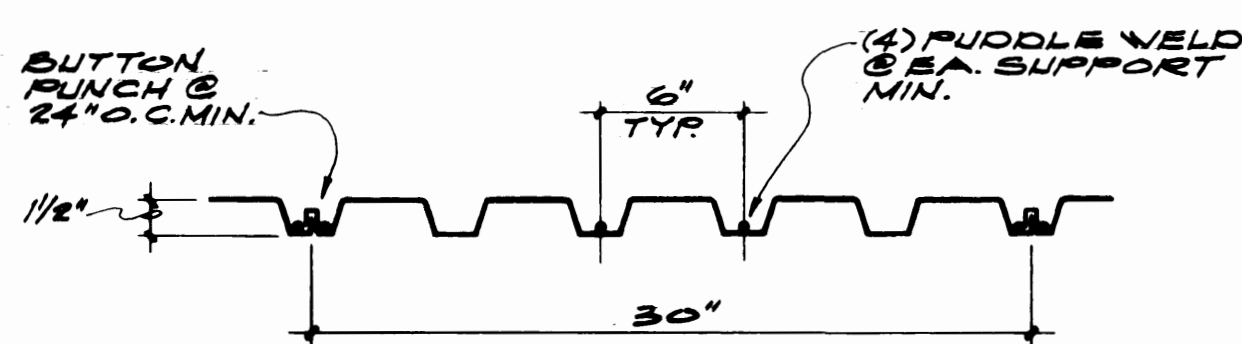


GAGE	I in. ⁴	S in. ³
20	.255	.271
22	.175	.206

NOTES:
1. Minimum deck properties and weld pattern shown. Provide heavier gage and/or weld pattern as required to develop diaphragm shears.
2. (2) span minimum, (3) span preferred, 3. For roof diaphragm shears see 11/S111.

DETAIL 7


NO SCALE

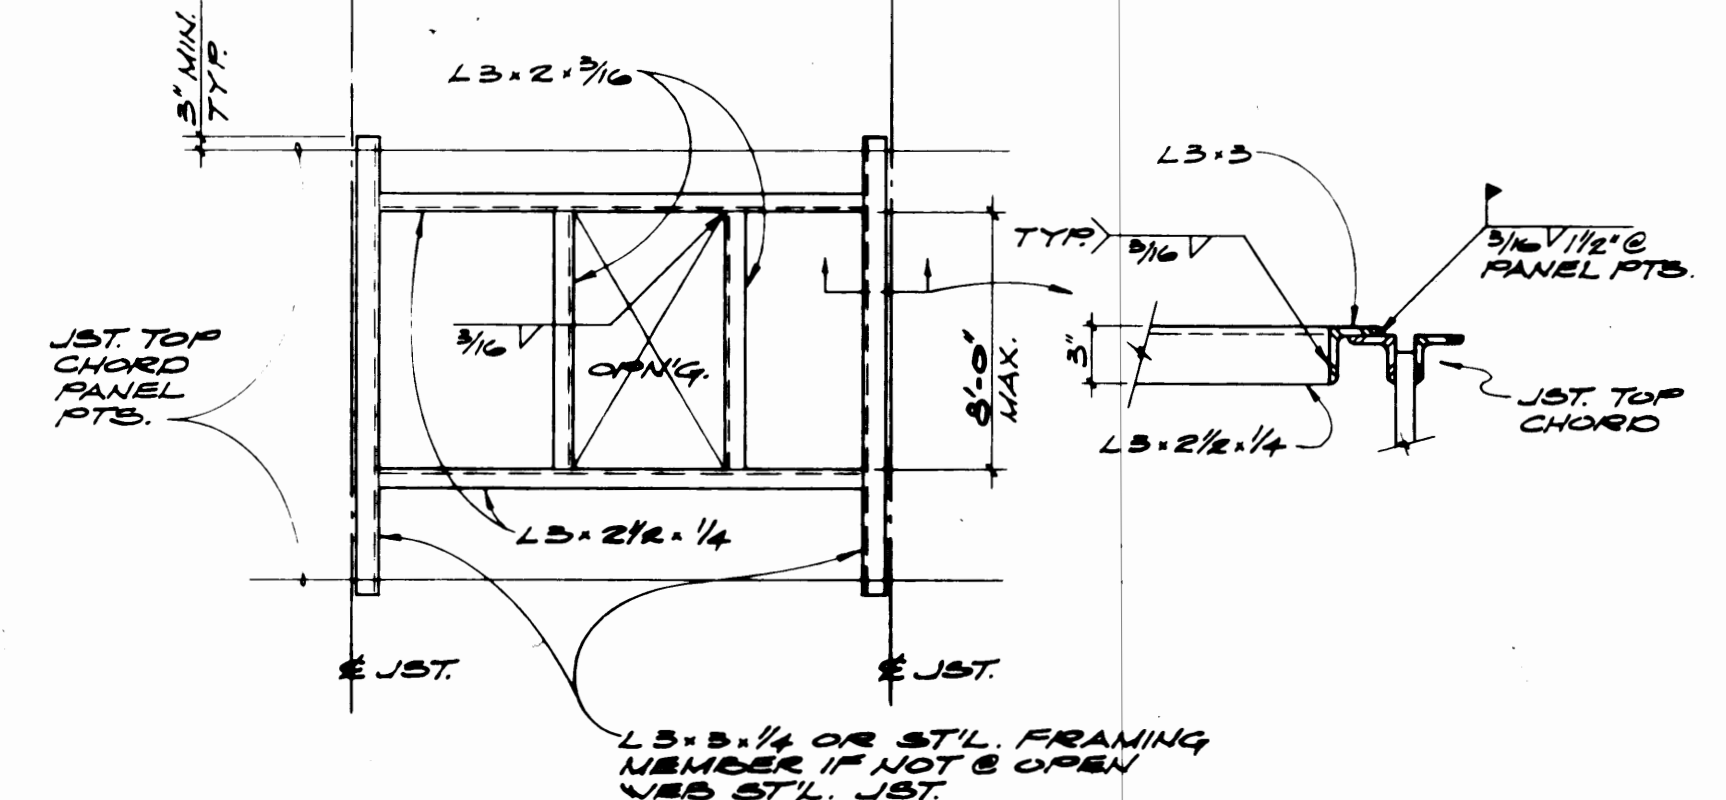

TYPICAL FRAMING & OPENINGS IN METAL ROOF DECK (MAX. LOAD = 600')

DETAIL 8


NO SCALE

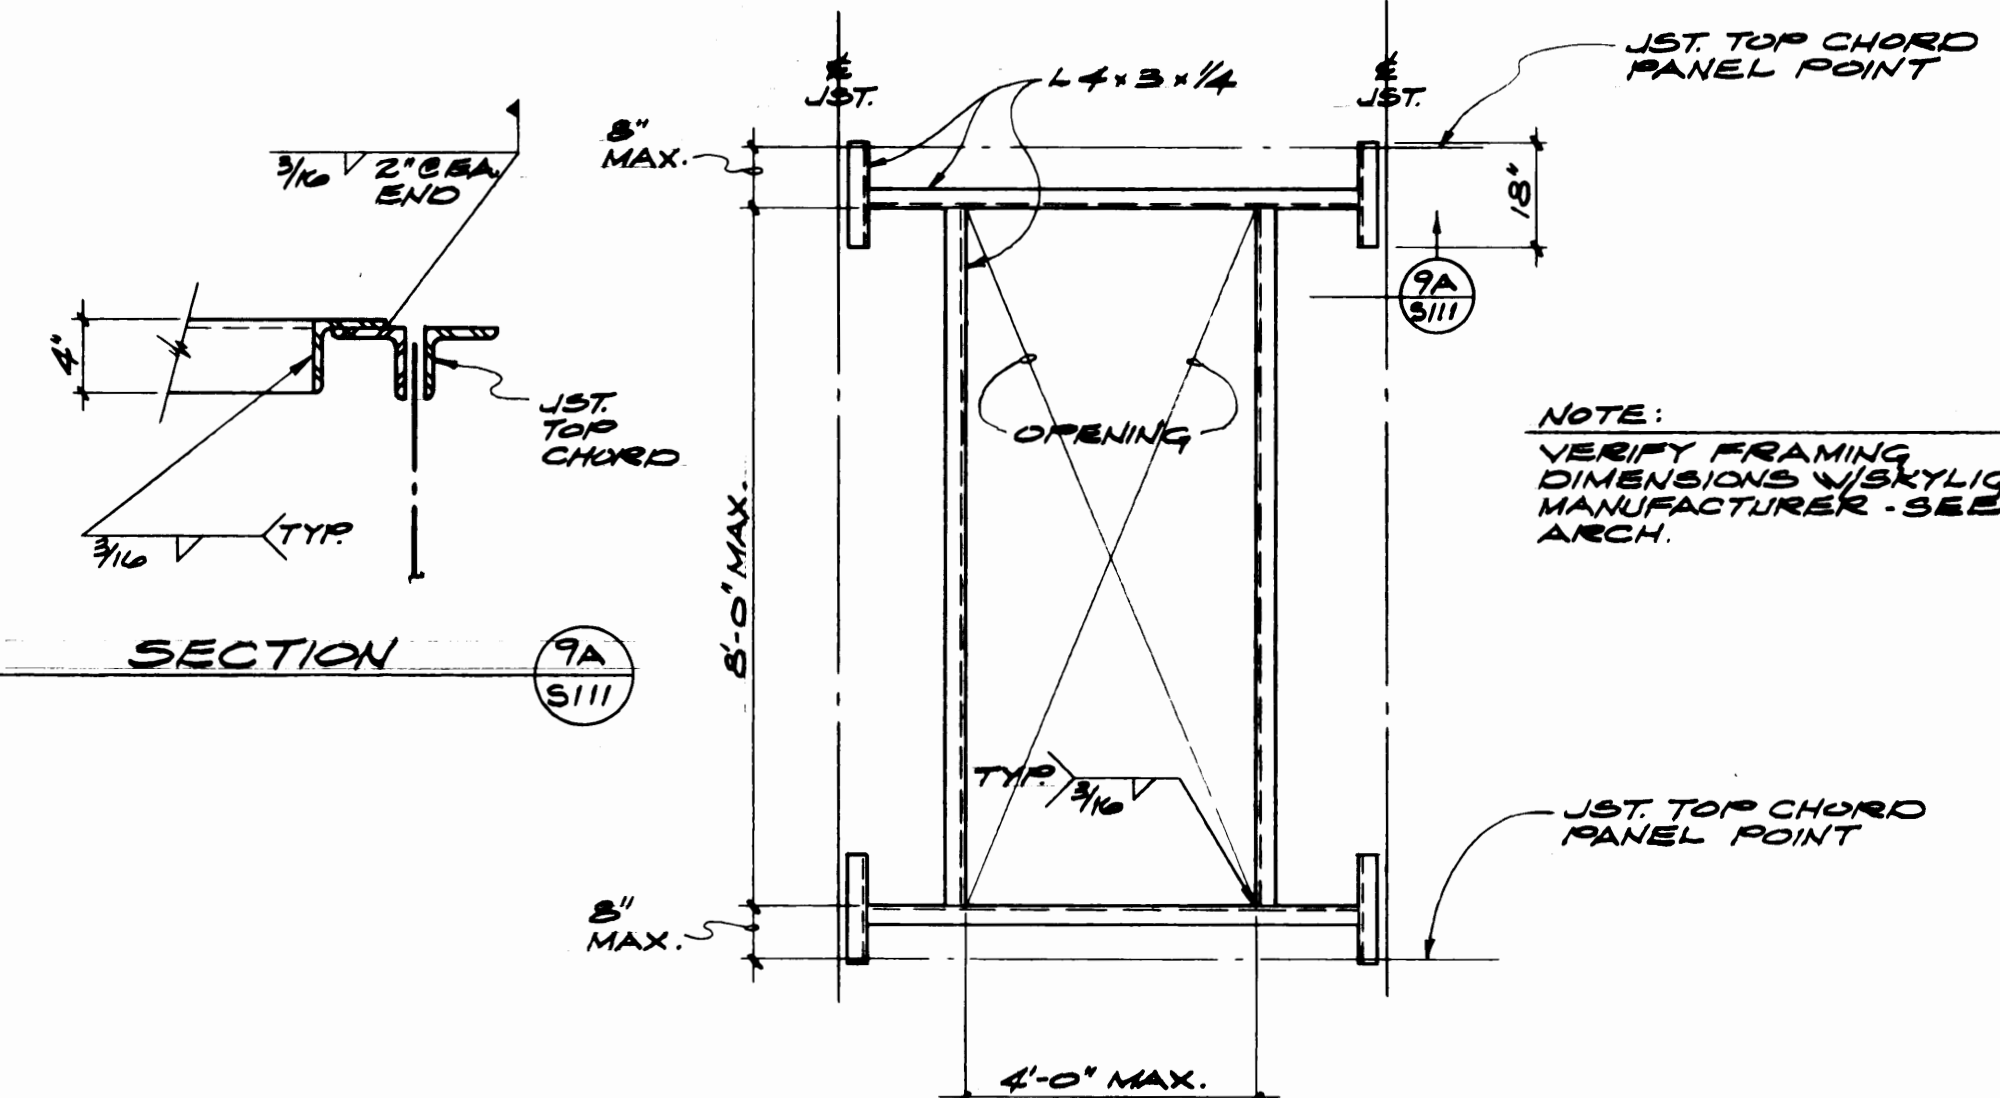

TYP. FRAMING & SKYLIGHT OPENING IN METAL ROOF DECK

DETAIL 9


NO SCALE

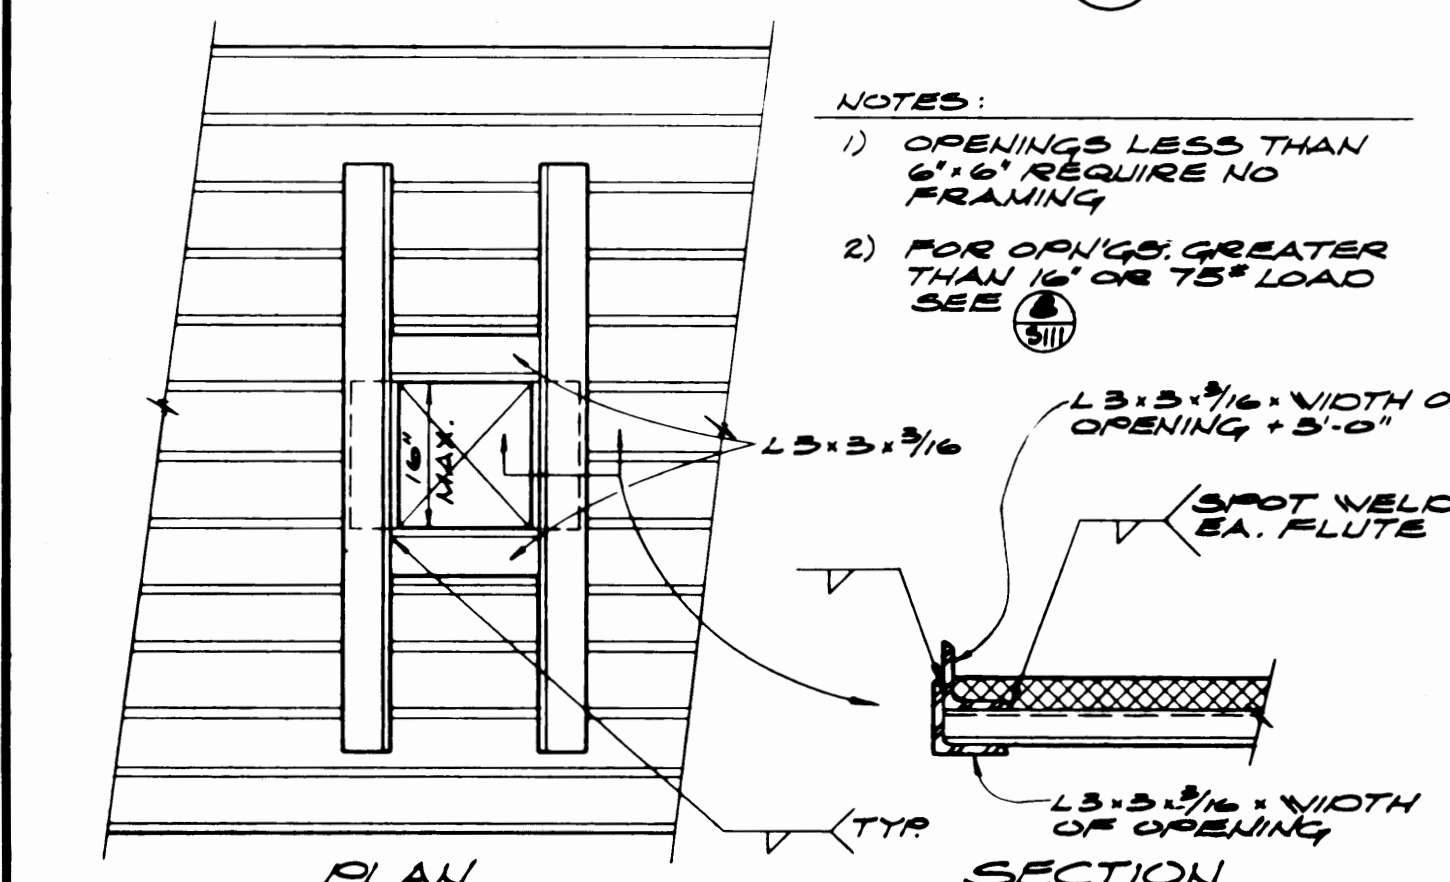

TYP. DETL. @ OPENINGS IN METAL DECK LESS THAN 16"

SECTION 10


NO SCALE

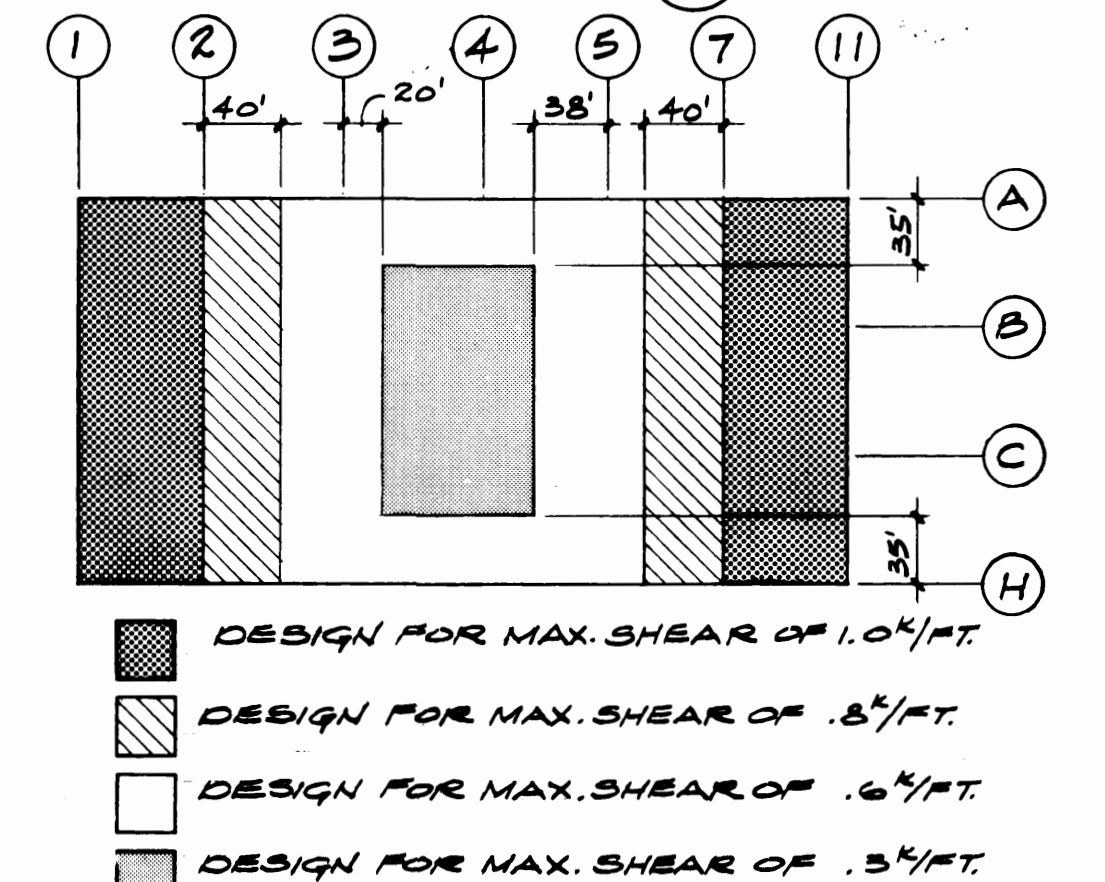

ROOF DIAPHRAGM DESIGN SHEARS

DETAIL 11


NO SCALE

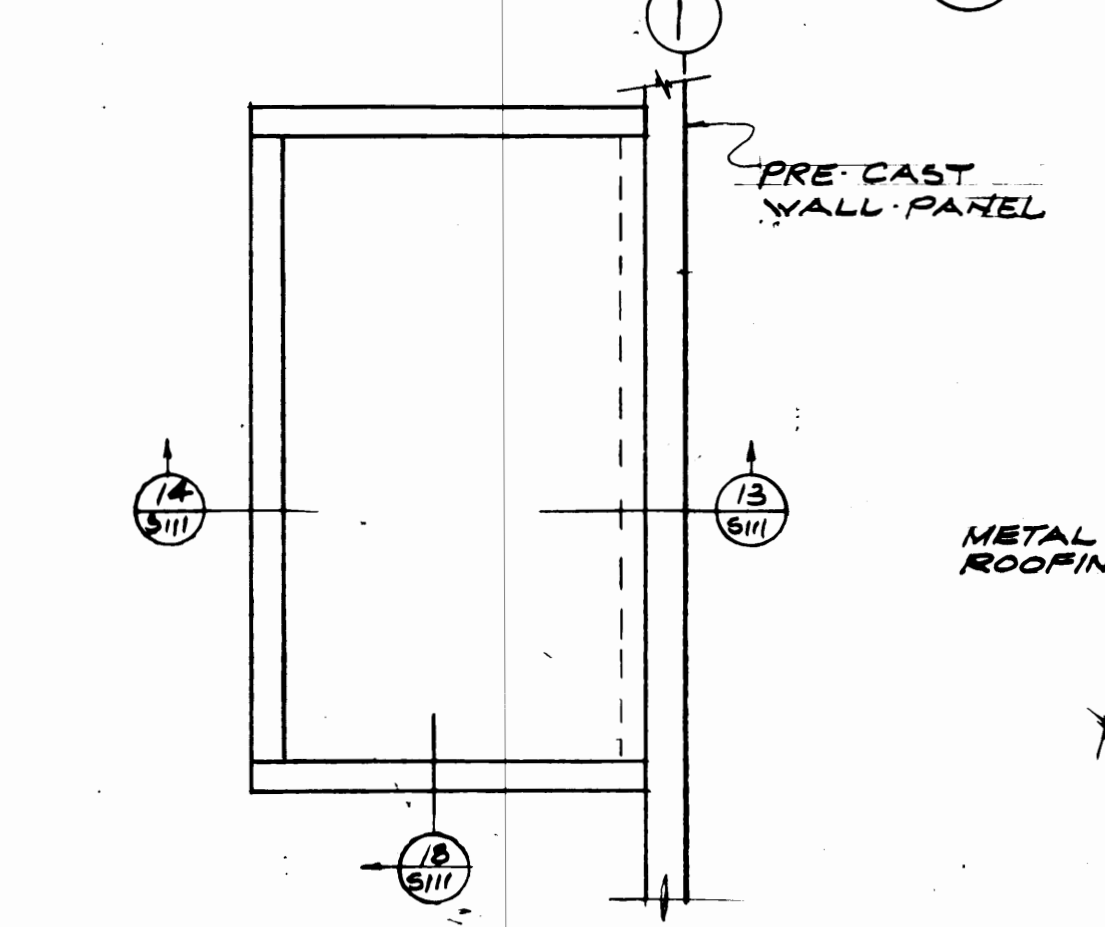

VALVE HOUSE ROOF PLAN

SECTION 12


3/8\"/>

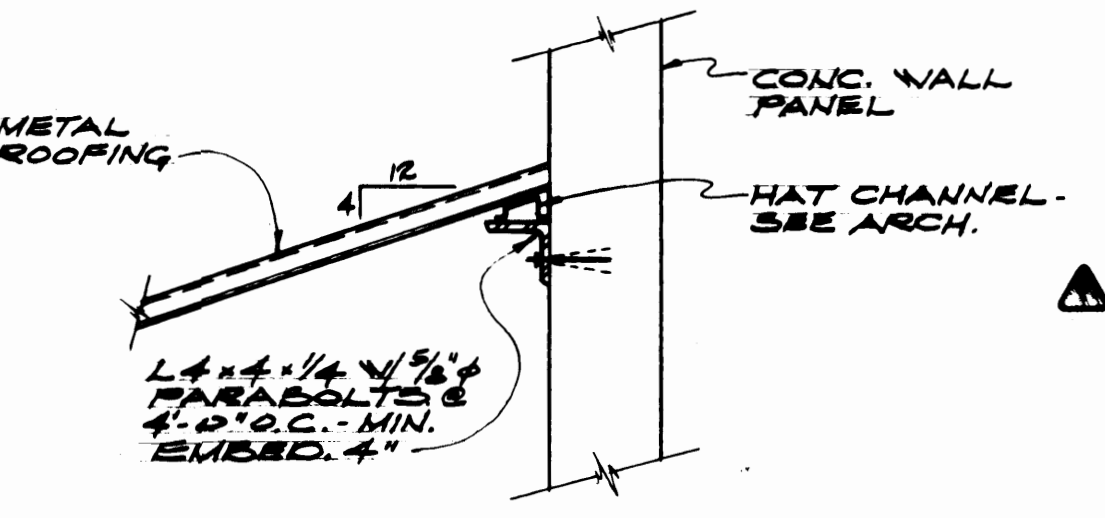

ROOF TO WALL CONN. @ VALVE HOUSE


SECTION 13

1/4\"/>

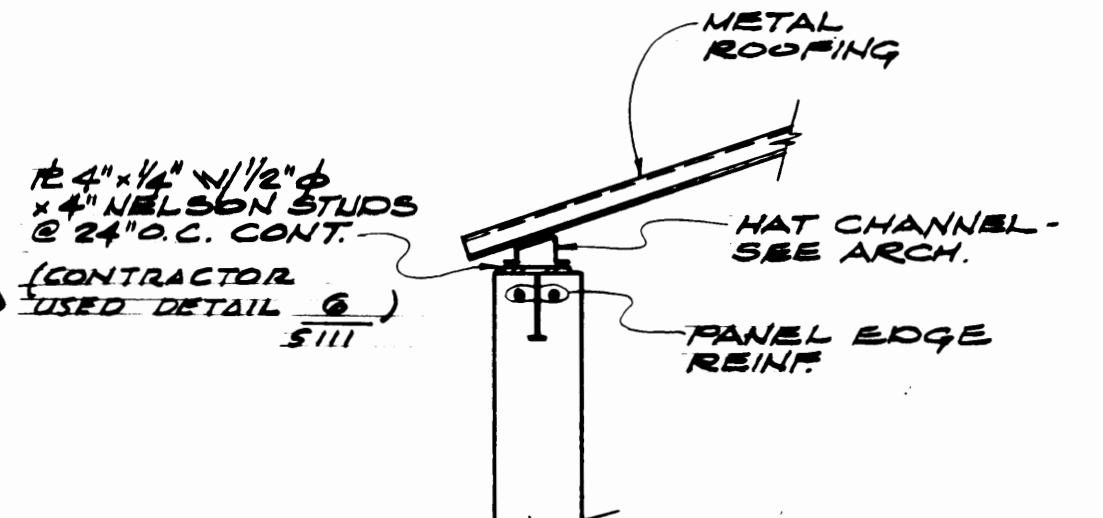

SECTION 14


1/4\"/>

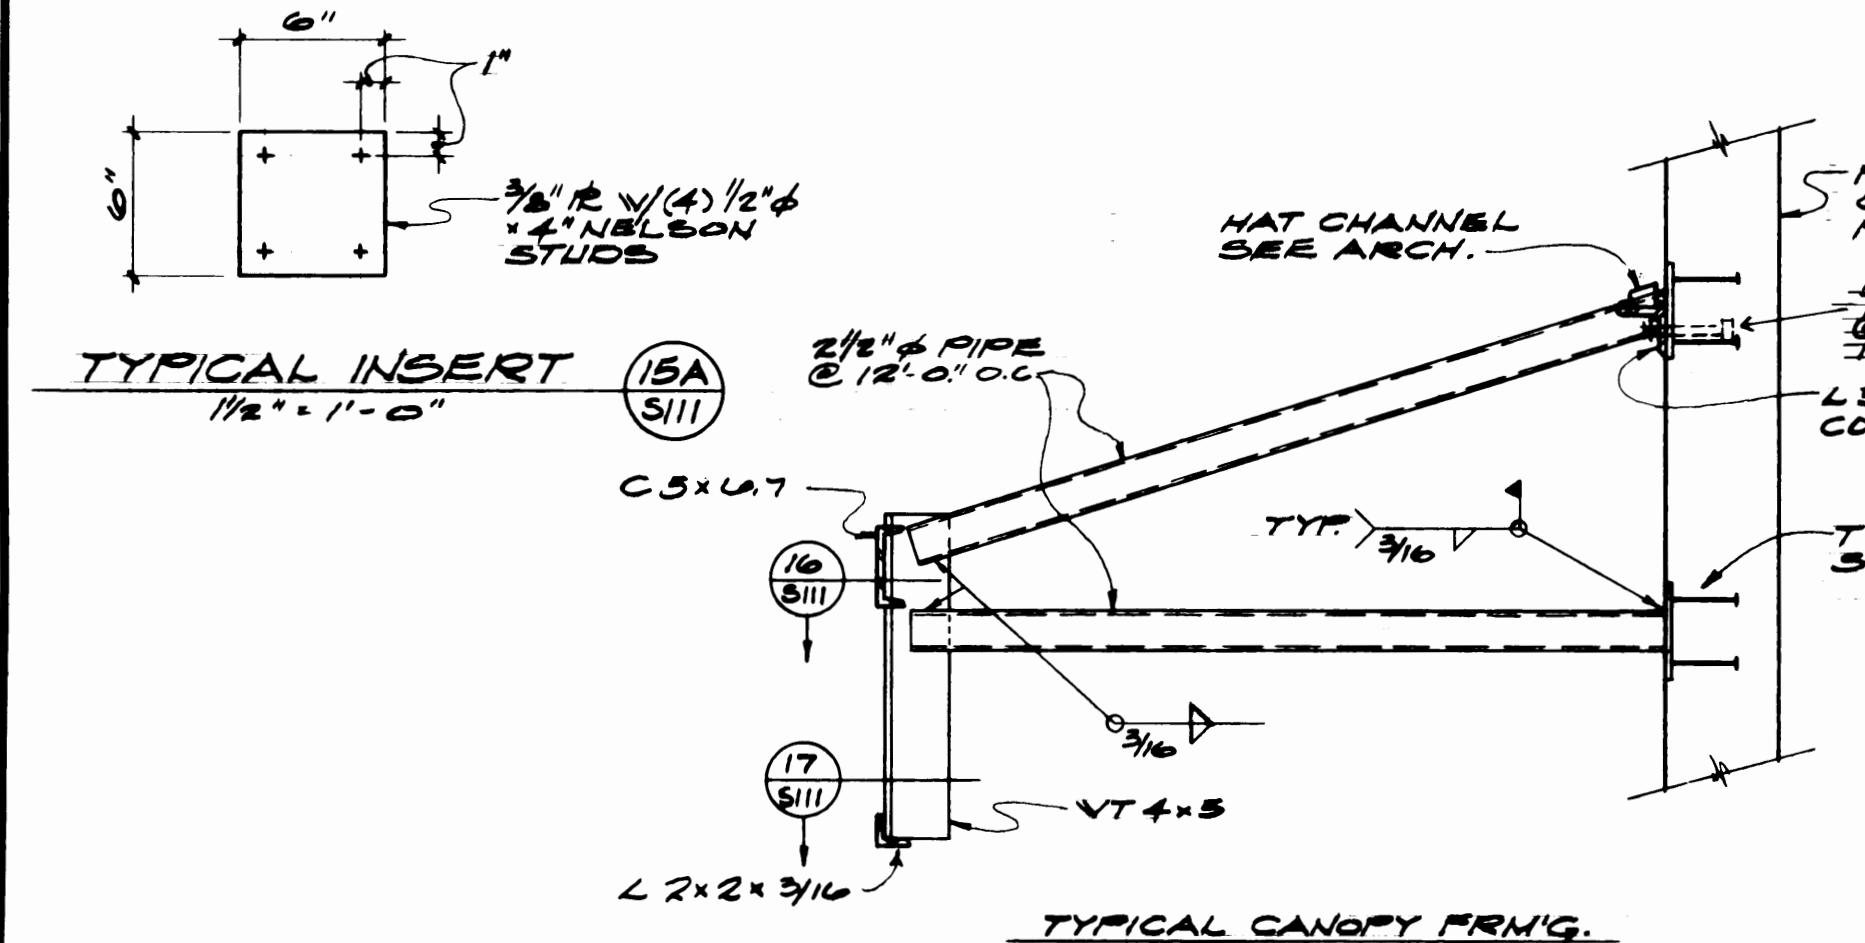

TYPICAL CANOPY FRING.


SECTION 15

1/4\"/>

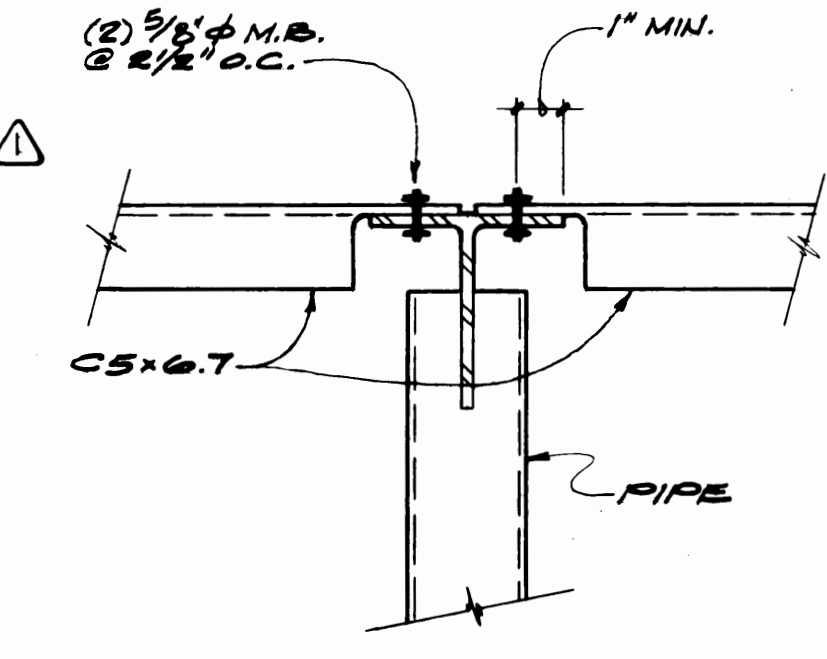


SECTION 16

3\"/>

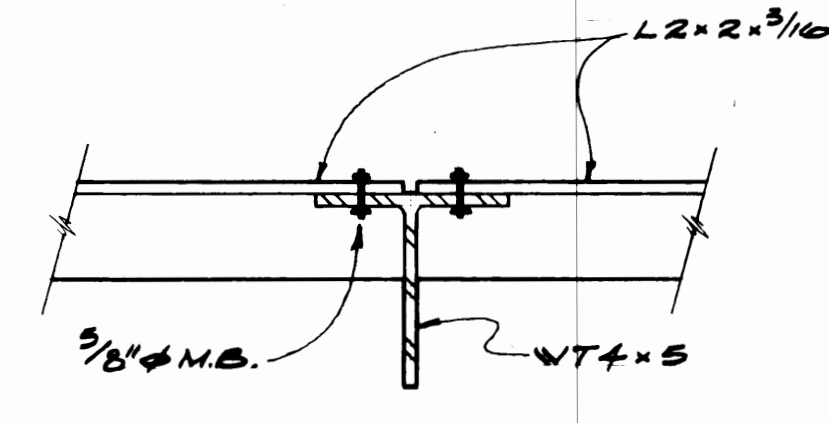

SECTION 17

3\"/>

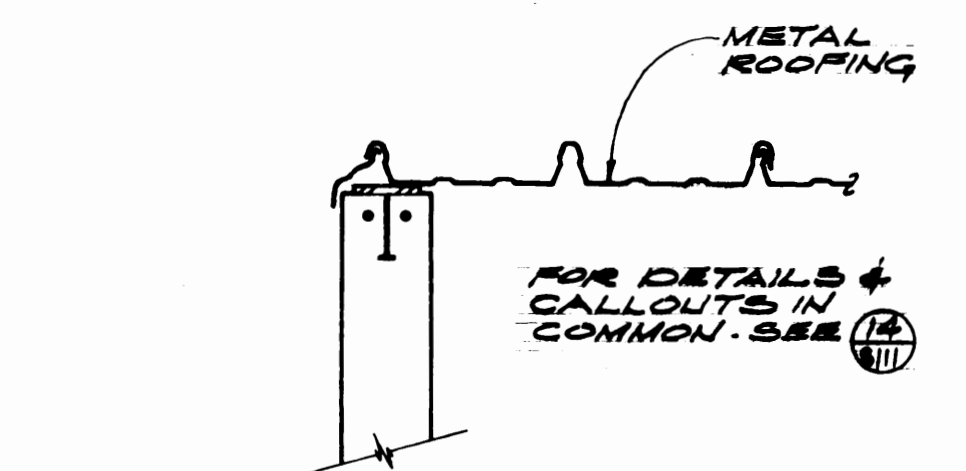

SECTION 18









1\"/>

DRAWN N.N.		PORT OF TACOMA	
DATE 3-22-84		TACOMA TERMINALS, INC.	
CHECKED P.S.		C.F.S. BUILDING	
DATE 3-22-84		MISCELLANEOUS DETAILS	
CHECKED D.F.			
DATE 3-22-84			
CONT. NO. 357			
FIELD BOOK (S)		SCALE	
APPROVED [Signature]		DRAWING NO.	
DATE 3/30/84		EP 3879-23 - 301	
[Signature]		SHEET 27 OF 71	
[Signature]		J-5585	



Shaffer Engineers, Inc.
Consulting Engineers
51 University, Suite 301
Bristol, VA 22101
(800) 525-4110
4800 Lee Ferry, Suite 301
Tampa, VA 33608
(813) 963-4787

REVISION	BY	APP.	DATE
REVISED TO AS-BUILT	R.J.S.		5-31-88

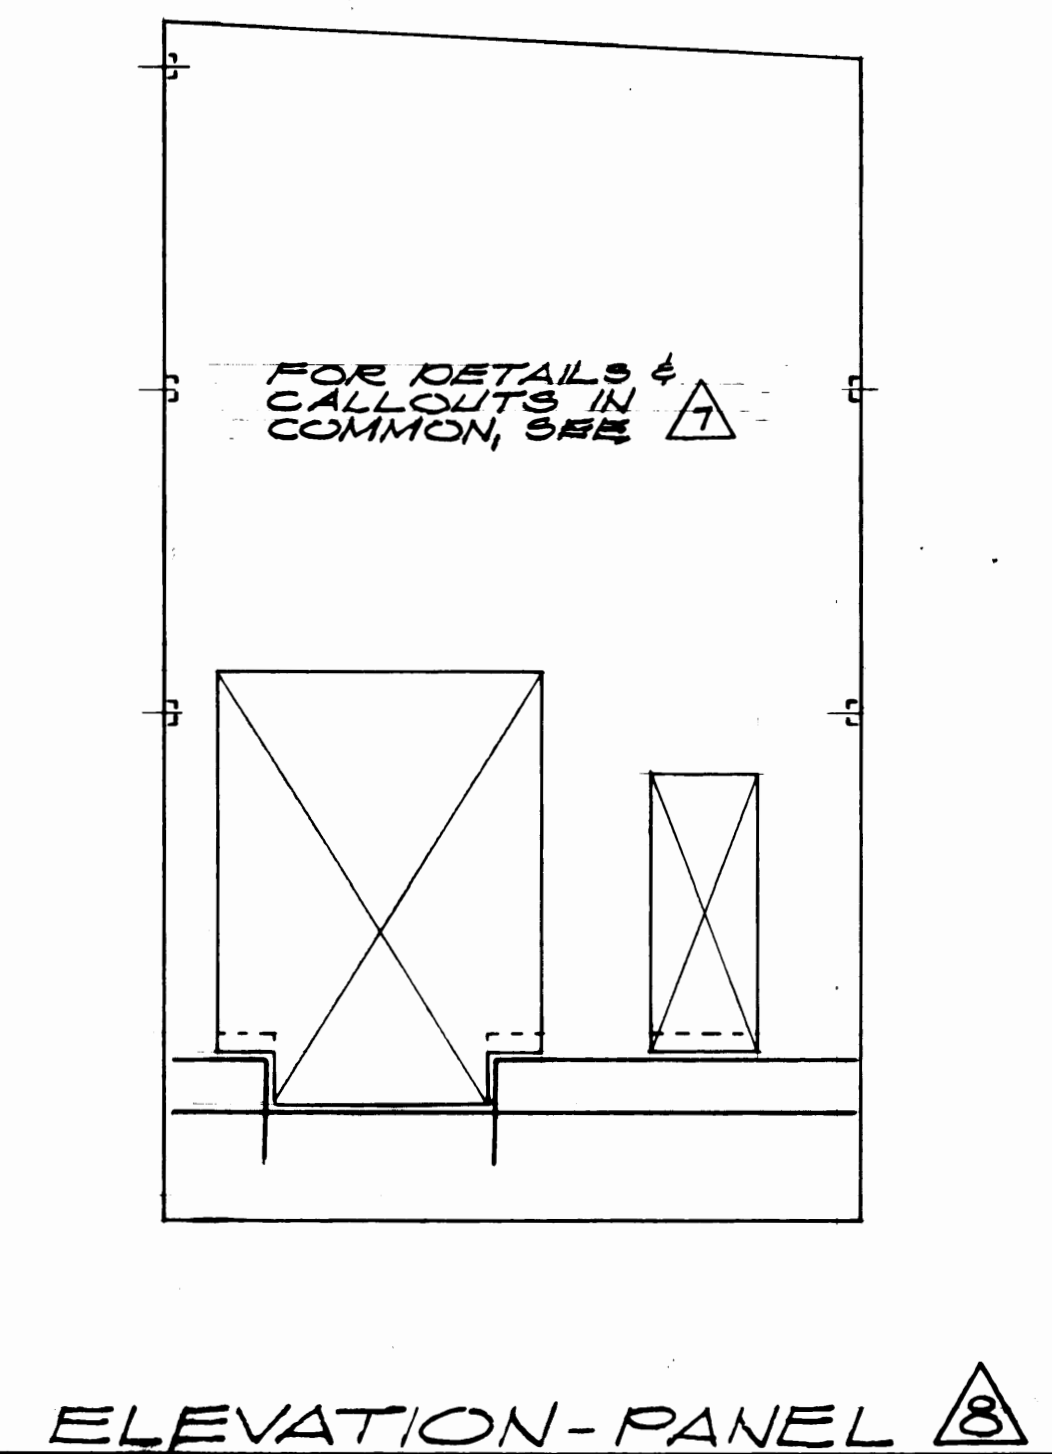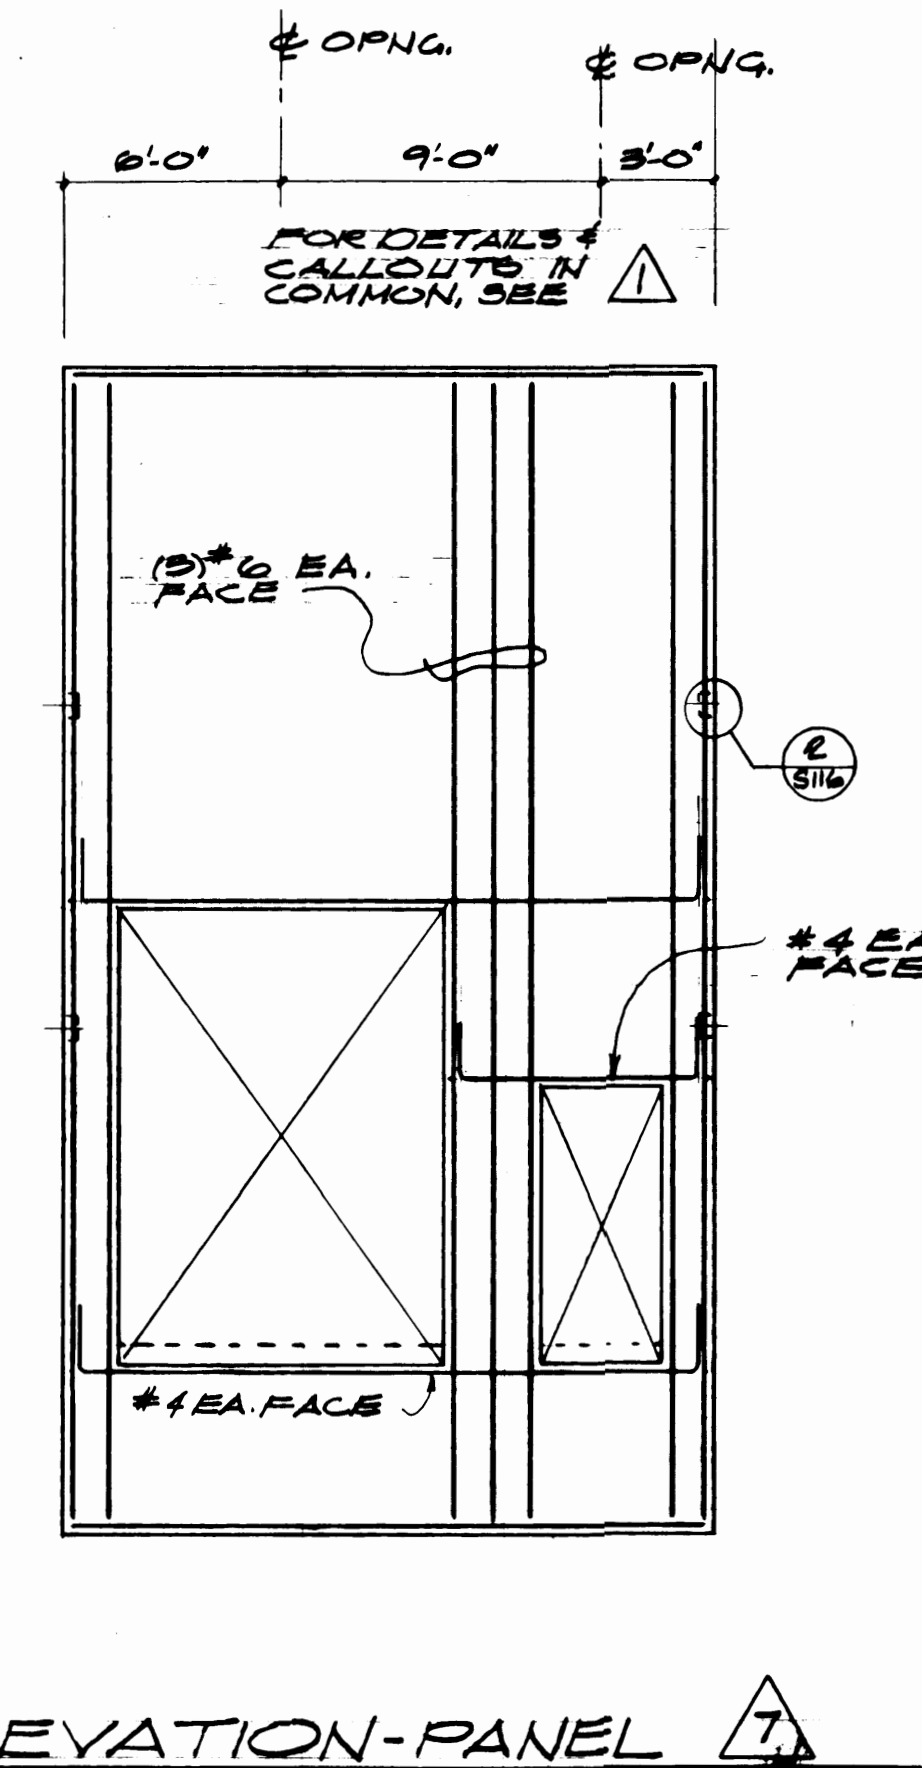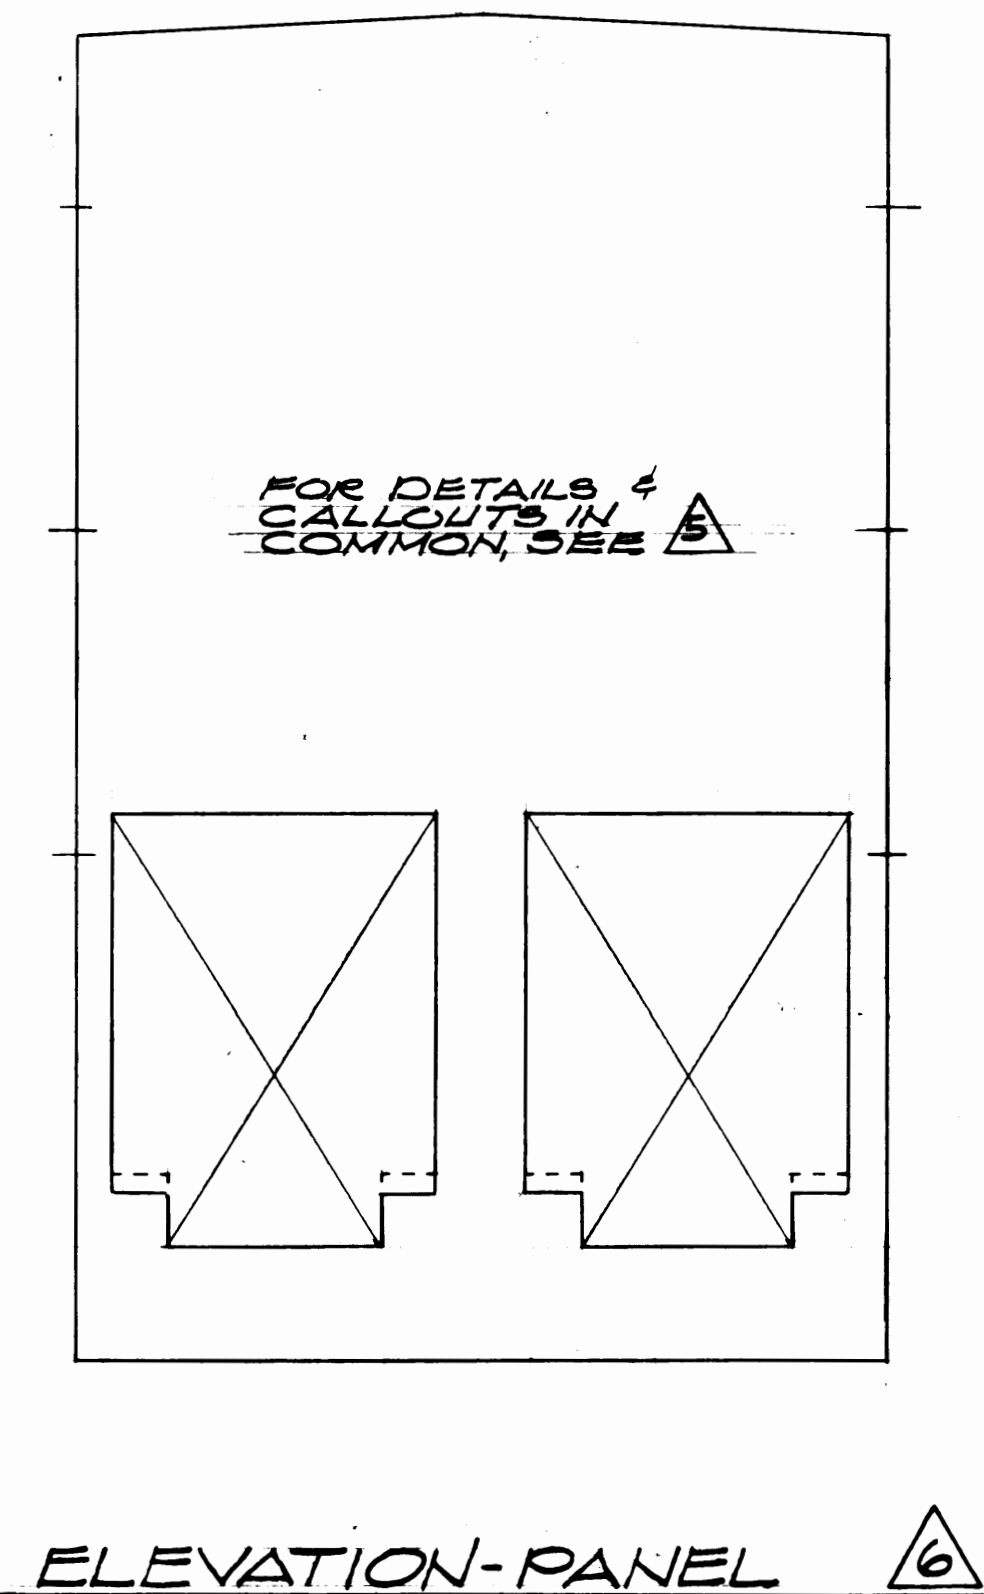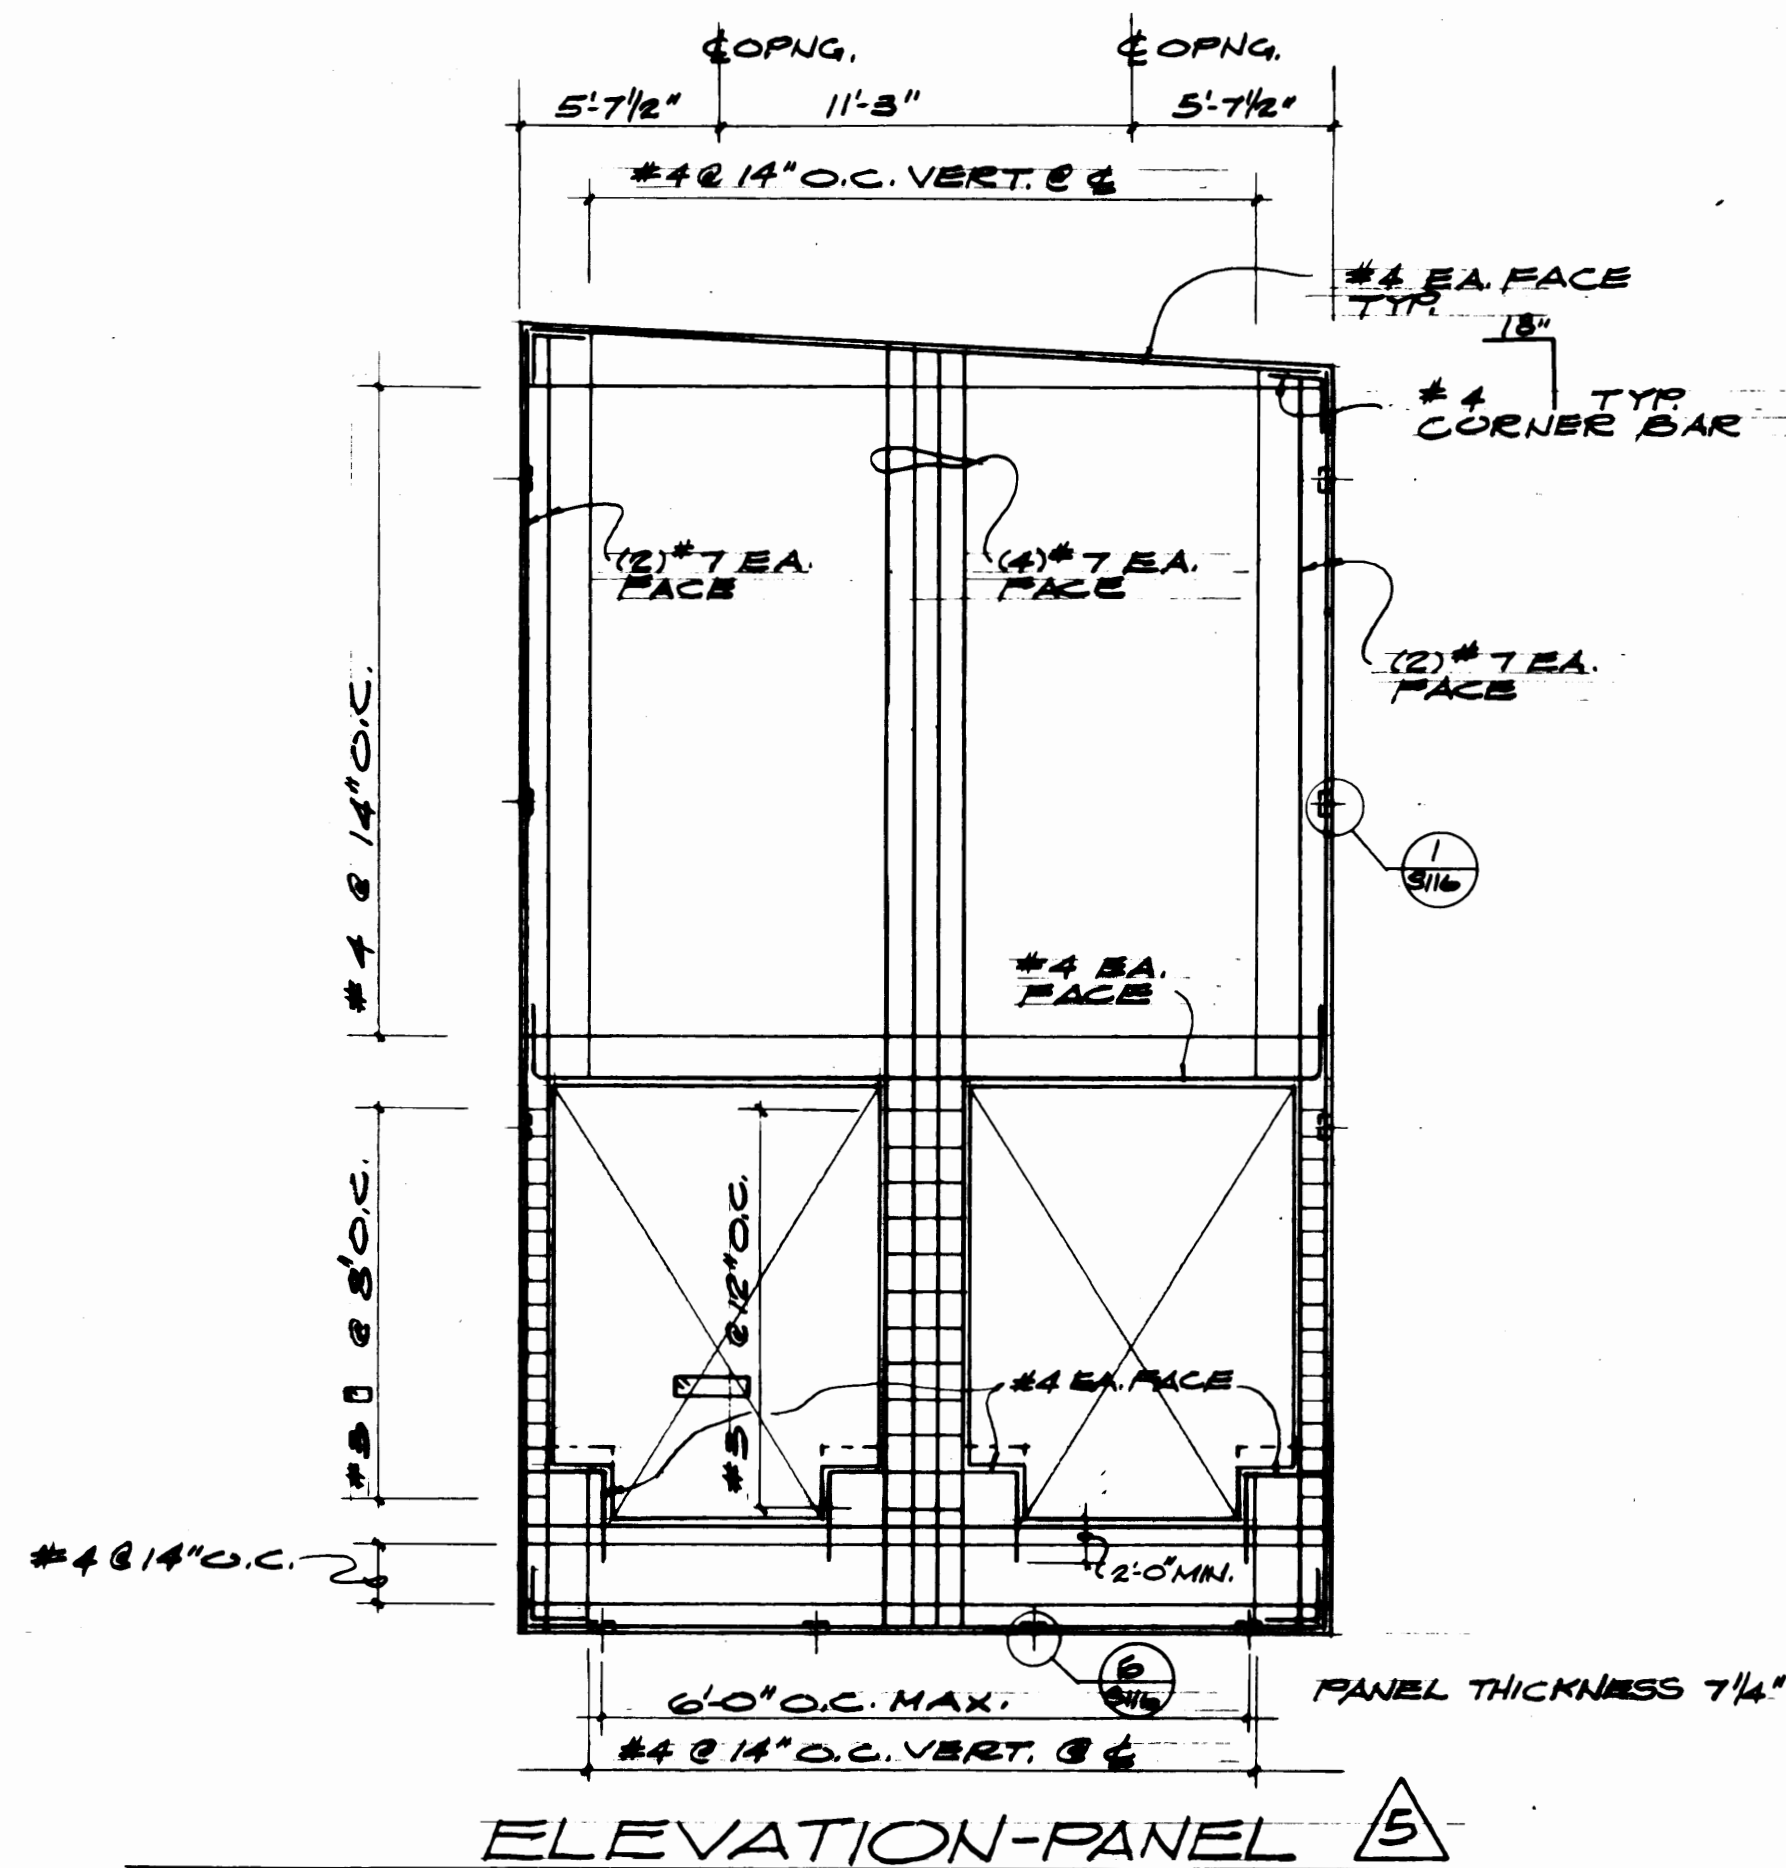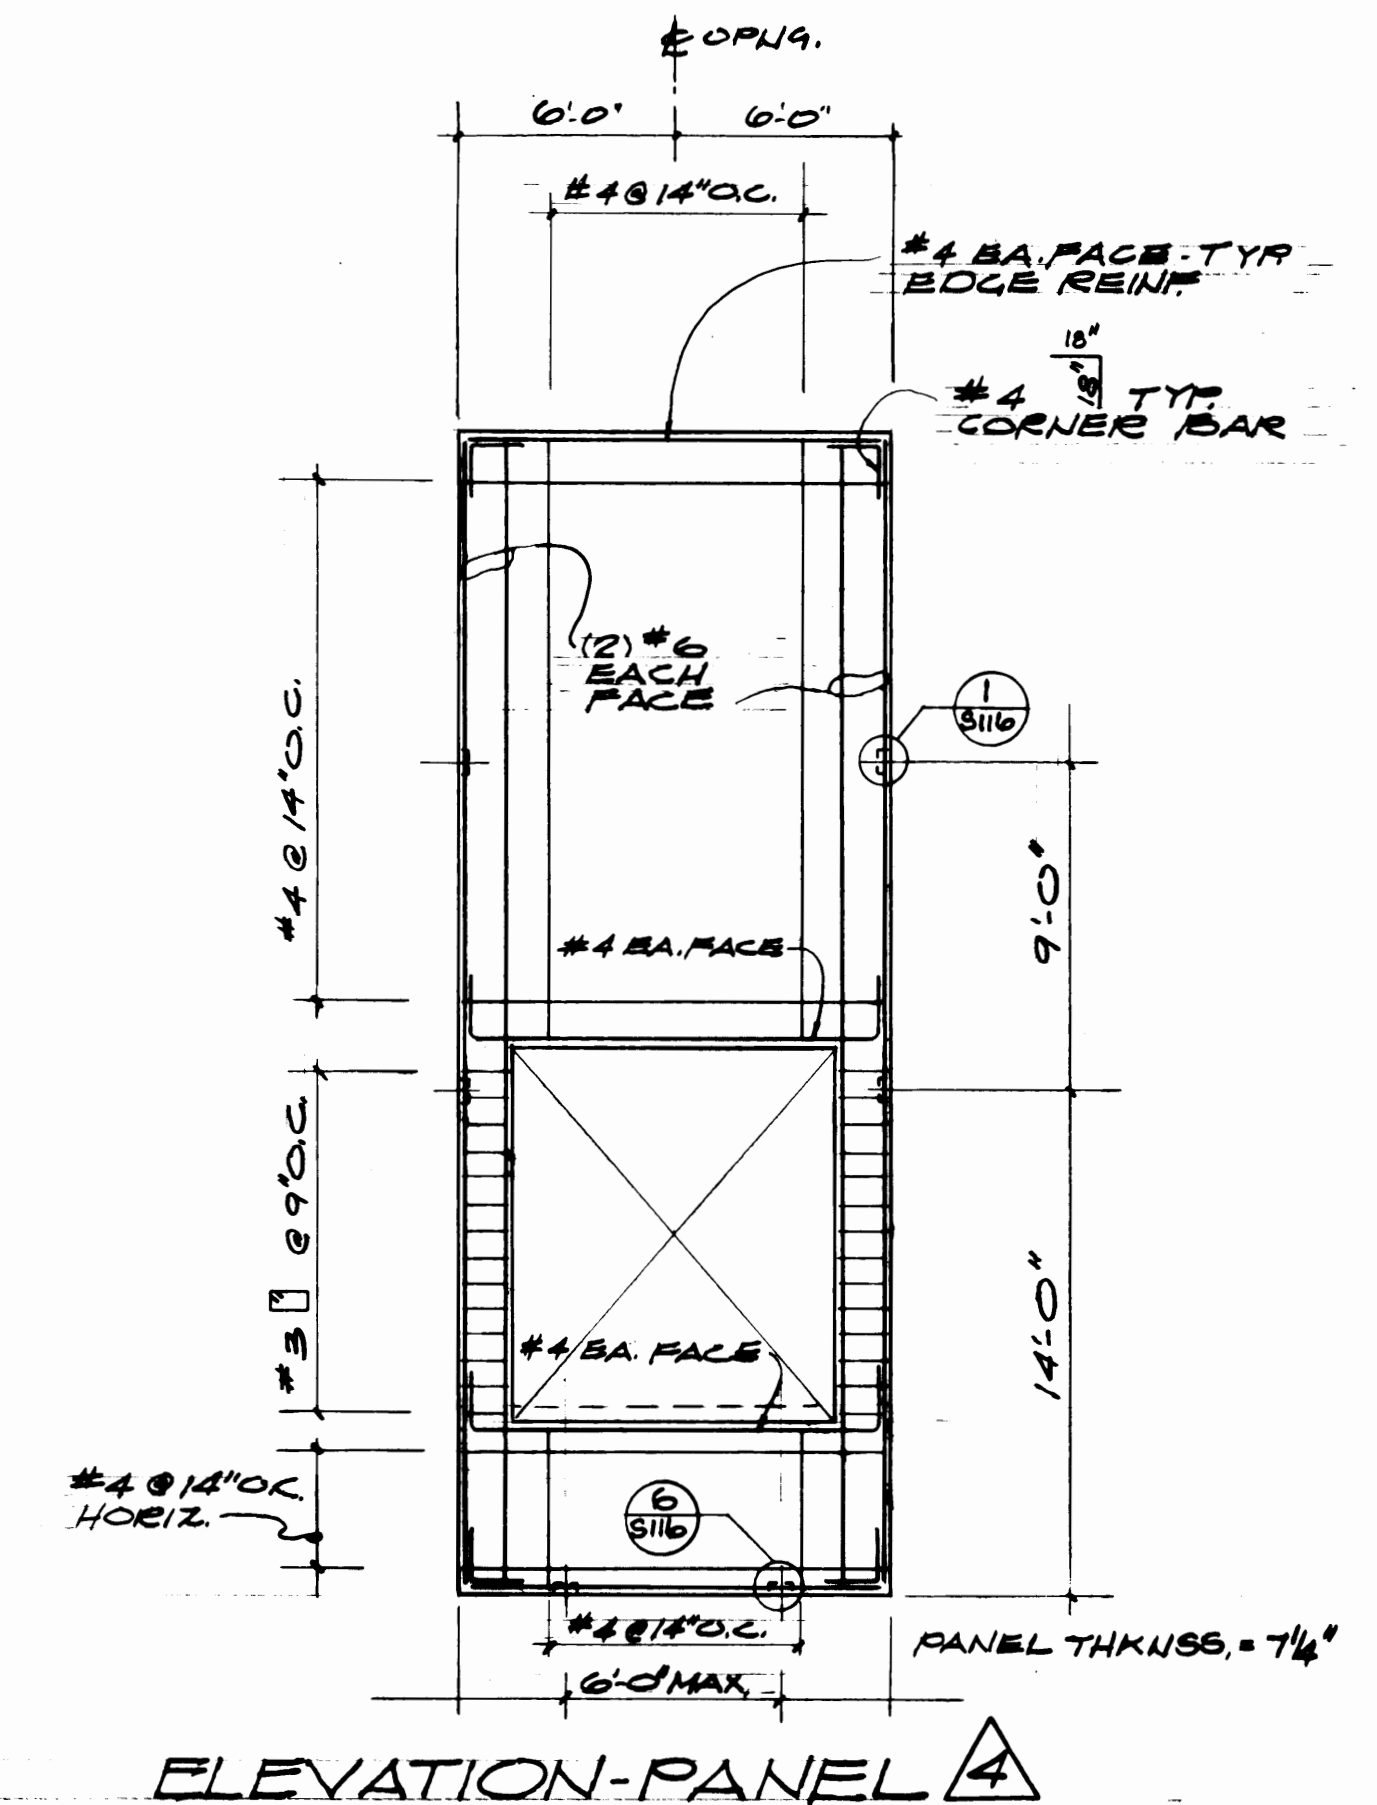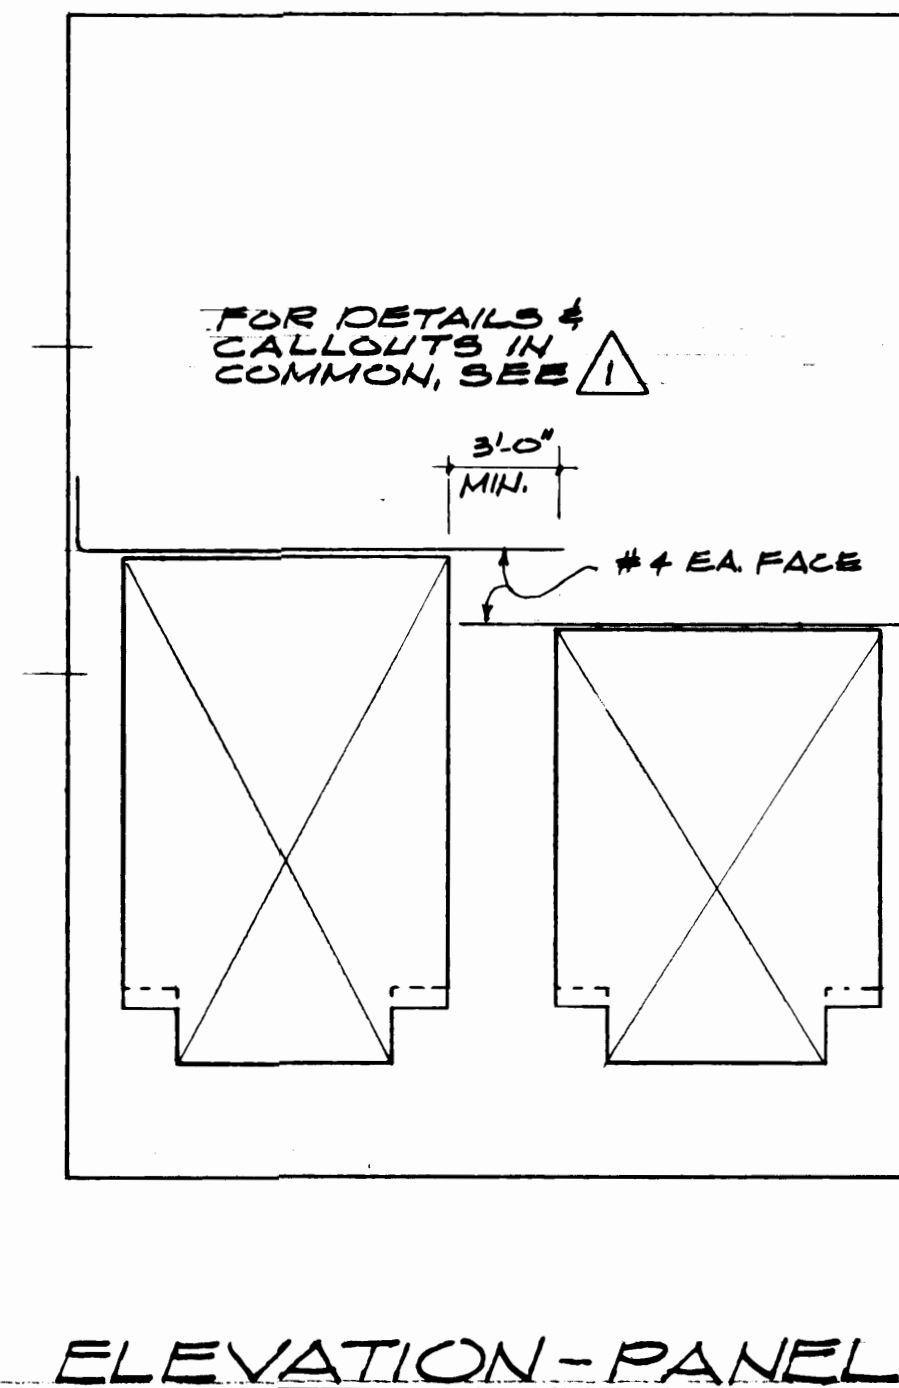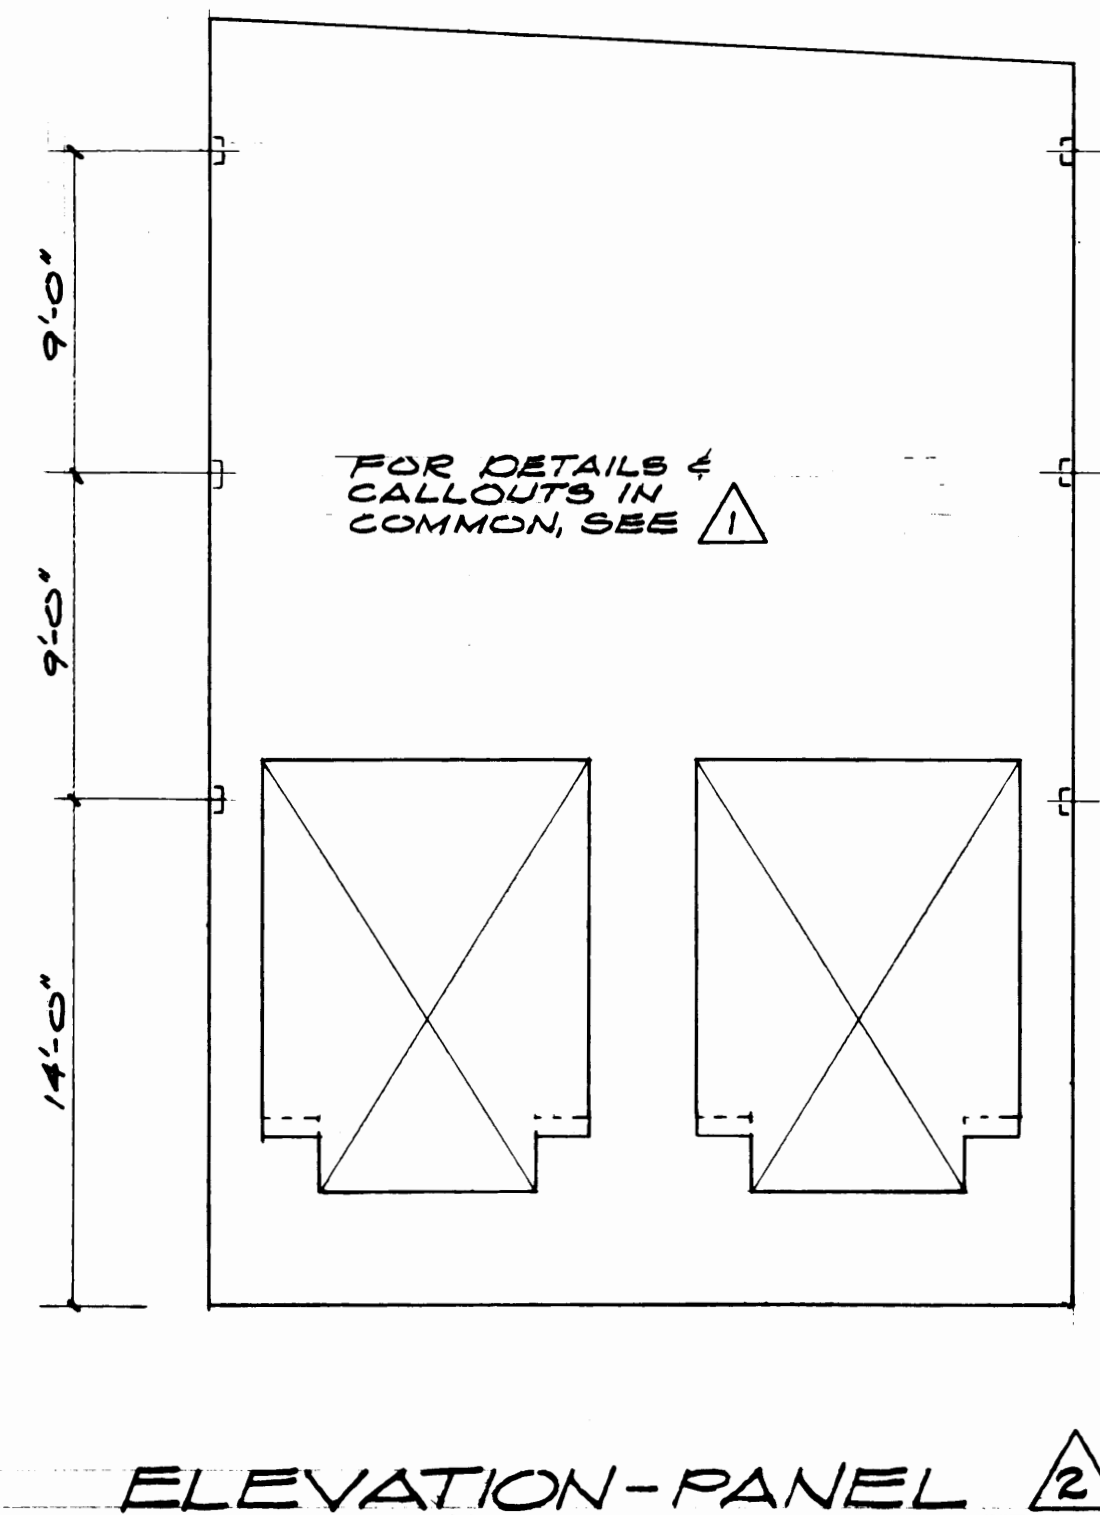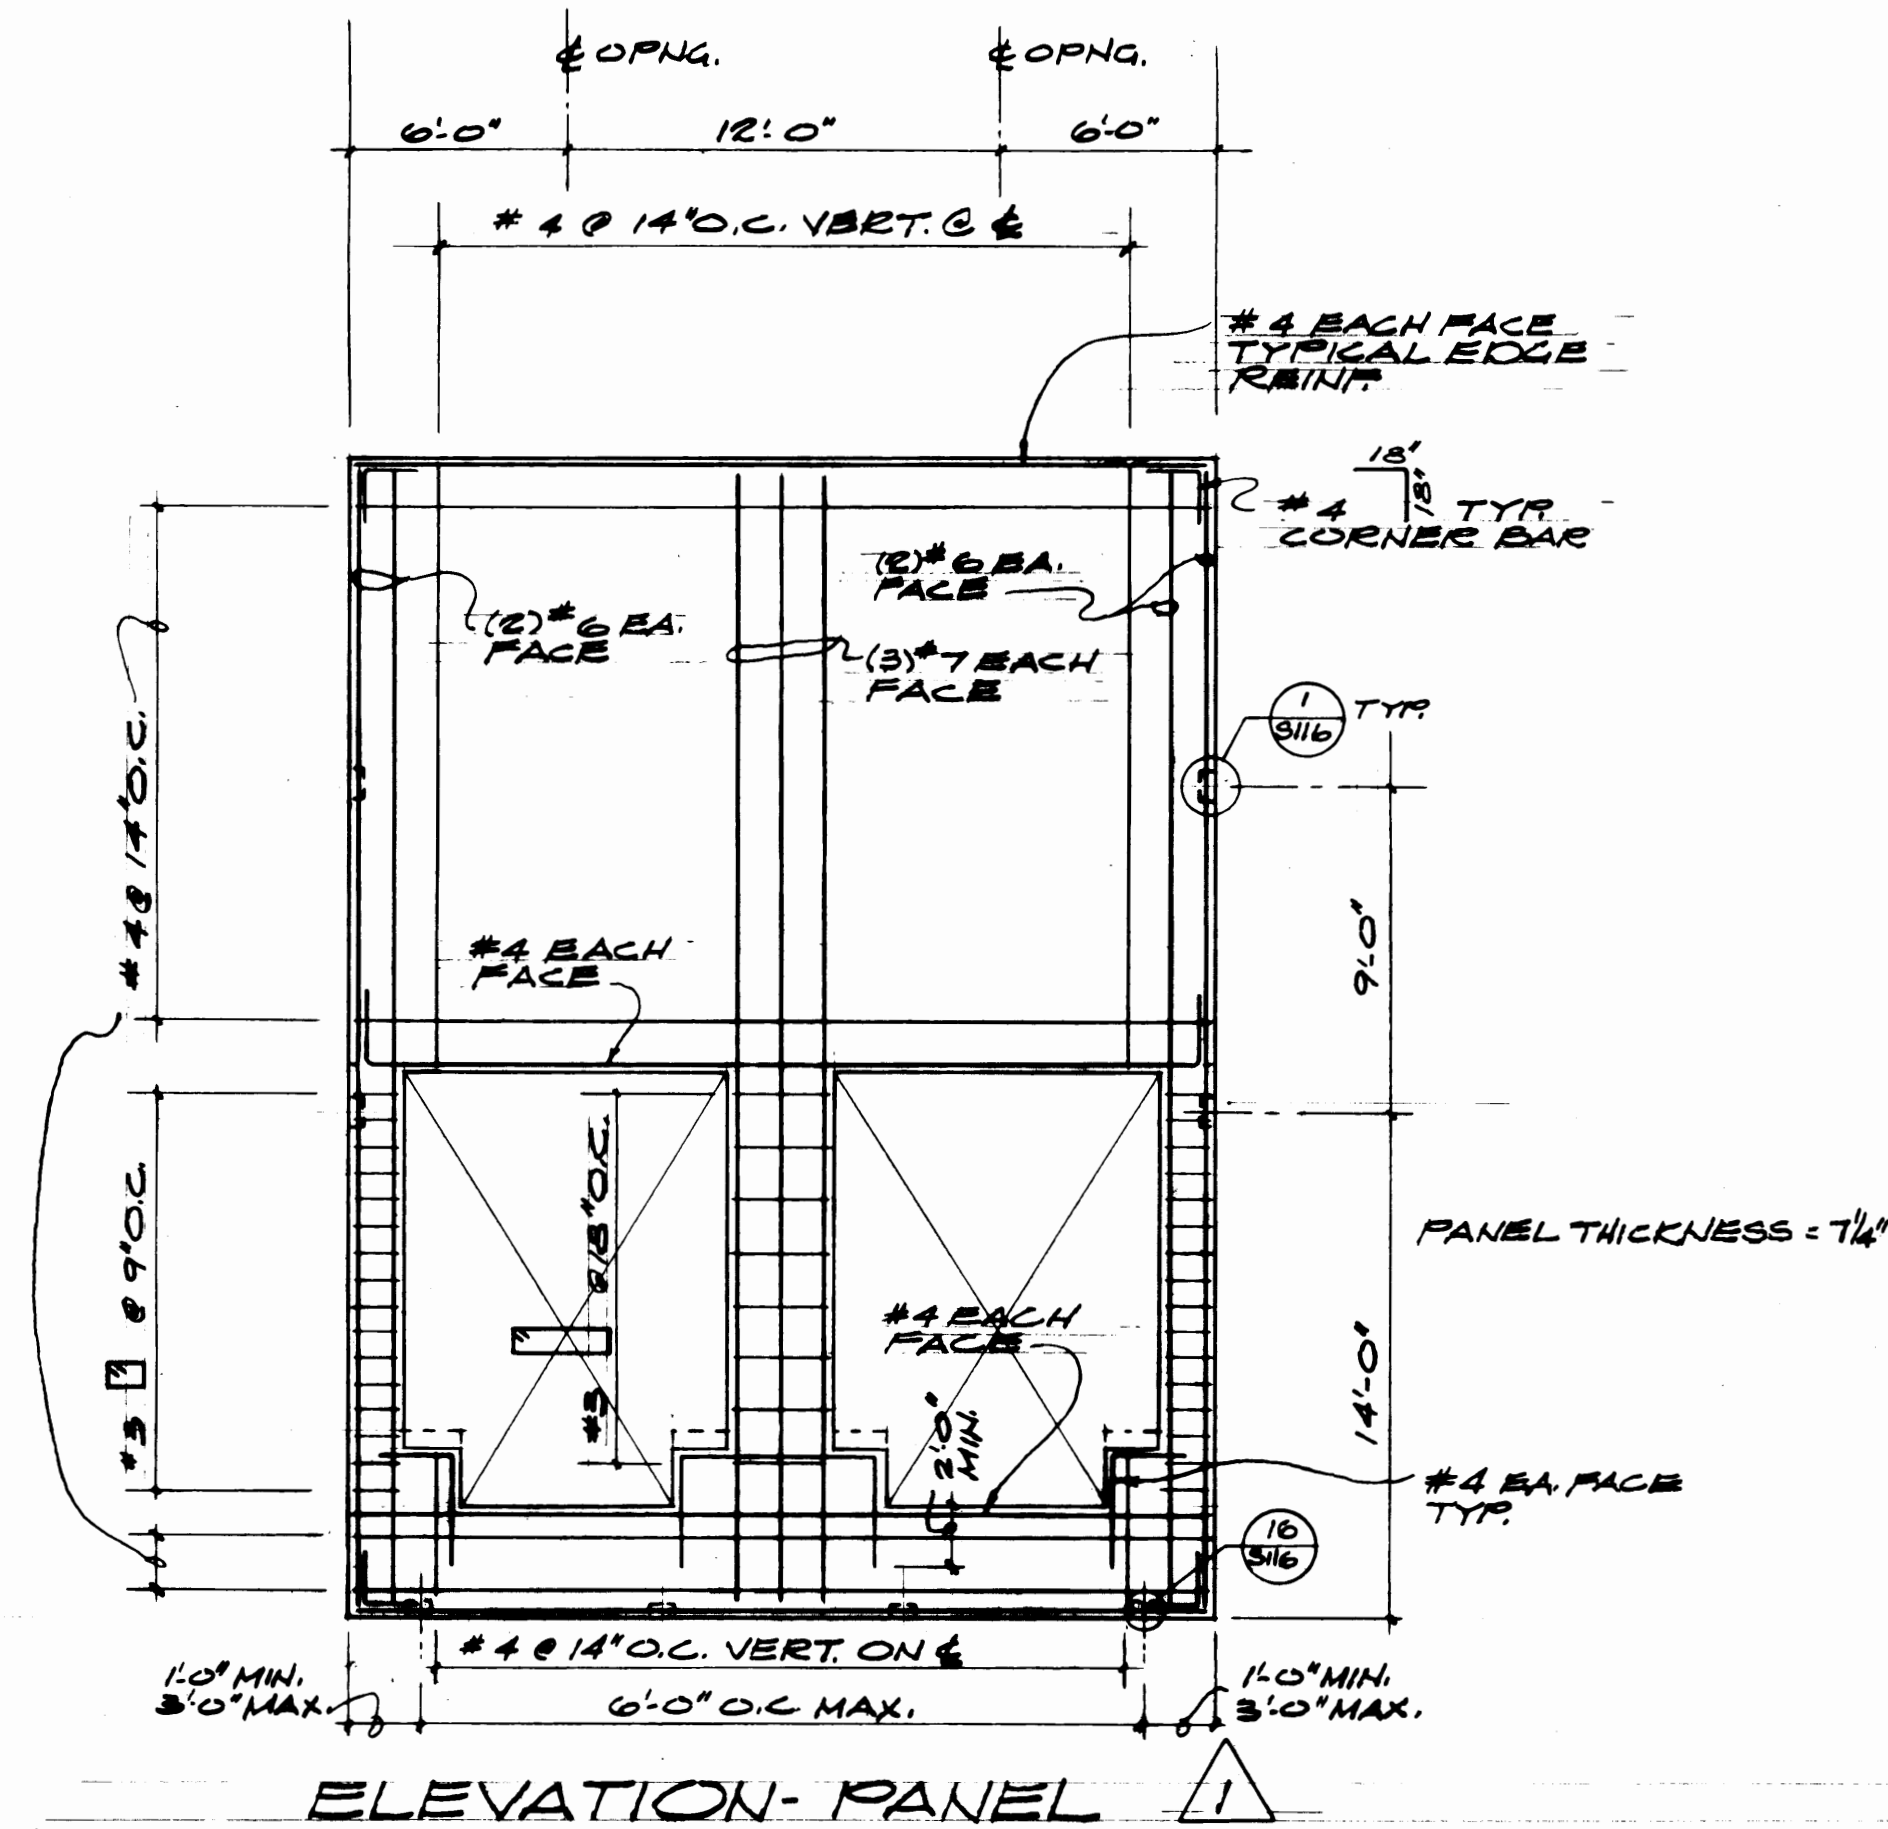


NOTE:
ALL PANELS ARE TO BE POURED
W/ EXTERIOR FACE DOWN.




Shelton Engineers, Inc.
Consulting Engineers
51 University, Suite 301
Boswell, VA 22011
(800) 828-4118
930 So. Forest, Suite 301
Tampa, VA 33608
(813) 283-0707

MARK	REVISION	BY	APP.	DATE
	NO AS-BUILT REVISIONS			3/21/84


DRAWN: N.N. DATE: 3-22-84		PORT OF TACOMA TACOMA TERMINALS, INC. C.F.S. BUILDING TILT-UP PANEL ELEVATIONS	
CHECKED: D.E. DATE: 3-22-84			
CHECKED: D.F. DATE: 3-22-84			
CONT. NO. 557			
FIELD BOOK (S)		APPROVED: [Signature] DATE: 3/30/84	SCALE:
DRAWING NO.		DATE: 3/20/84	DATE: 3/20/84
SHEET: 28 OF 71		J-5506	

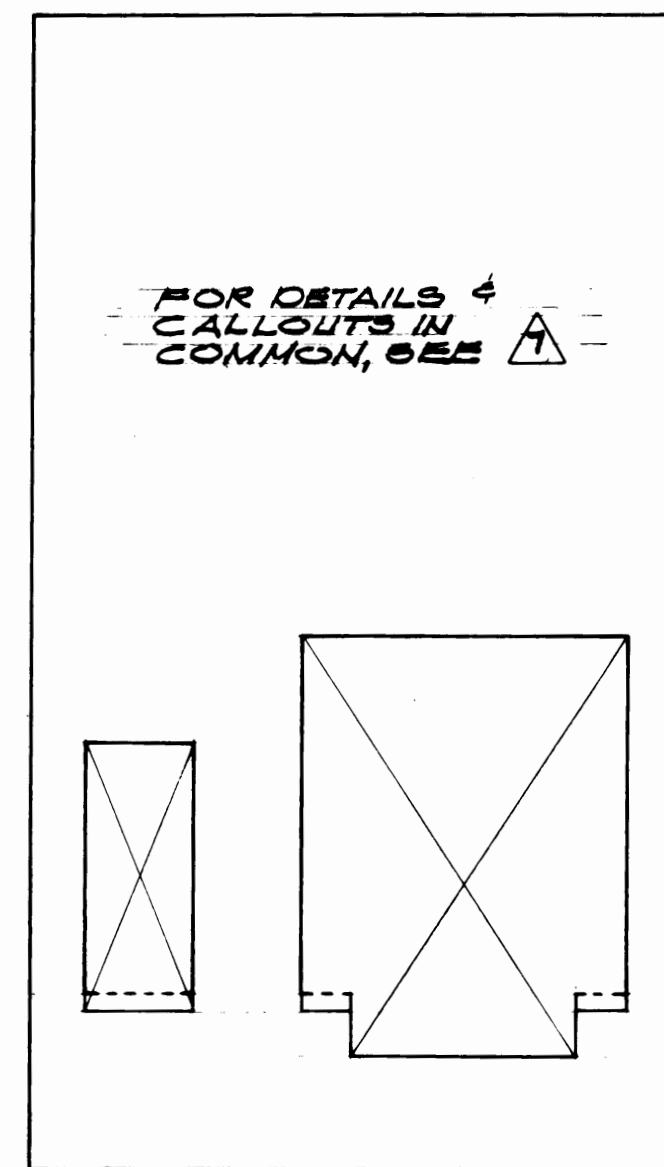


ELEVATION-PANEL 13

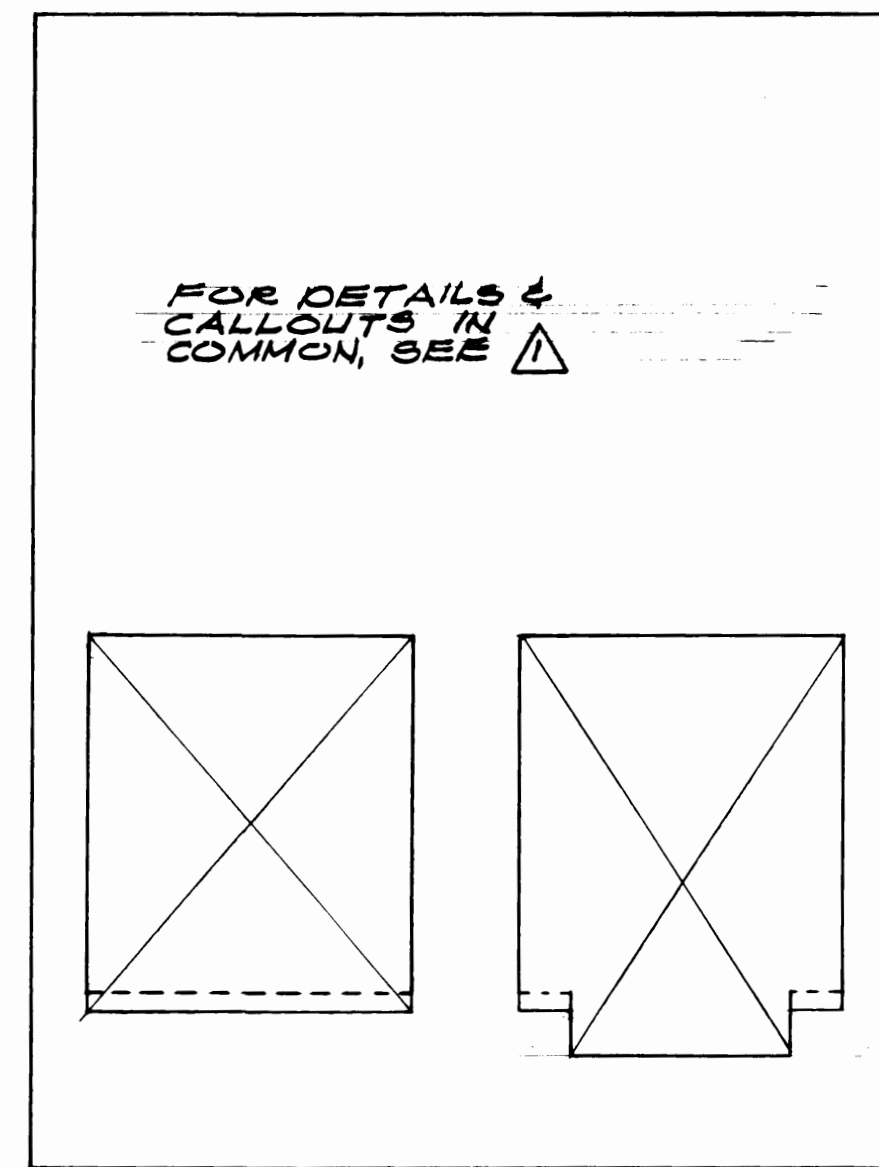


ELEVATION-PANEL 14

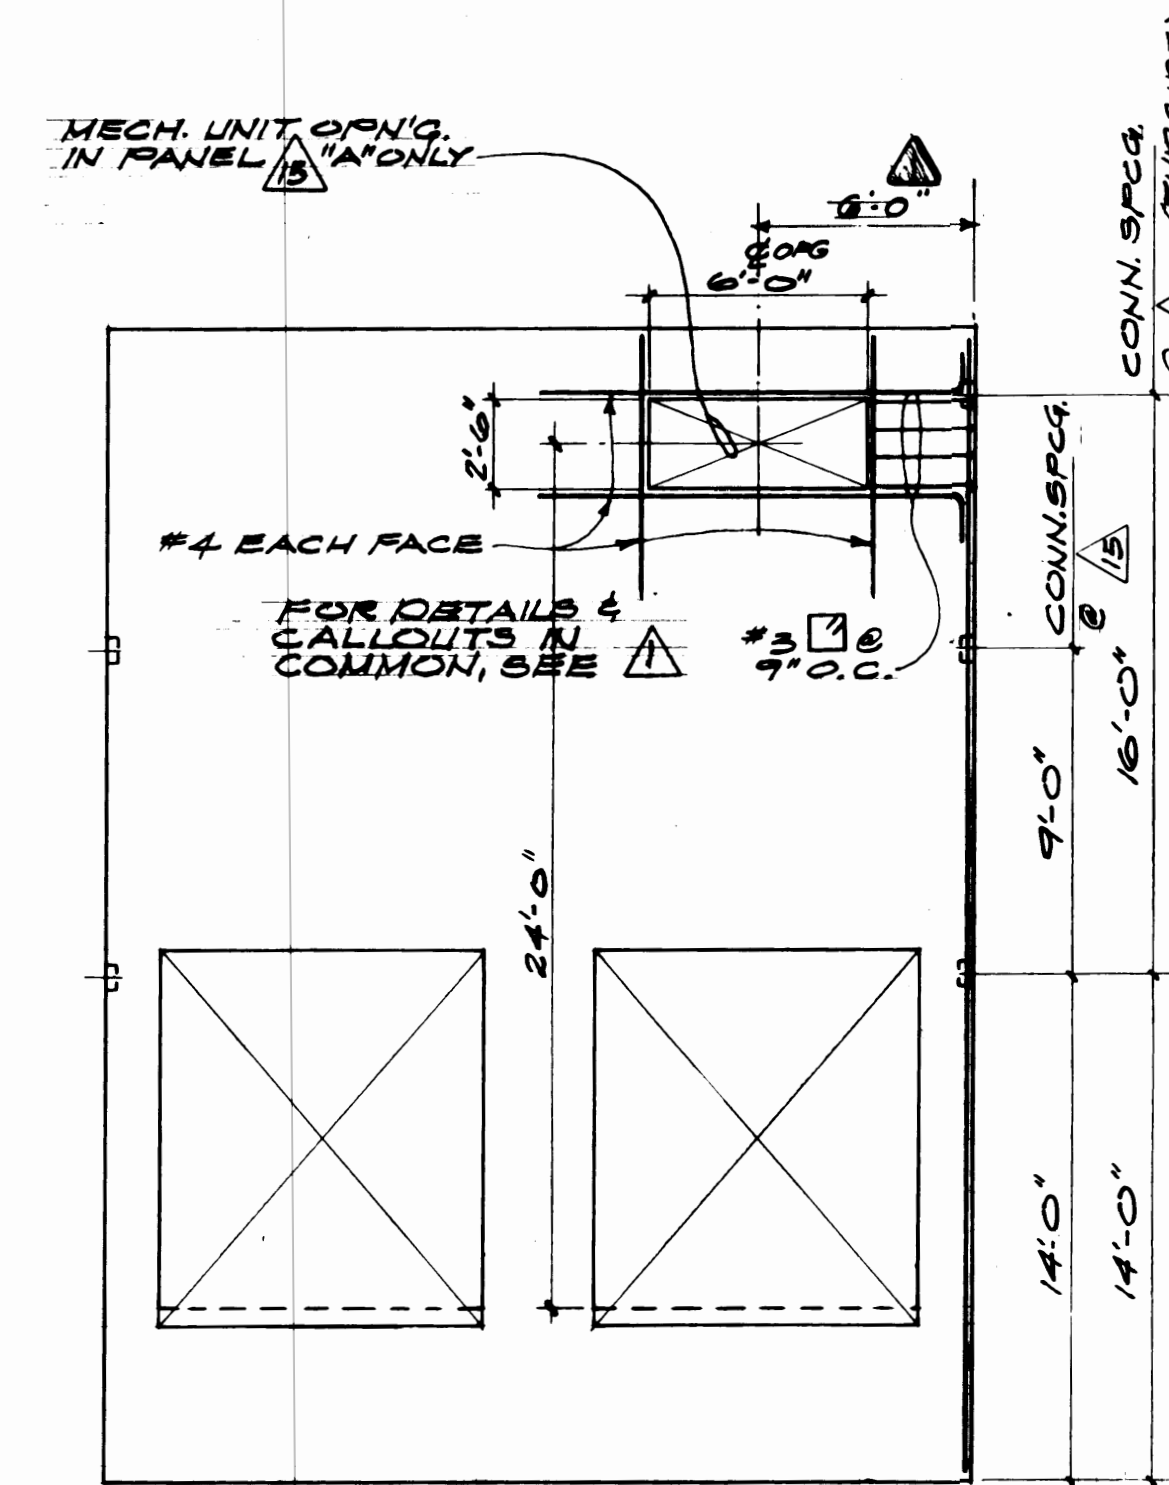


ELEVATION-PANEL 15 15A

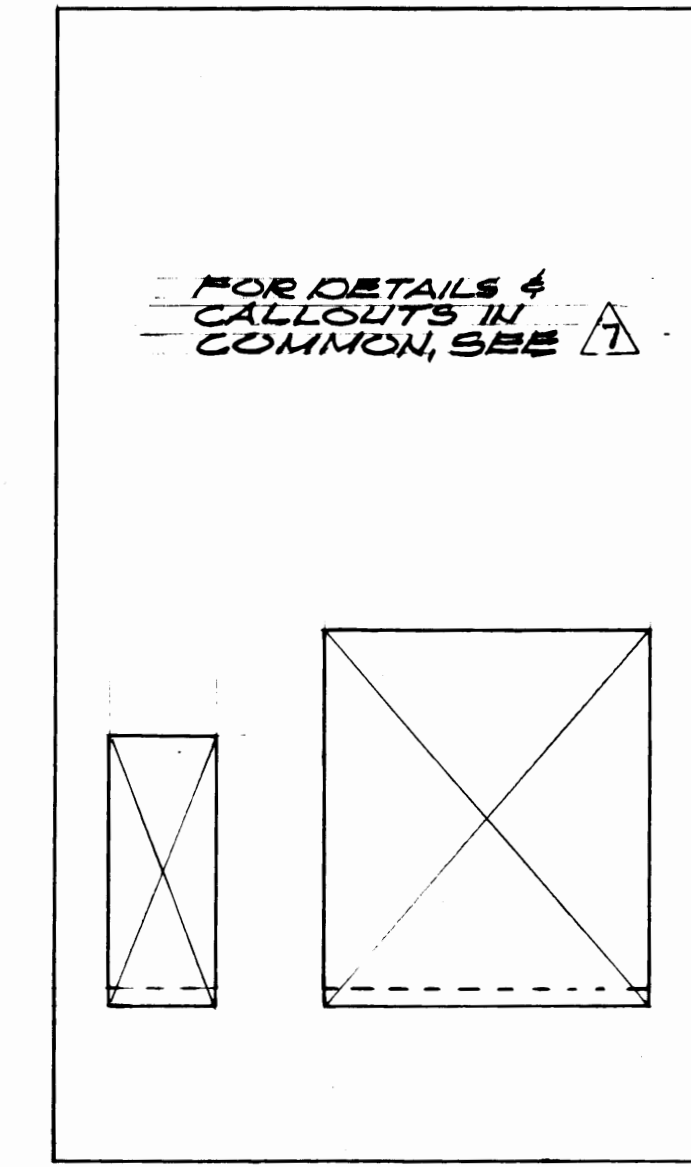


ELEVATION-PANEL 16

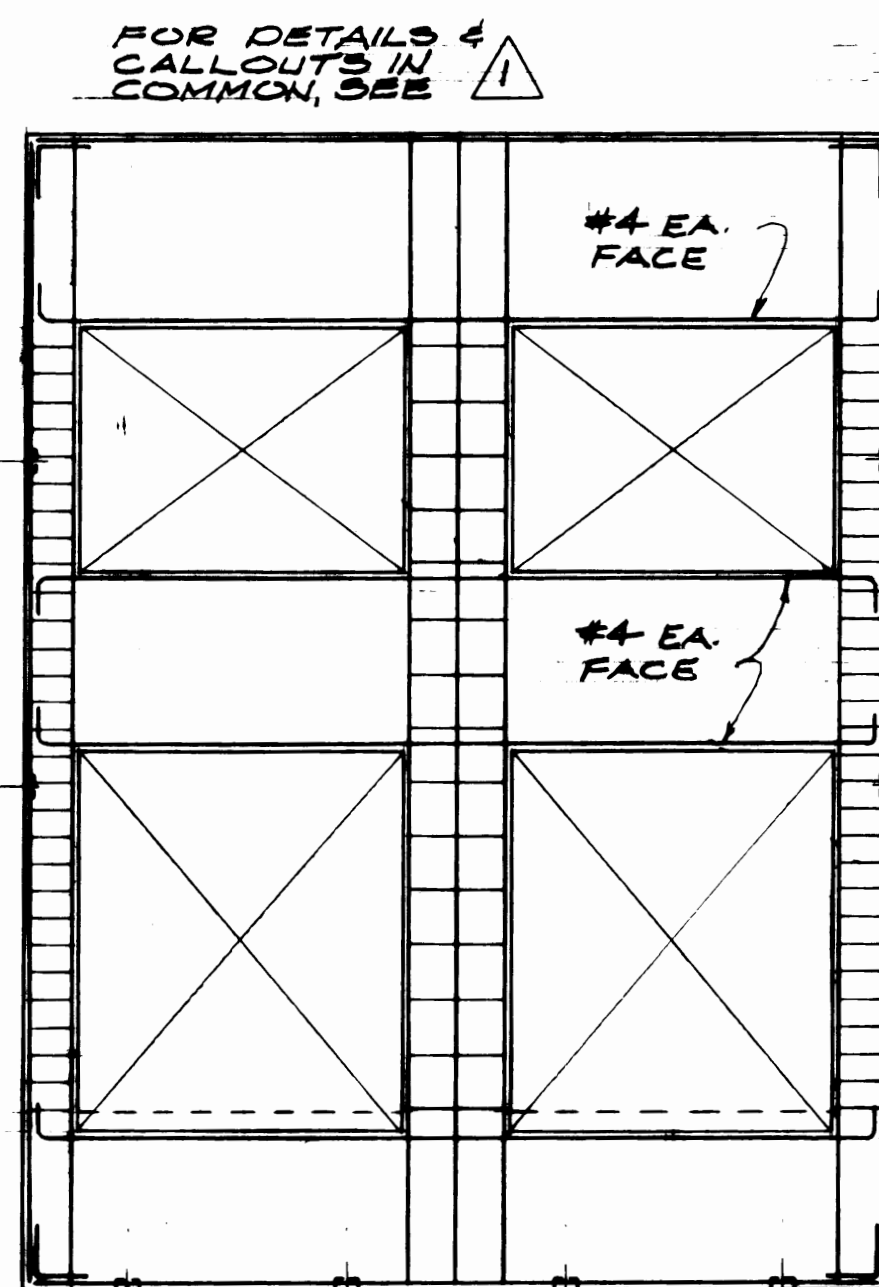


ELEVATION-PANEL 17

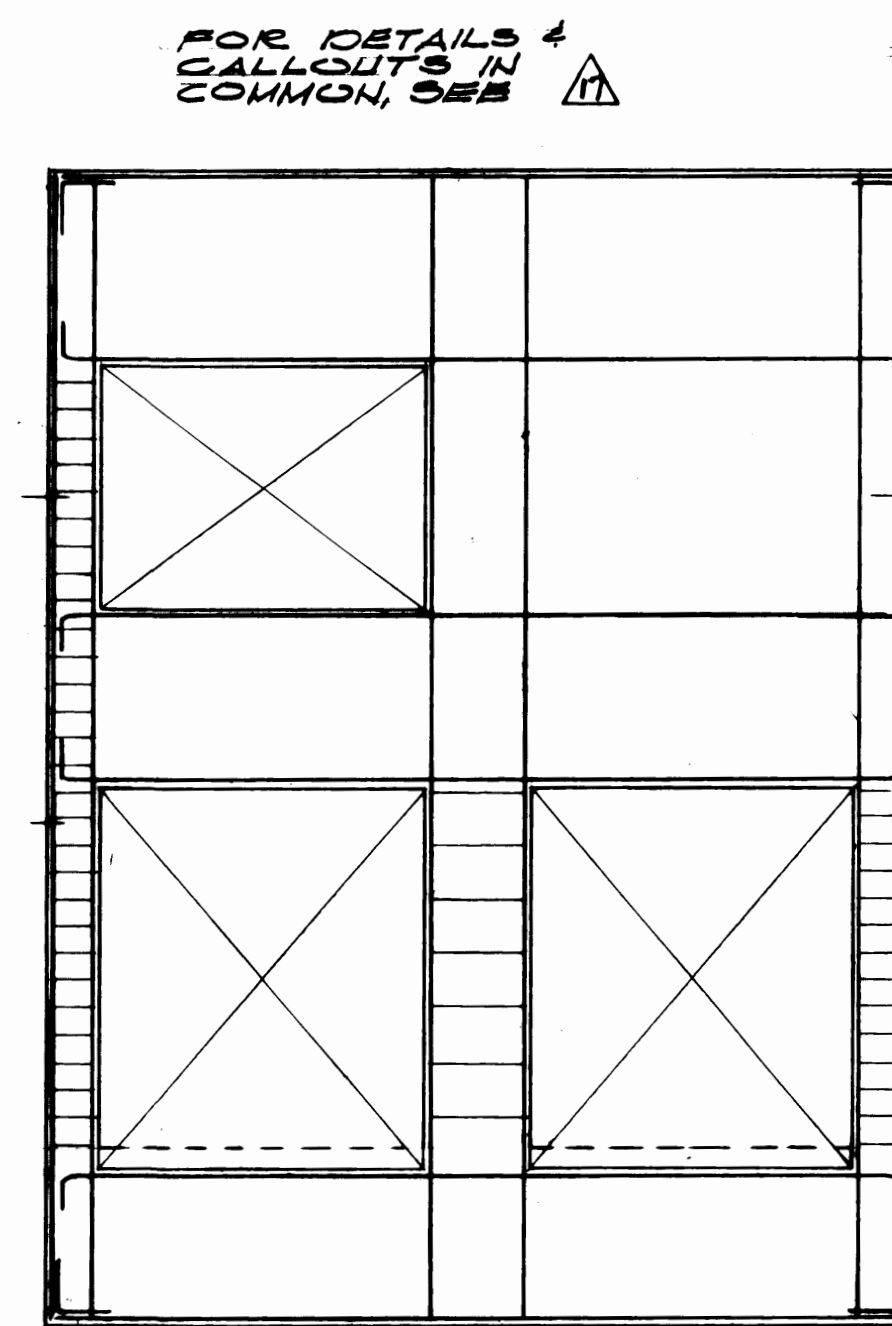

ELEVATION-PANEL 18

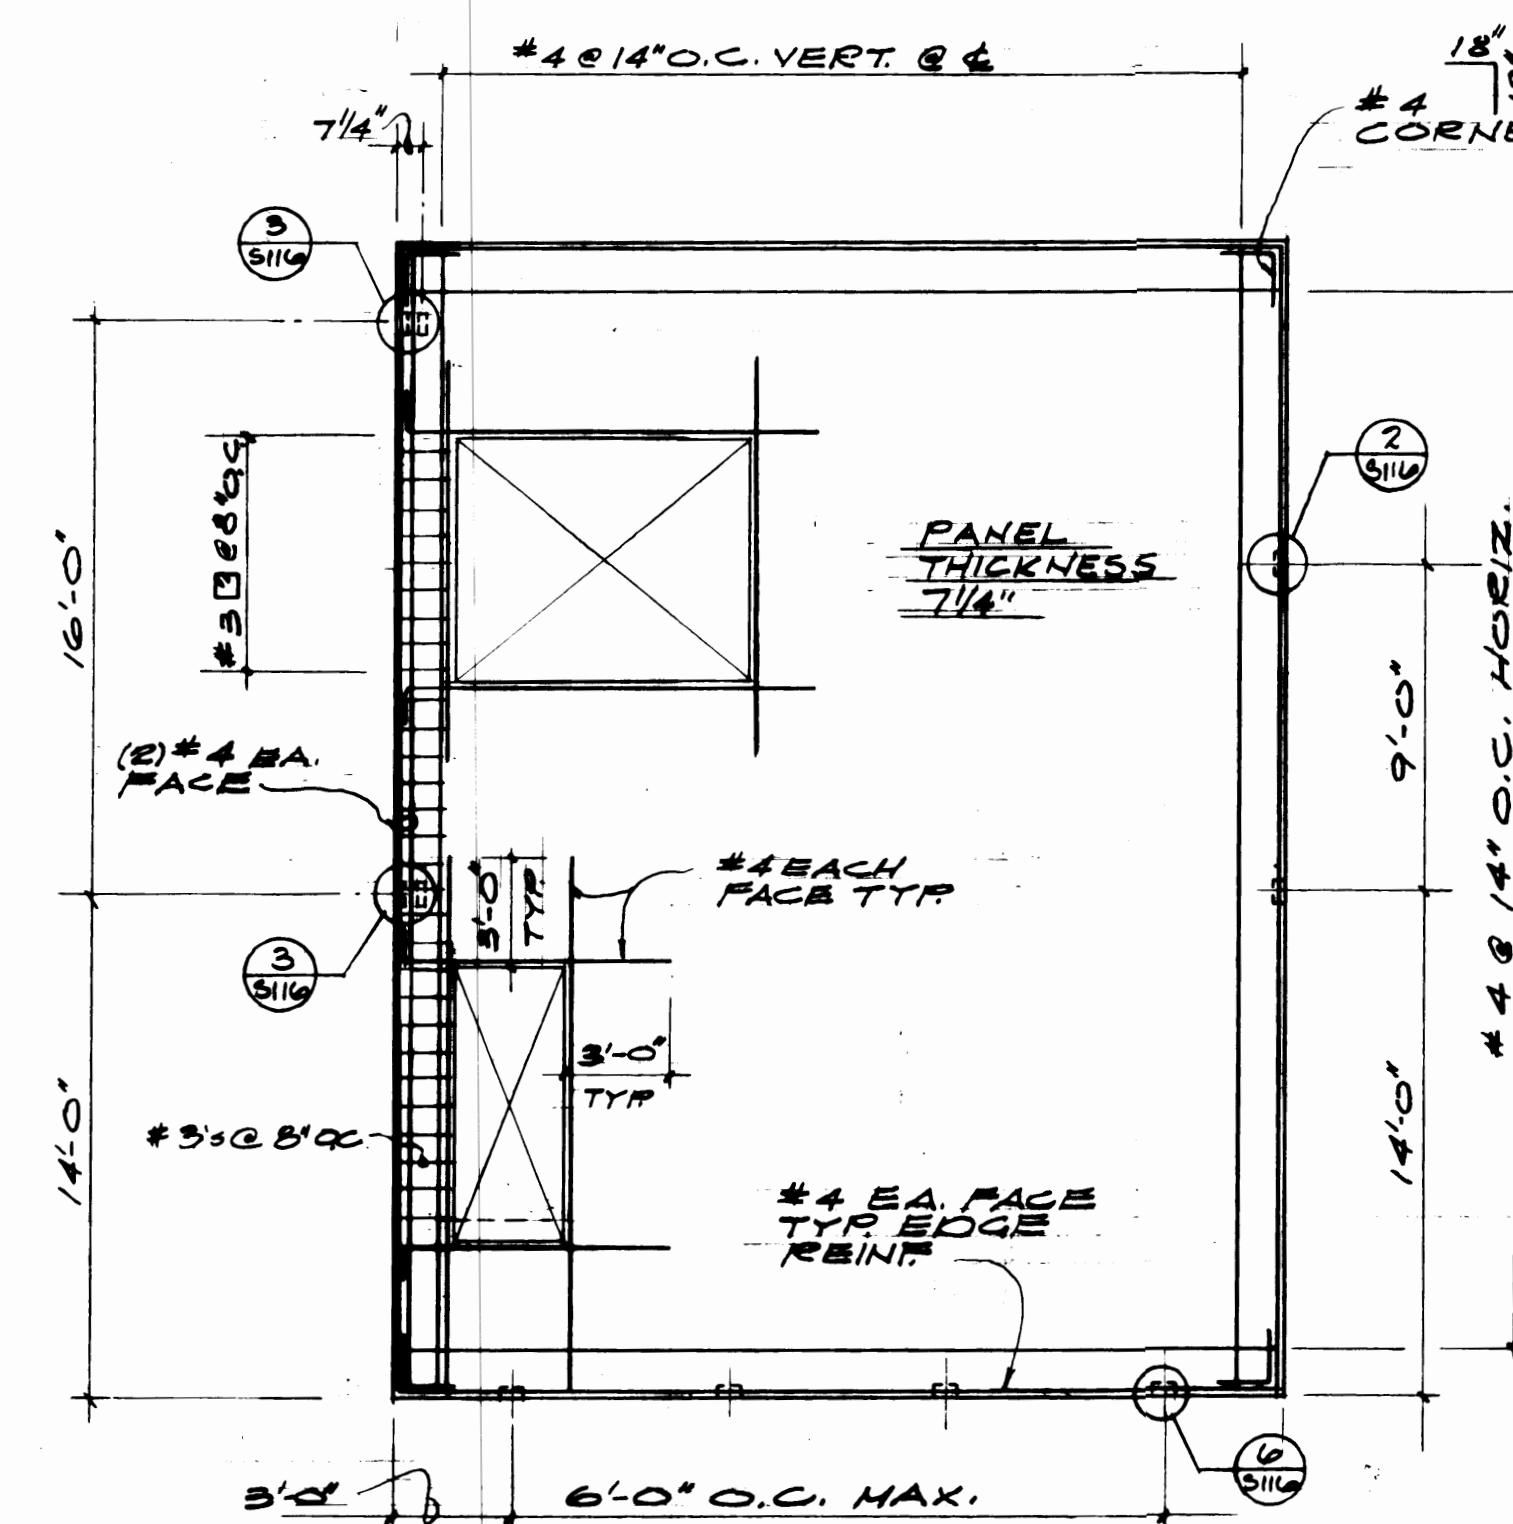

ELEVATION-PANEL 19

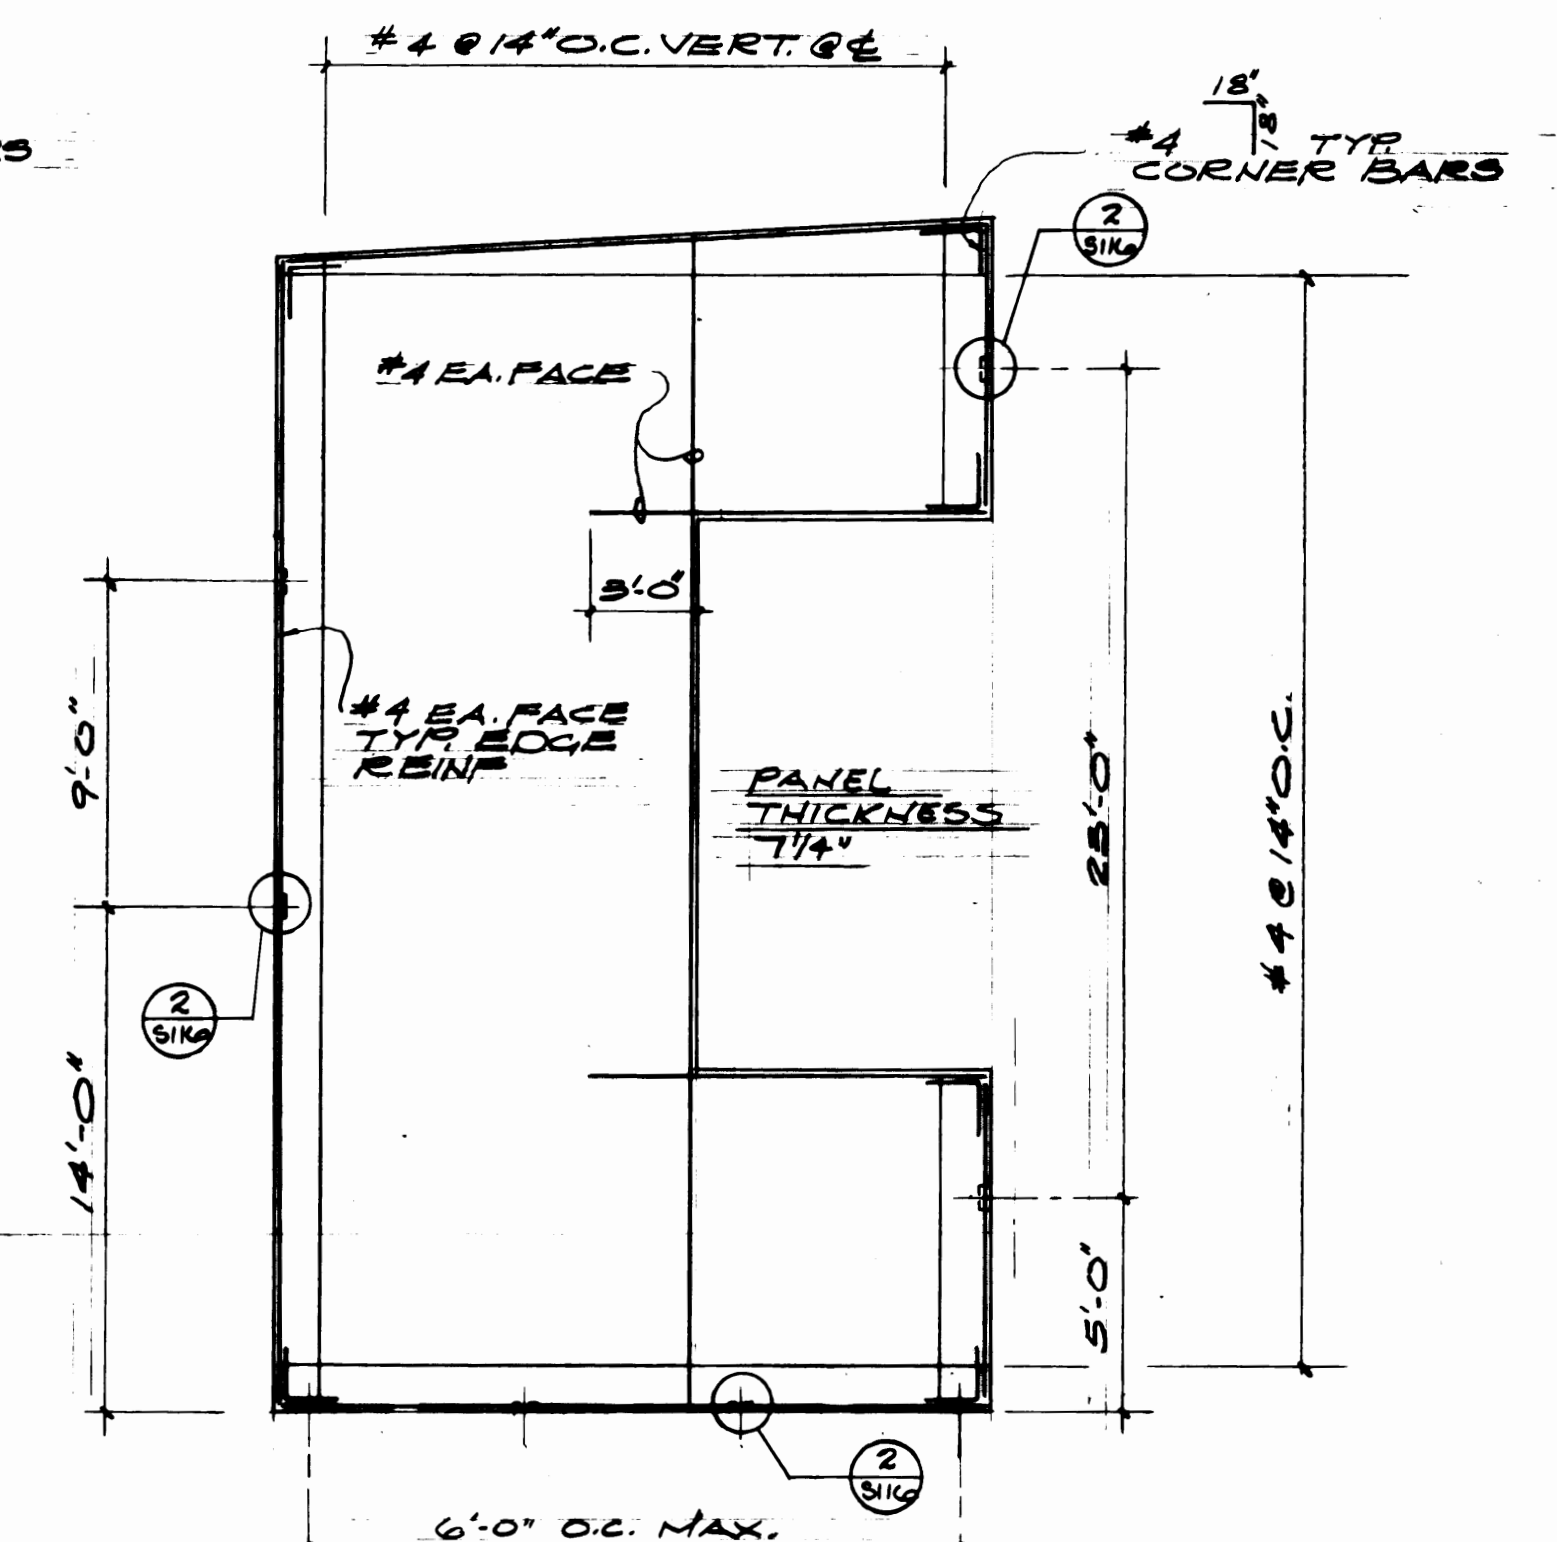

ELEVATION-PANEL 20




Checked by: [Signature]
 Date: 3/22/84
 Drawn by: [Signature]
 Date: 3/22/84


REVISION	BY	APP.	DATE
REVISED TO AS BUILT	RJS		3/22/84

DRAWN: N.N.		DATE: 3-22-84	
CHECKED: D.S.		DATE: 3-22-84	
CHECKED: D.P.		DATE: 3-22-84	
CONT. NO. 557		FIELD BOOK (S)	
APPROVED: [Signature]		DATE: 3/30/84	
PROJECT MANAGER: [Signature]		DATE: 3/20/84	
SCALE		DRAWING NO.	
		EP 3879-23 -3114	
		SHEET 30 OF 71	


W. H. H. H.

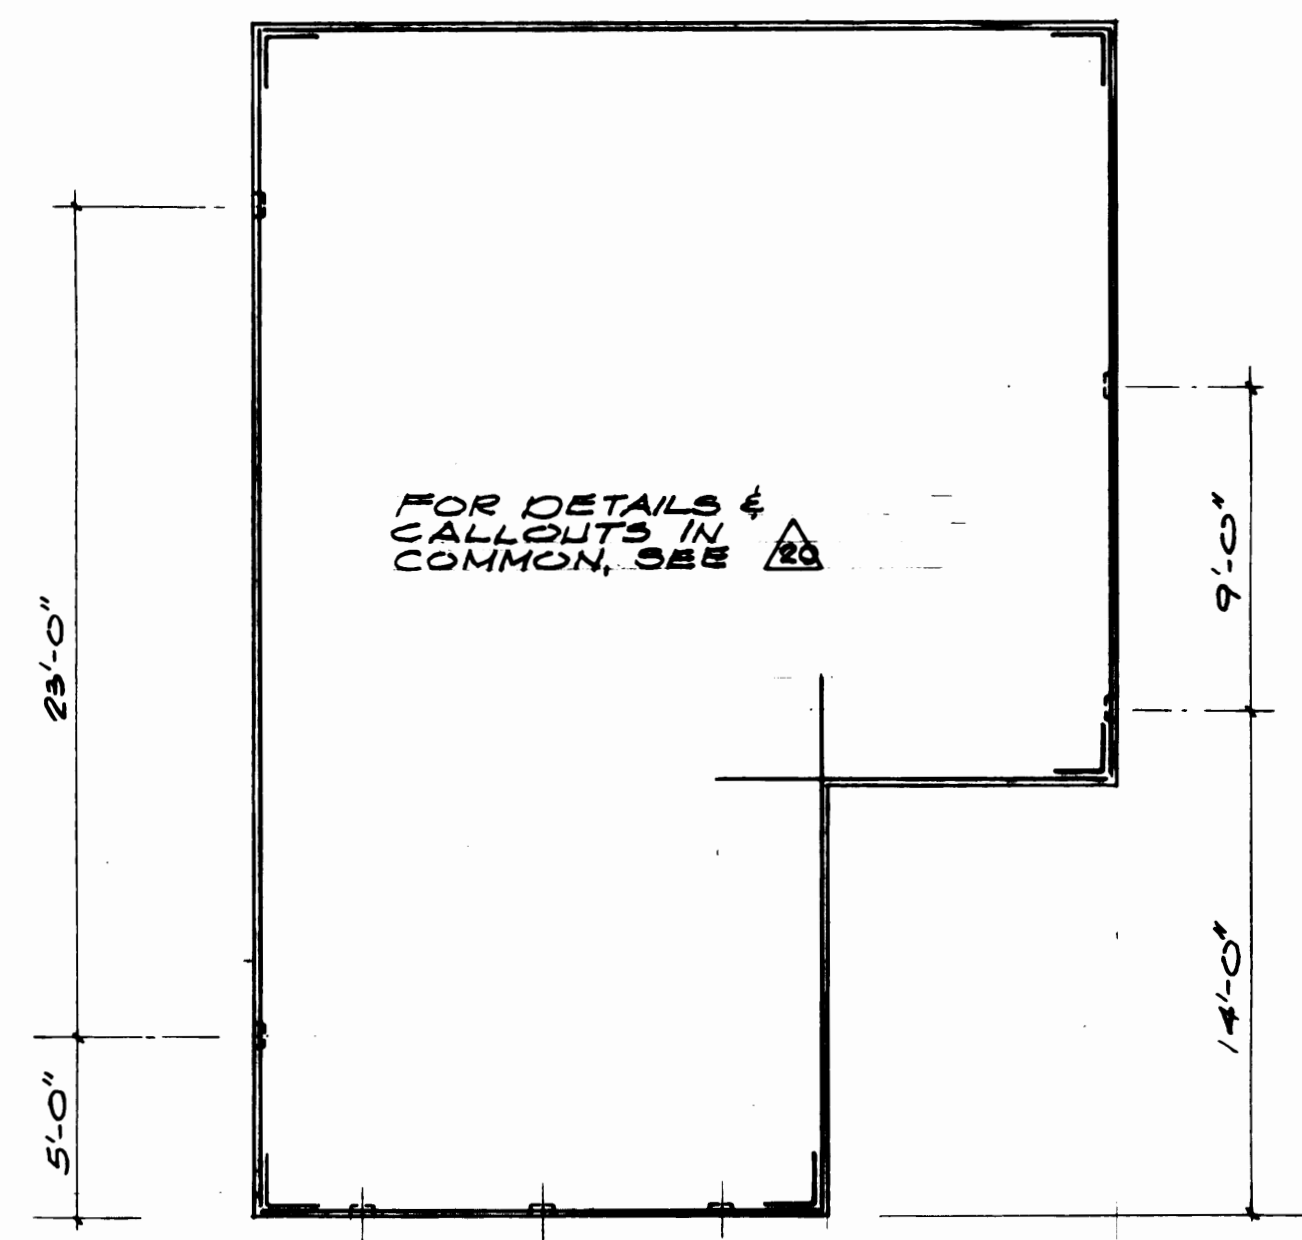


ELEVATION-PANEL 21

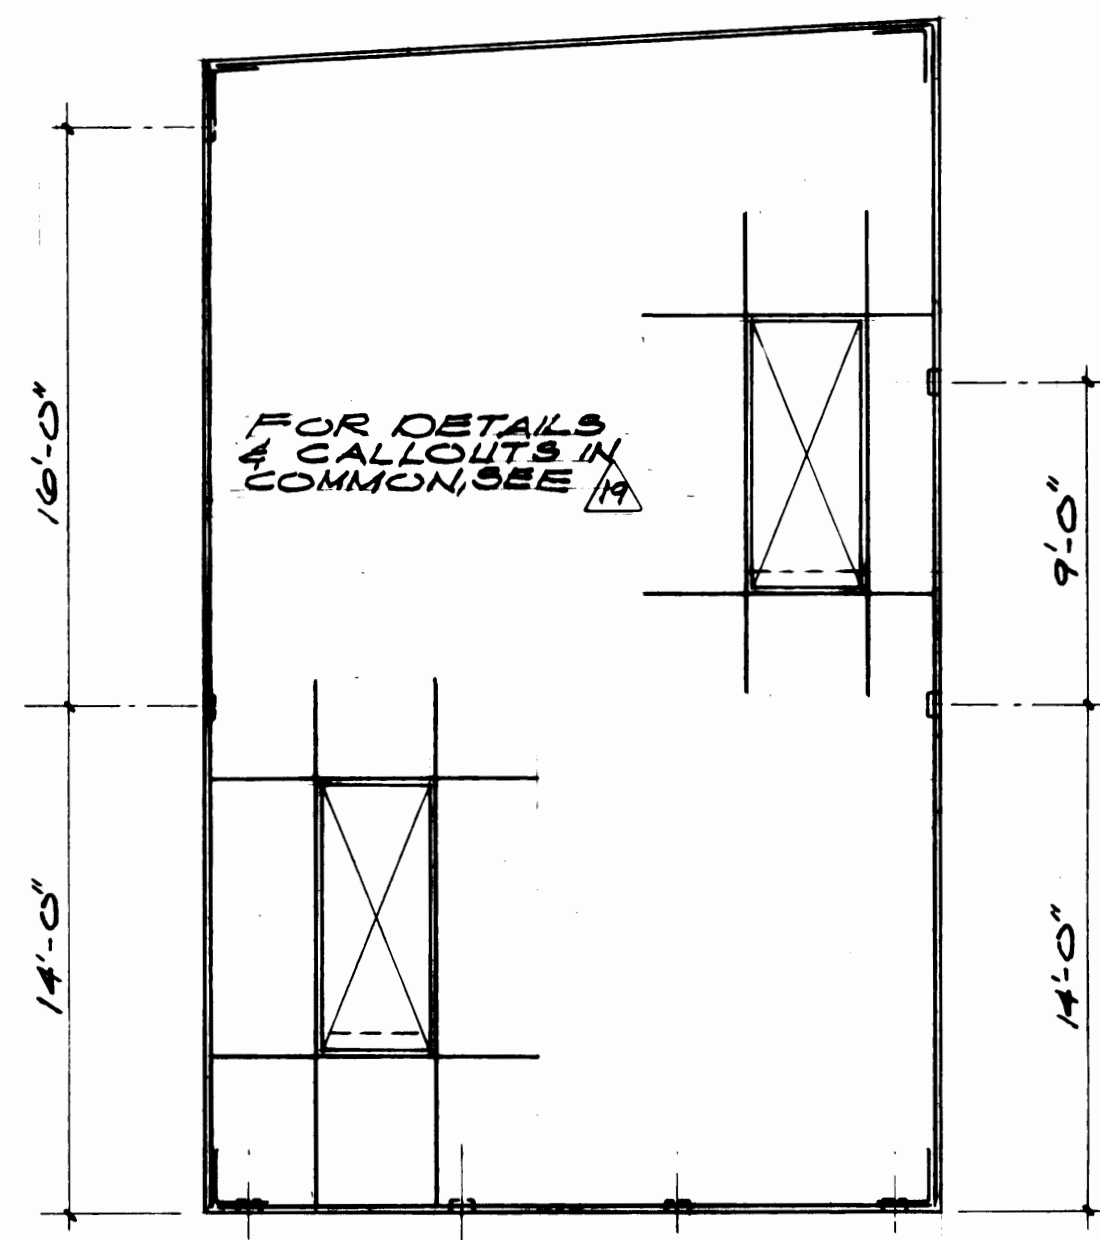


ELEVATION-PANEL 22

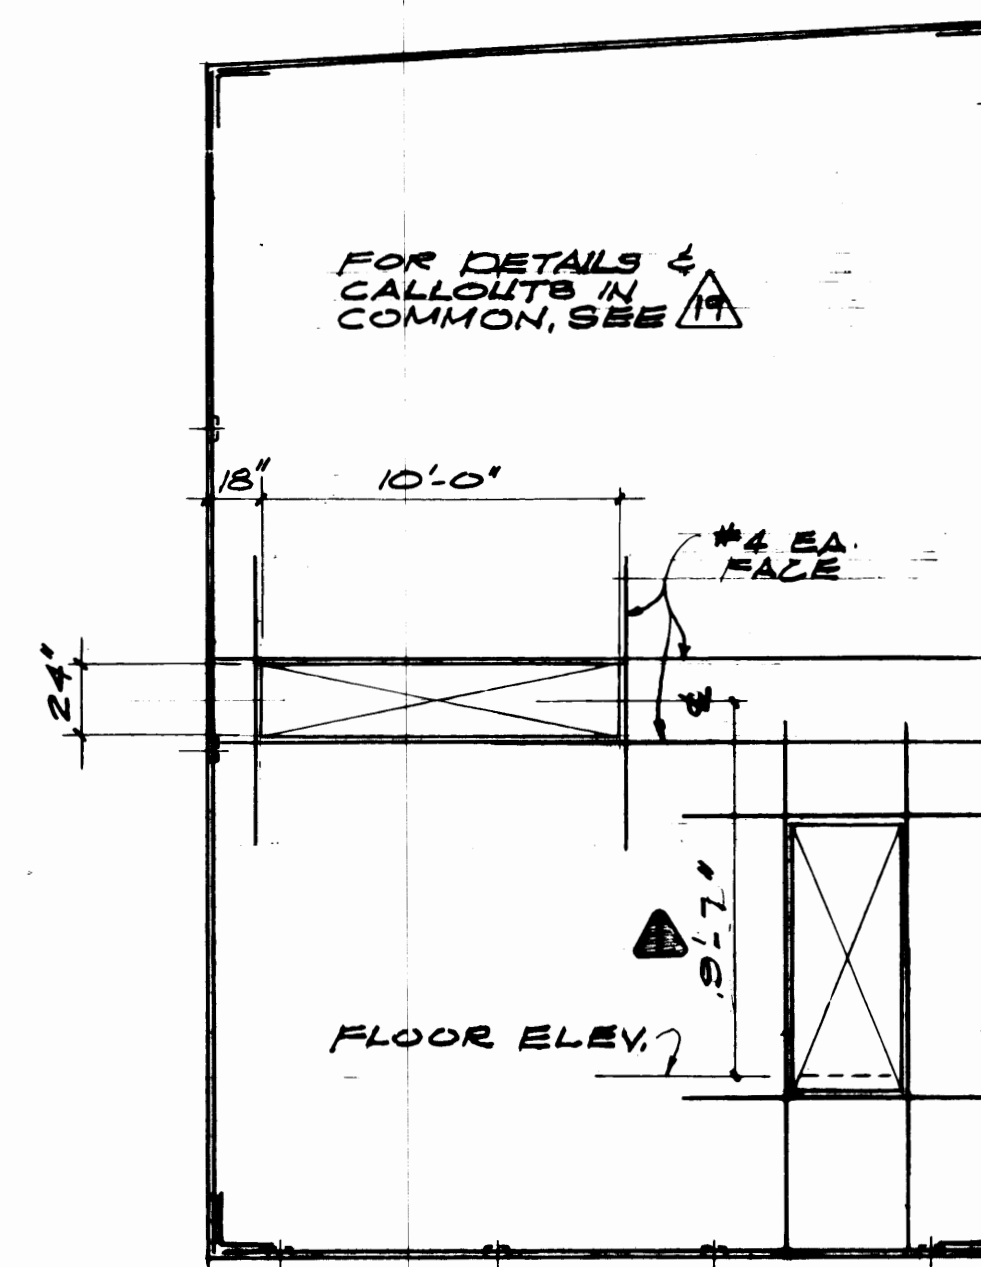


ELEVATION-PANEL 23

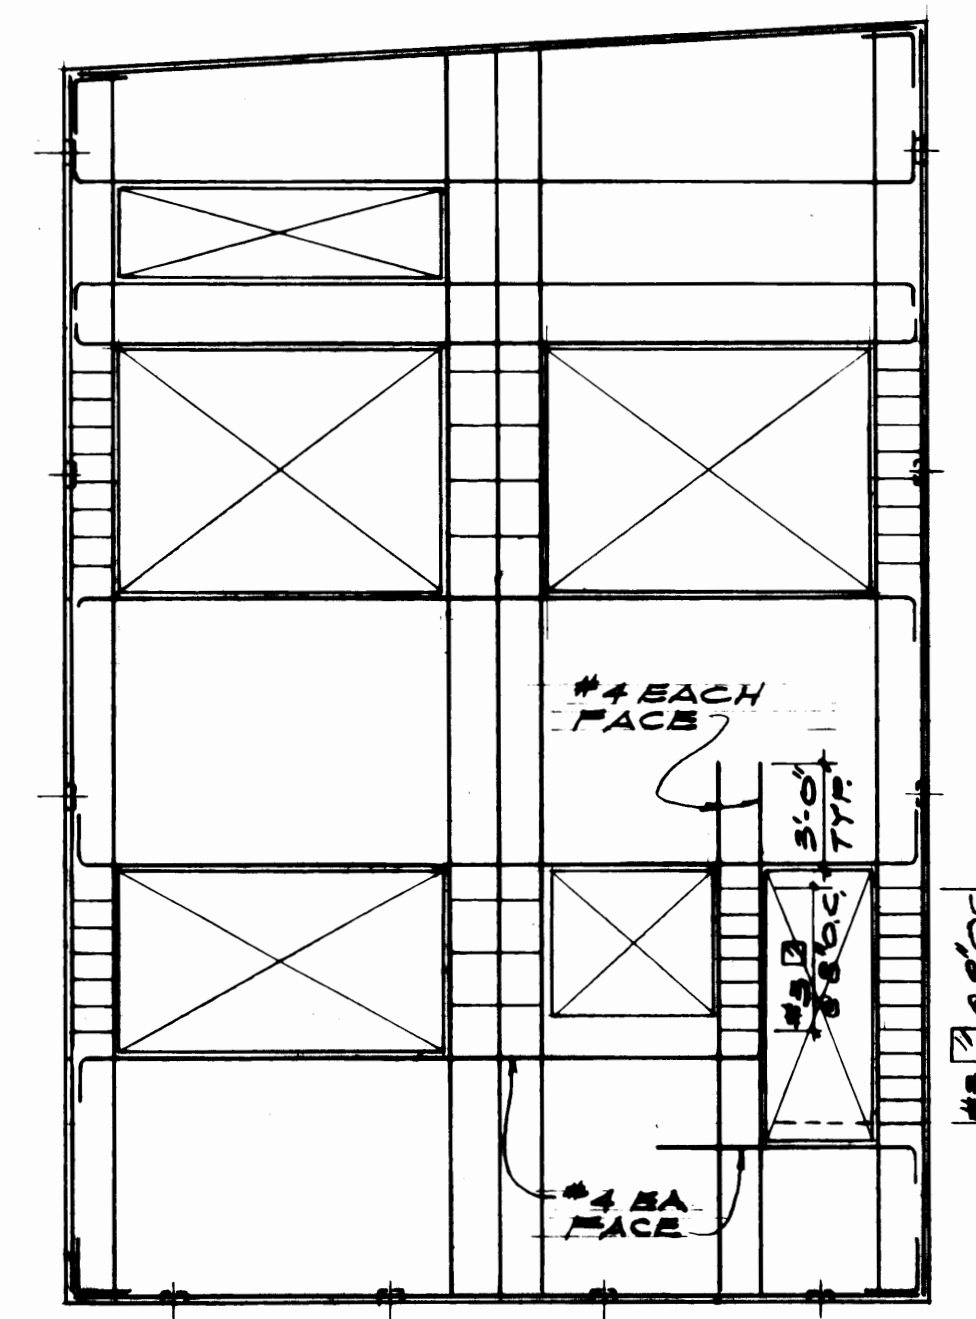


ELEVATION-PANEL 24

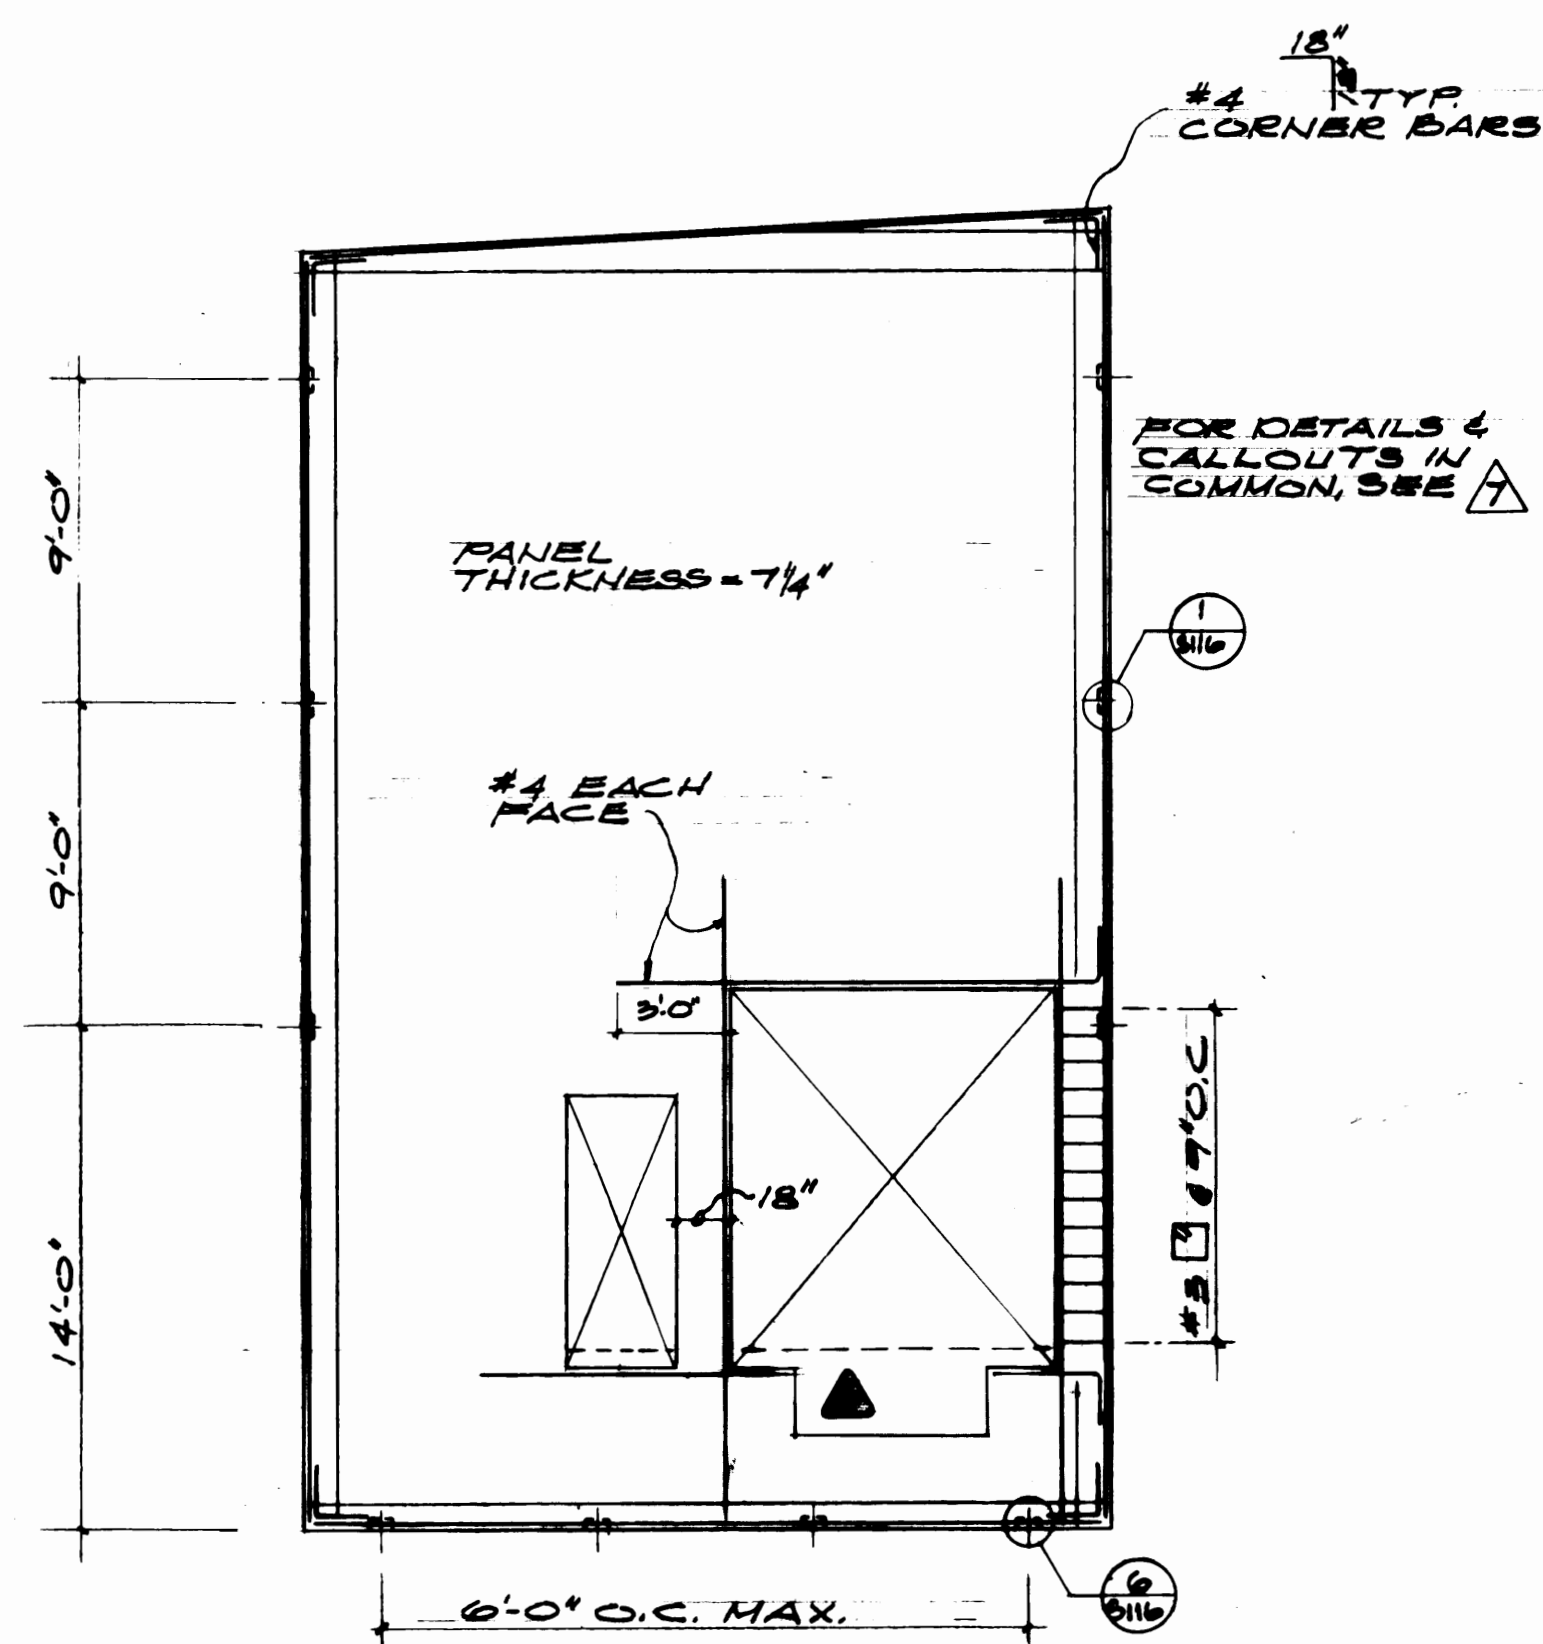


ELEVATION-PANEL 25

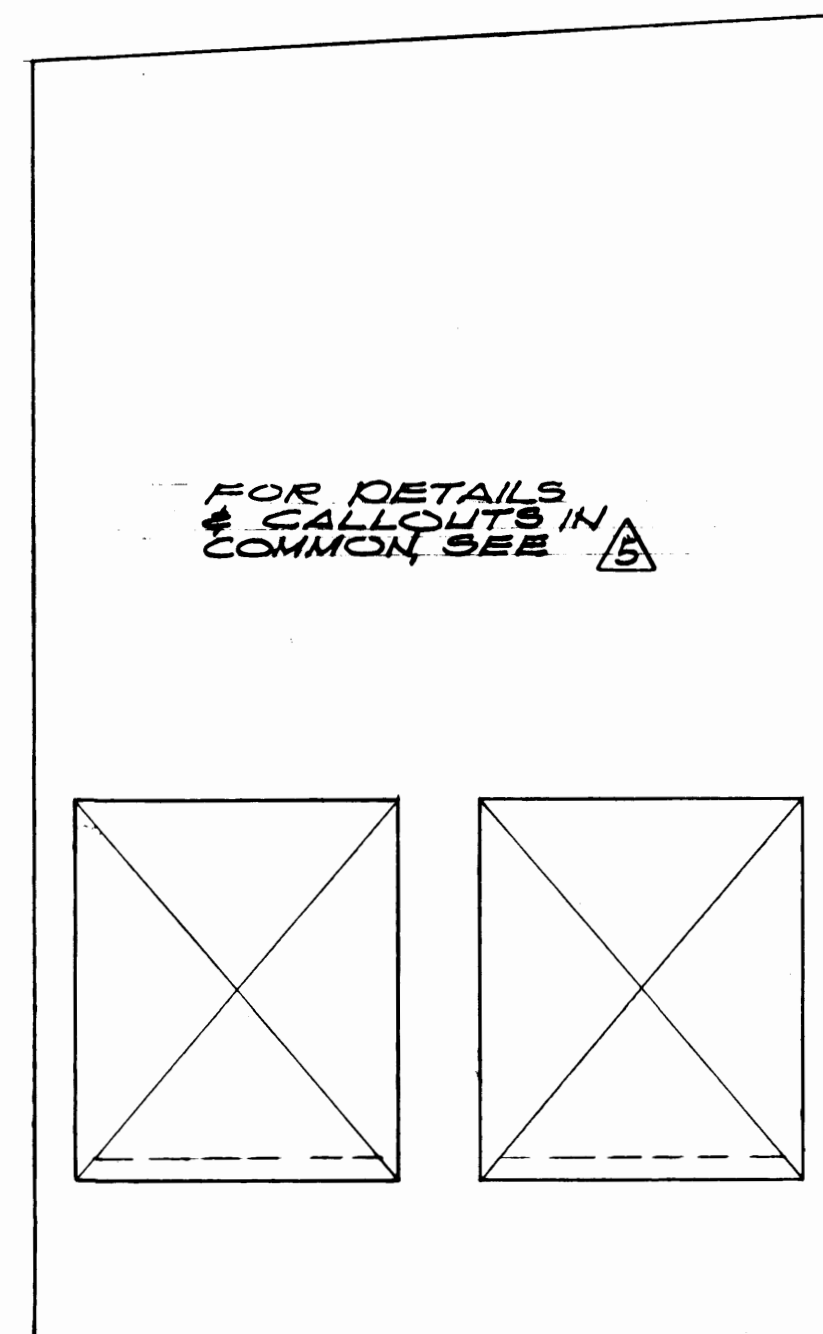


ELEVATION-PANEL 26

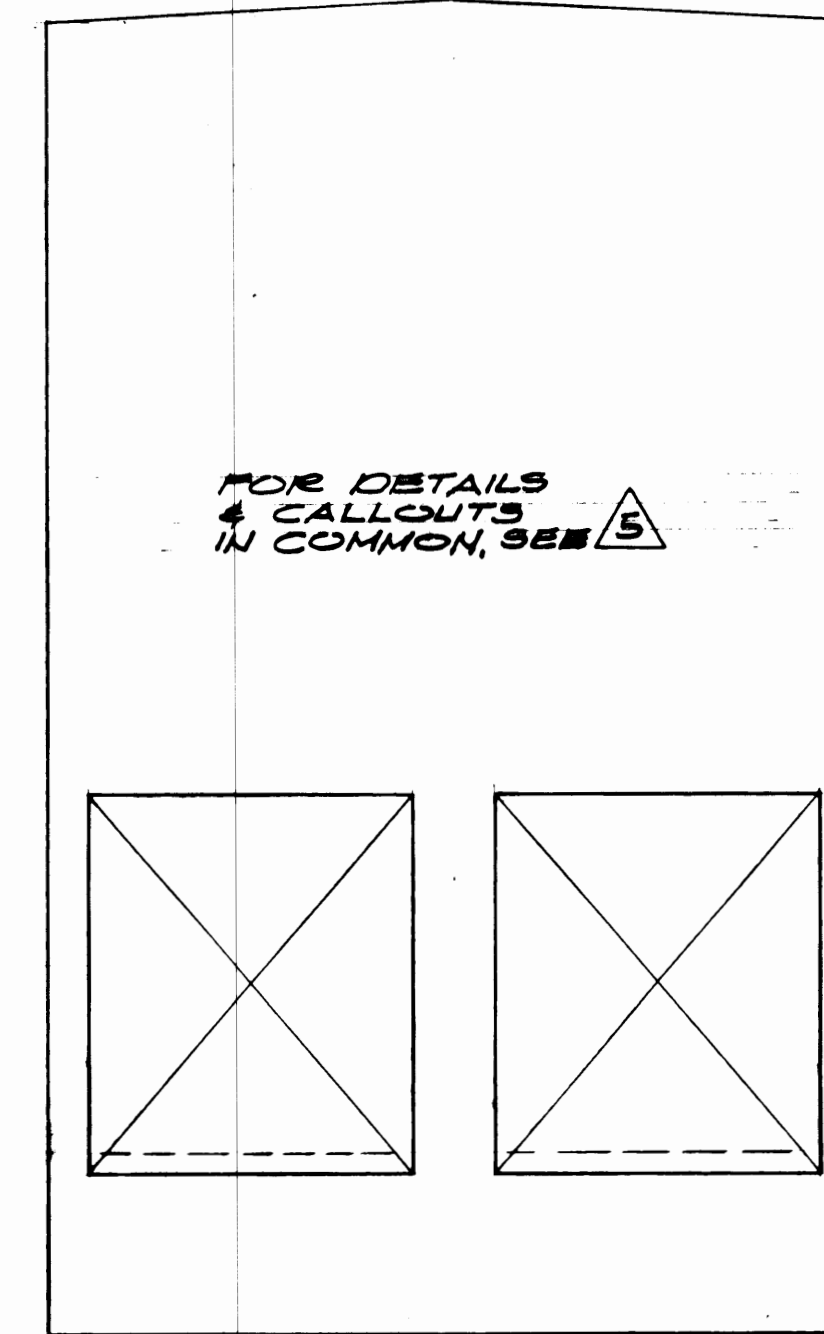


ELEVATION-PANEL 27

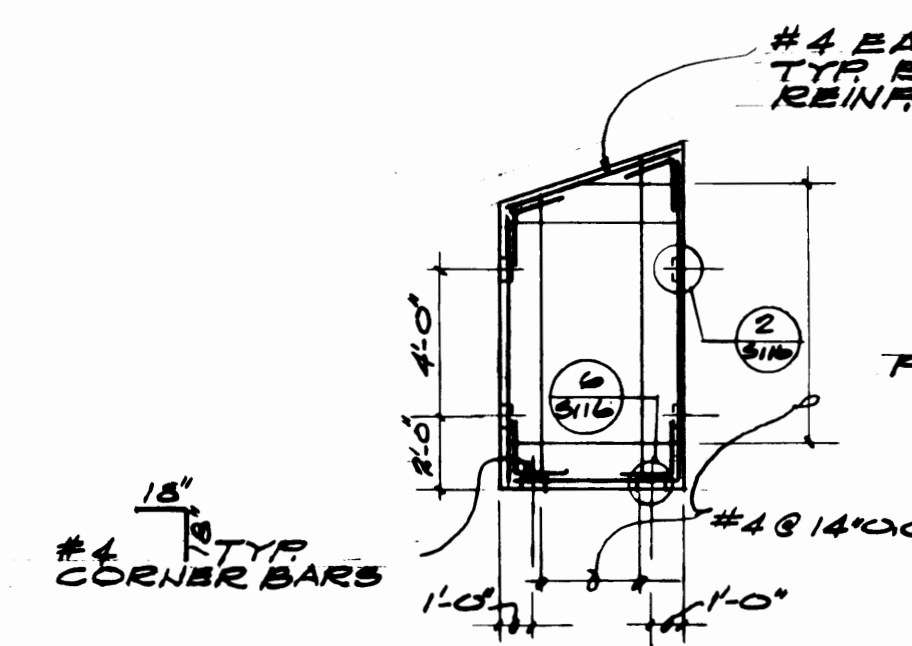

ELEVATION-PANEL 28

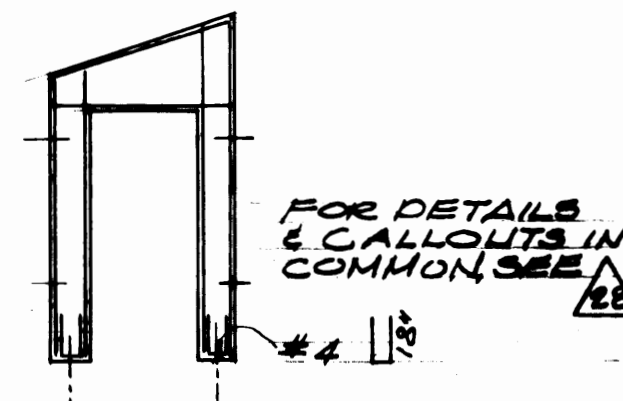

PANEL 29

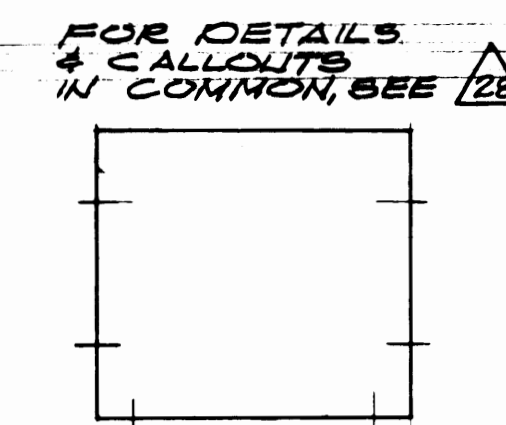

PANEL 30




Shelton Engineers, Inc.
Consulting Engineers
51 University, Suite 301
South, VA 22071
(800) 888-4116
550 E. Pennell, Suite 301
Tacoma, WA 98402
(206) 266-4767

MARK	REVISION	BY	APP.	DATE
	REVISED TO AS BUILT	R.J.S.		3/30/84


DRAWN: N.N.		DATE: 3-22-84	
CHECKED: D.B.		DATE: 3-22-84	
CHECKED: D.P.		DATE: 3-22-84	
CONT. NO. 557			
FIELD BOOK (S)			
APPROVED: <i>Robert J. Smith</i>		DATE: 3/30/84	
PROJECT MANAGER: <i>Robert J. Smith</i>		DATE: 3/30/84	
SCALE		DRAWING NO.	
		EP 3079-23 - 3112	
		SHEET 31 OF 71	

PORT OF TACOMA


TACOMA TERMINALS, INC.
C.F.S. BUILDING
TILT-UP PANEL ELEVATIONS

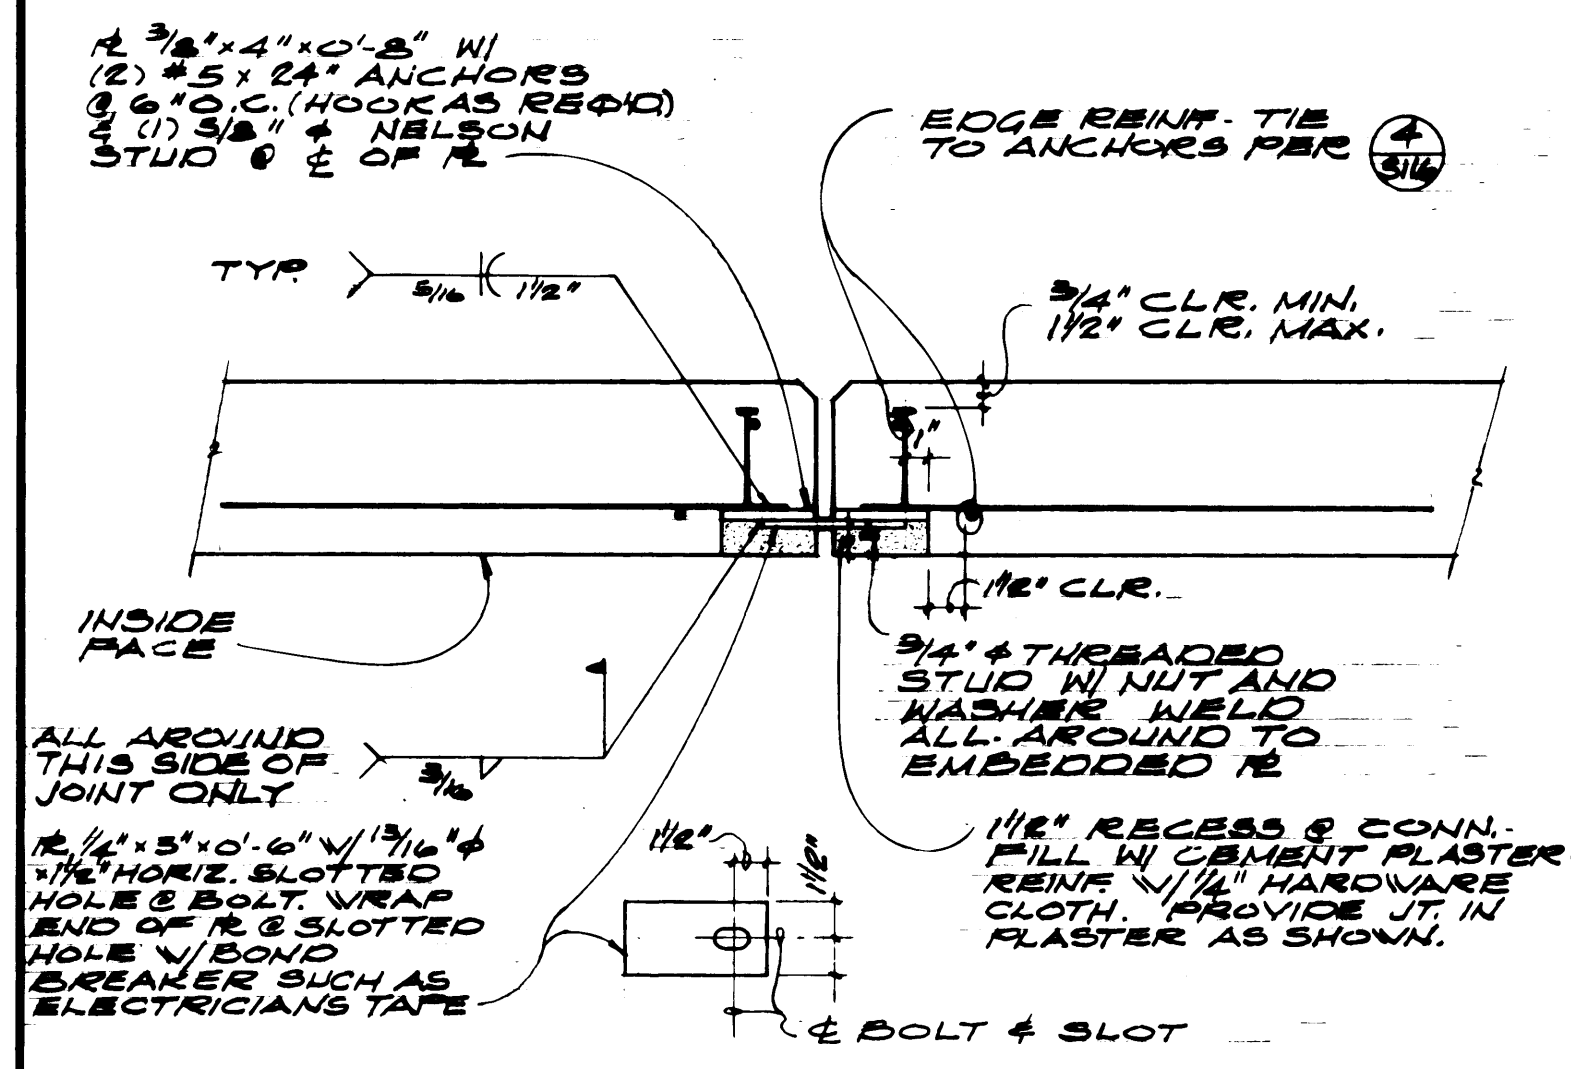


DETAIL 1
1/2\"/>

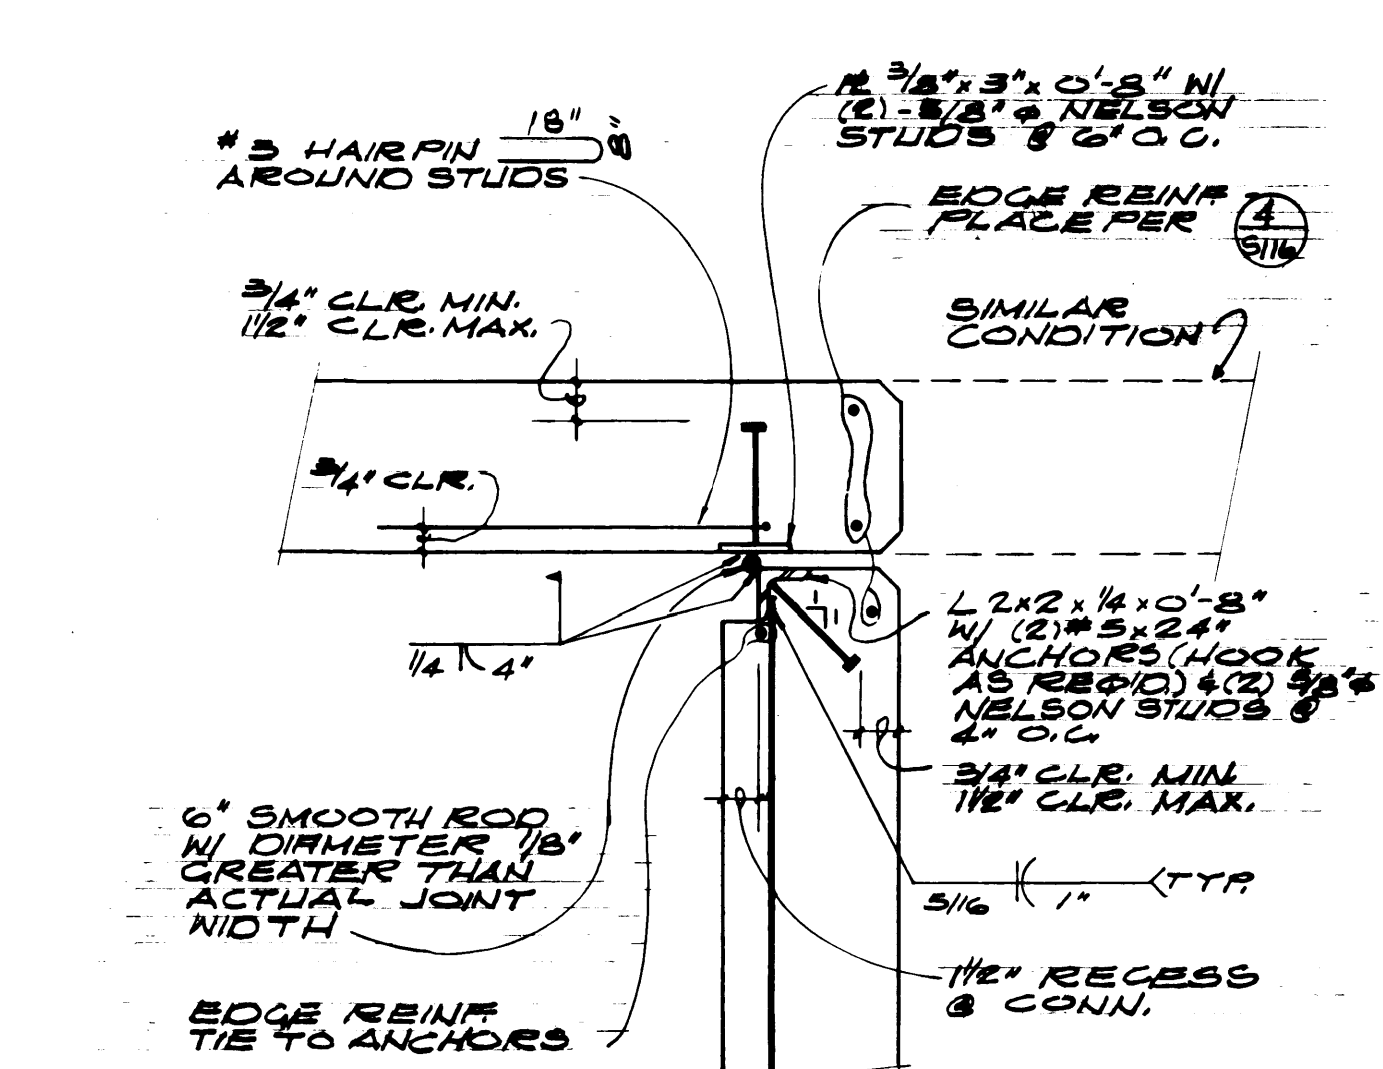


DETAIL 2
1/2\"/>

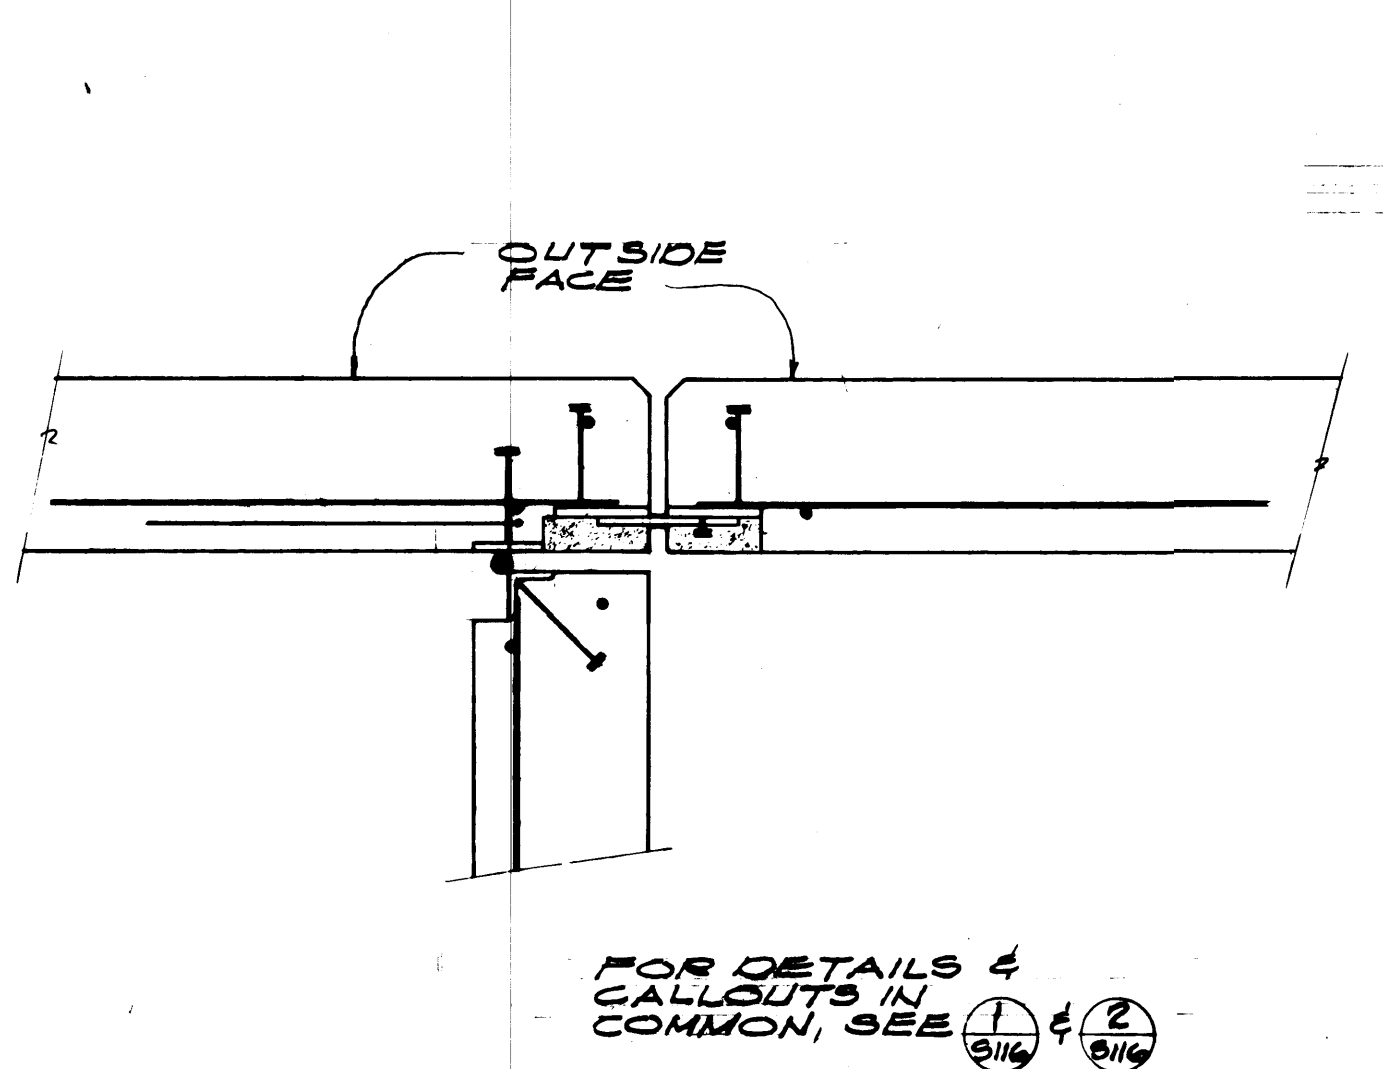


DETAIL 3
1/2\"/>

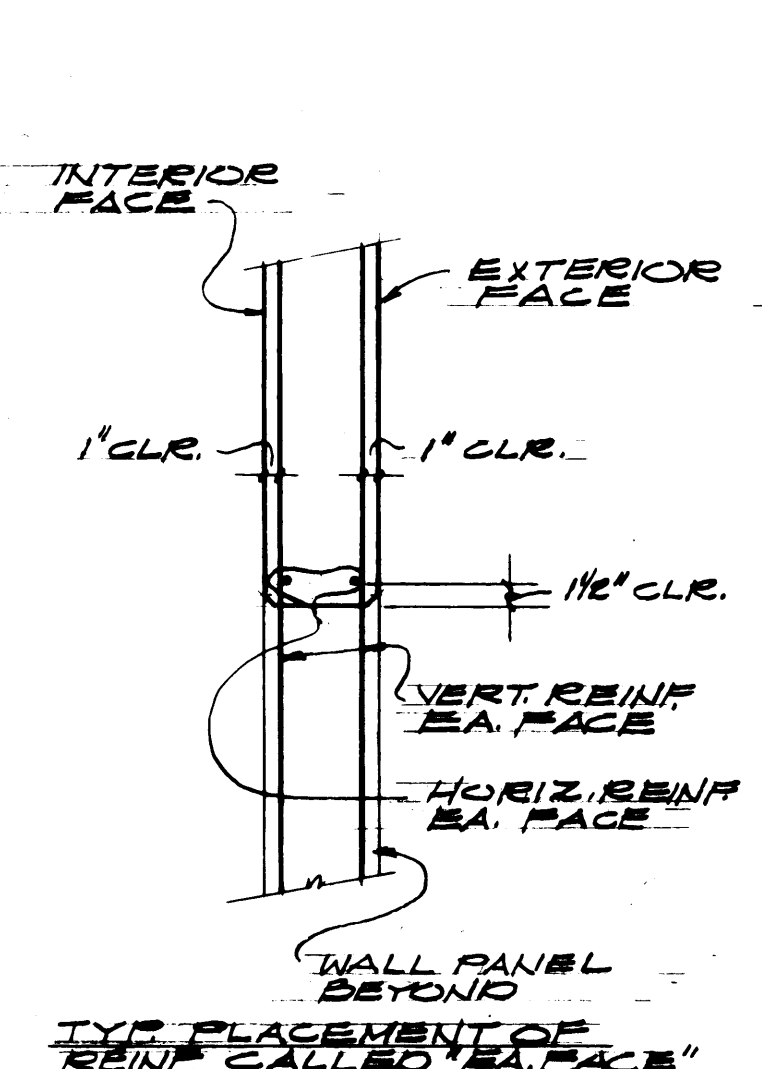


SECTION 4
1/2\"/>

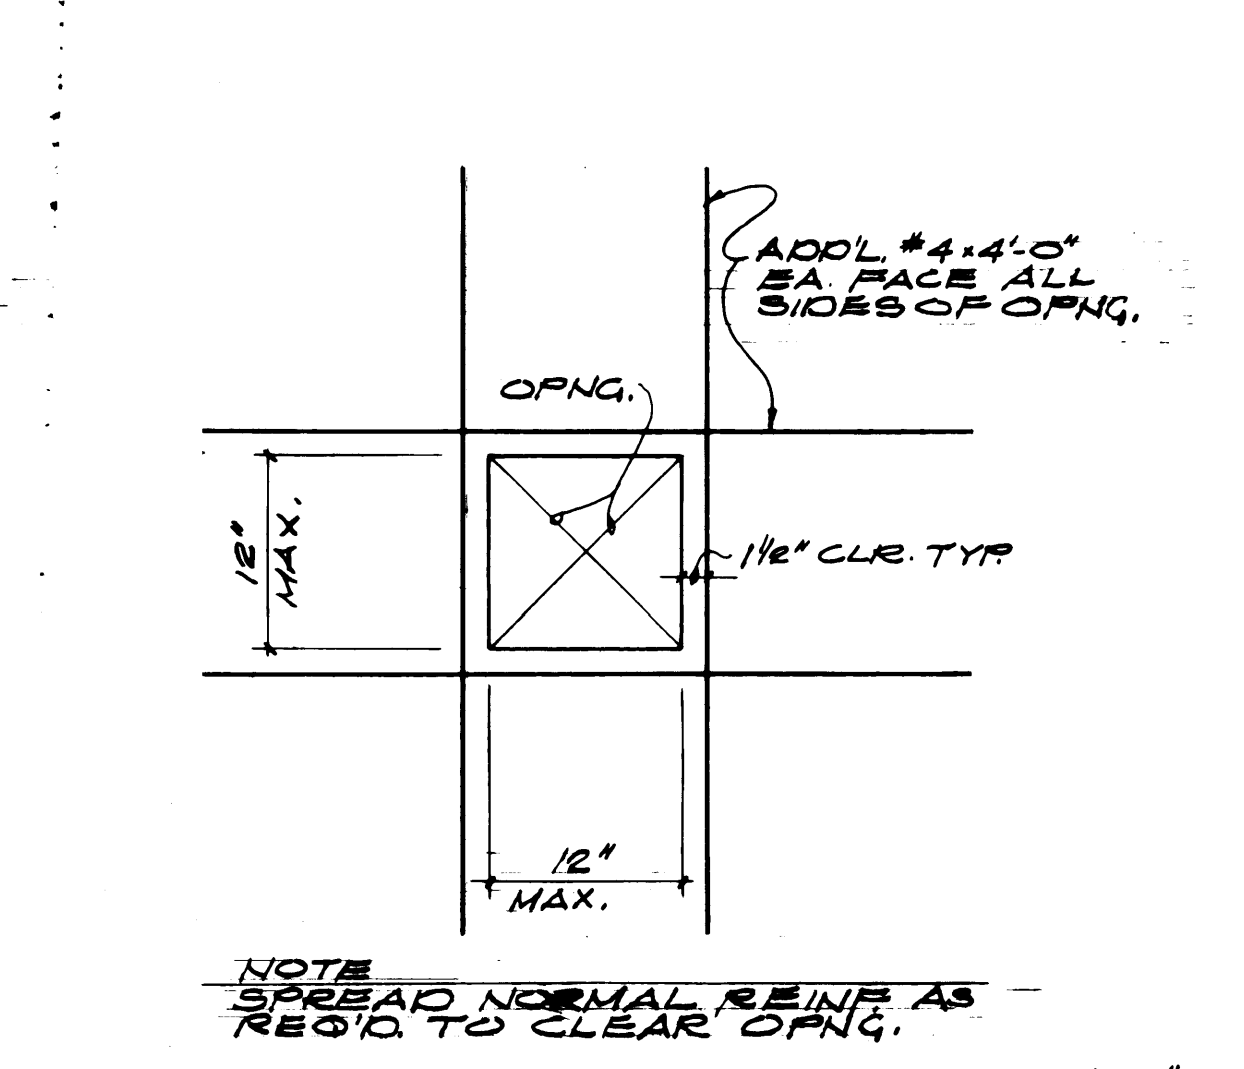


DETAIL 5
NO SCALE

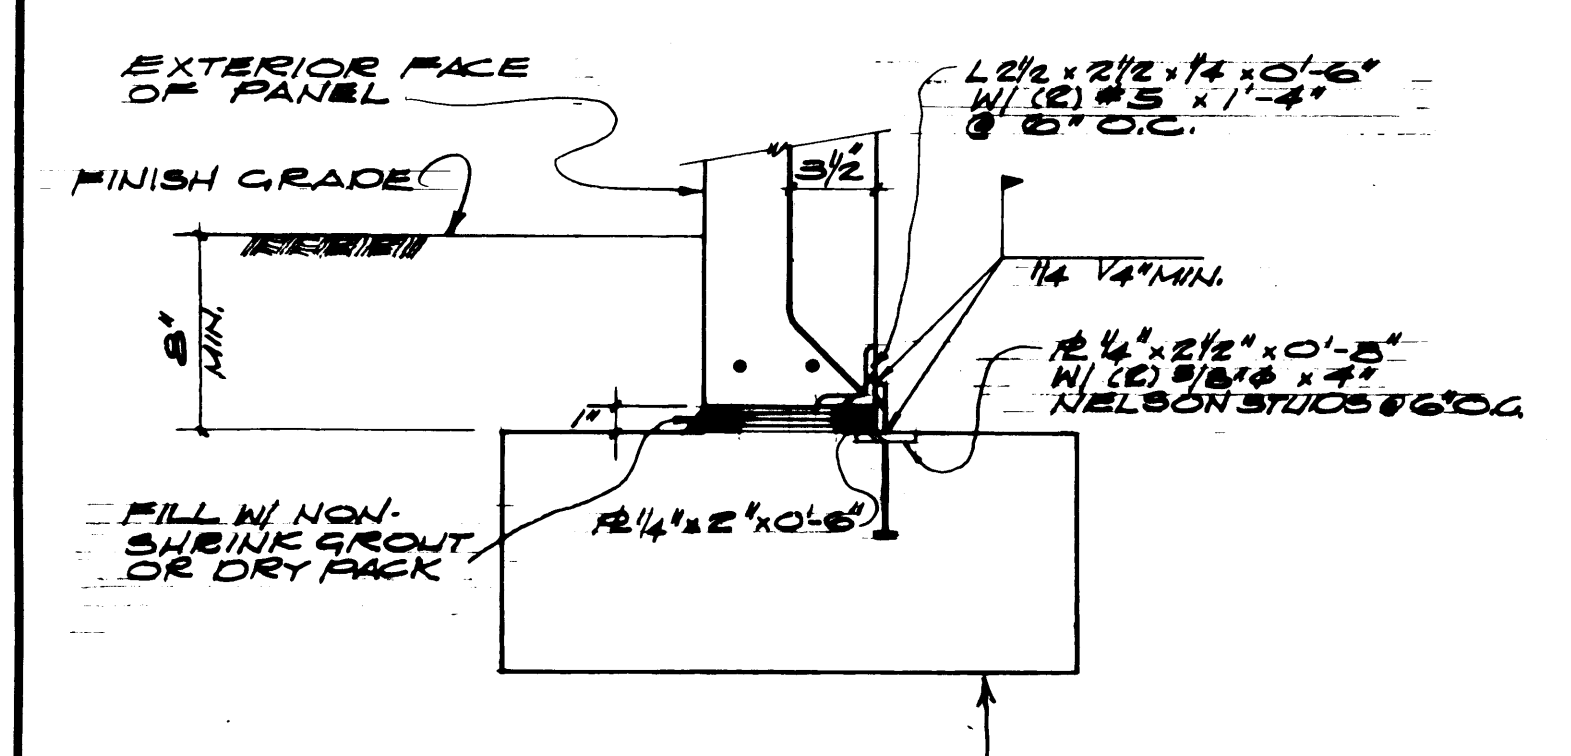


SECTION 6
1/2\"/>

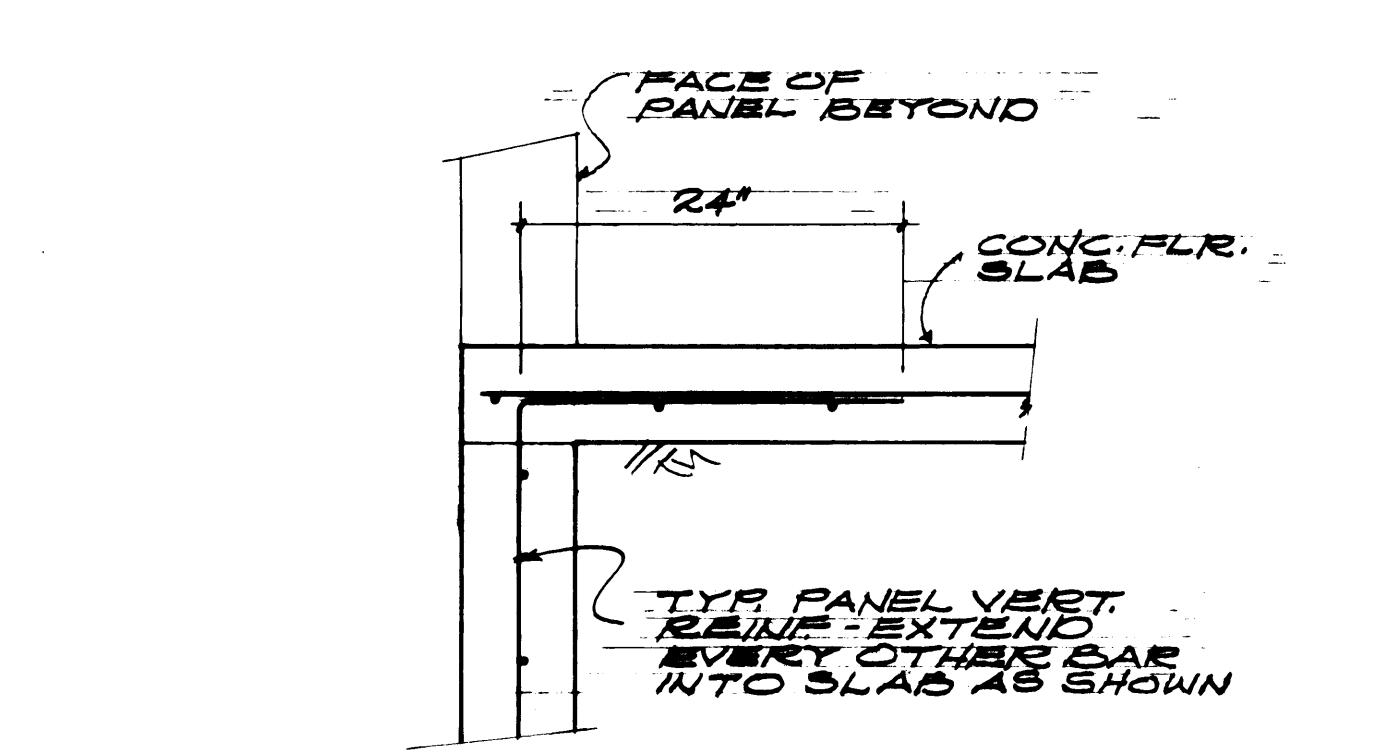

SECTION 7
1/2\"/>

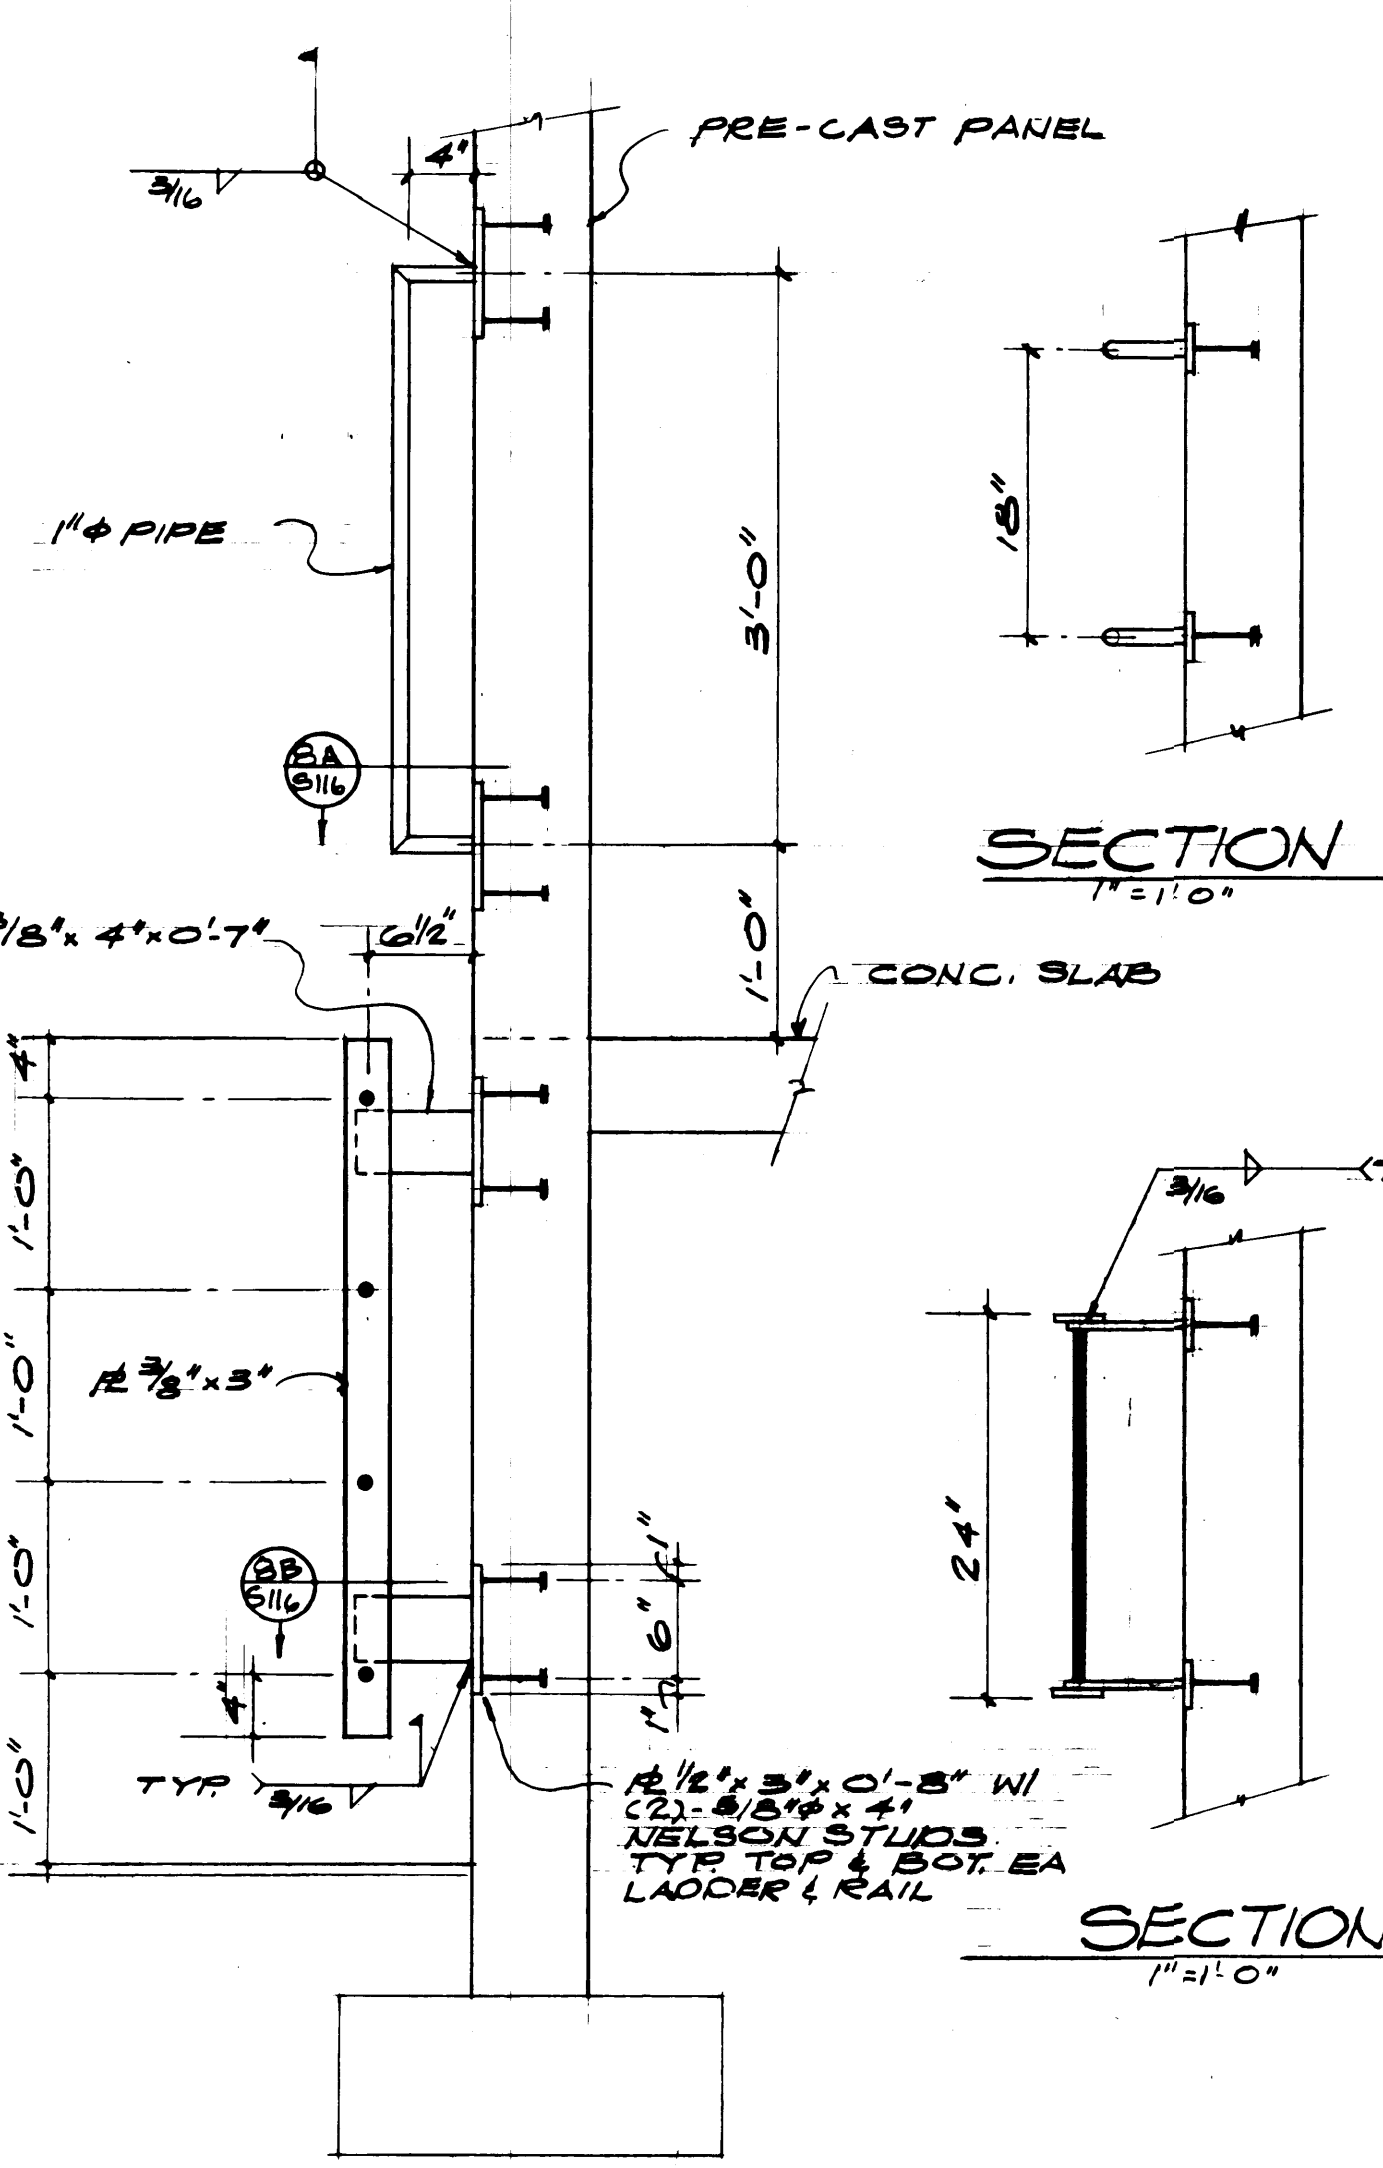

SECTION 8
1/2\"/>

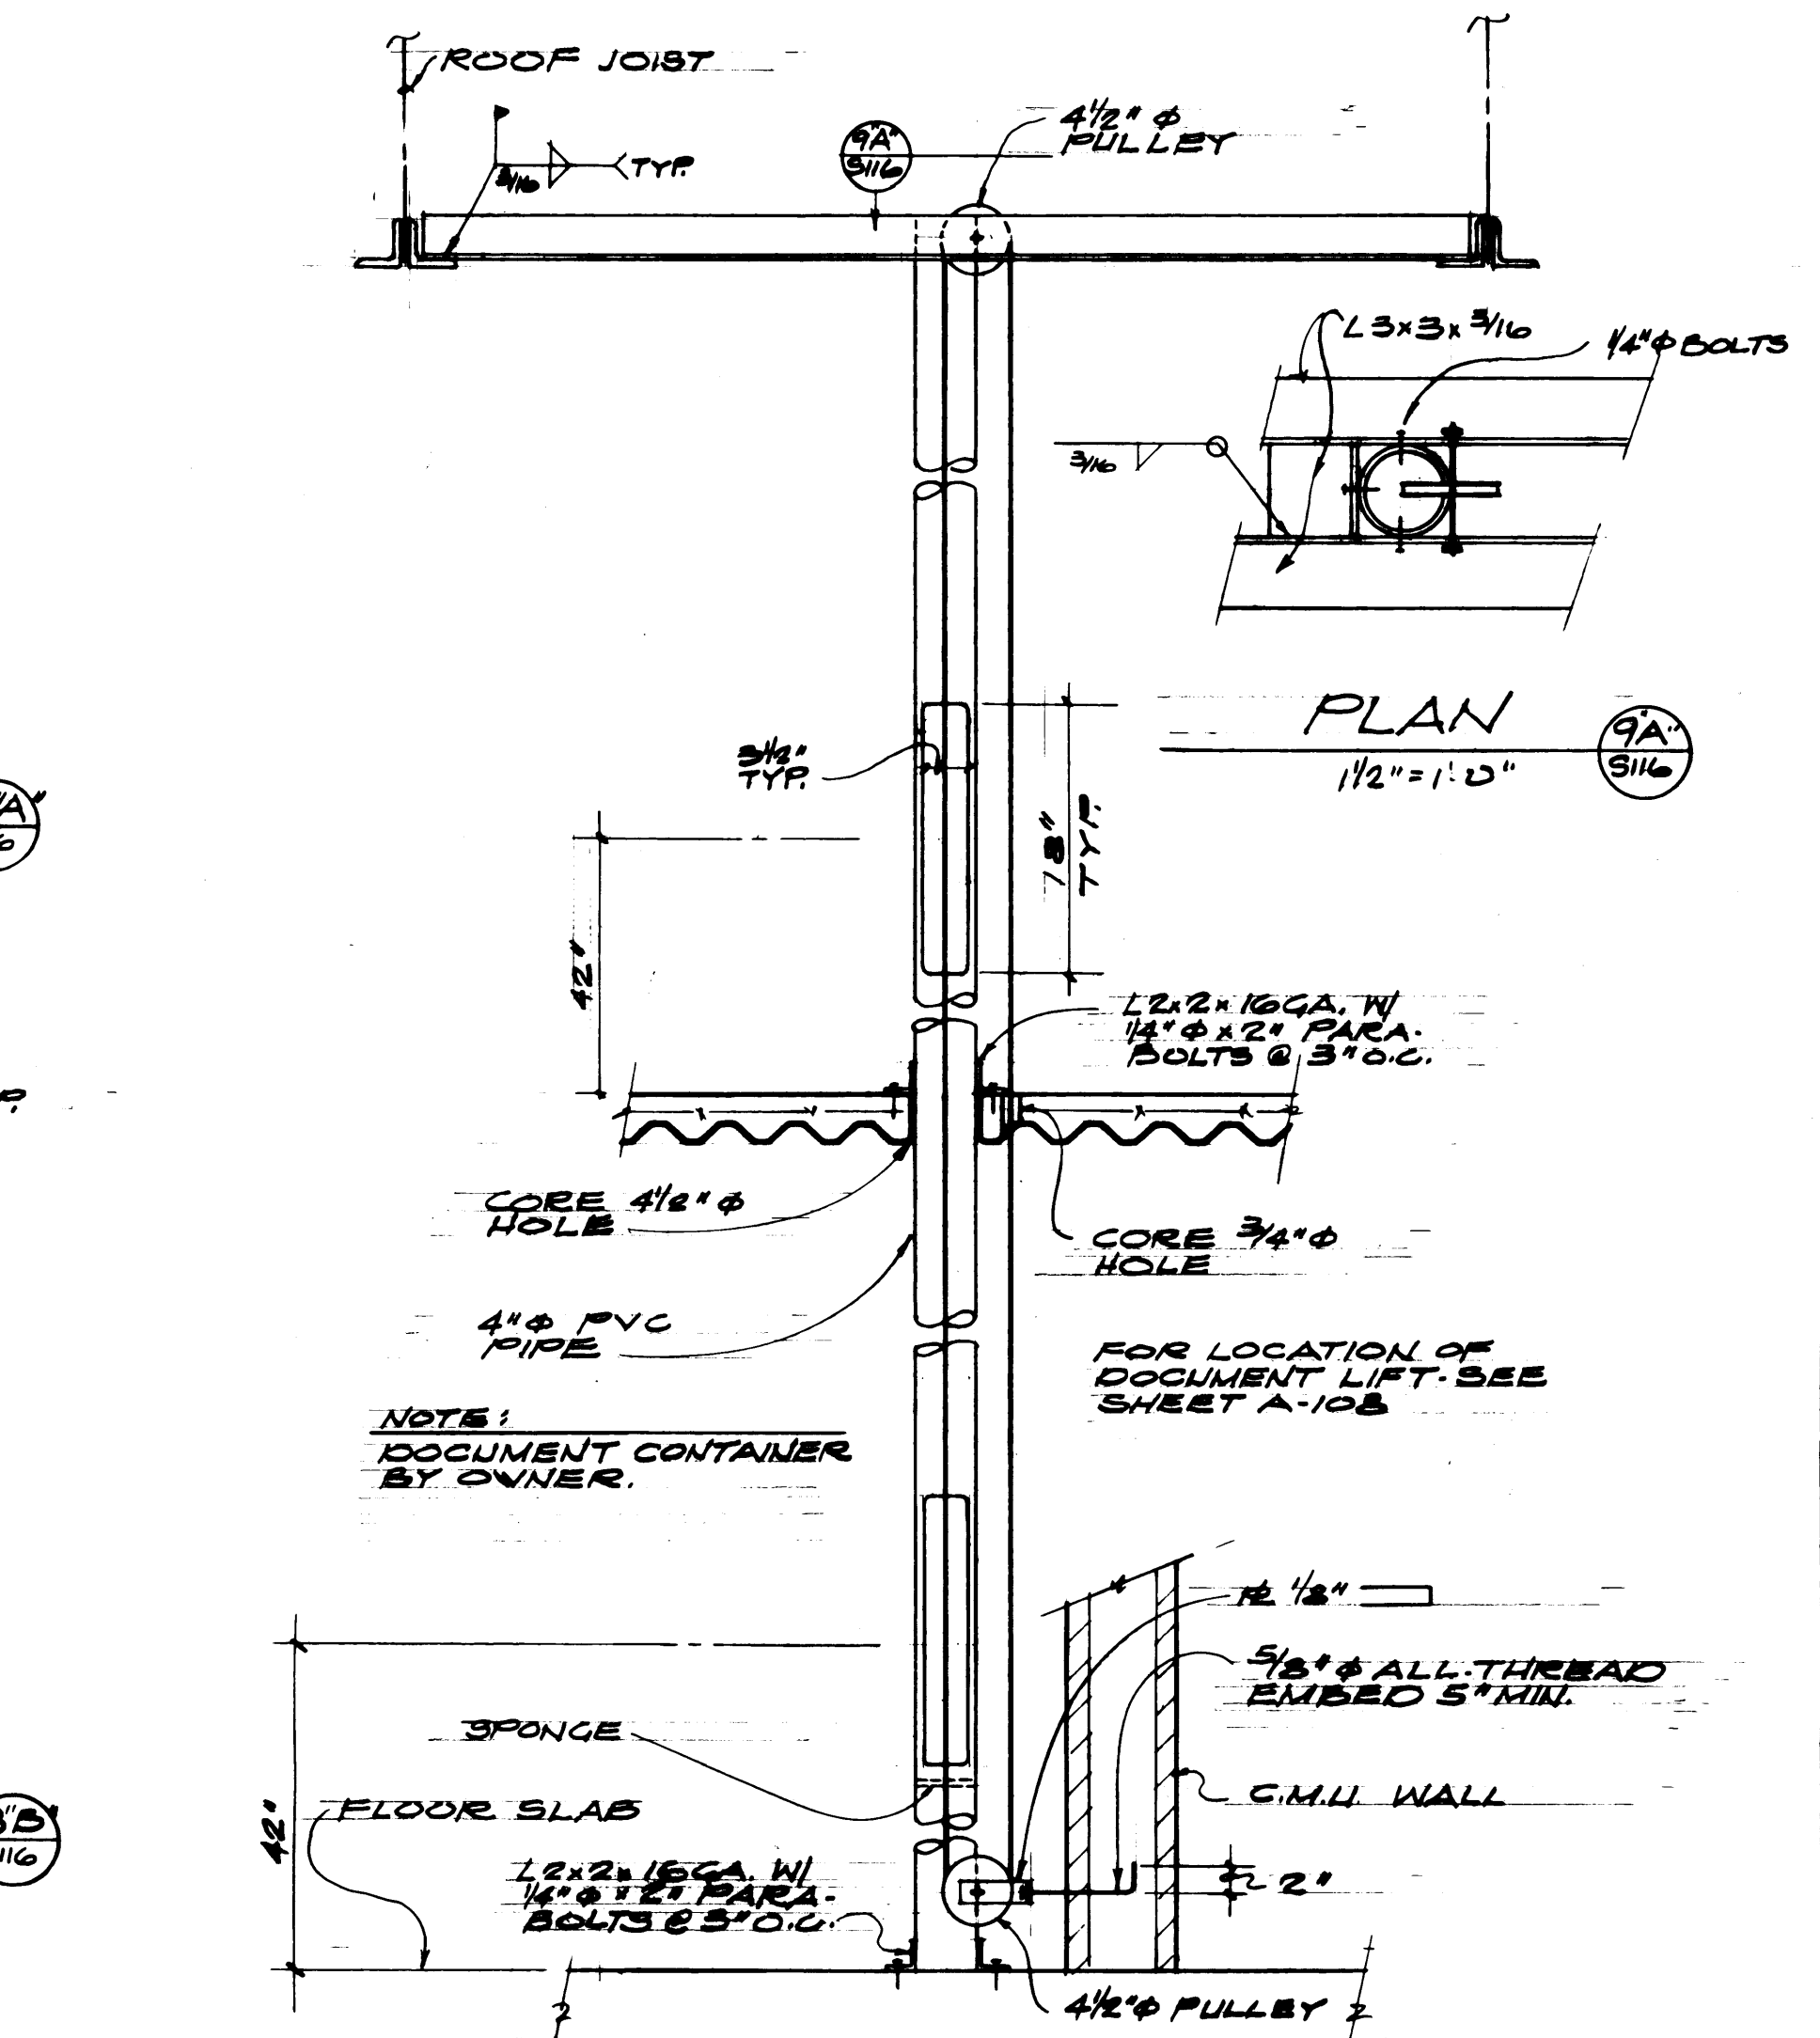

ELEVATION 9
1/2\"/>



Shelton Engineers, Inc.
Consulting Engineers
51 University, Suite 301
Seattle, WA 98101
(206) 462-4116
580 So. Fremont, Suite 301
Tacoma, WA 98402
(253) 263-8787

NO.	REVISION	BY	APP.	DATE
1	AS BUILT CHANGES	RJS		3/30/84

DRAWN: N.N.		DATE: 3-22-84	
CHECKED: D.S.		DATE: 3-22-84	
CHECKED: D.S.		DATE: 3-22-84	
CONT. NO. 557		FIELD BOOK (S)	
APPROVED: [Signature]		DATE: 3/30/84	
DRAWING NO. EP2671-23 3-116		SHEET 32 OF 71	

PORT OF TACOMA
TACOMA TERMINALS, INC.
C.F.S. BUILDING
TILT-UP PANEL
DETAILS

GENERAL NOTES

These General Notes are to be used as a supplement to the Specifications. Any discrepancies found among the Drawings, the Specifications, these General Notes and the site conditions shall be reported to the Engineer, who shall correct such error or omission in writing. Any work done by the Contractor after discovery of such error shall be done at the Contractor's risk. The Contractor shall verify and coordinate dimensions among all drawings prior to proceeding with any work or fabrication. The Contractor is responsible for all bracing and shoring during construction.

Standards

All methods, materials and workmanship shall conform to the 1979 Uniform Building Code (UBC) as amended and adopted by the City of Tacoma.

DESIGN CRITERIA

	Roof	Slab on Grade
Vertical Loads:	Dead Load	Actual
	Live Load	Actual
	25 PSF	500 PSF

Lateral Forces

- Lateral forces are transmitted by diaphragm action of roof and floors to the columns. The loads are then transferred to the footing by cantilever action of the columns where ultimate displacement is resisted by passive pressure of earth and/or sliding friction. Overturning is resisted by dead load of the structure and soil surcharge.
- Wind: 25 PSF "Wind-Pressure-Map" Area (20 PSF for Height < 30' - 4'). Overhangs and Partly Enclosed Areas: 125% of wind load less 2/3 design dead load.
- Seismic: Zone 3 per 1979 UBC. V=2IKCSW, V=Base Shear, Z=.75, I=1.00, K=1.00, CS=.14, W=Dead Load of Portion of Building.

Soil Bearing Pressure: 3500 PSF

All footings shall bear on firm structural backfill. Areas over-excavated shall be backfilled with lean concrete (f'c=2000 PSI) or "Structural Backfill". Areas designated "Structural Backfill" shall be filled with approved well-graded bankrun material. Maximum size of rock 4"-6". Frozen soil, organic material and deleterious matter not allowed. Compact to at least 95% of its maximum density as determined by ASTM D-1557. Contractor shall exercise extreme care during excavation to avoid damage to buried lines, tanks, and other concealed items. Upon discovery, do not proceed with work until receiving written instructions from Engineer. A competent representative of the Owner shall inspect all footing excavations for suitability of bearing surfaces prior to placement of reinforcing steel. Provide drainage around all work to avoid water-softened footings.

CONCRETE

Concrete: Shall be made with Portland Cement ASTM C-150 Type I or Type I-II, coarse and fine aggregate ASTM C-33, water clean and potable, and shall be ready-mixed per ASTM C-94 unless otherwise approved. Add to all concrete exposed to weather an air entraining agent to attain 5% ± 1-1/2% entrained air, by volume, conforming to ASTM C-260. No aluminum (conduit, miscellaneous items, etc.) shall be embedded in any concrete.

Materials

Item	Minimum f'c 28 Days	Normal Slump Inches* Maximum
Footings	3000	5
Retaining Walls	4000	4
Columns	4000	4
Slabs	4000	4
All Other Concrete	4000	4

*At Contractor's option, Contractor may use Master Builders Synergized Performance Systems or approved equal using Pozzolith admixtures to produce flowable concrete. Maximum slump shall not exceed 9". Master Builders concrete technician shall assist in determining proportions for SPS concrete and shall obtain approval of Engineer prior to employing this procedure.

Place concrete per ACI 304 and conform to ACI 304 (306) Winter Concreting and ACI 605 (305) for Hot Weather Concreting. Use interior mechanical vibrators with 7000 RPM minimum frequency. Do not over-vibrate. Concrete shall be poured monolithically between construction or expansion joints. Protect all freshly placed concrete from premature drying, excessive hot or cold temperature for seven days after pouring.

Non-Shrink Grout: Make from one part ASTM C-150 Type I Portland Cement, one part fine sand ASTM C-33, and one part "Master-flow 713" by Master Builders, or equal. Add water as required for a desired consistency. Fill entire space under plates, shapes, and it joints, avoiding air pockets. Use "Embeco 636" for nonexposed work.

Metal Reinforcement (Concrete & Masonry): All reinforcing shall conform to ASTM A-615, Grade 40 for #5 and smaller, Grade 60 for #6 and larger. Detail, fabricate and place per ACI 315 and ACI 318. Splices shall be 24 bar diameters or 18" minimum (30 bar diameters, 18" minimum for masonry).

STRUCTURAL STEEL

Detailing, Fabrication and Erection: Conform to the AISC "Manual of Steel Construction", 8th Edition.

Steel Shapes and Plates: ASTM A-36 (fy=36 ksi).

Steel Structural Tubing: ASTM A-500 (fy=46 ksi).

Machine Bolts (M.B.) and Anchor Bolts (A.B.): ASTM A-307.

Drilled-In Anchors: "Parabolt" by USM, Inc., Molly Fastener Division, or approved equal. Embed bolt into concrete or masonry 7 diameter minimum, except as shown.

Studs: "Nelson Studs" shall be by Nelson Stud Welding Division, Gregory Industries, Inc., or approved equal.

Concrete Anchors: Hooked or headed, smooth dowel stock, shop welded by certified welders.

Finish: Shop paint after fabrication with an approved primer (see Specifications). Galvanize after fabrication all miscellaneous steel exposed to weather or view.

Metal Joists: Shall conform to the Steel Joist Institute (SJI) and American Institute for Steel Construction (AISC) standards and shall be designed to carry the loads listed in the design criterion and those indicated on the framing plans. For special requirements, see structural drawings. Shop drawings shall be submitted bearing the stamp of a structural engineer licensed as such in the State of Washington.

Metal Roof Deck: Shall contain the minimum properties shown on the structural drawings and specifications. The roof deck shall be formed from steel sheets conforming to ASTM A-611-78 or A-446-72, and shall be galvanized per ASTM A-525. The roof deck shall be placed on the supporting framework with a minimum end lap of two inches.

Light-Gauge Metal Framing: Framing members shall be of the type, size and gauge as shown on the Plans and shall be manufactured by the Milcor Division of INRYCO Inc., or approved equal. All 16 gauge and heavier galvanized structural members shall be formed from steel that meets the requirements of ASTM A-446-72, Grade D, minimum 50 ksi yield. All 18 gauge and lighter galvanized structural members shall be formed from steel that meets the requirements of ASTM A-446-72, Grade A, minimum 33 ksi yield. Bridging per manufacturer's requirements shall be in place prior to placing of any construction loads. All runs shall be rigidly anchored to end walls.

WELDING

Structural Steel: Weld in accordance with "Structural Welding Code" AWS D-1.1-76.



Reinforcing Steel: Weld in accordance with "Reinforcing Steel Welding Code" AWS D-12.1-75. Weld only with specific approval of the Engineer. In no case will a weld be made within 6 bar diameters of a "cold bend".

Certification: All welding shall be by certified welders.

Electrodes: Use E60 or E70 electrodes.

SUBSTITUTIONS


Substitutions may be allowed only if they meet the requirements of these General Notes and the Specifications, and if complete written engineering data for each condition required for this project is provided to the Project Engineer seven days prior to bid date and approved in written addenda by the Engineer. Data is to indicate code basis by year, authority for stresses and stress increases, if any, and amount of expected deflection for flexural members under (1) total load and (2) live load only. All increased costs in mechanical, sprinkler, electrical or general installation and any architectural or structural redesign resulting from substitution will be borne by the General Contractor.

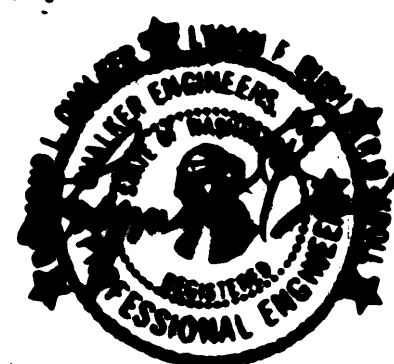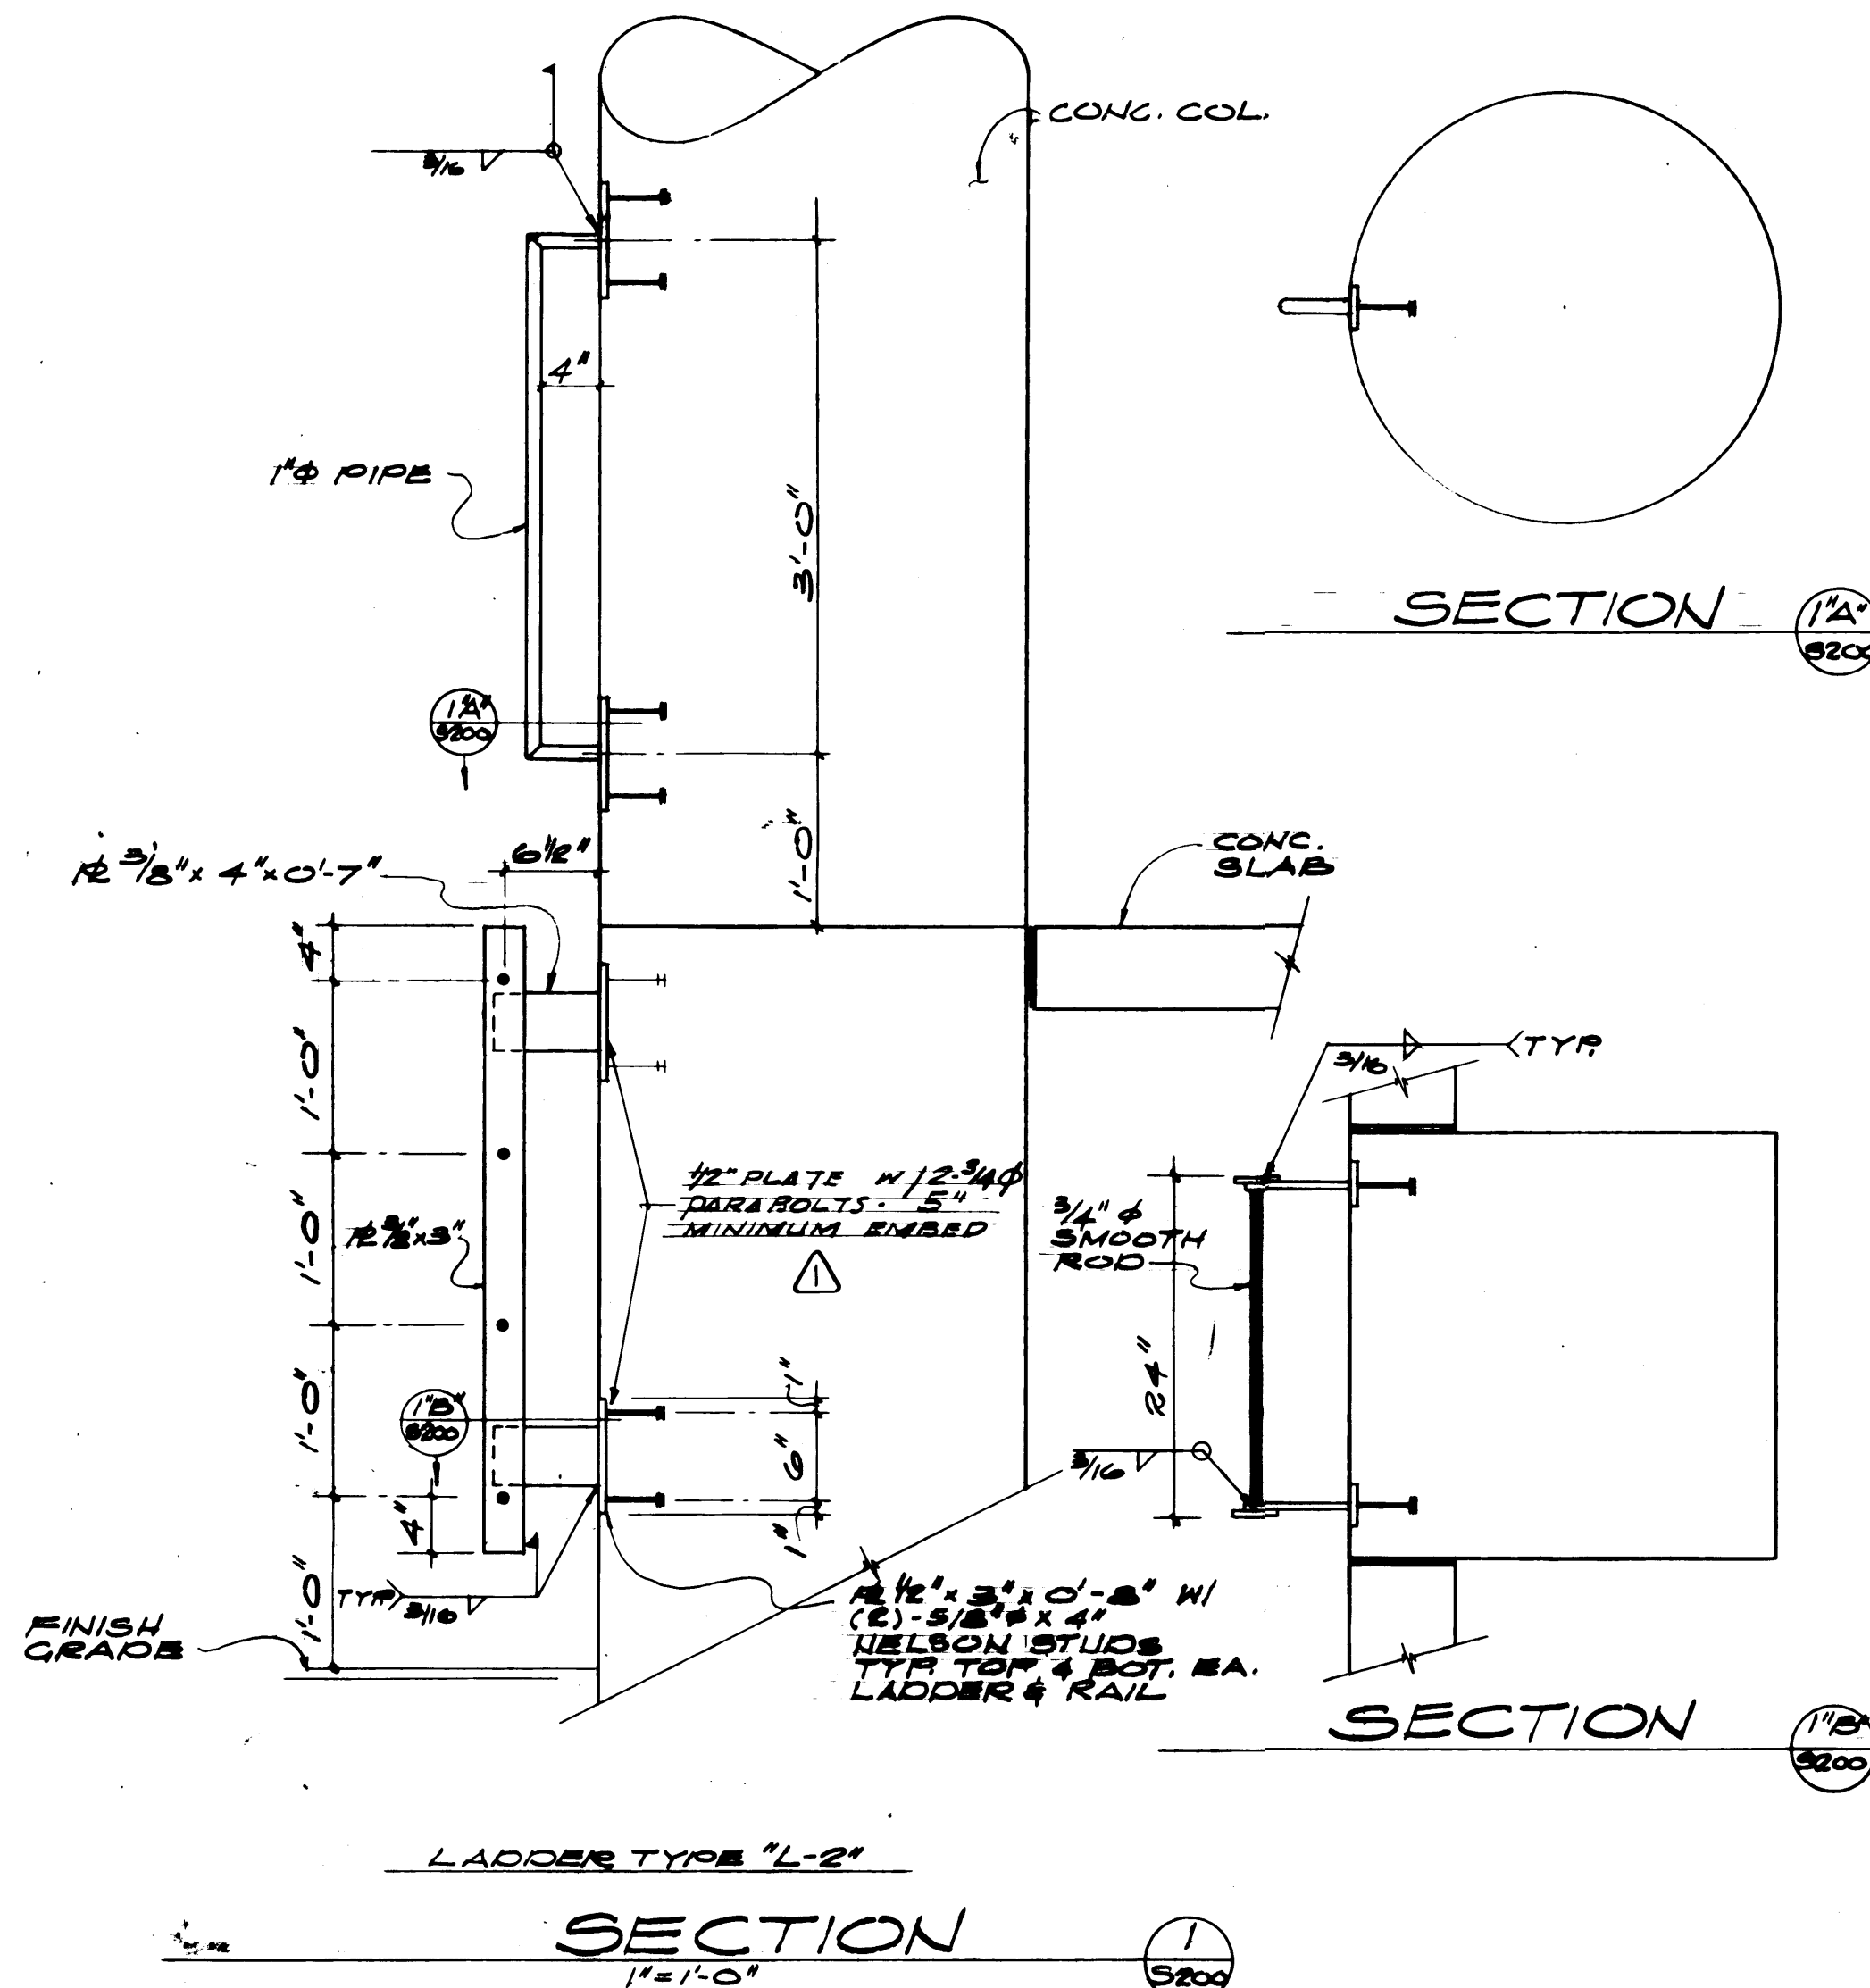

Robert J. Taylor
Professional Engineer
12345
12345
12345





MARK	REVISION	BY	APP.	DATE
	REVISED TO AS BUILT	RJS		3/20/84

DRAWN: N.N.		DATE: 3-22-84	
CHECKED: D.S.		DATE: 3-22-84	
CHECKED: D.P.		DATE: 3-22-84	
CONT. NO. 557			
FIELD BOOK (S)		SCALE	
APPROVED: [Signature]		DATE: 3/30/84	
PROJECT MANAGER: [Signature]		DATE: 3/20/84	
CHIEF ENGINEER: [Signature]		DATE	
DRAWING NO. EP 3879-23 3.200		SHEET 48 OF 71	

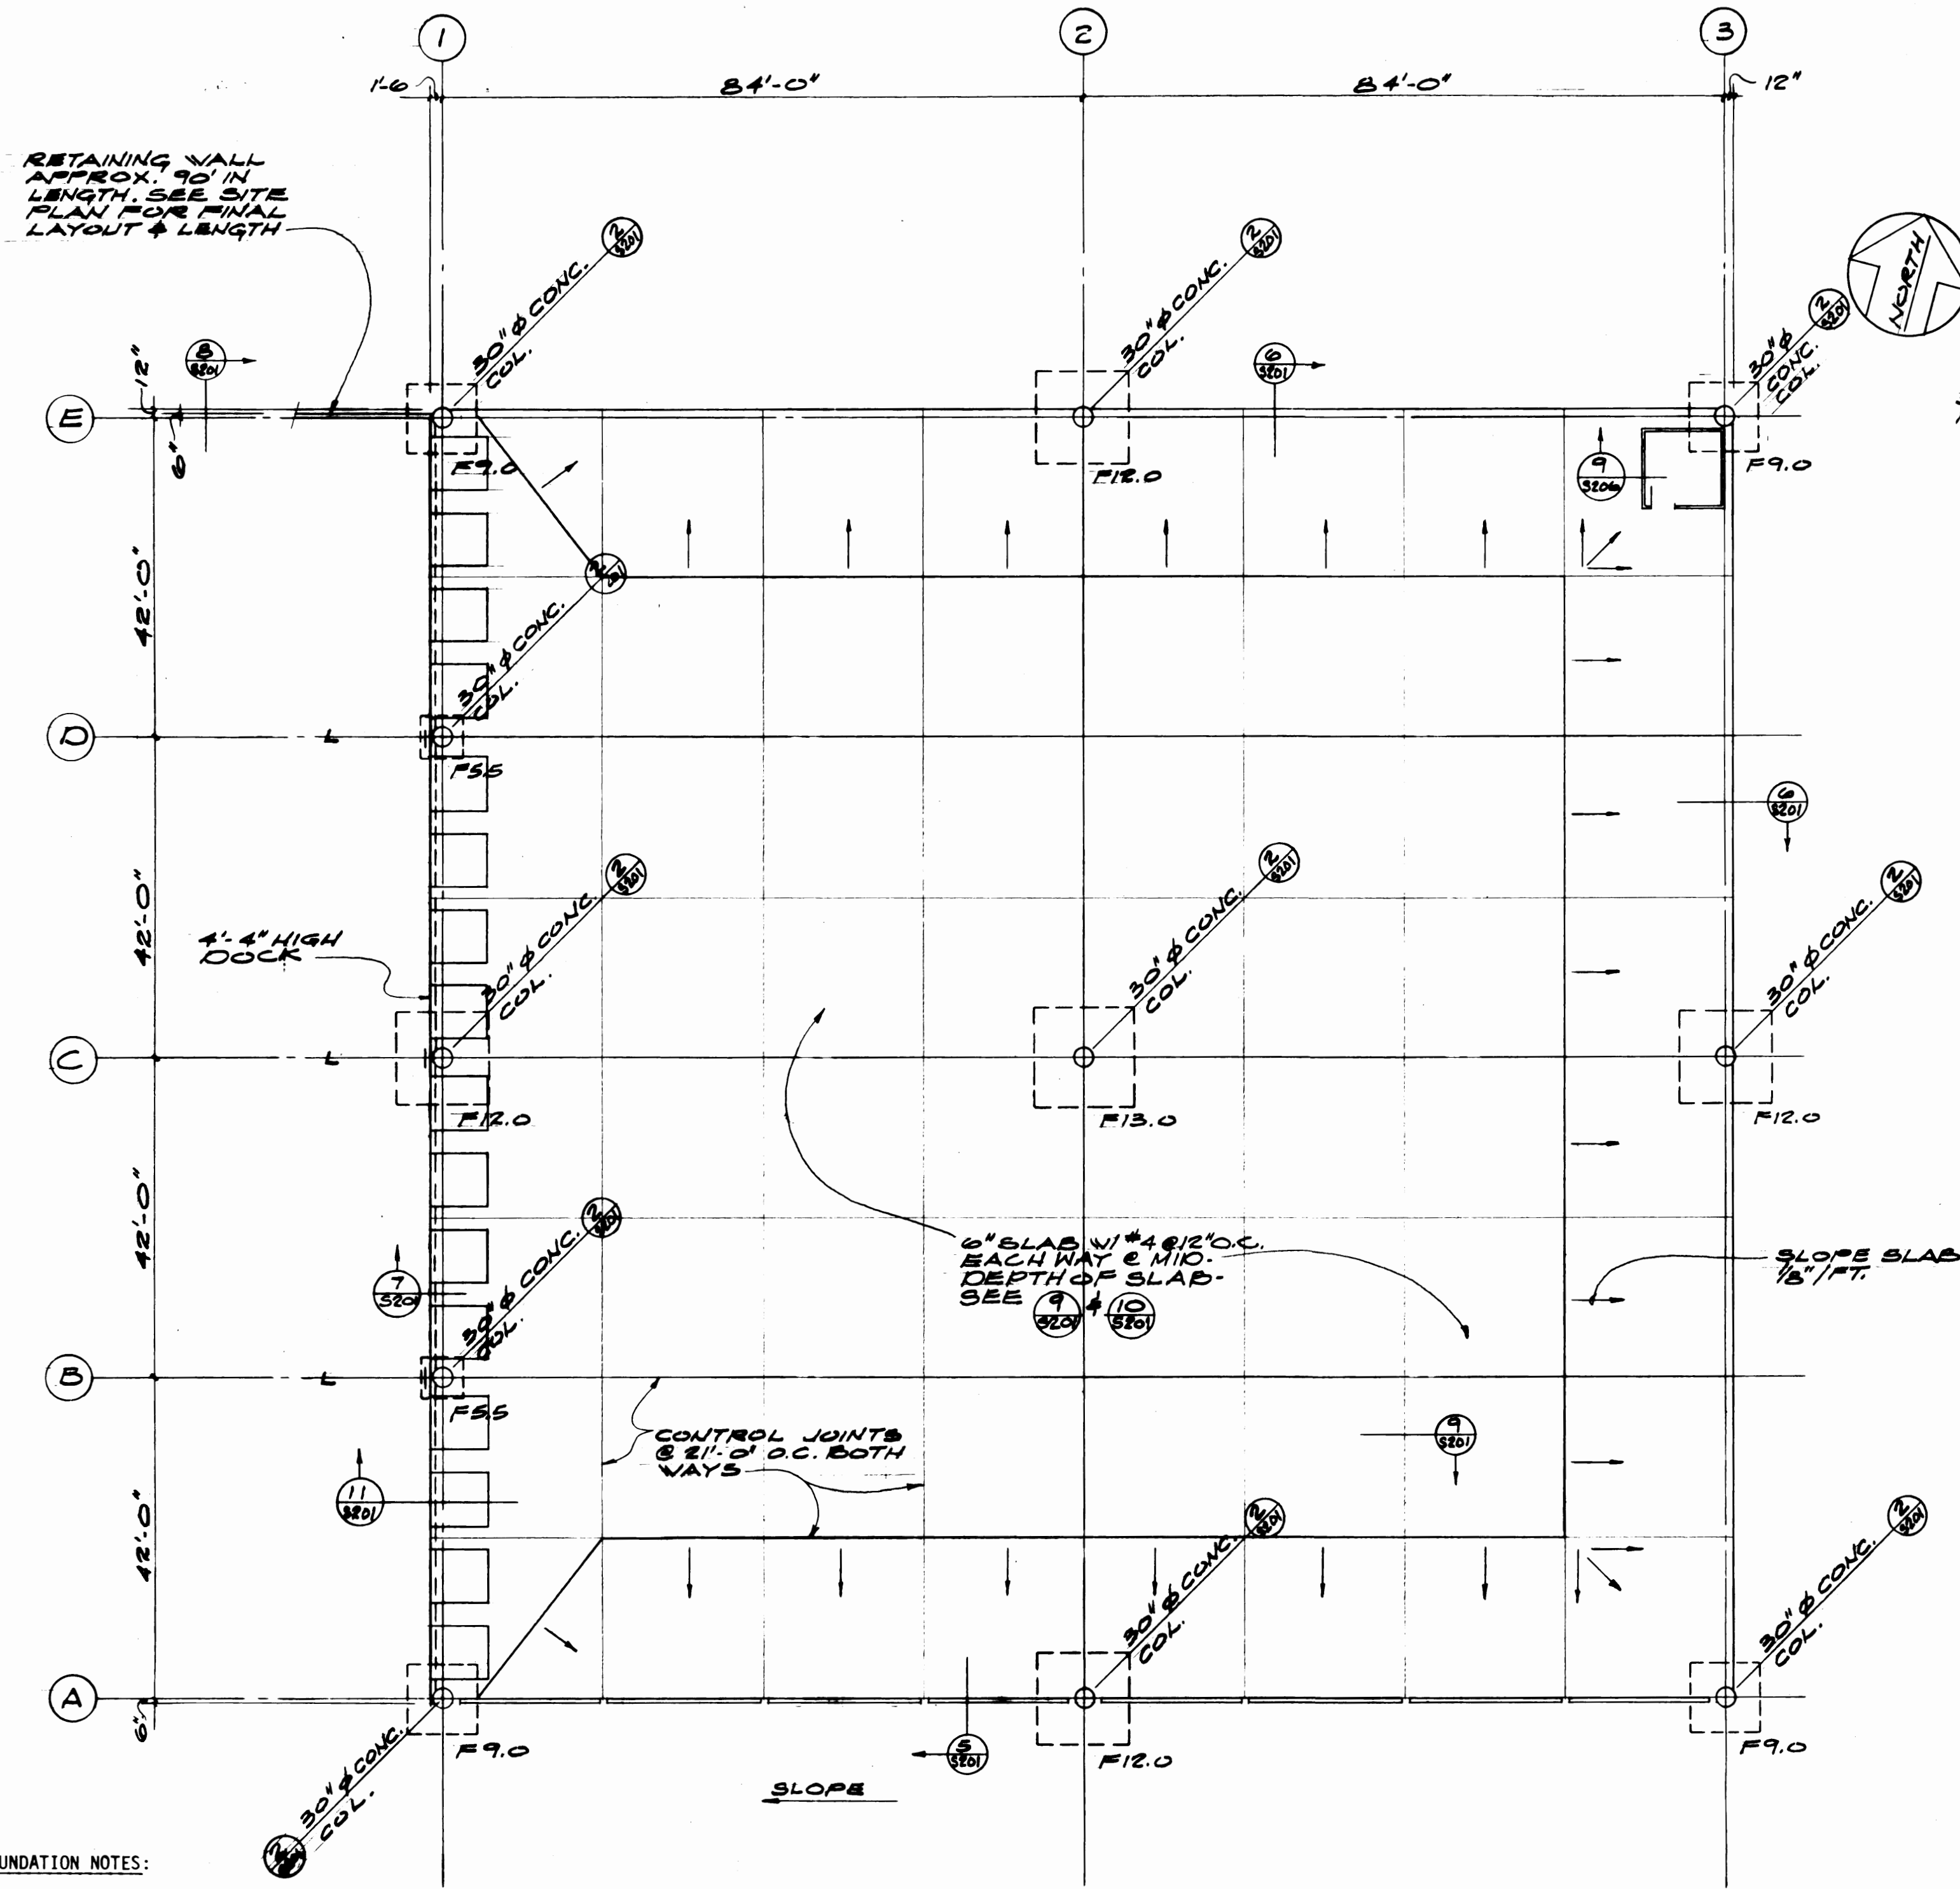


- FOUNDATION NOTES:
1. L indicates ladder type "L-2", see 1/S200.
 2. "F" denotes size of spread footing in feet. For details and reinforcing see 3/S201.


FOUNDATION PLAN
1/16" = 1'-0"

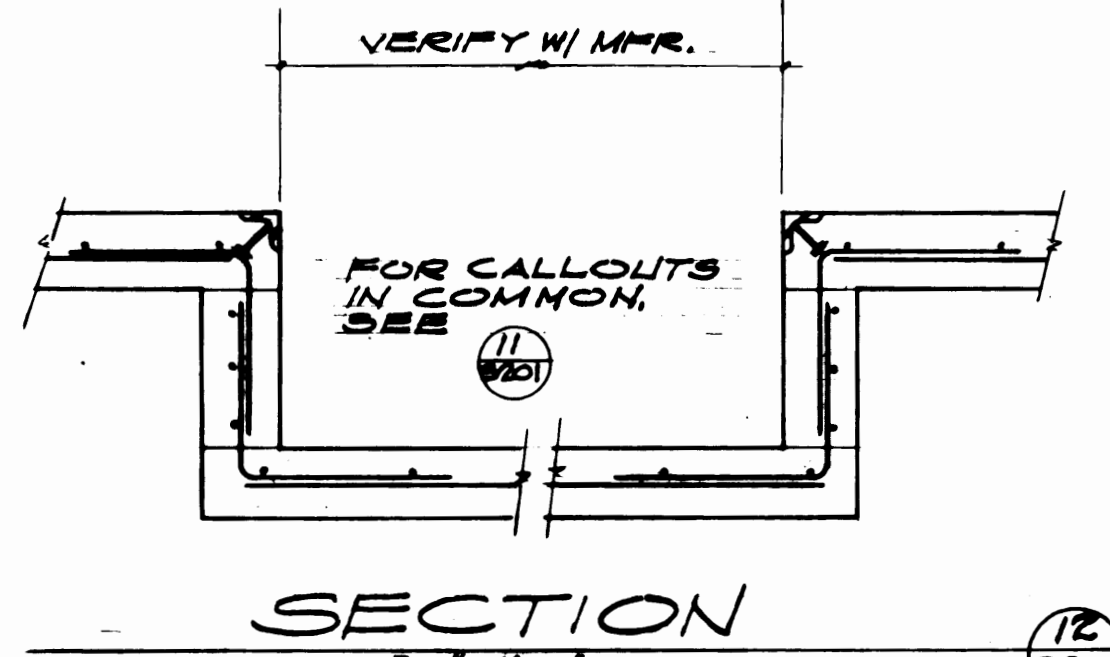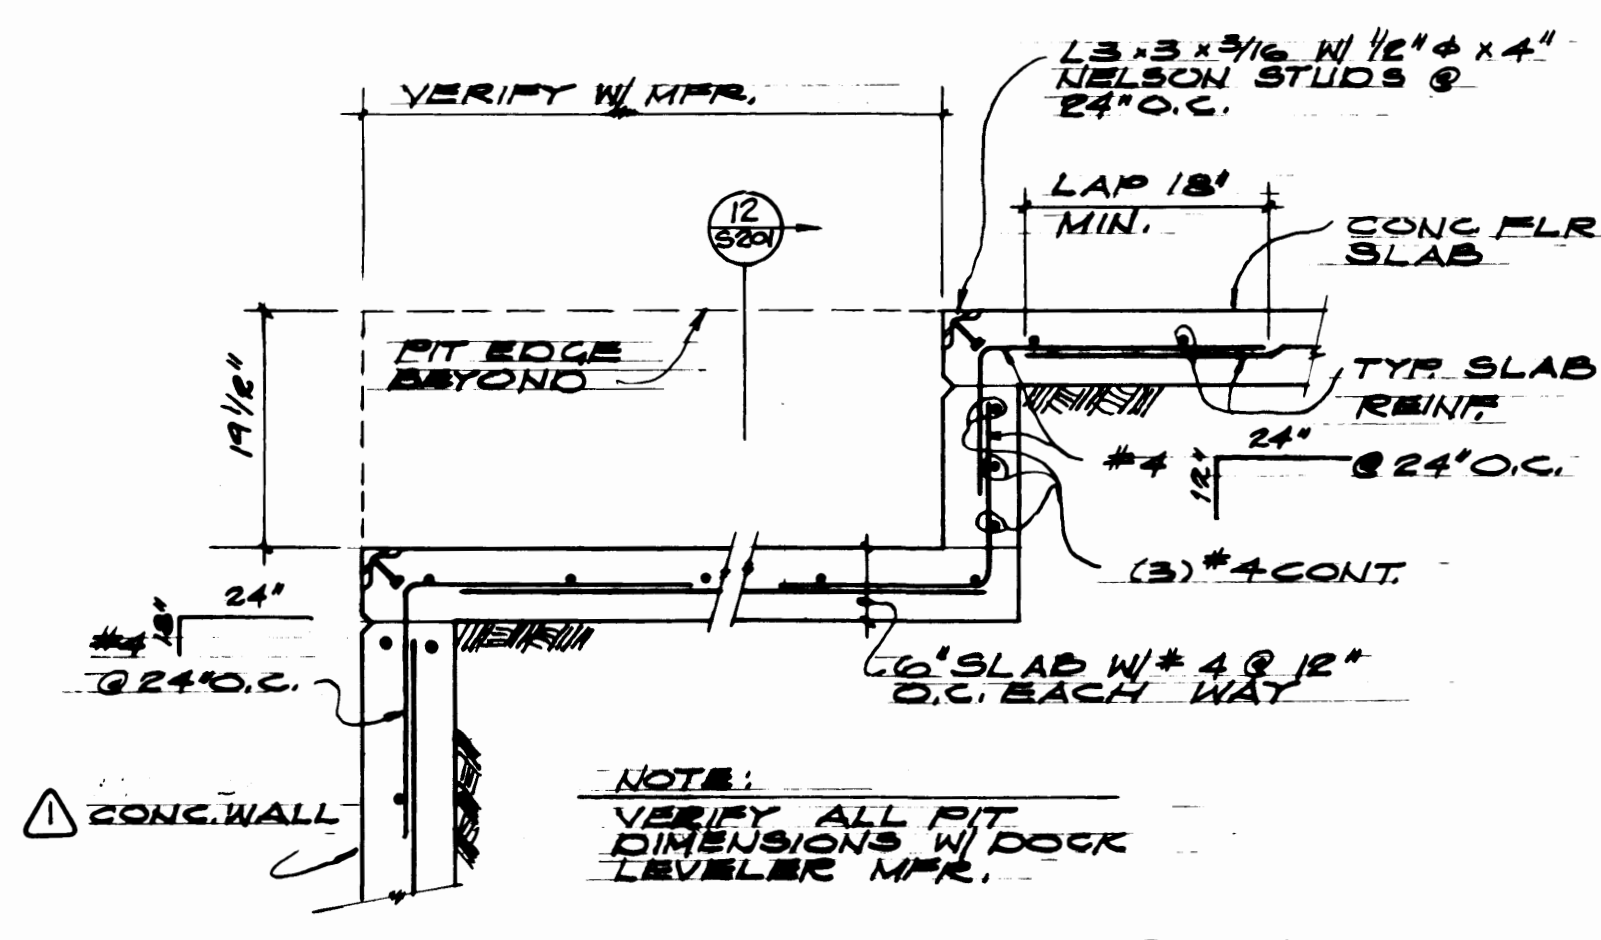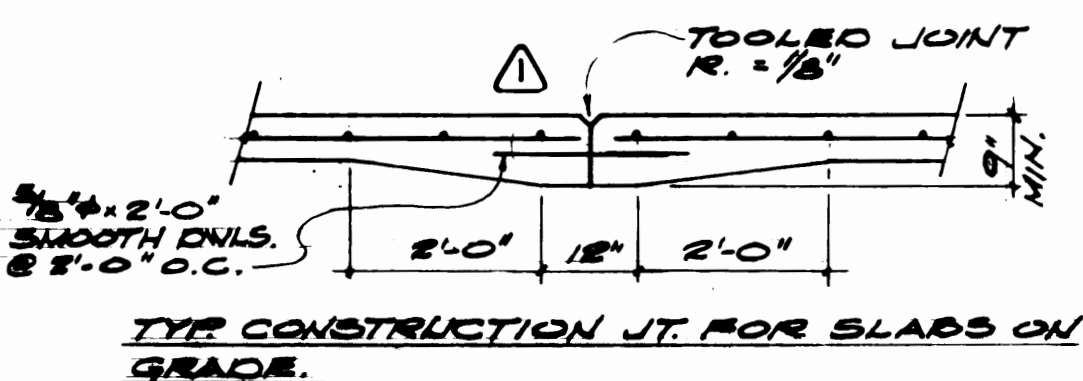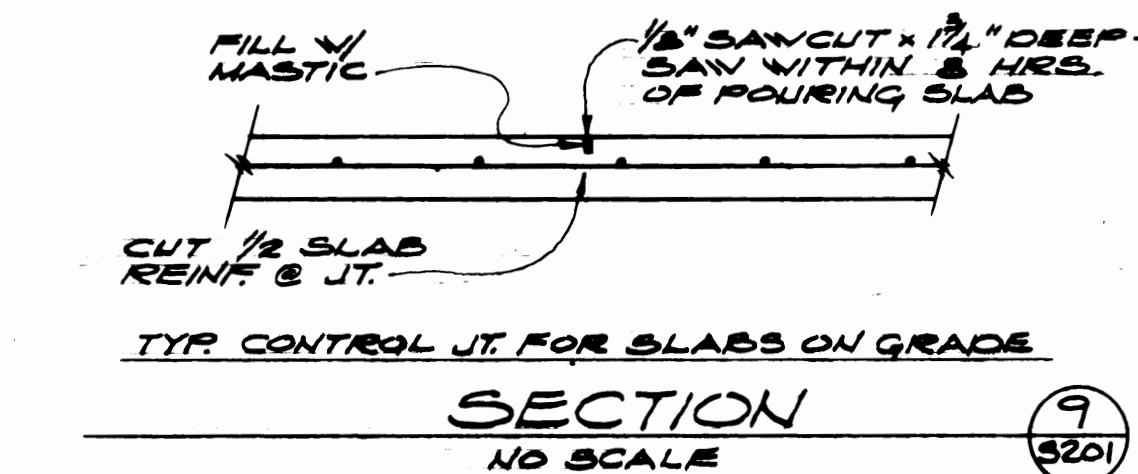


SECTION
1/2" = 1'-0"

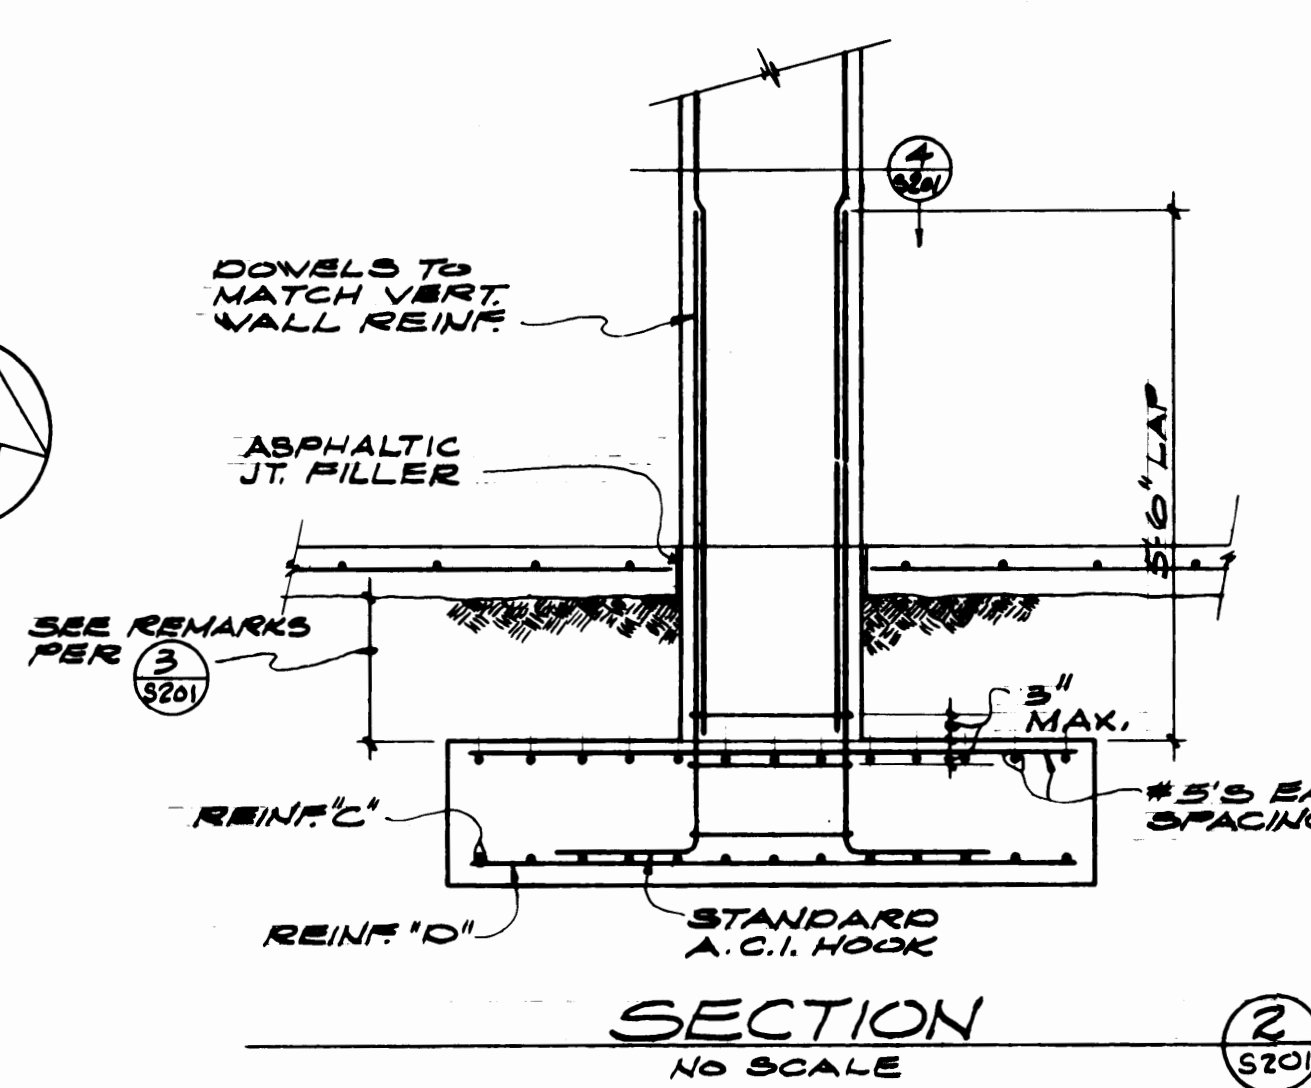

SECTION
NO SCALE


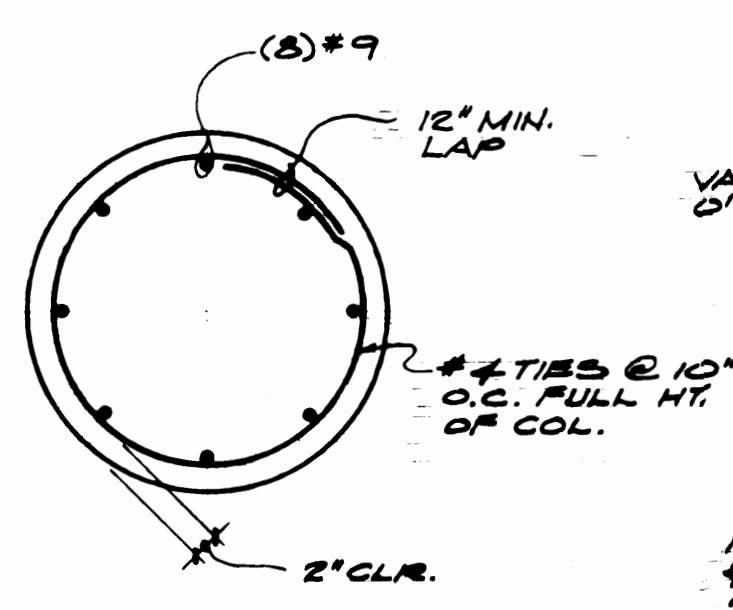


DETAIL
3/4" = 1'-0"

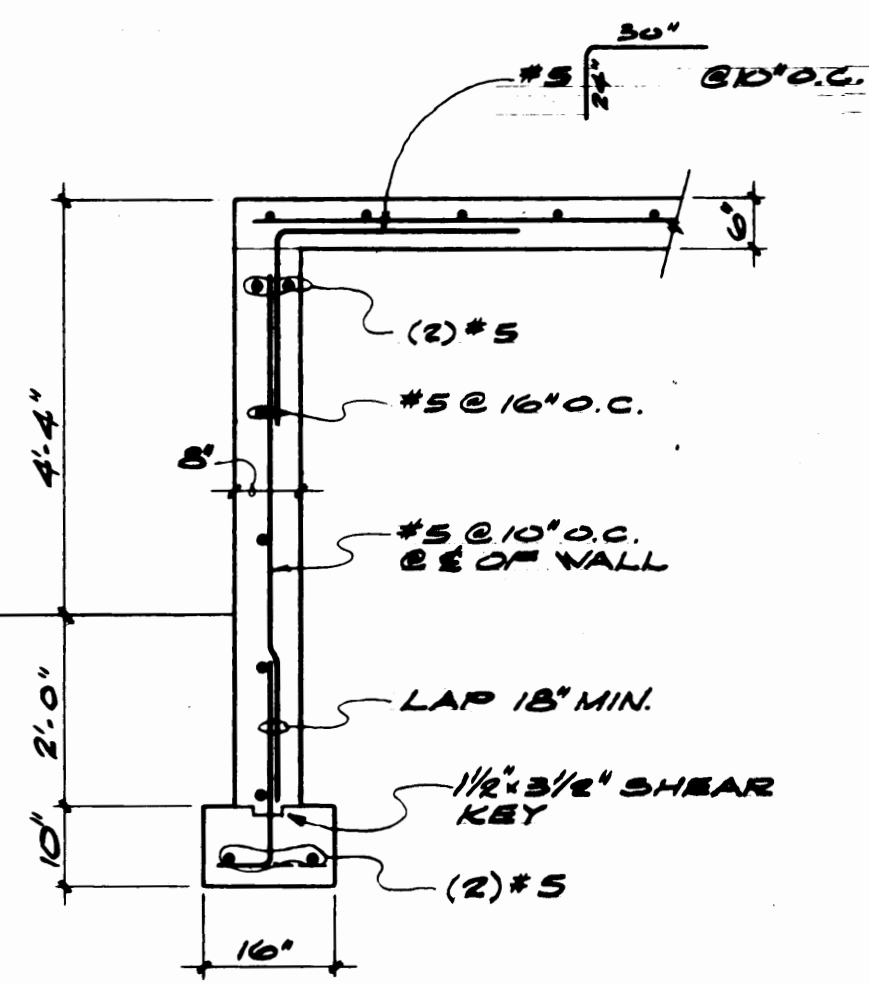


SECTION
1/2" = 1'-0"


SPREAD FTG. SCHEDULE					
MARK	DIMENSIONS			REIN.	
	"A"	"B"	"C"	"D"	REMARKS
F5.5	5'-6"	5'-6"	16"	(7)"#5	BURIED 2'
F9.0	9'-0"	9'-0"	30"	(18)"#5	BURIED 2'
F12.0	12'-0"	12'-0"	30"	(18)"#5	BURIED 2'
F13.0	13'-0"	13'-0"	30"	(18)"#5	BURIED 3'

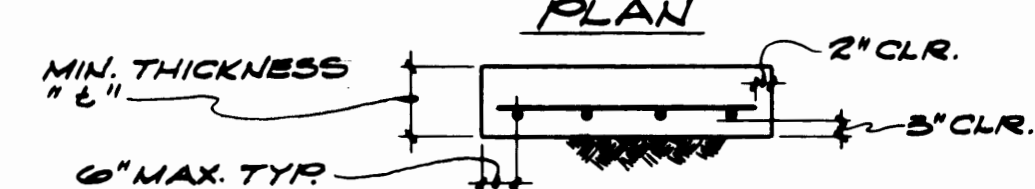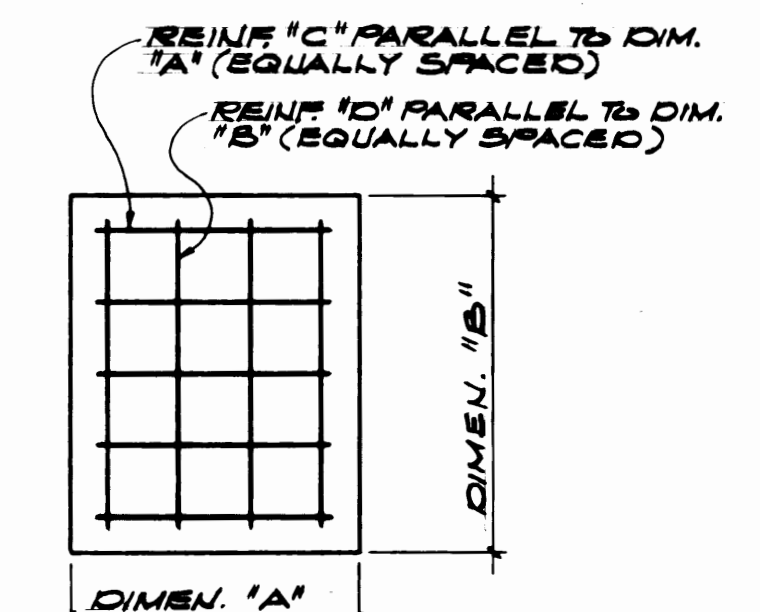


TYPICAL SPREAD FOOTING DETAILS
NO SCALE

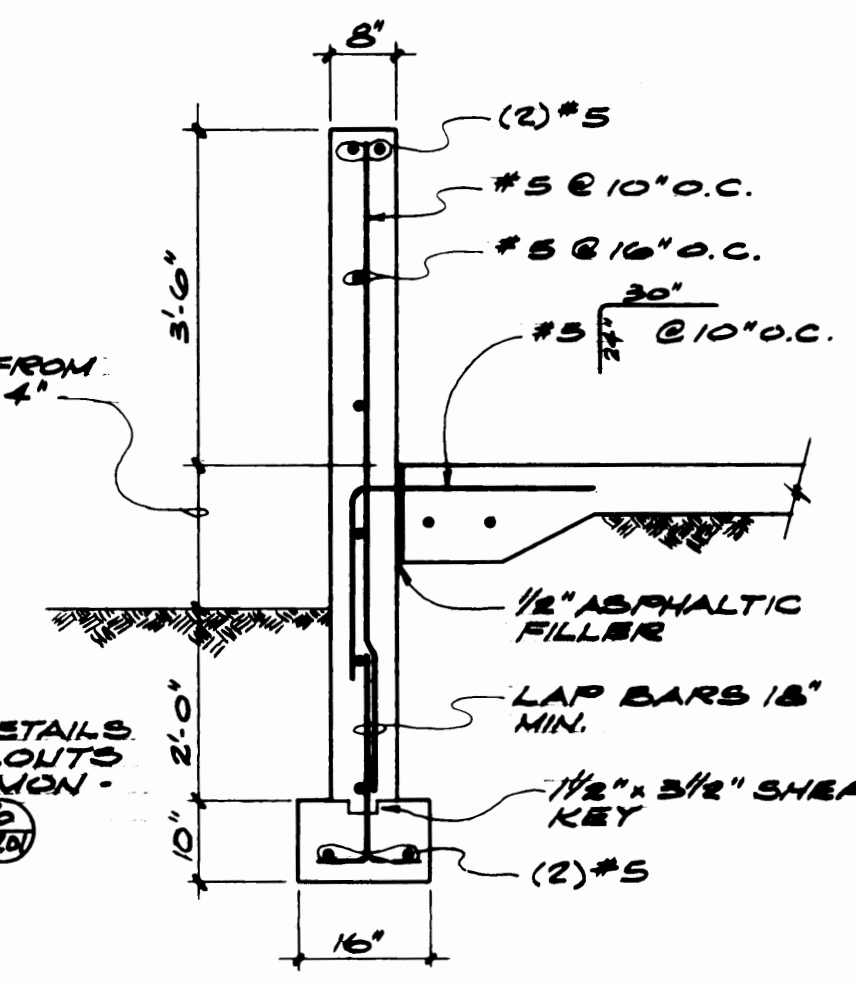


SECTION
1/2" = 1'-0"

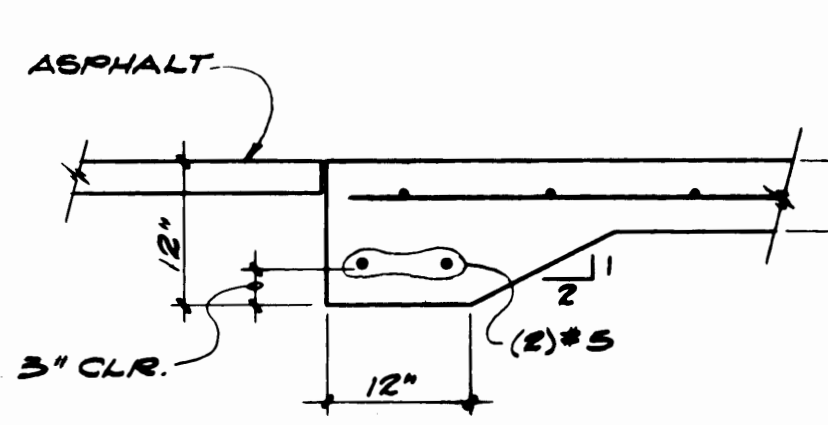

SECTION
3/4" = 1'-0"

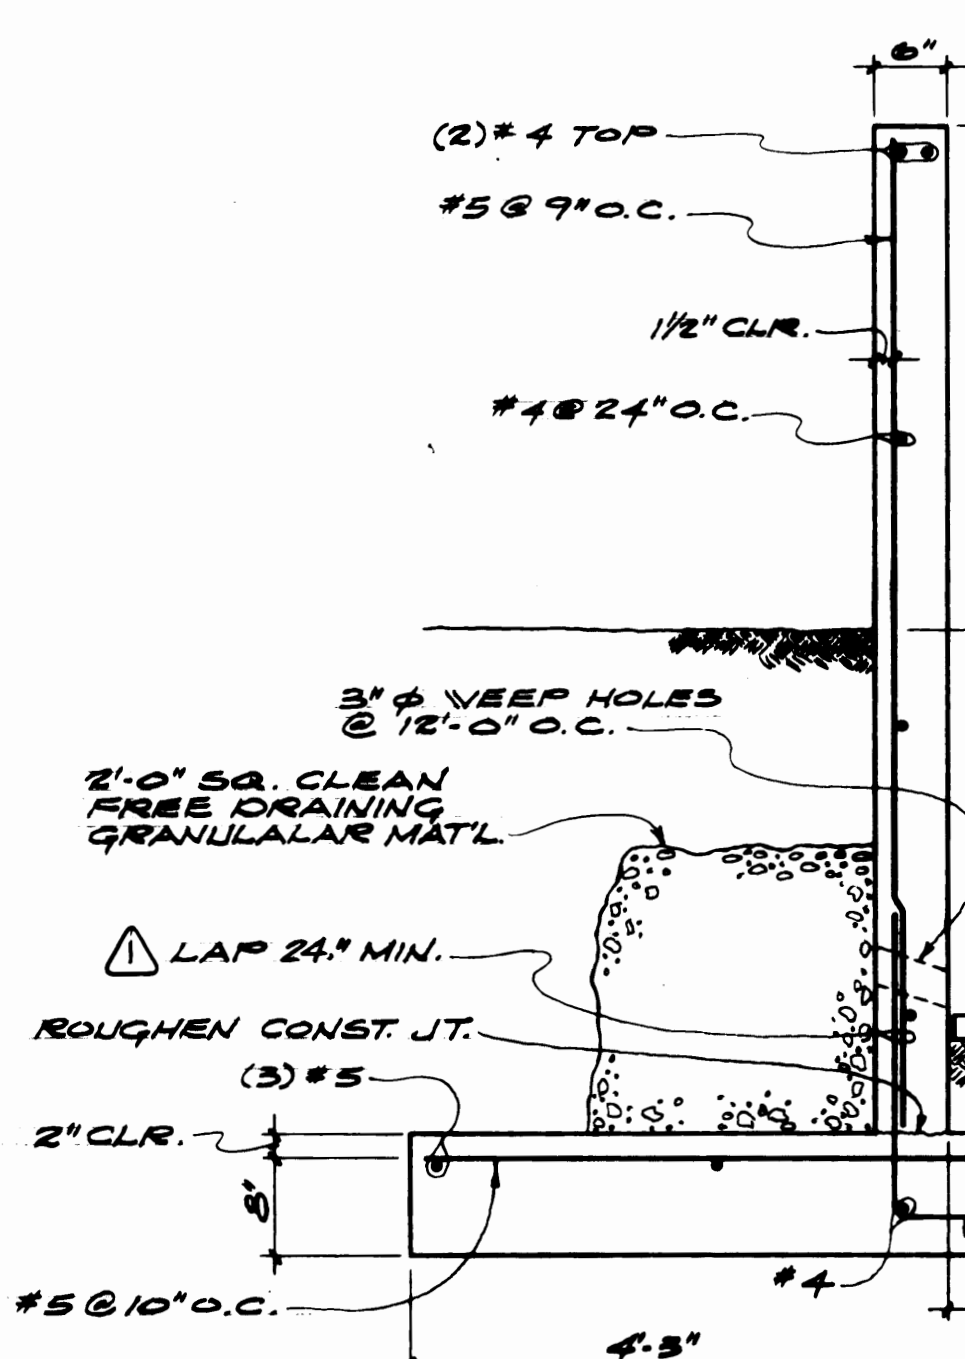

SECTION
3/4" = 1'-0"

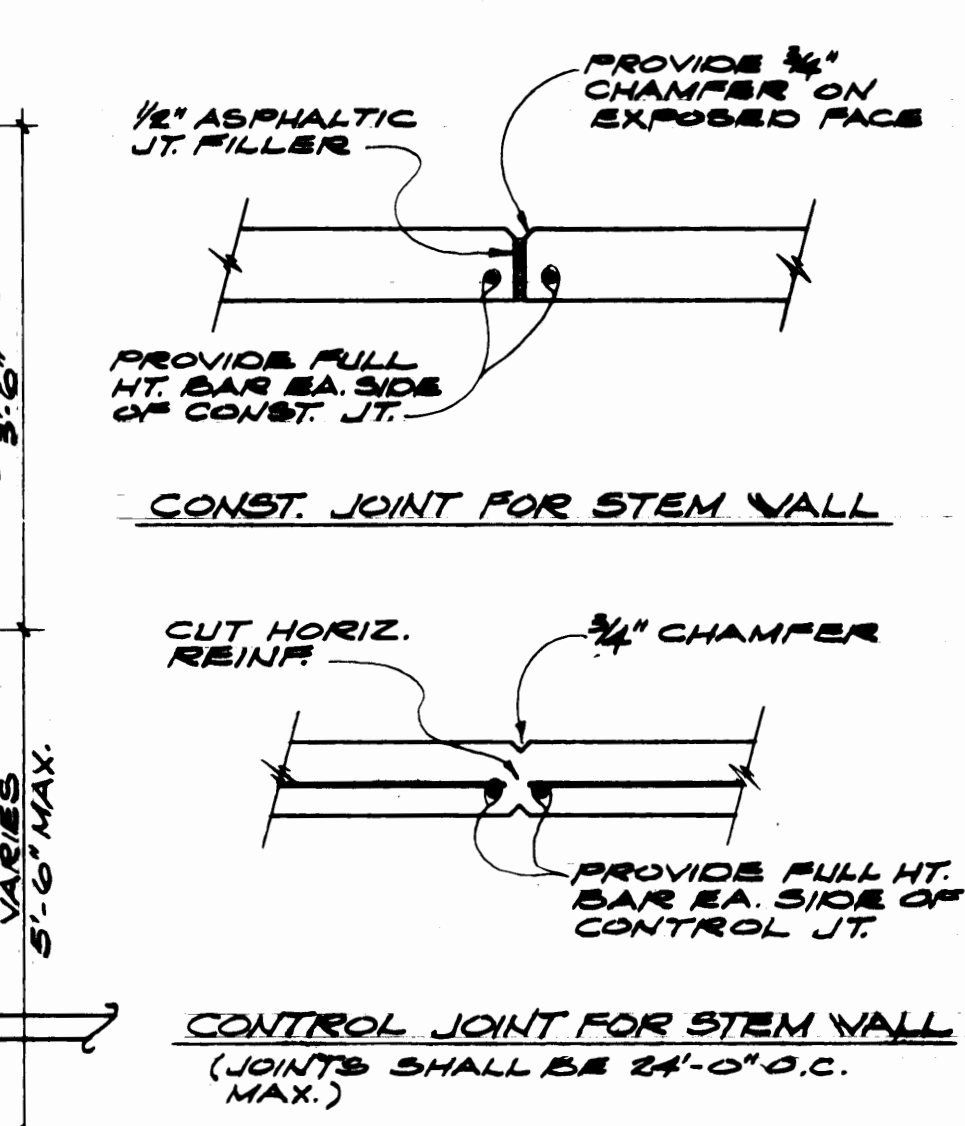

SECTION
3/4" = 1'-0"


DRAWN N.N.
DATE 3-22-84
CHECKED D.B.
DATE 3-22-84
CHECKED D.P.
DATE 3-22-84
CONT. NO. 557

PORT OF TACOMA
TACOMA TERMINALS, INC.
COVERED STORAGE DOCK
FOUNDATION PLAN & DETAILS

FIELD BOOK (S)
APPROVED [Signature] 3/30/84
PROJECT MANAGER [Signature] 3/30/84
DATE 3/30/84
SCALE
DRAWING NO. EP 3879.23
SHEET 49 OF 71




Revised to AS-BUILT
REVISION
BY
APP.
DATE

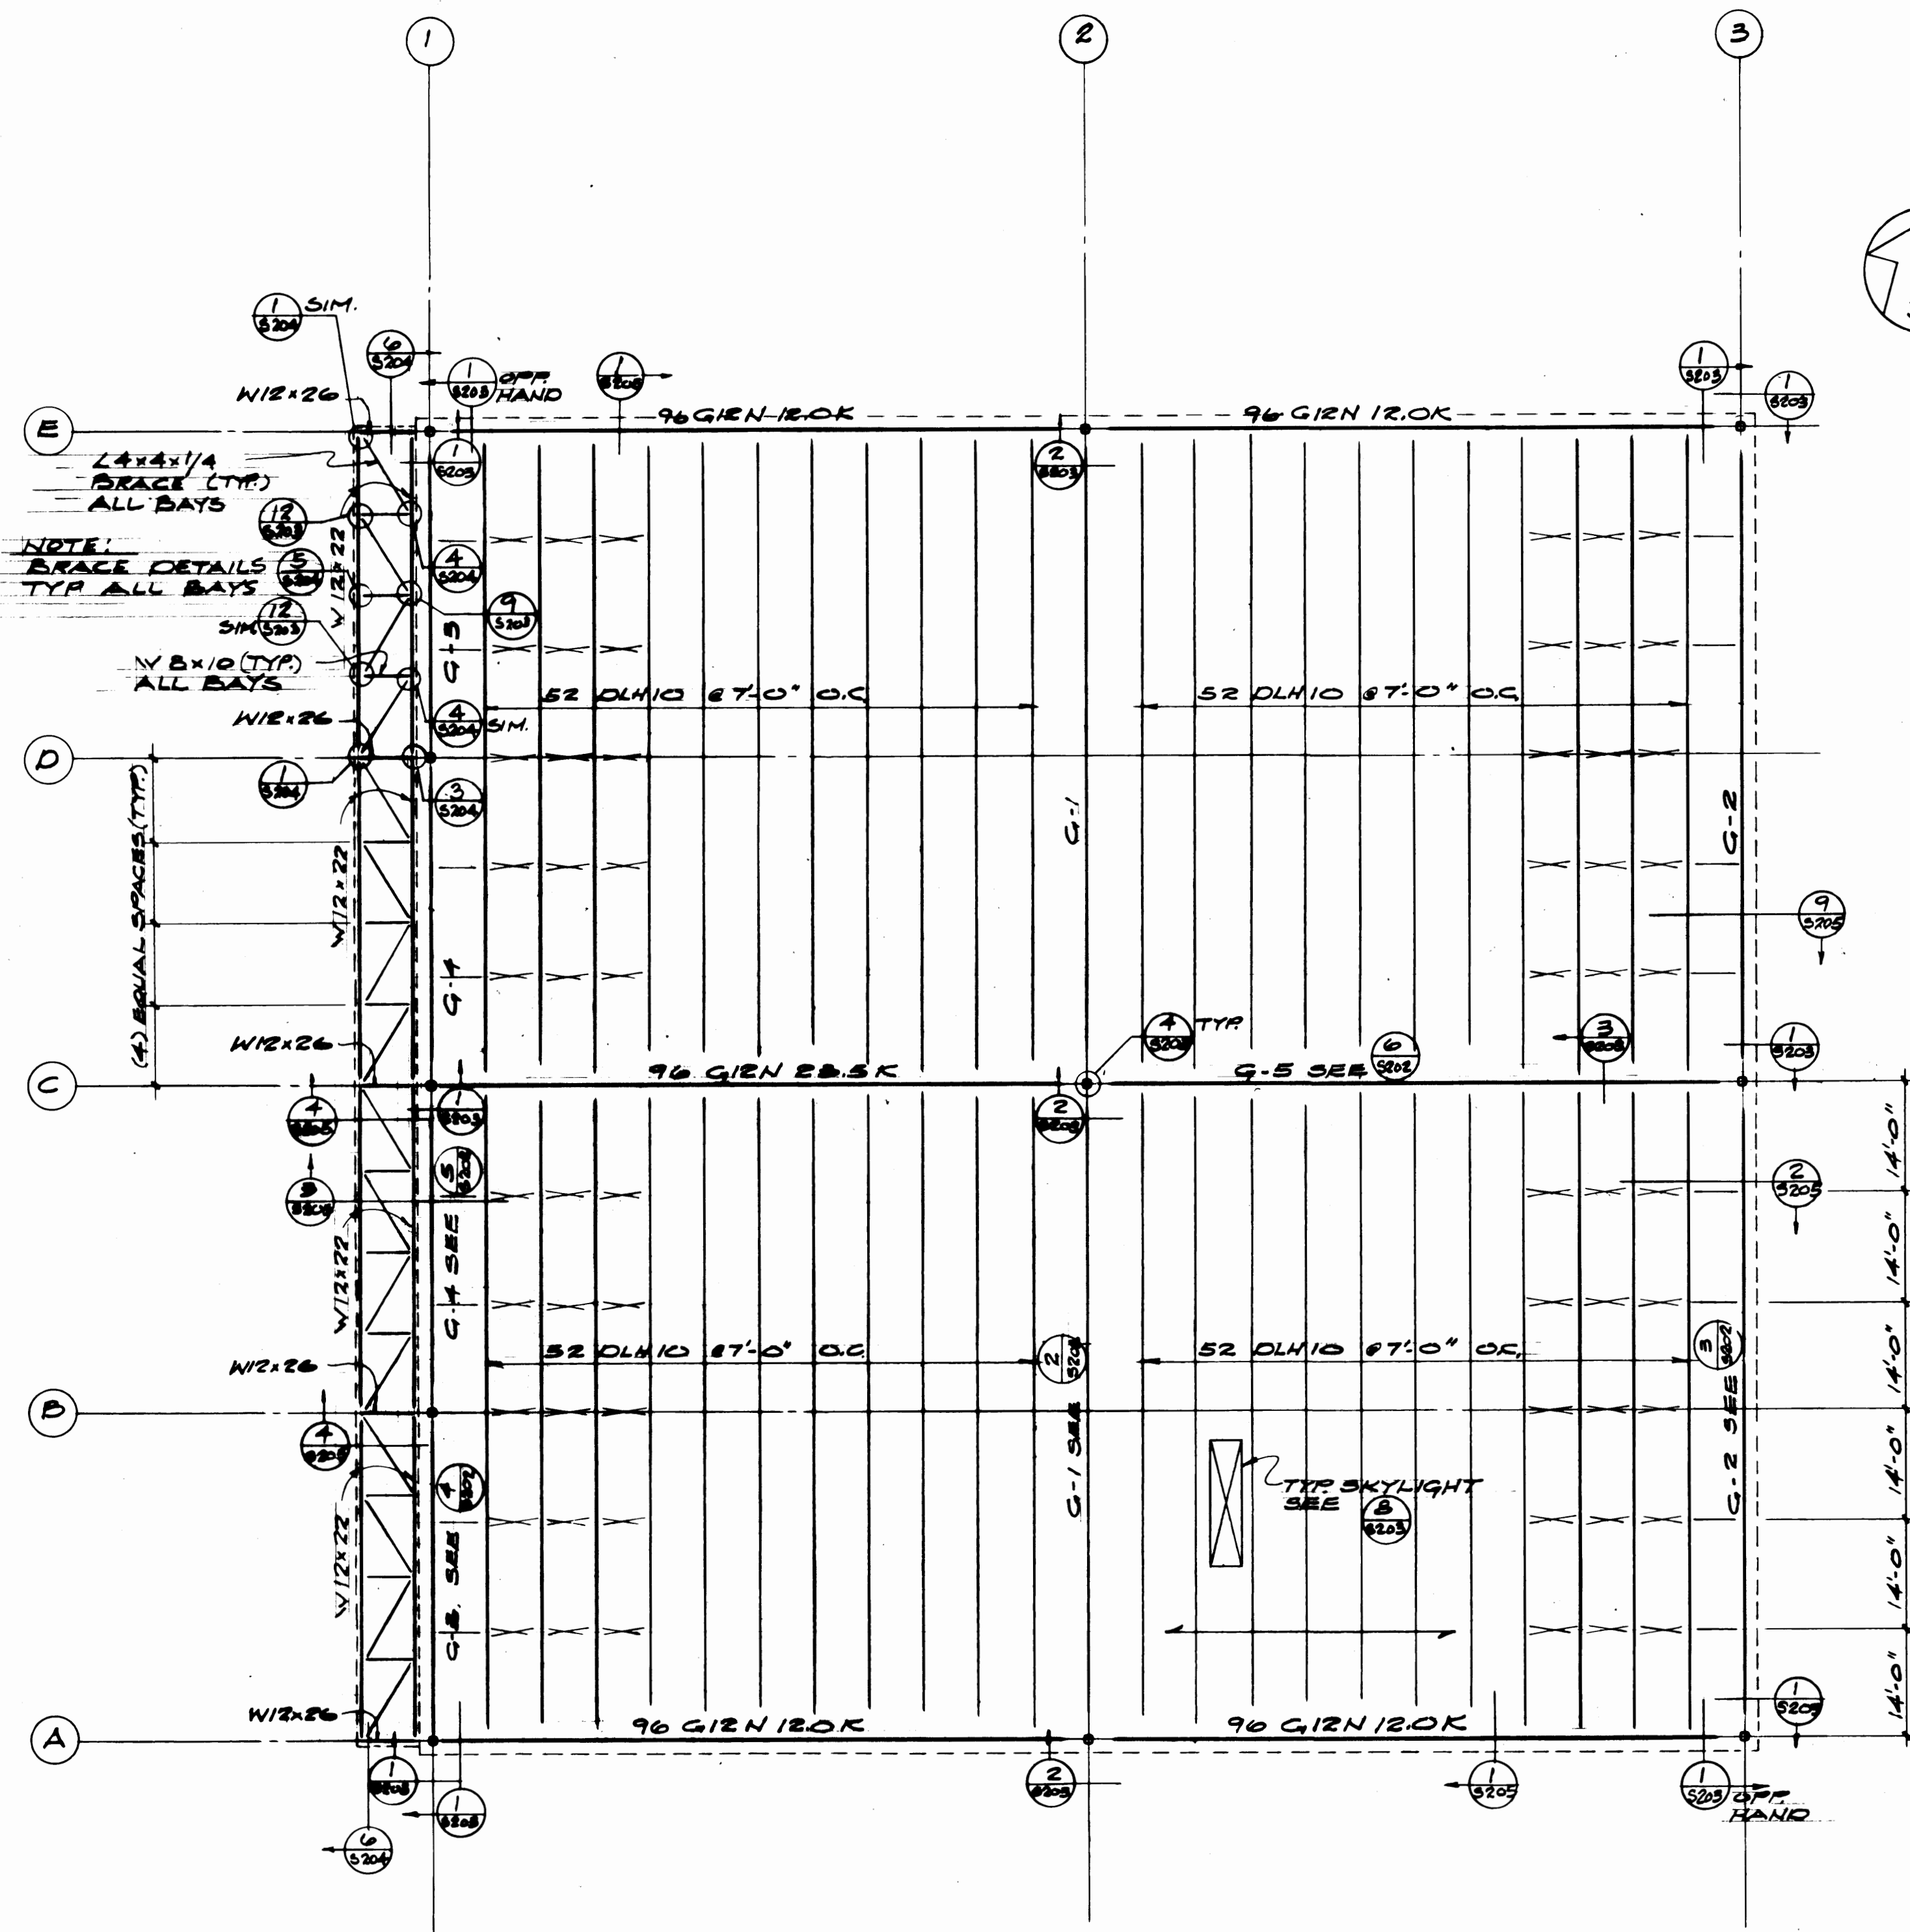

ROOF FRAMING PLAN

ROOF FRAMING NOTES:

- Indicates direction of metal deck span. See 6/S203.
- For openings less than 16" square see 7/S203.
- For allowable methods and locations for hanging loads from steel joist see 5/S203.

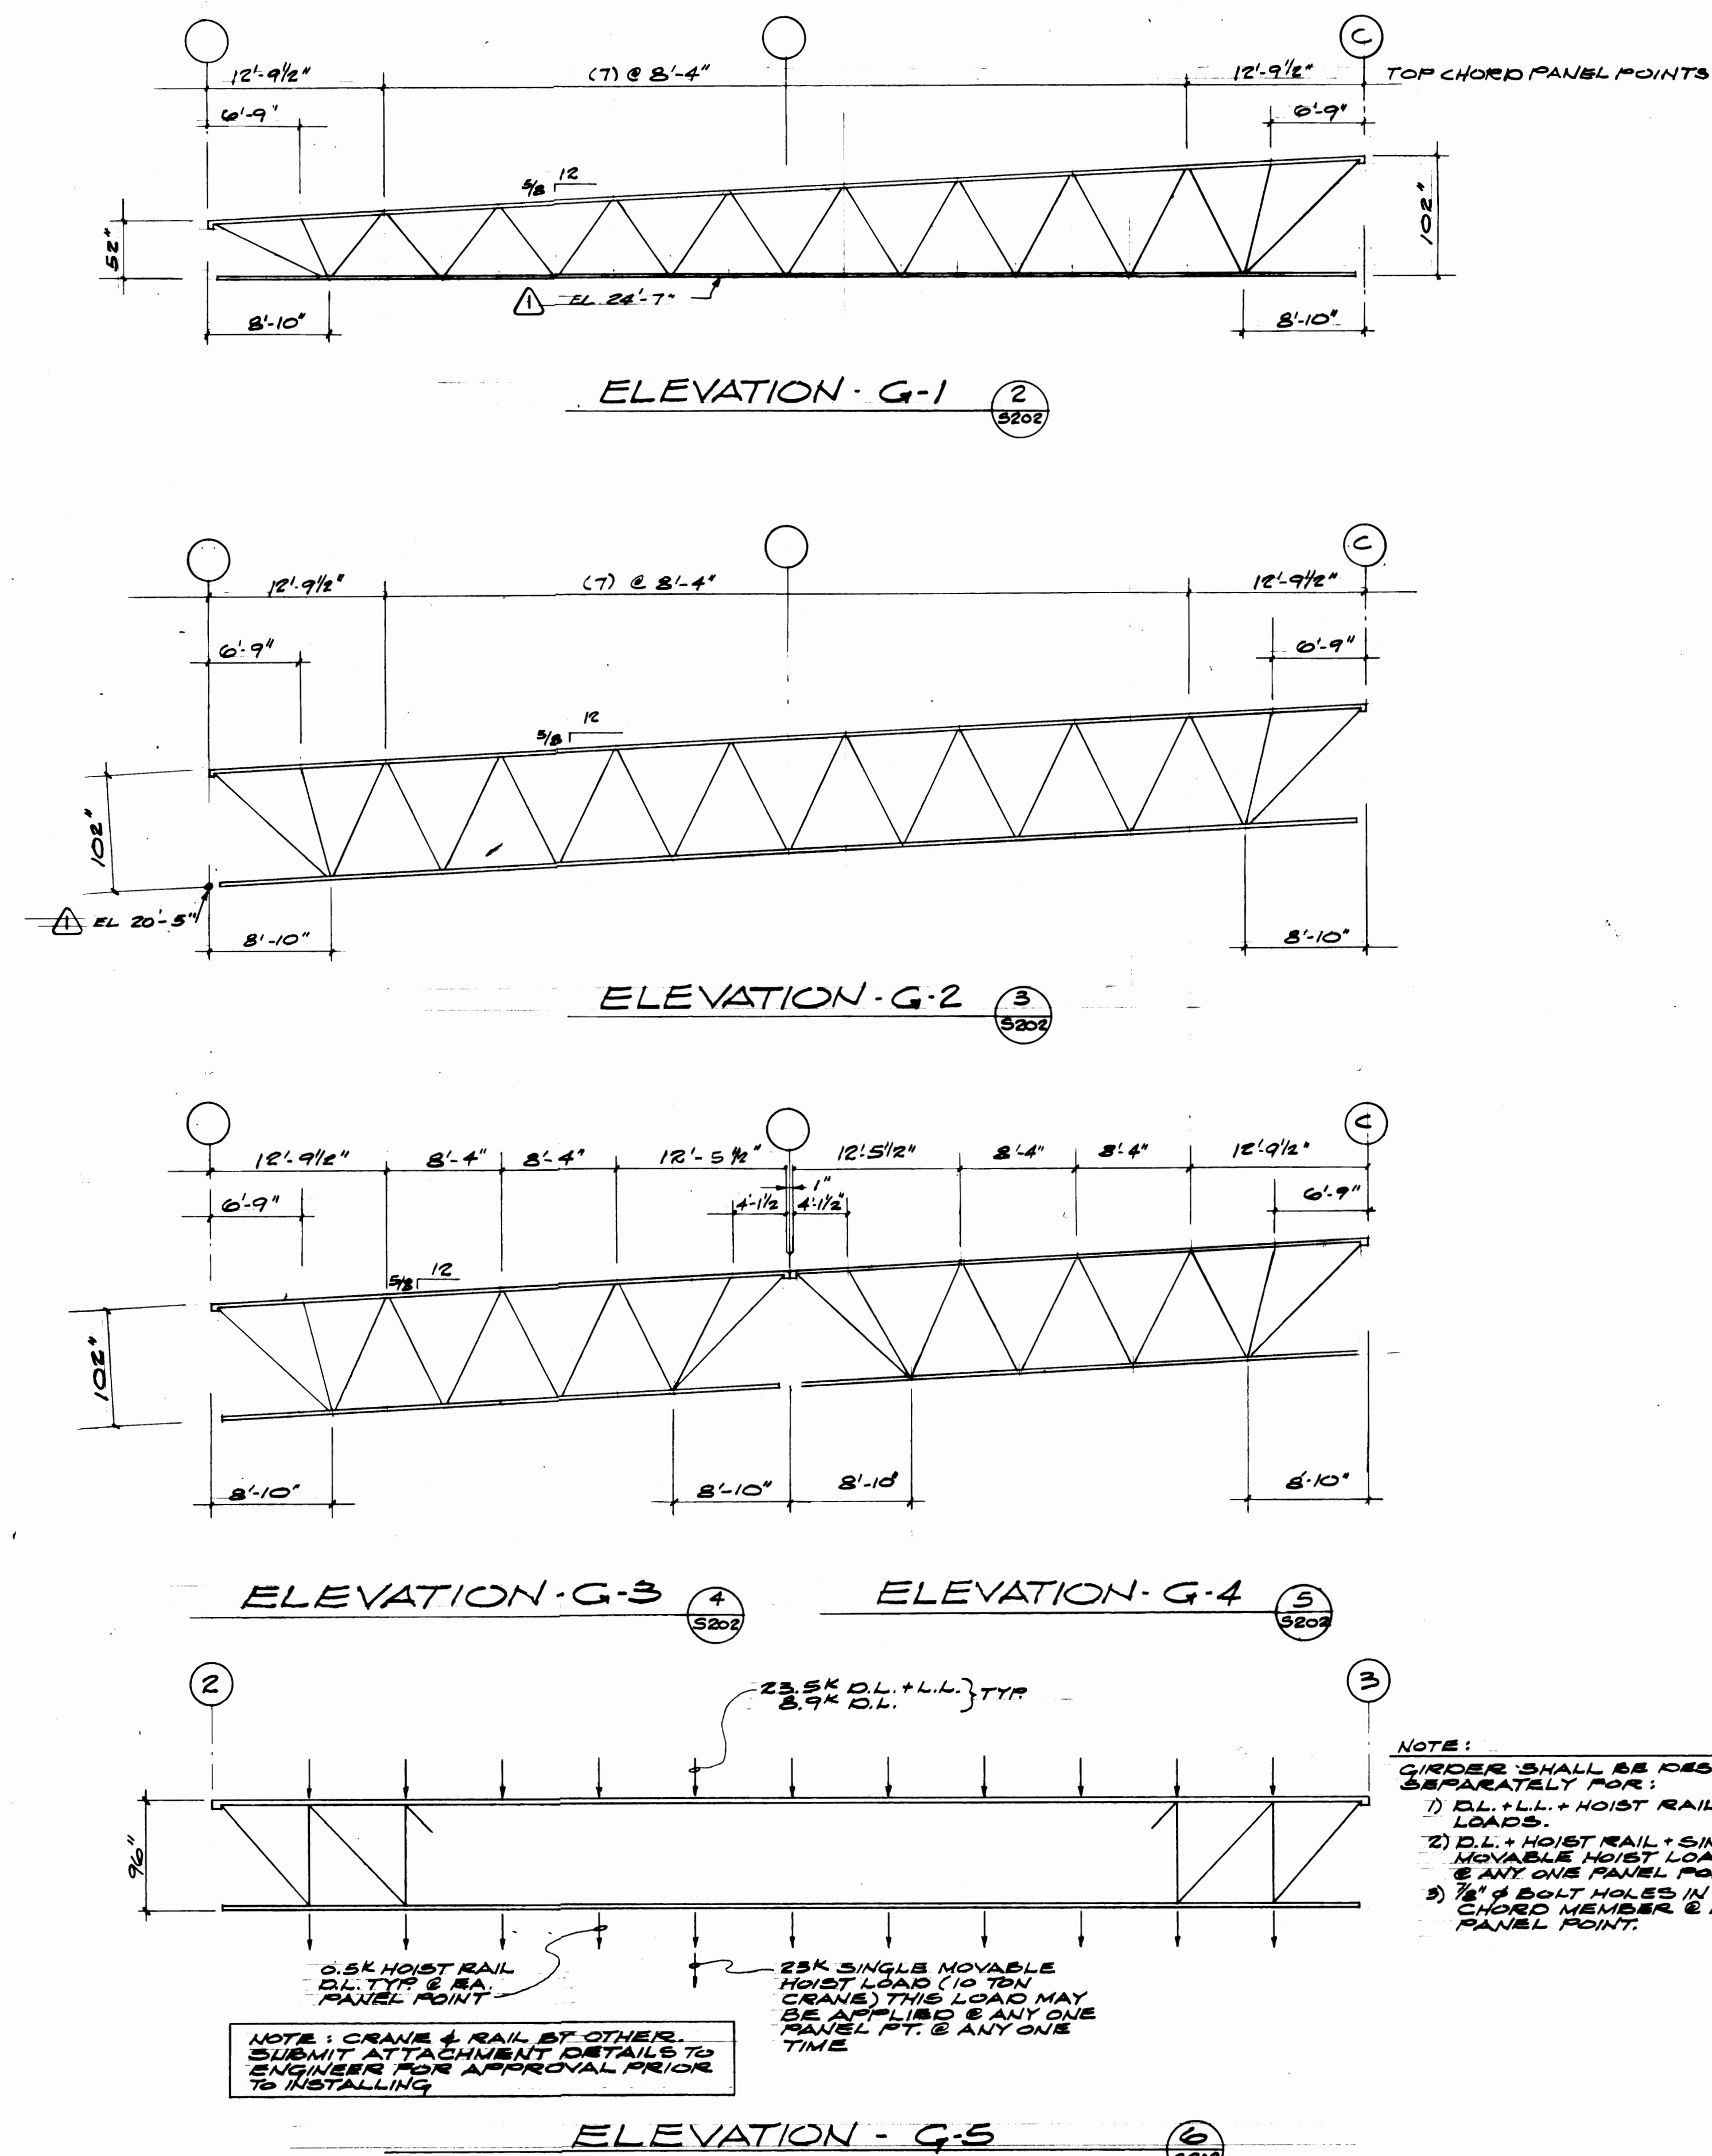

NOTE:
GIRDER SHALL BE DESIGNED SEPARATELY FOR:
1) DL+LL+HOIST RAIL LOADS.
2) DL+HOIST RAIL+ SINGLE MOVABLE HOIST LOAD, & ANY ONE PANEL POINT.
3) 1/2" BOLT HOLES IN EA. CHORD MEMBER @ EA. PANEL POINT.

NOTE: CRANE & RAIL BY OTHER. SUBMIT ATTACHMENT DETAILS TO ENGINEER FOR APPROVAL PRIOR TO INSTALLING.



Structural Engineers, Inc.
Consulting Engineers
81 University, Suite 201
Tacoma, WA 98401
(206) 255-4110



MARK	REVISION	BY	APP.	DATE
	REVISED TO AS BUILT	RJS		3/30/84

DRAWN: N.N.
DATE: 3-22-84
CHECKED: D.S.
DATE: 3-22-84
CHECKED: D.P.
DATE: 3-22-84
CONT. NO. 527

APPROVED: [Signature]
DATE: 3/30/84
DATE: 3/31/84

PORT OF TACOMA
TACOMA TERMINALS, INC.
COVERED STORAGE DOCK
ROOF FRAMING PLAN & DETAILS

SCALE: _____
DRAWING NO.: EP 3871-23
SHEET: 50 OF 71

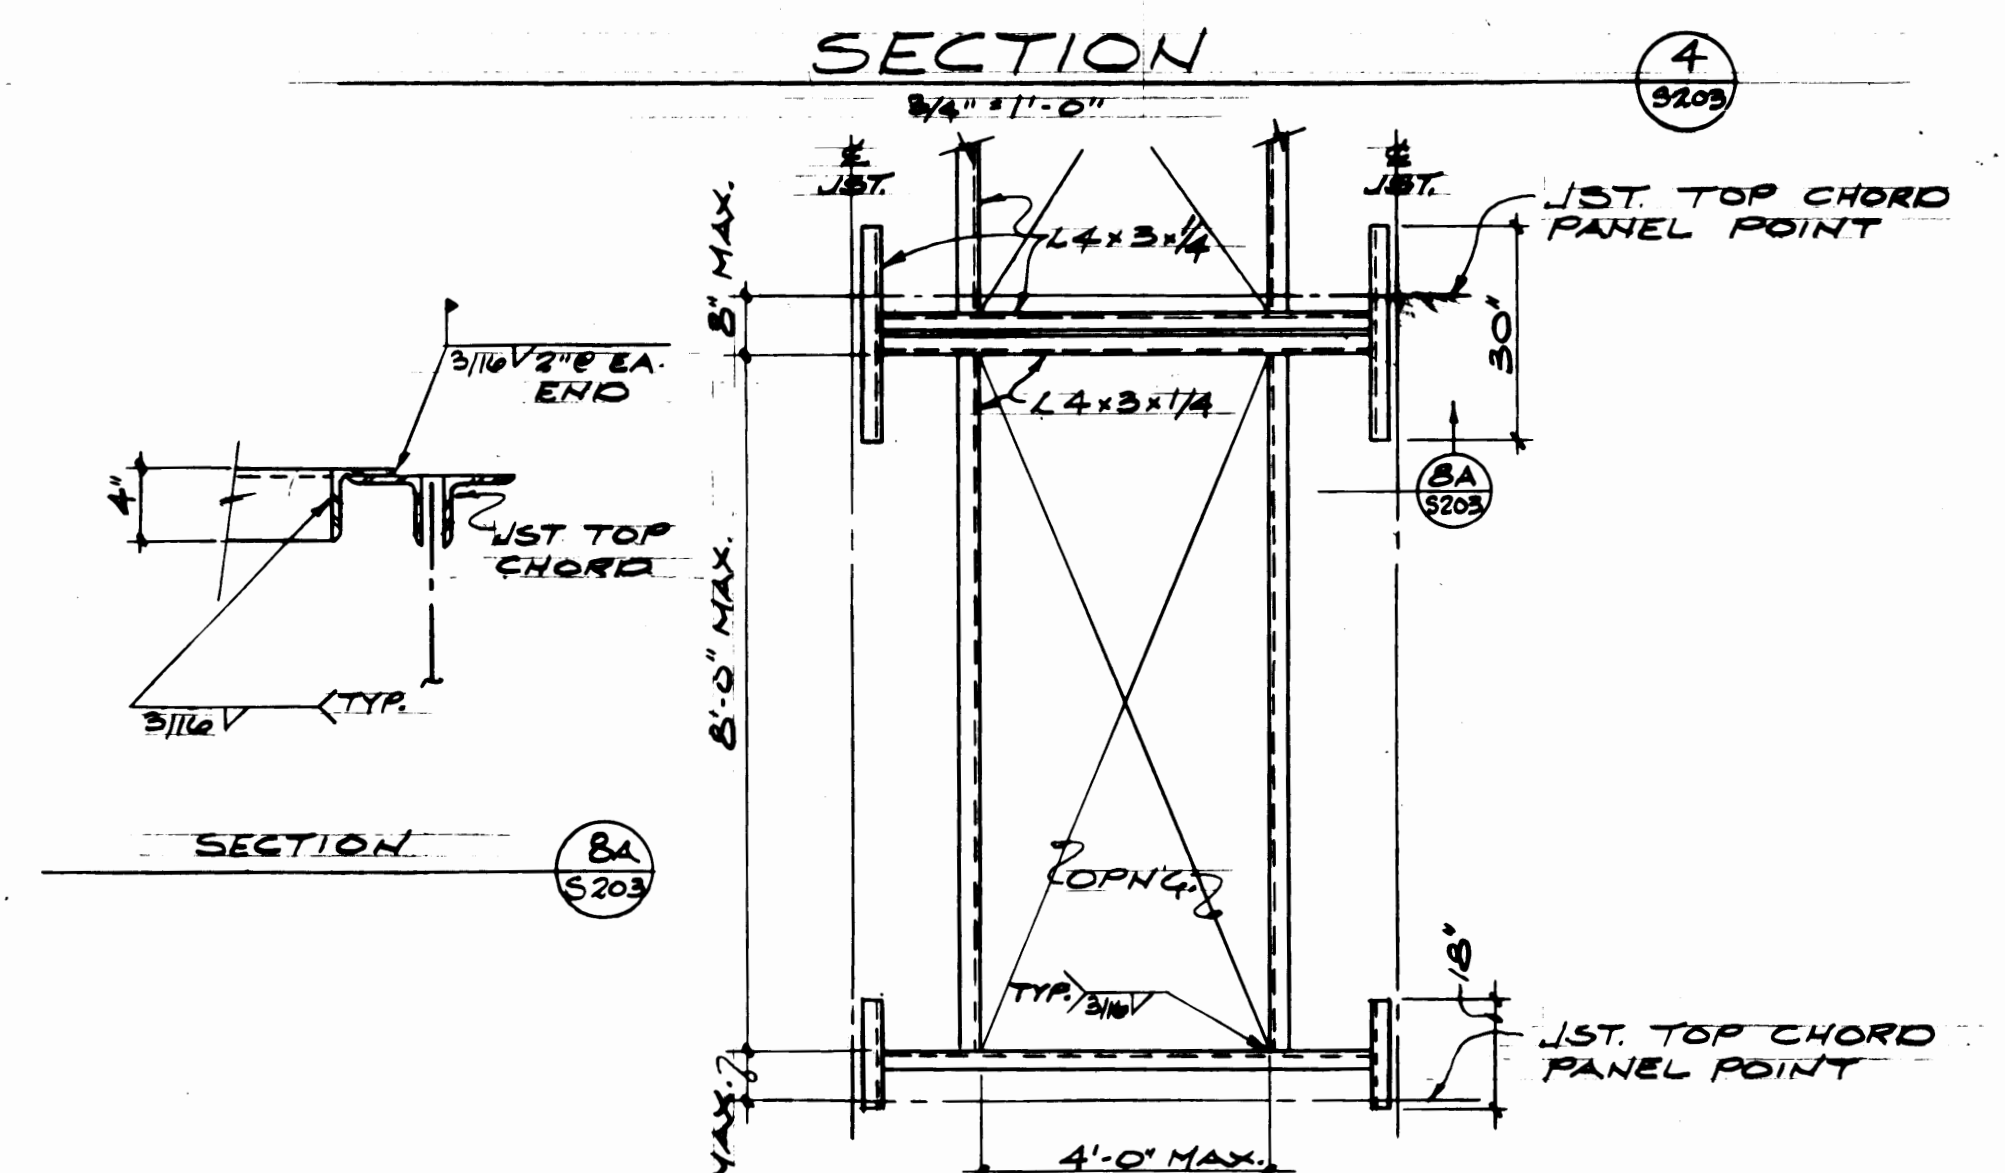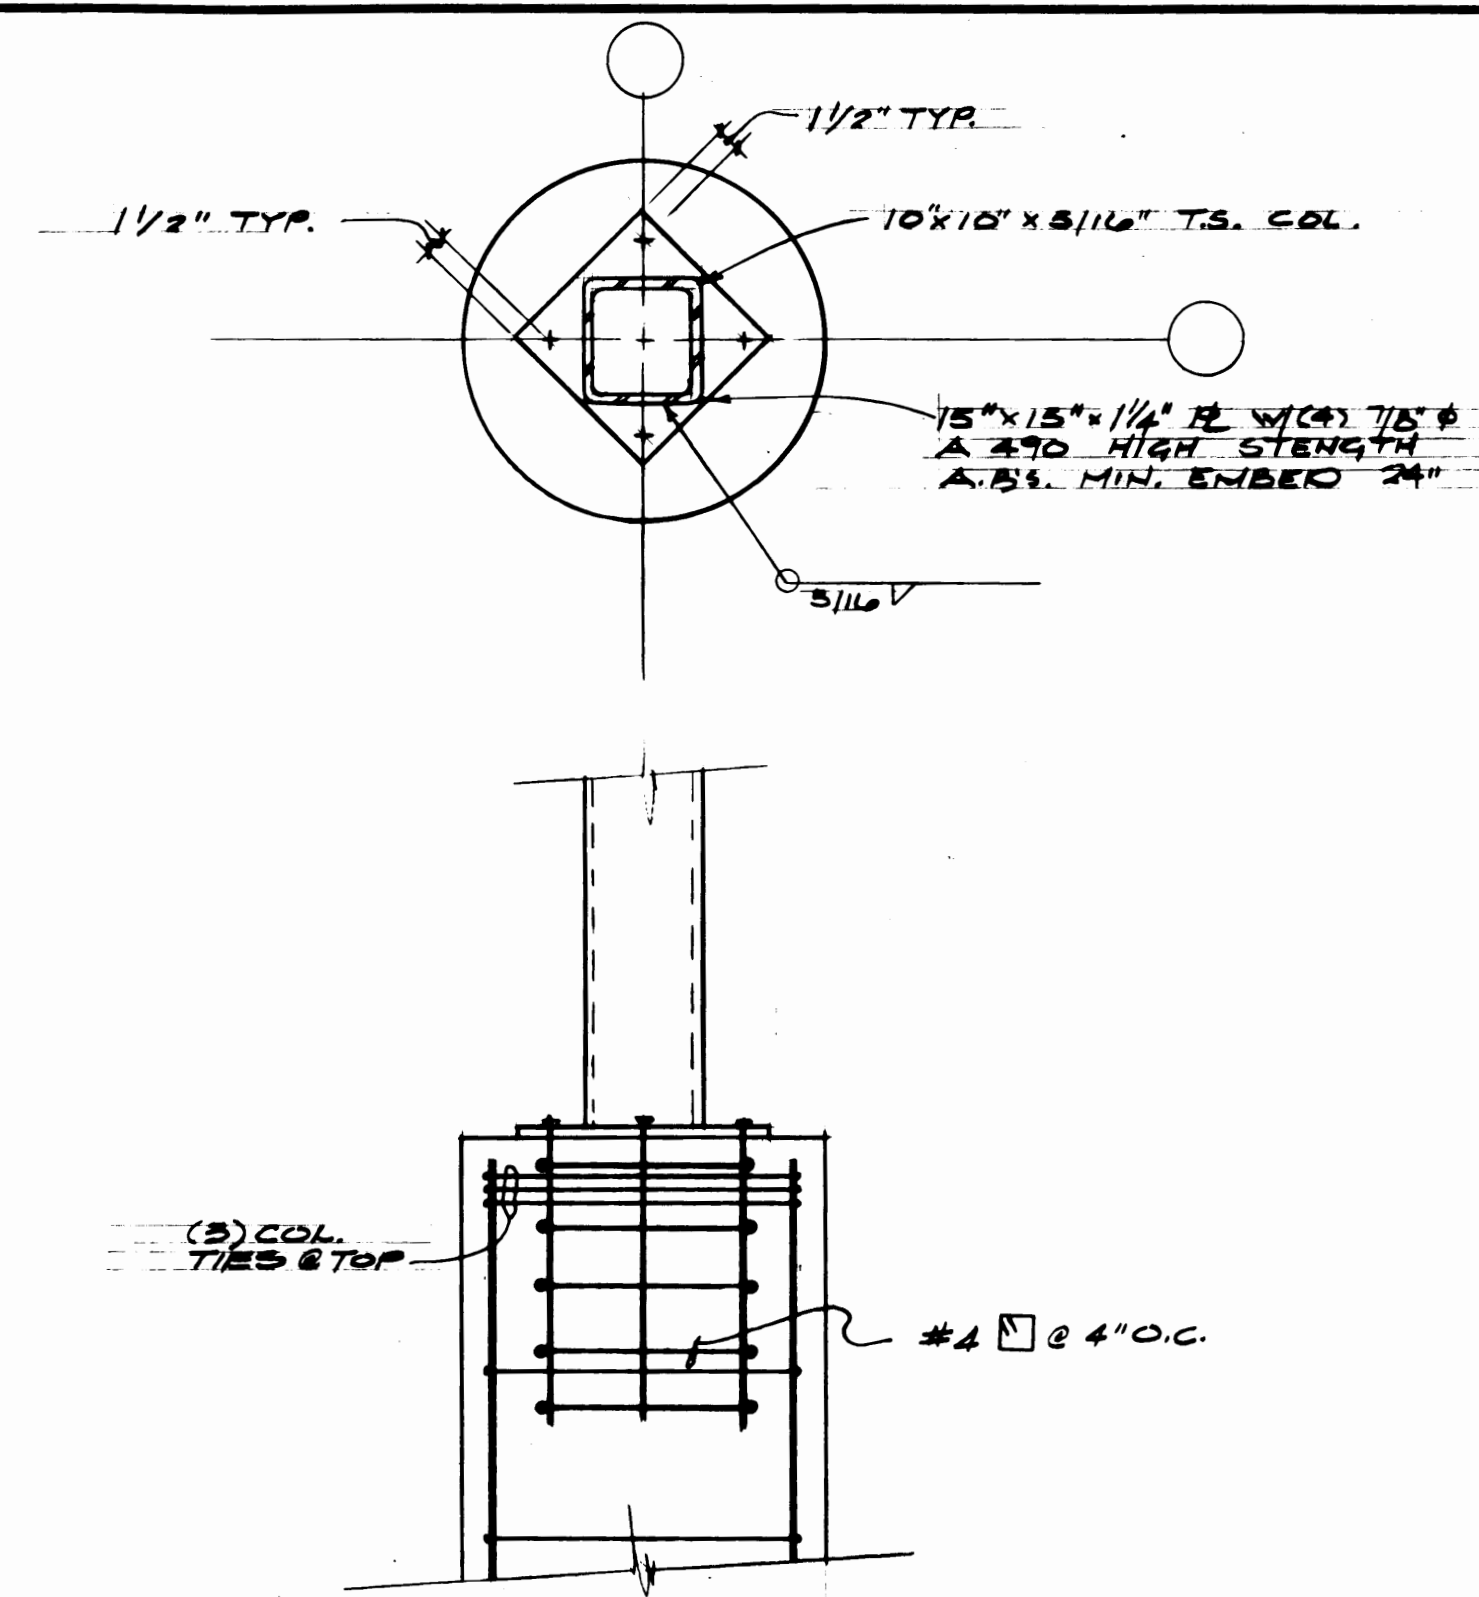

Notes:

1. The maximum allowable single load that may be added to the joist at any one point = **5000**
2. The maximum allowable total load that may be added to any one joist = **7000**
3. Single loads less than **400** may be added anywhere along the upper chord (not just at panel points) without adding an angle to stiffen the joist.
4. Do not cut or drill through any joist member.
5. This detail is applicable to hanging mechanical equipment, sprinkler pipes, etc.

NOTES:

- 1) MIN DECK PROPERTIES & WELD PATTERN SHOWN.
- 2) (2) SPAN MIN., (3) SPAN PREFERRED.

DETAIL
NO SCALE


DETAIL
NO SCALE

SECTION
NO SCALE

NOTE: VERIFY FRAMING DIMENSIONS
W/ SKYLIGHT MANUFACTURER-SEE ARCH.
FOR LOCATION.

TYP. FRAMING @ SKYLIGHT OPENING IN METAL ROOF DECK

DETAIL
NO SCALE

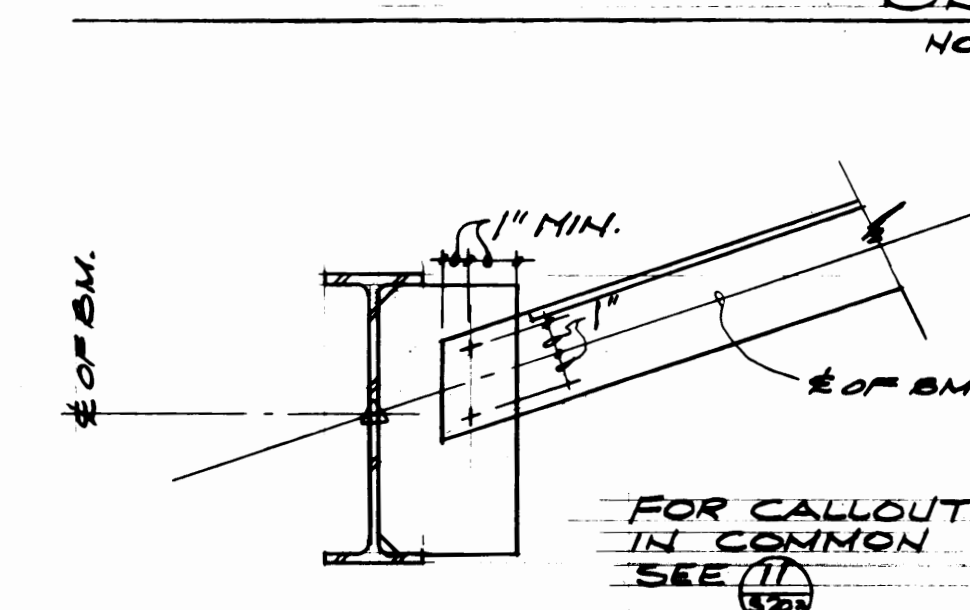



FOR CALLOUTS
IN COMMON
SEE (9)


FOR CALLOUTS IN
COMMON
SEE 10
5203

FOR CALLOUT
IN COMMON
SEE 11


SECTION

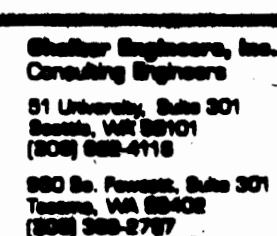

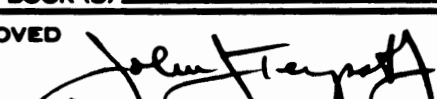
DRAWN <u>N.N.</u>		PORT OF TACOMA	
DATE <u>3-22-84</u>			
CHECKED <u>D.E.</u>		TACOMA TERMINALS, INC. <u>COVERED STORAGE DOCK</u> <u>SECTIONS 4 DETAILS</u>	
DATE <u>3-22-84</u>			
CHECKED <u>D.P.</u>			
DATE <u>3-22-84</u>			
CONT. NO. <u>557</u>			
FIELD BOOK (S)		SCALE	
APPROVED		DRAWING NO.	
 ROBERT J. SMITH PROJECT MANAGER		3/30/84 DATE 3/30/84	
DATE		SHEET 51 OF 71	

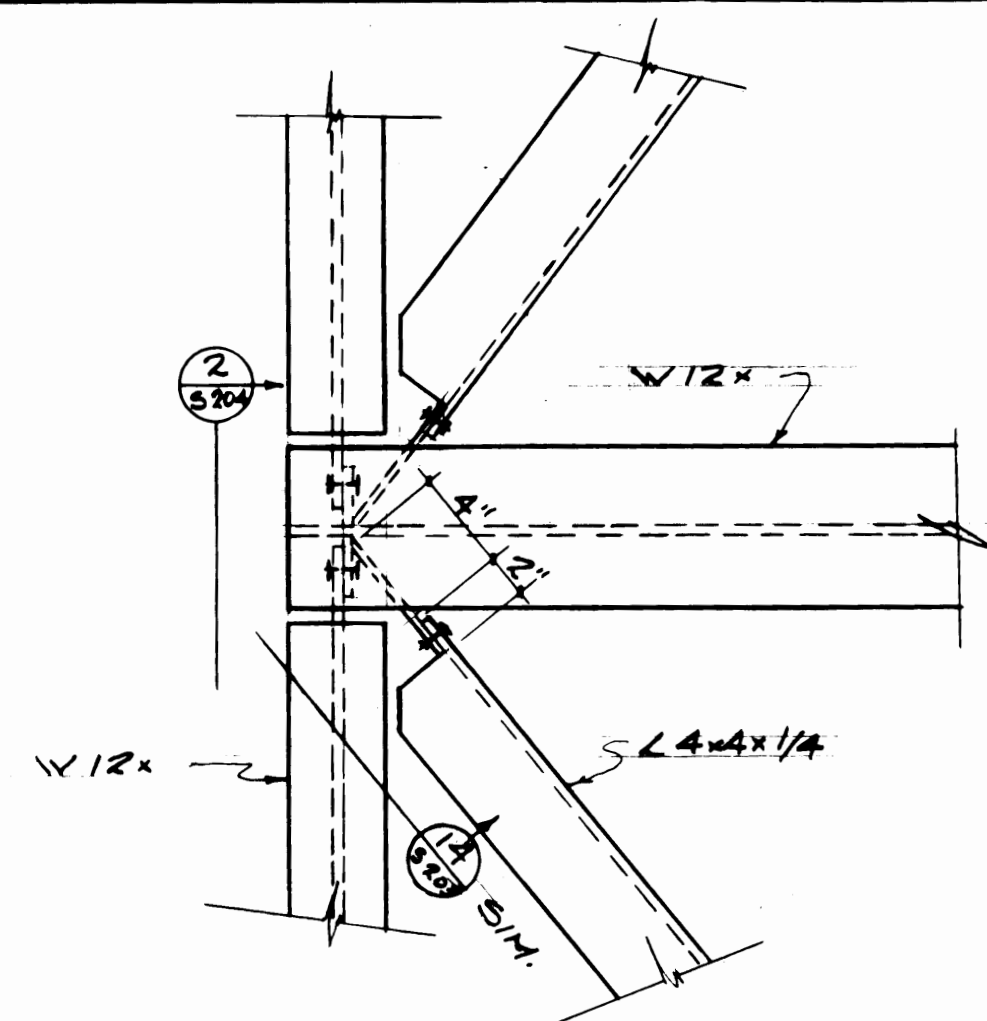


SECTION 1
1 1/2" x 1'-0" (5204)

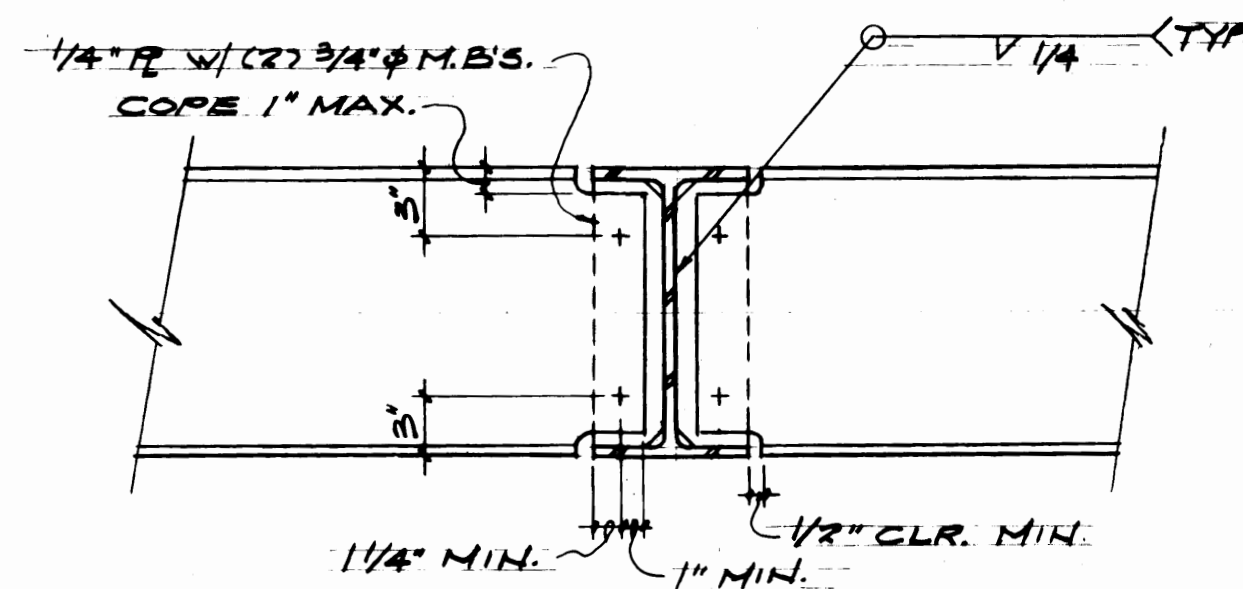


SECTION 2
1 1/2" x 1'-0" (5204)

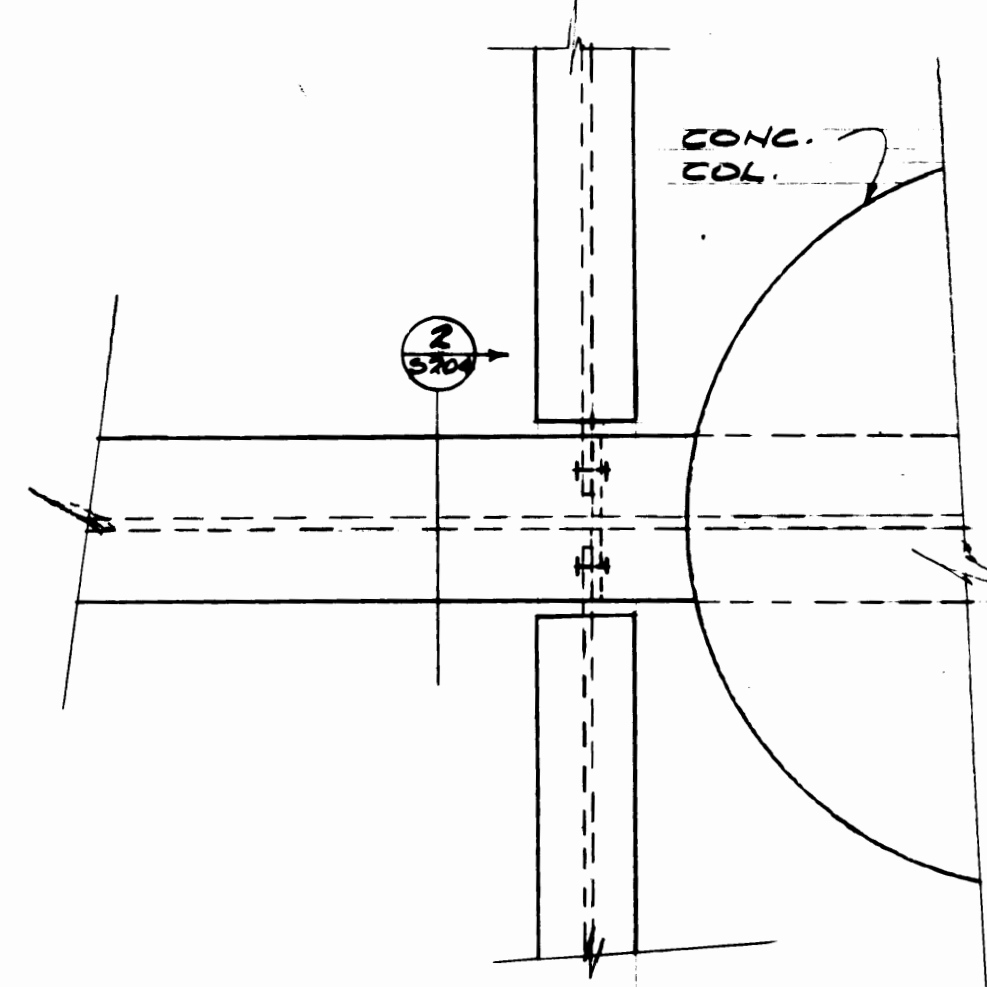


SECTION 3
1 1/2" x 1'-0" (5204)

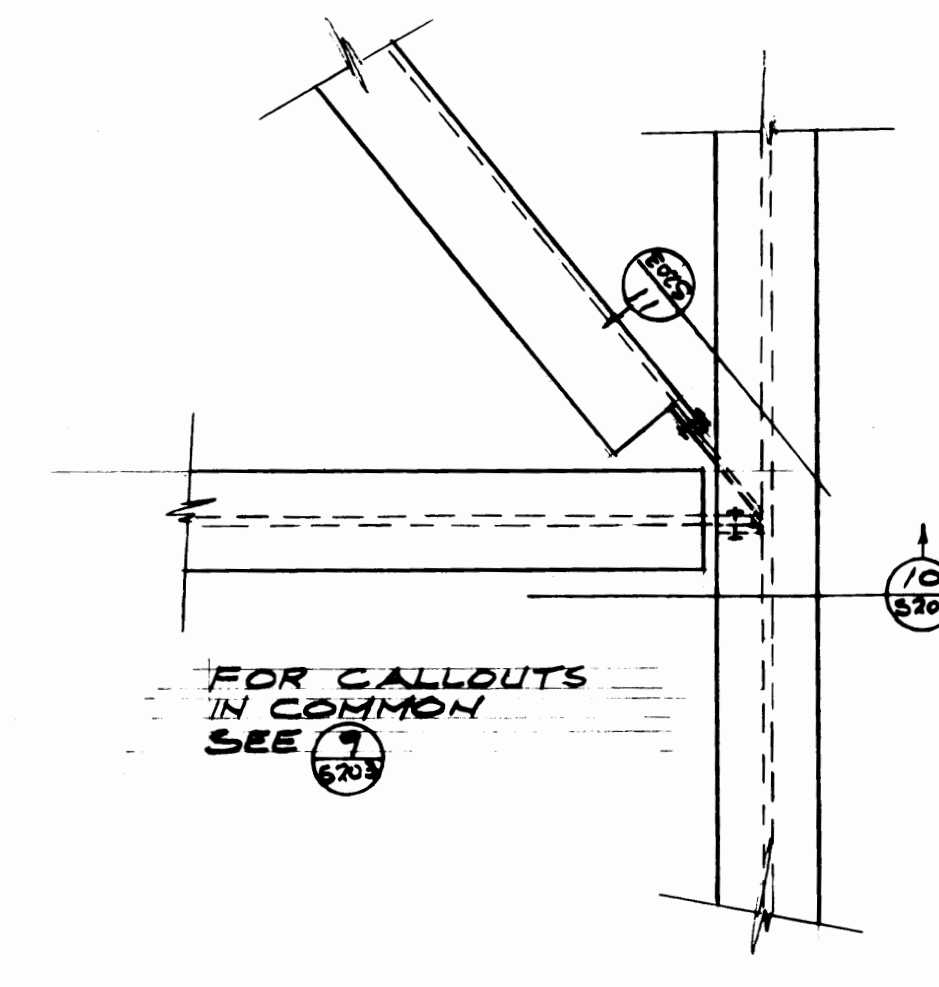

SECTION 4
1 1/2" x 1'-0" (5204)

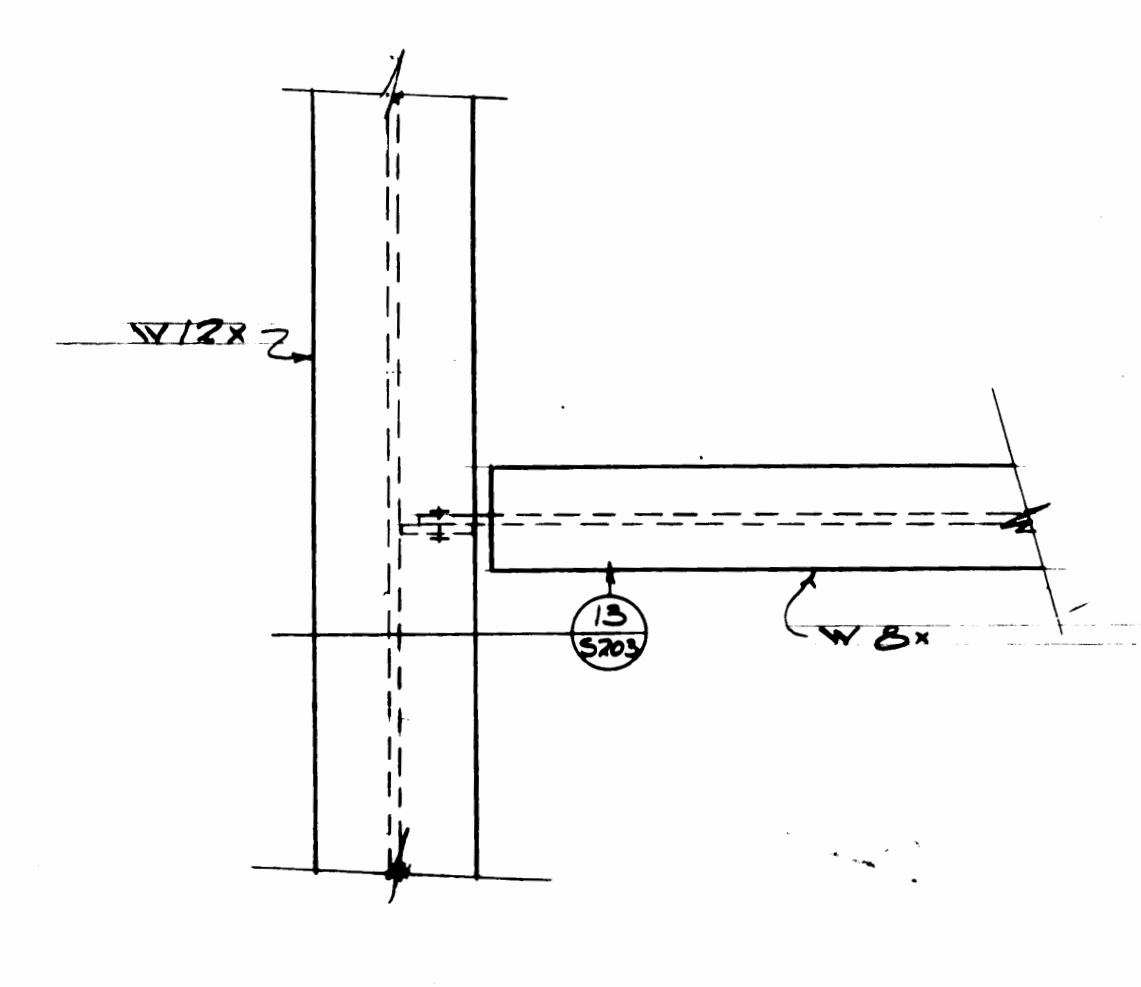

SECTION 5
1 1/2" x 1'-0" (5204)

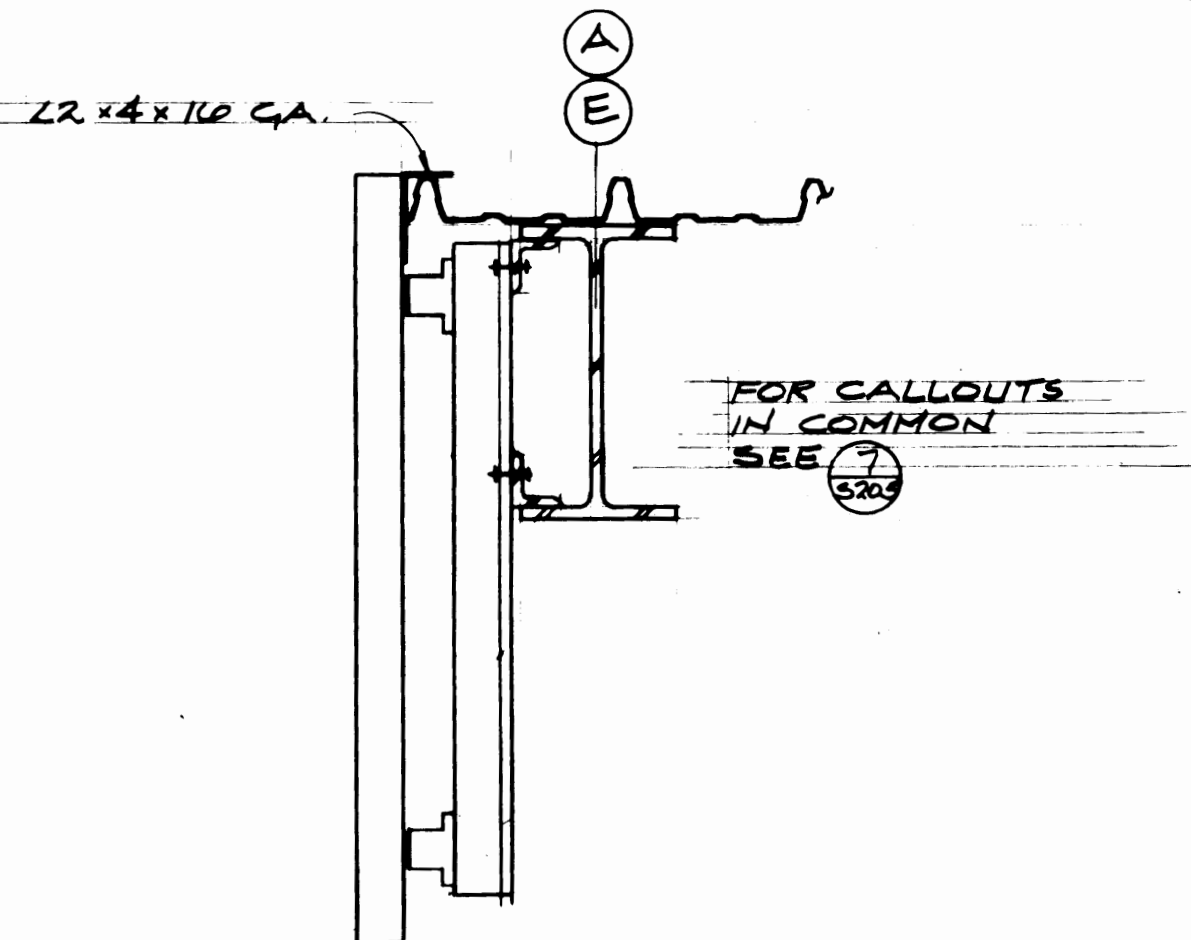


SECTION 6
1 1/2" x 1'-0" (5204)




Robert L. Smith, Inc.
Consulting Engineers
51 University, Suite 201
Roanoke, VA 24061
(800) 522-4118
500 So. Parkside, Suite 201
Roanoke, VA 24062
(540) 522-4118

MARK	REVISION	BY	APP.	DATE
	NO AS-BUILT CHANGE	R.L.S.		3/20/84


DRAWN: N.N.		DATE: 3-22-84		PORT OF TACOMA TACOMA TERMINALS, INC. COVERED STORAGE DOCK SECTIONS & DETAILS	
CHECKED: D.S.		DATE: 3-22-84			
CHECKED: D.F.		DATE: 3-22-84			
CONT. NO. 557					
FIELD BOOK (S)		APPROVED: [Signature] 3/20/84		DRAWING NO. EP 3879-23-5204	
		DATE: 3/20/84		SHEET 52 OF 71	
		DATE: 3/20/84		J-5586	

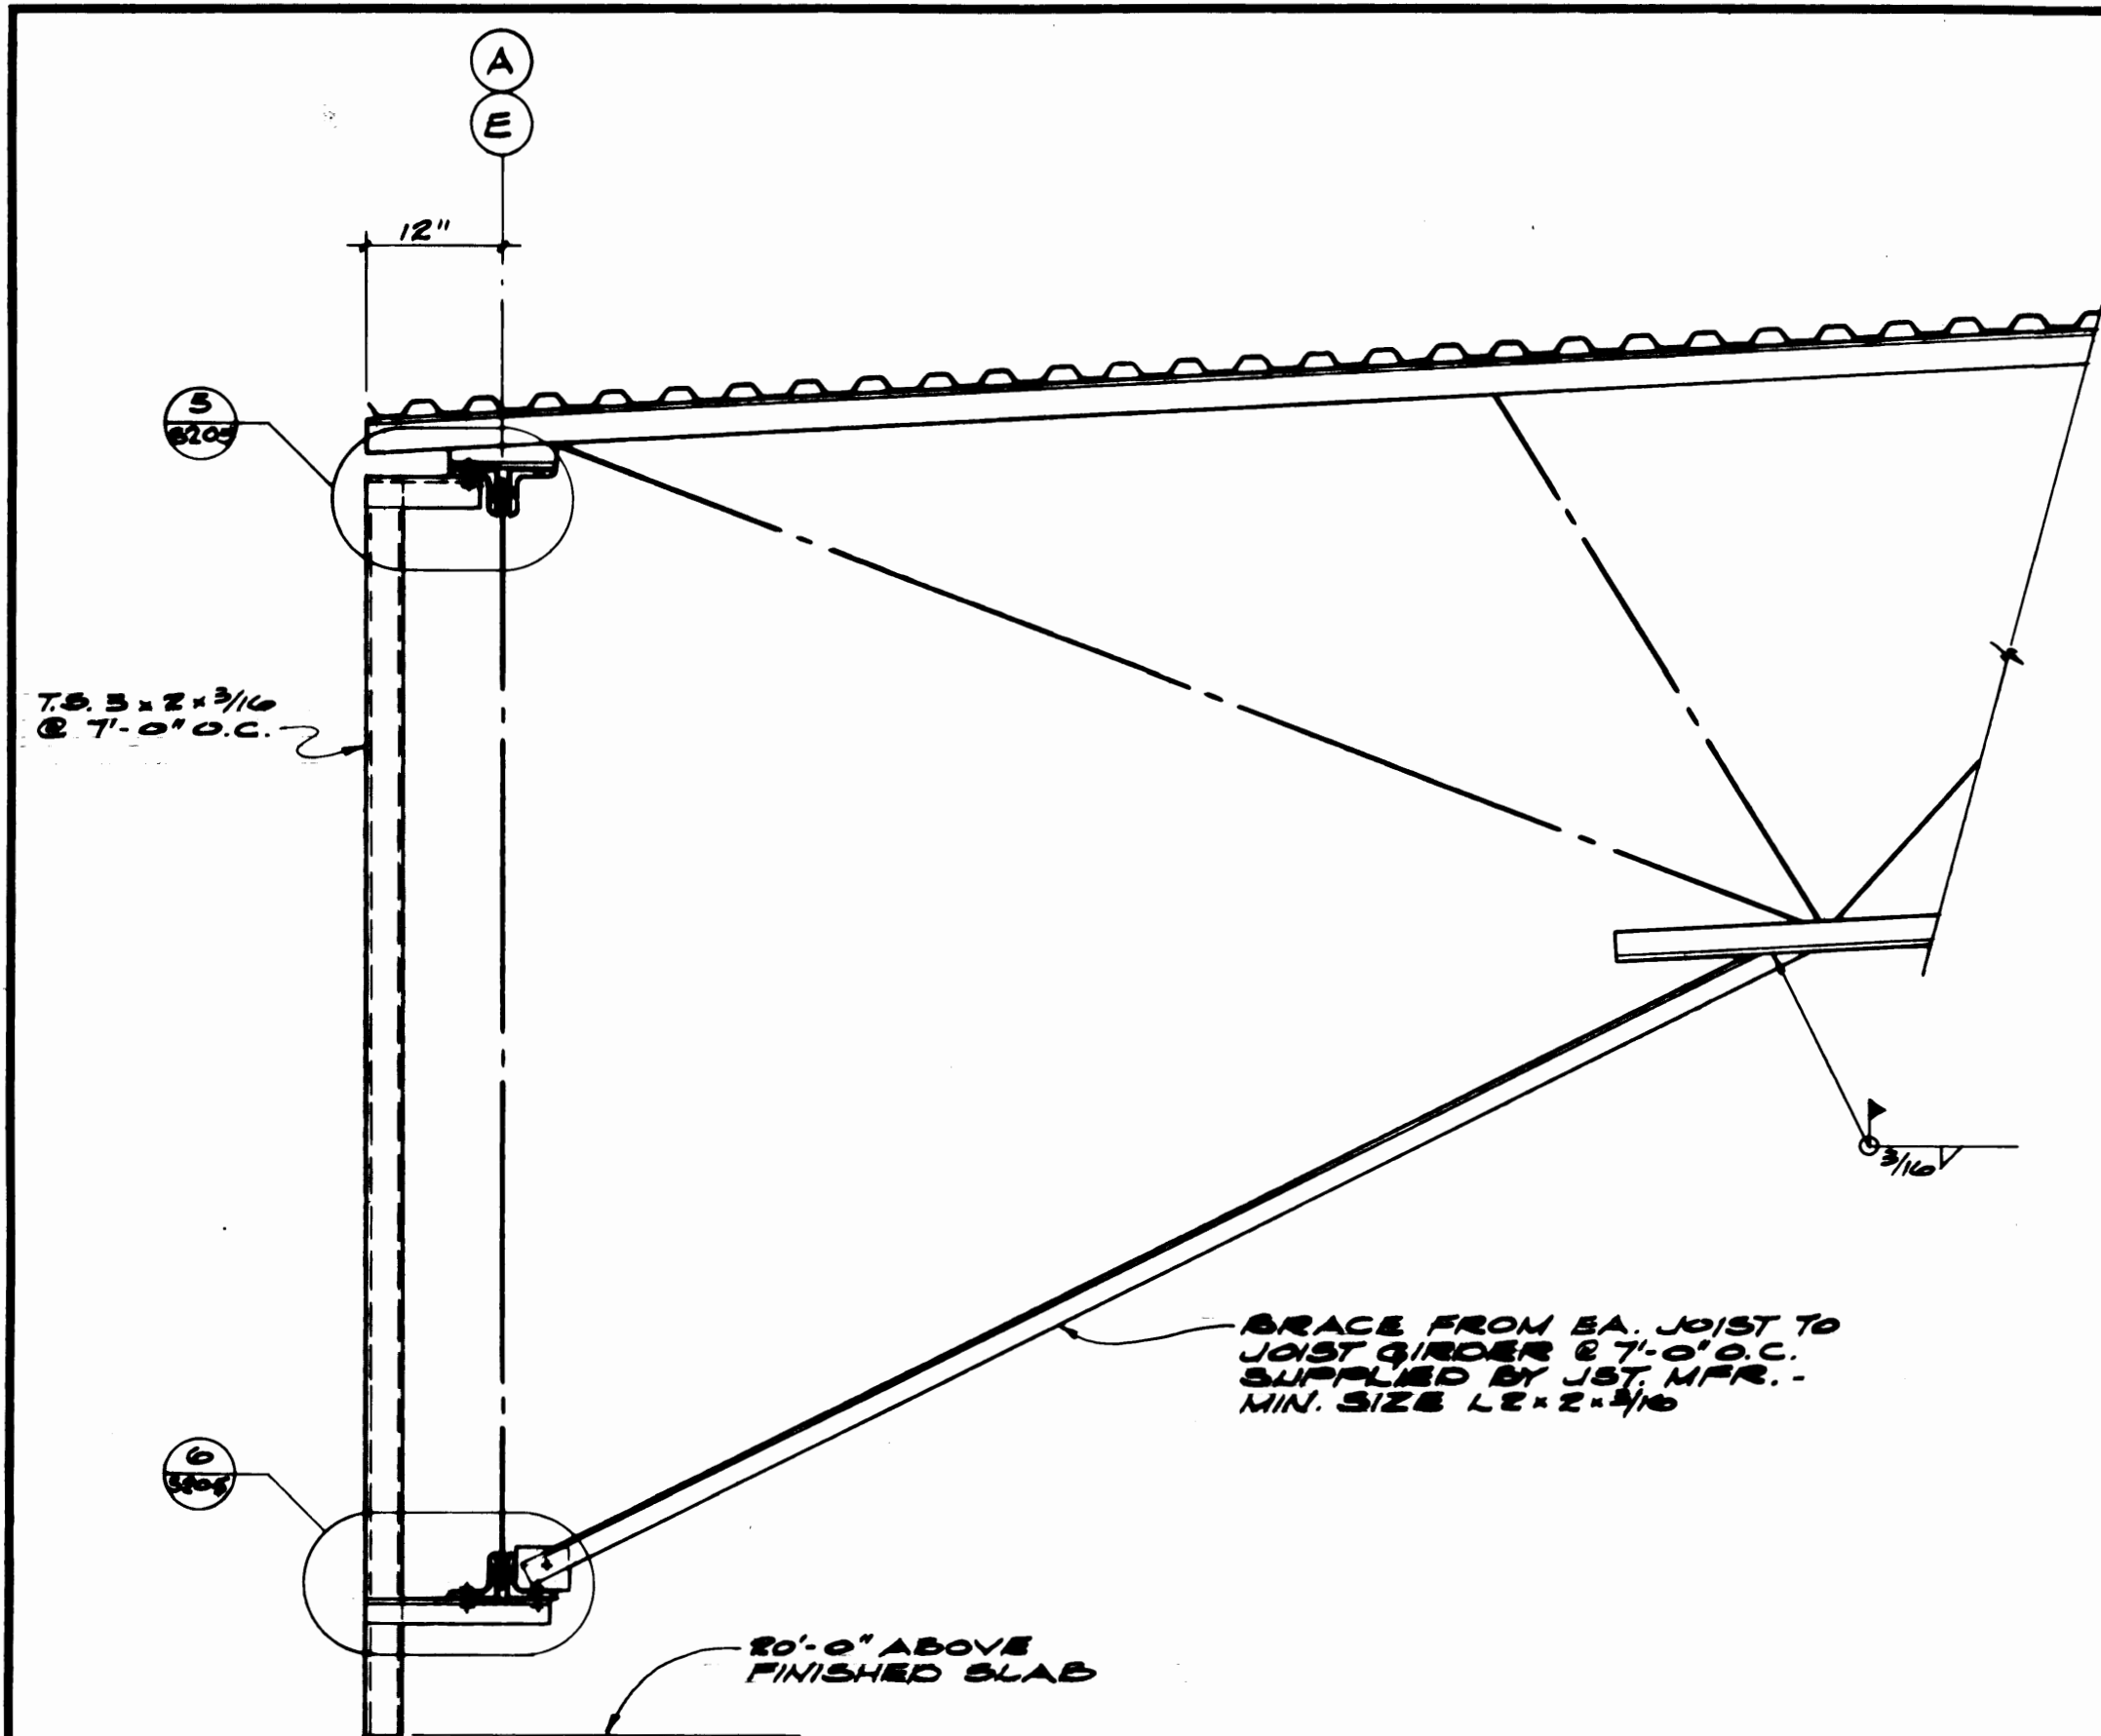


SECTION 1
1/2" = 1'-0"

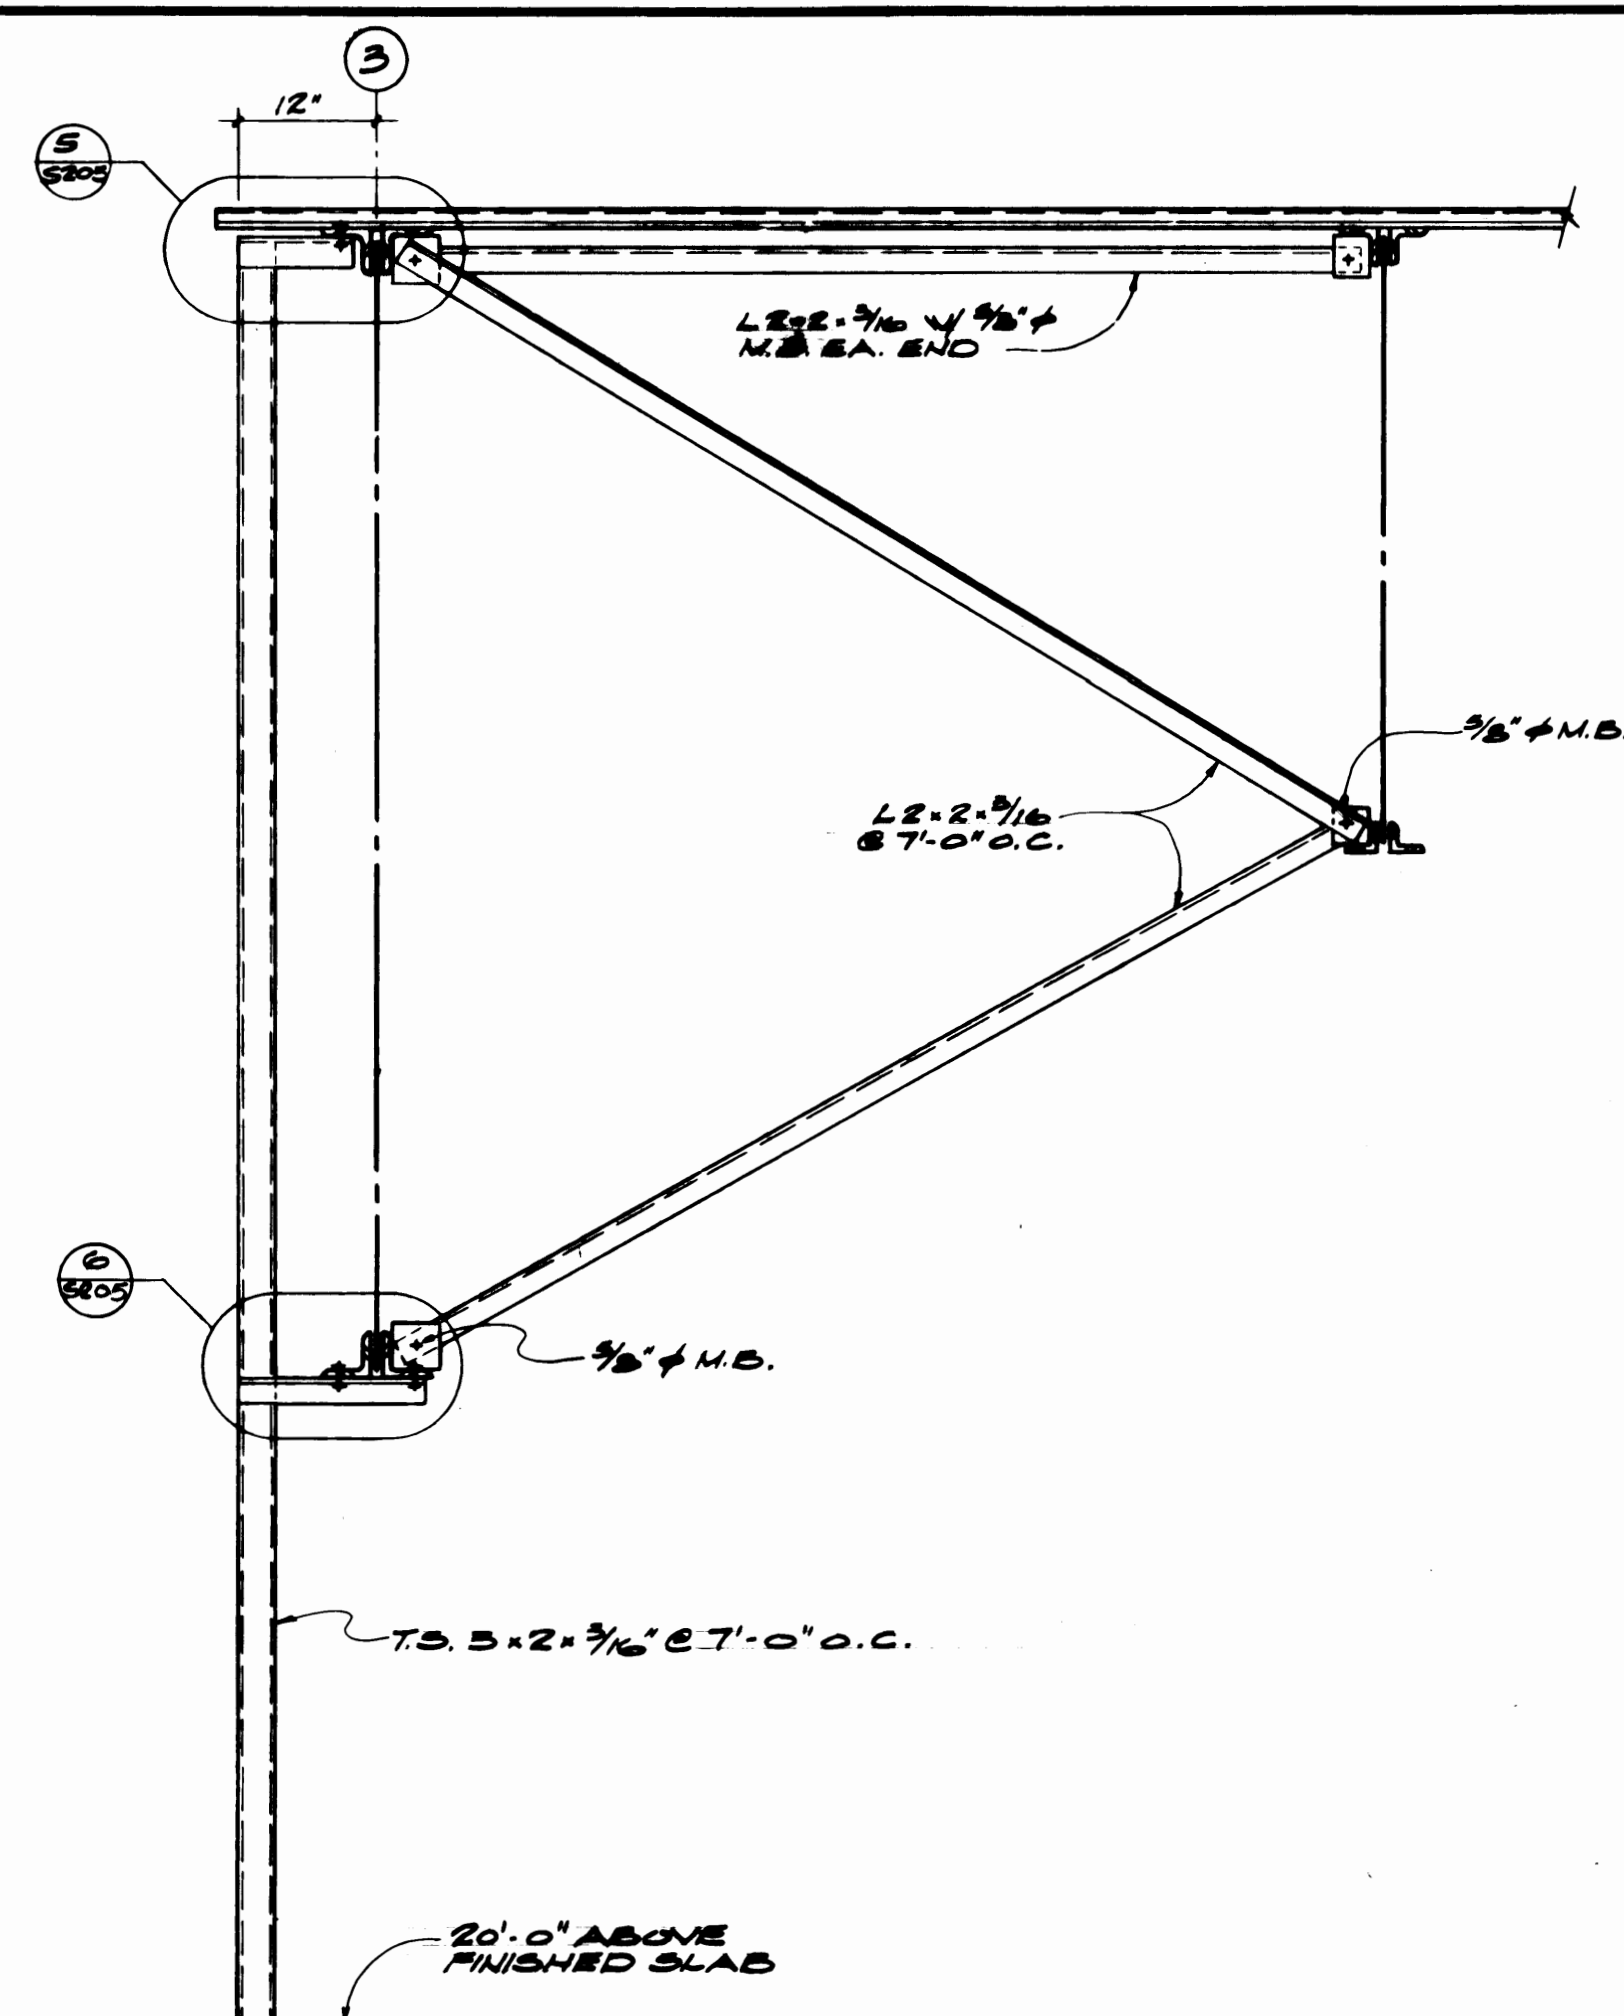


SECTION 2
3/4" = 1'-0"

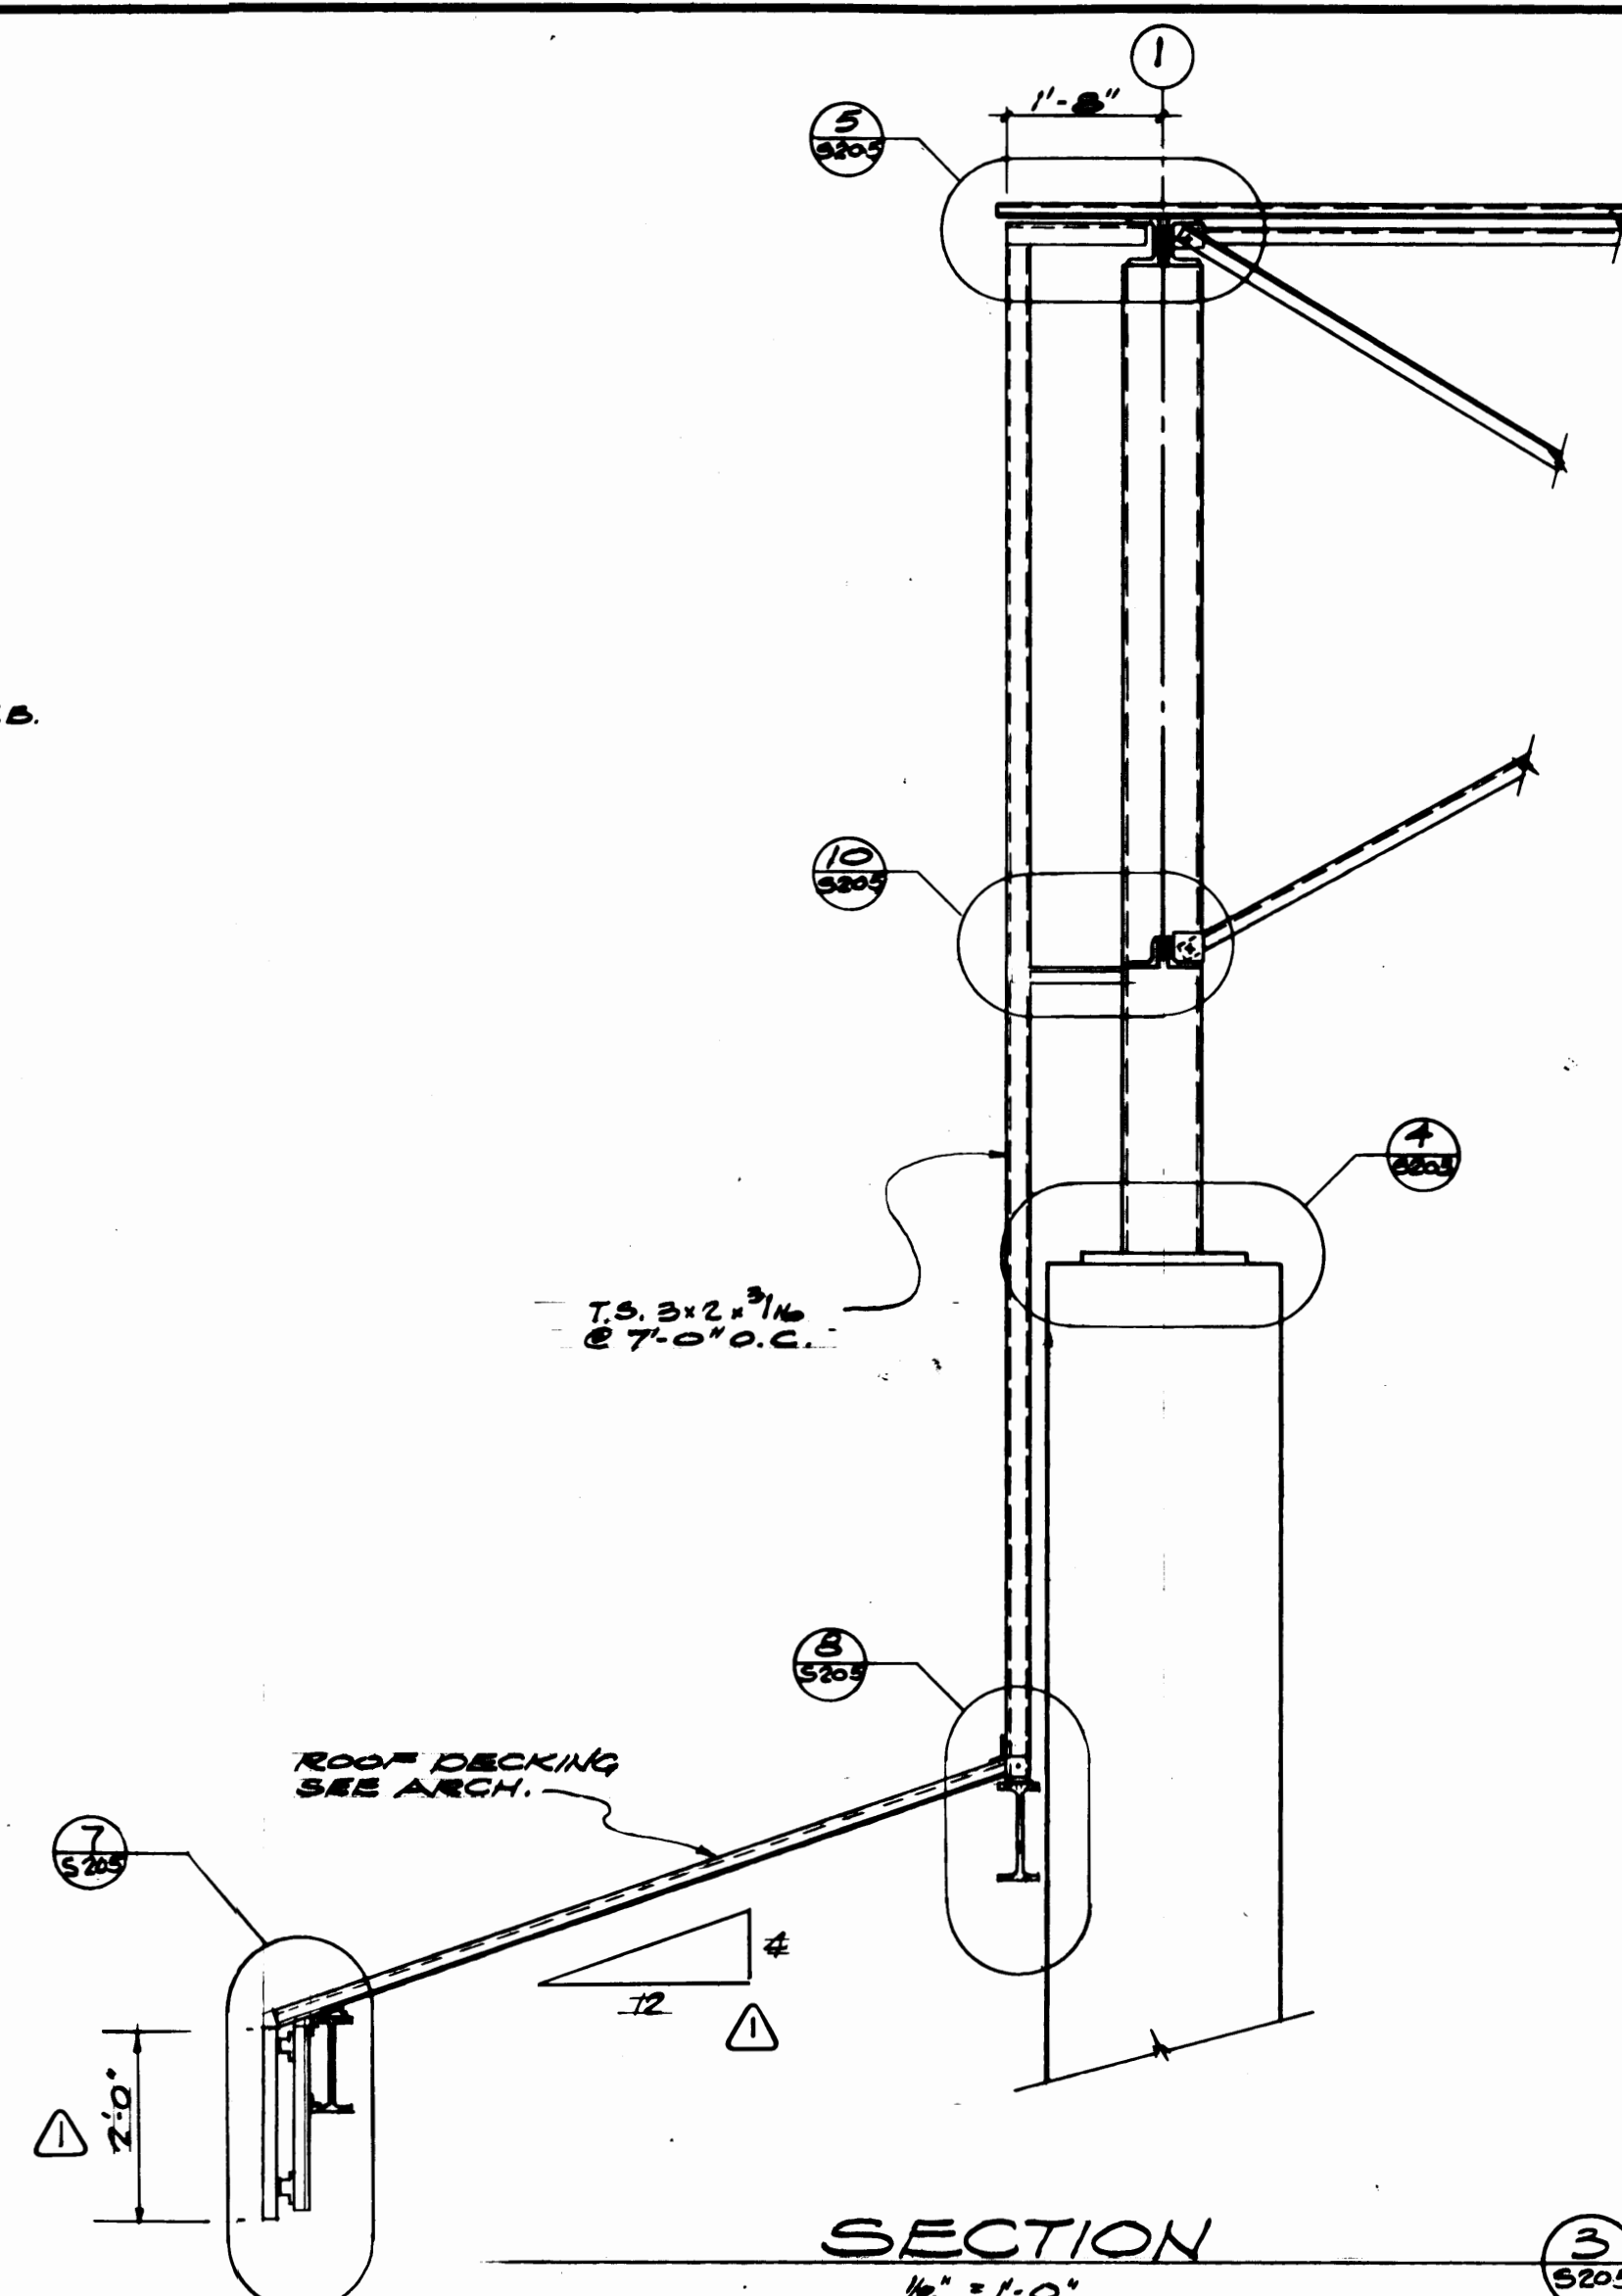


SECTION 3
1/2" = 1'-0"

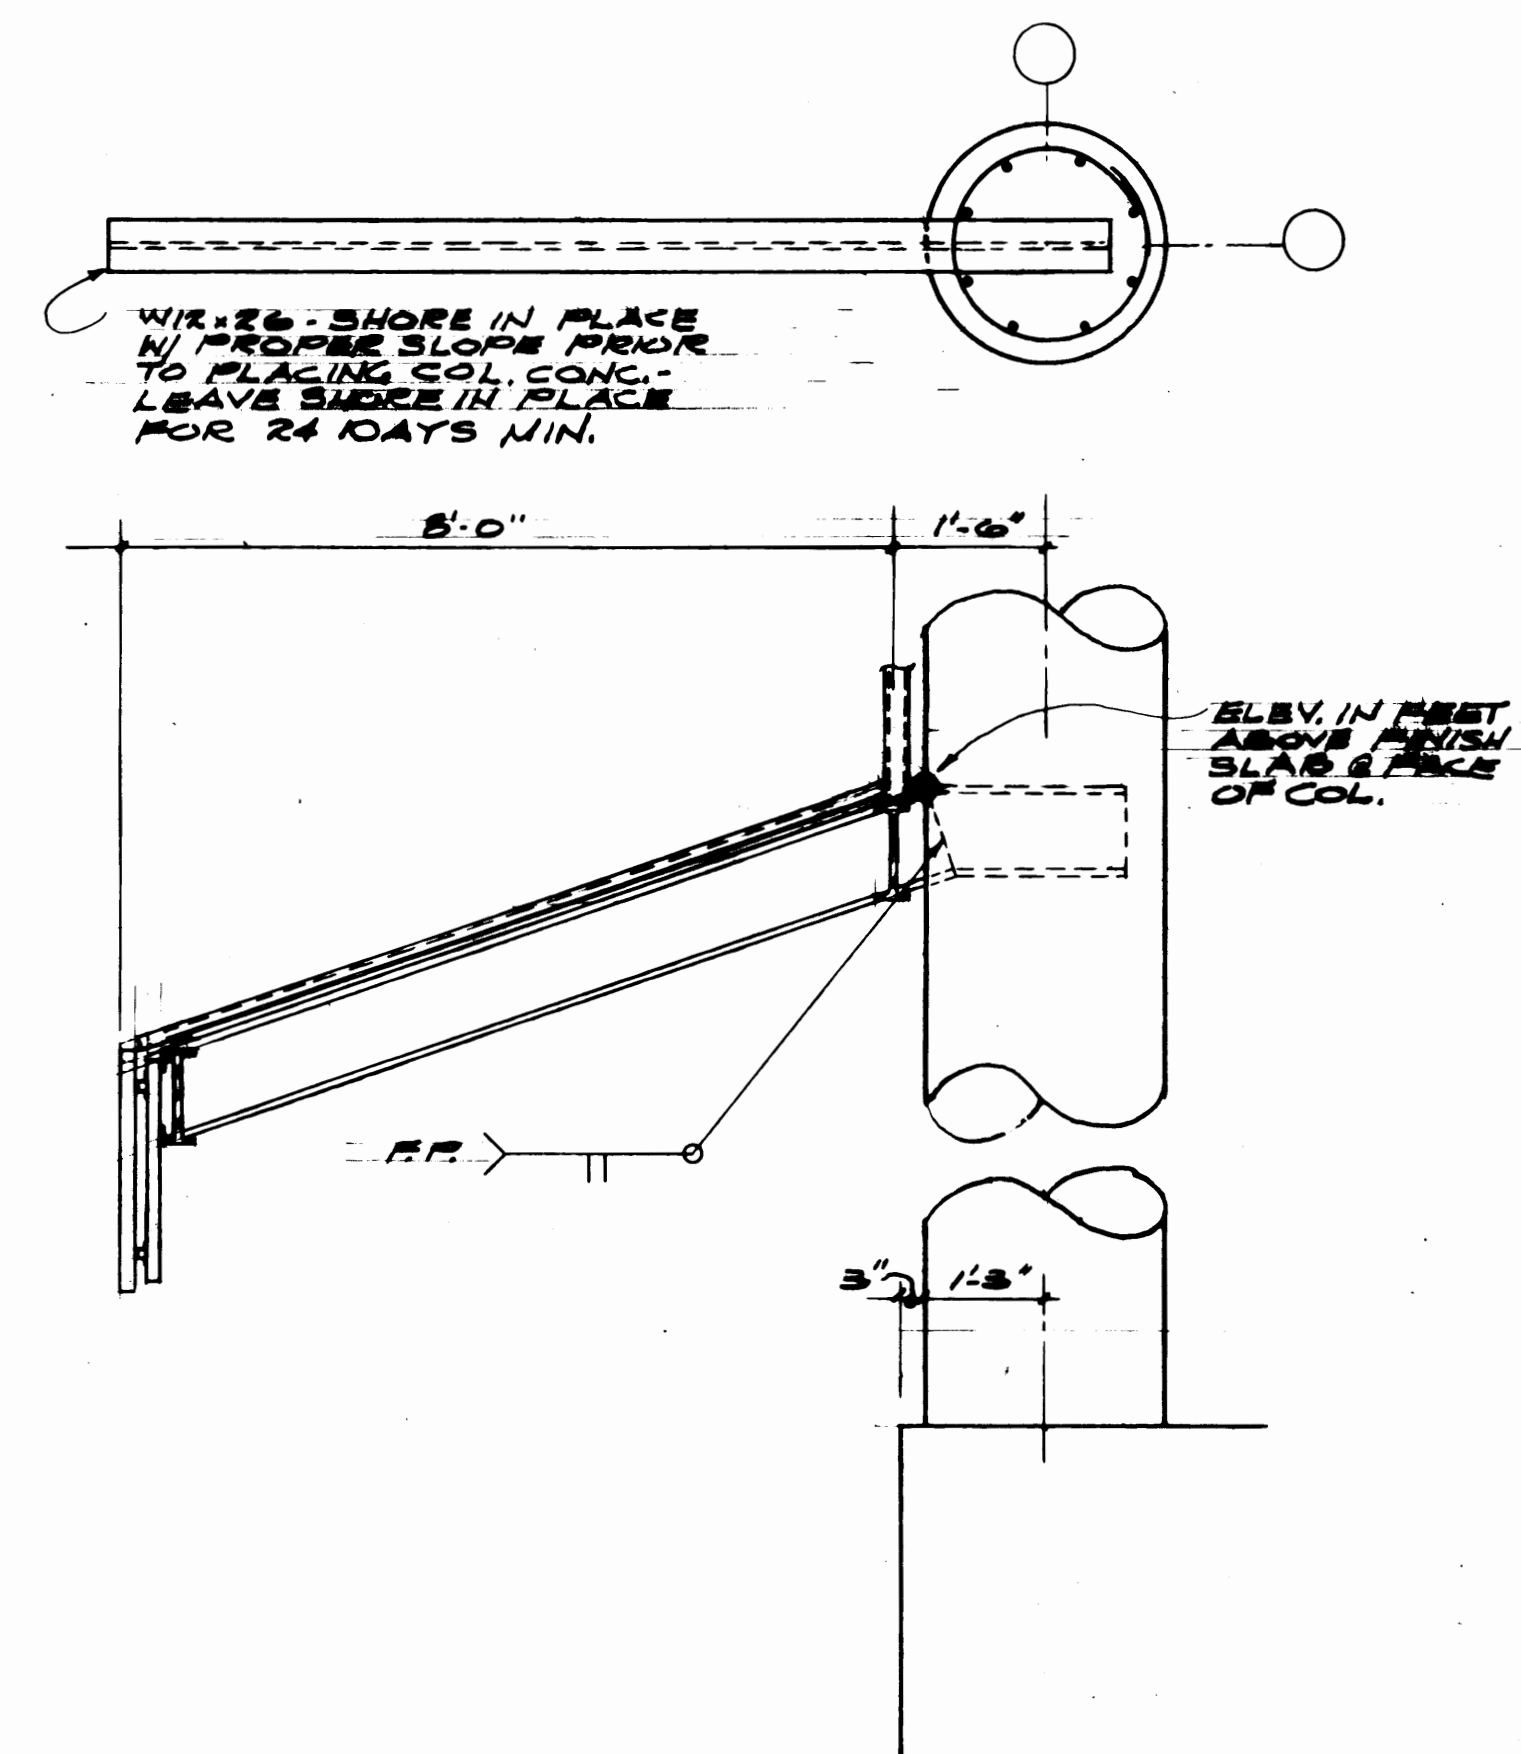


SECTION 4
1/2" = 1'-0"

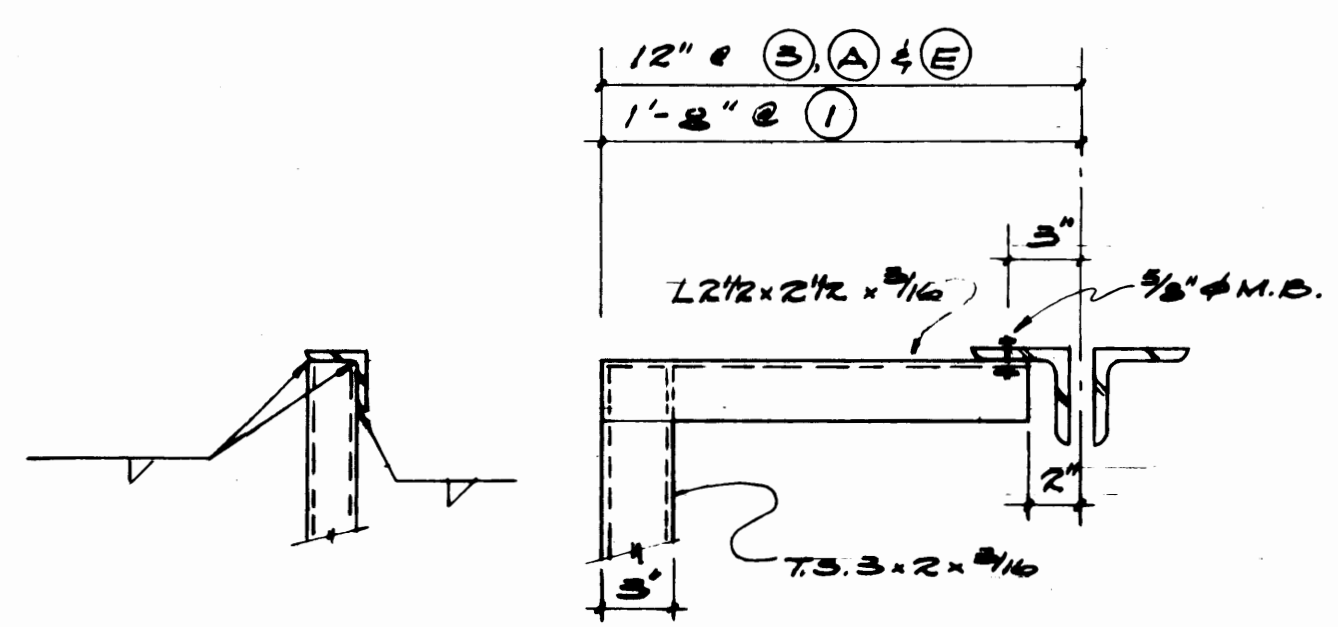


SECTION 5
1/2" = 1'-0"

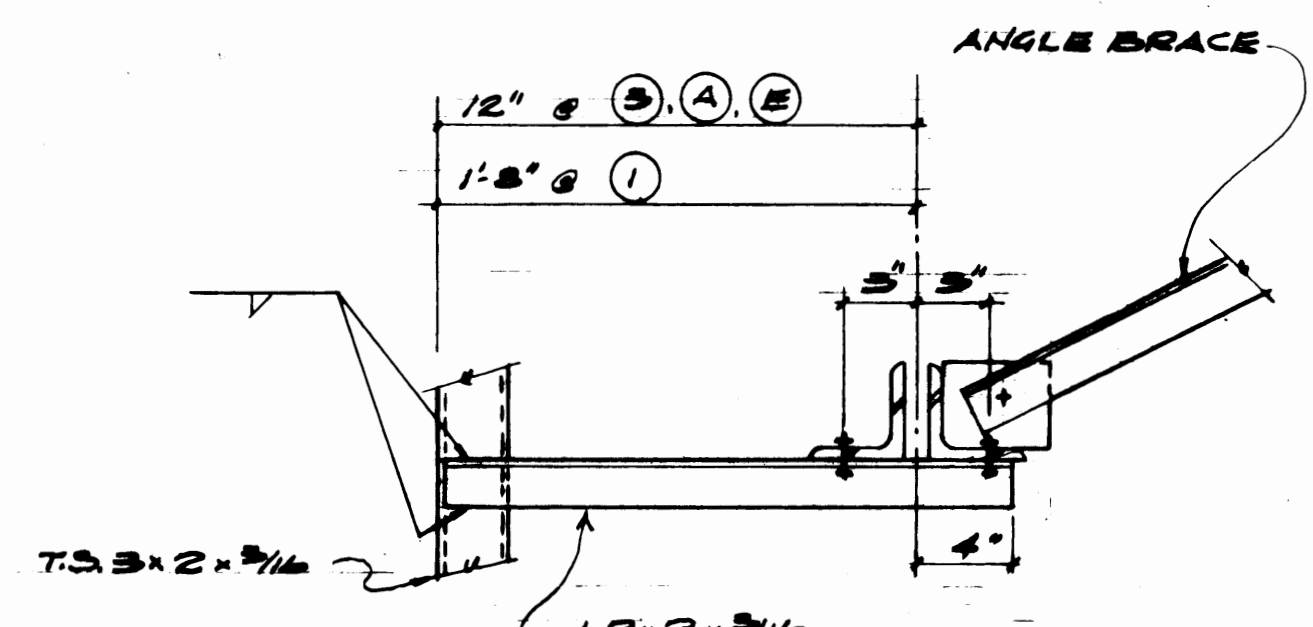


SECTION 6
1/2" = 1'-0"

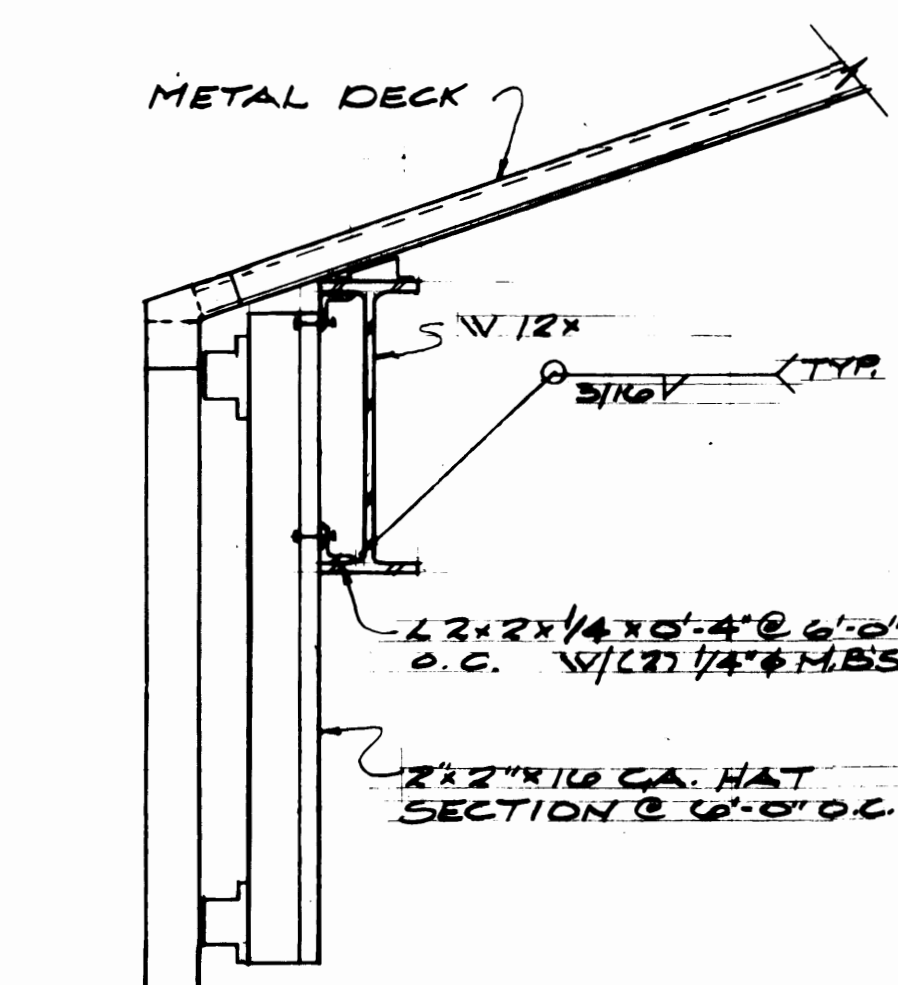


SECTION 7
1/2" = 1'-0"

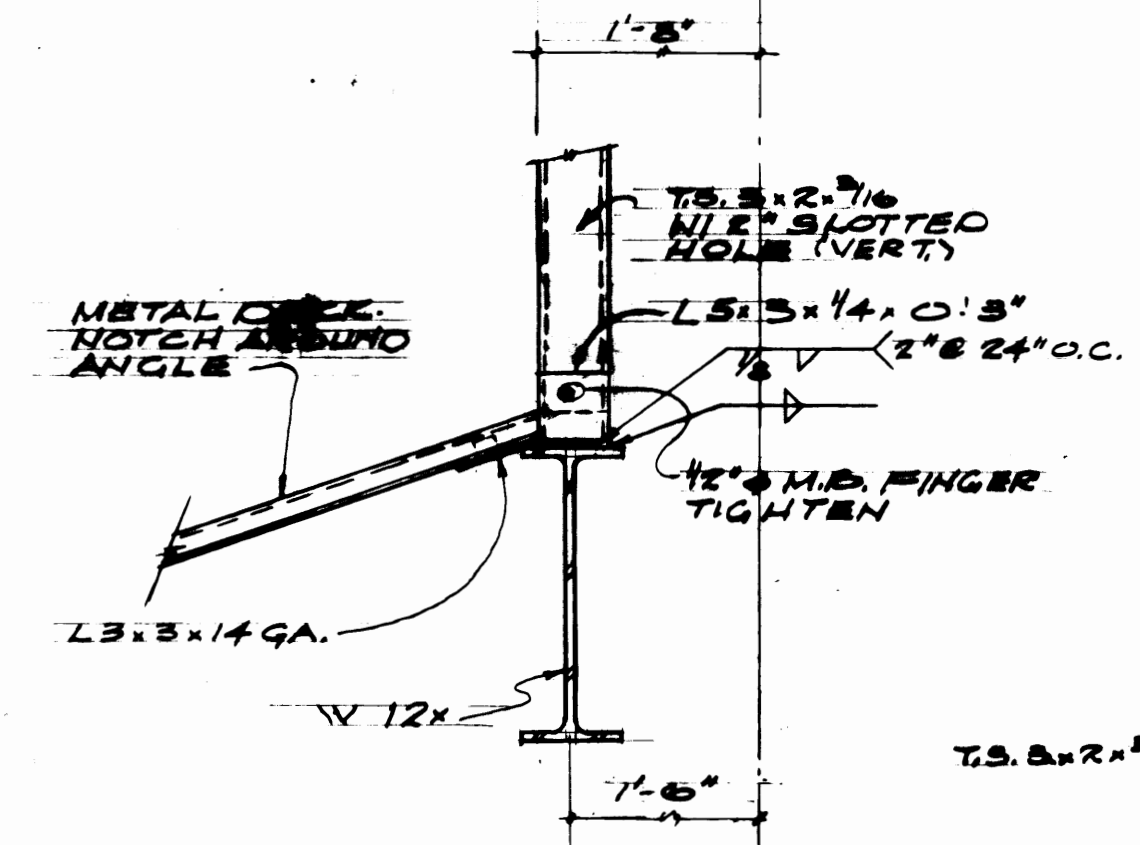

SECTION 8
1/2" = 1'-0"

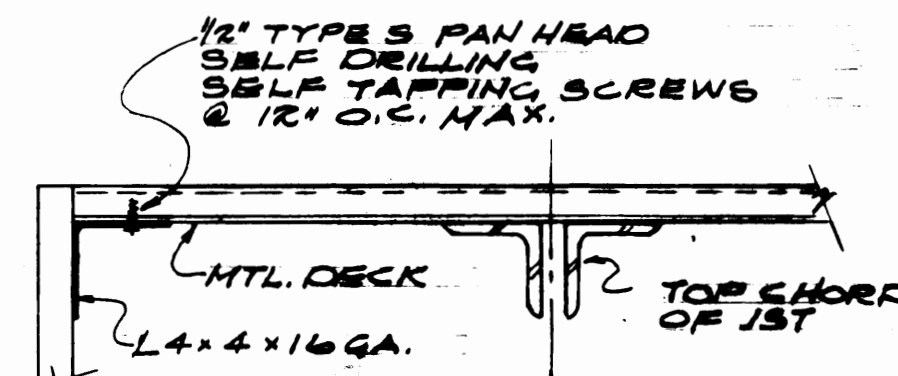

SECTION 9
1 1/2" = 1'-0"

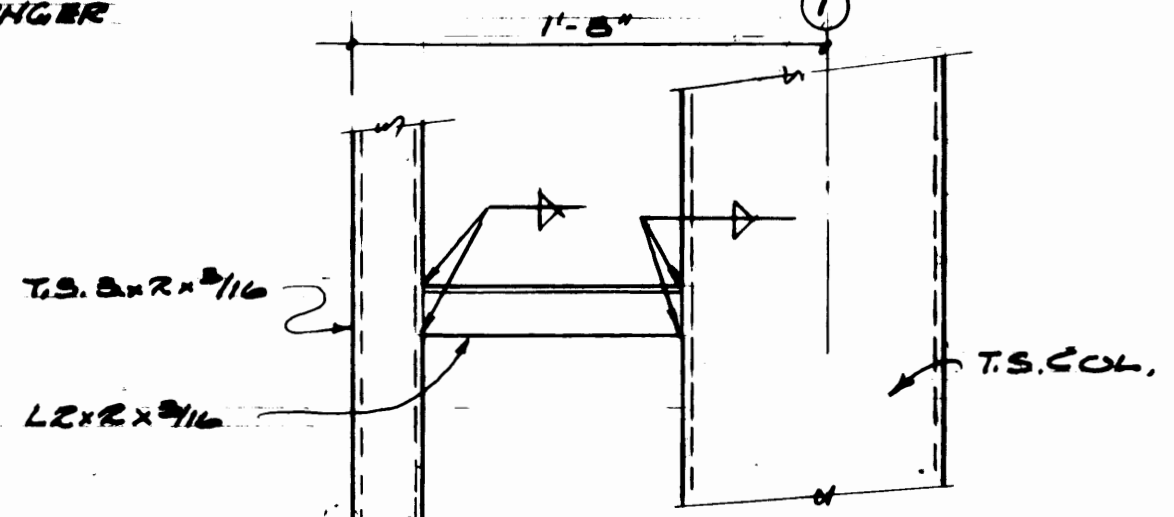

SECTION 10
1/2" = 1'-0"




Shaffer Engineers, Inc.
Consulting Engineers
51 University, Suite 201
Tacoma, WA 98401
(206) 866-4118
980 So. Tacoma, Suite 301
Tacoma, WA 98402
(206) 866-6787

REVISION	BY	APP.	DATE
1	J.S.	J.S.	3/30/84
2	J.S.	J.S.	3/30/84

DRAWN: J.N.		DATE: 3-22-84	
CHECKED: D.P.		DATE: 3-22-84	
CHECKED: D.P.		DATE: 3-22-84	
CONT. NO. 557			
FIELD BOOK (S)		APPROVED: [Signature] 3/30/84	
SCALE		DRAWING NO. EP 3874-23	
		DATE: 3/30/84	
		SHEET 53 OF 71	

PORT OF TACOMA
TACOMA TERMINALS, INC.
COVERED STORAGE DOCK
SECTIONS & DETAILS

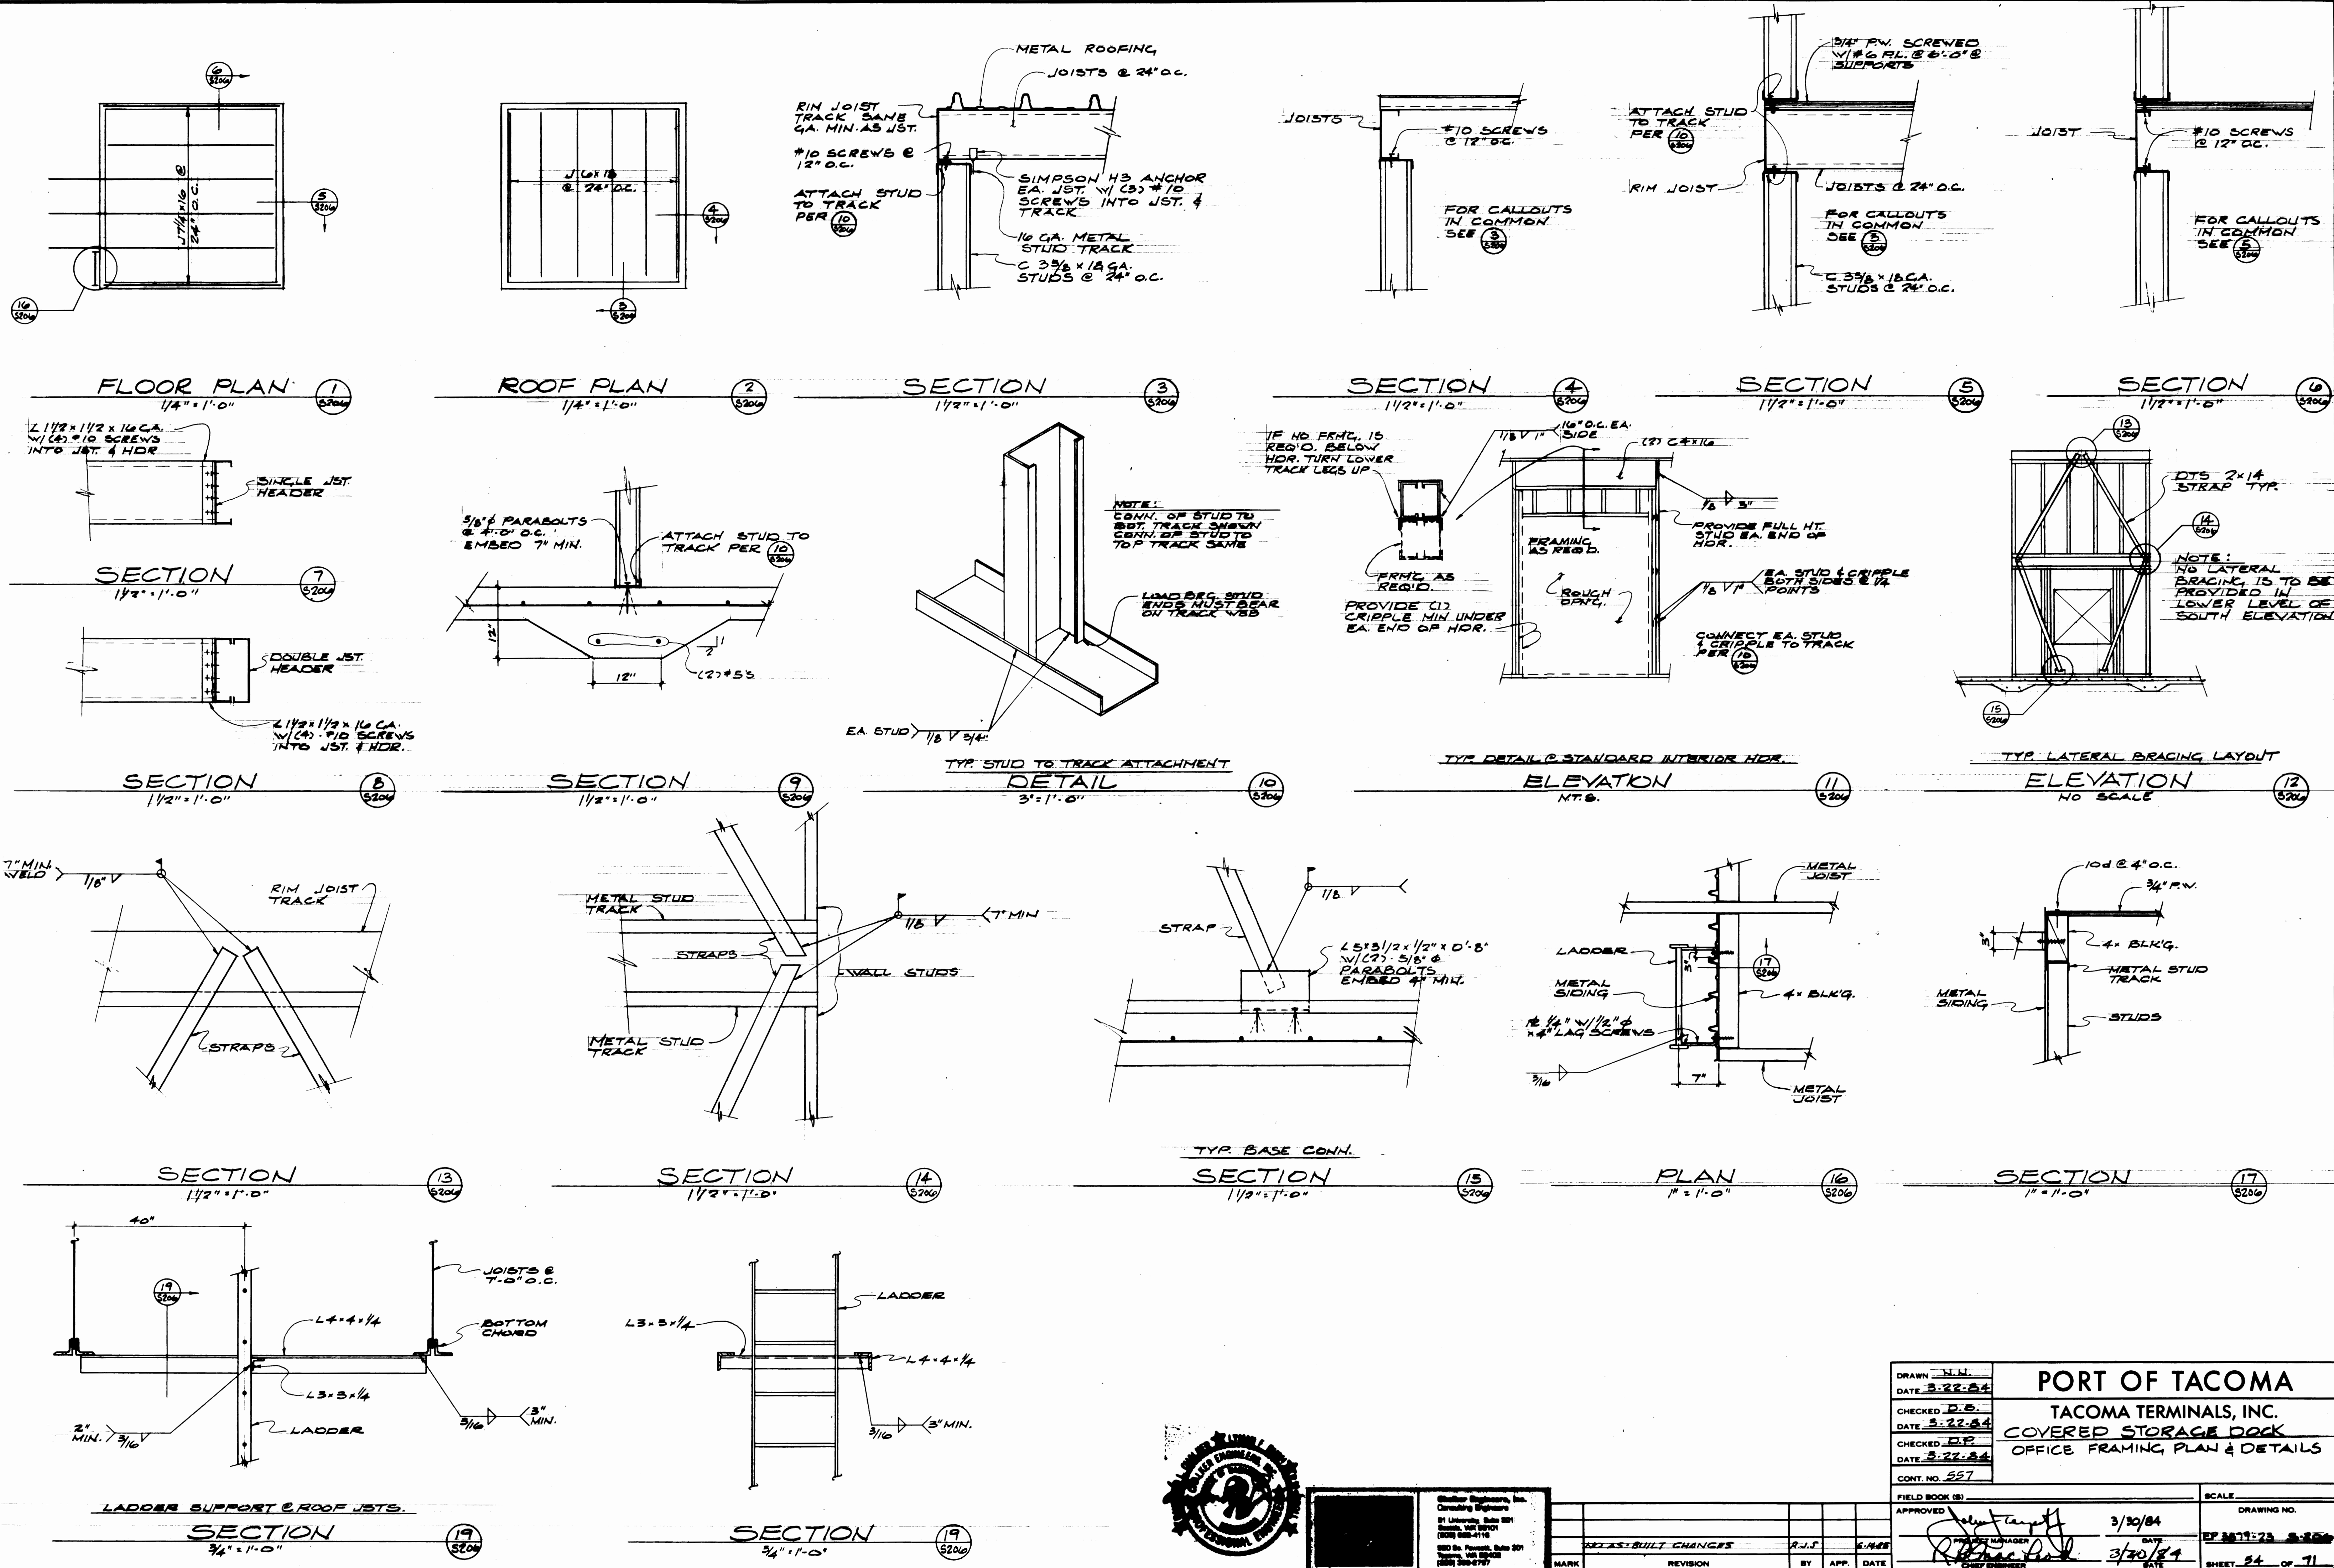

Structural Engineers, Inc.
Civil Engineering
21 University Blvd. SW
Bldg. 200, Suite 201
Tampa, FL 33606
(813) 288-4787

MARK	REVISION	BY	APP.	DATE
	AS-BUILT CHANGES	R.J.S.		5/1/88

DRAWN: N.N.		DATE: 3-22-84	
CHECKED: D.B.		DATE: 5-22-84	
CHECKED: D.B.		DATE: 5-22-84	
CONT. NO. 557		FIELD BOOK (S)	
APPROVED: [Signature]		DATE: 3/30/84	
PROJECT MANAGER: [Signature]		DATE: 3/30/84	
DATE: 3/30/84		DATE: 3/30/84	
SCALE		DRAWING NO.	
PORT OF TACOMA		TACOMA TERMINALS, INC.	
COVERED STORAGE DOCK		OFFICE FRAMING, PLAN & DETAILS	
SHEET 54 OF 71		J. 55816	