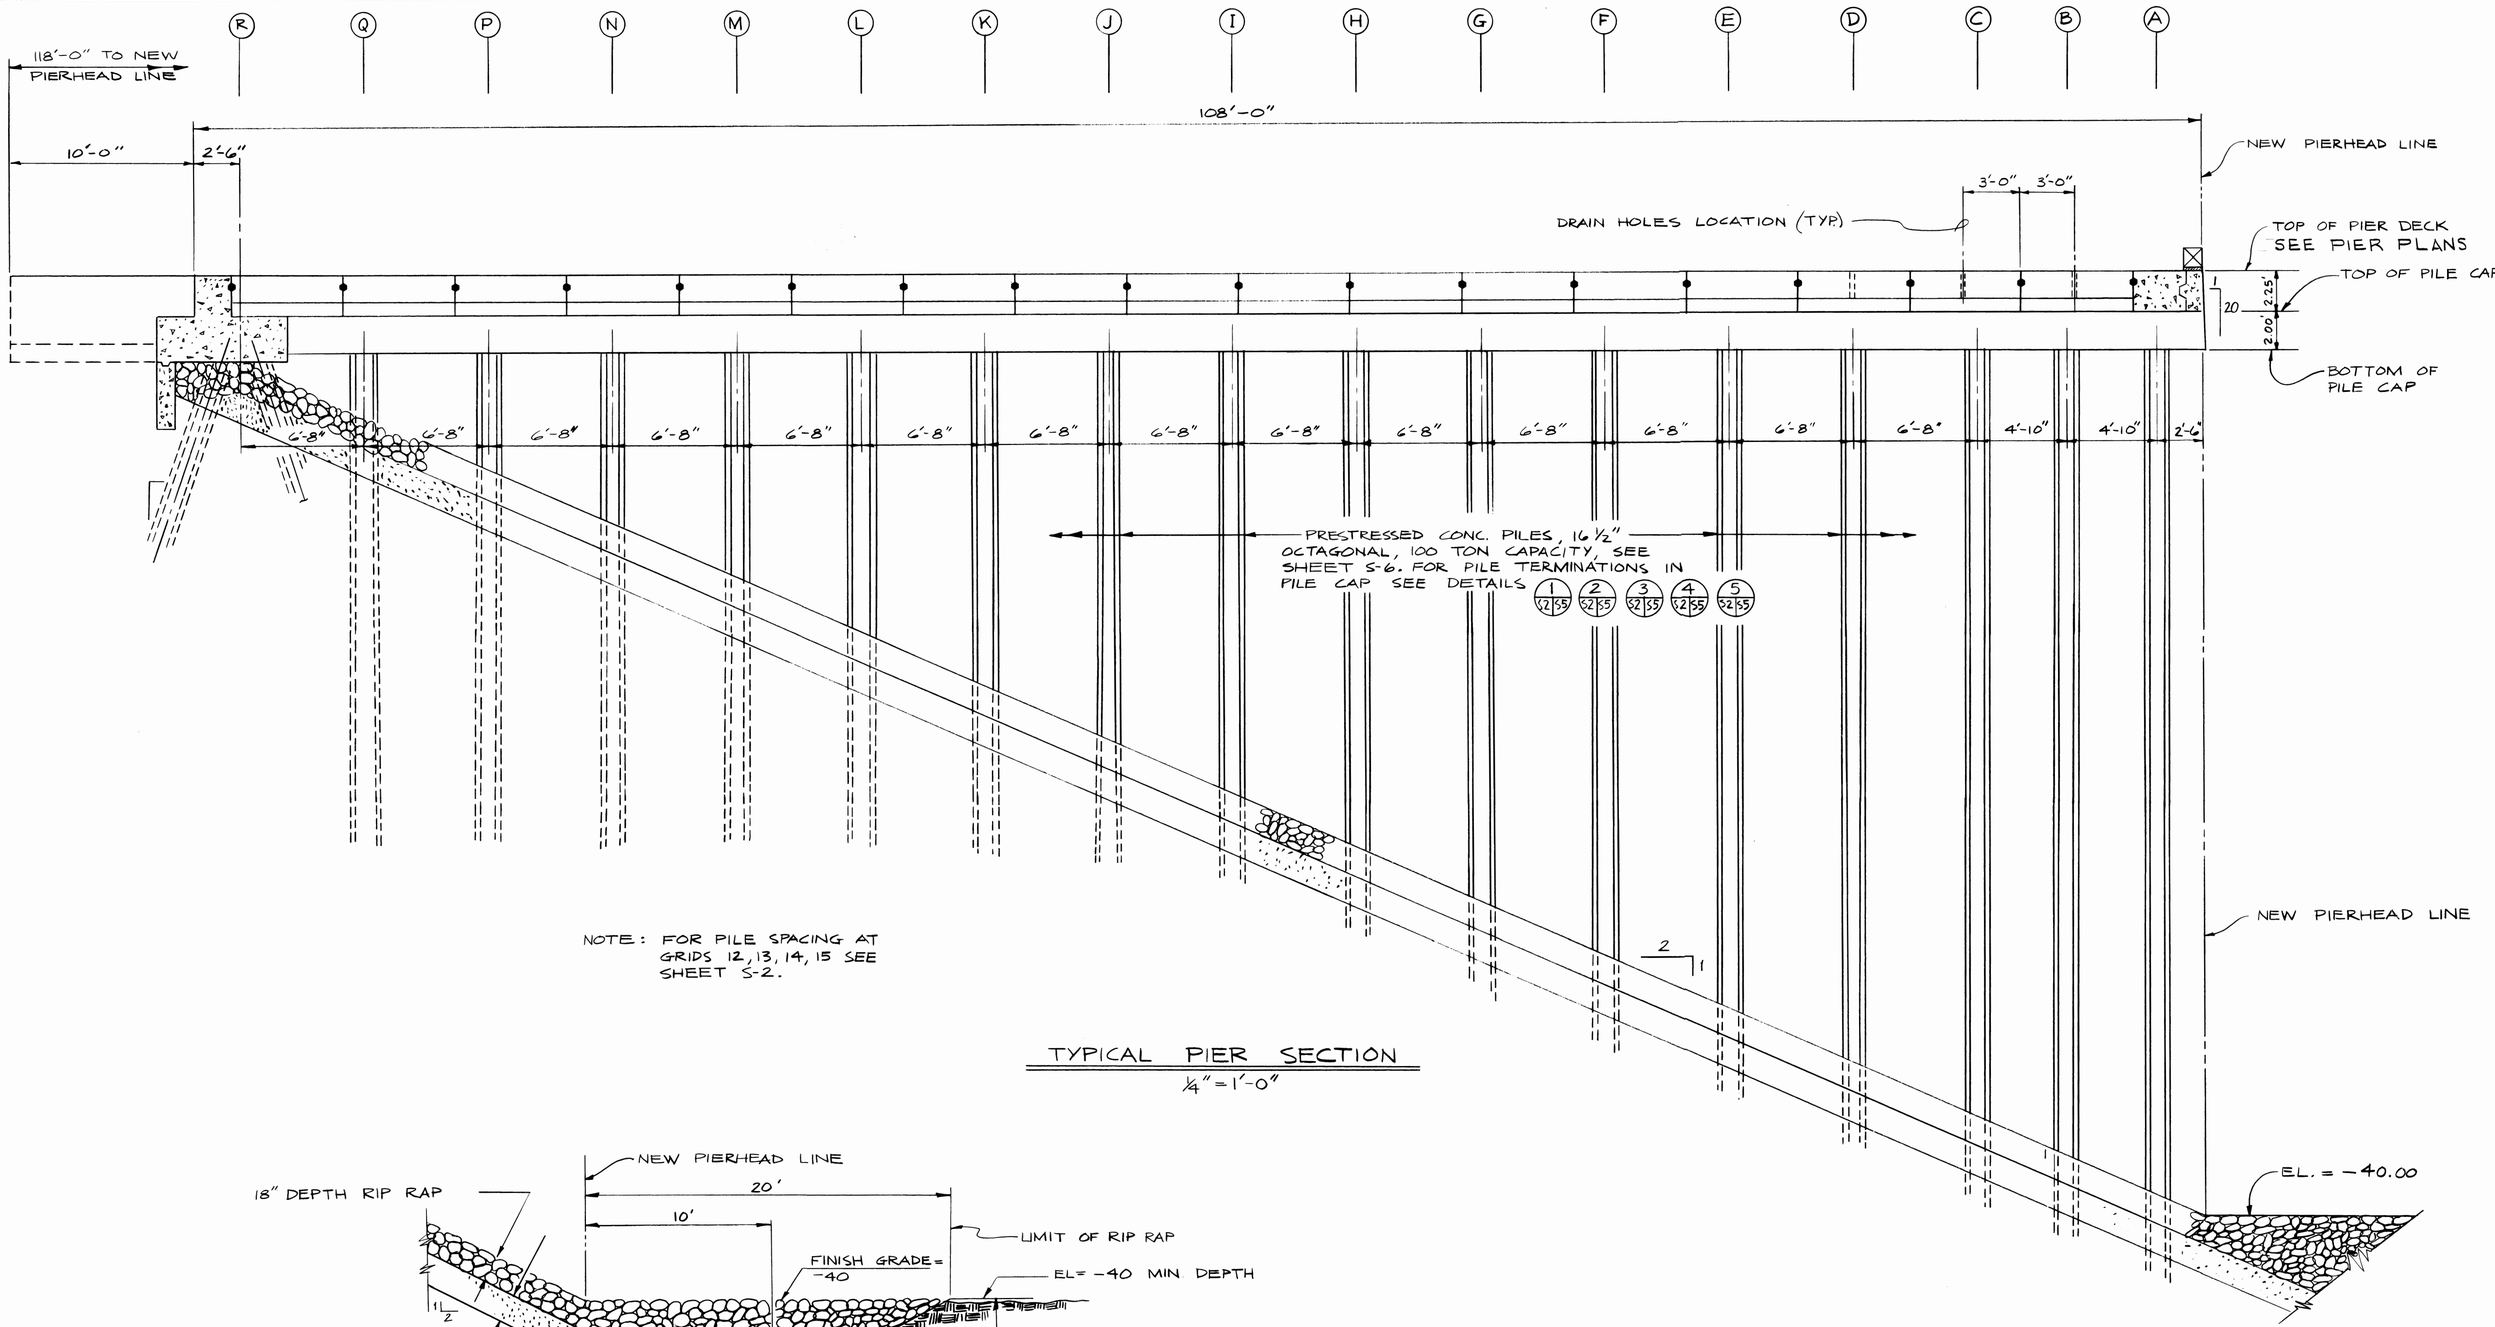

NOTE: FOR PILE SPACING AT GRIDS 12, 13, 14, 15 SEE SHEET S-2.

TYPICAL PIER SECTION

1/4" = 1'-0"

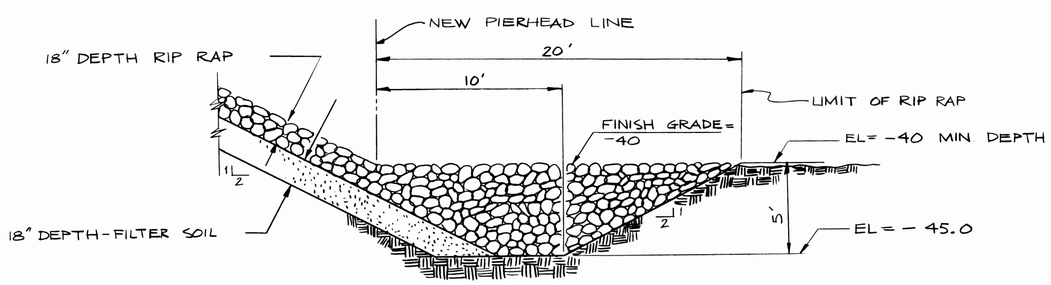

RIP RAP KEY DETAIL

N.T.S.

AS BUILT SEPT. 84 **S5**

DRAWN DJA DATE APRIL, 1983	PORT OF TACOMA
CHECKED WS DATE APRIL, 1983	PIER CROSS SECTION
CHECKED HLC DATE MAY, 1983	TOTE PIER FACILITY BLAIR WATERWAY, 1983
CONT. NO.	
FIELD BOOK(S)	SCALE NOTED
APPROVED R L MacLeod CHIEF ENGINEER 5/20/83 DATE	DRAWING NO. EP 3823-12
	SHEET 14 OF 25

SITTS & HILL ENGINEERS
CIVIL, STRUCTURAL & SURVEYING
2901 SO. 40th TACOMA WA 98409

MARK	REVISION	BY	APP.	DATE