PORT OF TACOMA

AS-BUILT DRAWINGS

TOTE PIER FACILITY
BLAIR WATERWAY - 1983
CONTRACT NO. 538

COMMISSIONERS: PATRICK O'MALLEY
PRESIDENT

JACK A. FABULICH
VICE PRESIDENT

ROBERT G. EARLEY
SECRETARY

EXECUTIVE DIRECTOR: RICHARD D. SMITH

CHIEF ENGINEER: ROBERT L. MacLEOD

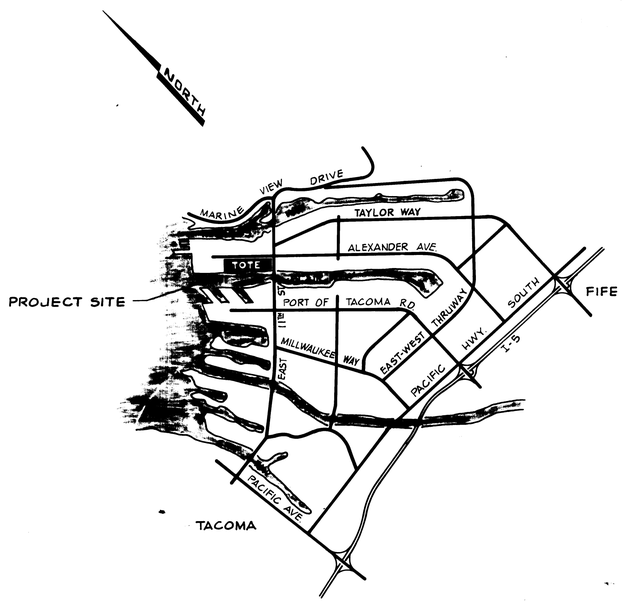

VICINITY MAP N.T.S.

DRAWING INDEX

EP 3823-12	SHEET 1 OF 25	—	TITLES & VICINITY MAP
EP 3823-12	SHEET 2 OF 25	C-1	SITE PLAN
EP 3823-12	SHEET 3 OF 25	C-2	DREDGING PLAN
EP 3823-12	SHEET 4 OF 25	C-3	UTILITY PLAN & DETAILS
EP 3823-12	SHEET 5 OF 25	C-4	CROSS SECTIONS STA. 6+00-8+00
EP 3823-12	SHEET 6 OF 25	C-5	CROSS SECTIONS STA. 9+00-11+00
EP 3823-12	SHEET 7 OF 25	C-6	CROSS SECTIONS STA. 12+00-14+00
EP 3823-12	SHEET 8 OF 25	C-7	CROSS SECTIONS STA. 15+00-17+00
EP 3823-12	SHEET 9 OF 25	C-8	CROSS SECTIONS STA. 18+00-19+50
EP 3823-12	SHEET 10 OF 25	S-1	PIER LAYOUT, DESIGN CRITERIA & GENERAL NOTES
EP 3823-12	SHEET 11 OF 25	S-2	PILING PLAN
EP 3823-12	SHEET 12 OF 25	S-3	FRAMING PLAN - 85 FT. PIER
EP 3823-12	SHEET 13 OF 25	S-4	PIER FRAMING PLANS
EP 3823-12	SHEET 14 OF 25	S-5	PIER CROSS SECTION
EP 3823-12	SHEET 15 OF 25	S-6	PRESTRESSED CONCRETE PILE & A & A-1 PANEL DETAILS
EP 3823-12	SHEET 16 OF 25	S-7	B & B-1 PRECAST PANEL DETAILS & WHEEL BEARING PLATES
EP 3823-12	SHEET 17 OF 25	S-8	TYPICAL PILE CAP DETAILS
EP 3823-12	SHEET 18 OF 25	S-9	MISCELLANEOUS DETAILS
EP 3823-12	SHEET 19 OF 25	S-10	FENDER SYSTEM LAYOUT
EP 3823-12	SHEET 20 OF 25	S-11	FENDER SYSTEM DETAILS
EP 3823-12	SHEET 21 OF 25	S-12	BOLLARD DETAILS
EP 3823-12	SHEET 22 OF 25	S-13	WALKWAY PLAN & DETAILS
EP 3823-12	SHEET 23 OF 25	S-14	WALKWAY DETAILS
EP 3823-12	SHEET 24 OF 25	E-1	ELECTRICAL SITE PLAN
EP 3823-12	SHEET 25 OF 25	E-2	ELECTRICAL DETAILS
~~EP 3823-12~~	~~SHEET 26 OF 27~~	~~GC-1~~	~~DISPOSAL SITE~~
~~EP 3823-12~~	~~SHEET 27 OF 27~~	~~GC-2~~	~~MATERIAL TRANSFER AREA~~

SITTS & HILL ENGINEERS
CIVIL, STRUCTURAL & SURVEYING
2201 SO. 48th TACOMA WA 98409

APPROVED 5/20/83
R L MacLeod
CHIEF ENGINEER

DRAWING NO. EP 3823-12
SHEET 1 OF 25

4663